

TLW Corporation

Initial Application Date: 05/20/05

Application # 05 50012201
946070

COUNTY OF HARNETT LAND USE APPLICATION
Central Permitting 102 E. Front Street, Lillington, NC 27546 Phone: (910) 893-4759 Fax: (910) 893-2793

LANDOWNER: Eaton Fisher Mailing Address: 47 Muscadine Court
City: Lillington State: NC Zip: 27546 Phone #:

APPLICANT: TLW Corporation Mailing Address: PO Box 292
City: Lillington State: NC Zip: 27546 Phone #: 910-893-7227/919-971-0240 (RI)

PROPERTY LOCATION: SR #: _____ SR Name: MUSCADINE COURT
Address: 47 MUSCADINE COURT

Parcel: 110651005749 PIN: 0651-93-1025

Zoning: RA-40 Subdivision: Plantation @ Vineyard Green Lot #: 77 Lot Size: .479 ac
Flood Plain: X Panel: 370850085R Watershed: _____ Deed Book/Page: 020240989 Plat Book/Page: 2000-549A

DIRECTIONS TO THE PROPERTY FROM LILLINGTON: 210 N; left on Tipp Rd; left on
Scuppernon Lane; left on Sweet Henry Lane; left on Muscadine Ct.
lot is at end of cul-de-sac, on left.

PROPOSED USE:

- Sg. Family Dwelling (Size 50 x 62) # of Bedrooms 3 # Baths 2 Basement (w/wo bath) N/A Garage 1/1C
 - Multi-Family Dwelling No. Units _____ No. Bedrooms/Unit _____
 - Manufactured Home (Size _____ x _____) # of Bedrooms _____ Garage _____ Deck _____
 - Number of persons per household 1
 - Business Sq. Ft. Retail Space _____ Type _____
 - Industry Sq. Ft. _____ Type _____
 - Church Seating Capacity _____ Kitchen _____
 - Home Occupation (Size _____ x _____) # Rooms _____ Use _____
- Additional Information: _____
- Accessory Building (Size _____ x _____) Use _____
 - Addition to Existing Building (Size _____ x _____) Use _____
 - Other _____

Ratio 12x8 Deck
Ratio 11x8 Deck
Not included in total size

Additional Information: _____

Water Supply: County Well (No. dwellings _____) Other _____

Sewage Supply: New Septic Tank Existing Septic Tank County Sewer Other _____

Erosion & Sedimentation Control Plan Required? YES NO

Property owner of this tract of land own land that contains a manufactured home w/in five hundred feet (500') of tract listed above? YES NO

Structures on this tract of land: Single family dwellings _____ Manufactured homes _____ Other (specify) _____

Required Residential Property Line Setbacks: Proposed Minimum Actual

Front	35	47.5'
Rear	25	78' 00'
Side	10	15.7'
Corner	20	-
Nearest Building	10	30'

If permits are granted I agree to conform to all ordinances and the laws of the State of North Carolina regulating such work and the specifications or plans submitted. I hereby swear that the foregoing statements are accurate and correct to the best of my knowledge.

Signature of Owner or Owner's Agent: [Signature]
TLW Corporation

Date: 5/20/05

This application expires 6 months from the initial date if no permits have been issued

A RECORDED SURVEY PLAT AND RECORDED DEED ARE REQUIRED WHEN APPLYING FOR A LAND USE APPLICATION



5/27 N

MAGNETIC NORTH
MAP NO. 2000-549A

MAP REFERENCE: MAP NO. 2000-549-A

MINIMUM BUILDING SET BACKS
 FRONT YARD ——— 35'
 REAR YARD ——— 25'
 SIDE YARD ——— 10'
 CORNER LOT SIDE YARD — 20'
 MAXIMUM HEIGHT ——— 35'

SITE PLAN APPROVAL
 DISTRICT RAFD USE SFD
 #BEDROOMS 3
Shades A. Dwyer
 Date _____
 Zoning Administrator

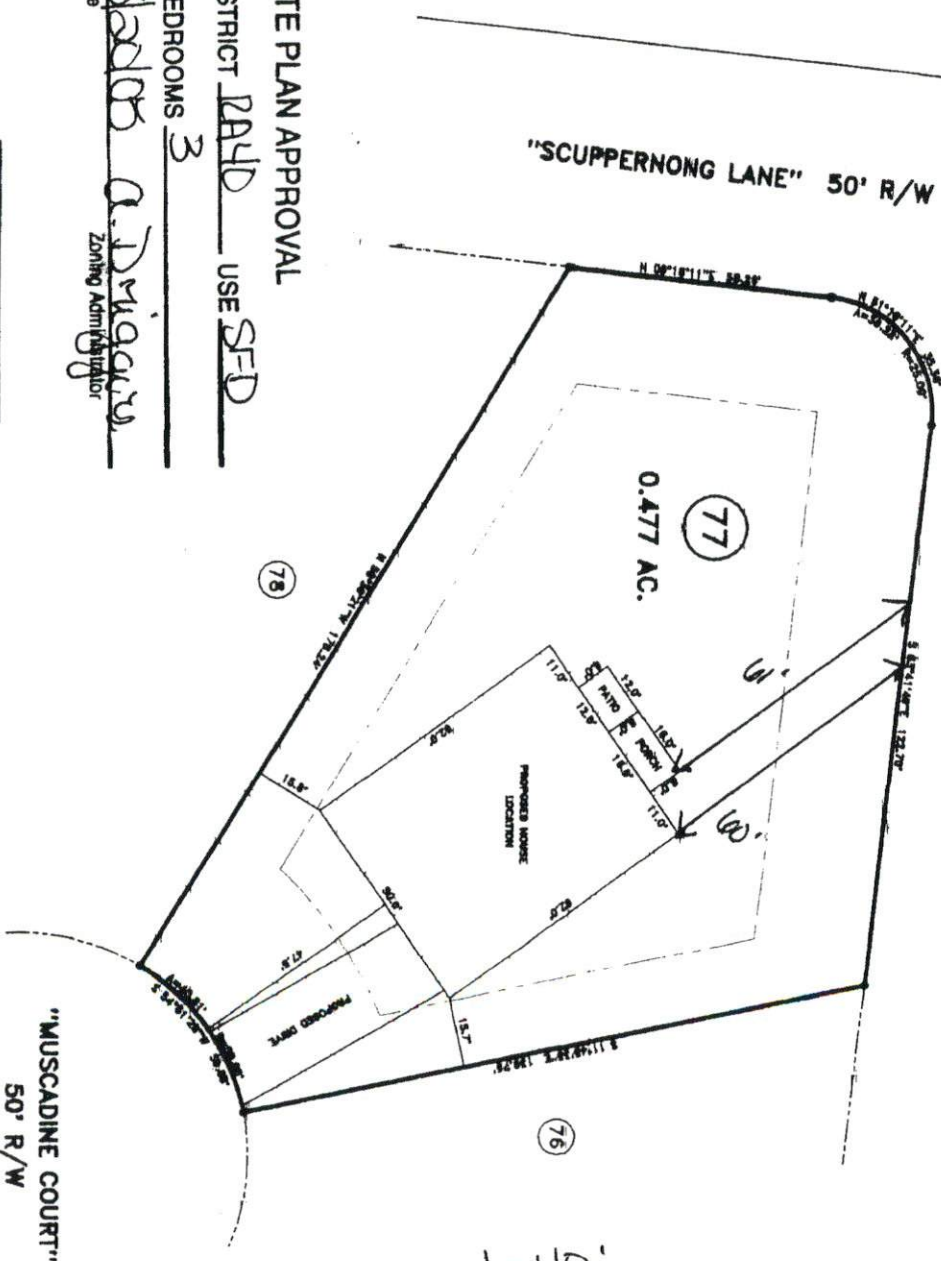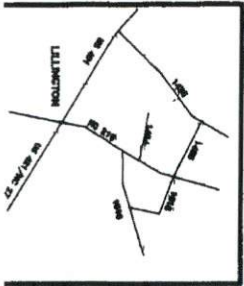

PROPOSED PLOT PLAN - LOT - 77
THE PLANTATION AT VINEYARD GREEN S/D

SURVEY FOR:

TOWNSHIP	NEALS CREEK	COUNTY	HARNETT
STATE	NORTH CAROLINA		
DATE	MAY 10, 2005		

BENNETT SURVEYS, INC.
 1862 CLARK RD., LILLINGTON, N.C. 27546
 (910) 883-0292

SCALE: 1" = 40'

DRAWN BY: RVS

HARNETT COUNTY TAX I.D.#
11-0651-0057-49
12-30-04 BY SICB

FOR REGISTRATION REGISTER OF DEEDS
 KIMBERLY S. HARGROVE
 HARNETT COUNTY, NC
 2004 DEC 30 02:49:21 PM
 BK: 2026 PG: 989-991 FEE: \$17.00
 NC REV STAMP: \$44.00
 INSTRUMENT # 2004024253

COPY

Excise Tax: \$ 44.00 Recording Time, Book & Page _____

BRIEF DESCRIPTION: Lot 77 The Plantation at Vineyard Green

Hold for: Parcel Identification No.: 110651-0057-49

Prepared By: S. Todd Adams, Attorney at Law
PREPARED WITHOUT A TITLE SEARCH OR TAX ADVICE.

NORTH CAROLINA GENERAL WARRANTY DEED

This WARRANTY DEED is made this 30th day of December, 2004 by and between **WMJ Developers, LLC (A North Carolina Limited Liability Company)**, whose address is PO Box 310; Angier, NC 27501, party(ies) of the first part, hereinafter referred to as the Grantor(s); and **ESTER FISCHER (unmarried)**, whose address is 47 Muscadine Court; Lillington, NC 27546, party(ies) of the second part, hereinafter referred to as the Grantee(s).

WITNESSETH:

WHEREAS Grantor(s) for and in consideration of the Sum of Ten Dollars (\$10.00) and other good and valuable consideration, receipt of which is hereby acknowledged, have given, granted, bargained, sold and conveyed, and by these presents do hereby give, grant, bargain, sell and convey unto the Grantee in fee simple. Said property being all of that certain piece, parcel or tract of land situated, lying and being in Neil's Creek Township, Harnett County, North Carolina, and more particularly described as follows:

BEING all of Lot 77, The Plantation at Vineyard Green, as shown in Map Number 2000, Page 549A, Harnett County Registry.

This property is conveyed subject to all of those terms and conditions set forth in those restrictive covenants recorded in Deed Book 1578, Page 485, Harnett County Registry which are by reference incorporated herein and made part of this conveyance.

Subject to all easements, rights-of-way, covenants and other restrictions as shown on the public record or as would be disclosed by an accurate survey and inspection of the land.

See Deed Book 1353, Page 420.

TO HAVE AND TO HOLD the above described lands and premises, together with all appurtenances thereunto belonging, or in anywise appertaining, unto the Grantees in fee simple, their heirs, successors and assigns forever, but subject always, however, to the limitations set out above.

AND the said Grantors, parties of the first part, covenant to and with said Grantees, parties of the second part, their heirs, successors, administrators and assigns that they are **lawfully seized in fee simple** of said lands and premises, and have **full right and power to convey** the same to the Grantees in fee simple (but subject, however, to the limitations set out above) and that said lands and premises are **free from any and all encumbrances**, except as set forth above, and that

Lot # 77 - Applic

Number: 05 5006201
FTP 05 5006203
Phone Access Code: 05 5006200

Harnett County Planning Department

PO Box 65, Lillington, NC 27546
910-893-7527

Environmental Health New Septic Systems Test
Environmental Health Code 800

- Place "property flags" in each corner of lot. All property lines must be clearly flagged approximately every 50 feet between corners.
- Place "house corner flags" at each corner of where the house/manufactured home will sit. Use additional flagging to outline driveways, garages, decks, out buildings, swimming pools, etc.
- Place flags at locations as developed on site plan by Customer Service Technician and you.
- Place Environmental Health "orange" card in location that is easily viewed from road.
- If property is thickly wooded, Environmental Health requires that you clean out the undergrowth to allow the soil evaluation to be performed. Inspectors should be able to walk freely around site. *No grading of property should be done.*
- After preparing proposed site call the voice permitting system at 910-893-7527 and give code 800 for Environmental Health confirmation.
- To hear results, call IVR again. Once approved, proceed to Central Permitting for permits

Environmental Health Existing Tank Inspections
Environmental Health Code 800

- Place Environmental Health "orange" card in location that is easily viewed from road.
- Prepare for inspection by removing soil over door as diagram indicates. Loosen trap door cover.
- After preparing trapdoor call the voice permitting system at 910-893-7527 and give code 800 for Environmental Health confirmation.
- To hear results, call IVR again. Once approved, proceed to Central Permitting for permits

Health and Sanitation Inspections
Health and Sanitation Plan Review 826

- After submitting plans fro food and lodging, call the voice permitting system at 910-893-7527 and give code 826.
- To hear results, call IVR again. Once approved, proceed to Central Permitting for permits

Fire Marshal Inspections
Fire Marshall Plan Review Code 804

- Call the voice permitting system at 910-893-7527 and give code 804 for plan review.
- Pick up Fire Marshal's letter and place on job site until work is completed.
- To hear results, call IVR again. Once approved, proceed to Central Permitting for permits

Public Utilities

- Place stake with "orange" tape/name thirty feet (30) from the center of the road at the location you wish to have water tap installed.
- Allow four to six weeks after application for water/sewer taps. Call Utilities at 893-7575 for technical assistance.

Planning
Planning Plan Review Code 806

- To hear results, call IVR again. Once the plans are approved, proceed to Central Permitting for permits

Building Inspections
Building Plan Review Code 802

- Call the voice permitting system at 910-893-7527 ~~and give code 802 for building plan review~~ *to schedule inspections*
- For new housing/set up permits ensure you meet E 911 / Addressing prior to calling for final inspection.
- To hear results, call IVR again. ~~Once the plans are approved, proceed to Central Permitting for permits~~

E911 Addressing

- Address numbers shall be mounted on the house, 3 inches high (5" for commercial).
- Numbers must be a contrasting color from house, must be clearly visible night and day at entrance of driveway if home is 100 ft or more from road, or if mailbox is on opposite side of road.
- Once you purchase permits and footing inspection has been approved call the voice permitting system at 910-893-7527 for address confirmation.
- To hear results, call IVR again.

Applicant Signature:

[Handwritten Signature] Date: *5/20/05*