

Application Date: 5/13/05

Application # 05 50012247

COUNTY OF HARNETT LAND USE APPLICATION
Central Permitting 102 E. Front Street, Lillington, NC 27546 Phone: (910) 893-4759 Fax: (910) 893-2793

APPLICANT: Woodshire Partners LLC Mailing Address: 2959 Breezewood Drive
City: Fayetteville State: NC Zip: 28303 Phone #: _____
APPLICANT: Cavness Land Development Mailing Address: 2818 Raeford Rd Ste 300
City: Fayetteville State: NC Zip: 28303 Phone #: 910-481-0503

PROPERTY LOCATION: SR #: 1125 SR Name: Lemevi Black Rd
Address: Turkey Oak Circle
Parcel: 01 05310 02 0038 14 PIN: 910 0500-94-9443.000
Zoning: RA30R Subdivision: Forest Oaks Lot #: 14 Lot Size: .36
Mod Plain: X Panel: D55 Watershed: N/A Deed Book/Page: 1899/852 Plat Book/Page: 2005-101
ADJACENT PROPERTIES TO THE PROPERTY FROM LILLINGTON: 270 Turn R on Nursery Rd. Turn L on Lemevi Black. Turn L Valley Oak. L Blue Oak L Turkey Oak lot @ Cul-de-sac.

PROPOSED USE:
 Single Family Dwelling (Size 48 x 56⁸³) # of Bedrooms 3 # Baths 2.5 Basement (w/wo bath) N/A Garage 2 car Deck 12x14
Multi-Family Dwelling No. Units _____ No. Bedrooms/Unit _____
Manufactured Home (Size _____ x _____) # of Bedrooms _____ Garage _____ Deck _____
 Number of persons per household Spec included in total size
Business Sq. Ft. Retail Space _____ Type _____
Industry Sq. Ft. _____ Type _____
Church Seating Capacity _____ Kitchen _____
Home Occupation (Size _____ x _____) # Rooms _____ Use _____
Additional Information: _____
Accessory Building (Size _____ x _____) Use _____
Addition to Existing Building (Size _____ x _____) Use _____
Other _____

Additional Information:
Water Supply: County () Well (No. dwellings _____) () Other Environmental Health Site Visit Date: _____
Waste Water Supply: New Septic Tank () Existing Septic Tank () County Sewer () Other
Erosion & Sedimentation Control Plan Required? YES NO

Does the property owner of this tract of land own land that contains a manufactured home w/in five hundred feet (500') of tract listed above? YES NO

Structures on this tract of land: Single family dwellings 1 Manufactured homes _____ Other (specify) _____

Required Residential Property Line Setbacks:	Proposed	Minimum	Actual
Front		35	39
Rear		25	82' 60'
Side		10	13.8 - 13.5
Corner		20	-
Nearest Building		10	35 N/A

If permits are granted I agree to conform to all ordinances and the laws of the State of North Carolina regulating such work and the specifications or plans submitted. I hereby swear that the foregoing statements are accurate and correct to the best of my knowledge.

Signature of Owner or Owner's Agent: [Signature] Date: 5/13/05


This application expires 6 months from the initial date if no permits have been issued

A RECORDED SURVEY PLAT AND RECORDED DEED ARE REQUIRED WHEN APPLYING FOR A LAND USE APPLICATION

4/16/05

SR 1125

N 79°06'31"W 158.98'

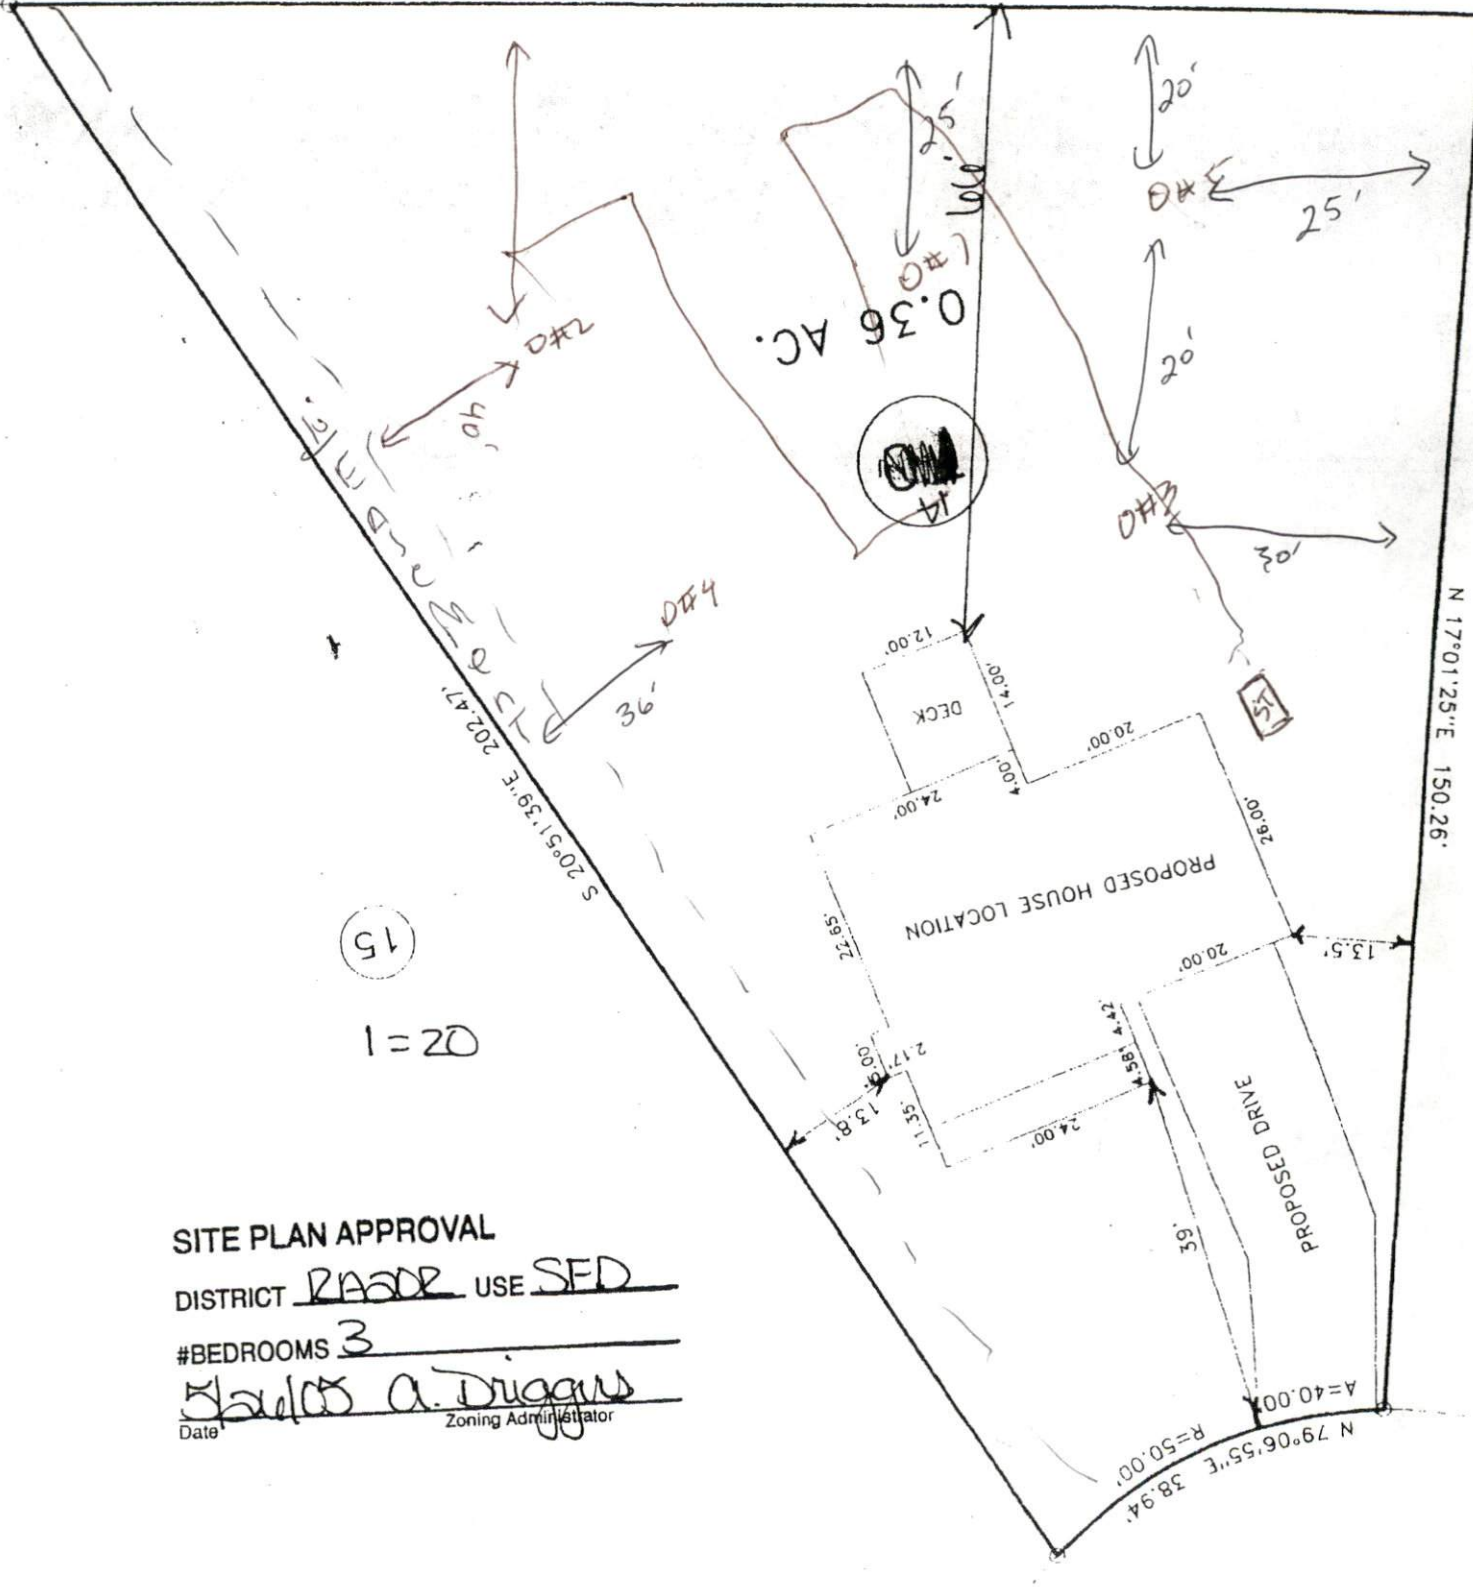

15

1=20

SITE PLAN APPROVAL


DISTRICT RA20R USE SFD

#BEDROOMS 3

Date Paul A. Driggs
Zoning Administrator

KEY OAK CIRCLE
50' R/W

KEY OAK CIRCLE"
50' R/W

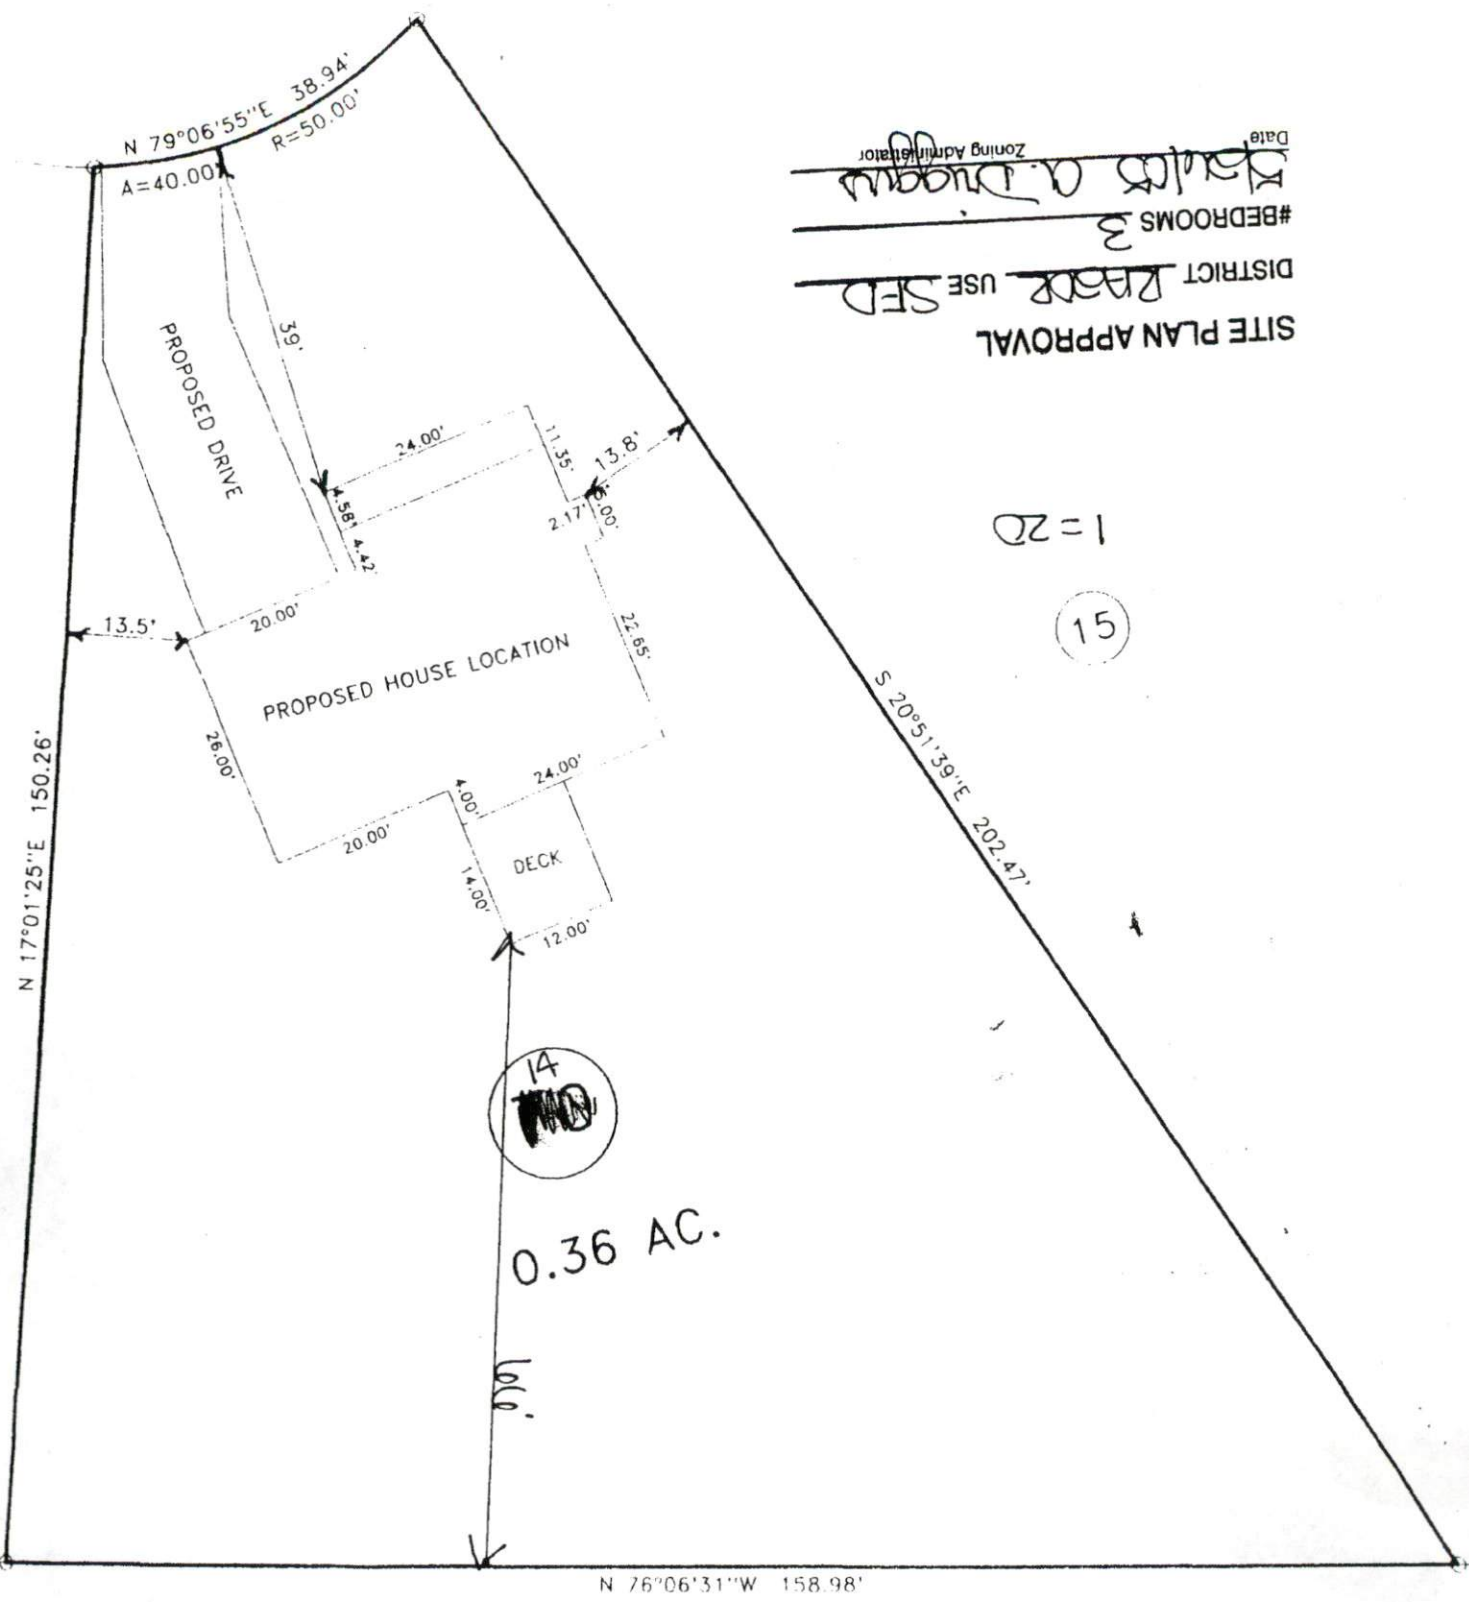

Date _____
Zoning Administrator Charles A. Douglas
#BEDROOMS 3
DISTRICT R-200 USE SFD
SITE PLAN APPROVAL

1 = 20

15

14

0.36 AC.



FOR REGISTRATION REGISTER OF DEEDS
 KIMBLEY S. HIGGINS
 WARETT COUNTY, NC
 2004 MAR 09 11:06:04 AM
 BK: 1899 PG: 852-857 FEE \$26.00
 NC REV STAMP: \$1,160.00
 INSTRUMENT # 2004004049

WARRETT COUNTY TAX
 B/P 01-0531-0028-01
 379-014 BY H.L.W.

NORTH CAROLINA GENERAL WARRANTY DEED

Excise Tax: \$1,160.00

Parcel Identifier No. portion of 010531-0028-01 Verified by _____ County on the _____ day of _____, 20____
 By: _____

Mail/Box to: _____
 This instrument was prepared by L. Holden Reaves, Esq., Reaves & Reaves, Attorneys at Law, Fayetteville, NC

Brief description for the Index: 127 +/- Acres, Nursery Rd and Lemuel Black Rd

THIS DEED made this 5 day of March, 2004, by and between

GRANTOR	GRANTEE
<p>CEBCO CONSTRUCTION, INC., a North Carolina corporation <u>To Box 591</u> <u>Martins, NC 27552</u></p>	<p>WOODSHIRE PARTNERS, LLC, a North Carolina limited liability company <u>2929 Breezewood Avenue, Suite 200</u> <u>Fayetteville, NC 28303</u></p>


Enter in appropriate block for each party: name, address, and, if appropriate, character of entity, e.g. corporation or partnership.

The designation Grantor and Grantee as used herein shall include said parties, their heirs, successors, and assigns, and shall include singular, plural, masculine, feminine or neuter as required by context.

WITNESSETH, that the Grantor, for a valuable consideration paid by the Grantee, the receipt of which is hereby acknowledged, has and by these presents does grant, bargain, sell and convey unto the Grantee in fee simple, all that certain lot or parcel of land situated in the City of _____, Anderson Creek Township, Harnett County, North Carolina and more particularly described as follows:

See Exhibit A attached hereto and incorporated herein by reference.

The property hereinabove described was acquired by Grantor by instrument recorded in Book 1103, Page 22 and Book 1490, Page 170.

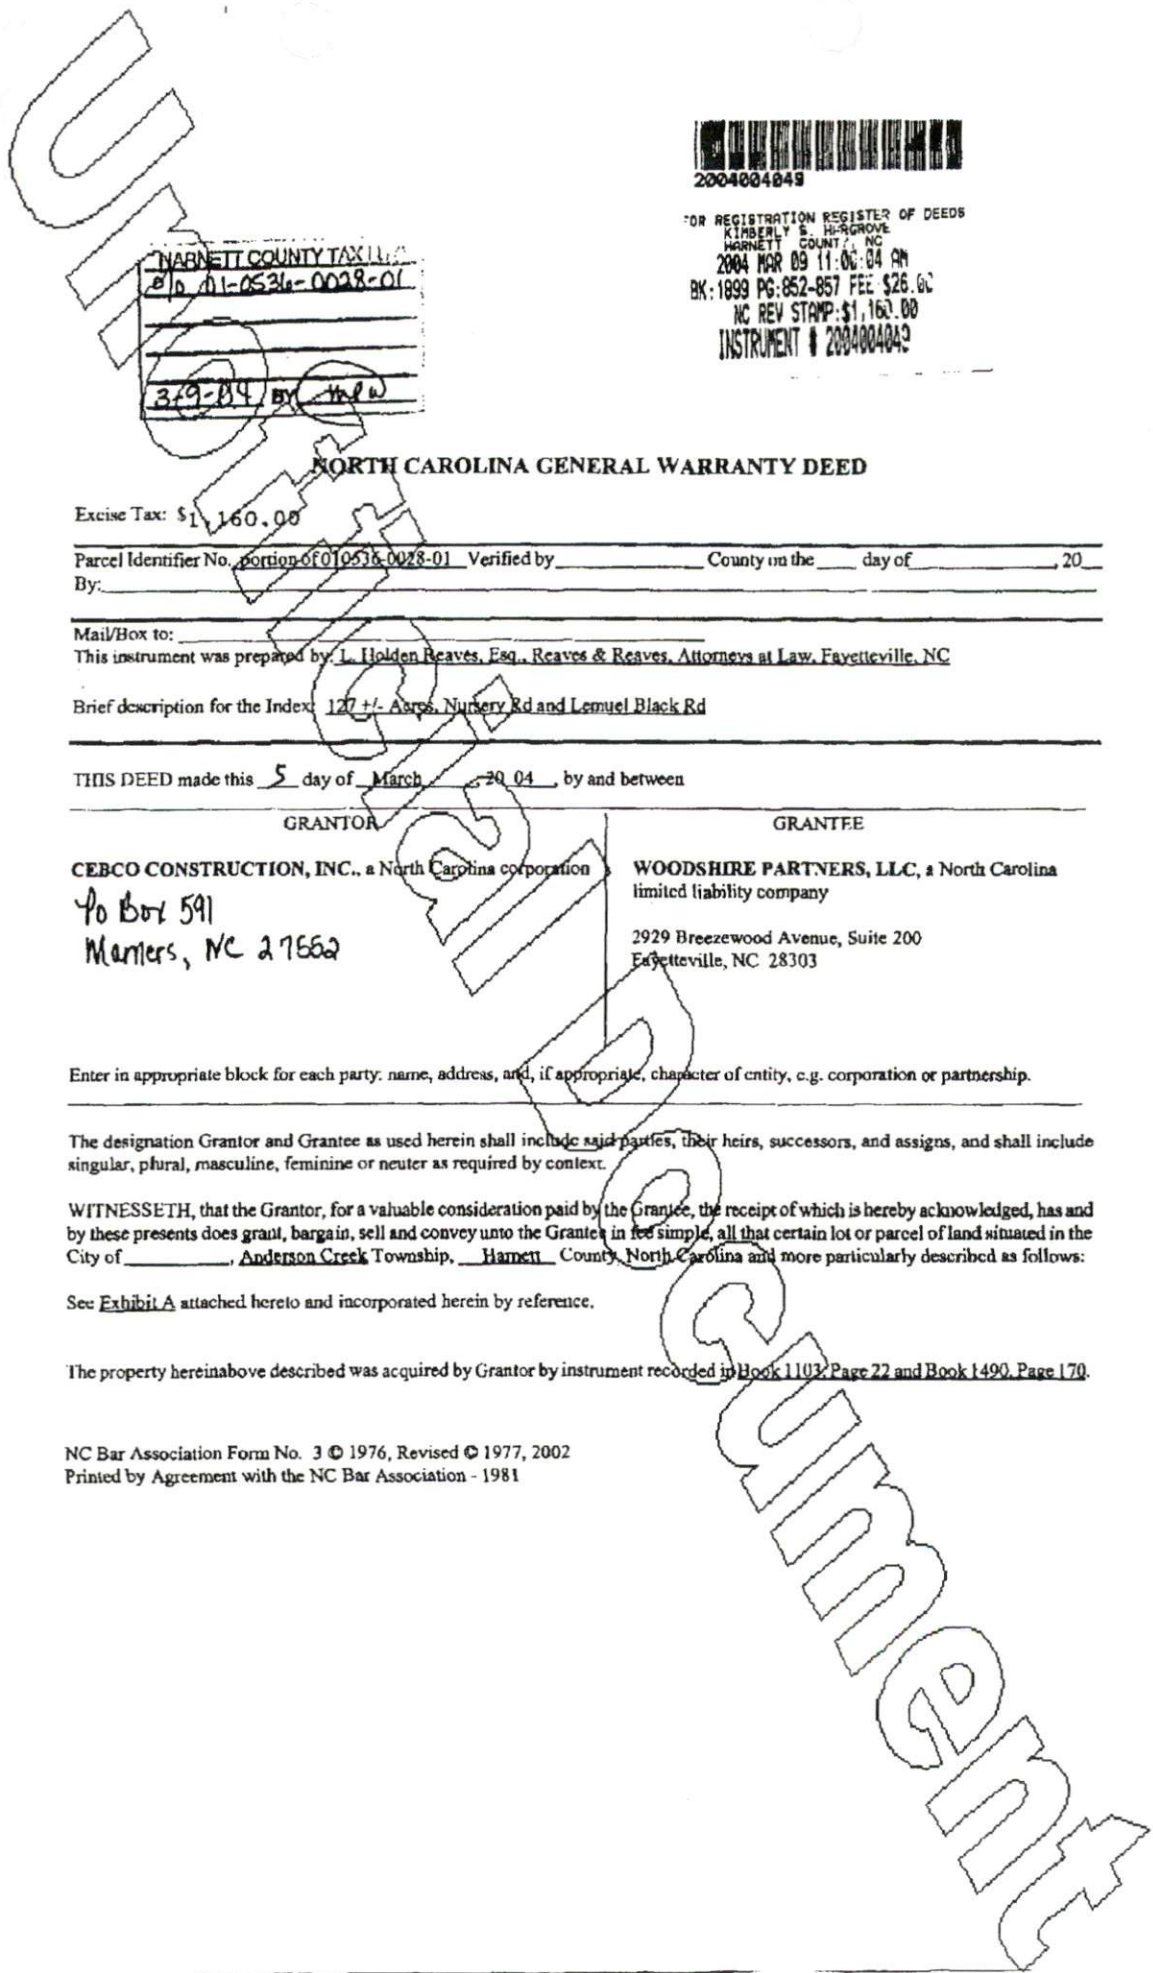

Appl n Number: _____

Phone Access Code: _____

Harnett County Planning Department

PO Box 65, Lillington, NC 27546
910-893-7527

Environmental Health New Septic Systems Test

Environmental Health Code 800

- Place "property flags" in each corner of lot. All property lines must be clearly flagged approximately every 50 feet between corners.
- Place "house corner flags" at each corner of where the house/manufactured home will sit. Use additional flagging to outline driveways, garages, decks, out buildings, swimming pools, etc.
- Place flags at locations as developed on site plan by Customer Service Technician and you.
- Place Environmental Health "orange" card in location that is easily viewed from road.
- If property is thickly wooded, Environmental Health requires that you clean out the undergrowth to allow the soil evaluation to be performed. Inspectors should be able to walk freely around site. *No grading of property should be done.*
- After preparing proposed site call the voice permitting system at 910-893-7527 and give code 800 for Environmental Health confirmation.
- To hear results, call IVR again. Once approved, proceed to Central Permitting for permits

Environmental Health Existing Tank Inspections

Environmental Health Code 800

- Place Environmental Health "orange" card in location that is easily viewed from road.
- Prepare for inspection by removing soil over door as diagram indicates. Loosen trap door cover.
- After preparing trapdoor call the voice permitting system at 910-893-7527 and give code 800 for Environmental Health confirmation.
- To hear results, call IVR again. Once approved, proceed to Central Permitting for permits

Health and Sanitation Inspections

Health and Sanitation Plan Review 826

- After submitting plans fro food and lodging, call the voice permitting system at 910-893-7527 and give code 826.
- To hear results, call IVR again. Once approved, proceed to Central Permitting for permits

Fire Marshal Inspections

Fire Marshall Plan Review Code 804

- Call the voice permitting system at 910-893-7527 and give code 804 for plan review.
- Pick up Fire Marshal's letter and place on job site until work is completed.
- To hear results, call IVR again. Once approved, proceed to Central Permitting for permits

Public Utilities

- Place stake with "orange" tape/name thirty feet (30) from the center of the road at the location you wish to have water tap installed.
- Allow four to six weeks after application for water/sewer taps. Call Utilities at 893-7575 for technical assistance.

Planning

Planning Plan Review Code 806

- To hear results, call IVR again. Once the plans are approved, proceed to Central Permitting for permits

Building Inspections

~~Building Plan Review Code 802~~

- Call the voice permitting system at 910-893-7527 ~~and give code 802 for building plan review.~~ *to schedule inspections*
- For new housing/set up permits ensure you meet E 911 / Addressing prior to calling for final inspection.
- To hear results, call IVR again. ~~Once the plans are approved, proceed to Central Permitting for permits~~

E911 Addressing

- Address numbers shall be mounted on the house, 3 inches high (5" for commercial).
- Numbers must be a contrasting color from house, must be clearly visible night and day at entrance of driveway if home is 100 ft or more from road, or if mailbox is on opposite side of road.
- Once you purchase permits and footing inspection has been approved call the voice permitting system at 910-893-7527 for address confirmation.
- To hear results, call IVR again.

Applicant Signature: _____

Date: 4/5/05