Divis	artment of Enviror site Wastewat	nmental H er Section	SOIL/SITE E	tural Resources  VALUATION EWATER SYSTEM	Shee Property IE Lot # File # Code	D: #: #:				,
	Owner:				Applican	t:				
	Address:					Date	Evaluated:			
Prop	osed Facility:			Design Flow (.1949):		Pro	perty Size:			*
Loca	ation of Site:					Property	Recorded:			
Wat	er Supply:		[ ] Public	[ ] Individual	[ ] Well		[] Spring		[] Other	
Eva	luation Method	d:	[ ] Auger Borin	g	[ ] Pit		[ ] Cut			
Тур	e of Wastewa	ter:	[] Sewage		[ ] Industrial Process		[ ] Mixed			
PROF-LE#	.1940 Landscape Position/ Slope%	Horizon Depth (IN.)		MORPHOLOGY ,1941 ,1941 Consistence Mineralogy	PROF 1942 Soil Wetness/ Color	OTHER ILE FACTO  .1943 Soil Depth (IN.)	RS .1956 Sapro' Class	.1944 Restr Horiz	Profile Class & LTAR	
#		0-10	3L	FR GN NOW?	2 September 20101	Depth (iiv.)	Olubb	a in totile	G LIVIN	
1	L 2%	10-48	-	Fra 1334 85 S	34" 106				-3	
	*				5.2					
-		0-6	\$	BREN NSWP	10.7				- 3	
2		6.48	SCL 2	sepper 15m 55,P	32 5.2					
1	1	1			1			1		

Description	Initial System	Repair Şystem
Available Space (.1945)		/
System Type(s)	26%	MIR
Site LTAR	. 3	• 3

52

sec

SL

0-3

8-48

0-8

3

PR GN NOWP

48 fpm 13Ac 85. 9

FRON NOW

Other Factors (.1946):

Site Classification (.1948):

Evaluated By:

3

Others Present:

FILE	#	

COMMENTS:	

LANDSCAPE POSITIONS	GROUP	TEXTURES	.1955 LTAR	CONSISTENCE MOIST	WET
R-RIDGE S-SHOULDER SLOPE L-LINEAR SLOPE	I	S-SAND LS-LOAMY SAND	1.2 - 0.8	VFR-VERY FRIABLE	NS-NON-STICKY
FS-FOOT SLOPE N-NOSE SLOPE H-HEAD SLOPE	11	SL-SANDY LOAM L-LOAM	0.8 - 0.6	FR-FRIABLE FI-FIRM VFI-VERY FIRM	SS-SLIGHTLY STICKY S-STICKY VS-VERY STICKY
CC-CONCLAVE SLOPE CV-CONVEX SLOPE T-TERRACE FP-FLOOD PLAN	ш	SI-SILT- SIL-SILT LOAM CL-CLAY LOAM SCL-SANDY CLAY LOAM SICL-SILTY CLAY LOAM	0.6 – 0.3	EFI-EXTREMELY FIRM	NP-NON-PLASTIC SP-SLIGHTLY STICKY P-PLASTIC VP-VERY PLASTIC
	IV	SIC-SILTY CLAY C-CLAY	0.4 - 0.1		


STRUCTURE
SG-SINGLE GRAIN
M-MASSIVE
CR-CRUMB
GR-GRANULAR
SBK-SUBANGULAR BLOCKY
ABK-ANGULAR BLOCKY
PL-PLATY
PR-PRISMATIC

MINERALOGY SLIGHTLY EXPANSIVE

SC-SANDY CLAY

EXPANSIVE

										Δį				ensio		10,000				1						
	V.								- 6					1								 -		-		
				-					-				-	-								 				
-				 				-				<u></u>														
														-				-				 -	-		$\vdash$	
								-	-		-		-					_	al.			 				
-	-						1											-				 			$\vdash$	
<del> </del>				 			-	-				-														
-				 											-	ing				53						
							ļ								-	-	S)		30			 		-		
						-		-	-	à					-					0		 				
<del> </del>				 		ļ					ļ										,					
								i i																		
											1				-			-	-	-	-	 -		-		
-			-	 	-						ļ		-	-	-						-					
ļ		-		 		1												-								
																		T-				 		-		
1		**		 		-	1	-	<del>                                     </del>		ļ	<u> </u>	<u> </u>	-							**********	 			-	********
-	(Page 18 Spring)			 	et more webs	-		ļ			-				-											
						and of the same					1						10									
	7 1						1	1	<b>†</b>	T							November.				ļ	 ļ	*****			Participation of the Control of the
-			a Principal and	 	or employ							** ***	-	ļ		5-10-10-10-1										

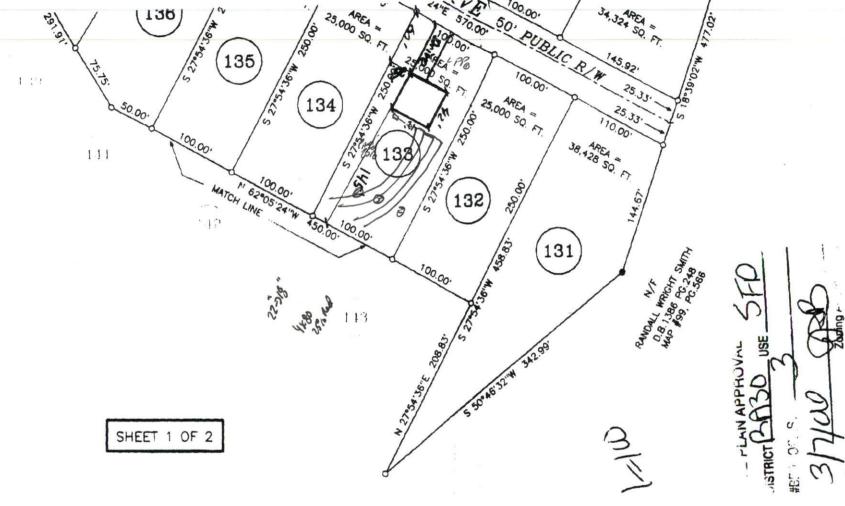

Y A PRIVATE THAT LOT(S) ON THAT FINAL HE APPROPRIATE R SPECIFIC USE FORCE AT THE T REPRESENT

P.5

200 300

## DEPARTMENT OF TRANSPORTATION DIVISION OF HIGHWAYS

PROPOSED SUBDIVISION ROAD CONSTRUCTION STANDARDS CERTIFICATION

APPROVED 2 R STONE
DISTRICT ENGINEER WEX

ONLY NORTH CAROLINA DEPARTMENT OF TRANSPORTATION APPROVED STRUCTURES ARE TO BE CONSTRUCTED ON PUBLIC RIGHT OF WAY. OWNER: LEON ANDERSON CONSTRUCTION 6212 RAWLS CHURCH RD. FUQUAY-VARINA, N.C. 27526

## SURVEY OF:

## VICTORIA HILLS SUBDIVISION

PHASE 6

HECTOR'S CREEK TOWNSHIP, HARNETT COUNTY, NORTH CAROLINA SCALE 1" = 100' FEBRUARY 15, 2005

MAULDIN - WATKINS SURVEYING, P.A. P.O. BOX 444 / 1301 W. BROAD ST. FUQUAY VARINA, NORTH CAROLINA 27526 (919) 552-9326

JOB #2263 CF:2263 PF:PH6RM