

Initial Application Date: 6/21/06

Application # 02-50015191

COUNTY OF HARNETT LAND USE APPLICATION

Central Permitting

102 E. Front Street, Lillington, NC 27546

Phone: (910) 893-4759

Fax: (910) 893-2793

LANDOWNER: RBC Homes, Inc Mailing Address: PO Box 755
City: Fayetteville State: NC Zip: 28302 Phone #: 910-423-3556

APPLICANT: RBC Homes, Inc Mailing Address: PO Box 755
City: Fayetteville State: NC Zip: 28302 Phone #: 910-423-3555

PROPERTY LOCATION: SR #: 96 SR Name: Williams Creek Dr.
Parcel: 12 056 0010 10 PIN: 0565-49-2747 000
Zoning: none Subdivision: Byrds Pond Estates Lot #: 9 Lot Size: .80
Flood Plain: X Panel: DMS Watershed: N/A Deed Book/Page: 211/517 Plat Book/Page: 200/101

DIRECTIONS TO THE PROPERTY FROM LILLINGTON: TAKE HWY 101 TOWARDS FAYETTEVILLE. TIR
BYRD POND RD. .09 MILE TIL INTO BYRD POND ESTATES.

PROPOSED USE:
 Sg. Family Dwelling (Size 34 x 39) # of Bedrooms 3 # Baths 2 Basement (w/wo bath) N/A Garage included Deck patio
 Multi-Family Dwelling No. Units _____ No. Bedrooms/Unit _____
 Manufactured Home (Size _____ x _____) # of Bedrooms _____ Garage _____ Deck _____

Comments:
 Number of persons per household 3 per
 Business Sq. Ft. Retail Space _____ Type _____
 Industry Sq. Ft. _____ Type _____
 Home Occupation (Size _____ x _____) # Rooms _____ Use _____
 Accessory Building (Size _____ x _____) Use _____
 Addition to Existing Building (Size _____ x _____) Use _____
 Other _____

Water Supply: County Well (No. dwellings _____) Other _____
Sewage Supply: New Septic Tank Existing Septic Tank County Sewer Other _____
Erosion & Sedimentation Control Plan Required? YES NO
Structures on this tract of land: Single family dwellings 1 Manufactured homes _____ Other (specify) _____
Property owner of this tract of land own land that contains a manufactured home w/in five hundred feet (500') of tract listed above? YES NO

| Required Property Line Setbacks: | Minimum | Actual | Minimum | Actual |
|----------------------------------|------------|------------|---------|------------|
| Front | <u>35'</u> | <u>36'</u> | Rear | <u>25'</u> |
| Side | <u>10'</u> | <u>20'</u> | Corner | <u>20'</u> |
| Nearest Building | <u>10'</u> | <u>N/A</u> | | <u>N/A</u> |

If permits are granted I agree to conform to all ordinances and the laws of the State of North Carolina regulating such work and the specifications or plans submitted. I hereby swear that the foregoing statements are accurate and correct to the best of my knowledge.

Signature of Owner or Owner's Agent: _____ Date: 6/19/06

This application expires 6 months from the date issued if no permits have been issued


A RECORDED SURVEY PLAT AND RECORDED DEED ARE REQUIRED WHEN APPLYING FOR A LAND USE PERMIT

CURVE TABLE

| CURVE | RADIUS | LENGTH | CH. BEARING | CHORD |
|-------|---------|---------|-------------|---------|
| C1 | 450.00' | 133.84' | S42°25'11"E | 133.34' |


LEGEND

R/W-RIGHT OF WAY
 PB-PLAT BOOK
 DB-DEED BOOK
 PG-PAGE
 PROP-PROPOSED
 SF-SQUARE FEET
 AC-ACRE(S)
 CONC-CONCRETE

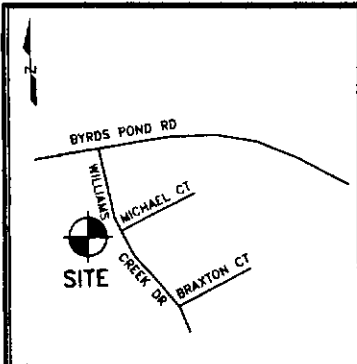


Vicinity Map
(Not to Scale)

JONATHAN L. JUDD
 MAP #2000-57 0565-39-8466
 DB 1416, PG 278

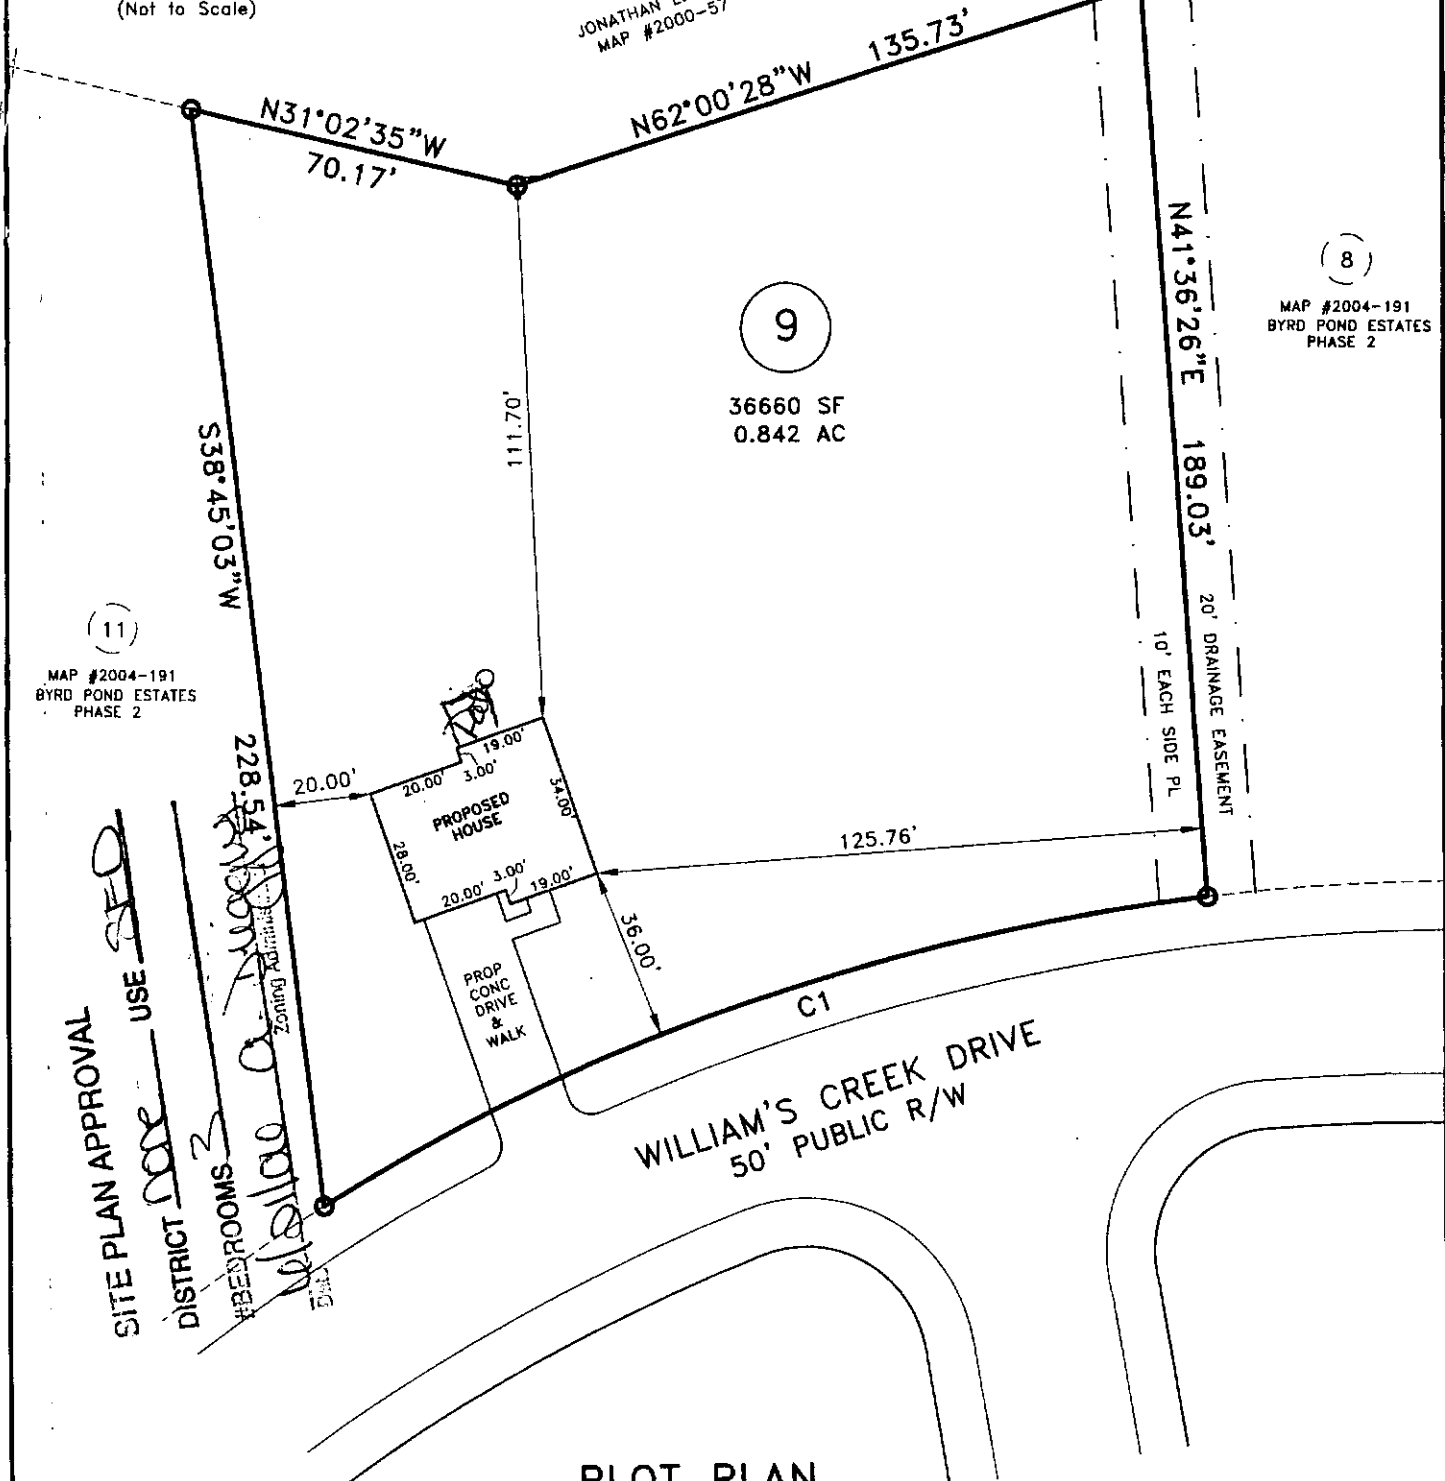


PLOT PLAN

PROPERTY OF: RBC HOMES, INC.
 ADDRESS: WILLIAMS CREEK DRIVE
 CITY: NEAR LINDEN, NC
 COUNTY: HARNETT
 TAX PIN: 0565-49-2747.000

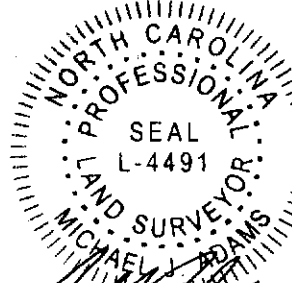

TOWNSHIP: STEWARTS CREEK
 DATE: JUNE 14, 2006
 SCALE: 1" = 40'
 REFERENCE: LOT 9-BYRD POND
 ESTATES-PHASE 2
 MAP # 2004-191

MINIMUM SETBACKS:
 35'-FRONT
 10'-SIDE
 25'-REAR
 CORNER LOT SIDE: 20'

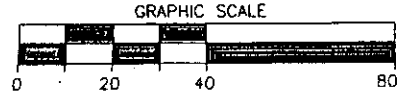

MICHAEL J. ADAMS
 PLS L-4491
 CFS NC-075
 M.A.P.S. SURVEYING, INC.
 203 N. VIRGINIA AVE
 FAYETTEVILLE, NC 28305
 PHN: (910)484-6432
 FAX: (910)778-9440

- NOTES:
- 1) THIS MAP IS NOT A CERTIFIED SURVEY AND NO RELIANCE MAY BE PLACED IN IT'S ACCURACY.
 - 2) THIS MAP IS FOR PERMITTING PURPOSES ONLY.
 - 3) THIS MAP CAN NOT BE USED FOR RECORDATION OR ATTACHED TO A DEED TO BE RECORDED.
 - 4) THIS MAP IS NOT DRAWN IN ACCORDANCE WITH GS 47-30.
 - 5) SUBJECT PROPERTY IS NOT IN A SPECIAL FLOOD HAZARD AREA PER FEMA FIRM 37085C0175 DATED APRIL 16, 1990.

Harnett County Planning Department

PO Box 65, Lillington, NC 27546
910-893-7527

Environmental Health New Septic Systems Test
Environmental Health Code 800

- Place "property flags" in each corner of lot. All property lines must be clearly flagged.
- Place "house corner flags" at each corner of where the house/manufactured home will sit. Use additional flagging to outline driveways, garages, decks, out buildings, swimming pools, etc.
- Place flags at locations as developed on site plan by Customer Service Technician and you.
- Place Environmental Health "orange" card in location that is easily viewed from road.
- *No grading of property should be done.* Undergrowth should be cleaned out to allow soil evaluation to be performed. Inspectors should be able to walk freely.
- After preparing proposed site call the voice permitting system at 910-893-7527 and give code **800** for Environmental Health confirmation. Please note confirmation number given at end of recording for proof of request.
- To hear results, call IVR in approx. 7-10 working days. Once approved, proceed to Central Permitting for permits.

Environmental Health Existing Tank Inspections
Environmental Health Code 800

- Place Environmental Health "orange" card in location that is easily viewed from road.
- Prepare for inspection by removing soil over door as diagram indicates. Loosen trap door cover. (Unless inspection is for a septic tank in a mobile home park)
- After preparing trapdoor call the voice permitting system at 910-893-7527 and give code **800** for Environmental Health confirmation. Please note confirmation number given at end of recording for proof of request.
- To hear results, call IVR in approx. 7-10 working days. Once approved, proceed to Central Permitting for permits.

Health and Sanitation Inspections
Health and Sanitation Plan Review 826

- After submitting plans for food and lodging, call the voice permitting system at 910-893-7527 and give code **826** for Health and Sanitation confirmation. Please note confirmation number given at end of recording for proof of request.
- To hear results, call IVR in approx. 7-10 working days. Once approved, proceed to Central Permitting for permits.

Fire Marshal Inspections
Fire Marshall Plan Review Code 804

- Call the voice permitting system at 910-893-7527 and give code **804** for plan review. Please note confirmation number given at end of recording for proof of request.
- To hear results, call IVR in approx 7-10 working days. Once approved, proceed to Central Permitting for permits.
- Pick up Fire Marshal's letter and place on job site until work is completed.

Public Utilities

- Place stake with "orange" tape/name thirty feet (30) from the center of the road at the location you wish to have water tap installed.
- Allow four to six weeks after application for water/sewer taps. Call Utilities at 893-7575 for technical assistance.


Building Inspections

- Call the voice permitting system at 910-893-7527 to schedule inspections. Please note confirmation number given at end of recording for proof of request.
- For new housing/set up permits must meet E 911 / Addressing guidelines prior to calling for final inspection.
- To hear results of inspections, call IVR after scheduled inspection is done.

E911 Addressing
Addressing Confirmation Code 814

- Address numbers shall be mounted on the house, 3 inches high (5" for commercial).
- Numbers must be a contrasting color from house, must be clearly visible night and day at entrance of driveway if home is 100 ft or more from road, or if mailbox is on opposite side of road.
- Once you purchase permits and footing inspection has been approved call the voice permitting system at 910-893-7527 and give code **814** for address confirmation. This must be called in even if you have contacted E911 for verbal confirmation.

Customers can view all inspection results online at www.harnett.org.

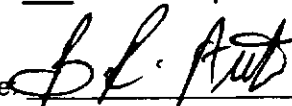Applicant Signature:  Date: 6-21-06



FOR REGISTRATION REGISTER OF DEEDS
 KIMBERLY E. HARGROVE
 HARNETT COUNTY, NC
 2005 AUG 01 09:14:29 AM
 BK: 2111 PG: 517-519 FEE: \$17.00
 NC REV STAMP: \$517.00
 INSTRUMENT # 2005013483

HARNETT COUNTY TAX ID#

12 0555 0406
 V.P. LLC.
 S/W/D/S BY KHD

NORTH CAROLINA GENERAL WARRANTY DEED

Excise Tax: \$17.00

Parcel Identification No.: 120555 0006 (Parent) Verified by Harnett County

By:

Mail/Box to: The Real Estate Law Firm, PO Drawer 53515, Fayetteville, NC 28305

Reference Number: 05768-088

This instrument was prepared by: The Real Estate Law Firm

Brief description for the Index: Lots 2,3,7,8,9,21,22,23,24,25, and 26 Byrd Pond Estates

THIS DEED made this 28th day of July, 2005 by and between

| GRANTOR | GRANTEE |
|--------------------------------------------------------------------------------------------------|----------------------------------------------------------------------|
| Southeast Development of Cumberland, LLC, 428 Swan Island Court Fayetteville, NC 28311 | RBC Homes, Inc., 1018 Hope Mills Road Hope Mills, NC 28348 |

The designation Grantor and Grantee as used herein shall include said parties, their heirs, successors, and assigns, and shall include singular, plural, masculine, feminine or neuter as required by context.

WITNESSETH, that the Grantor, for a valuable consideration paid by the Grantee, the receipt of which is hereby acknowledged, has and by these presents does grant, bargain, sell and convey unto the Grantee in fee simple, all that certain lot or parcel of land situated in or near City of Bunnlevel, Township, Harnett County, NC and more particularly described as follows:

Being all of Lots 2 and 3 in a Subdivision known as Byrd Pond Estates, Phase One, and the same being duly recorded in Map 2000, Page 16 in the Harnett County Registry, North Carolina.

Being all of Lots 7,8,9,21,22,23,24,25, and 26 in a Subdivision known as Byrd Pond Estates, Phase Two and the same being duly recorded in Plat Book 2004, Page 229 in the Harnett County Registry, North Carolina.

Property Address: Lots 2,3,7,8,9,21,22,23,24,25,26 Byrd Pond Estates, Bunnlevel, NC
 Parcel Identification No.: 120555 0006 (Parent), 120565 0017 0351940 (Lot 2), 120565 0017 0451941 (Lot 3), 120565 0016 1460082 (Lot 7), 120565 0016 1560083 (Lot 8), 120565 0016 1660084 (Lot 9), 120565 0016 1760085 (Lot 21), 120565 0012 2860096 (Lot 22), 120565 0016 2960097 (Lot 23), 120565 0016 3060098 (Lot 24), 120565 0016 3160099 (Lot 25), 120565 0016 3260160 (Lot 26)

The property hereinabove described was acquired by Grantor by instrument recorded in Book 2111, Page 514.

A map showing the above describe proberly was acquired by Grantor by instrument recorded in Plat Book 2004, Page 229.