

Initial Application Date: 02 NOV 06

Application # 0105001653

owner: Even Par Dev, LLC

COUNTY OF HARNETT LAND USE APPLICATION

Central Permitting 108 E. Front Street, Lillington, NC 27546 Phone: (910) 893-7525 Fax: (910) 893-2793 www.harnett.org

APP: LANDOWNER

LANDOWNER: THE QUEST DEV. CO. INC. Mailing Address: P.O. Box 2121

City: DUNN State: NC Zip: 28335 Home #: 910-567-4686 Contact #: 910-237-1853

APPLICANT: HOWELL EDWARDS Mailing Address: SAME

City: _____ State: _____ Zip: _____ Home #: _____ Contact #: _____

*Please fill out applicant information if different than landowner

PROPERTY LOCATION: State Road #: 1125 State Road Name: LEMUEL BLACK RD

Parcel: 01 0525 01 0095 07 PIN: 90

Zoning: RA-20R Subdivision: GATE WEST Lot #: 7 Lot Size: 47317(6F)

Flood Plain: X Panel: 155 Watershed: NA Deed Book/Page: OTD Plat Book/Page: 2006/878

SPECIFIC DIRECTIONS TO THE PROPERTY FROM LILLINGTON: Hwy 210 WEST TO ANDERSON CREEK RD. TK. THEN RIGHT ON LEMUEL BLACK RD. SUB DIVISION ON RIGHT

PROPOSED USE:

Circle:

- SFD (Size 63 x 60) # Bedrooms 3 # Baths 2 1/2 Basement (w/wo bath) No Garage YES Deck No Crawl Space / Slab
- Modular: On frame Off frame (Size x) # Bedrooms # Baths Garage (site built?) Deck (site built?)
- Multi-Family Dwelling No. Units No. Bedrooms/Unit
- Manufactured Home: SW DW TW (Size x) # Bedrooms Garage (site built?) Deck (site built?)
- Business Sq. Ft. Retail Space Type # Employees: Hours of Operation:
- Industry Sq. Ft. Type # Employees: Hours of Operation:
- Church Seating Capacity # Bathrooms Kitchen
- Home Occupation (Size x) # Rooms Use Hours of Operation:
- Accessory/Other (Size x) Use
- Addition to Existing Building (Size x) Use Closets in addition ()yes ()no

Water Supply: County Well (No. dwellings) Other

Sewage Supply: New Septic Tank (Need to fill out New Tank Checklist) Existing Septic Tank County Sewer Other

Property owner of this tract of land own land that contains a manufactured home w/in five hundred feet (500') of tract listed above? YES NO

Structures on this tract of land: Single family dwellings 1 proposed Manufactured Homes Other (specify)

Required Residential Property Line Setbacks: Comments:

Front	Minimum	<u>35</u>	Actual	<u>65</u>
Rear		<u>25</u>		<u>234</u>
Side		<u>10</u>		<u>37</u>
Corner/Sidestreet		<u>20</u>		<u>X</u>
Nearest Building on same lot		<u>10</u>		<u>X</u>

If permits are granted I agree to conform to all ordinances and the laws of the State of North Carolina regulating such work and the specifications of plans submitted. I hereby state that the foregoing statements are accurate and correct to the best of my knowledge. This permit is subject to revocation if false information is provided on this form.

Signature of Owner or Owner's Agent [Signature]

Date 02 NOV 03

This application expires 6 months from the initial date if no permits have been issued

A RECORDED SURVEY MAP, RECORDED DEED (OR OFFER TO PURCHASE) AND PLAT ARE REQUIRED WHEN APPLYING FOR LAND USE APPLICATION

Please use Blue or Black Ink ONLY

... use as noted, and
 the subdivision
 County.

[Signature]

OWNER / agent

SITE PLAN APPROVAL


DISTRICT BA20/R USE SFD

#BEDROOMS 3


Date 11/13/06

[Signature]
 Zoning Administrator

ALL BE
 SHALL THEIR
 SYSTEMS.

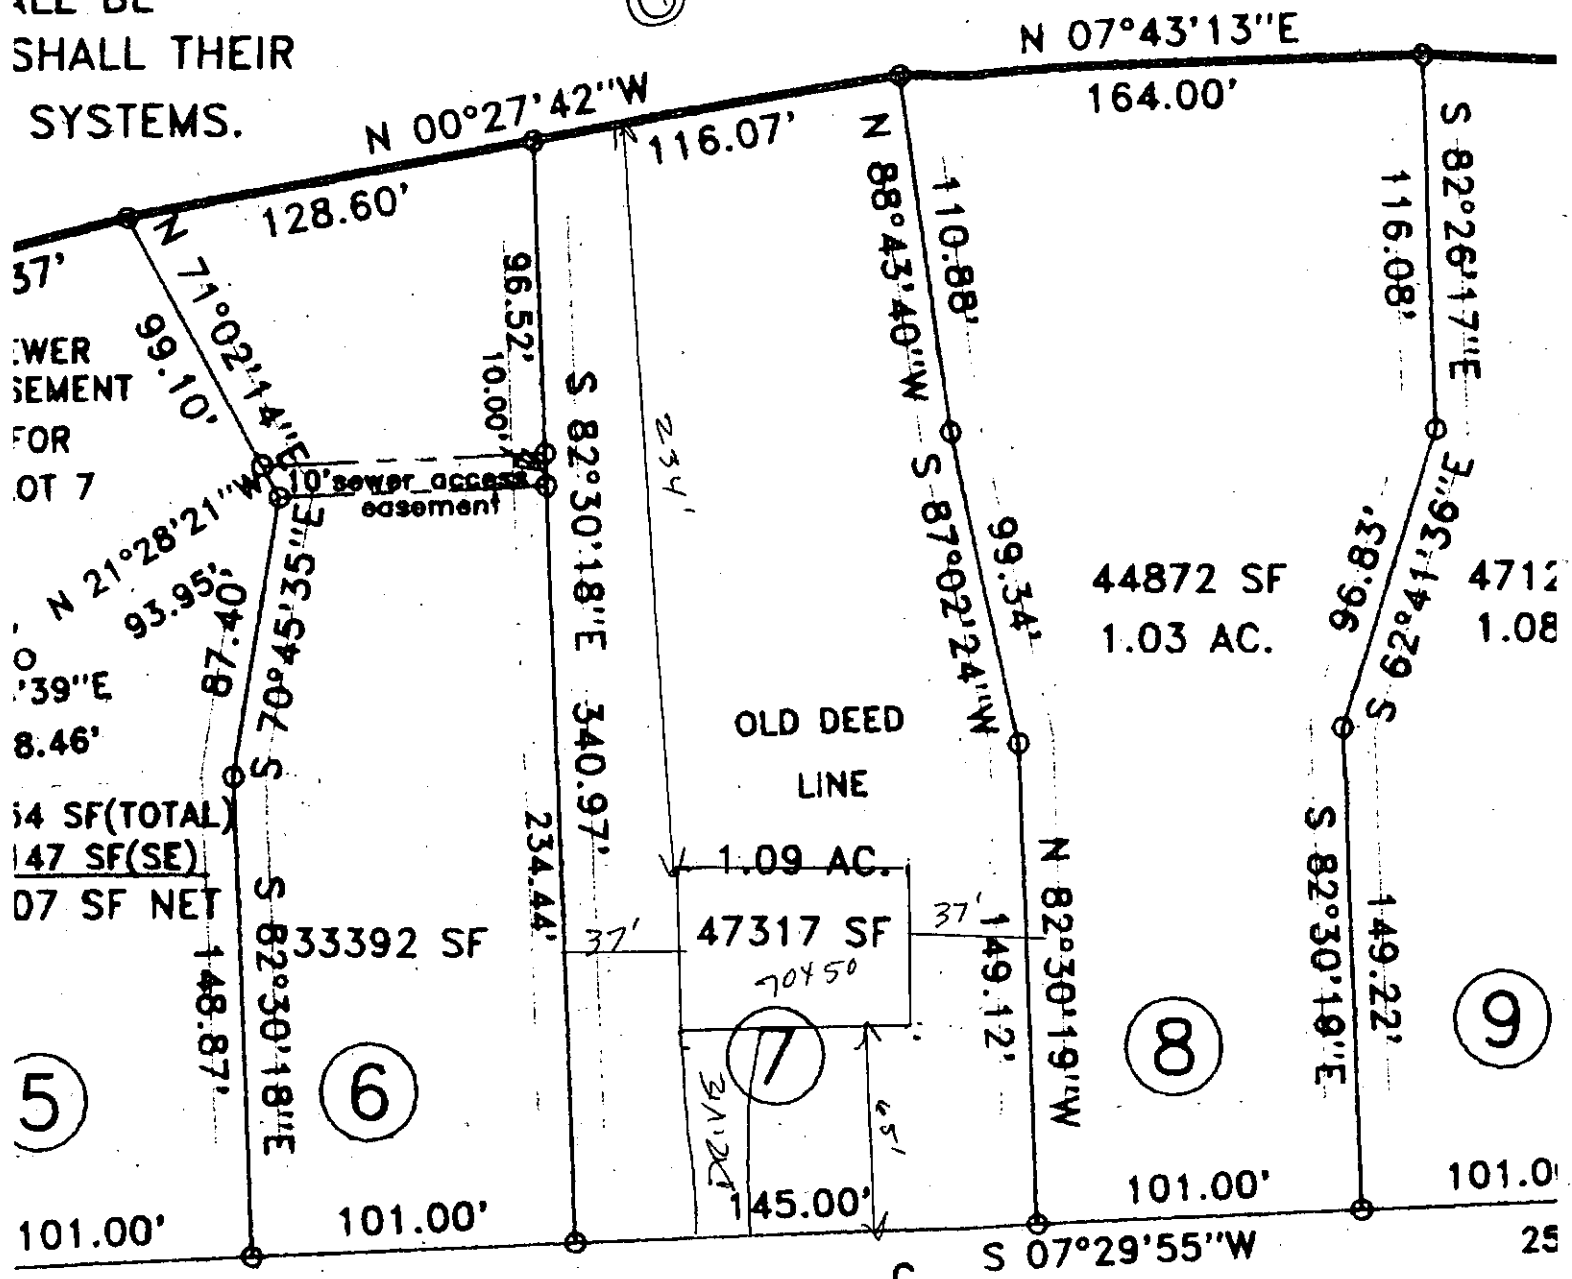

WEST DR. (50' R/W)
 N 07°29'55\"E

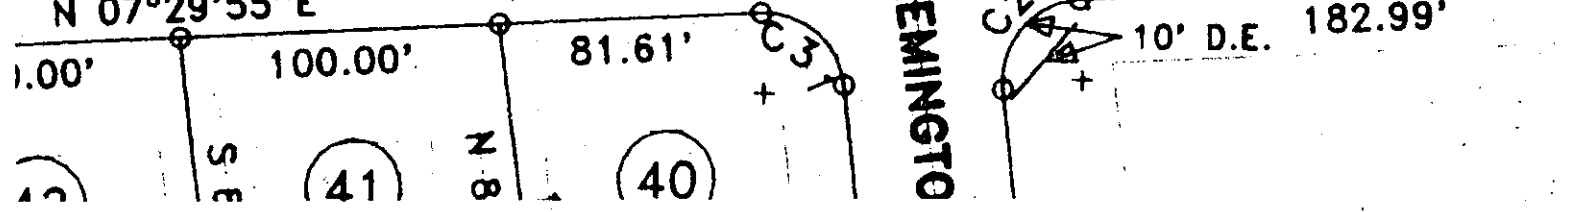

OWNER NAME: THE QUEST DEV. CO. INC.

APPLICATION #: 0050010153

This application to be filled out only when applying for a new septic system.

County Health Department Application for Improvement Permit and/or Authorization to Construct

IF THE INFORMATION IN THIS APPLICATION IS FALSIFIED, CHANGED, OR THE SITE IS ALTERED, THEN THE IMPROVEMENT PERMIT OR AUTHORIZATION TO CONSTRUCT SHALL BECOME INVALID. The permit is valid for either 60 months or without expiration depending upon documentation submitted. (complete site plan = 60 months; complete plat = without expiration)

DEVELOPMENT INFORMATION

- New single family residence
- Expansion of existing system
- Repair to malfunctioning sewage disposal system
- Non-residential type of structure

WATER SUPPLY

- New well
- Existing well
- Community well
- Public water
- Spring

Are there any existing wells, springs, or existing waterlines on this property?

yes no unknown

SEPTIC


If applying for authorization to construct please indicate desired system type(s): can be ranked in order of preference, must choose one.

- Accepted Innovative
- Alternative Other
- Conventional Any

The applicant shall notify the local health department upon submittal of this application if any of the following apply to the property in question. If the answer is "yes", applicant must attach supporting documentation.

- YES NO Does The Site Contain Any Jurisdictional Wetlands?
- YES NO Does The Site Contain Any Existing Wastewater Systems?
- YES NO Is Any Wastewater Going To Be Generated On The Site Other Than Domestic Sewage?
- YES NO Is The Site Subject To Approval By Any Other Public Agency?
- YES NO Are There Any Easements Or Right Of Ways On This Property?


I Have Read This Application And Certify That The Information Provided Herein Is True, Complete And Correct. Authorized County And State Officials Are Granted Right Of Entry To Conduct Necessary Inspections To Determine Compliance With Applicable Laws And Rules. I Understand That I Am Solely Responsible For The Proper Identification And Labeling Of All Property Lines And Corners And Making The Site Accessible So That A Complete Site Evaluation Can Be Performed.

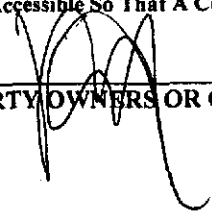
PROPERTY OWNERS OR OWNERS LEGAL REPRESENTATIVE SIGNATURE (REQUIRED)

02 Nov 03
DATE

Gatewest Subdivision
Lemuel Black Road (SR1125)
Anderson Creek, Harnett County, North Carolina

Drainfield Repair
Lines 24" x 3' wide
9' ON centers
Drain Field Lines 80'
Repair Lines 50'
(SEE Lot #5)
1" = 50'

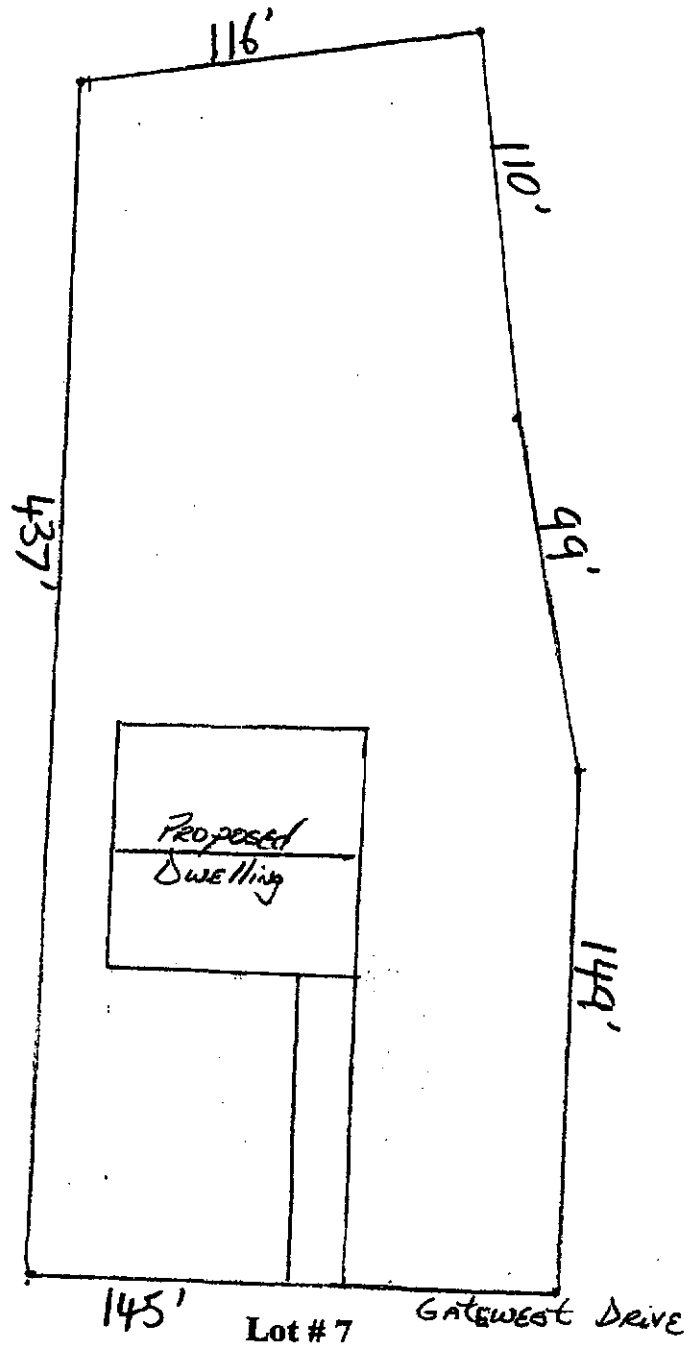

Harnett County Planning Department

PO Box 65, Lillington, NC 27546
910-893-7527

16148
16149
16150
16151
16152
16153
16154
16155

Environmental Health New Septic Systems Test

Environmental Health Code 800

- Place "property flags" in each corner of lot. All property lines must be clearly flagged.
- Place "house corner flags" at each corner of where the house/manufactured home will sit. Use additional flagging to outline driveways, garages, decks, out buildings, swimming pools, etc.
- Place flags at locations as developed on site plan by Customer Service Technician and you.
- Place Environmental Health "orange" card in location that is easily viewed from road.
- *No grading of property should be done.* Undergrowth should be cleaned out to allow soil evaluation to be performed. Inspectors should be able to walk freely.
- After preparing proposed site call the voice permitting system at 910-893-7527 and give code 800 for Environmental Health confirmation. Please note confirmation number given at end of recording for proof of request.
- To hear results, call IVR in approx. 7-10 working days. Once approved, proceed to Central Permitting for permits.

Environmental Health Existing Tank Inspections

Environmental Health Code 800

- Place Environmental Health "orange" card in location that is easily viewed from road.
- Prepare for inspection by removing soil over door as diagram indicates. Loosen trap door cover. (Unless inspection is for a septic tank in a mobile home park)
- After preparing trapdoor call the voice permitting system at 910-893-7527 and give code 800 for Environmental Health confirmation. Please note confirmation number given at end of recording for proof of request.
- To hear results, call IVR in approx. 7-10 working days. Once approved, proceed to Central Permitting for permits.

Health and Sanitation Inspections

Health and Sanitation Plan Review 826

- After submitting plans for food and lodging, call the voice permitting system at 910-893-7527 and give code 826 for Health and Sanitation confirmation. Please note confirmation number given at end of recording for proof of request.
- To hear results, call IVR in approx. 7-10 working days. Once approved, proceed to Central Permitting for permits.

Fire Marshal Inspections

Fire Marshall Plan Review Code 804

- Call the voice permitting system at 910-893-7527 and give code 804 for plan review. Please note confirmation number given at end of recording for proof of request.
- To hear results, call IVR in approx 7-10 working days. Once approved, proceed to Central Permitting for permits.
- Pick up Fire Marshal's letter and place on job site until work is completed.

Public Utilities

- Place stake with "orange" tape/name thirty feet (30) from the center of the road at the location you wish to have water tap installed.
- Allow four to six weeks after application for water/sewer taps. Call Utilities at 893-7575 for technical assistance.

Building Inspections

- Call the voice permitting system at 910-893-7527 to schedule inspections. Please note confirmation number given at end of recording for proof of request.
- For new housing/set up permits must meet E 911 / Addressing guidelines prior to calling for final inspection.
- To hear results of inspections, call IVR after scheduled inspection is done.

E911 Addressing

Addressing Confirmation Code 814

- Address numbers shall be mounted on the house, 3 inches high (5" for commercial).
- Numbers must be a contrasting color from house, must be clearly visible night and day at entrance of driveway if home is 100 ft or more from road, or if mailbox is on opposite side of road.
- Once you purchase permits and footing inspection has been approved call the voice permitting system at 910-893-7527 and give code 814 for address confirmation. This must be called in even if you have contacted E911 for verbal confirmation.

Customers can view all inspection results online at www.harnett.org.

Applicant Signature: [Signature] Date: 02 NOV 04

APPROVED
[Signature]
 COUNTY PUBLIC ENGINEER
 WASHINGTON, D.C. 20540

CERTIFICATION OF OWNERSHIP, RESIDENCE AND JURISDICTION
 I, the undersigned, being duly qualified and sworn as a Public Engineer, do hereby certify that the above described lots and parcels are owned by the persons named therein, and that the same are situated within the limits of the County of Harnett, North Carolina, and that the same are subject to the jurisdiction of the State of North Carolina.

DEED REFERENCE
 DEED BOOK 318, PAGE 578
 DEED BOOK 328, PAGE 641
MAP REFERENCE
 MAP NO. 3008-101
 MAP NO. 3008-787



[Signature]
 MICHAEL R. BARNETT
 1514
 HARNETT COUNTY, N.C.

NOTES:
 1. PER FROM SET AT ALL CORNERS UNLESS OTHERWISE NOTED.
 2. ALL CORNERS TO BE BOUND BY THE DEED BOOKS AND MAPS REFERENCED HEREIN.
 3. ALL UNBOUND CORNERS TO BE BOUND BY THE DEED BOOKS AND MAPS REFERENCED HEREIN.
 4. ALL UNBOUND CORNERS TO BE BOUND BY THE DEED BOOKS AND MAPS REFERENCED HEREIN.
 5. ALL UNBOUND CORNERS TO BE BOUND BY THE DEED BOOKS AND MAPS REFERENCED HEREIN.

DEPARTMENT OF TRANSPORTATION
 DIVISION OF HIGHWAYS
 COMMISSION ON PLANNING AND CERTIFICATION
 APPROVED: *[Signature]*
 DATE: 10-2-06

MINIMUM BUILDING SET BACKS
 FRONT YARD 35'
 SIDE YARD 25'
 REAR YARD 25'
 CORNER LOT SIDE YARD 10-20'
 MAXIMUM HEIGHT 35'

I HEREBY CERTIFY THAT THIS RECORD PLAT COMPLES WITH THE SUBDIVISION REGULATIONS OF HARNETT COUNTY, N.C. AND THAT THIS PLAT HAS BEEN APPROVED FOR RECORDATION BY THE REGISTER OF DEEDS HARNETT COUNTY, N.C.

[Signature]
 PLANNING DIRECTOR

STATE OF NORTH CAROLINA
 COUNTY OF HARNETT
 I, *[Signature]*, ATTORNEY AT LAW, do hereby certify that the map on this plat is a true and correct copy of the original map on file in my office and that all the requirements for recordation have been complied with.

RECORDED IN THIS OFFICE AT THE REGISTER'S OFFICE ON THIS 10th day of October, 2006.
 REGISTER OF DEEDS
 HARNETT COUNTY

THE LOTS ON THIS PLAT HAVE BEEN EVALUATED BY A PRIVATE CONSULTANT. BASED ON THIS REVIEW, IT APPEARS THAT LOTS (1) THROUGH (30) MEET APPROXIMATE REGULATIONS. NOTE THAT FINAL APPROVAL FOR EACH LOT REQUIRES ISSUANCE OF THE PERMITS BY THE COUNTY HEALTH DEPARTMENT. THIS CERTIFICATION DOES NOT REPRESENT APPROVAL OR A PERMIT FOR ANY SITE WORK.

ROAD NAMES HAVE BEEN REVIEWED AND APPROVED BY E-911
 Approved by: *[Signature]*
 Date: 10-2-06

CHECKED THE SHOWN DATA:
 1. AREA
 2. PERIMETER
 3. BEARING
 4. DISTANCE
 5. AREA
 6. PERIMETER
 7. BEARING
 8. DISTANCE

CHECKED THE SHOWN DATA:
 1. AREA
 2. PERIMETER
 3. BEARING
 4. DISTANCE
 5. AREA
 6. PERIMETER
 7. BEARING
 8. DISTANCE


CHECKED THE SHOWN DATA:
 1. AREA
 2. PERIMETER
 3. BEARING
 4. DISTANCE
 5. AREA
 6. PERIMETER
 7. BEARING
 8. DISTANCE

CHECKED THE SHOWN DATA:
 1. AREA
 2. PERIMETER
 3. BEARING
 4. DISTANCE
 5. AREA
 6. PERIMETER
 7. BEARING
 8. DISTANCE

CHECKED THE SHOWN DATA:
 1. AREA
 2. PERIMETER
 3. BEARING
 4. DISTANCE
 5. AREA
 6. PERIMETER
 7. BEARING
 8. DISTANCE

CHECKED THE SHOWN DATA:
 1. AREA
 2. PERIMETER
 3. BEARING
 4. DISTANCE
 5. AREA
 6. PERIMETER
 7. BEARING
 8. DISTANCE

CHECKED THE SHOWN DATA:
 1. AREA
 2. PERIMETER
 3. BEARING
 4. DISTANCE
 5. AREA
 6. PERIMETER
 7. BEARING
 8. DISTANCE

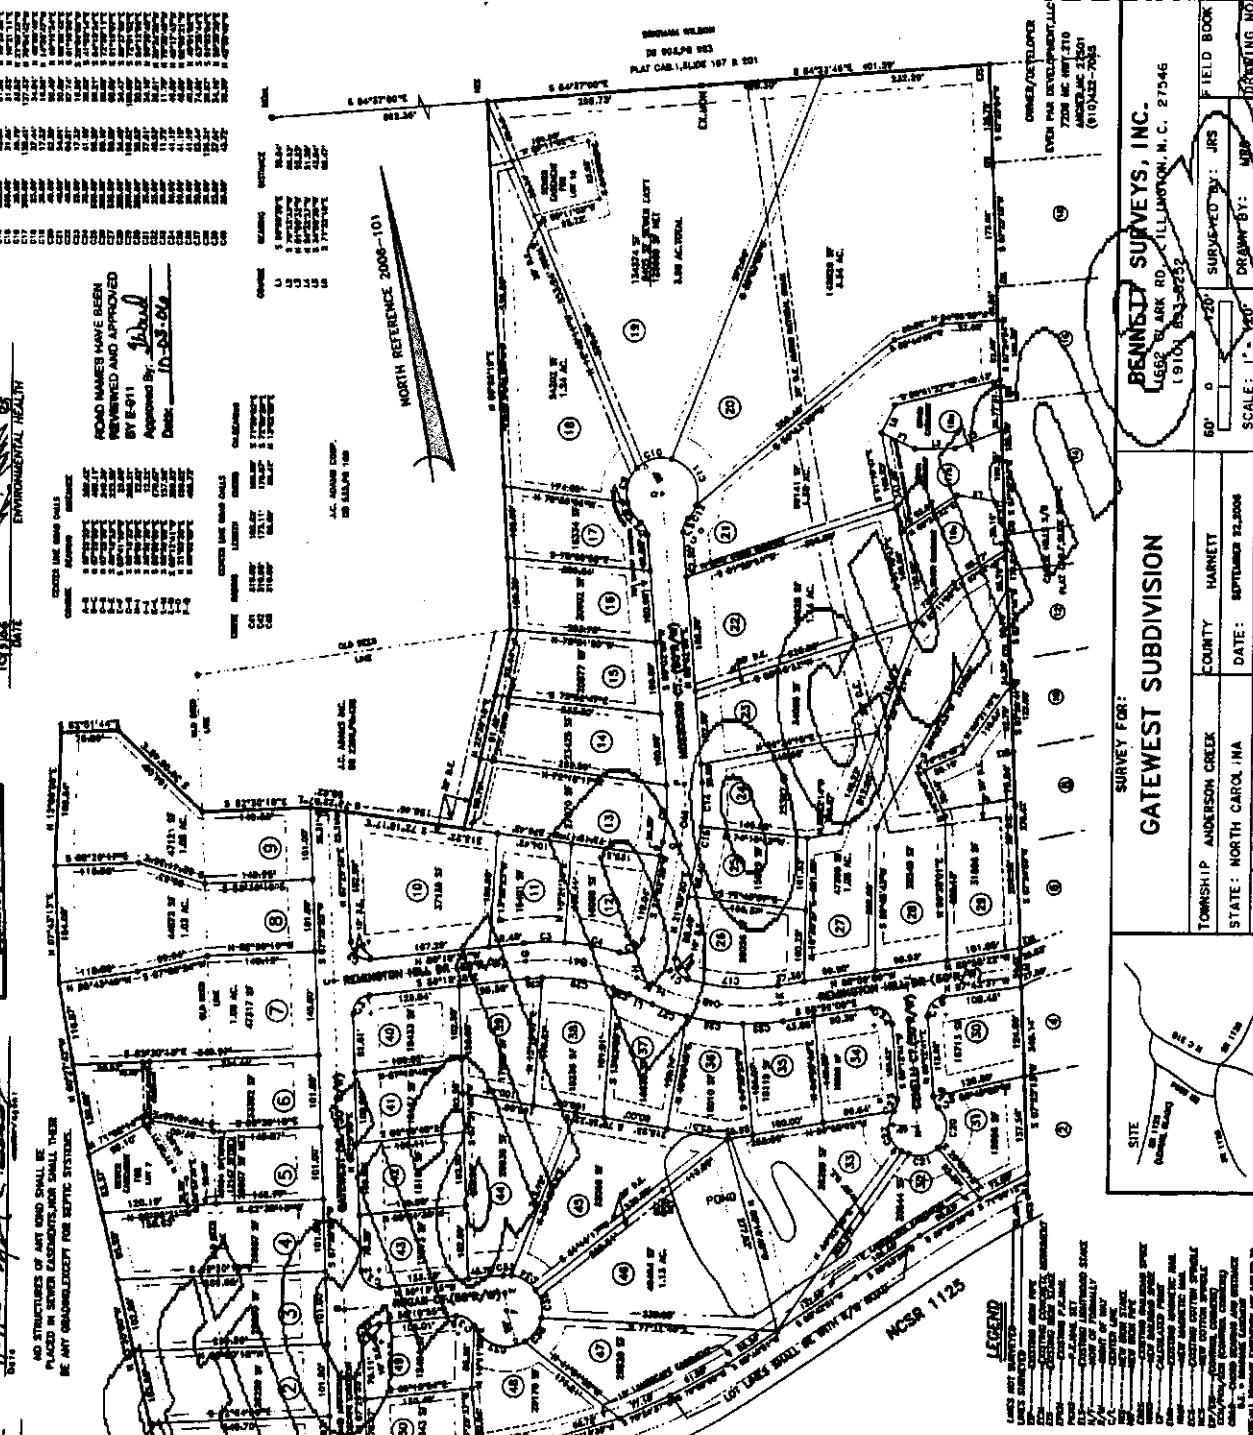

BENNETT SURVEYS, INC.
 4652 BLACK RD., WILMINGTON, N.C. 27546
 (910) 438-2252

GATEWEST SUBDIVISION
 TOWNSHIP: ANDERSON CREEK
 COUNTY: HARNETT
 STATE: NORTH CAROLINA
 DATE: SEPTEMBER 2006
 ZONE: WATERSEED DISTRICT
 N/A

LEGEND
 LINES SHOWN ON THIS PLAT:
 1. BOUNDARY LINES
 2. EASEMENTS
 3. RIGHT-OF-WAY LINES
 4. ADJACENT PROPERTY LINES
 5. UNBOUND CORNERS
 6. BOUNDARY CORNERS
 7. ADJACENT PROPERTY CORNERS
 8. UNBOUND CORNERS
 9. BOUNDARY CORNERS
 10. ADJACENT PROPERTY CORNERS

SCALE: 1" = 200'
 CHECKED & CLOSED BY: *[Signature]*
 DRAWN BY: *[Signature]*
 SURVEYED BY: *[Signature]*
 FIELD BOOK NO. 0558

DATE: 10-10-06
 REVIEW OFFICER: *[Signature]*

[Handwritten notes and signatures]

OFFER TO PURCHASE AND CONTRACT

Buyer: The Quest Development Company of Dunn, Inc.
Howell L. Edwards, Jr., President
PO Box 2121
Dunn, North Carolina 28335

Sellers: Eiken Park Dev. LLC

The Buyer hereby offers to purchase and the Sellers agree to sell and convey, 50 lots known as Gatewest Subdivision, Anderson Creek Township, Harnett County, North Carolina.

TERMS AND CONDITIONS

PRICE: \$ 25,500.00 per lot.

CLOSING: 40 lots shall be closed by December 15th, 2006. The remaining 10 lots shall be closed as follows: 5 lots at the time of the sale of 5 houses in Gatewest and the last 5 lots at the time of the sale of 10 houses in Gatewest Subdivision. Any or all of these lots may be closed sooner if desired by the Buyer.

LOTS TO BE CLOSED FIRST: 1, 2, 3, 4, 5, 6, 7, 8, 9, 11, 12, 13, 14, 15, 16, 17, 24, 25, 26, 27, 28, 29, 30, 34, 35, 36, 37, 38, 39, 40, 41, 42, 43, 44, 45, 46, 47, 48, 49, 50. The remaining 10 lots may be closed in any order.

COVENANTS: Seller shall prepare and record restrictive covenants before closing. Buyer shall approve covenants before recording.

SEPTIC SYSTEMS: Each lot must accommodate a minimum 54' wide by 54' deep building site in a standard position and a septic site or sewer easement approved by the Harnett County Health Department for a 3 bedroom 2 ½ bath single family residence. Any lots that do not meet this requirement will be considered unsuitable by the Buyer and will not have to be closed. The standard position is to be defined by the Buyer.