

**HARNETT COUNTY HEALTH DEPARTMENT
 ENVIRONMENTAL HEALTH SECTION
 307 W. CORNELIUS HARNETT BLVD.
 LILLINGTON, NC 27546
 910-893-7547 PHONE
 910-893-9371 FAX**

Application for Repair

NAME Dawne Bjorklund EMAIL ADDRESS: dawnebjorklund@hotmail.c
 PHONE NUMBER (910) 658-7559 / (910) 489-6092
 PHYSICAL ADDRESS 151 Gatwest Drive Bunnlevel, NC 28323

MAILING ADDRESS (IF DIFFERENT THAN PHYSICAL) _____

IF RENTING, LEASING, ETC., LIST PROPERTY OWNER NAME _____

Gatwest 8 1.03 Acres
 SUBDIVISION NAME LOT #/TRACT # STATE RD/HWY SIZE OF LOT/TRACT

Type of Dwelling: Modular Mobile Home Stick built Other _____

Number of bedrooms 4 Basement

Garage: Yes No Dishwasher: Yes No Garbage Disposal: Yes No

Water Supply: Private Well Community System County

Directions from Lillington to your site: 210W → Right onto Anderson Creek School Road →
Slight right onto Lemeul Black Road → Right onto Gatwest Drive

In order for Environmental Health to help you with your repair, you will need to comply by completing the following:

1. A "surveyed and recorded map" and "deed to your property" must be attached to this application. Please inform us of any wells on the property by showing on your survey map.
2. The outlet end of the tank and the distribution box will need to be uncovered and property lines flagged. After the tank is uncovered, property lines flagged, underground utilities marked, and the orange sign has been placed, you will need to call us at 910-893-7547 to confirm that your site is ready for evaluation.

Your system must be repaired within 30 days of issuance of the Improvement Permit or the time set within receipt of a violation letter. (Whichever is applicable.)

By signing below, I certify that all of the above information is correct to the best of my knowledge. False information will result in the denial of the permit. The permit is subject to revocation if the site plan, intended use, or ownership changes.

Dawne Bjorklund
 Signature

3/22/2012
 Date

3/26/12

HOMEOWNER INTERVIEW FORM

It is important that you answer the following questions for our inspectors. Please do not leave any blanks if possible, and answer all questions to the best of your ability. Thank You.

Have you received a violation letter for a failing system from our office? YES NO

Also, within the last 5 years have you completed an application for repair for this site? YES NO

Year home was built (or year of septic tank installation) _____

Installer of system Otis Strickland

Septic Tank Pumper _____

Designer of System _____

1. Number of people who live in house? 2 # adults 2 # children 4 # total
2. What is your average estimated daily water usage? _____ gallons/month or day _____ county water. If HCPU please give the name the bill is listed in _____
3. If you have a garbage disposal, how often is it used? daily weekly monthly NA
4. When was the septic tank last pumped? _____ How often do you have it pumped? _____
5. If you have a dishwasher, how often do you use it? daily every other day weekly
6. If you have a washing machine, how often do you use it? daily every other day weekly monthly
7. Do you have a water softener or treatment system? YES NO Where does it drain?

8. Do you use an "in tank" toilet bowl sanitizer? YES NO
9. Are you or any member in your household using long term prescription drugs, antibiotics or chemotherapy? YES NO If yes please list Long term prescription drugs
10. Do you put household cleaning chemicals down the drain? YES NO If so, what kind?

11. Have you put any chemicals (paints, thinners, etc.) down the drain? YES NO
12. Have you installed any water fixtures since your system has been installed? YES NO If yes, please list any additions including any spas, whirlpool, sinks, lavatories, bath/showers, toilets _____
13. Do you have an underground lawn watering system? YES NO
14. Has any work been done to your structure since the initial move into your home such as, a roof, gutter drains, basement foundation drains, landscaping, etc? If yes, please list Yes - trees cut down
15. Are there any underground utilities on your lot? Please check all that apply:
 Power Phone Cable Gas Water
16. Describe what is happening when you are having problems with your septic system, and when was this first noticed?
Sewage is rising above ground in the backyard
17. Do you notice the problem as being patterned or linked to a specific event (i.e., wash clothes, heavy rains, and household guests?) YES NO If Yes, please list _____

... use as ...
 the subdivision
 County.

owner/agent

ALL BE
 SHALL THEIR
 SYSTEMS.


SITE PLAN APPROVAL

DISTRICT RAZOR USE SFD

#BEDROOMS 3


Date 11/13/03 gfb
 Zoning Administrator

(8)

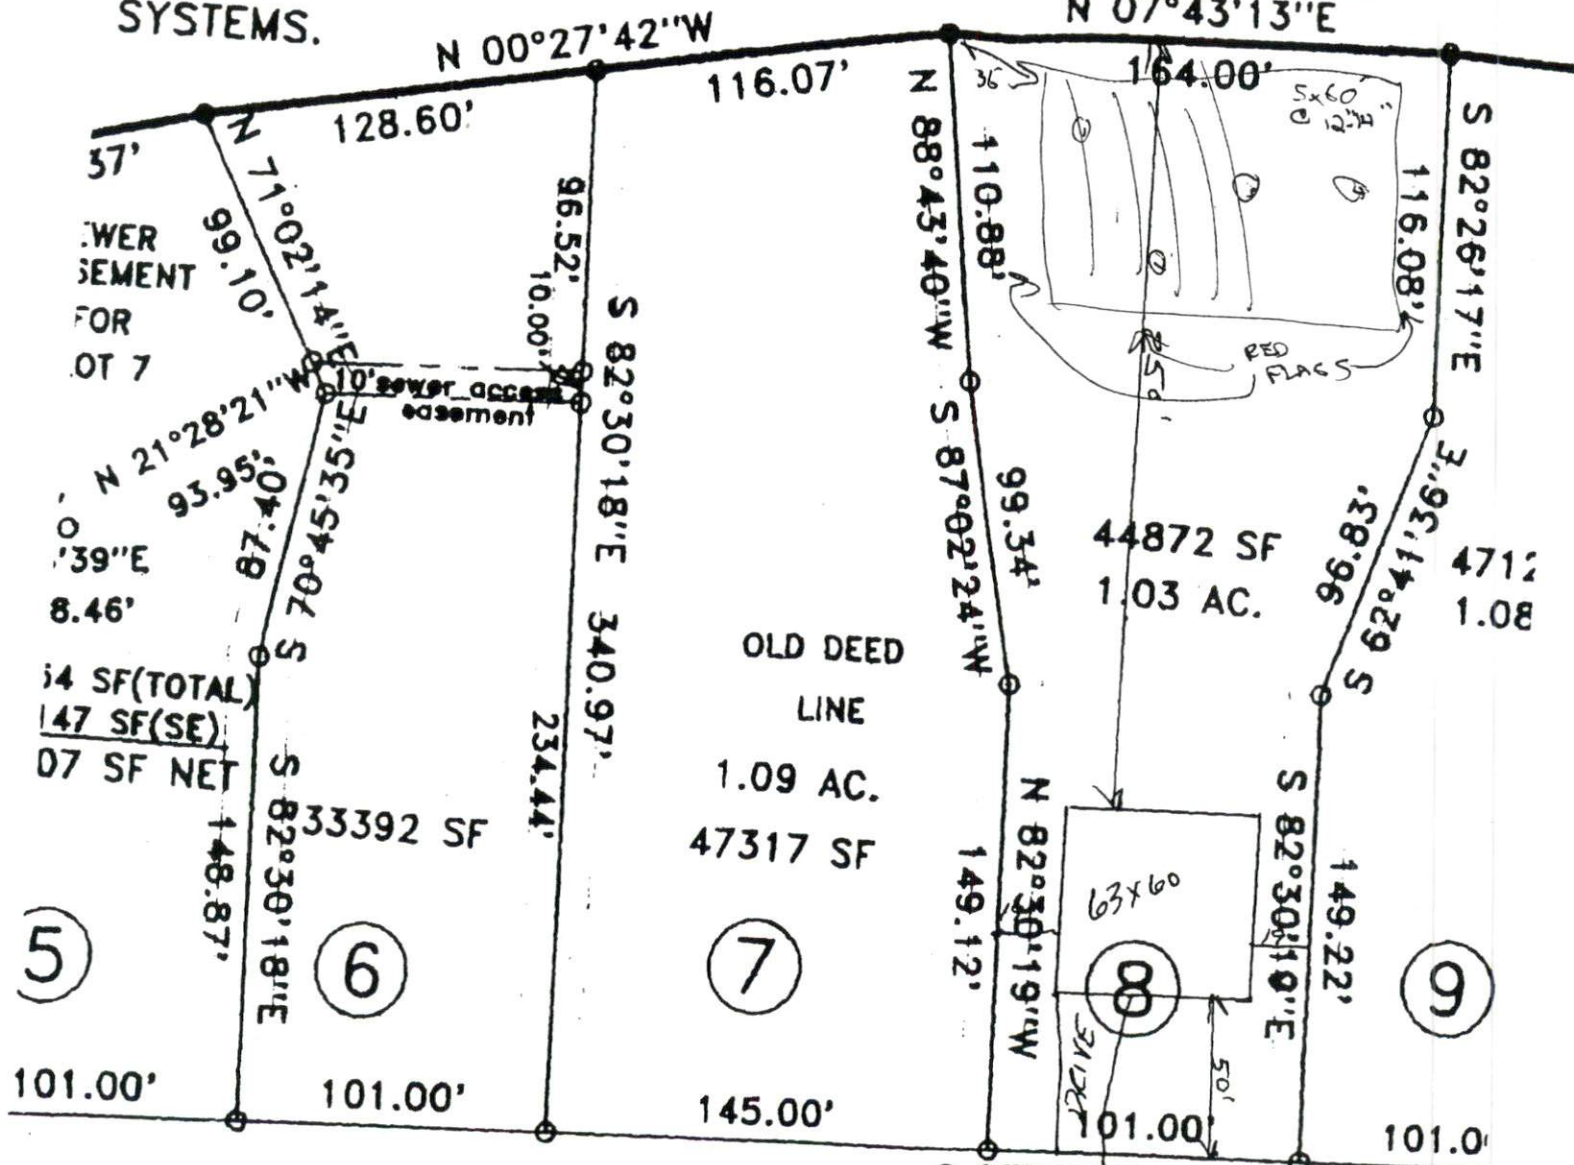


WEST DR. (50' R/W)
 N 07°29'55"E

REMINGTO

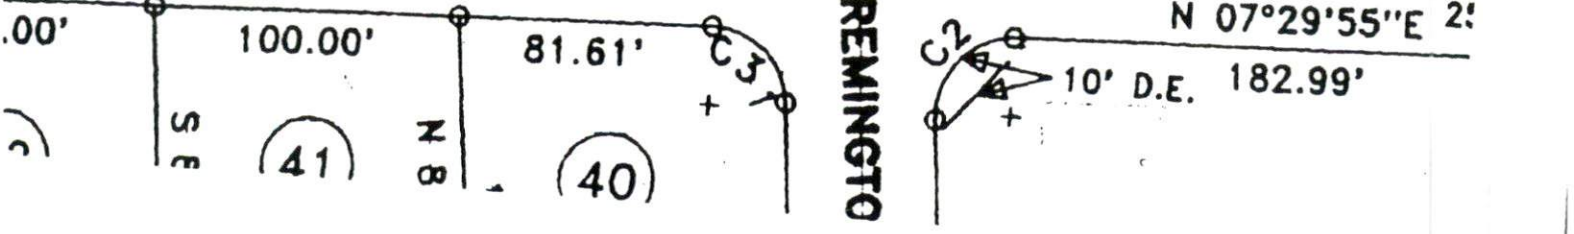

**GateWest Subdivision
 Lemuel Black Road (SR1125)
 Anderson Creek, Harnett County, North Carolina**

Drain Field - Repair
Lines 24" x 3' wide
9' ON CENTERS x 100'
Washed Stone
 1" = 50'

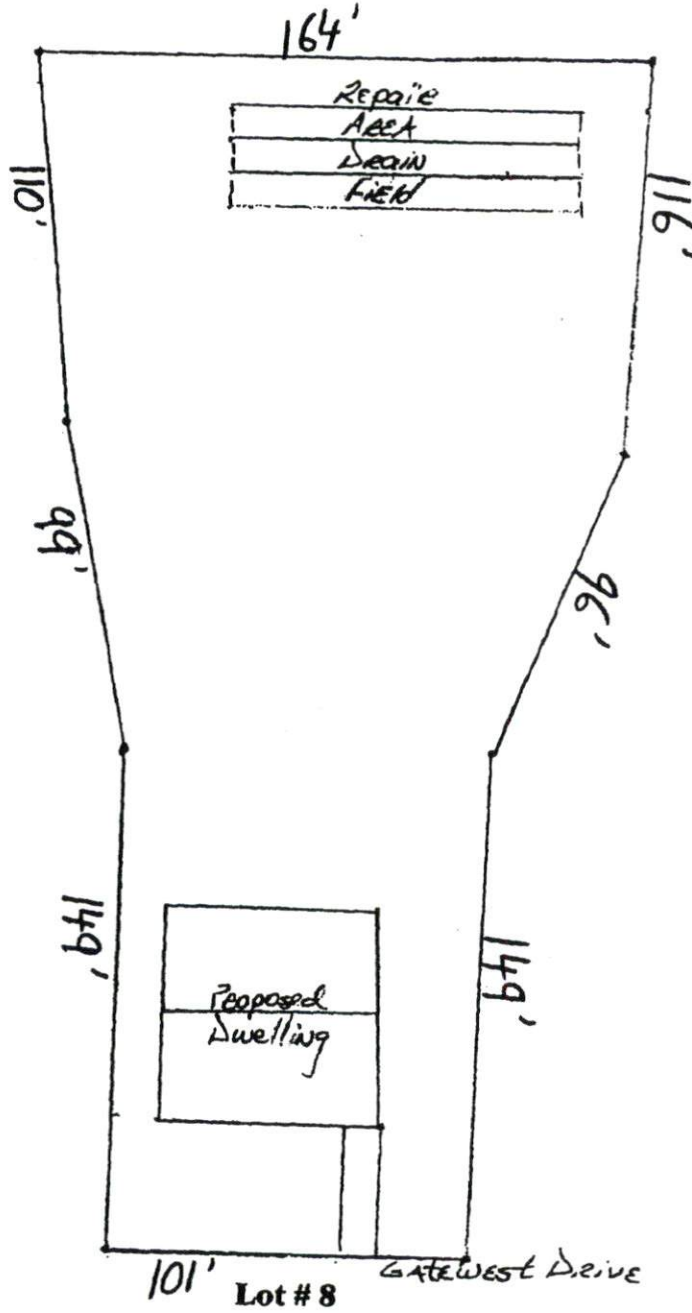

HTE# 06-5-16154

Harnett County Department of Public Health

20335

PERMIT # 25042

Operation Permit

New Installation Septic Tank Repair Nitrification Line Expansion

PROPERTY LOCATION: LEWEL BLACK RD

Name: (owner) QUEST DEV. CO. INC SUBDIVISION GATEWEST LOT # 2

System Installer: OTIS STRICKLAND Registration # _____


Basement with plumbing: Garage Number of Bedrooms 3

Type of Water Supply: Community Public Well Distance from well 100 feet

System Type: III Types V and VI Systems expire in 5 years.

(In accordance with Table V a) Owner must contact Health Department 6 months prior to expiration for permit renewal.

This system has been installed in compliance with applicable North Carolina General Statutes, Rules for Sewage Treatment and Disposal, and all conditions of the Improvement Permit and Construction Authorization.

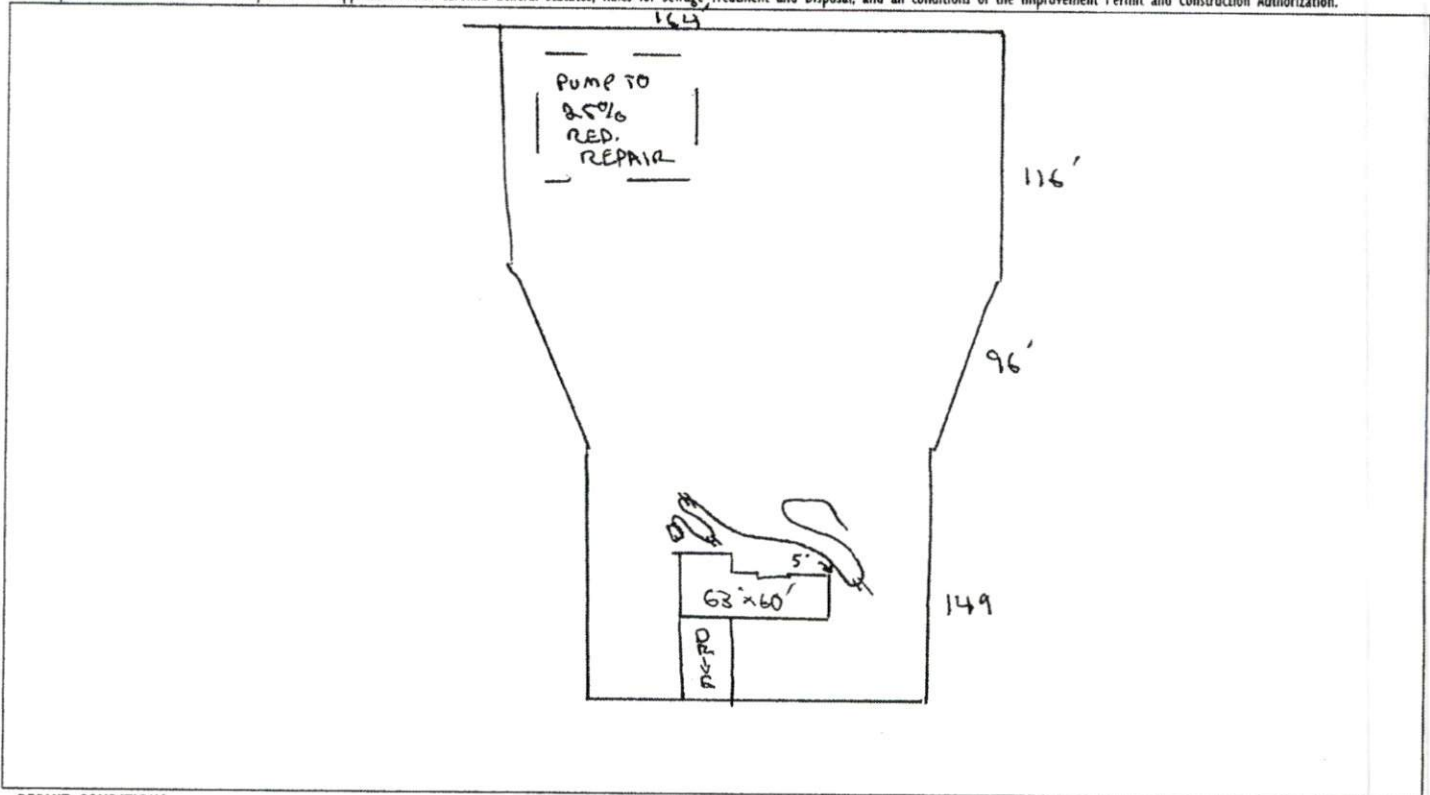

PERMIT CONDITIONS:

- I. Performance: System shall perform in accordance with Rule .1961.
- II. Monitoring: As required by Rule .1961.
- III. Maintenance: As required by Rule .1961. Other: _____
Subsurface system operator required? Yes No
If yes, see attached sheet for additional operation conditions, maintenance and reporting.
- IV. Operation: _____
- V. Other: _____

Following are the specifications for the sewage disposal system on the above captioned property.

Type of system: Conventional Other EZ FLOW Septic Tank: 1000 gallons Pump Tank: _____ gallons

Subsurface No. of exact length width of depth of
Drainage Field ditches 1 of each ditch 240 feet ditches 3 feet ditches 12-14 inches

French Drain Required: _____ Linear feet

Authorized State Agent [Signature] Date 10/16/08

Functions Help



3/30/2012 12:58:23 PM

Actual Consumption Data | Actual Consumption Graph | Daily Consumption Graph

Location ID 85819 Address 151 GATEWEST DR 01
Customer ID 139201 Name BJORKLUND, DANIEL T
Service WA WATER

| Period | Actual Consumption | Days | Daily Consumption |
|--------|--------------------|------|-------------------|
| 03/12 | 5,348.00 | 28 | 190.71 |
| 02/12 | 5,118.00 | 28 | 182.50 |
| 01/12 | 8,160.00 | 35 | 233.14 |
| 12/11 | 6,120.00 | 29 | 211.03 |
| 11/11 | 5,200.00 | 32 | 162.50 |
| 10/11 | 5,290.00 | 31 | 170.65 |
| 09/11 | 11,230.00 | 28 | 401.07 |
| 08/11 | 16,820.00 | 33 | 509.70 |

OK Exit Cancel

Actual Consumption Data | Actual Consumption Graph | Daily Consumption Graph

Location ID 85819 Address 151 GATEWEST DR 01
Customer ID 139201 Name BJORKLUND, DANIEL T
Service WA WATER

| Period | Actual Consumption | Days | Daily Consumption |
|--------|--------------------|------|-------------------|
| 07/11 | 9,110.00 | 28 | 325.36 |
| 06/11 | 9,630.00 | 30 | 321.00 |
| 05/11 | 8,170.00 | 33 | 247.58 |
| 04/11 | 5,330.00 | 31 | 171.94 |
| 03/11 | 5,170.00 | 27 | 191.48 |
| 02/11 | 4,760.00 | 25 | 190.40 |
| 01/11 | 8,070.00 | 38 | 212.37 |
| 12/10 | 8,140.00 | 32 | 254.38 |

OK Exit Cancel

Functions Help



3/30/2012 12:58:57 PM

Actual Consumption Data | Actual Consumption Graph | Daily Consumption Graph

Location ID 85819 Address 151 GATEWEST DR 01
Customer ID 139201 Name BJORKLUND, DANIEL T
Service WA WATER

| Period | Actual Consumption | Days | Daily Consumption |
|--------|--------------------|------|-------------------|
| 11/10 | 7,760.00 | 30 | 258.67 |
| 10/10 | 15,130.00 | 36 | 420.28 |
| 09/10 | 6,370.00 | 27 | 235.93 |
| 08/10 | 8,190.00 | 26 | 315.00 |
| 07/10 | 5,620.00 | 31 | 181.29 |
| 06/10 | 3,450.00 | 28 | 123.21 |
| 05/10 | 2,960.00 | 32 | 92.50 |
| 04/10 | 3,780.00 | 32 | 118.13 |

OK Exit Cancel