
Initial Application Date: 0-2-07  Application # U 1500   8590	
CU	
COUNTY OF HARNETT RESIDENTIAL LAND USE APPLICATION  Central Permitting 108 E. Front Street, Lillington, NC 27546 Phone: (910) 893-7525 Fax: (910) 893-2793 www.harnett.org	
LANDOWNER: Freedom Constructors Fre. Mailing Address: P. O. Box 608	
City: DUNN State: N.C. Zip: 2833 5 Home #: 9/0-892-/23/ Contact #:	
APPLICANT: Wellows Realty FNC. Mailing Address: P.O. By 730	
City: DUNN State: M.C. Zip: 28335 Home #: 9/0-892-3/23 Contact #: *Please fill out applicant information if different than landowner	
CONTACT NAME APPLYING IN OFFICE: DUANE Stephenson Phone #:	
PROPERTY LOCATION: Subdivision: HAIVES + Brave Ph 2 Lot #: 13 Lot Size: 2.32 ACIES	
State Road #: 1703 State Road Name: KLO HW Ch RO Map Book&Page: 99/31	
Parcel: 02/507 0005 /9 PIN: 15/9-31-6726.000	
Zoning: RA 30 Flood Zone: Watershed: DE Deed Book&Page: 02/69/ 0094	
SPECIFIC DIRECTIONS TO THE PROPERTY FROM LILLINGTON: Take 27 Hay East go thru Conts,	
turn Right on Red Hill Church Rd, go report 2 miles turn	
left into HARVEST Drove Sub. divi lot at end of	
Street.	
PROPOSED HOP	
PROPOSED USE:  Circle:  SFD (Size 7/ x 45) # Bedrooms 3 # Baths 2 Basement (w/wo bath)  Garage   Deck  Crawl Space/ Slab	
□ Mod (Size x ) # Bedrooms # Baths Basement (w/wo bath) Garage Site Built Deck ON Frame / OFI	=
Duplex No. Buildings No. Bedrooms/Unit	
☐ Manufactured Home: SW DW TW (Size x ) # Bedrooms Garage (site built? ) Deck (site built? )	
☐ Home Occupation # Rooms Use Hours of Operation: #Employees	
□ Addition/Accessory/Other (Size x ) Use Closets in addition(_)yes (_)no	
Water Supply: ( County ( ) Well (No. dwellings) MUST have operable water before final	
Sewage Supply: Wew Septic Tank (Complete New Tank Checklist)	
Property owner of this tract of land own land that contains a manufactured home w/in five hundred feet (500') of tract listed above? (_)YES (_)NO	
Structures (existing or proposed): Single family dwellings Other (specify)	
Comments:	
Required Residential Property Line Setbacks:	
Front Minimum 35 Actual 67.2	
Rear 25 240'	
Closest Side /0 59, 2	
Sidestreet/corner lot	
Nearest Building	
on same lot	
If permits are granted I agree to conform to all ordinances and laws of the State of North Carolina regulating such work and the specifications of plans subn	nitted
I hereby state that foregoing statements are accurate and correct to the best of my knowledge. Permit subject to revocation if false information is provided.	
Mane Alighers 10-2-07	
Signature of Owner or Owner's Agent)  Date	

\*\*This application expires 6 months from the initial date if no permits have been issued\*\*

A RECORDED SURVEY MAP, RECORDED DEED (OR OFFER TO PURCHASE) AND PLAT ARE REQUIRED WHEN APPLYING FOR LAND USE APPLICATION
Please use Blue or Black Ink ONLY

10/5 N

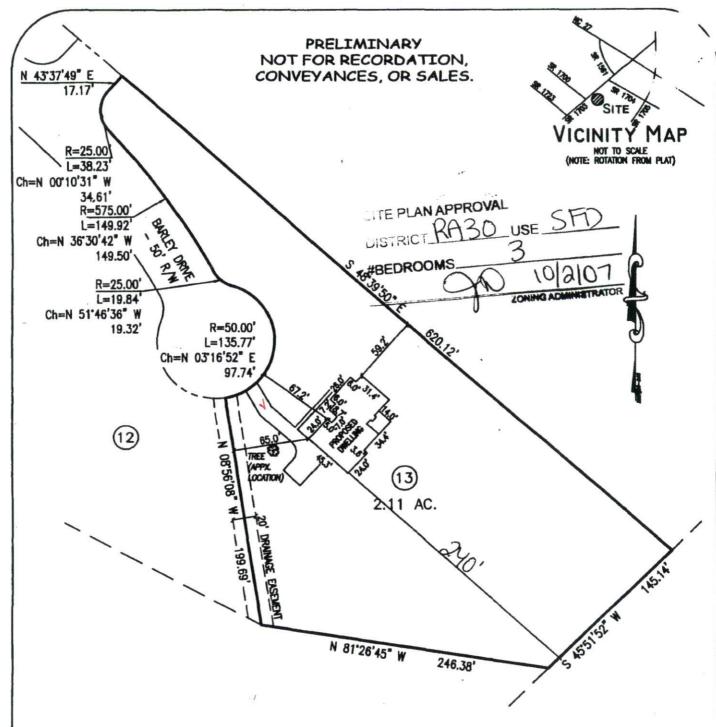

BEING ALL OF LOT 13, HARVEST GROVE, PHASE 2, MAP NUMBER 99-246, HARNETT COUNTY REGISTRY PLOT PLAN FOR

## WELLONS REALTY, INC.

GROVE TOWNSHIP HARNETT CO., NORTH CAROLINA

SCALE: 1" = 80' September 24th, 2007

i, Ronnie E. Jordan, Professional Land Surveyor No. 2556, certify that this plat is a survey of an existing parcel or parcels of land. OWNERNAME: Wellows Realty Two.

APPLICATION #: 0750018590

\*This application to be filled out only when applying for a new septic system.\*

County Health Department Application for Improvement Permit and/or Authorization to Construct

IF THE INFORMATION IN THIS APPLICATION IS FALSIFIED, CHANGED, OR THE SITE IS ALTERED, THEN THE IMPROVEMENT PERMIT OR AUTHORIZATION TO CONSTRUCT SHALL BECOME INVALID. The permit is valid for either 60 months or without expiration depending upon documentation submitted. (complete site plan = 60 months; complete plat = without expiration)

DEVELOPMENT INFORMATION			
New single family residence			
Expansion of existing system			
☐ Repair to malfunctioning sewage disposal system			
□ Non-residential type of structure			
WATER SUPPLY			
□ New well			
□ Existing well			
□ Community well .			
Public water			
□ Spring			
Are there any existing wells, springs, or existing waterlines on this property?			
{_}} yes {_\(\omega\) no {} unknown			
SEPTIC  If applying for authorization to construct please indicate desired system type(s): can be ranked in order of preference, must choose one.			
{} Accepted {} Innovative			
{}} Alternative			
{ Conventional { } Any			
The applicant shall notify the local health department upon submittal of this application if any of the following apply to the property in question. If the answer is "yes", applicant must attach supporting documentation.			
{ }YES { \( \subseteq \) NO Does the site contain any Jurisdictional Wetlands?			
{ }YES { \( \nu \) NO Does the site contain any existing Wastewater Systems?			
{ }YES { \( \subseteq \) NO Is any wastewater going to be generated on the site other than domestic sewage?			
{ }YES { LYNO   Is the site subject to approval by any other Public Agency?			
{LYYES { } NO Are there any easements or Right of Ways on this property?			
{_}}YES {\( \subseteq \) NO Does the site contain any existing water, cable, phone or underground electric lines?			
If yes please call No Cuts at 800-632-4949 to locate the lines. This is a free service.			
I Have Read This Application And Certify That The Information Provided Herein Is True, Complete And Correct. Authorized County And			
State Officials Are Granted Right Of Entry To Conduct Necessary Inspections To Determine Compliance With Applicable Laws And Rules.			
I Understand That I Am Solely Responsible For The Proper Identification And Labeling Of All Property Lines And Corners And Making			
The Site Accessible So That A Complete Site Evaluation Can Be Performed.			
PROPERTY OWNERS OR OWNERS LEGAL REPRESENTATIVE SIGNATURE (REQUIRED)  DATE			



	1400   101   100   100   100   100   100   100   100   100   100   100   100   100   100   100   100   100     2005022745
//>	
HARNETT COUNTY TAX ID#	FOR REGISTRATION REGISTER OF DEEDS ATMERTY S. HEROROVE HERNET COUNTY NC 2005 DEC 16 11:30:35 AM
02 1507 0005 18 02 1507 0005 19	BK:2169 PG:94-98 FEE:\$21.60 IMSTRUMENT # 2005022745
12.11/08 BY KHD	10010011 # 2000022140
EXPLANATION STĂTEMENT TO COR INSTRUMENT AS ORIGINALLY RECO	RECT OBVIOUS MINOR ERROR(S) MADE IN AN ORDED.
RE: BOOK 2136 PAGE 204	
RECORDED IN THE Harnett	COUNTY REGISTRY
NAMES OF ALL PARTIES TO PHE OR	IGINAL INSTRUMENT:
GRANTORS: Four W's Inc	
GRANTEES: Freedom Constructors,	Inc. of Dunn
TRUSTEE/BENEFICIARY: n/a	//
STATE OF NORTH CAROLINA COUNTY OF HARNETT	
I, THE UNDERSIGNED, HEREBY CER ARE MADE IN THE ABOVE NAMED B WITH THE PROVISIONS OF G.S. 47-38	TIFY THAT THE FOLLOWING CORRECTIONS RECORDED INSTRUMENT IN ACCORDANCE 1 RATTIFIED JUNE 30, 1986.
DESCRIPTION OF CORRECTION:	
Map reference for Lot 13 was corr	ected to show Map #99-377
The undersigned prepared the origi	nal deed
THIS THE /6 DAY OF December	, 2005
	DWIGHT W. SNOW (SEAL)
This explanation statement together with the and page on the first page hereof.	the attached instrument duty refecoeded at 16th day of December 2015 in the book
REGISTER OF DEEDS	By: Elmin M. Leasur REGISTER OF DEEDS
	(a)
	· · · · · · · · · · · · · · · · · · ·