

HTE# 07-500-18792

Harnett County Department of Public Health 19989

PERMIT # 23575

Operation Permit

New Installation Septic Tank Repair Nitrification Line Expansion

PROPERTY LOCATION: 1125

Name: (owner) H & H SUBDIVISION Forest Oaks LOT # 154

System Installer: O. Starkland Registration #


Basement with plumbing: Garage Number of Bedrooms 3
Type of Water Supply: Community Public Well Distance from well 5 feet

System Type: Pumps C-2 Flow Types V and VI Systems expire in 5 years.

(In accordance with Table V a) Owner must contact Health Department 6 months prior to expiration for permit renewal.

This system has been installed in compliance with applicable North Carolina General Statutes, Rules for Sewage Treatment and Disposal, and all conditions of the Improvement Permit and Construction Authorization.

Due to Plumbing Problem pump tank had to be added to system after system was installed.

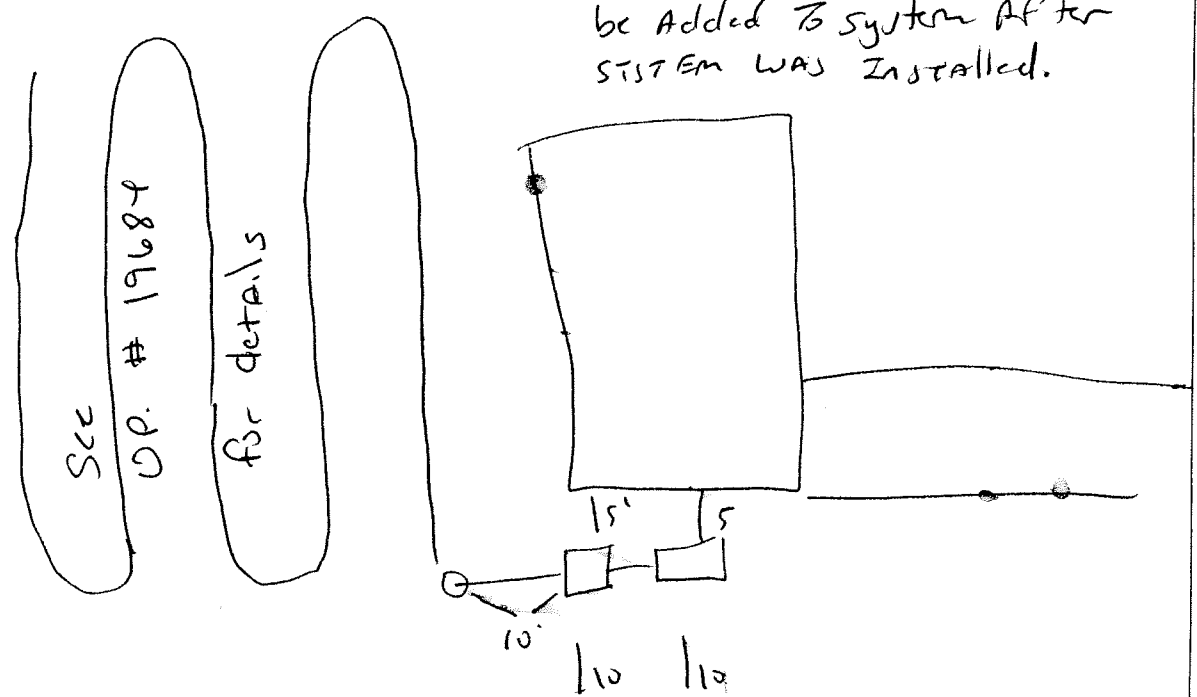

PERMIT CONDITIONS:

- I. Performance: System shall perform in accordance with Rule .1961.
- II. Monitoring: As required by Rule .1961.
- III. Maintenance: As required by Rule .1961. Other: _____
Subsurface system operator required? Yes No
If yes, see attached sheet for additional operation conditions, maintenance and reporting.
- IV. Operation: _____
- V. Other: _____

Following are the specifications for the sewage disposal system on the above captioned property.

Type of system: Conventional Other Pumps C-2 Flow Size of tank: Septic Tank: 1000 gallons Pump Tank: 1000 gallons
 Subsurface No. of exact length width of depth of
 Drainage Field ditches 1 of each ditch 300 feet ditches 2 feet ditches 12 inches
 French Drain Required: _____ Linear feet

Authorized State Agent [Signature] Date 04-14-08