

\* Each section below to be filled out by whomever performing work. Must be owner or licensed contractor. Address, company name & phone must match information on license.

Application # \_\_\_\_\_

Harnett County Central Permitting  
PO Box 65 Lillington, NC 27546  
Phone 910-893-7525 Fax 910-893-2793 www.harnett.org  
**Application for Building and Trades Permit**

Owner's Name: STEPHENSON BUILDERS INC. Date: 12-11-07

Site Address: 38 DERBY LANE LILLINGTON NC Phone: 919-639-2862

Directions to job site from Lillington: HWY 210 EAST 1/2 MI. PASS 401

TURN LT. ON BRUCE JOHNSON RD. GO TO END LEFT ON DERBY LANE

Subdivision: JOHNSON FARMS Lot: 25

Construction Type: (Please Check)

New  Moved House  
 Renovation  Addition  Other

Building Use: (Please Check)

Residential  Commercial  
 Modular  Multi-Family

Total Project Cost: \$130,000<sup>00</sup> Description of Proposed Work: NEW

Heated SF ~~1900~~ 1900 Unheated SF 200 Finished Rec Room? ~~NO~~ YES Crawl Space  Slab ( )

General Contractor Information Building Cost \$ 130,000<sup>00</sup>

STEPHENSON BUILDERS INC. 919-639-2862  
Building Contractor's Company Name Telephone

1187 N. RALEIGH ST. ANGIER, NC. 27501 53604  
Address License #

Phil Stephenson  
Signature of Owner/Contractor/Officer(s) of Corporation

Must sign second page & fill out third page

Electrical Permit Information Elec Cost \$ 1400<sup>00</sup>

Description of Work NEW Service Size: 200 Amps #TPoles 1

REX DEAN ELECTRIC 919-552-4202  
Electrical Contractor's Company Name Telephone

8039 KENNEDY RD. WILLOW SPRING NC 27592 5748  
Address License #

Rex Dean  
Signature of Officer(s) of Corporation

Mechanical Permit Information Mech Cost \$ 4500<sup>00</sup>

Description of Work NEW # Units 2

JL'S HVAC 919-552-6258  
Mechanical Contractor's Company Name Telephone

1580 WADE STEPHENSON RD. HOLLY SPRING N.C. 27546 12655 H-3  
Address License #

Jimmy Carroll  
Signature of Officer(s) of Corporation

Plumbing Permit Information Plumb Cost \$ 4000<sup>00</sup>

Description of Work NEW # Baths 2

W & W PLUMBING CO. INC. 919 639 0195  
Plumbing Contractor's Company Name Telephone

Box 1004 ANGIER, NC-27501 14087  
Address License #

Paul Walker  
Signature of Officer(s) of Corporation

Insulation Permit Information

INSULATING INC. 1212 HONEY LANE RALEIGH NC 27603 919-772-9000

Insulation Contractor's Company Name & Address Telephone

**Commercial Jobs must fill out this portion**  
**Sprinkler System Information**

Sprinkler Contractor's Company Name

Contact & Telephone

Address

License #

Signature of Officer(s) of Corporation

**Fire Alarm System Information**

Fire Alarm Contractor's Company Name

Contact & Telephone

Address

License #

Signature of Officer(s) of Corporation

**Driveway Access** - NC Department of Transportation Driveway Access/Permit?

Yes

No

**Homeowners Applying to Build Their Own Home**

Please answer the following questions then see a Permit Technician to determine if you qualify for permit under Owners Exemption.

Questionnaire per G.S. 87-14 Regulations as to Issue of Building Permits (Memo available upon request)

1. Do you own the land on which this building will be constructed?    \_\_\_ yes    \_\_\_ no
2. Have you hired or intend to hire an individual to superintend and manage construction of the project?    \_\_\_ yes    \_\_\_ no
3. Do you intend to directly control & supervise construction activities?    \_\_\_ yes    \_\_\_ no
4. Do you intend to schedule, contract, or directly pay for all phases of construction work to be done?    \_\_\_ yes    \_\_\_ no
5. Do you intend to personally occupy the building for at least 12 consecutive months following completion of construction and do you understand that if you do not do so, it creates the presumption under law that you fraudulently secured the permit?    \_\_\_ yes    \_\_\_ no

Sign & date

N/A

I hereby certify that I have the authority to make necessary application, that the application is correct and that the construction will conform to the regulations in the Building, Electrical, Plumbing and Mechanical codes, and the Harnett County Zoning Ordinance. I state the information on the above contractors is correct as known to me and if any changes occur including listed contractors, site plan, building and trade plans, Environmental Health permit changes or proposed use changes, I certify it is my responsibility to notify the Harnett County Central Permitting Department of any and all changes.

Signature of Owner/Contractor/Officer(s) of Corporation

Date

12-11-07

**Affidavit for Worker's Compensation  
N.C.G.S. 87-14**

The undersigned applicant for Building Permit # \_\_\_\_\_ being the:

- General Contractor
- Owner
- Officer/Agent of the Contractor or Owner

Do hereby confirm under penalties of perjury that the person(s), firm(s) or corporation(s) performing the work set forth in the permit:

\_\_\_\_\_ Has/have three (3) or more employees and has/have obtained workers' compensation insurance to cover them.

\_\_\_\_\_ Has/have one (1) or more subcontractors(s) and has/have obtained workers' compensation insurance to cover them.

Has/have one (1) or more subcontractors(s) who has/have their own policy of workers' compensation insurance covering themselves.

\_\_\_\_\_ Has/have not more than two (2) employees and no subcontractors.

While working on the project for which this permit is sought it is understood that the Central Permitting Department issuing the permit may require certificates of coverage of worker's compensation insurance prior to issuance of the permit and at any time during the permitted work from any person, firm or corporation carrying out the work.

Firm Name: Stephenson Builders, Inc

Sign/Title: *Phil Stephenson* PRESIDENT

Date: 12-11-07

Plan Box Number 07

Job Name Stephenson

Date: 12-14-07

Required Inspections for SFA/SFD

Appl. # 07-50019052  
Valuation 151578  
Sq. Feet 2333

Sequence

10	<u>✓</u>	R* Bldg. Footing
10-30		R* Elec. Temp Service Pole
20	<u>✓</u>	R* Building Foundation
20		Address Confirmation
30-999	<u>✓</u>	Open Floor
30-999		R* Bldg. Slab Insp.
30-999		R* Elec. Under Slab
30-999		R*Plumb. Under Slab
40	<u>✓</u>	Four Trade Rough In
40		Four Trade Rough In > 2500
40		Three Trade Rough In
40		Three Trade Rough In > 2500
40		Two Trade Rough In
40		Two Trade Rough In > 2500
40		One Trade Rough In
40		One Trade Rough In > 2500
50	<u>✓</u>	R* Insulation
60	<u>✓</u>	Four Trade Final
60		Four Trade Final > 2500
60		Three Trade Final
60		Three Trade Final > 2500
60		Two Trade Final
60		Two Trade Final > 2500
60		One Trade Final
60		One Trade Final > 2500
999	<u>✓</u>	Envir. Operations Permit



69 Shipwash Drive  
Garner, North Carolina 27529

Phone: (919) 773-1200  
Fax: (919) 773-9658

December 18, 2007

Attn: Phil Stephenson  
M: 427-8654  
Fax: 639-9933

Stephenson Builders, Inc.  
1187 N. Raleigh Street  
Angier, NC 27501

Re.: Optional Side Load Garage  
Plan: Southern Designs 0705-05  
Project No.: 07AA-169

To Whom It May Concern:

A representative of Tyndall Engineering & Design analyzed framing items for the above referenced project. Specifically, the following items listed were analyzed:

- 1) Optional side load garage.

The following conclusions and recommendations were presented for the above-mentioned items:


- 1) Based on our plan review and analysis, refer to the attached sheet for framing the side load garage.


We appreciate being able to assist you during this phase of the project. If you need further assistance or require additional information please do not hesitate to contact us.

Sincerely,  
Tyndall Engineering & Design

A handwritten signature in black ink, appearing to read "Avram Adelman", written over a horizontal line.



Avram Adelman  
AA/07AA-169

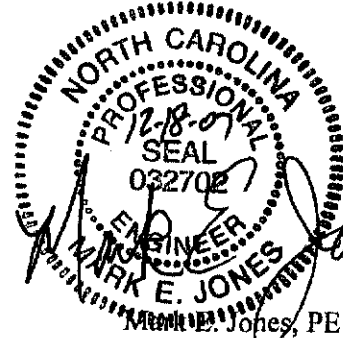

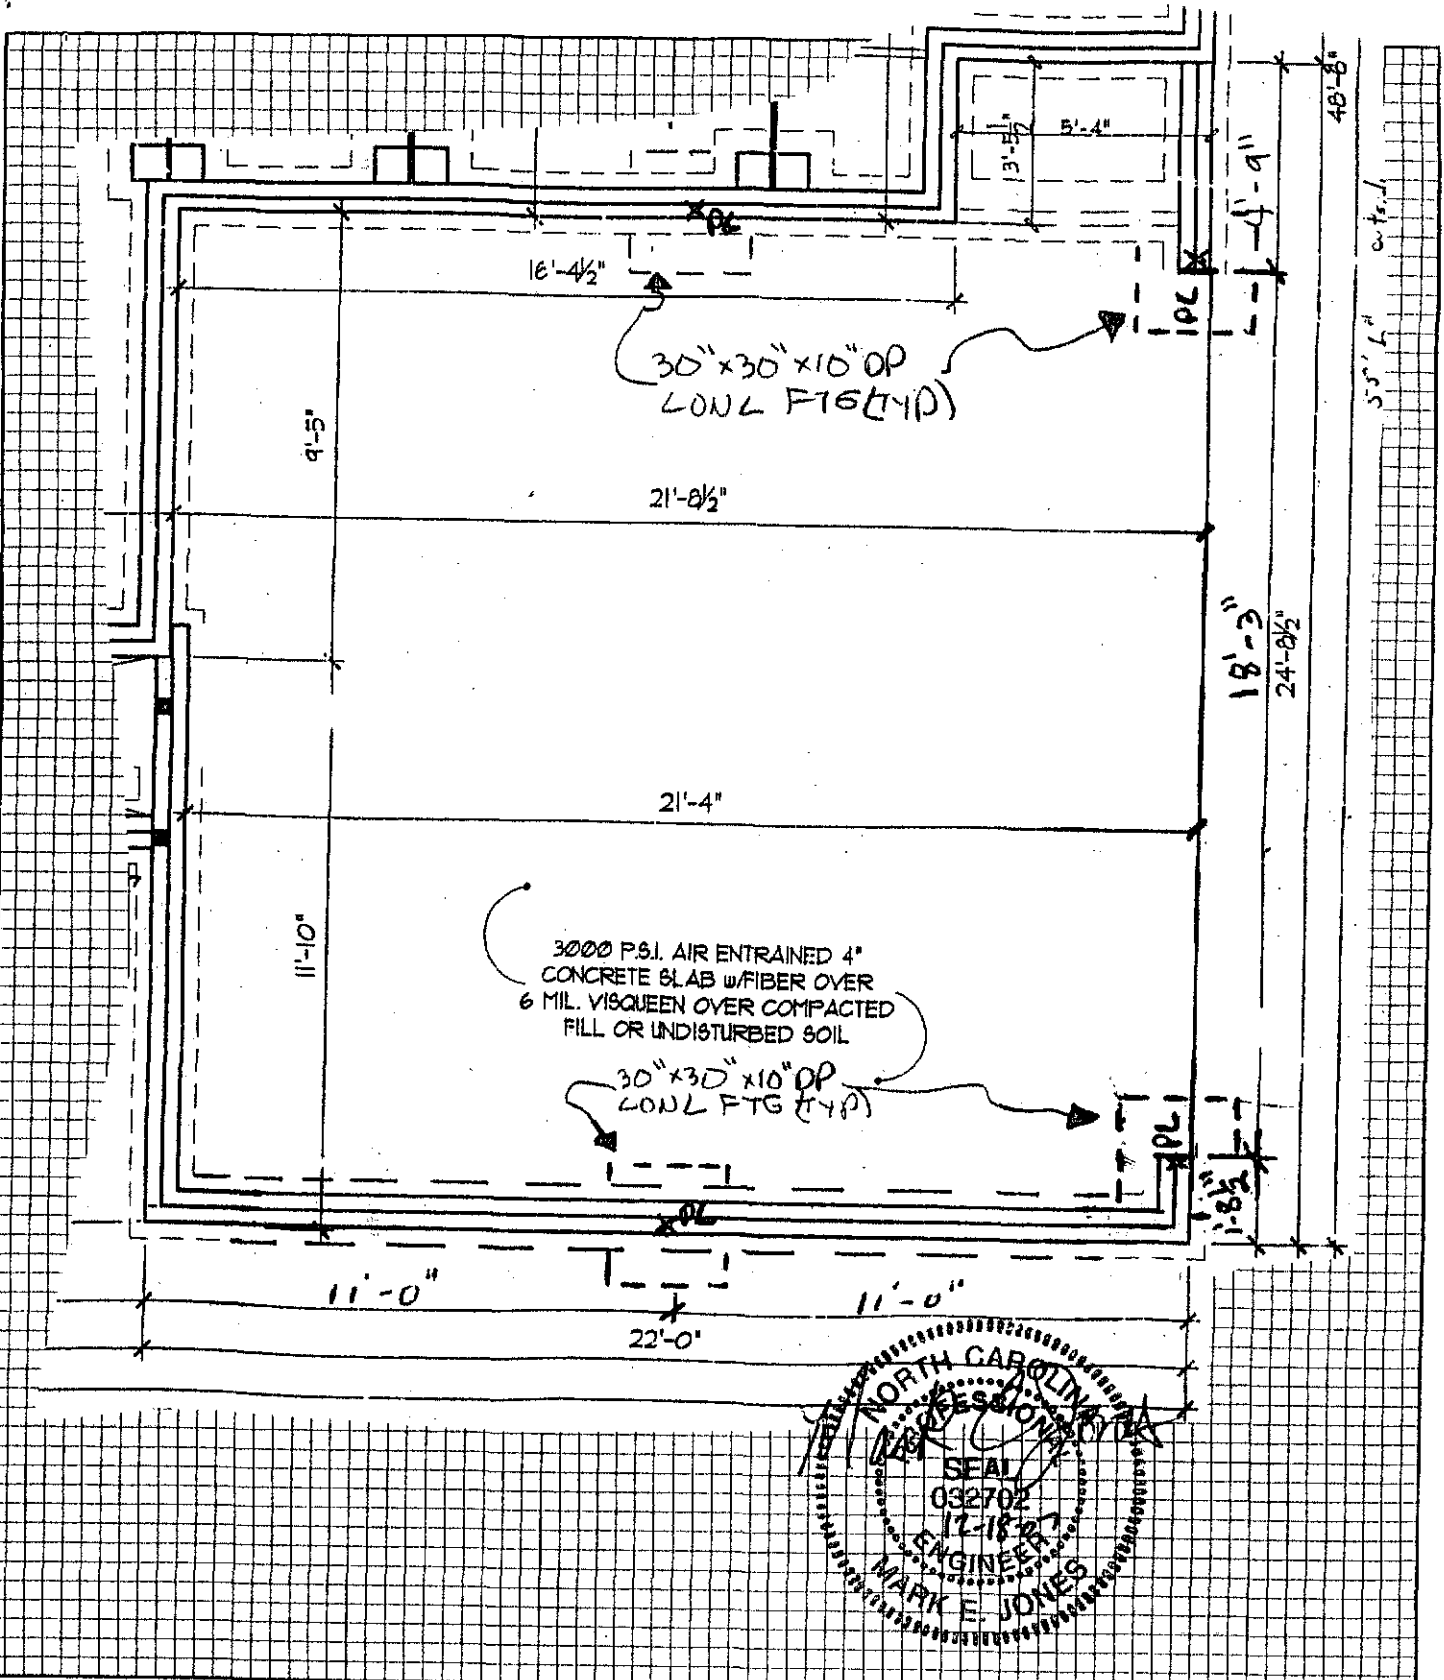

**Tyndall**  
 Engineering & Design, PC  
 69 Shipwash Dr.  
 Garner, NC 27529  
 Phone: (919) 773-1200  
 Fax: (919) 773-965R

JOB 07AA-169  
 LOCATION GARAGE FOU  
 CALCULATED BY AA DATE 12.18.07  
 SHEET NO. 2 OF 3  
 SCALE NTS

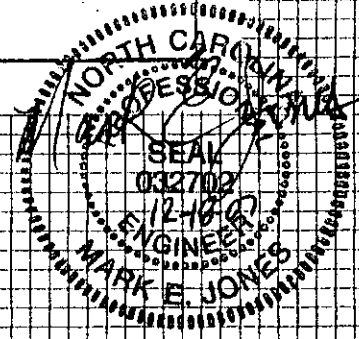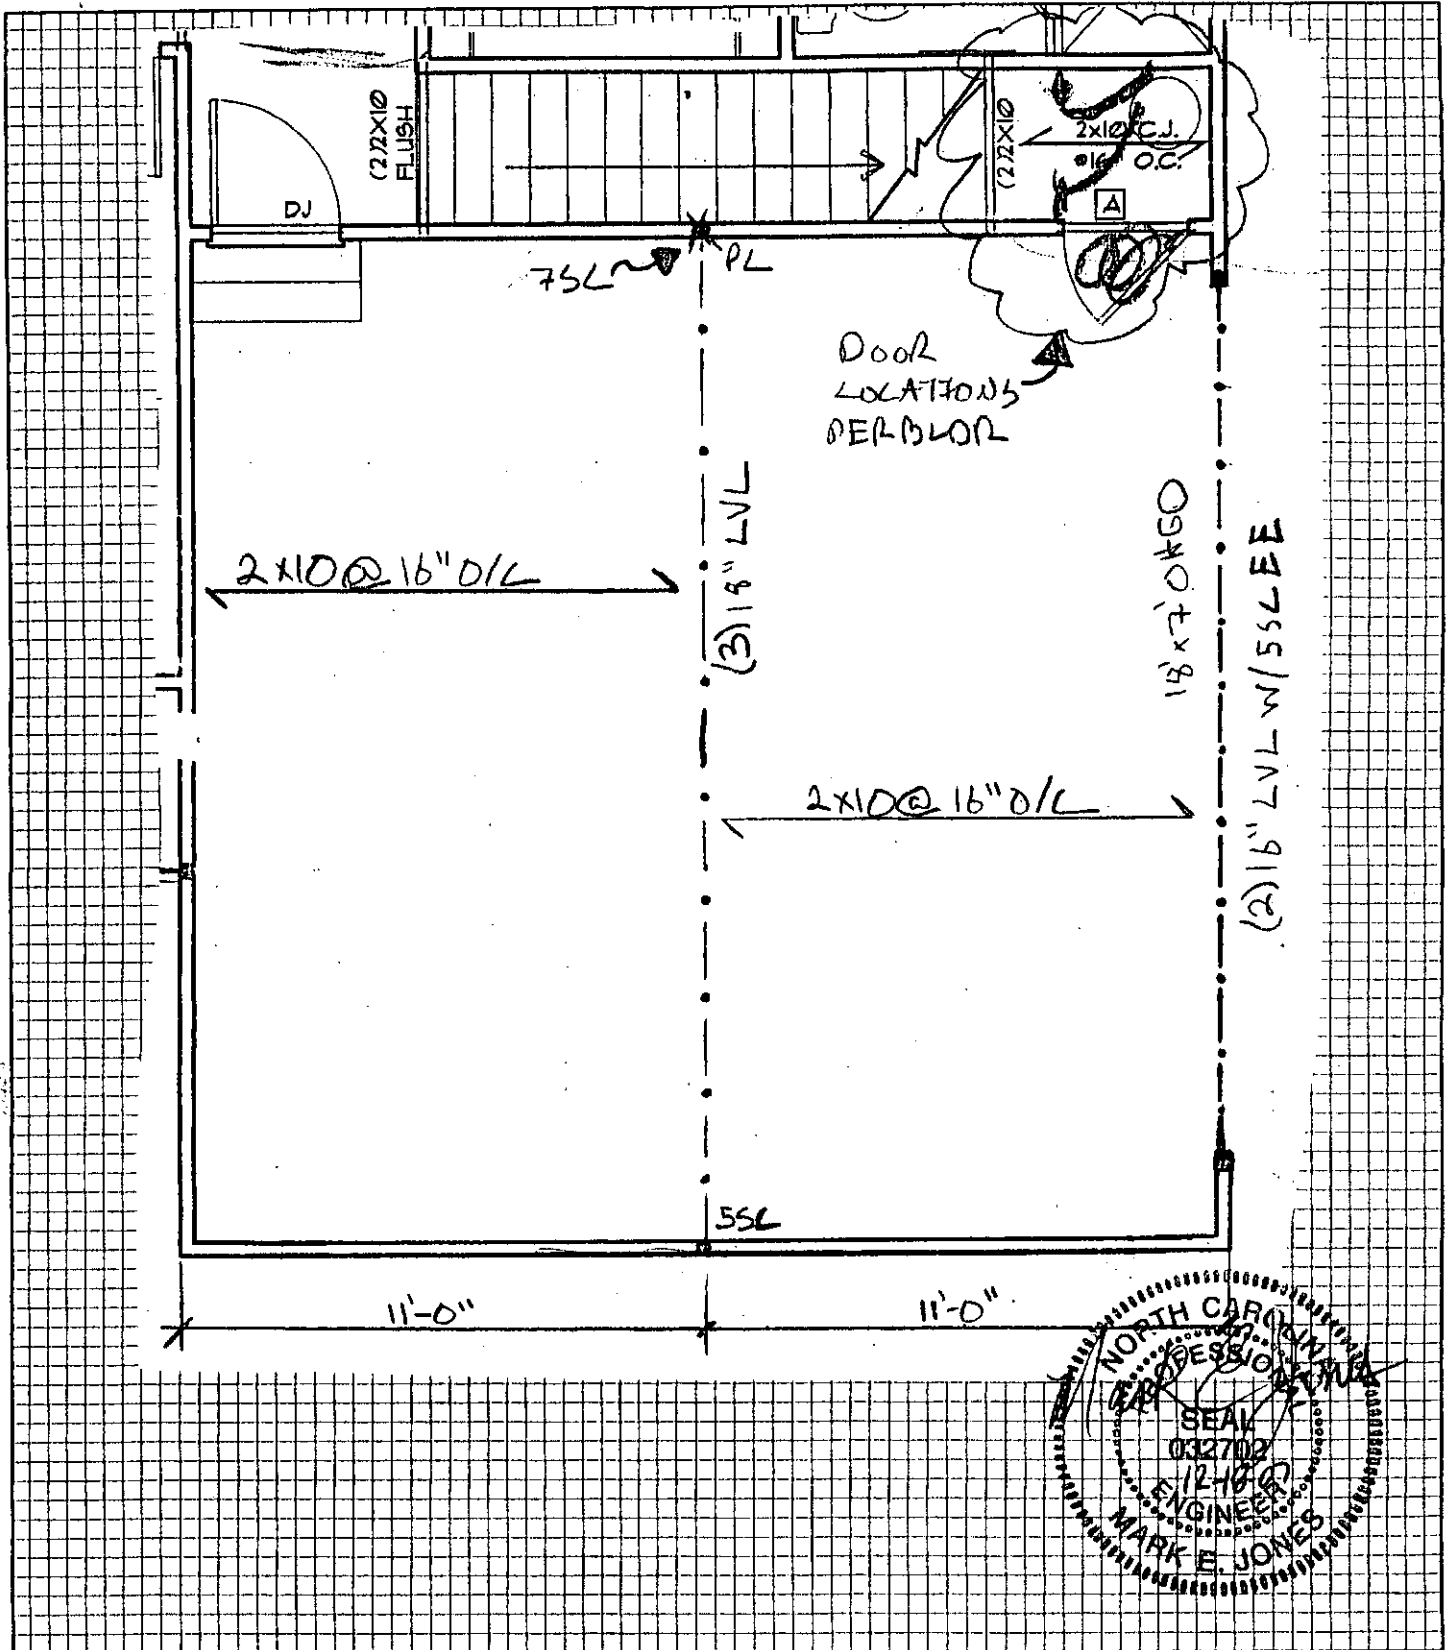

**Tyndall**  
**Engineering & Design, P.A.**  
 69 Shipwash Dr.  
 Garner, NC 27529  
 Phone: (919) 773-1200  
 Fax: (919) 773-0450

JOB 07AA-169  
 LOCATION GARAGE  
 CALCULATED BY AA DATE 12.18.07  
 SHEET NO. 3 OF 3  
 SCALE NTS