

Improvement Permit

A building permit cannot be issued with only an Improvement Permit

ISSUED TO: Weaver Dev. Corp PROPERTY LOCATION: 1141
 NEW REPAIR EXPANSION SUBDIVISION: The Summit LOT # 93
 Type of Structure: SFD-60x50 3BR Site Improvements required prior to Construction Authorization Issuance:
 Proposed Wastewater System Type: 25% Reduction sys.
 Projected Daily Flow: 360 GPD
 Number of bedrooms: 3 Number of Occupants: 6 max
 Basement Yes No
 Pump Required: Yes No May be required based on final location and elevations of facilities
 Type of Water Supply: Community Public Well Distance from well 100 feet Permit valid for: Five years
 Permit conditions: Meet on site for final layout maintain all set back No expiration
STUBOUT Plumbing shallow, at ground level or higher where shown
NOTE All Utilities to enter home from DRIVEWAY SIDE
 Authorized State Agent: J. W. AM Date: 07-14-08 SEE ATTACHED SITE SKETCH

The issuance of this permit by the Health Department in no way guarantees the issuance of other permits. The permit holder is responsible for checking with appropriate governing bodies in meeting their requirements. This site is subject to revocation if the site plan, plat, or the intended use changes. The Improvement Permit shall not be affected by a change in ownership of the site. This permit is subject to compliance with the provisions of the Laws and Rules for Sewage Treatment and Disposal and to conditions of this permit.

Construction Authorization

(Required for Building Permit)

The construction and installation requirements of Rules .1950, .1952, .1954, .1955, .1956, .1957, .1958, and .1959 are incorporated by references into this permit and shall be met. Systems shall be installed in accordance with the attached system layout.

ISSUED TO: Weaver Dev. Corp PROPERTY LOCATION: 1141
 Facility Type: SFD-60x50-3BR New Expansion Repair
 Basement? Yes No Basement Fixtures? Yes No
 Type of Wastewater System** 25% Reduction system (Initial) Wastewater Flow: 360 GPD
 (See note below, if applicable
25% Reduction system (Repair)

Installation Requirements/Conditions

Septic Tank Size <u>1000</u> gallons	Number of trenches <u>1</u>	
Pump Tank Size _____ gallons	Exact length of each trench <u>180</u> feet	Trench Spacing: <u>9</u> Feet on Center
	Trenches shall be installed on contour at a	Soil Cover: <u>6</u> inches
	Maximum Trench Depth of: <u>18.24</u> inches	(Maximum soil cover shall not exceed 36" above the trench bottom)
	(Trench bottoms shall be level to +/-1/4" in all directions)	
Pump Requirements: _____ ft. TDH vs. _____ GPM		Aggregate Depth: _____ inches below pipe
Conditions: _____		_____ inches above pipe
		_____ inches total

**If applicable: I understand the system type specified is different from the type specified on the application. I accept the specifications of this permit.

Owner/Legal Representative Signature: _____ Date: _____

This Construction Authorization is subject to revocation if the site plan, plat, or the intended use changes. The Construction Authorization shall not be transferred when there is a change in ownership of the site. This Construction Authorization is subject to compliance with the provisions of the Laws and Rules for Sewage Treatment and Disposal and to the conditions of this permit. SEE ATTACHED SITE SKETCH

Authorized State Agent: J. W. AM Date: 07.14.08
Construction Authorization Expiration Date: 07-14-2013


HTE# 08-500-19808RR

Permit # 24888

Harnett County Department of Public Health Site Sketch

ISSUED TO: Weaver Dev. Corp PROPERTY LOCATOR: 1141
SUBDIVISION: The Summit LOT # 93

Authorized State Agent: Ju Lars Date: 07-14-08

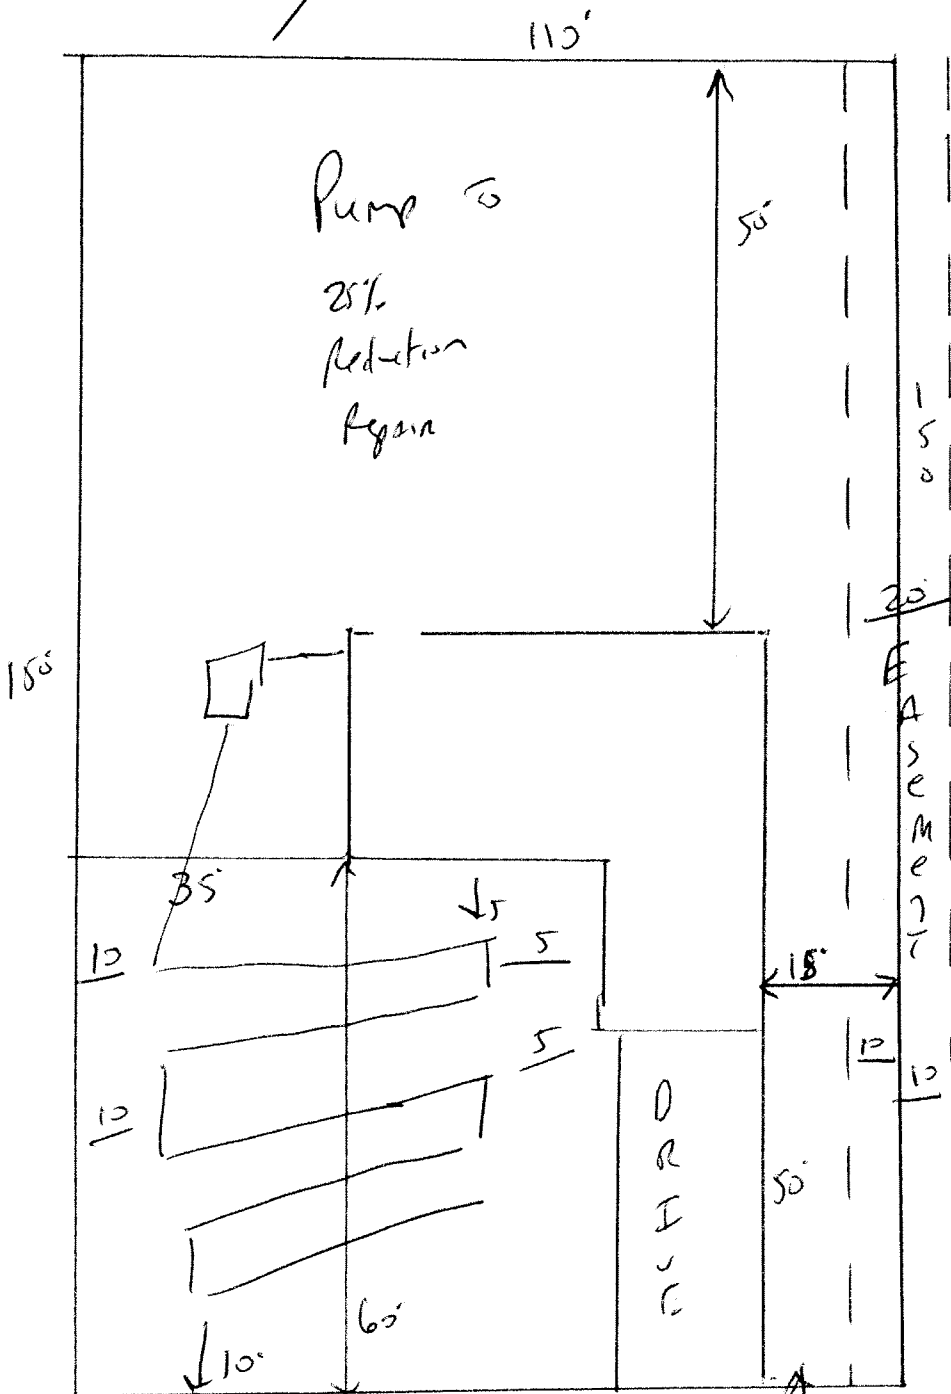

Meet on site for Final layout
 Maintain All Set Backs
 STUB out Plumbing shallow at ground level or higher where shown
 Install 180' of 25% Reduction system at 18" to 24" Deep.
 NOTE All utilities to Enter home on the DRIVEWAY side of the home.

NOTE All utilities to Enter Home from this side