

SOUTHEASTERN SOIL & ENVIRONMENTAL ASSOC., INC.
PROPOSED SUBSURFACE WASTE DISPOSAL SYSTEM DETAIL SHEET

SUBDIVISION Crestview LOT 186

INITIAL SYSTEM pump to gravelless REPAIR SYSTEM drip irrigation (no penetrant)

BENCHMARK ELEV. 100.0 LOCATION _____

TYPE OF DISTRIBUTION pump to D-box

LINE ELEVATION LENGTH FLAG COLOR

INITIAL SYSTEM
AS BUILT BELOW 2-3 ft file

	Length (ft)	Elev
1	20	102.17
2	40	101.33
3	45	100.75
4	20	99.84
5	85	98.75
6	85	98.08
7	85	97.67


repair elevations

320

BY M Eaker DATE 01/20/06

FLAG COLOR: Y = YELLOW R = RED W = WHITE B = BLUE O = ORANGE P = PINK

Note: No outbuildings, pools, etc allowed on this lot

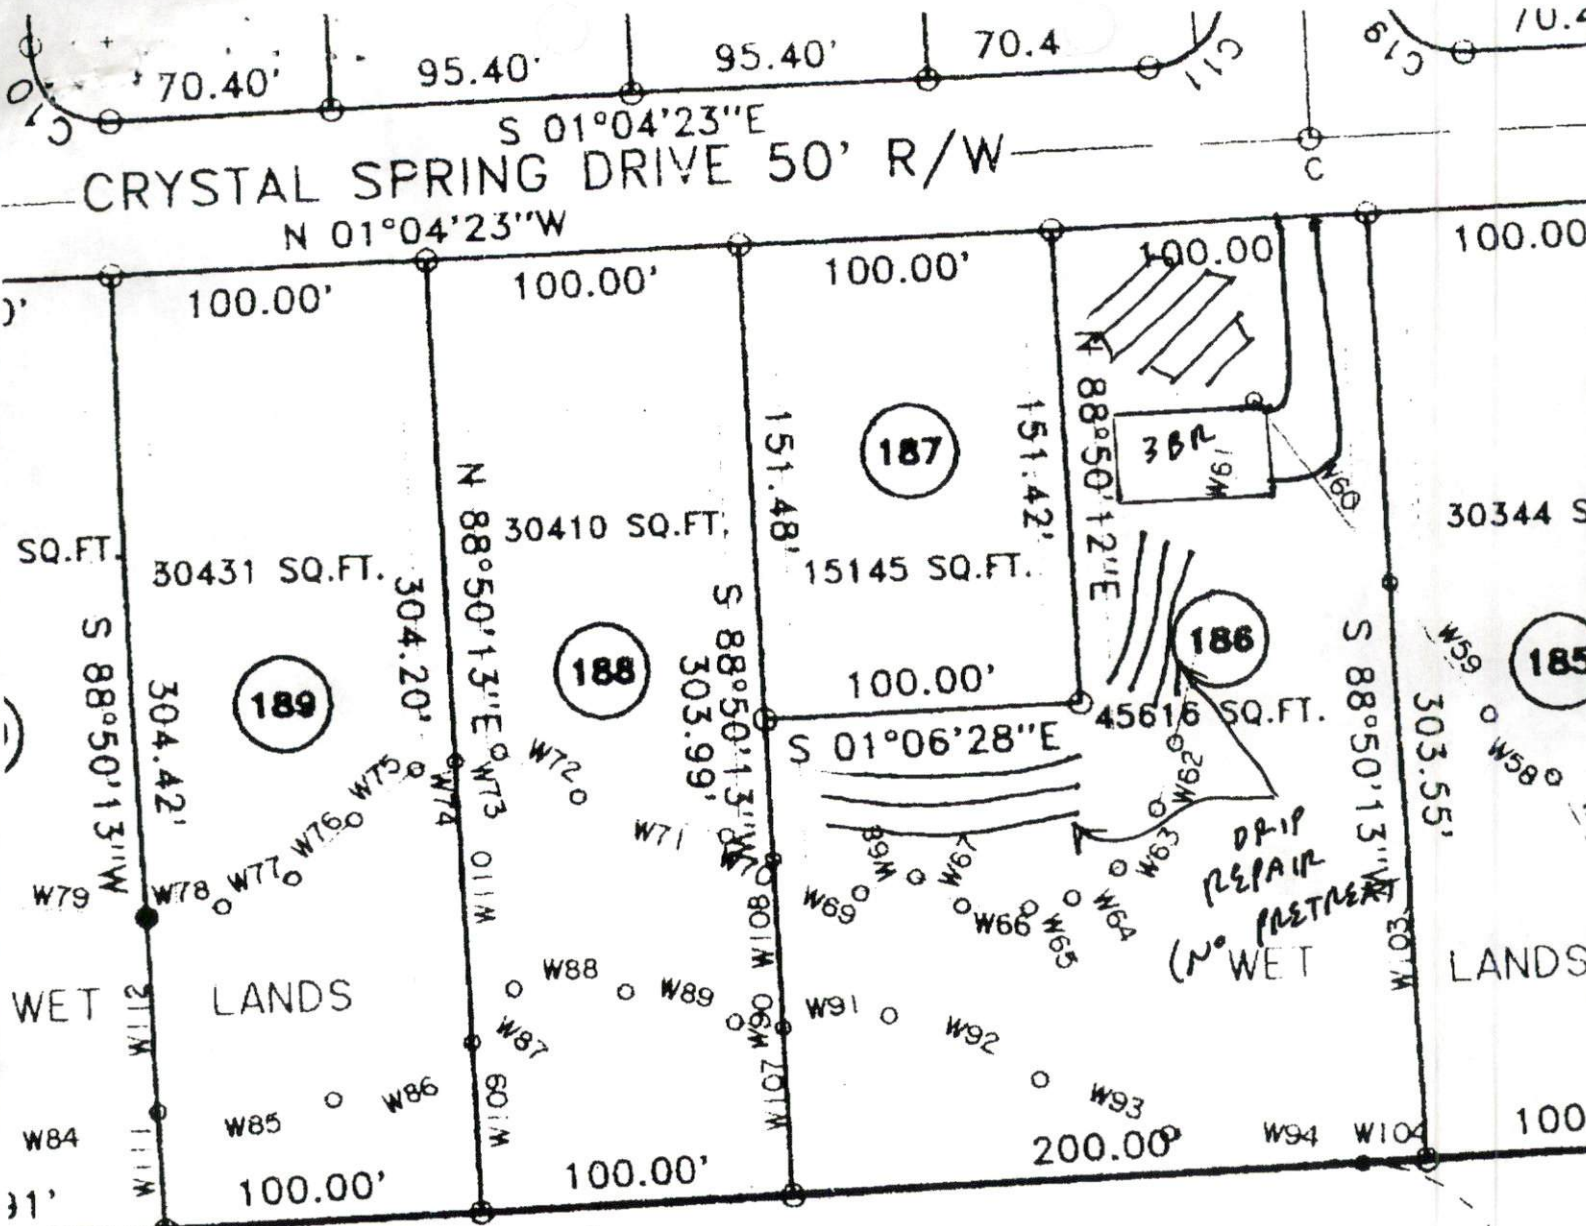

S 01°11'54"E
 PINE VALLEY LANE 50' R/W

PHASE 5

R M.HOWARD 89E/CUMB

... THAT THIS RECORD PLAT COMPLIES WITH