

Improvement Permit

A building permit cannot be issued with only an Improvement Permit

ISSUED TO: Wynn Const. PROPERTY LOCATION: 1115
 NEW REPAIR EXPANSION SUBDIVISION: Cameron Pines LOT # 3
 Type of Structure: SFD-37x40-3BR Site Improvements required prior to Construction Authorization Issuance:
 Proposed Wastewater System Type: Pump to 25% Reduction system
 Projected Daily Flow: 360 max GPD
 Number of bedrooms: 3 max Number of Occupants: 6 max
 Basement Yes No
 Pump Required: Yes No May be required based on final location and elevations of facilities
 Type of Water Supply: Community Public Well Distance from well 100 feet Permit valid for: Five years
 Permit conditions: meet onsite for final layout No expiration
Maintain All set BACK) Note where All utilities must enter The home

Authorized State Agent: J. W. ARS Date: 06-05-09 SEE ATTACHED SITE SKETCH
 The issuance of this permit by the Health Department in no way guarantees the issuance of other permits. The permit holder is responsible for checking with appropriate governing bodies in meeting their requirements. This site is subject to revocation if the site plan, plat, or the intended use changes. The Improvement Permit shall not be affected by a change in ownership of the site. This permit is subject to compliance with the provisions of the Laws and Rules for Sewage Treatment and Disposal and to conditions of this permit.

Construction Authorization

(Required for Building Permit)

The construction and installation requirements of Rules .1950, .1952, .1954, .1955, .1956, .1957, .1958, and .1959 are incorporated by references into this permit and shall be met. Systems shall be installed in accordance with the attached system layout.

ISSUED TO: Wynn Const. PROPERTY LOCATION: 1115
 SUBDIVISION: Cameron Pines LOT # 3
 Facility Type: SFD-37x40-3BR New Expansion Repair
 Basement? Yes No Basement Fixtures? Yes No
 Type of Wastewater System** Pump to 25% Reduction system (Initial) Wastewater Flow: 360 GPD
 (See note below, if applicable) Pump to 25% Reduction system (repair)

Installation Requirements/Conditions
 Septic Tank Size 1000 gallons
 Pump Tank Size 1000 gallons
 Number of trenches 1
 Exact length of each trench 180' feet
 Trench Spacing: 9 Feet on Center
 Trenches shall be installed on contour at a
 Maximum Trench Depth of: 18 inches
 (Trench bottoms shall be level to +/-1/4" in all directions)
 Soil Cover: 6 inches
 (Maximum soil cover shall not exceed 36" above the trench bottom)
 Pump Requirements: _____ ft. TDH vs. _____ GPM
 Aggregate Depth: _____ inches below pipe
 _____ inches above pipe
 _____ inches total
 Conditions: _____

**If applicable: I understand the system type specified is different from the type specified on the application. I accept the specifications of this permit.

Owner/Legal Representative Signature: _____ Date: _____

This Construction Authorization is subject to revocation if the site plan, plat, or the intended use changes. The Construction Authorization shall not be transferred when there is a change in ownership of the site. This Construction Authorization is subject to compliance with the provisions of the Laws and Rules for Sewage Treatment and Disposal and to the conditions of this permit. SEE ATTACHED SITE SKETCH

Authorized State Agent: J. W. ARS Date: 06-05-09
 Construction Authorization Expiration Date: 06-05-2013

HTE# 08-500-21231RR

Permit # 25506

Harnett County Department of Public Health Site Sketch

ISSUED TO: Wynn Coast. PROPERTY LOCATION: 1115
SUBDIVISION: Cameron Pine LOT # 3


Authorized State Agent: [Signature] Date: 06-05-09

Meet onsite for
Final Layout

MAINTAIN ALL SETBACKS
STUB OUT Plumbing
Where shown

Install 180' of 25%
Reduction system at
18"

NOTE All utilities to
enter the home from
The side of the home
Along Lot 3/Lot 4 Property
Line.

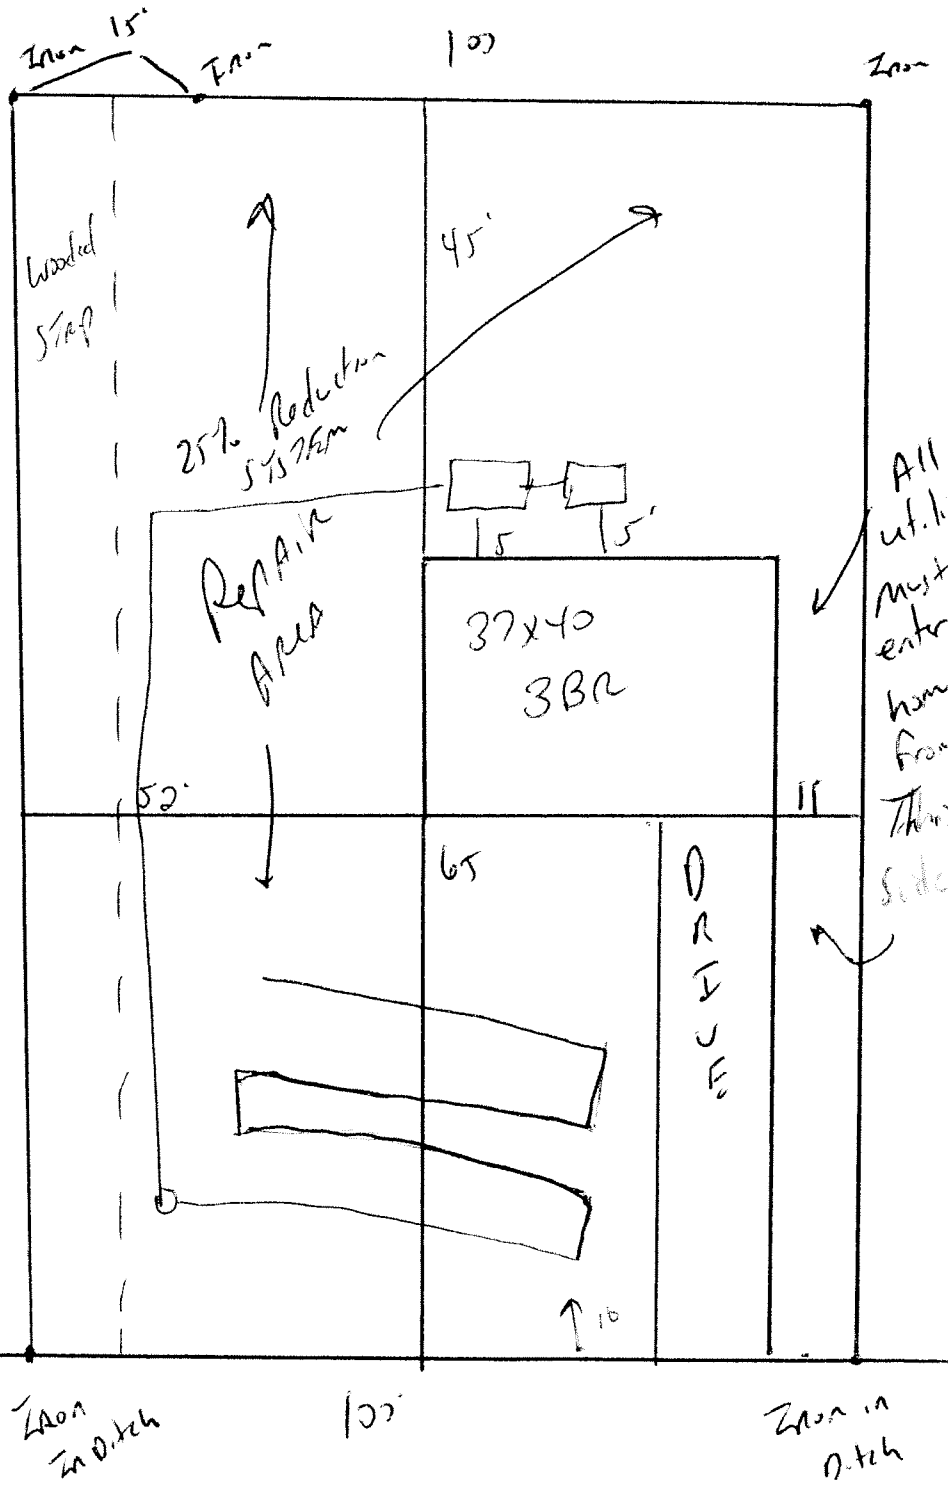

All ut. li. must enter here from this side