

PERMIT # 25450

Operation Permit

- New Installation
- Septic Tank
- Repair
- Nitrification Line
- Expansion

PROPERTY LOCATION: 311437 Balland RD

Name: (owner) Shelock Homes DM INC SUBDIVISION Revenstone SID LOT # 4

System Installer: Glen Carroll Registration # _____


Basement with plumbing: Garage Number of Bedrooms 3

Type of Water Supply: Community Public Well Distance from well _____ feet

System Type: 25% REDUCED-System Type G 6000 Types V and VI Systems expire in 5 years.

(In accordance with Table V a) Owner must contact Health Department 6 months prior to expiration for permit renewal.

This system has been installed in compliance with applicable North Carolina General Statutes, Rules for Sewage Treatment and Disposal, and all conditions of the Improvement Permit and Construction Authorization.

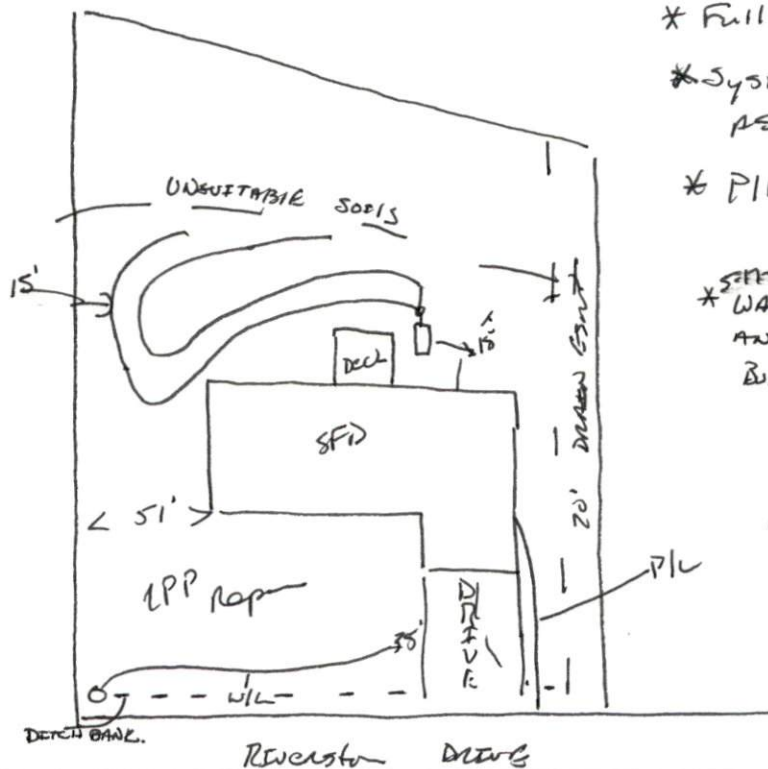

- * Full STORAGE
- * System installed AS permitted
- * P/L RUN ON INITIAL INSPECT.
- * ~~5000~~ WATER LINE WAS INSTALLED AND COVERED UP. HAD BUILDER UNCOVER ~~PIPE~~ LINE FROM METER TO HOME - DID NOT RUN DOWN DITCH W/L WAS IN partial repair area. IT WILL HAVE TO BE moved for repair

PERMIT CONDITIONS:

- I. Performance: System shall perform in accordance with Rule .1961.
- II. Monitoring: As required by Rule .1961.
- III. Maintenance: As required by Rule .1961. Other: _____
Subsurface system operator required? Yes No
If yes, see attached sheet for additional operation conditions, maintenance and reporting.
- IV. Operation: _____
- V. Other: _____

Following are the specifications for the sewage disposal system on the above captioned property.

Type of system: Conventional Other 25% REDUCED Septic Tank: 1000 gallons Pump Tank: _____ gallons
 Subsurface No. of exact length width of depth of
 Drainage Field ditches 2 of each ditch 120 feet ditches 3 feet ditches 30-18 inches
 French Drain Required: _____ Linear feet

Authorized State Agent Jane E. Mander Date 5-17-10