

HTE# 10-5-23765

Harnet. County Department of Public Health

21478

PERMIT # 25909

Operation Permit

New Installation Septic Tank Repair Nitrification Line Expansion

PROPERTY LOCATION: ADCOCK RD

Name: (owner) WYNN CONSTRUCTION SUBDIVISION PIONEER FARMS LOT # 11

System Installer: RANDY BATES Registration # _____

Basement with plumbing: Garage Number of Bedrooms 3


Type of Water Supply: Community Public Well Distance from well 100 feet

System Type: IIIb Types V and VI Systems expire in 5 years.

(In accordance with Table V a)

Owner must contact Health Department 6 months prior to expiration for permit renewal.

This system has been installed in compliance with applicable North Carolina General Statutes, Rules for Sewage Treatment and Disposal, and all conditions of the Improvement Permit and Construction Authorization.

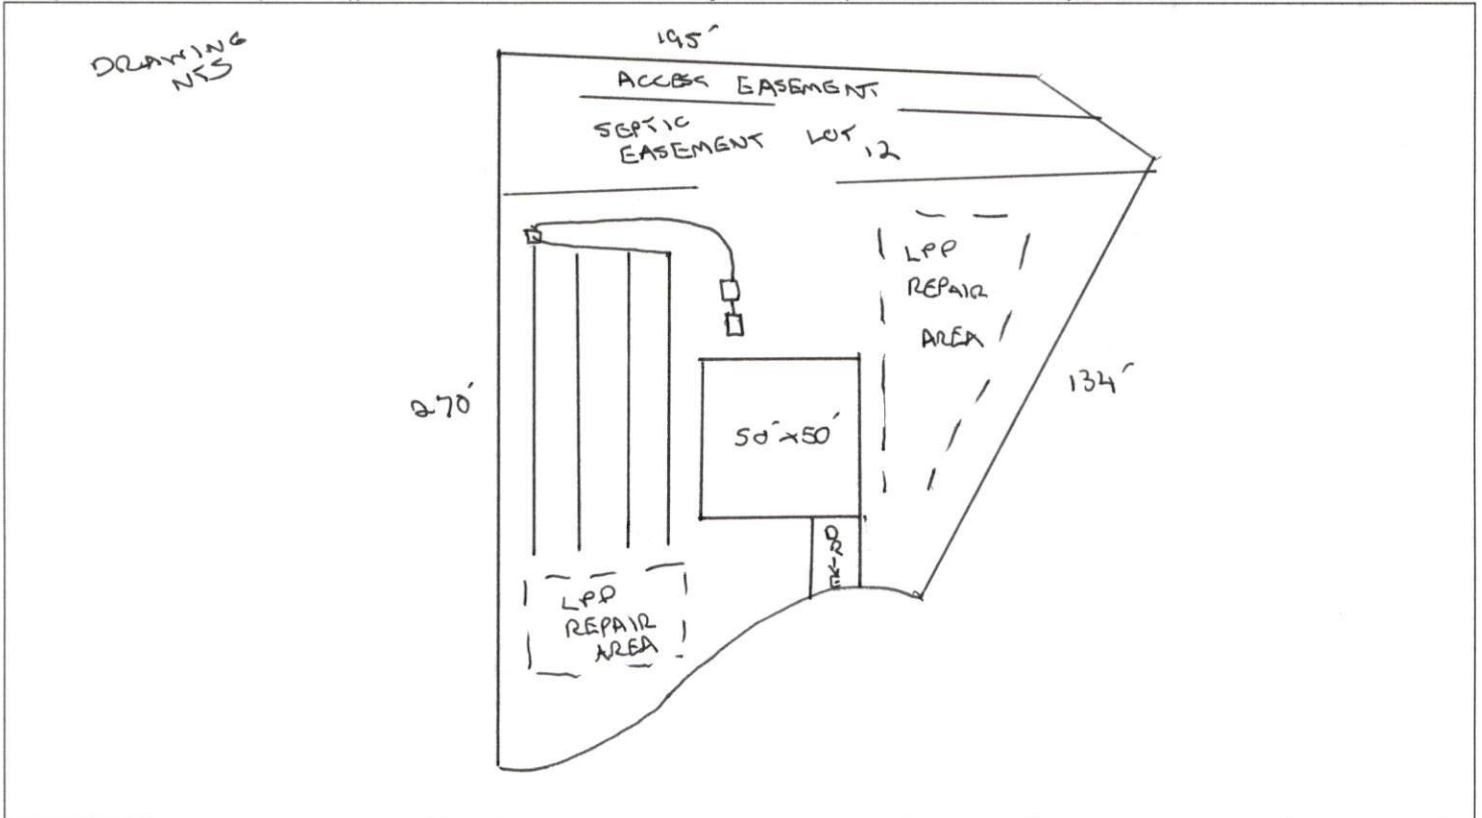

PERMIT CONDITIONS:

- I. Performance: System shall perform in accordance with Rule .1961.
- II. Monitoring: As required by Rule .1961.
- III. Maintenance: As required by Rule .1961. Other: _____
Subsurface system operator required? Yes No
If yes, see attached sheet for additional operation conditions, maintenance and reporting.
- IV. Operation: _____
- V. Other: PUMP, ALARM, & UTILITIES TO BE CHECKED

Following are the specifications for the sewage disposal system on the above captioned property.

Type of system: Conventional Other PUMP TO 2 CHAMBER Septic Tank: 1000 gallons Pump Tank: 1000 gallons
 Subsurface No. of exact length width of depth of
 Drainage Field ditches 4 of each ditch 85 feet ditches 3 feet ditches 18 inches
 French Drain Required: _____ Linear feet

Authorized State Agent [Signature] Date 7/6/2010