

PERMIT # 26060

Operation Permit

New Installation Septic Tank Repair Nitrification Line Expansion

PROPERTY LOCATION: 521448 ATKINS RD

Name: (owner) Comfort Homes INC SUBDIVISION STETSON LOT # 39

System Installer: Frank Bradberg Registration #

Basement with plumbing: Garage Number of Bedrooms 3

Type of Water Supply: Community Public Well Distance from well _____ feet


System Type: 25% REDUCTION System Type III @ 62 LAY Types V and VI Systems expire in 5 years.

(In accordance with Table V a)

Owner must contact Health Department 6 months prior to expiration for permit renewal.

This system has been installed in compliance with applicable North Carolina General Statutes, Rules for Sewage Treatment and Disposal, and all conditions of the Improvement Permit and Construction Authorization.

* System WAS INSTALLED AS CONSULTED upon.
* W/L + P/L were constructed.

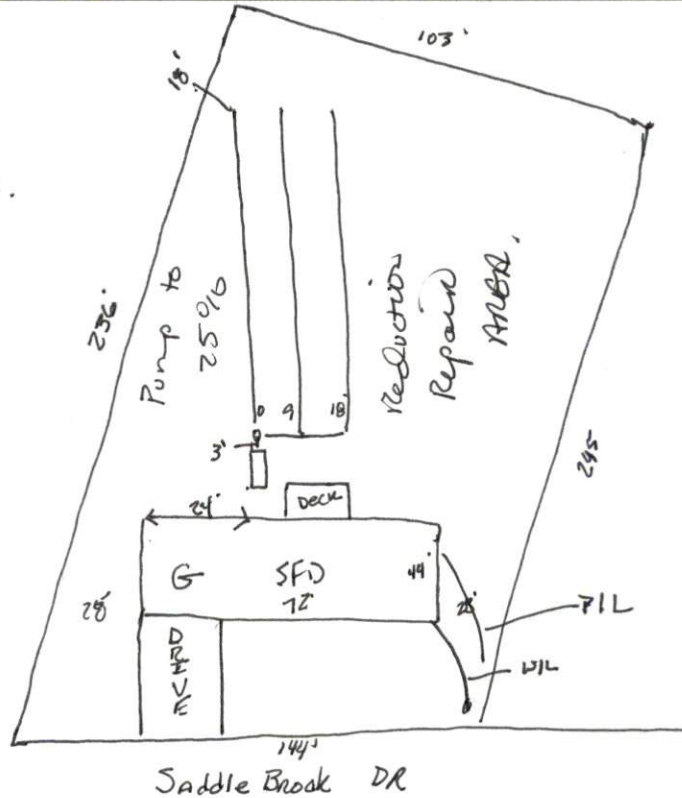

PERMIT CONDITIONS:

- I. Performance: System shall perform in accordance with Rule .1961.
- II. Monitoring: As required by Rule .1961.
- III. Maintenance: As required by Rule .1961. Other: _____
Subsurface system operator required? Yes No
If yes, see attached sheet for additional operation conditions, maintenance and reporting.
- IV. Operation: _____
- V. Other: _____

Following are the specifications for the sewage disposal system on the above captioned property.

Type of system: Conventional Other 25% REDUCTION SYSTEM Type III @ 62 LAY
Septic Tank: 1000 gallons Pump Tank: _____ gallons
Subsurface Drainage Field: No. of ditches 3 exact length of each ditch 80 feet width of ditches 3 feet depth of ditches 24 inches
French Drain Required: _____ Linear feet

Authorized State Agent James E. Manahan RBAS Date 9-2-10