

**SOIL/SITE EVALUATION  
 for ON-SITE WASTEWATER SYSTEM**

Owner:                      Applicant:  
 Address:                      Date Evaluated:  
 Proposed Facility: 2 BSO EORNS Design Flow (.1949): 480 gal Property Size:  
 Location of Site:                      Property Recorded:  
 Water Supply:                       Public  Individual  Well  Spring  Other  
 Evaluation Method:  Auger Boring  Pit  Cut  
 Type of Wastewater:  Sewage  Industrial Process  Mixed


P R O F I L E #	.1940 Landscape Position/ Slope %	Horizon Depth (In.)	SOIL MORPHOLOGY .1941		OTHER PROFILE FACTORS				Profile Class & LTAR
			.1941 Structure/ Texture	.1941 Consistence Mineralogy	.1942 Soil Wetness/ Color	.1943 Soil Depth (IN.)	.1956 Sapro Class	.1944 Restr Horiz	
1	LS 7-10	0-21	G S	VFA NS/VP					
		21-48	SBX SCL	FR SS/VP					PS .5
2		0-27	G S	VFA NS/VP					
		27-41	SBX SCL	FR SS/VP					PS .5
FOR FINAL REVISION									

Description	Initial System	Repair System	Other Factors (.1946): Site Classification (.1948): <u>PS</u> Evaluated By: <u>JS</u> Others Present: <u>  </u>
Available Space (.1945)	<u>  </u>	<u>  </u>	
System Type(s)	<u>  </u>	<u>  </u>	
Site LTAR	<u>.5</u>	<u>.5</u>	



MAP NO. 2012-551

MAP REFERENCE: MAP NO. 2012-551

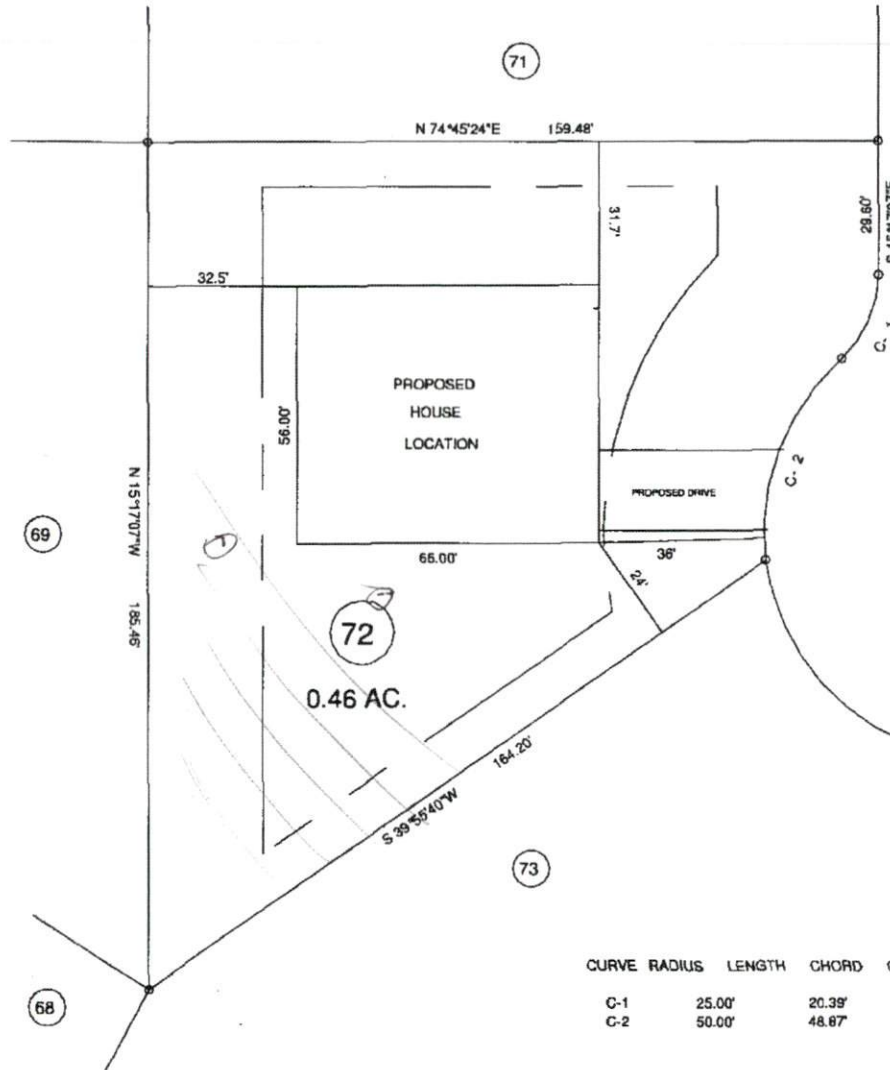

CURVE	RADIUS	LENGTH	CHORD	CH. BEARING
C-1	25.00'	20.39'	19.83'	S 08°04'16\"W
C-2	50.00'	48.87'	46.95'	S 05°38'01\"W

"BLACK DIAMOND CT." 50' RW

*REVISION*

SITE PLAN APPROVAL


DISTRICT ~~BARBECUE~~ USE ~~SFD~~

#BEDROOMS ~~4~~

1-11-13  
Date

Zoning Administrator

MINIMUM BUILDING SET BACKS  
 FRONT YARD — 30'  
 REAR YARD — 20'  
 SIDE YARD — 10'  
 CORNER LOT SIDE YARD — 30'  
 MAXIMUM HEIGHT — 35'

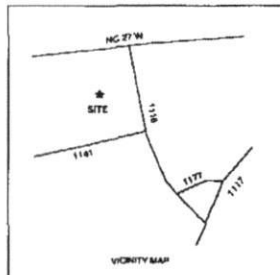


SURVEY FOR: PROPOSED PLOT PLAN - LOT - 72 TROTTER'S RIDGE S/D, PHASE-2-A		BENNETT SURVEYS 1662 CLARK RD., ULLINGTON, N.C. 27546 (910) 893-5252	
TOWNSHIP BARBECUE	COUNTY HARNETT	20' 0 40'	SURVEYED BY:
STATE: NORTH CAROLINA	DATE: DECEMBER 26, 2012	SCALE: 1"= 40'	DRAWN BY: RVB
ZONE RA 20R	WATERSHED DISTRICT	TAX PARCEL ID#	CHECKED & CLOSURE BY:
			FIELD BOOK DRAWING NO. 12446

480

80  
70  
60  
55  
50

90  
95

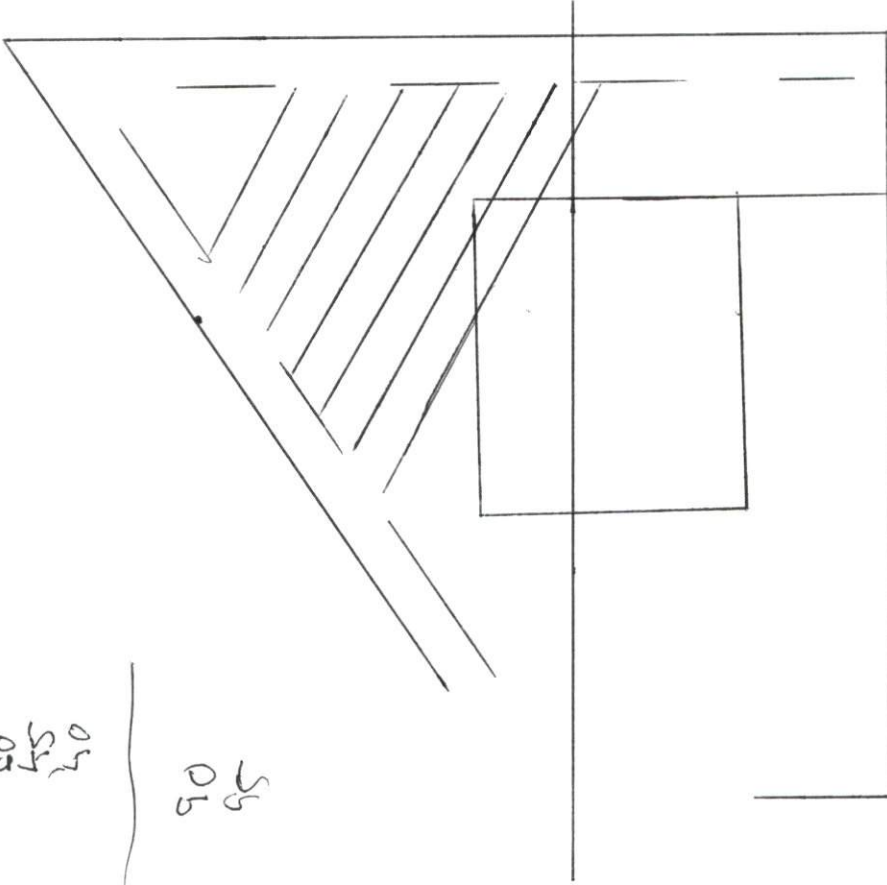

556

150  
100