
	L-LEHULE, DEUM CCSCU WILL LAND USE ABBL	
COUNTY OF H. Central Permitting 108 E. Front Street, Lillington, NC	27546 Phone: (910) 893-7525 ext:2	Fax: (910) 893-2793 www.harnett.org/permits
"A RECORDED SURVEY MAP, RECORDED DEED (OR OFF	ER TO PURCHASE) & SITE PLAN ARE REQUIRE	D WHEN SUBMITTING A LAND USE APPLICATION**
Callered C	Mailing Address: 6200 Ran	
City: Fayetteville State NC Zip.2	8311 Contact No. 910.401.5505 ext	226 Email: lauren.grhomes@gmail.com
APPLICANT*: Gary Robinson Homes, LLC M	ailing Address: U COO ICOO ISO	1 ST. SUICE ZUU
APPLICANT*: Gary Robinson Homes, LTC M  City: Fayetteville State: NC Zip: 2  *Please fill out applicant information if different than landowner	Contact No: 910,401,3303 ext 2	Email:
CONTACT NAME APPLYING IN OFFICE: Lauren Robinson		Phone #
PROPERTY LOCATION: Subdivision: 2014-89		Lot #: 1233 Lot Size: 5.93
State Road #State Road Name:JOS  Parcel:120555 00916 02  Zoning:	eu Williams Road	Map Book & Page: 2014 / 89
Parcel: 120555 00910 02	PIN: 0545-11-	1971
Zaring PAD K Flood Zone: V Watershed: NA	Deed Book & Page: 1973 / 0488	Power Company*:
*New structures with Progress Energy as service provider near		from Progress Energy.
New Structures with Progress Energy as service provider new		
PROPOSED USE:	107.4	. Monolithic
PROPOSED USE:	Basement(w/wo bath): Garage: [	Deck:   ☐ Crawl Space:  ☐ Slab:  ☐ Sla
(Is the bonus room finished? (	_) yes () no_w/ a closet? () yes (	_) no (if yes add in with # bedrooms)
☐ Mod: (Sizex) # Bedrooms # Baths	Basement (w/wo bath) Garage:\$	Site Built Deck: On Frame Off Frame
(Is the second floor finished? (	) yes () no Any other site built addit	dons? () yes () no
		(alta build? ) Doels (alta built? )
Manufactured Home:SWDWTW (Size	x) # Bedrooms: Garage:_	(site built/) Deck(site built//
□ Duplex: (Sizex) No. Buildings:	No. Bedrooms Per Unit:	_ <del>.</del>
□ Addition/Accessory/Other: (Sizex) Use:		Closets in addition? () yes () no
Water Supply:	dew Mell (# of dwollings using well	) *Must have operable water before final
Sewage Supply: V New Septic Tank (Complete Checkli.		
•		
Does owner of this tract of land, own land that contains a ma		of tract listed above
Does the property contain any easements whether undergro	1	- Other (mosth) Bally
Structures (existing or proposed): Single family dwellings:	Manufactured Homes:	Other (specify).
Required Residential Property Line Setbacks:	domments:	<u> </u>
Front Minimum 35 Actual 2013		
Rear 25 323.4		
Closest Side 10		
Sidestreet/corner lot 20		
Nearest Building		
on same lot Residential Land Use Application	Page 1 of 2	03/11

PECIFIC DIRECTIONS T	O THE PROPERTY FRO	M LILLINGTON:				
		<del></del>	·			·
	·					
			· ·		· · · · · · · · · · · · · · · · · · ·	
	<del>_</del> ,	·				
				<u> </u>		
				· · · · · · · · · · · · · · · · · · ·	<u>".                                      </u>	
				<u> </u>		
<del></del>	<del></del>	·				
				·	······································	
·						
permits are granted Lagre	e to conform to all arding	ances and laws of the State	-5 N - 40 - 6 - 12 - 1			
hereby state that foregoing	statements are accurate	and correct to the best of r	of North Carolina reg	julating such work ar	nd the specifications	of plans submitte
, otalio iliai /1/090  /	ODIOTICINA ACCUIATE	and correct to the pest of t	ny knowledge. Perm	iit subject to revocati	on if false informatio	n is provided.
				7112117	-	
<del></del>	Signature of Owns	er or Owner's Agent	<del></del>	110117	_	
	January Onlie	or Certion a Agenit		Date		
	\ /					

\*\*This application expires 6 months from the initial date if permits have not been issued\*\*

<sup>\*\*\*</sup>It is the owner/applicants responsibility to provide the county with any applicable information about the subject property, including but not limited to: boundary information, house location, underground or overhead easements, etc. The county or its employees are not responsible for any incorrect or missing information that is contained within these applications.\*\*\*

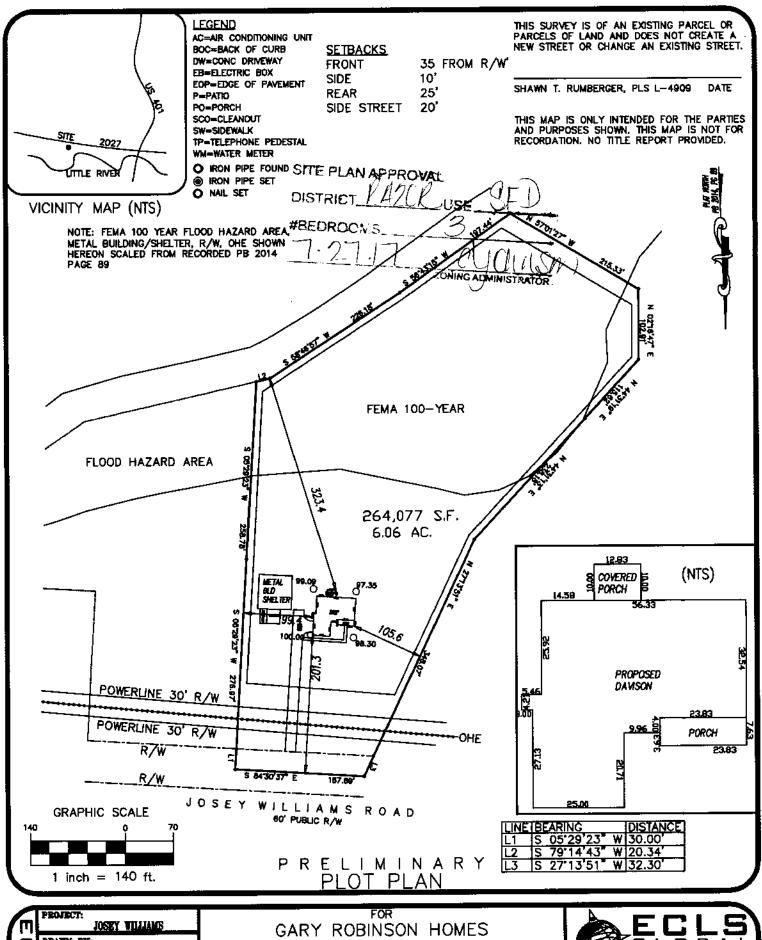

M	PROJECT: JOSEY VILLIAMS			
	DRAWN BY:	AMW		
<u> </u>	SCALE:	1"=140'		
(n	DATE:	07-26-17		

GARY ROBINSON HOMES

1233 JOSEY WILLIAMS ROAD
STEWARTS CREEK TWP., HARNETT CO., NC
P.B. 2014, PG. 89



910.897.2329 (FAX) 50#C-417

NAME:	APPLICATION #: 41930				
NAME:					
County Health I	*This application to be filled out when applying for a septic system inspection.*  County Health Department Application for Improvement Permit and/or Authorization to Construct				
FTHE INFORMATION PERMIT OR AUTHORIZ depending upon document 910-893-7525  Environmental F  All property lines must be Place "orange out buildings, Place orange If property is evaluation to All lots to be for failure to After preparin 800 (after sel confirmation is Use Click2Go Environmental F  Follow above Prepare for is possible) and ONOT LEAN After uncover if multiple pe given at end	Department Application for Improvement Permit and/or Authorization to Construct IN THIS APPLICATION IS FALSIFIED, CHANGED, OR THE SITE IS ALTERED, THEN THE IMPROVEMENT ATION TO CONSTRUCT SHALL BECOME INVALID. The permit is valid for either 60 months or without expiration ation submitted. (Complete site plan = 60 months; Complete plat = without expiration)				
SEPTIC					
	ation to construct please indicate desired system type(s): can be ranked in order of preference, must choose one.				
{}} Accepted	{} Innovative {} Conventional {\sum_X} Any				
.—,	() Other				
The applicant shall notify the local health department upon submittal of this application if any of the following apply to the property in question. If the answer is "yes", applicant MUST ATTACH SUPPORTING DOCUMENTATION:					
{_}}YES	Does the site contain any Jurisdictional Wetlands?				
$\{\_\}$ YES $\{X\}$ NO	Do you plan to have an irrigation system now or in the future?				
$\{\bot\}$ YES $\{X\}$ NO	Does or will the building contain any drains? Please explain				
()YES {X} NO	Are there any existing wells, springs, waterlines or Wastewater Systems on this property?				
$\{\_\}$ YES $\{X\}$ NO	Is any wastewater going to be generated on the site other than domestic sewage?				
$\{\_\}$ YES $\{X\}$ NO	Is the site subject to approval by any other Public Agency?				
$\{\bot\}$ YES $\{X\}$ NO	Are there any Easements or Right of Ways on this property?				
(_)YES (X) NO	Does the site contain any existing water, cable, phone or underground electric lines?				
(	If yes please call No Cuts at 800-632-4949 to locate the lines. This is a free service.				
I Have Read This Applie	cation And Certify That The Information Provided Herein Is True, Complete And Correct. Authorized County And				
	State Officials Are Granted Right Of Entry To Conduct Necessary Inspections To Determine Compliance With Applicable Laws And Rules.				
I Understand That I Am Solely Responsible For The Proper Identification And Labeling Of All Property Lines And Corners And Making					
	hat A Complete Site Evaluation Can Be Performed.				

PROPERTY OWNERS OF OWNERS LEGAL REPRESENTATIVE SIGNATURE (REQUIRED)

10/10