

IMPROVEMENT PERMIT

01-5-1305

Be it ordained by the Harnett County Board of Health as follows: Section III, Item B. "No Person shall begin construction of any building at which a septic tank system is to be used for disposal of sewage without first obtaining a written permit from the Harnett County Health Department."

Name: (owner) BASS B.H. Homes
Property Location: SR# 1120
New Installation, Septic Tank, Repairs, Nitrification Line

Subdivision STONE CROSS Lot # 55

Tax ID # Quadrant #

Number of Bedrooms Proposed: 4 (50x58) Lot Size: .4 AC

Basement with Plumbing: Garage:

Water Supply: Well, Public, Community

Distance From Well: 50 ft.

Following is the minimum specifications for sewage disposal system on above captioned property. Subject to final approval.

Type of system: Conventional, Other

Size of tank: Septic Tank: 1000 gallons Pump Tank: gallons


Subsurface Drainage Field No. of ditches 1 exact length 280 ft. width of 3 ft. depth of 18-24 in.

French Drain Required: Linear feet

Date: 02-27-01

Signed: Joe [Signature] Environmental Health Specialist

This permit is subject to revocation if site plans or intended use change.

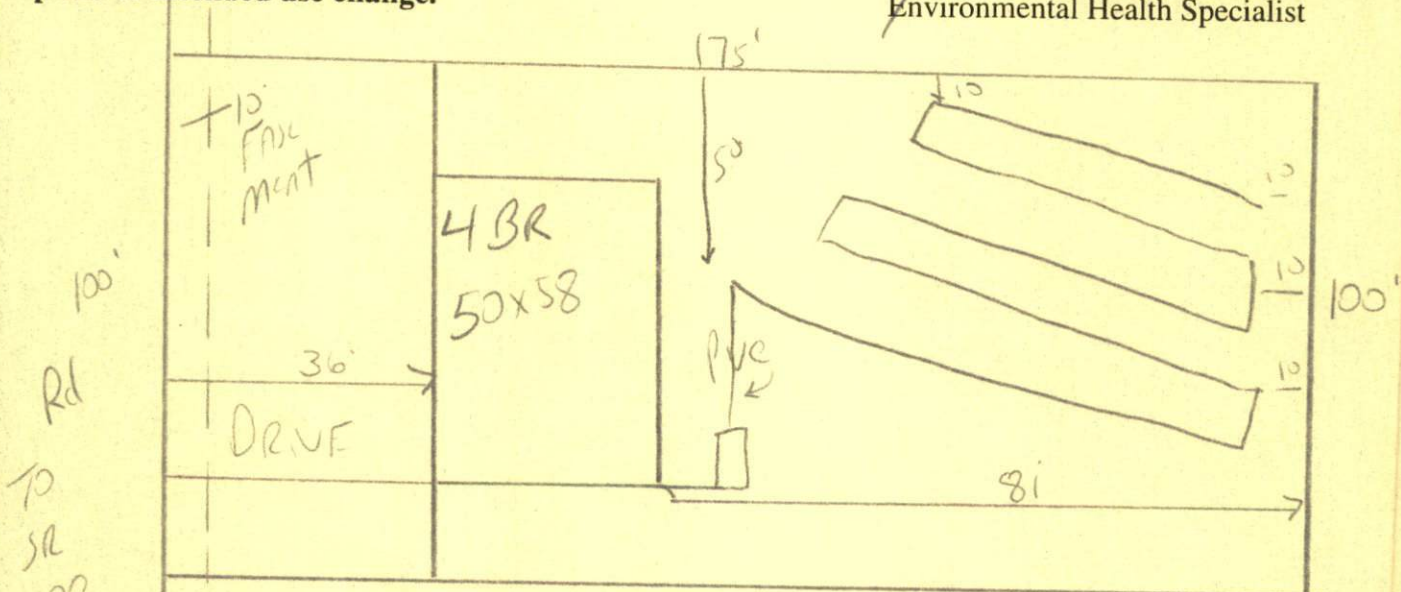

STUB out Plumbing shallow 18" depth 175' Depth, maintain All set Back Do not Drive or Park on septic system

HARNETT COUNTY HEALTH DEPARTMENT
AUTHORIZATION TO CONSTRUCT

Authorization is hereby given to construct a wastewater system to the specifications described by Harnett County Health Department Improvement Permit # 17637. This authorization shall be valid for a period not to exceed five (5) years from the date of issuance. This authorization will be invalid if ownership, site plans, or intended use change.

Owner or Authorized Agent BAS Built Homes Inc.

Name: _____ Telephone # 864-1253

Address: _____

Property Location: SR # 1120 Road Name _____

New Installation Repair Septic Tank Nitrification Lines

Subdivision STONE CROSS Lot # 55

Number of Bedrooms Proposed: 4 (50x58) Lot size: 4 AC

Basement With Plumbing Without Plumbing

Water Supply: Well Public Minimum Well Setback: _____ ft.

Type of System: Conventional Other

Tank Volume: Septic Tank 1000 gallons Pump Chamber _____ gallons

Nitrification Field Specifications

Number of fields 1 Number of Lines per Field 1 Length of lines 200

Width of ditches 3 ft. Depth of ditches 18 inches

French Drain: Linear feet required _____ Depth of gravel _____

No wastewater system shall be covered or placed into use by any person until an inspection by the Harnett County Health Department has determined that the system has been installed according to the conditions of the improvement permit and that a valid operations permit has been issued.

Authorized Agent for Harnett County Health Department
Name: [Signature] Date: 02-28-01

(Revised 2/96)CNSTRCT.WPD