
2-21-03
Initial Application Date 25-03  240 Replication # On K Replication #
COUNTY OF HARNETT LAND USE APPLICATION  Control Permitting 102 E Front Street, Lillington, NC 27546 Phone: (910) 893-4759 Fax: (910) 893-2793
Central retinating
LANDOWNER: Cleribertand Horres Mailing Address: PUBEX 727 City: Western State: 1 Zip: 28335 Phone #: 910-892-9345
APPLICANT: National Mailing Address: PUBUX 727  City: Deem State: 1 Zip: 08335 Phone #: 810-882-4345
PROPERTY LOCATION: SR #: //S SR Name: Bey Jalo Salo Rd - Parcel: U3-9587-U6-W20  Pancel: U3-9587-U6-W20  Zoning: CAUR Subdivision: Doc ht 100 Plan Subdivision: D
DIRECTIONS TO THE PROPERTY FROM LILLINGTON: Teen last on Geoffals Rake Ro. Jeun Reft into Penchties Rot or Ribbon Oak Court.
0
PROPOSED USE:  Sg. Family Dwelling (Size 50 x 28) # of Bedrooms 3 # Baths 22 Basement (w/wo bath) Garage 2012 4 Deck 1621/6  Multi-Family Dwelling No. Units No. Bedrooms/Unit Deck 1621/6  Manufactured Home (Size x ) # of Bedrooms Garage Deck
Comments:  Number of persons per household  Y
Business Sq. Ft. Retail Space Type
□ Industry Sq. Ft Type
Home Occupation (Size x ) #Rooms Use
Accessory Building (Size x ) Use
Addition to Existing Building (Size x ) Use
Other
Water Supply: ( ) Well (No. dwellings) ( ) Other
Sewage Supply: Wew Septic Tank ( ) Existing Septic Tank ( ) County Sewer ( ) Other
Erosion & Sedimentation Control Plan Required? YES NO
Structures on this tract of land: Single family dwellings Manufactured homes Other (specify)
Property owner of this tract of land own land that contains a manufactured from tw/in five hundred feet (500') of tract listed above?  YES NO
Required Property Line Setbacks: Minimum Actual Minimum Actual
Front 35 45 Rear 35 70285
32)
-/1 -
Nearest Building
If permits are granted I agree to conform to all ordinances and the laws of the State of North Carolina regulating such work and the specifications or plans submitted. I
hereby swear that the foregoing statements are accurate and correct to the best of my knowledge.
elanz Norris 2-26-03
Signature of Applicant Date

\*\*This application expires 6 months from the date issued if no permits have been issued \*\*

A RECORDED SURVEY PLAT AND RECORDED DEED ARE REQUIRED WHEN APPLYING FOR A LAND USE PERMIT

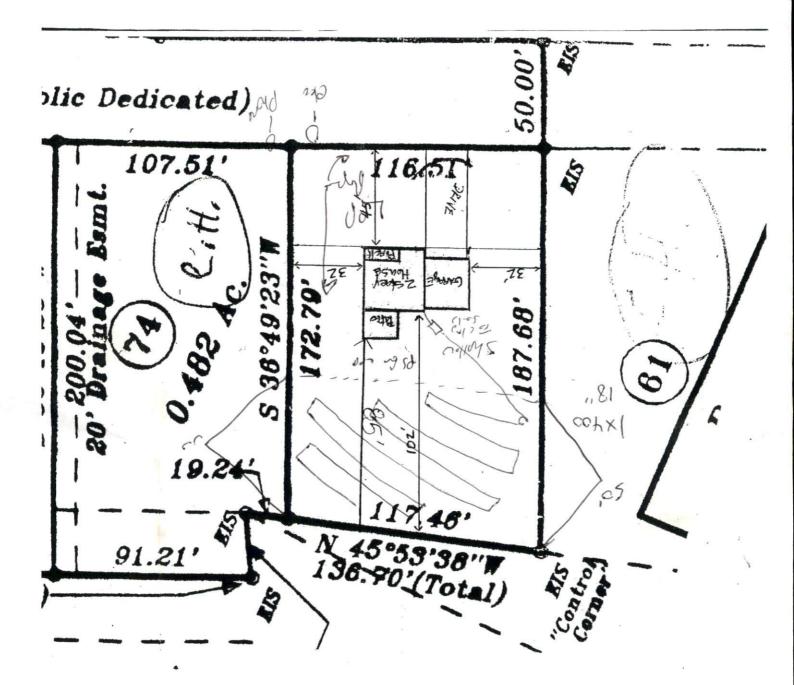

TAVORAGA MAJE BITIES TO SMOORE BROOFIES TO SMOORE B

LUM HOND HONES TENERS