

**Harnett County Central Permitting**

PO Box 65 Lillington, NC 27546 - Ph: 910-893-7525 - Fx: 910-893-2793 - www.harnett.org/permits

**Certification of Work Performed By Owner/Contractor**

(Individual Trade Application)

Owner (s) of Structure: Buddy Miller Phone: 910-892-4551

Owner (s) Mailing Address: 401 E Jackson Blvd.  
Erwin, N.C. 28339

Land Owner Name (s): Buddy Miller Phone: \_\_\_\_\_

Construction or Site Address: 401 E. Jackson Blvd.

PIN # \_\_\_\_\_ Parcel # \_\_\_\_\_

Job Cost: 500.00 Description of Work to be done: Re-install existing 400 Amp Service

Mechanical: New Unit With Ductwork \_\_\_ New Unit Without Ductwork \_\_\_ Gas Piping \_\_\_ Other \_\_\_

Electrical\*: 200 Amp \_\_\_ <200 Amp \_\_\_ Service Change \_\_\_ Service Reconnect \_\_\_ Other    
\* For Progress Energy customers we need the premise number

Plumbing: Water/Sewer Tap \_\_\_ Number of Baths \_\_\_ Water Heater \_\_\_

Specific Directions to Job from Lillington: 1

Subdivision: \_\_\_\_\_ Lot #: \_\_\_\_\_

I Bobby Williams will provide the Elec. labor on this structure.   
(Contractors Name) (Trade)

I am the building owner or my NC state license number is 16588U, which entitles me to perform such work on the above structure legally. All work shall comply with the State Building Code and all other applicable State and local laws, ordinances and regulations.

Bobby Williams Elec. Co.  
Contractor's Company Name  
805 South Washington Ave.  
Address  
16588U  
License #

910-308-0525  
Telephone  
bwmselect@gmail.com  
Email Address

Structure Owner / Contractor Signature: Buddy L. Miller Date: 5-29-19

By signing this application you affirm that you have obtained permission from the above listed license holder to purchase permits on their behalf. If doing the work as owner you understand that you cannot rent, lease or sell the listed property for 12 months after completion of the listed work.

**\*Company name, address, & phone must match information on license**



# Zoning Application & Permit

Planning & Inspections Department

Permit #

Rev Sep 2014

Each application should be submitted with an attached plot/site plan with the proposed use/structure showing lot shape, existing and proposed buildings, parking and loading areas, access drives and front, rear, and side yard dimensions.

Name of Applicant	Bobby Williams	Property Owner	Buddy Miller
Home Address	805 S. Washington Ave	Home Address	401 E. Jackson Blvd
City, State, Zip	Dunn 28334	City, State, Zip	Farmville
Telephone	910-308-0595	Telephone	910-892-4551
Email	bwilliams@comcast.com	Email	

Address of Proposed Property	401 E. Jackson Blvd		
Parcel Identification Number(s) (PIN)		Estimated Project Cost	400.00
What is the applicant requesting to build / what is the proposed use of the subject property? Be specific.	Storage 1,512 SF Building		
Description of any proposed improvements to the building or property	None		
What was the Previous Use of the subject property?	NA		
Does the Property Access DOT road?	Yes		
Number of dwelling/structures on the property already		Property/Parcel size	
Floodplain SFHA Yes No	Watershed Yes No	Wetlands Yes No	
<b>MUST</b> circle one that applies to property			
Existing/Proposed Septic System		Or	
Existing/Proposed County/City Sewer			

### Owner/Applicant Must Read and Sign

The undersigned property owner, or duly authorized agent/representative thereof certifies that this application and the forgoing answers, statements, and other information herewith submitted are in all respects true and correct to the best of their knowledge and belief. The undersigning party understands that any incorrect information submitted may result in the revocation of this application. Upon issuance of this permit, the undersigning party agrees to conform to all applicable town ordinances, zoning regulations, and the laws of the State of North Carolina regulating such work and to the specifications of plans herein submitted. The undersigning party authorizes the Town of Erwin to review this request and conduct a site inspection to ensure compliance to this application as approved.

Print Name	Bobby Williams	Signature of Owner or Representative	Bobby Williams	Date	5-24-19
------------	----------------	--------------------------------------	----------------	------	---------


### For Office Use

Zoning District	B3a	Existing Nonconforming Uses or Features	
Front Yard Setback		Other Permits Required	Conditional Use Building Fire Marshal <input checked="" type="checkbox"/> Other
Side Yard Setback		Requires Town Zoning Inspection(s)	Foundation Prior to C. of O.
Rear Yard Setback		Zoning Permit Status	<input checked="" type="checkbox"/> Approved Denied
Fee Paid: -		Date Paid: -	Staff Initials: -

Comments	- need electrical permit for storage build
----------	--

Signature of Town Representative:	Erin Boyd	Date Approved/Denied:	5/28/19
-----------------------------------	-----------	-----------------------	---------


This storage building was approved as a part of the original site plan approved already and paid for original site plan

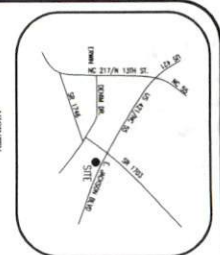

**NOTES**

THIS MAP IS NOT FOR RECORDATION, CONFORMANCE, OR SALES.

PROPERTY FROM U.S. ROAD RIGHTS OF WAY (ROW) AND ADJACENT PROPERTIES TO BE DELETED FROM THIS PLAN. THESE ARE: 1. 41ST STREET (60' PUBLIC ROW) 2. 42ND STREET (60' PUBLIC ROW) 3. 43RD STREET (60' PUBLIC ROW) 4. 44TH STREET (60' PUBLIC ROW) 5. 45TH STREET (60' PUBLIC ROW) 6. 46TH STREET (60' PUBLIC ROW) 7. 47TH STREET (60' PUBLIC ROW) 8. 48TH STREET (60' PUBLIC ROW) 9. 49TH STREET (60' PUBLIC ROW) 10. 50TH STREET (60' PUBLIC ROW) 11. 51ST STREET (60' PUBLIC ROW) 12. 52ND STREET (60' PUBLIC ROW) 13. 53RD STREET (60' PUBLIC ROW) 14. 54TH STREET (60' PUBLIC ROW) 15. 55TH STREET (60' PUBLIC ROW) 16. 56TH STREET (60' PUBLIC ROW) 17. 57TH STREET (60' PUBLIC ROW) 18. 58TH STREET (60' PUBLIC ROW) 19. 59TH STREET (60' PUBLIC ROW) 20. 60TH STREET (60' PUBLIC ROW) 21. 61ST STREET (60' PUBLIC ROW) 22. 62ND STREET (60' PUBLIC ROW) 23. 63RD STREET (60' PUBLIC ROW) 24. 64TH STREET (60' PUBLIC ROW) 25. 65TH STREET (60' PUBLIC ROW) 26. 66TH STREET (60' PUBLIC ROW) 27. 67TH STREET (60' PUBLIC ROW) 28. 68TH STREET (60' PUBLIC ROW) 29. 69TH STREET (60' PUBLIC ROW) 30. 70TH STREET (60' PUBLIC ROW) 31. 71ST STREET (60' PUBLIC ROW) 32. 72ND STREET (60' PUBLIC ROW) 33. 73RD STREET (60' PUBLIC ROW) 34. 74TH STREET (60' PUBLIC ROW) 35. 75TH STREET (60' PUBLIC ROW) 36. 76TH STREET (60' PUBLIC ROW) 37. 77TH STREET (60' PUBLIC ROW) 38. 78TH STREET (60' PUBLIC ROW) 39. 79TH STREET (60' PUBLIC ROW) 40. 80TH STREET (60' PUBLIC ROW) 41. 81ST STREET (60' PUBLIC ROW) 42. 82ND STREET (60' PUBLIC ROW) 43. 83RD STREET (60' PUBLIC ROW) 44. 84TH STREET (60' PUBLIC ROW) 45. 85TH STREET (60' PUBLIC ROW) 46. 86TH STREET (60' PUBLIC ROW) 47. 87TH STREET (60' PUBLIC ROW) 48. 88TH STREET (60' PUBLIC ROW) 49. 89TH STREET (60' PUBLIC ROW) 50. 90TH STREET (60' PUBLIC ROW) 51. 91ST STREET (60' PUBLIC ROW) 52. 92ND STREET (60' PUBLIC ROW) 53. 93RD STREET (60' PUBLIC ROW) 54. 94TH STREET (60' PUBLIC ROW) 55. 95TH STREET (60' PUBLIC ROW) 56. 96TH STREET (60' PUBLIC ROW) 57. 97TH STREET (60' PUBLIC ROW) 58. 98TH STREET (60' PUBLIC ROW) 59. 99TH STREET (60' PUBLIC ROW) 60. 100TH STREET (60' PUBLIC ROW)

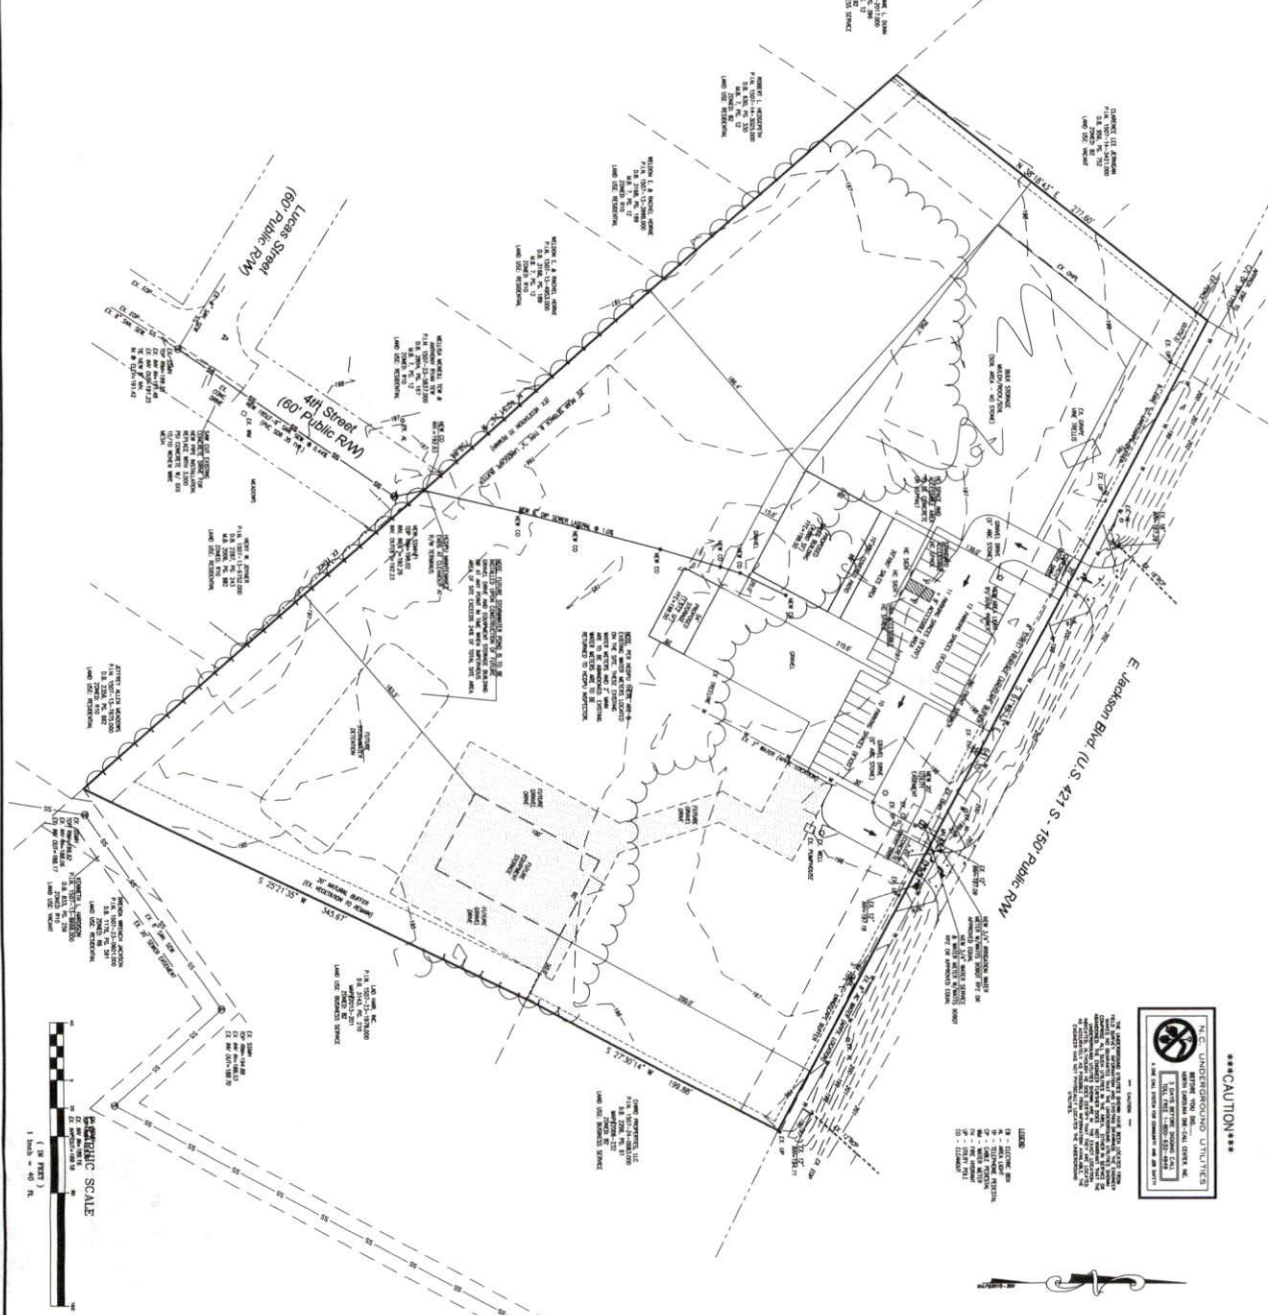

**CAUTION**

UNDERGROUND UTILITIES

ALL UTILITIES SHOWN ON THIS PLAN ARE BASED ON RECORD DRAWINGS AND FIELD SURVEY DATA. THE LOCATION AND DEPTH OF UTILITIES MAY VARY FROM THE SHOWN INFORMATION. ANY UNIDENTIFIED UTILITIES SHOULD BE LOCATED AND DEPTHS DETERMINED PRIOR TO ANY CONSTRUCTION.

**S-1**

**WATER/SEWER AS-BUILT SITE & UTILITY PLAN**

FOR MILLER'S LAWN & LANDSCAPING

LOCATION  
US 421  
ERWIN NC  
DUKE TOWNSHIP  
HARRIS COUNTY, NC

PROPERTY OWNERS:  
MILLER'S LAWN & LANDSCAPING, INC.  
P.O. BOX 248  
DUNN, NC 28535

Revisions	PLAN INFORMATION
02-02-2016: DRIVEWAY PERMIT SUBMITTAL	DRAWN BY: E.L.P.
05-09-2016	DESIGNED BY: C.E.P.
07-06-2016: TRC COMMENTS	CHECKED BY: FT
07-27-2016: TRC COMMENTS	DATE CREATED: 07-02-2015
10-22-2016: BLDG/SEWER REVISION	SURVEY INFORMATION
01-20-2019: WATER/SEWER AS-BUILT	

HORIZONTAL SCALE: 1" = 40'

VERTICAL SCALE: FT

**Enoch Engineers, P.A.**

CONSULTING ENGINEERS & SURVEYORS

160 NC Highway 79 South - Raleigh, NC 27604  
Phone: (919) 894-7765 Fax: (919) 894-8199  
E-mail: enoch@enocheengineers.com  
NC Firm License #2005