

# HARPER'S MEADOW SITE DEVELOPMENT PLANS



**VICINITY MAP**  
**NOT TO SCALE**

## EXISTING UTILITY OWNER

### SEWER

LILLINGTON PUBLIC WORKS DEPARTMENT  
PO Box 296  
Lillington, North Carolina 27546  
910-893-0314  
Contact: Shane Cummings, PE

### WATER

HARNETT REGIONAL WATER  
700 McKinney Parkway  
Lillington, North Carolina 27546  
910-893-7575  
Contact: Glenn McFadden

SOURCE OF TITLE  
DB 4177, PG 1478  
HARNETT COUNTY  
REGISTER OF DEEDS

#### REZONING CONDITIONS

1. MINIMUM LOT SIZE - 20'x100'
2. FRONT SETBACK - 20', REAR SETBACK - 10',  
SIDE SETBACK - 0', CORNER SIDE - 10'
3. GARAGES FOR TOWN HOMES WILL BE FRONT  
ENTRY.
4. SINGLE STREET CONNECTION TO NC 210 WITH  
TWO ROAD STUBS TO ADJOINING PROPERTY AS  
SHOWN.

## INDEX OF DRAWINGS

- G1.0 - PROJECT NOTES
- C1.0 - EXISTING CONDITIONS
- C2.0 - SITE PLAN
- C3.0 - GRADING AND EROSION CONTROL PLAN
- C3.1 - DETAILED WET POND PLAN
- C4.0 - UTILITY PLAN
- C4.1 - STORM & SEWER STRUCTURE DATA
- C5.0 - 5.5 - PROFILES
- C6.0 - SITE DETAILS
- C6.1 - 6.2 - EROSION CONTROL DETAILS
- C6.3 - SITE & EROSION CONTROL DETAILS
- C6.4 - 6.5 - STORM DETAILS
- C6.6 - WATER DETAILS
- C6.7 - WATER & SEWER DETAILS
- C6.8 - SEWER DETAILS
- C6.9 - LIFT STATION DETAILS

NOTICE TO CONTRACTOR  
All construction must comply with current NC Building Codes  
and is subject to field inspection and verification.  
Reviewed for Code  
Compliance  
02/21/2025

Electrical review only



**APPROVED**

SEP 13 2024  
HARNETT REGIONAL WATER  
PO BOX 1119  
LILLINGTON, NC 27546

#### REVISIONS

ISSUED FOR CONSTRUCTION

#### PROJECT NAME

**HARPER'S  
MEADOW**

PIN: 0651-90-8197.000  
N MAIN ST/ NC HWY 210  
NEILLS CREEK TOWNSHIP  
TOWN OF LILLINGTON  
HARNETT COUNTY  
NORTH CAROLINA

#### CLIENT

**TRIANGLE LAND  
PARTNERS, LLC**

PO Box 5548  
Cary, North Carolina 27512  
Phone: (704) 608-3085

#### PROJECT INFORMATION

DESIGNED BY:	CALEB
DRAWN BY:	CALEB
CHECKED BY:	SCOTT
PROJECT NUMBER:	1896

#### DRAWING SCALE

SEE SHEETS

#### DATE RELEASED

MARCH 22, 2024



Know what's below.  
Call before you dig.

### CIVIL ENGINEER


4D SITE SOLUTIONS, INC.  
409 Chicago Drive - Suite 112  
Fayetteville, North Carolina 28306  
910-426-6777  
Contact: Scott Brown, PE  
email: sbrown@4dsitesolutions.com

### OWNER/DEVELOPER

TRIANGLE LAND PARTNERS, LLC  
PO Box 5548  
Cary, North Carolina 27512  
704-608-3085  
Contact: Kirby LaForce  
email: carolinalandgroup@outlook.com

### SURVEYOR

4D SITE SOLUTIONS, INC.  
409 Chicago Drive - Suite 112  
Fayetteville, North Carolina 28306  
910-426-6777  
Contact: Jimmy Holland, PLS  
email: jholland@4dsitesolutions.com

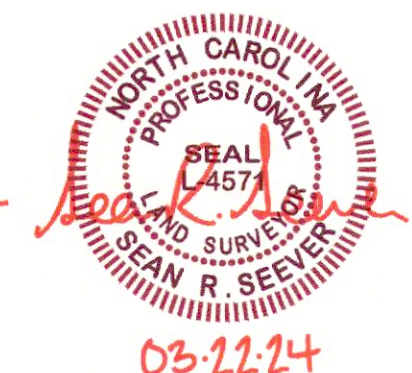

THE CONTRACTOR MUST CONTACT NORTH CAROLINA ONE CALL CENTER AT 1-800-632-4949 A MINIMUM OF 72 HOURS PRIOR TO DIGGING IN ORDER TO HAVE THE EXISTING UTILITIES LOCATED



ISSUED FOR CONSTRUCTION

## HARPER'S MEADOW

**TRIANGLE LAND  
PARTNERS, LLC**


DESIGNED BY:	CALEB
DRAWN BY:	CALEB
CHECKED BY:	SCOTT
PROJECT NUMBER:	1896

# G-1.0

(1) - THREE (3") INCH SCHEDULE 40 PVC CONDUIT, BUT EACH WATER SERVICE SHALL BE TAPPED DIRECTLY TO THE WATER MAIN. SPLIT SERVICES ARE NOT ALLOWED BY HRW. IF

(1) - THREE (3") INCH SCHEDULE 40 PVC CONDUIT, BUT EACH WATER SERVICE SHALL BE TAPPED DIRECTLY TO THE WATER MAIN. SPLIT SERVICES ARE NOT ALLOWED BY HRW. IF



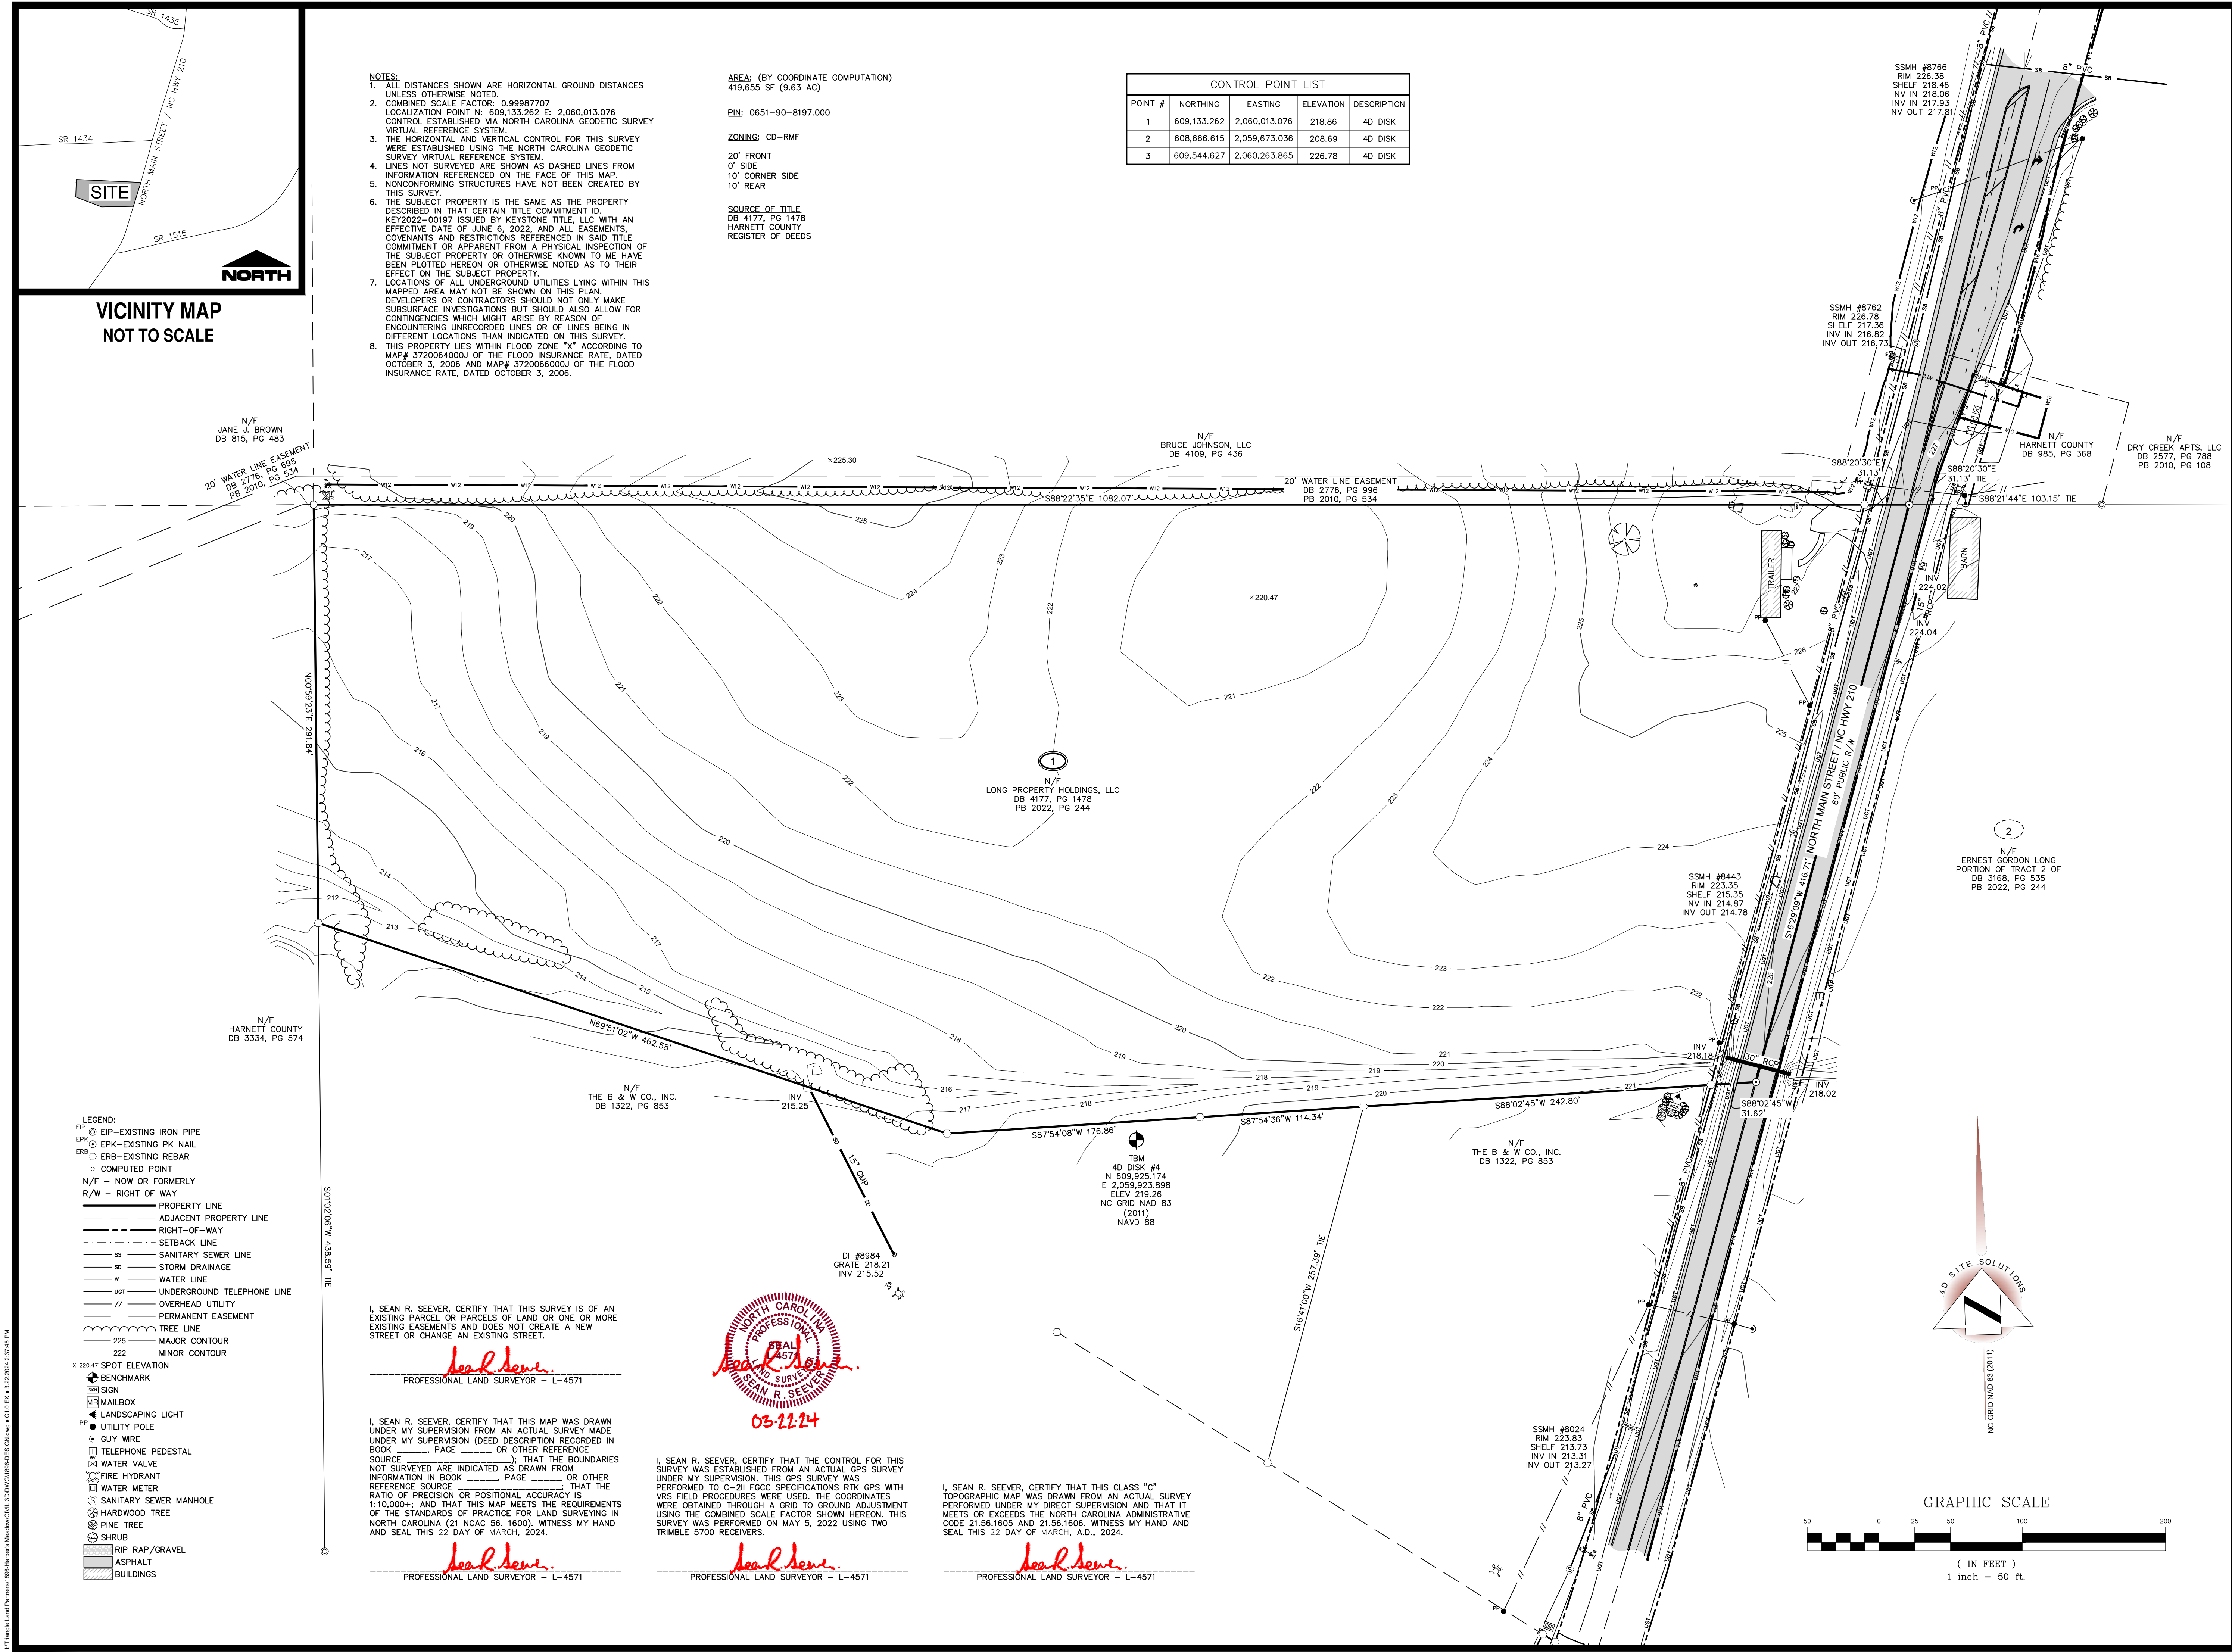

civil engineering | land surveying

409 Chicago Drive, Suite 112, Fayetteville, NC 28306  
office | 910-426-6777 fax | 910-426-5777 license number | C-2354  
www.4dsitesolutions.com

REVISIONS

ISSUED FOR CONSTRUCTION

PROJECT NAME

HARPER'S MEADOW

CLIENT

TRIANGLE LAND PARTNERS, LLC

PO Box 5548  
Cary, North Carolina 27512  
Phone: (704) 608-3085

PROJECT INFORMATION

SURVEYED BY:	CLIFF
DRAWN BY:	SEAN
CHECKED BY:	JIMMY
PROJECT NUMBER:	1896

DRAWING SCALE

HORIZONTAL: 1"=50'

DATE SURVEYED

MAY 5, 2022

SHEET NUMBER

C-1.0





VICINITY MAP  
NOT TO SCALE


- LEGEND:
- EIP - EXISTING IRON PIPE
  - EPK - EXISTING PK NAIL
  - ERB - EXISTING REBAR
  - CP - COMPUTED POINT
  - N/F - NOW OR FORMERLY
  - R/W - RIGHT OF WAY
  - TOL - TOWN OF LILLINGTON
  - PROPERTY LINE
  - ADJACENT PROPERTY LINE
  - RIGHT-OF-WAY
  - SETBACK LINE
  - SS - SANITARY SEWER LINE
  - SD - STORM DRAINAGE
  - W - WATER LINE
  - UT - UNDERGROUND TELEPHONE LINE
  - OVERHEAD UTILITY
  - PERMANENT EASEMENT
  - TREE LINE
  - 225 - MAJOR CONTOUR
  - 222 - MINOR CONTOUR
  - X 225.47 - SPOT ELEVATION
  - BENCHMARK
  - SIGN
  - MAILBOX
  - LANDSCAPING LIGHT
  - LIGHT POLE
  - UTILITY POLE
  - GUY WIRE
  - TELEPHONE PEDESTAL
  - WATER VALVE
  - FIRE HYDRANT
  - WATER METER
  - SANITARY SEWER MANHOLE
  - HARDWOOD TREE
  - PINE TREE
  - SHRUB
  - RIP RAP/GRAVEL
  - ASPHALT
  - BUILDINGS

SITE DATA


DEVELOPER	TRIANGLE LAND PARTNERS, LLC
MAILING ADDRESS	PO BOX 5548
CITY, STATE	CARY, NORTH CAROLINA 27512
PIN NUMBER	0651-90-8197.000
TOWNSHIP	NEILLS CREEK
TOTAL SITE ACREAGE	9.63 AC
ACREAGE TO BE DEVELOPED	9.63 AC
ZONING	CD-RMF
EXISTING USE	UNDEVELOPED/RESIDENTIAL
PROPOSED USE	RESIDENTIAL
DISTURBED/DENUDED AREA	10.82 AC
SETBACKS REQUIRED:	
FRONT	20 FT
SIDE	0 FT
CORNER SIDE	10 FT
REAR	10 FT
OPEN SPACE REQUIRED:	
TOTAL REQUIRED (15%)	61,066 SF
USABLE SPACE REQUIRED (5%)	20,356 SF
TOTAL PROVIDED	75,369 SF
USABLE SPACE PROVIDED	28,342 SF
PARKING:	
REQUIRED	
2 SP/UNIT	150 SPACES
0.25 SP/UNIT (QUEST)	19 SPACES
TOTAL REQUIRED	169 SPACES
TOTAL PROVIDED	169 SPACES

ROAD NAME	TOTAL LENGTH
BRAYDENS WAY	246
HARPERS MEADOW	751
ROSE LANDING	865

CURVE	LENGTH	RADIUS	BEARING	CHORD
C1	43.45	25.00	N33°19'05"W	38.18
C2	12.18	205.00	N84°48'37"W	12.17
C3	20.03	205.00	N89°18'40"W	20.02
C4	4.84	100.00	S89°16'30"W	4.84
C5	24.48	100.00	N82°19'39"W	24.42
C6	23.47	100.00	N68°35'31"W	23.41
C7	20.04	100.00	N56°07'40"W	20.01
C8	20.34	100.00	N44°33'31"W	20.31
C9	21.61	100.00	N32°32'19"W	21.57
C10	39.07	100.00	N15°09'15"W	38.82
C11	9.75	100.00	N01°10'09"W	9.74
C12	39.27	25.00	N43°22'35"W	35.36
C13	39.27	25.00	S46°37'25"W	35.36
C14	39.27	25.00	N43°22'35"W	35.36
C15	39.27	25.00	N46°37'25"E	35.36
C16	40.90	25.00	S45°14'36"E	36.49
C17	55.37	255.00	N85°53'25"W	55.26
C18	36.59	25.00	N58°24'04"E	33.41
C19	37.64	25.00	N44°45'24"E	34.18
C20	70.23	50.00	N51°52'16"W	64.60
C21	11.57	50.00	N05°00'14"W	11.54
C22	39.27	25.00	S46°37'25"W	35.36
C23	39.27	25.00	N43°22'35"W	35.36

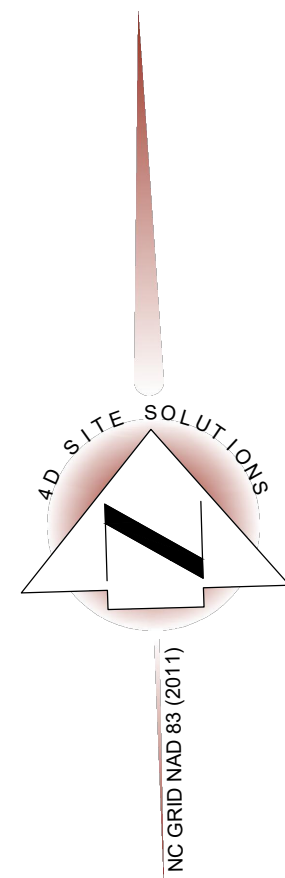

N/F  
BRUCE JOHNSON, LLC  
DB 4109, PG 436

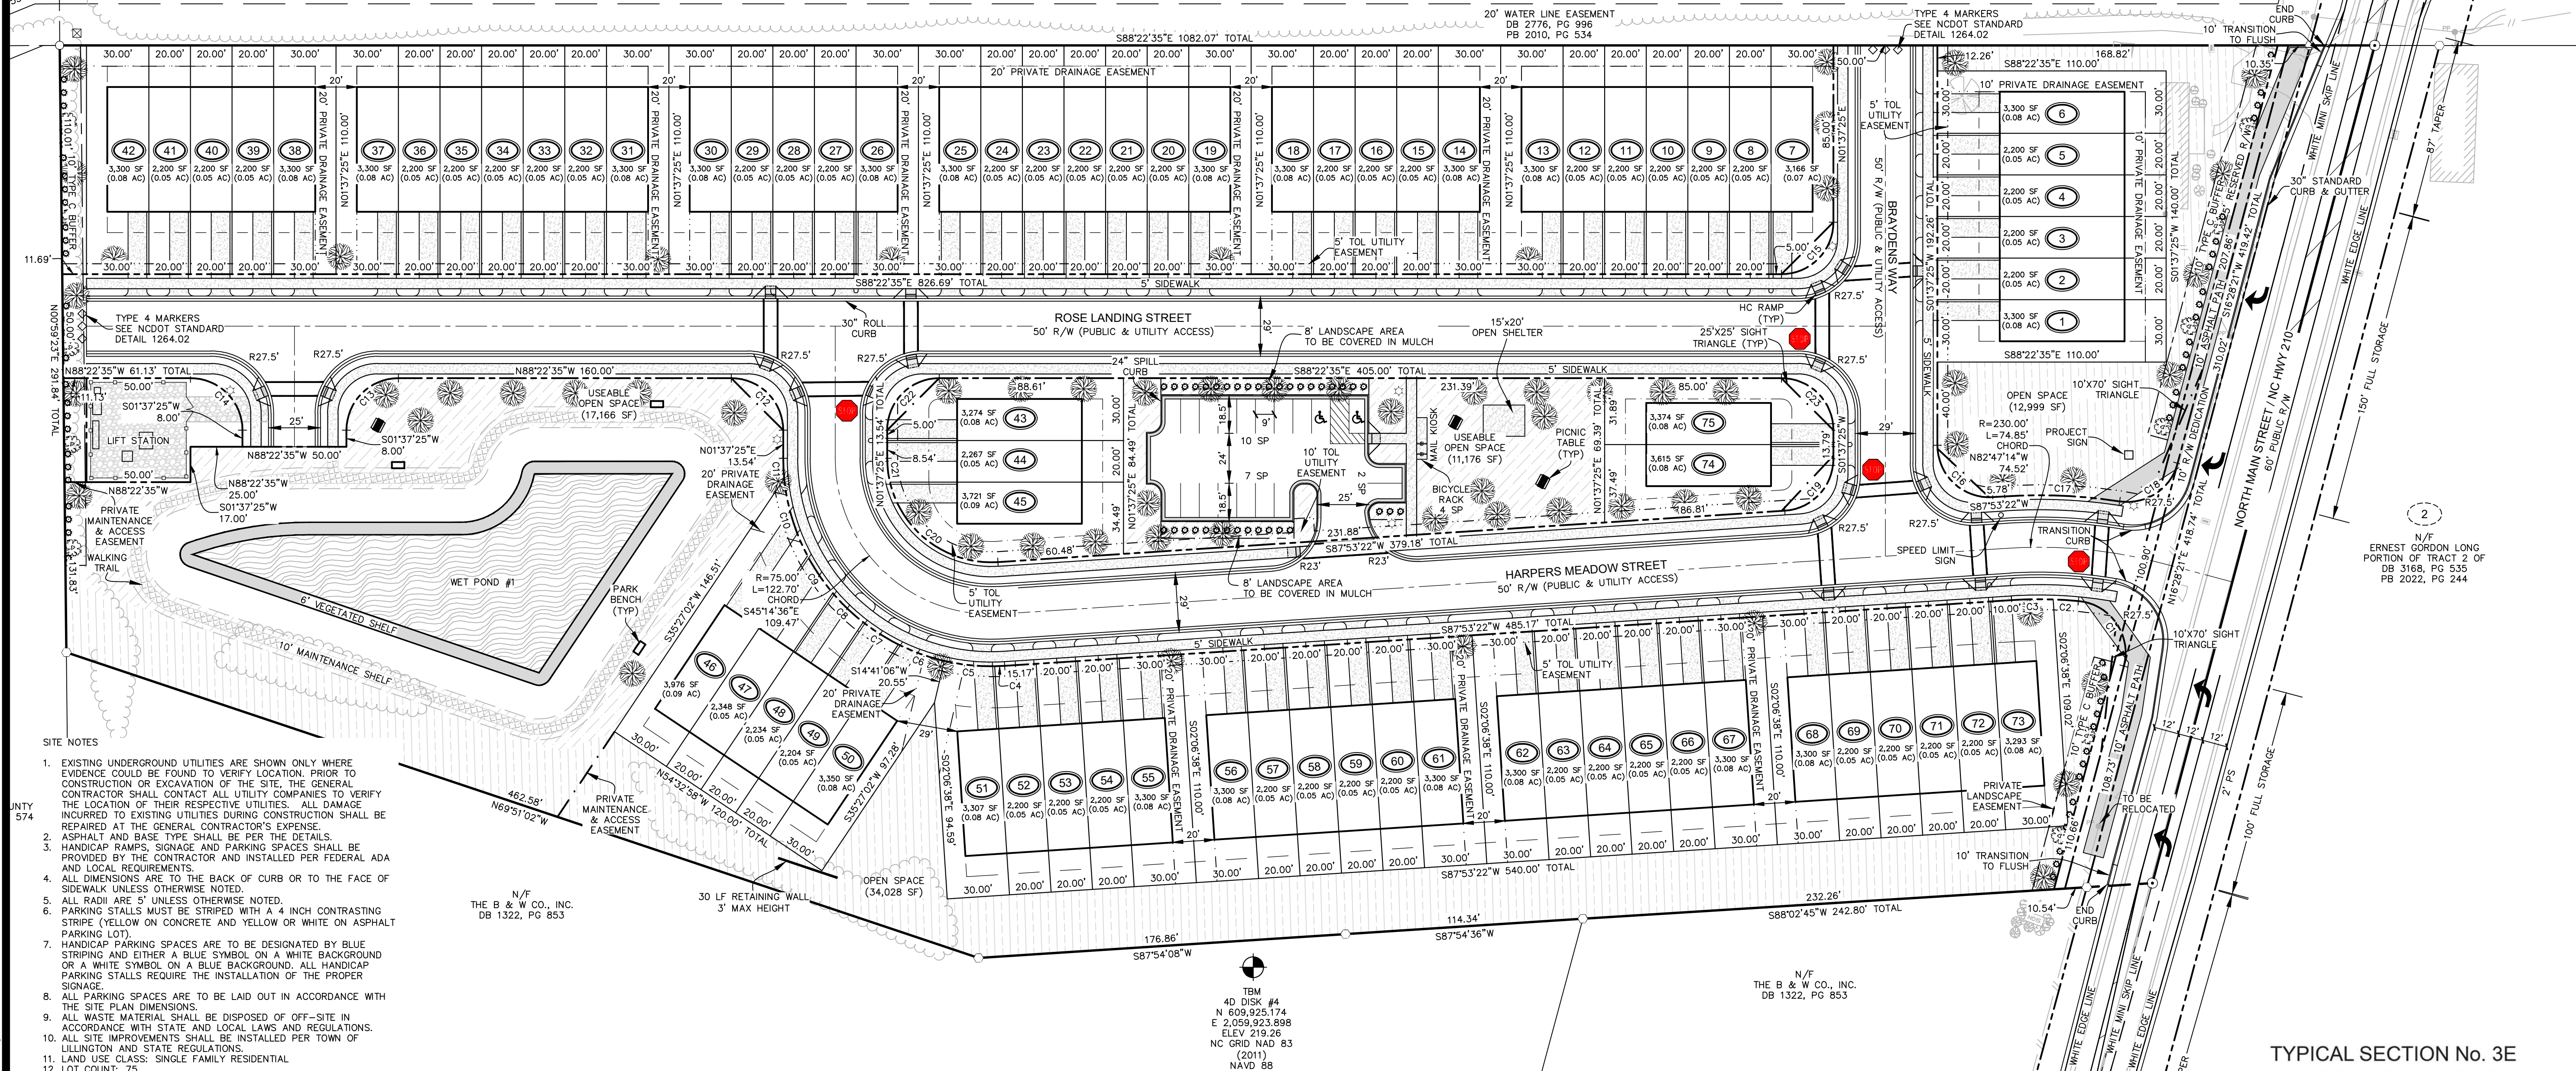


SITE NOTES

- EXISTING UNDERGROUND UTILITIES ARE SHOWN ONLY WHERE EVIDENCE COULD BE FOUND TO VERIFY LOCATION. PRIOR TO CONSTRUCTION OR EXCAVATION OF THE SITE, THE GENERAL CONTRACTOR SHALL CONTACT ALL UTILITY COMPANIES TO VERIFY THE LOCATION OF THEIR RESPECTIVE UTILITIES. ALL DAMAGE INCURRED TO EXISTING UTILITIES DURING CONSTRUCTION SHALL BE REPAIRED AT THE GENERAL CONTRACTOR'S EXPENSE.
- ASPHALT AND BASE TYPE SHALL BE PER THE DETAILS.
- HANDICAP RAMPS, SIGNAGE AND PARKING SPACES SHALL BE PROVIDED BY THE CONTRACTOR AND INSTALLED PER FEDERAL ADA AND LOCAL REQUIREMENTS.
- ALL DIMENSIONS ARE TO THE BACK OF CURB OR TO THE FACE OF SIDEWALK UNLESS OTHERWISE NOTED.
- ALL RADI ARE 5' UNLESS OTHERWISE NOTED.
- PARKING STALLS MUST BE STRIPED WITH A 4 INCH CONTRASTING STRIPE (YELLOW ON CONCRETE AND YELLOW OR WHITE ON ASPHALT PARKING LOTS).
- HANDICAP PARKING SPACES ARE TO BE DESIGNATED BY BLUE STRIPING AND EITHER A BLUE SYMBOL ON A WHITE BACKGROUND OR A WHITE SYMBOL ON A BLUE BACKGROUND. ALL HANDICAP PARKING STALLS REQUIRE THE INSTALLATION OF THE PROPER SIGNAGE.
- ALL PARKING SPACES ARE TO BE LAID OUT IN ACCORDANCE WITH THE SITE PLAN DIMENSIONS.
- ALL WASTE MATERIAL SHALL BE DISPOSED OF OFF-SITE IN ACCORDANCE WITH STATE AND LOCAL LAWS AND REGULATIONS.
- ALL SITE IMPROVEMENTS SHALL BE INSTALLED PER TOWN OF LILLINGTON AND STATE REGULATIONS.
- LAND USE CLASS: SINGLE FAMILY RESIDENTIAL
- LOT COUNT: 75
- WATERSHED CLASSIFICATION: WS-V-PA
- THIS PROJECT LIES WITHIN 1 MILE OF A VOLUNTARY AGRICULTURAL DISTRICT.
- NC 210N IS ON THE NCDOT THOROUGHFARE PLAN.
- FOUNDATION SURVEYS WILL BE REQUIRED FOR LOTS.
- NO PARKING WITHIN R/W WILL BE PERMITTED.
- STREET AND STORM WATER DRAINAGE IMPROVEMENTS TO BE INSTALLED IN ACCORDANCE WITH THE TOWN OF LILLINGTON STANDARD ROADWAY, SIDEWALK, CURB & GUTTER, & DRAINAGE PIPE SPECIFICATIONS.
- OPEN SPACES, SIGNAGE, MAIL KIOSK, DRAINAGE EASEMENTS, LANDSCAPING, PARKING LOTS, AND ALL OTHER ITEMS NOT UNDER TOWN PURVIEW TO BE MAINTAINED BY THE HOME OWNERS ASSOCIATION ("HOA"), PROPERTY OWNERS ASSOCIATION ("POA"), CONDOMINIUM OWNERS ASSOCIATION ("COA"), OR ANY OTHER ASSOCIATION RESPONSIBLE FOR THE MAINTENANCE AND/OR UPKEEP OF THE RESIDENTIAL COMMUNITY.

- LANDSCAPING NOTES:
- HEIGHT AND SPREAD OF TREE SPECIMEN SHALL MEET REQUIREMENTS OF THE AMERICAN ASSOCIATION OF NURSERYMEN, AMERICAN STANDARD FOR NURSERY STOCK.
  - EACH TREE MUST BE PLANTED SUCH THAT THE ROOT FLARE IS VISIBLE AT THE TOP OF THE ROOT BALL. TREES WHERE THE ROOT FLARE IS NOT VISIBLE SHALL BE REJECTED. DO NOT COVER THE ROOT FLARE WITH MULCH.
  - DO NOT PLACE MULCH IN CONTACT WITH THE TREE TRUNK. KEEP MULCH A MIN. OF 4" AWAY FROM THE TRUNK BASE.
  - STREET TREE LOCATIONS ARE FOR ILLUSTRATION PURPOSES ONLY. PLACEMENT OF TREES TO BE ADJUSTED FOR DRIVEWAYS AND UTILITIES.


\*THIS LANDSCAPING PLAN IS THE MINIMUM REQUIRED TO MEET WITH THE TOWN OF LILLINGTON UDD. THE OWNER OR DEVELOPER IS ENCOURAGED TO CONSULT WITH A LANDSCAPE ARCHITECT IN ORDER TO DEVELOP A PLAN THAT IS MORE IN DEPTH THAN THE MINIMUM REQUIREMENTS. THIS PLAN IS FOR PERMITTING PURPOSES ONLY.

QTY.	TYPE	PLANTING SIZE	MIN. HEIGHT	SCIENTIFIC NAME
68	WILLOW OAK	3" CALIPER	8'	QUERCUS PHellos
11	FLOWERING DOGWOOD	1.5" CALIPER	8'	CORNUS FLORIDA
101	JAPANESE HOLLY	5 GAL.	18"	ILEX CRENATA

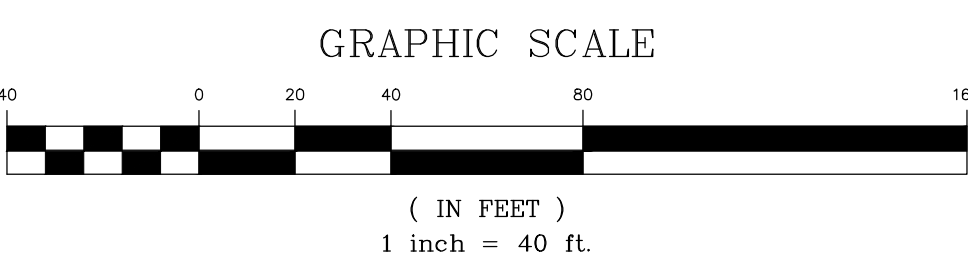

TYPICAL SECTION No. 3E

2 LANE WITH TWO WAY LEFT TURN LANE.  
CURB & GUTTER, SIDEWALKS, AND SIDEPATH

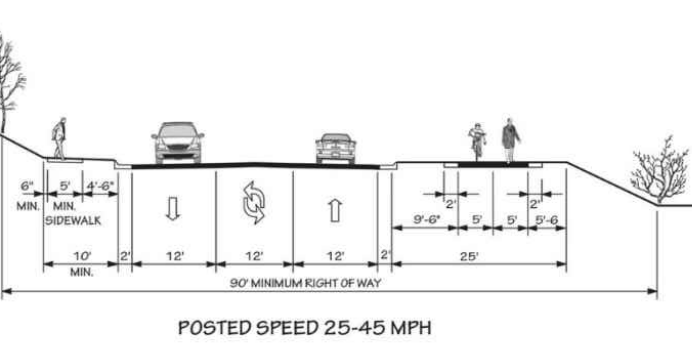

REVISIONS

ISSUED FOR CONSTRUCTION

PROJECT NAME

**HARPER'S MEADOW**

SITE PLAN

CLIENT

**TRIANGLE LAND PARTNERS, LLC**

PO Box 5548  
Cary, North Carolina 27512  
Phone: (704) 608-3085

PROJECT INFORMATION

DESIGNED BY:	CALEB
DRAWN BY:	CALEB
CHECKED BY:	SCOTT
PROJECT NUMBER:	1896

DRAWING SCALE

HORIZONTAL: 1"=40'

DATE RELEASED

MARCH 22, 2024

SHEET NUMBER

**C-2.0**





### VICINITY MAP NOT TO SCALE

NOTIFICATION OF COMBINED SELF-MONITORING AND SELF-INSPECTION FORM:

THE SEDIMENTATION POLLUTION CONTROL ACT WAS AMENDED IN 2006 TO REQUIRE THAT PERSONS RESPONSIBLE FOR LAND-DISTURBING ACTIVITIES INSPECT A PROJECT AFTER EACH PHASE OF THE PROJECT TO MAKE SURE THAT THE APPROVED EROSION AND SEDIMENTATION CONTROL PLAN IS BEING FOLLOWED. RULES DETAILING THE DOCUMENTATION OF THESE INSPECTIONS TOOK EFFECT OCTOBER 1, 2010.

TO SIMPLIFY DOCUMENTATION OF SELF-INSPECTION REPORTS AND NPDES SELF-MONITORING REPORTS, DWO AND DEMUR DEVELOPED A COMBINED FORM. THE SELF-INSPECTION PROGRAM IS SEPARATE FROM THE WEEKLY SELF-MONITORING PROGRAM OF THE NPDES STORMWATER PERMIT FOR CONSTRUCTION ACTIVITIES. THE FOCUS OF THE SELF-INSPECTION REPORT IS THE INSTALLATION AND MAINTENANCE OF EROSION AND SEDIMENTATION CONTROL MEASURES ACCORDING TO THE APPROVED PLAN. THE INSPECTIONS SHOULD BE CONDUCTED AFTER EACH PHASE OF THE PROJECT, AND CONTINUED UNTIL PERMANENT GROUND COVER IS ESTABLISHED. THE FORM CAN BE ACCESSED AT: [HTTP://PORTAL.NCDEM.ORG/WEB/LR/EROSION](http://PORTAL.NCDEM.ORG/WEB/LR/EROSION)

IF YOU HAVE QUESTIONS OR CANNOT ACCESS THE FORM, PLEASE CONTACT THE FAYETTEVILLE REGIONAL OFFICE AT (910) 433-3300.

LEGEND:  
EIP - EXISTING IRON PIPE  
EPK - EXISTING PK NAIL  
ERB - EXISTING REBAR  
C - COMPUTED POINT  
N/F - NOW OR FORMERLY  
R/W - RIGHT OF WAY  
T - TOWN OF ULLINGTON  
--- PROPERTY LINE  
--- ADJACENT PROPERTY LINE  
--- RIGHT-OF-WAY  
--- SETBACK LINE  
SS - SANITARY SEWER LINE  
SD - STORM DRAINAGE  
W - WATER LINE  
UT - UNDERGROUND TELEPHONE LINE  
// OVERHEAD UTILITY  
--- PERMANENT EASEMENT  
--- TREE LINE  
--- MAJOR CONTOUR  
--- MINOR CONTOUR  
X 225.47 SPOT ELEVATION  
BENCHMARK  
SIGN  
MAILBOX  
LANDSCAPING LIGHT

PP - UTILITY POLE  
GUY WIRE  
TELEPHONE PEDESTAL  
WATER VALVE  
FIRE HYDRANT  
WATER METER  
SANITARY SEWER MANHOLE  
HARDWOOD TREE  
PINE TREE  
SHRUB  
RIP RAP/GRAVEL  
ASPHALT  
BUILDINGS  
LOC - LIMITS OF CONSTRUCTION  
SILT FENCE LINE  
JUTE NETTING  
DIV - DIVERSION BERM  
INLET PROTECTION

### GROUND STABILIZATION CHART


SITE AREA DESCRIPTION	STABILIZATION TIME FRAME	STABILIZATION TIME FRAME EXCEPTIONS
PERIMETER DIKES, SWALES, DITCHES AND SLOPES	7 DAYS	NONE
HIGH QUALITY WATER (HOW) ZONES	7 DAYS	NONE
SLOPES STEEPER THAN 3:1	7 DAYS	IF SLOPES ARE 10' OR LESS IN LENGTH AND ARE NOT STEEPER THAN 2:1, 14 DAYS ARE ALLOWED
SLOPES 3:1 OR FLATTER	14 DAYS	7-DAYS FOR SLOPES GREATER THAN 50 FEET LENGTH
ALL OTHER AREAS WITH SLOPES FLATTER THAN 4:1	14 DAYS	NONE (EXCEPT FOR PERIMETERS AND HOW ZONES)

### EROSION CONTROL NOTES

- ALL INLET/OUTLET PROTECTION WILL BE CHECKED FOR MAINTENANCE AND FAILURE EACH ACTIVE DAY ON SITE. SEDIMENT WILL BE REMOVED FROM THE SEDIMENT TRAP AND INLET PROTECTION DEVICES WHEN THE STORAGE CAPACITY HAS BEEN APPROXIMATELY 50% FILLED. GRAVEL WILL BE CLEANED OR REPLACED WHEN THE SEDIMENT POOL NO LONGER DRAINS PROPERLY. SEDIMENT WILL BE REMOVED FROM BEHIND THE SEDIMENT FENCE WHEN IT BECOMES ABOUT 15' DEEP AT THE FENCE. THE SEDIMENT FENCE WILL BE REPAIRED AS NEEDED TO MAINTAIN A PROPER BARRIER.
- TEMPORARY EROSION CONTROL FACILITIES AND/OR PERMANENT FACILITIES INTENDED TO CONTROL EROSION OF AND EARTH DISTURBANCE OPERATION SHALL BE INSTALLED BEFORE ANY EARTH DISTURBANCE OPERATIONS TAKE PLACE OR AT THE EARLIEST POSSIBLE POINT DURING CONSTRUCTION.
- TEMPORARY OR PERMANENT EROSION CONTROL MEASURES SHALL BE CONSTRUCTED PER THE DETAILS HEREIN, OR SHALL BE CONSTRUCTED IN ACCORDANCE WITH THE NORTH CAROLINA EROSION AND SEDIMENT CONTROL PLANNING AND DESIGN MANUAL.
- THE CONTRACTOR MUST NOTIFY THE APPROPRIATE NCEQ OFFICE A MINIMUM OF 48 HOURS PRIOR TO BEGINNING ANY LAND DISTURBING ACTIVITIES. 910-433-3300.
- REMOVE ALL SOILS AND SEDIMENTS TRACKED OR OTHERWISE DEPOSITED ONTO PUBLIC AND PRIVATE PAYMENT AREAS. REMOVAL SHALL BE ON A DAILY BASIS WHEN TRACKING OCCURS.
- LOCATE SOIL STOCKPILES NO LESS THAN FIFTY (50) FEET FROM ANY PUBLIC OR PRIVATE ROADWAY OR DRAINAGE CHANNEL. IF REMAINING FOR MORE THAN SEVEN DAYS, STABILIZE THE STOCKPILES BY VEGETATIVE COVER, TARPS, OR OTHER MEANS. CONTROL EROSION FROM ALL STOCKPILES BY PLACING SILT BARRIERS AROUND THE PILES. TEMPORARY STOCKPILES LOCATED ON PAVED SURFACES MUST BE NO LESS THAN FIVE FEET FROM THE DRAINAGE/GUTTER LINE AND SHALL BE COVERED IF LEFT MORE THAN 24 HOURS.
- MAINTAIN ALL TEMPORARY EROSION AND SEDIMENT CONTROL DEVICES IN PLACE UNTIL THE CONTRIBUTING DRAINAGE AREA HAS BEEN STABILIZED. INSPECT TEMPORARY EROSION AND SEDIMENT CONTROL DEVICES ON A DAILY BASIS AND REPLACE DETERIORATED, DAMAGED, OR ROTTED EROSION CONTROL DEVICES IMMEDIATELY.
- TEMPORARILY OR PERMANENTLY STABILIZE ALL DENuded AREAS WHICH HAVE BEEN FINISH GRADED, AND ALL DENuded AREAS IN WHICH GRADING OR SITE BUILDING

- ALL INLET/OUTLET PROTECTION WILL BE CHECKED FOR MAINTENANCE AND FAILURE EACH ACTIVE DAY ON SITE. SEDIMENT WILL BE REMOVED FROM THE SEDIMENT TRAP AND INLET PROTECTION DEVICES WHEN THE STORAGE CAPACITY HAS BEEN APPROXIMATELY 50% FILLED. GRAVEL WILL BE CLEANED OR REPLACED WHEN THE SEDIMENT POOL NO LONGER DRAINS PROPERLY. SEDIMENT WILL BE REMOVED FROM BEHIND THE SEDIMENT FENCE WHEN IT BECOMES ABOUT 15' DEEP AT THE FENCE. THE SEDIMENT FENCE WILL BE REPAIRED AS NEEDED TO MAINTAIN A PROPER BARRIER.
- TEMPORARY EROSION CONTROL FACILITIES AND/OR PERMANENT FACILITIES INTENDED TO CONTROL EROSION OF AND EARTH DISTURBANCE OPERATION SHALL BE INSTALLED BEFORE ANY EARTH DISTURBANCE OPERATIONS TAKE PLACE OR AT THE EARLIEST POSSIBLE POINT DURING CONSTRUCTION.
- TEMPORARY OR PERMANENT EROSION CONTROL MEASURES SHALL BE CONSTRUCTED PER THE DETAILS HEREIN, OR SHALL BE CONSTRUCTED IN ACCORDANCE WITH THE NORTH CAROLINA EROSION AND SEDIMENT CONTROL PLANNING AND DESIGN MANUAL.
- THE CONTRACTOR MUST NOTIFY THE APPROPRIATE NCEQ OFFICE A MINIMUM OF 48 HOURS PRIOR TO BEGINNING ANY LAND DISTURBING ACTIVITIES. 910-433-3300.
- REMOVE ALL SOILS AND SEDIMENTS TRACKED OR OTHERWISE DEPOSITED ONTO PUBLIC AND PRIVATE PAYMENT AREAS. REMOVAL SHALL BE ON A DAILY BASIS WHEN TRACKING OCCURS.
- LOCATE SOIL STOCKPILES NO LESS THAN FIFTY (50) FEET FROM ANY PUBLIC OR PRIVATE ROADWAY OR DRAINAGE CHANNEL. IF REMAINING FOR MORE THAN SEVEN DAYS, STABILIZE THE STOCKPILES BY VEGETATIVE COVER, TARPS, OR OTHER MEANS. CONTROL EROSION FROM ALL STOCKPILES BY PLACING SILT BARRIERS AROUND THE PILES. TEMPORARY STOCKPILES LOCATED ON PAVED SURFACES MUST BE NO LESS THAN FIVE FEET FROM THE DRAINAGE/GUTTER LINE AND SHALL BE COVERED IF LEFT MORE THAN 24 HOURS.
- MAINTAIN ALL TEMPORARY EROSION AND SEDIMENT CONTROL DEVICES IN PLACE UNTIL THE CONTRIBUTING DRAINAGE AREA HAS BEEN STABILIZED. INSPECT TEMPORARY EROSION AND SEDIMENT CONTROL DEVICES ON A DAILY BASIS AND REPLACE DETERIORATED, DAMAGED, OR ROTTED EROSION CONTROL DEVICES IMMEDIATELY.
- TEMPORARILY OR PERMANENTLY STABILIZE ALL DENuded AREAS WHICH HAVE BEEN FINISH GRADED, AND ALL DENuded AREAS IN WHICH GRADING OR SITE BUILDING

N/F  
BRUCE JOHNSON, LLC  
DB 4109, PG 436

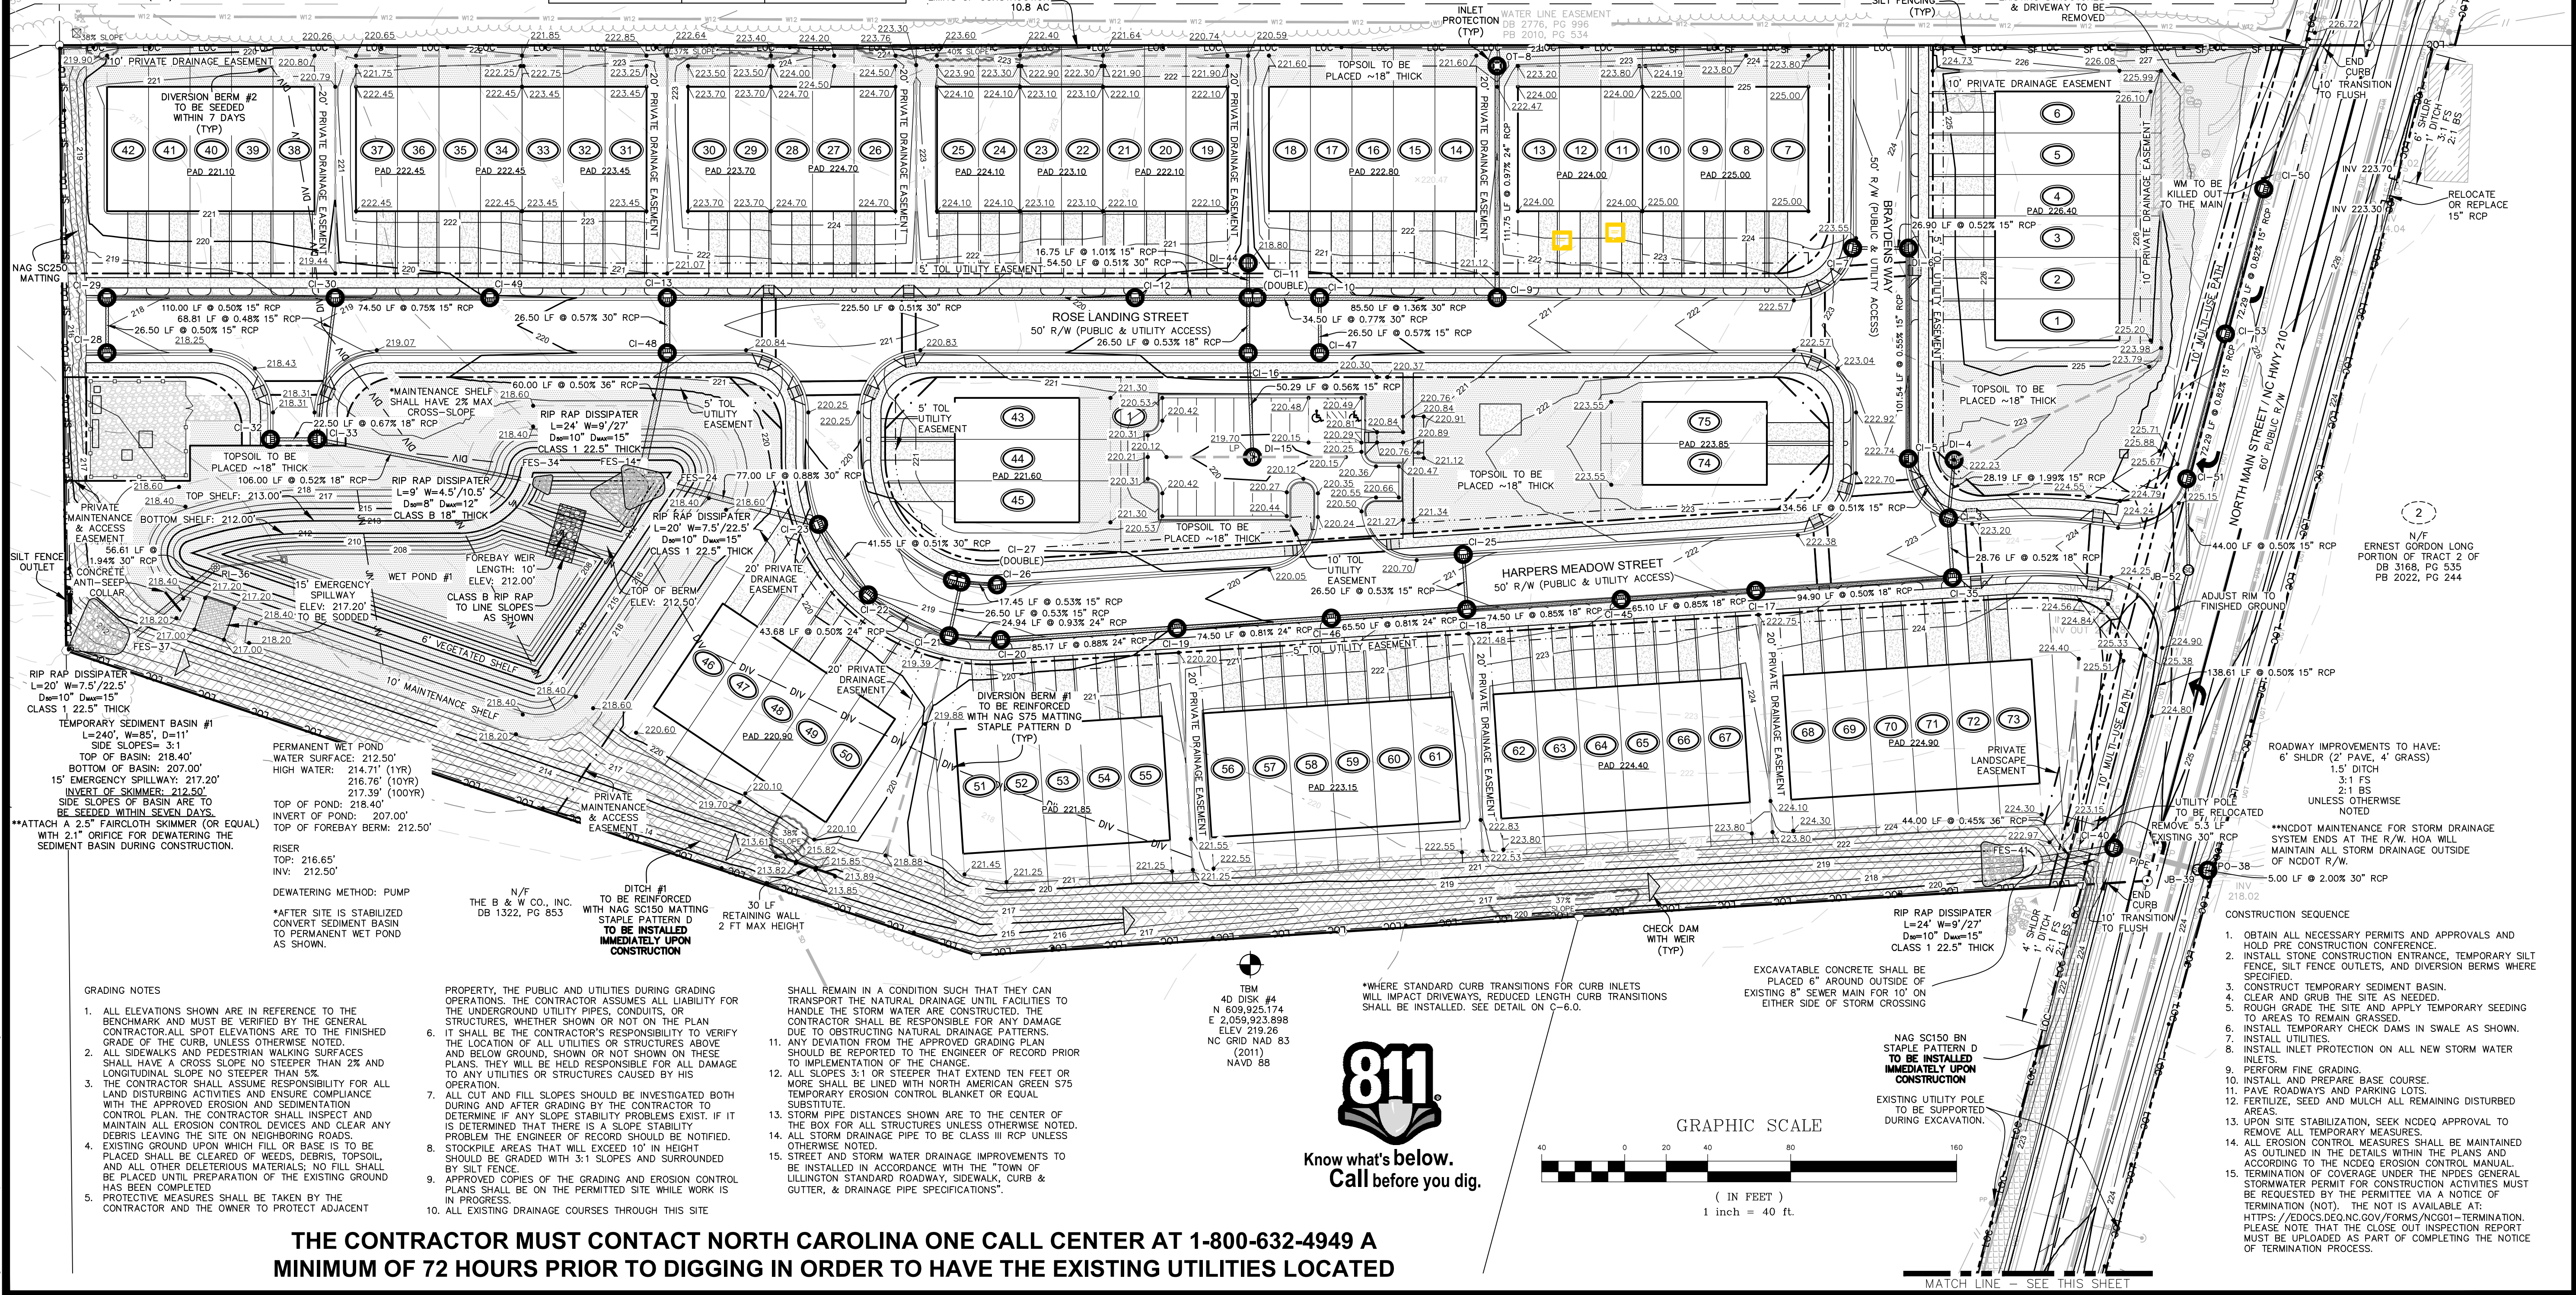

4Dsite solutions  
civil engineering | land surveying  
409 Chicago Drive, Suite 112, Fayetteville, NC 28306  
office | 910-426-6777 fax | 910-426-5777 license number | C-2854  
www.4Dsite.com

03-22-24

REVISIONS

ISSUED FOR CONSTRUCTION
-------------------------

PROJECT NAME

## HARPER'S MEADOW

CLIENT

### TRIANGLE LAND PARTNERS, LLC

PO Box 5548  
Cary, North Carolina 27512  
Phone: (704) 608-3085

PROJECT INFORMATION

DESIGNED BY:	CALEB
DRAWN BY:	CALEB
CHECKED BY:	SCOTT
PROJECT NUMBER:	1896

DRAWING SCALE

HORIZONTAL: 1"=40'


DATE RELEASED

MARCH 22, 2024

SHEET NUMBER

# C-3.0



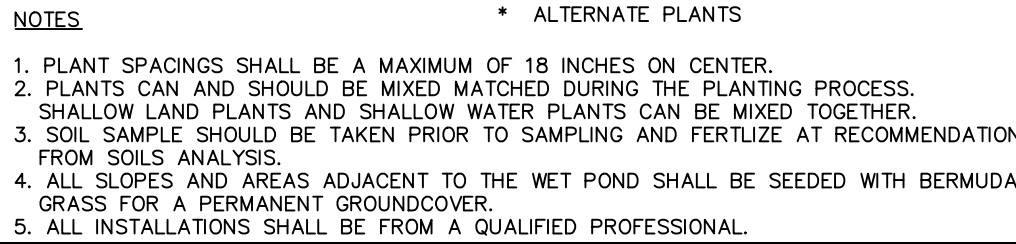

NOTES

1. THE MAXIMUM SPACING BETWEEN BARS SHALL NOT EXCEED 5.5 INCHES.
2. INSTALL A MAN ACCESS IN THE RACK FOR MAINTENANCE INSIDE THE STRUCTURE.

## NTS

1. INSTALL THE EMERGENCY SPILLWAY IN UNDISTURBED SOIL. THE ACHIEVEMENT OF PLANNED ELEVATIONS, GRADE, DESIGN WIDTH, AND ENTRANCE AND EXIT CHANNEL SLOPES ARE CRITICAL TO THE SUCCESSFUL OPERATION OF THE EMERGENCY SPILLWAY.
2. ALTERNATIVE MATERIALS MAY BE USED OTHER THAN THE SPECIFIED SOD IF APPROVED BY THE DESIGN ENGINEER.
3. MAX SIDE SLOPES ARE 3:1

## 6 ANTI-SEEP COLLAR


\*MUST INCLUDE A MINIMUM OF 3 DIVERSE SPECIES AT A MINIMUM PLANTING RATE OF 50 PLANTS PER 200 SF

### PLANT SUPPLIERS

CAROLINA GREENERY, WEST END, NC 910-947-3150  
MELLOW MARSH FARM, PITTSBORO, NC 919-742-1200  
PLANT DELIGHTS NURSERY, RALEIGH, NC 919-772-4794  
CILL IDE NATIVE PLANT NURSERY, RALEIGH, NC 877-479-2673

\*\*\*VEGETATED SHELF AND SLOPES ABOVE THE PERMANENT POOL ELEVATION SHALL HAVE A MINIMUM OF 6" TOPSOIL. SUBGRADE SHALL BE ADJUSTED TO ACCOUNT FOR ADDITION OF TOPSOIL IN THESE AREAS SUCH THAT THE ELEVATIONS SHOWN ABOVE ARE TO THE FINISHED GRADE OF THE TOPSOIL.

## NTS

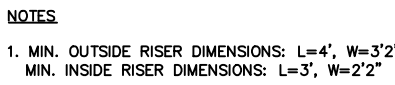

## NTS


## FOREBAY WEIR CROSS SECTION

1. ALTERNATIVE MATERIALS MAY BE USED OTHER THAN THE SPECIFIED STONE IF APPROVED BY THE DESIGN ENGINEER.
2. MAX SIDE SLOPES ARE 3:1

## NTS

Know what's **below**.  
**Call** before you dig

GRAPHIC SCALE

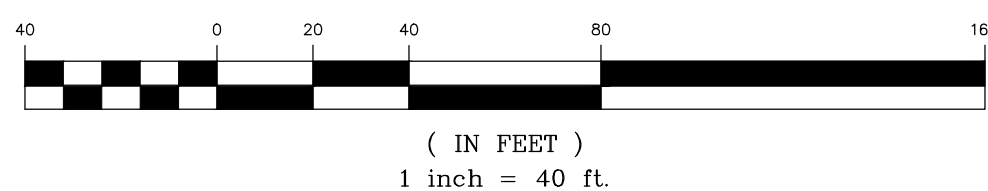

## REVISIONS

ISSUED FOR CONSTRUCTION

PROJECT NAME

# HARPER'S MEADOW

**CLIENT**

**TRIANGLE LAND  
PARTNERS, LLC**

PO Box 5548  
Cary, North Carolina 27512  
Phone: (704) 608-3085

## PROJECT INFORMATION

DESIGNED BY:	CALEB
DRAWN BY:	CALEB
CHECKED BY:	SCOTT
PROJECT NUMBER:	1896

**DRAWING SCALE**

HORIZONTAL: 1"=40'

DATE RELEASED

MARCH 22, 2024

**SHEET NUMBER**

# C-3.1





VICINITY MAP  
NOT TO SCALE

- LEGEND:
- EP - EXISTING IRON PIPE
  - EPK - EXISTING PK NAIL
  - ERB - EXISTING REBAR
  - CP - COMPUTED POINT
  - N/F - NOW OR FORMERLY
  - R/W - RIGHT OF WAY
  - TOL - TOWN OF LILLINGTON
  - PROPERTY LINE
  - ADJACENT PROPERTY LINE
  - RIGHT-OF-WAY
  - SETBACK LINE
  - SS - SANITARY SEWER LINE
  - SD - STORM DRAINAGE
  - W - WATER LINE
  - UT - UNDERGROUND TELEPHONE LINE
  - OV - OVERHEAD UTILITY
  - PERMANENT EASEMENT
  - TREE LINE
  - 225 - MAJOR CONTOUR
  - 222 - MINOR CONTOUR
  - X 220.47 SPOT ELEVATION
  - BENCHMARK
  - SIGN
  - MAILBOX
  - LANDSCAPING LIGHT
  - UTILITY POLE
  - GUY WIRE
  - TELEPHONE PEDESTAL
  - WATER VALVE
  - FIRE HYDRANT
  - WATER METER
  - SANITARY SEWER MANHOLE
  - HARDWOOD TREE
  - PINE TREE
  - SHRUB

- RIP RAP/GRAVEL
- ASPHALT
- BUILDINGS
- PROPOSED SANITARY SEWER MANHOLE
- PROPOSED CLEANOUT
- PROPOSED FIRE HYDRANT
- PROPOSED WATER METER
- PROPOSED TAP SLEEVE AND VALVE
- PROPOSED BLOW OFF
- PROPOSED TEE
- PROPOSED 45° BEND
- PROPOSED 22.5° BEND


\*APPROVAL OF THIS PLAT/PLAN DOES NOT GUARANTEE WATER CAPACITY OR WASTEWATER CAPACITY. CURRENT/FUTURE CAPACITY MAY NOT BE AVAILABLE. THIS DEVELOPMENT MAY REQUIRE ADDITIONAL IMPROVEMENTS TO THE EXISTING WATER SYSTEM TO MEET FUTURE WATER AND WASTEWATER DEMANDS PRIOR TO A PRELIMINARY PLAT, CONSTRUCTION PLAN AND/OR FINAL PLAT APPROVAL.

\*\*SIDEWALKS AND STREET TREES ARE TO BE MAINTAINED BY THE HOME OWNERS ASSOCIATION (HOA). PROPERTY OWNERS ASSOCIATION (POA), CONDOMINIUM OWNERS ASSOCIATION (COA), OR ANY OTHER ASSOCIATION RESPONSIBLE FOR THE MAINTENANCE AND/OR UPKEEP OF THIS RESIDENTIAL COMMUNITY. SIDEWALK OR STREET TREE INSTALLATIONS THAT ARE DAMAGED AND/OR REMOVED BY HARNETT COUNTY/DEPARTMENT OF PUBLIC UTILITIES/HARNETT REGIONAL WATER OR ITS REPRESENTATIVES, AGENTS, OR CONTRACTORS AS A RESULT OF REPAIR/MAINTENANCE OF THE PUBLIC WATER AND/OR SEWER LINE WILL BE REPLACED OR REPAIRED BY THE HOA, POA, COA, OR ANY OTHER ASSOCIATION RESPONSIBLE FOR THE MAINTENANCE AND/OR UPKEEP OF THE RESIDENTIAL COMMUNITY.

#### UTILITY NOTES

- THE CONTRACTOR SHALL MAINTAIN A SET OF RED LINE AS-BUILTS DURING THE CONSTRUCTION OF THE WATER LINE. ALL DEVIATIONS FROM THE PLAN SHALL BE NOTED ON THE AS-BUILT DRAWINGS. ALL VALVES AND CHANGE IN DIRECTION OF THE WATER LINE SHALL BE LOCATED WITH A MINIMUM OF TWO DISTANCES FROM A KNOWN OBJECT. THE CONTRACTOR WILL PROVIDE THE AS-BUILT DRAWINGS TO THE OWNER TO BE USED FOR THE WATER LINE.
  - CERTIFICATION AT THE COMPLETION OF THE PROJECT. ANY WATER ENTERING THE SANITARY SEWER SYSTEM TO BE CONSTRUCTED UNDER THE APPROVED PLANS SHALL NOT BE DISCHARGED TO THE EXISTING SEWER SYSTEM. PLUGS SHALL BE INSTALLED IN EXISTING MANHOLES AS NECESSARY TO PERMIT PUMPING THE NEW SYSTEM CLEAR OF WATER AND DEBRIS PRIOR TO ACCEPTANCE BY THE CITY. CARE SHALL BE EXERCISED IN LOCATING PLUGS TO AVOID INTERRUPTING SERVICE TO EXISTING CONNECTIONS. MECHANICAL PLUGS OR MORTAR AND BRICK MUST BE USED. INFLATABLE DEVICES ARE NOT ALLOWED.
  - HORIZONTAL DIMENSIONS GIVEN FOR UNDERGROUND UTILITY TIES ARE APPROXIMATE UNLESS OTHERWISE NOTED.
  - THE CONTRACTOR SHALL BE RESPONSIBLE FOR CONTACTING ALL UTILITY COMPANIES AFFECTED BY THE PROPOSED WORK.
  - THE GENERAL CONTRACTOR SHALL OBTAIN ALL NECESSARY PERMITS TO COMPLETE THE PROPOSED WORK, AND SHALL COMPLY WITH ALL LOCAL, STATE, AND FEDERAL REGULATIONS.
  - PIPE SHALL BE LAID UPSTREAM WITH THE SPIGOT ENDS POINTING DOWNSTREAM. ALL PIPES SHALL BE PLACED TRUE TO LINE AND GRADE WITH ENDS ABUTTING CAREFULLY CENTERED, AND WITH A SMOOTH INVERT AT THE JOINT.
  - LATERAL SEPARATION OF SEWERS AND WATER MAINS: WATER MAINS SHALL BE LAID AT LEAST 10 FEET LATERALLY FROM EXISTING OR PROPOSED SEWERS, UNLESS LOCAL CONDITIONS OR BARRIERS PREVENT A 10-FOOT LATERAL SEPARATION—IN WHICH CASE:
  - THE WATER MAIN IS LAID IN A SEPARATE TRENCH, WITH THE ELEVATION OF THE BOTTOM OF THE WATER MAIN AT LEAST 24 INCHES ABOVE THE TOP OF THE SEWER; OR
  - THE WATER MAIN IS LAID IN THE SAME TRENCH AS THE SEWER WITH THE WATER MAIN LOCATED AT ONE SIDE ON A BENCH OF UNDISTURBED EARTH, AND WITH THE ELEVATION OF THE BOTTOM OF THE WATER MAIN AT LEAST 24 INCHES ABOVE THE TOP OF THE SEWER.
8. CROSSING A WATER MAIN OVER A SEWER: WHENEVER IT IS NECESSARY FOR A WATER MAIN TO CROSS OVER A SEWER, THE WATER MAIN SHALL BE LAID AT SUCH AN ELEVATION THAT THE BOTTOM OF THE WATER MAIN IS AT LEAST 24 INCHES ABOVE THE TOP OF THE SEWER, UNLESS LOCAL CONDITIONS OR BARRIERS PREVENT AN 24 INCH VERTICAL SEPARATION—IN WHICH CASE BOTH THE WATER MAIN AND SEWER SHALL BE CONSTRUCTED OF FERROUS MATERIALS AND WITH JOINTS THAT ARE EQUIVALENT TO WATER MAIN STANDARDS FOR A DISTANCE OF 10 FEET ON EACH SIDE OF THE POINT OF CROSSING.
9. CROSSING A WATER MAIN UNDER A SEWER: WHENEVER IT IS NECESSARY FOR A WATER MAIN TO CROSS UNDER A SEWER, BOTH THE WATER MAIN AND THE SEWER SHALL BE CONSTRUCTED OF FERROUS MATERIALS AND WITH JOINTS EQUIVALENT TO WATER MAIN STANDARDS FOR A DISTANCE OF 10 FEET ON EACH SIDE OF THE POINT OF CROSSING. A SECTION OF WATER MAIN PIPE SHALL BE CENTERED AT THE POINT OF CROSSING.
10. ALL MAINS, LATERALS AND APPURTENANCES SHALL BE TESTED IN ACCORDANCE WITH LILLINGTON PW AND NCEQ TECHNICAL SPECIFICATIONS.
11. ALL MATERIALS SHALL BE APPROVED BY LILLINGTON PW BEFORE INSTALLATION.
12. THE CONTRACTOR SHALL NOTIFY THE ENGINEER OF RECORD AND LILLINGTON PW A MINIMUM OF 48 HOURS BEFORE CONSTRUCTION OF THE WATER LINE AND SANITARY SEWER LINE BEGINS. THE CONTRACTOR SHALL ALSO NOTIFY THE ENGINEER OF RECORD AND LILLINGTON PW 48 HOURS IN ADVANCE OF ALL TESTING.
13. EXISTING UTILITIES NOT FOUND IN THE FIELD DURING SURVEY MAY REQUIRE DEMOLITION. NO UTILITIES SHALL BE LEFT IN PLACE THAT CROSS THE NEW UTILITIES UNLESS RUNNING ALONG A LOT LINE. IF ADDITIONAL UTILITIES ARE FOUND, CONTACT ENGINEER PRIOR TO DEMOLITION.
14. ALL ELEVATIONS ARE IN NAVD 88 DATUM.
15. WATERLINES TO BE INSPECTED, OPERATED, AND MAINTAINED BY HRW.
16. SEWER LINES TO BE INSPECTED, OPERATED, AND MAINTAINED BY THE TOWN OF LILLINGTON.
17. SANITARY SEWER INSTALLATION TO BE PERFORMED IN ACCORDANCE WITH THE TOWN OF LILLINGTON DETAILED "SANITARY SEWER SPECIFICATIONS".
18. SEWER CLEANOUTS GREATER THAN 6 FT IN DEPTH TO SATISFY UTILITY SEPARATION REQUIREMENTS PER TOL STANDARDS. WHERE POSSIBLE, DEEP SEWER LATERALS TO BE INSTALLED PER DETAIL S-4.1 (SEE SHEET C-6.8).

N/F  
BRUCE JOHNSON, LLC  
DB 4109, PG 436

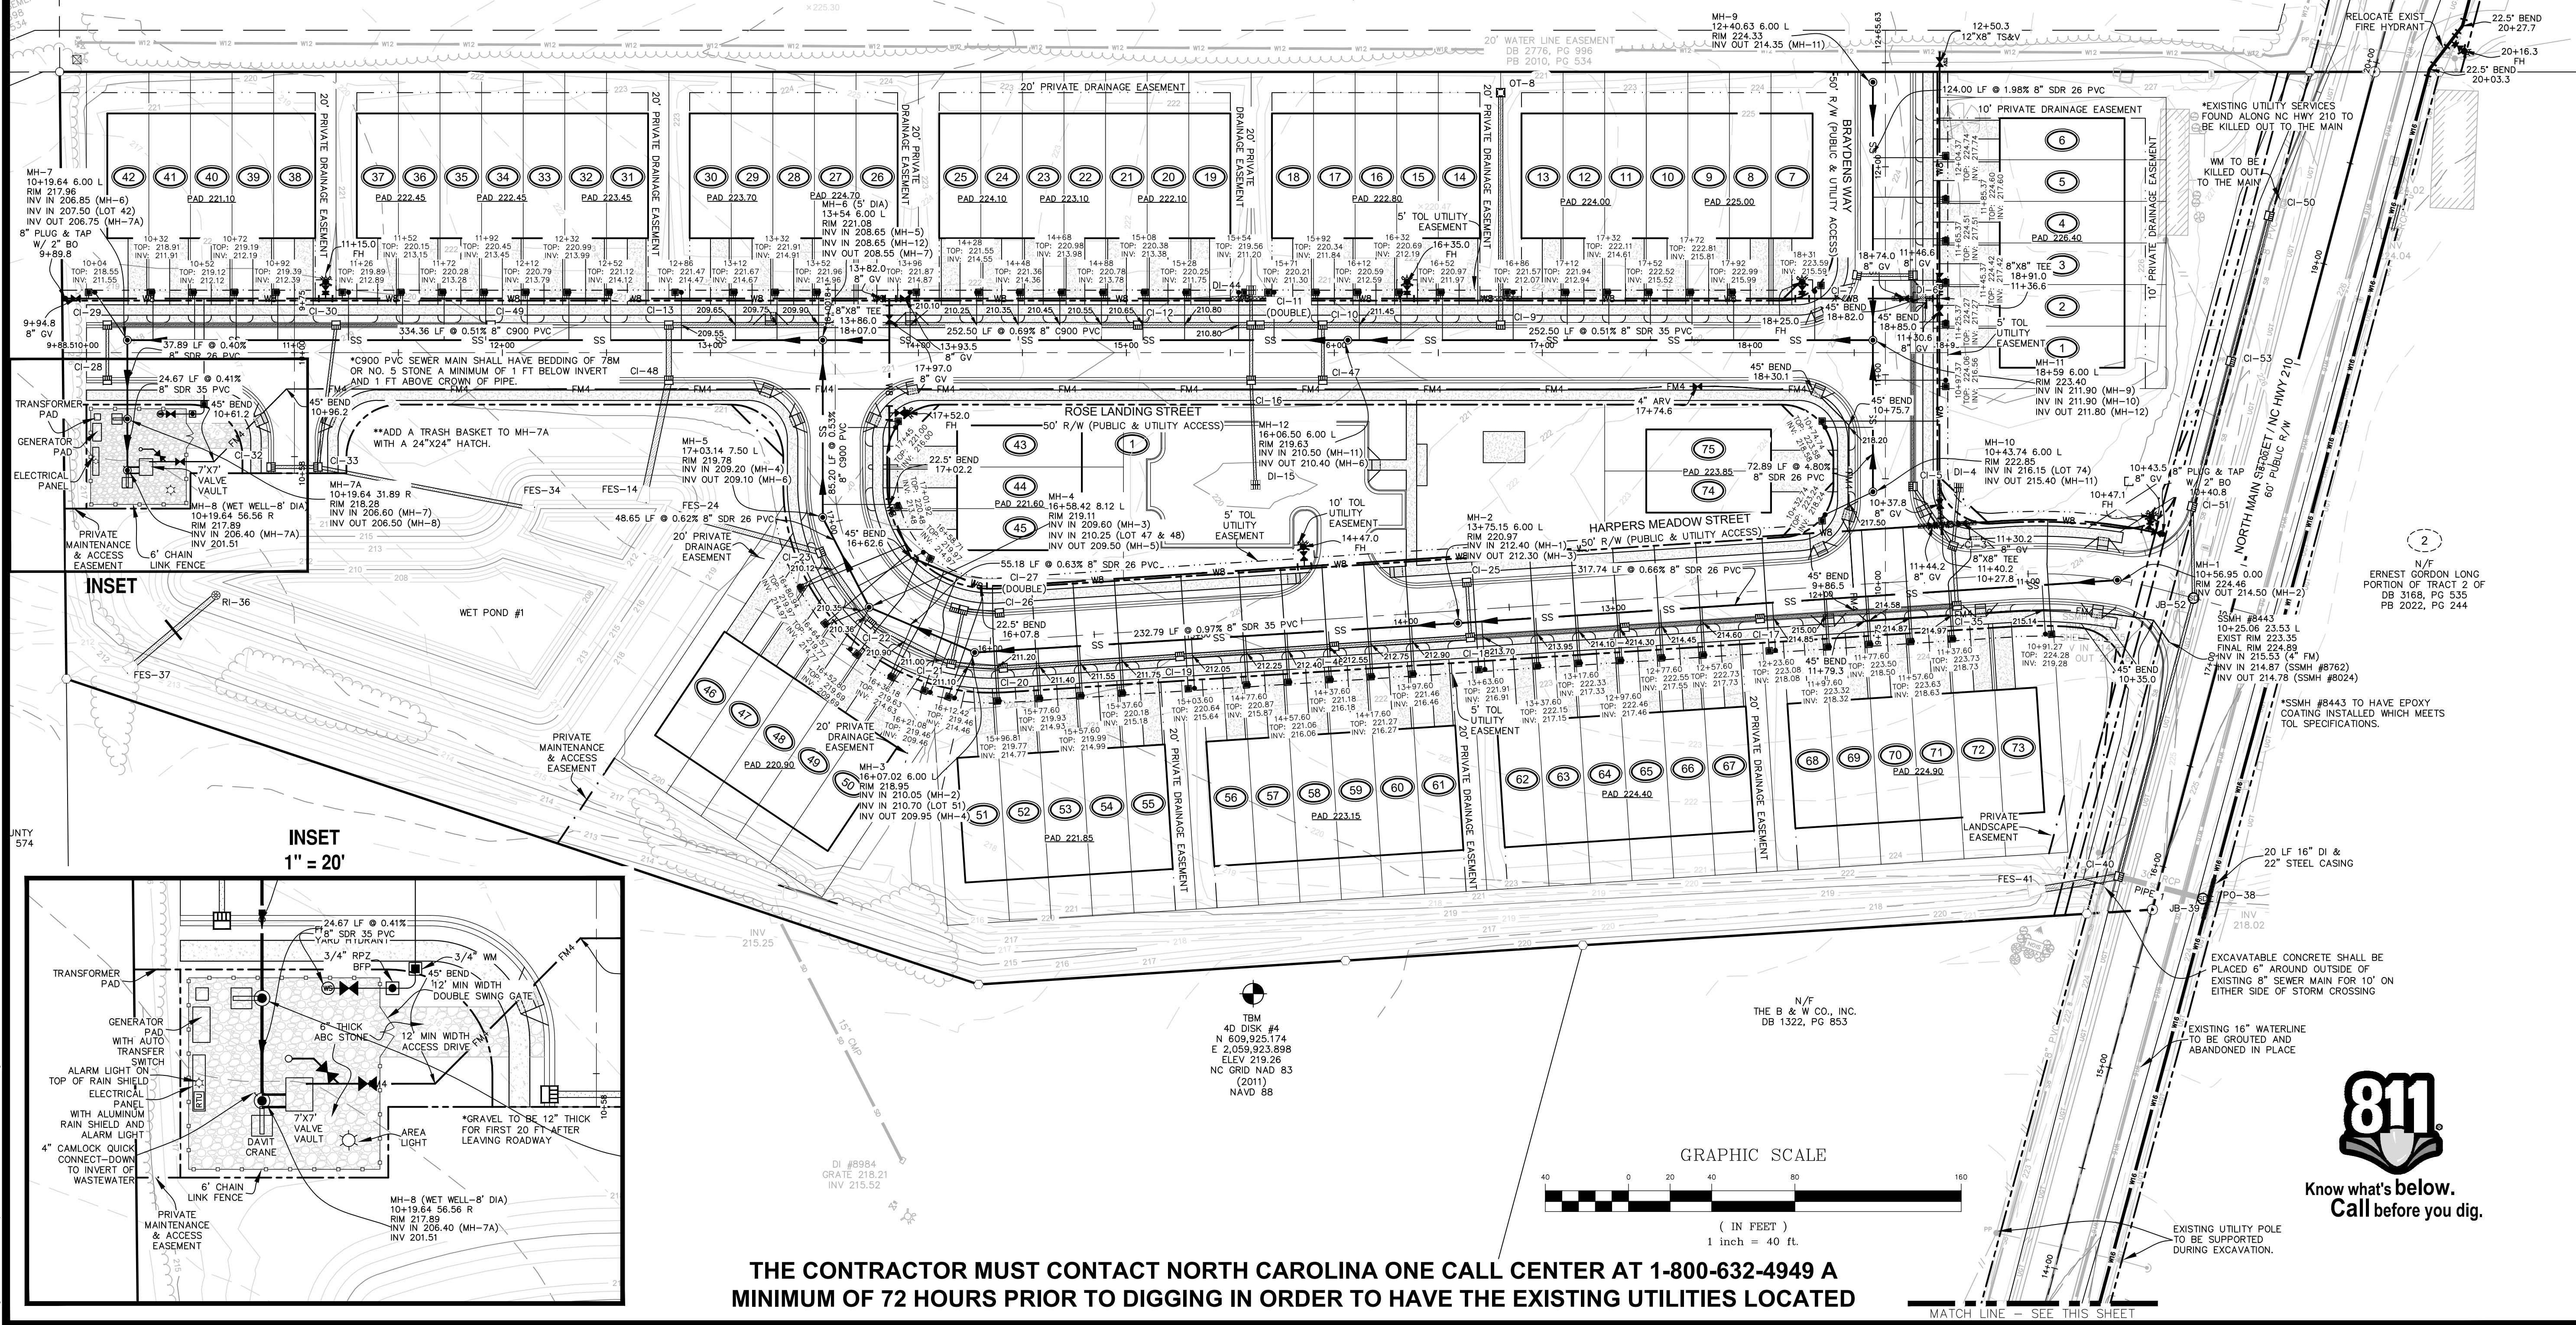

4Dsite solutions  
civil engineering / land surveying  
409 Chicago Drive, Suite 112, Fayetteville, NC 28406  
office | 910-426-6777 fax | 910-426-5777 license number | C-2354  
www.4Dsite.com

08-29-24

REVISIONS

ISSUED FOR CONSTRUCTION
-------------------------

08-29-24 ADDED MH-7A

PROJECT NAME

**HARPER'S MEADOW**

PIN:

**0651-90-8197.000**

CLIENT

**TRIANGLE LAND PARTNERS, LLC**

PO Box 5548  
Cary, North Carolina 27512  
Phone: (704) 608-3085

PROJECT INFORMATION

DESIGNED BY:	CALEB
DRAWN BY:	CALEB
CHECKED BY:	SCOTT
PROJECT NUMBER:	1896

DRAWING SCALE

HORIZONTAL: 1"=40'


DATE RELEASED

MARCH 22, 2024

SHEET NUMBER

**C-4.0**



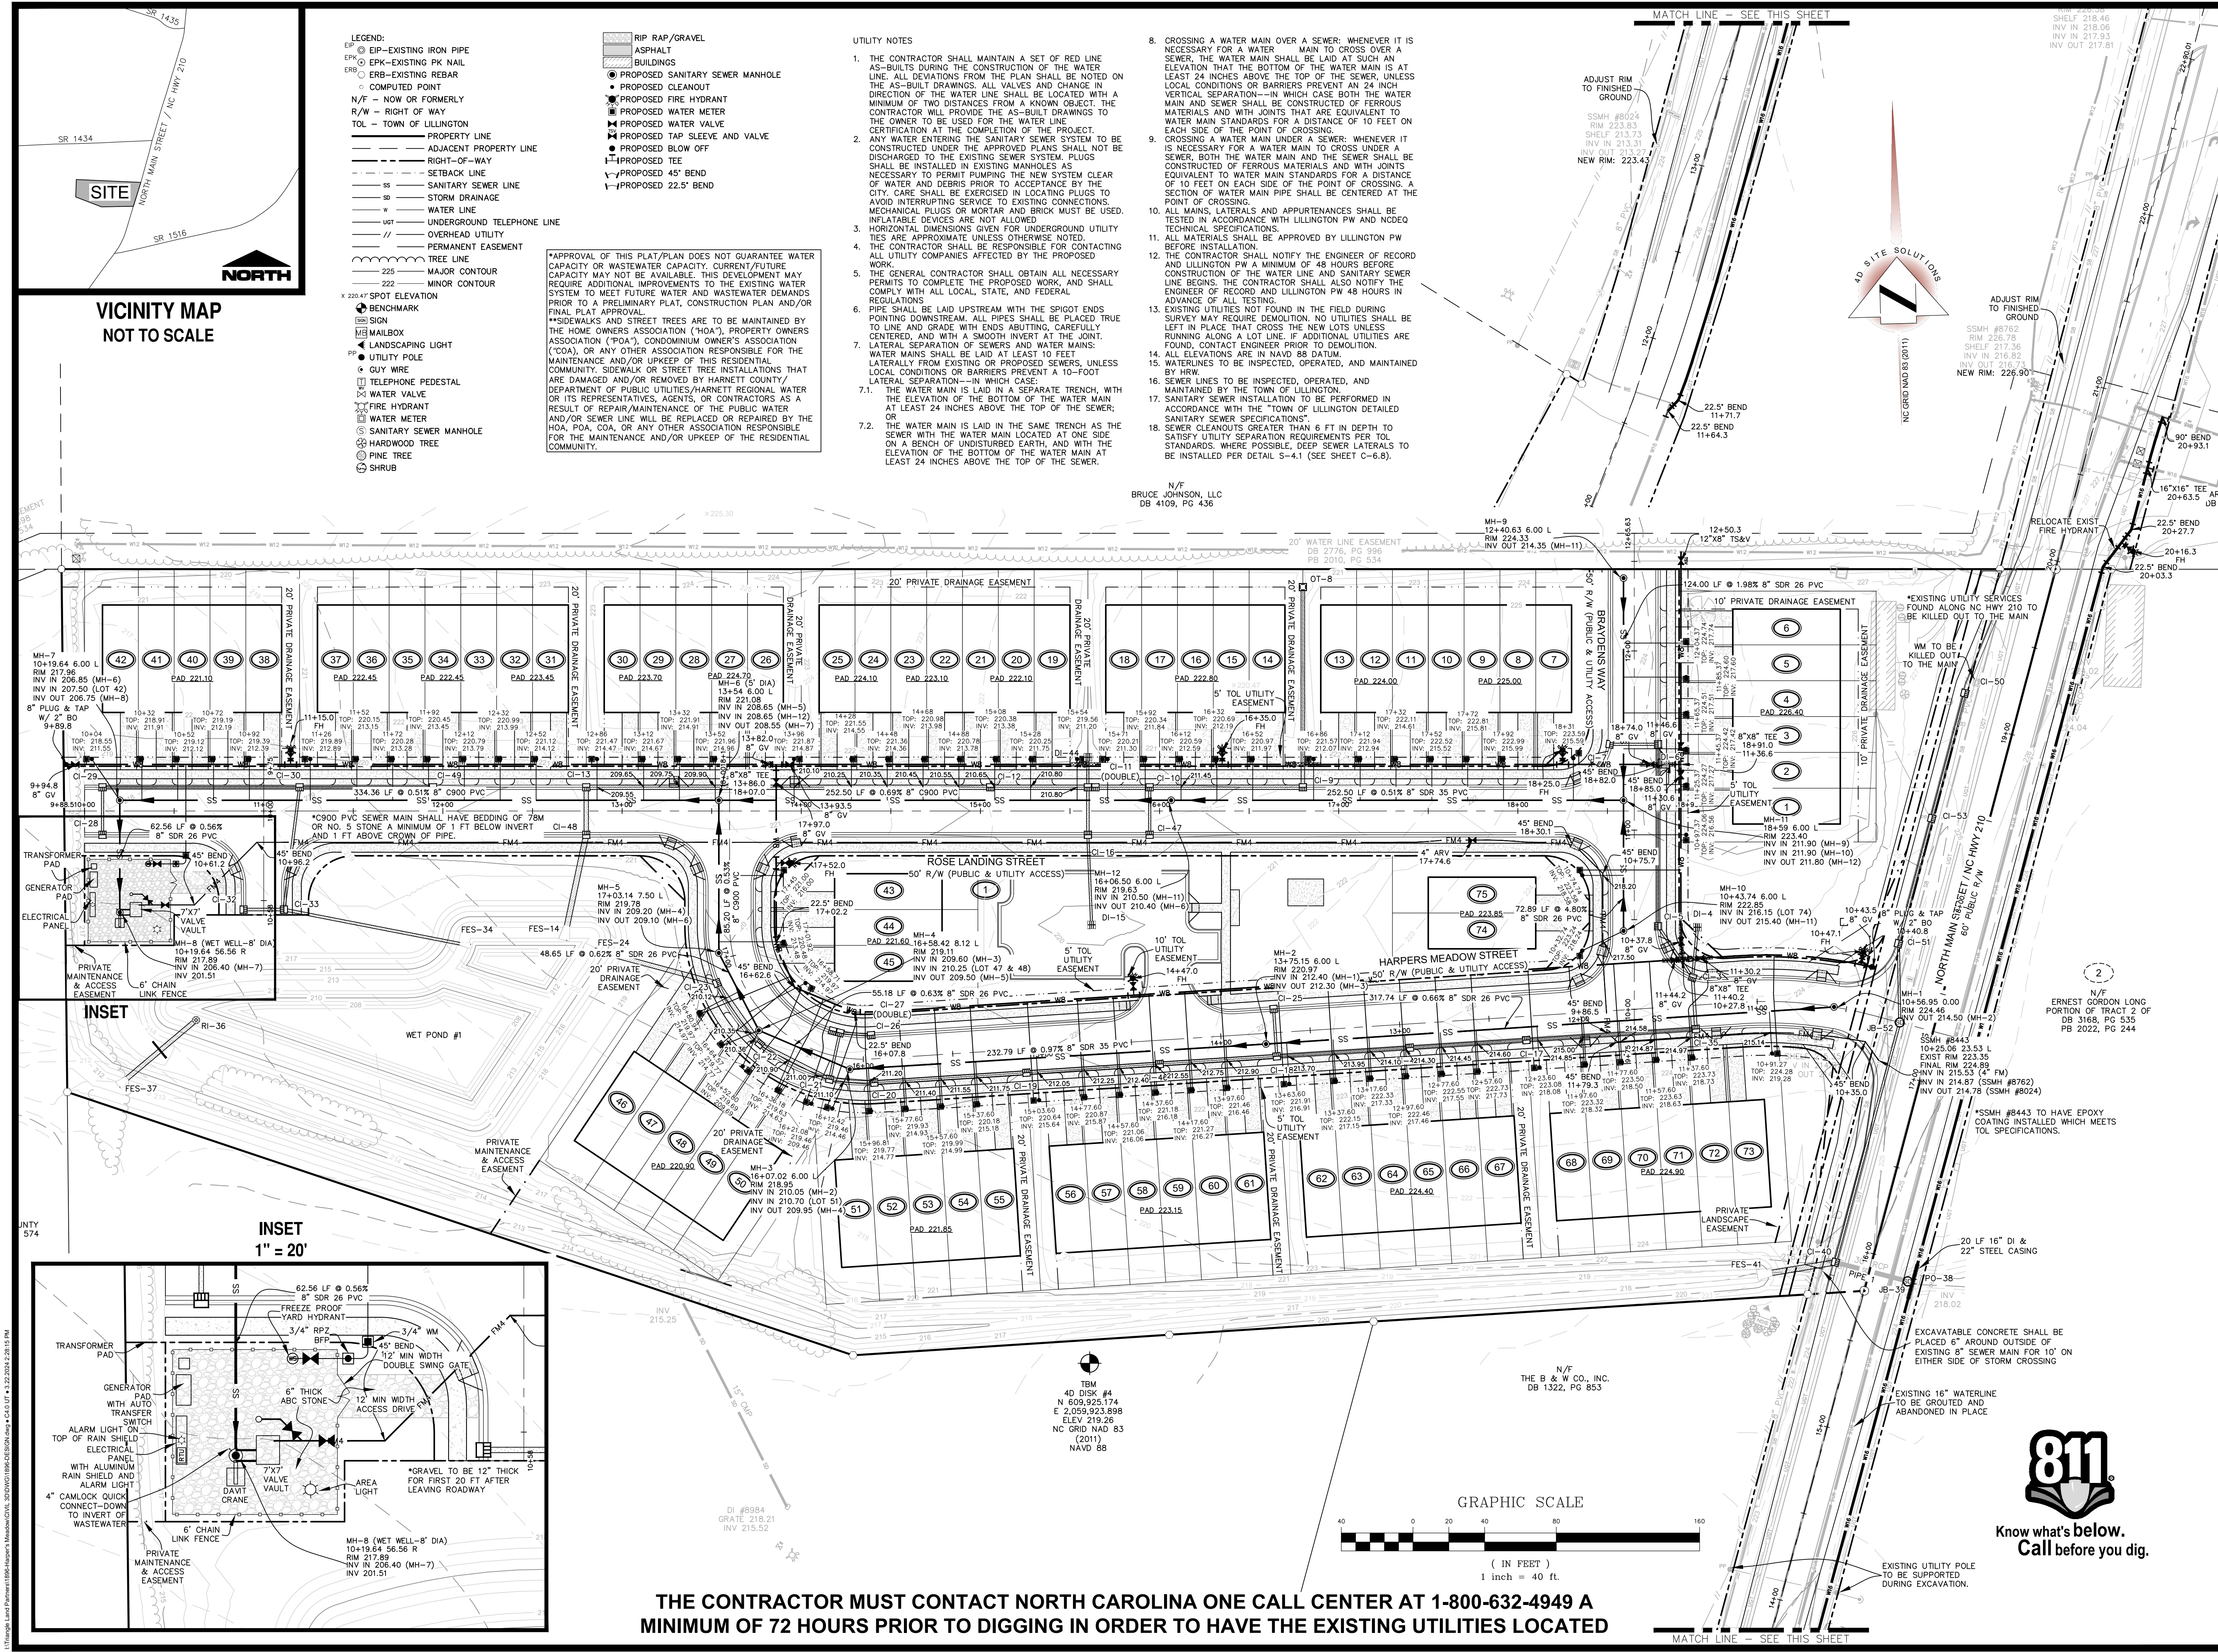

4Dsite solutions  
civil engineering / land surveying  
409 Chicago Drive, Suite 112, Fayetteville, NC 28406  
office: 910-426-6777 fax: 910-426-5777 license number: C-2354  
www.4Dsite.com

03-22-24

REVISIONS

ISSUED FOR CONSTRUCTION

PROJECT NAME

**HARPER'S MEADOW**

PIN:

**0651-90-8197.000**

CLIENT

**TRIANGLE LAND PARTNERS, LLC**

PO Box 5548  
Cary, North Carolina 27512  
Phone: (704) 608-3085

PROJECT INFORMATION

DESIGNED BY:	CALEB
DRAWN BY:	CALEB
CHECKED BY:	SCOTT
PROJECT NUMBER:	1896

DRAWING SCALE

HORIZONTAL: 1"=40'


DATE RELEASED

MARCH 22, 2024

SHEET NUMBER

**C-4.0**



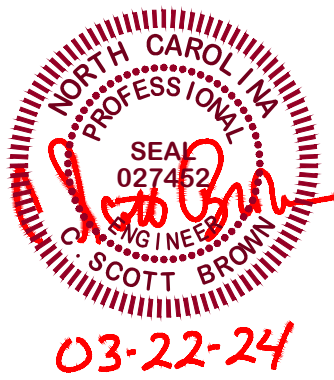

REVISIONS

ISSUED FOR CONSTRUCTION

PROJECT NAME

HARPER'S MEADOW

STORM & SEWER STRUCTURE DATA

CLIENT

TRIANGLE LAND PARTNERS, LLC

PO Box 5548  
Cary, North Carolina 27512  
Phone: (704) 608-3085

PROJECT INFORMATION

DESIGNED BY:	CALEB
DRAWN BY:	CALEB
CHECKED BY:	SCOTT
PROJECT NUMBER:	1896

DRAWING SCALE

HORIZONTAL: 1"=40'

DATE RELEASED

MARCH 22, 2024

SHEET NUMBER

C-4.1



SEWER STRUCTURE TABLE					
STRUCTURE	DIA	RIM EL	STRUCTURE IN	INVERT IN	INV OUT
MH-1	4'	224.46			214.50
MH-2	4'	220.97	MH-1	212.40	212.30
MH-3	4'	218.95	MH-2 LOT 51	210.05 210.70	209.95
MH-4	4'	219.11	MH-3 LOT 47 & 48	209.60 210.25	209.50
MH-5	4'	219.78	MH-4	209.20	209.10
MH-6	5'	221.08	MH-5 MH-12	208.65 208.65	208.55
MH-7	4'	217.96	MH-6 LOT 42	206.85 207.50	206.75
MH-8	8"	217.89	MH-7	206.40	
MH-9	4'	224.33			214.35
MH-10	4'	222.85	LOT 74	216.15	215.40
MH-11	4'	223.40	MH-9 MH-10	211.90 211.90	211.80
MH-12	4'	219.63	MH-11	210.50	210.40

SEWER PIPE TABLE						
UPSTREAM STRUCTURE	DOWNSTREAM STRUCTURE	SIZE	LENGTH	SLOPE	UPSTREAM INVERT	DOWNSTREAM INVERT
MH-1	MH-2	8"	317.74	0.66%	214.50	212.40
MH-2	MH-3	8"	232.79	0.97%	212.30	210.05
MH-3	MH-4	8"	55.18	0.63%	209.95	209.60
MH-4	MH-5	8"	48.65	0.62%	209.50	209.20
MH-5	MH-6	8"	85.20	0.53%	209.10	208.65
MH-6	MH-7	8"	334.36	0.51%	208.55	206.85
MH-7	MH-8	8"	62.56	0.56%	206.75	206.40
MH-9	MH-11	8"	124.00	1.98%	214.35	211.90
MH-10	MH-11	8"	72.89	4.80%	215.40	211.90
MH-11	MH-12	8"	252.50	0.51%	211.80	210.50
MH-12	MH-6	8"	252.50	0.69%	210.40	208.65

STORM STRUCTURE TABLE				
STRUCTURE	TOP EL	STRUCTURE IN	INVERT IN	INV OUT
CI-3	223.51	CI-5 DI-4	218.29 (15") 219.29 (15")	218.04 (18")
CI-5	223.17	CI-6	218.47 (15")	218.47 (15")
CI-6	223.93	CI-7	219.03 (15")	219.03 (15")
CI-7	223.86			219.17 (15")
CI-9	220.96	OT-8	216.81 (24")	215.01 (30")
CI-10	219.80	CI-9 CI-47	213.85 (30") 215.15 (15")	213.85 (30")
CI-11	219.64	CI-10 CI-16 DI-44	213.58 (30") 214.58 (18") 216.03 (15")	213.58 (30")
CI-12	220.03	CI-11	213.30 (30")	213.30 (30")
CI-13	220.91	CI-12	212.15 (30")	212.00 (30")
CI-16	219.64	DI-15	214.97 (15")	214.72 (18")
CI-17	222.59	CI-35	217.42 (18")	217.42 (18")
CI-18	221.32	CI-45 CI-25	216.23 (18") 216.48 (15")	215.73 (24")
CI-19	220.04	CI-46	214.59 (24")	214.59 (24")
CI-20	219.29	CI-19	213.84 (24")	213.84 (24")
CI-21	219.24	CI-20 CI-27	213.61 (24") 214.36 (15")	213.61 (24")
CI-22	219.42	CI-21	213.39 (24")	212.99 (30")
CI-23	219.89	CI-22	212.78 (30")	212.68 (30")
CI-25	221.32			216.62 (15")
CI-26	219.29			214.59 (15")
CI-27	219.23	CI-26	214.50 (15")	214.50 (15")
CI-28	218.16			213.46 (15")
CI-29	218.16	CI-28	213.33 (15")	213.33 (15")
CI-30	219.28	CI-29 CI-49	212.78 (15") 214.68 (15")	212.78 (15")
CI-32	218.66			213.90 (18")
CI-33	218.66	CI-32 CI-30	213.75 (18") 212.45 (15")	212.20 (18")
CI-35	223.49	CI-3	217.89 (18")	217.89 (18")
CI-40	224.79	JB-39 JB-52	218.16 (30") 219.66 (15")	217.80 (36")
CI-45	222.00	CI-17	216.86 (18")	216.86 (18")
CI-46	220.72	CI-18	215.20 (24")	215.20 (24")
CI-47	219.80			215.30 (15")
CI-48	220.91	CI-13	211.85 (30")	211.50 (36")
CI-49	220.04			215.24 (15")
DI-4	222.23			219.85 (15")
DI-15	219.70			215.25 (15")
DI-44	218.80			216.20 (15")
FES-14	214.62	CI-48	211.20 (36")	
FES-24	214.88	CI-23	212.00 (30")	
FES-34	213.44	CI-33	211.65 (18")	
FES-37	214.28	RI-36	211.40 (30")	
FES-41	221.02	CI-40	217.60 (36")	
JB-39	223.98	PO-38	219.40 (30")	218.02 (30")
OT-8	221.65			217.90 (24")
RI-36	216.65			212.50 (30")



STORM PIPE TABLE						
UPSTREAM STRUCTURE	DOWNSTREAM STRUCTURE	SIZE	LENGTH	SLOPE	UPSTREAM INVERT	DOWNSTREAM INVERT
		15"	12.70'	3.15%	223.70	223.30
CI-3	CI-35	18"	28.76'	0.52%	218.04	217.89
CI-5	CI-3	15"	34.56'	0.51%	218.47	218.29
CI-6	CI-5	15"	101.54'	0.55%	219.03	218.47
CI-7	CI-6	15"	26.90'	0.52%	219.17	219.03
CI-9	CI-10	30"	85.50'	1.36%	215.01	213.85
CI-10	CI-11	30"	34.50'	0.77%	213.85	213.58
CI-11	CI-12	30"	54.50'	0.51%	213.58	213.30
CI-12	CI-13	30"	225.50'	0.51%	213.30	212.15
CI-13	CI-48	30"	26.50'	0.57%	212.00	211.85
CI-16	CI-11	18"	26.50'	0.53%	214.72	214.58
CI-17	CI-45	18"	65.10'	0.85%	217.42	216.86
CI-18	CI-46	24"	65.50'	0.81%	215.73	215.20
CI-19	CI-20	24"	85.17"	0.88%	214.59	213.84
CI-20	CI-21	24"	24.94'	0.93%	213.84	213.61
CI-21	CI-22	24"	43.68'	0.50%	213.61	213.39
CI-22	CI-23	30"	41.55'	0.51%	212.99	212.78
CI-23	FES-24	30"	77.00'	0.88%	212.68	212.00
CI-25	CI-18	15"	26.50'	0.53%	216.62	216.48
CI-26	CI-27	15"	17.45'	0.53%	214.59	214.50
CI-27	CI-21	15"	26.50'	0.53%	214.50	214.36
CI-28	CI-29	15"	26.50'	0.50%	213.46	213.33
CI-29	CI-30	15"	110.00'	0.50%	213.33	212.78
CI-30	CI-33	15"	68.81'	0.48%	212.78	212.45
CI-32	CI-33	18"	22.50'	0.67%	213.90	213.75
CI-33	FES-34	18"	106.00'	0.52%	212.20	211.65
CI-35	CI-17	18"	94.90'	0.50%	217.89	217.42
CI-40	FES-41	36"	44.00'	0.45%	217.80	217.60
CI-45	CI-18	18"	74.50'	0.85%	216.86	216.23
CI-46	CI-19	24"	74.50'	0.81%	215.20	214.59
CI-47	CI-10	15"	26.50'	0.57%	215.30	215.15
CI-48	FES-14	36"	60.00'	0.50%	211.50	211.20
CI-49	CI-30	15"	74.50'	0.75%	215.24	214.68
CI-50	CI-53	15"	72.29'	0.82%	221.76	221.16
CI-51	JB-52	15"	44.00'	0.50%	220.57	220.35
CI-53	CI-51	15"	72.29'	0.82%	221.16	220.57
DI-4	CI-3	15"	28.19'	1.99%	219.85	219.29
DI-15	CI-16	15"	50.29'	0.56%	215.25	214.97
DI-44	CI-11	15"	16.75'	1.01%	216.20	216.03
JB-39	CI-40	30"	41.74'	-0.34%	218.02	218.16
JB-52	CI-40	15"	138.61'	0.50%	220.35	219.66
OT-8	CI-9	24"	111.75'	0.97%	217.90	216.81
PO-38	JB-39	30"	5.00'	2.00%	219.50	219.40
RI-36	FES-37	30"	56.61'	1.94%	212.50	211.40



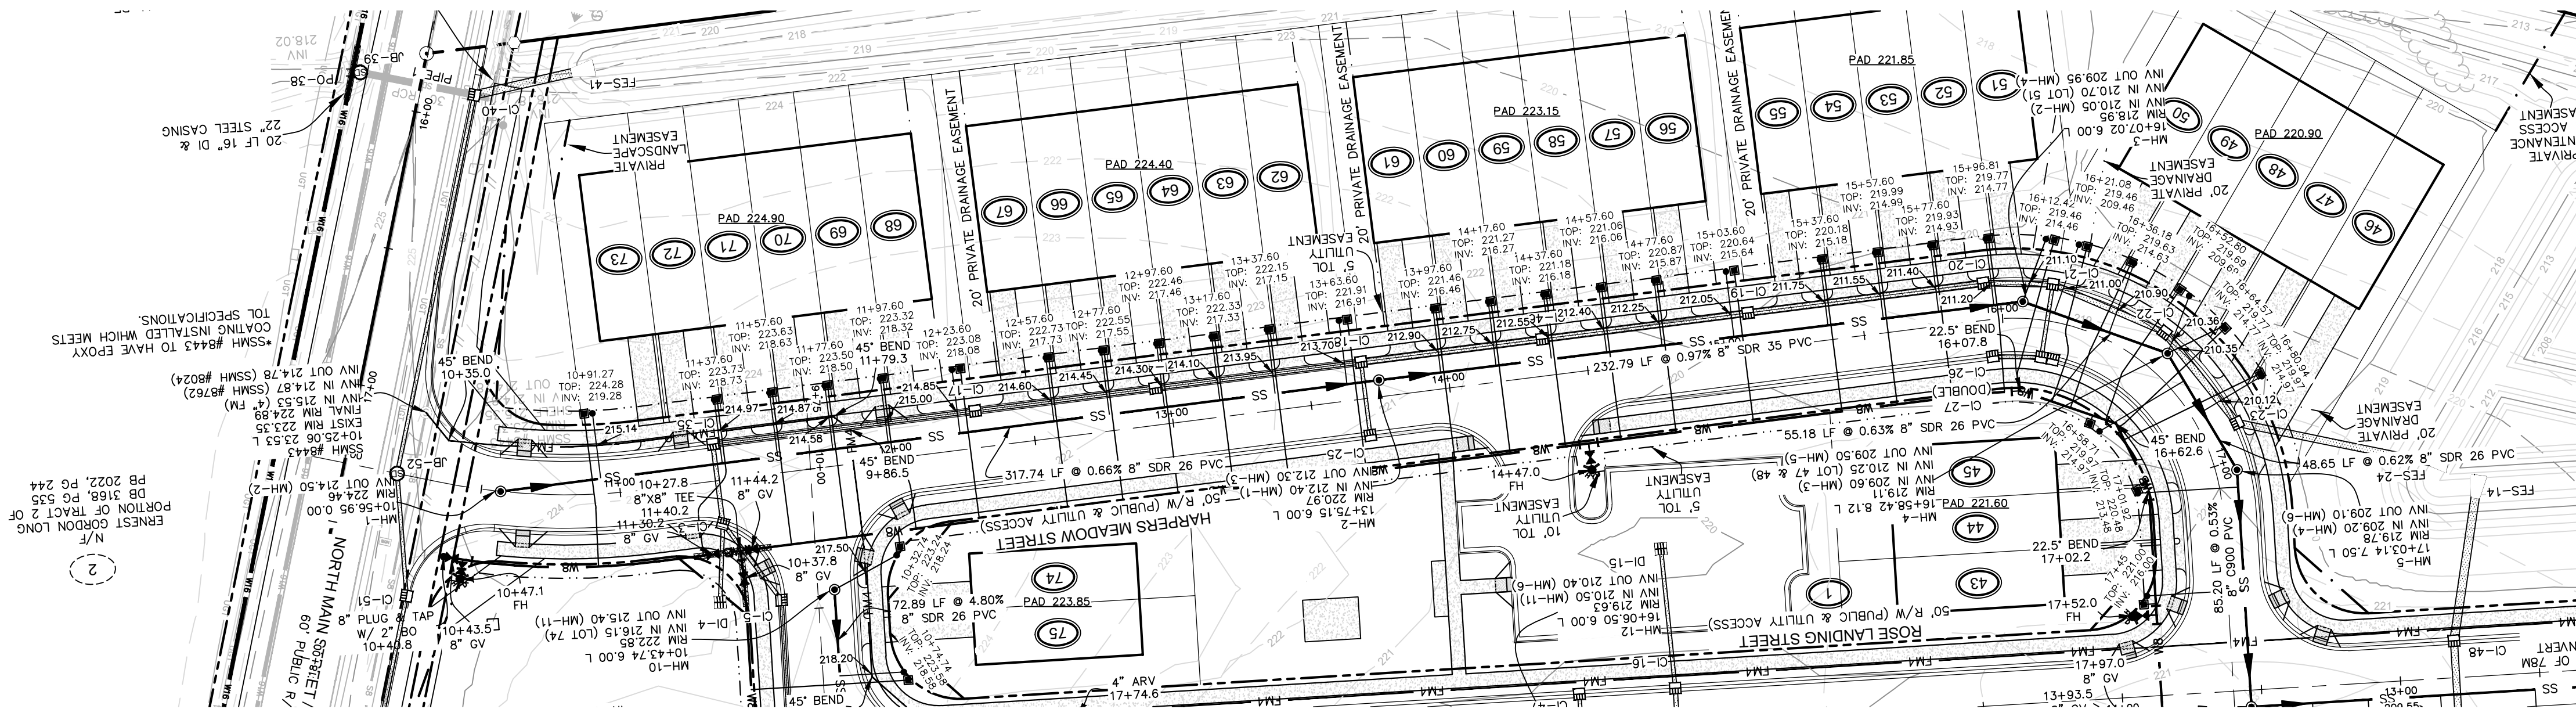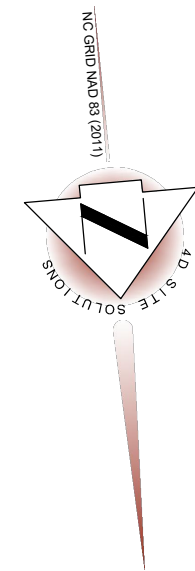

## HARPERS MEADOW STREET

50' R/W (PUBLIC STREET)  
ROADWAY PROFILE 9+50 TO 18+50

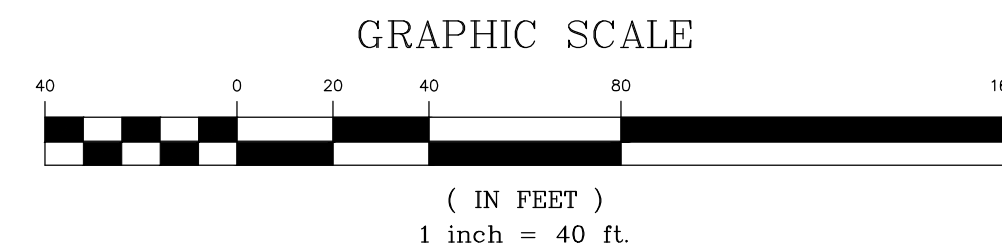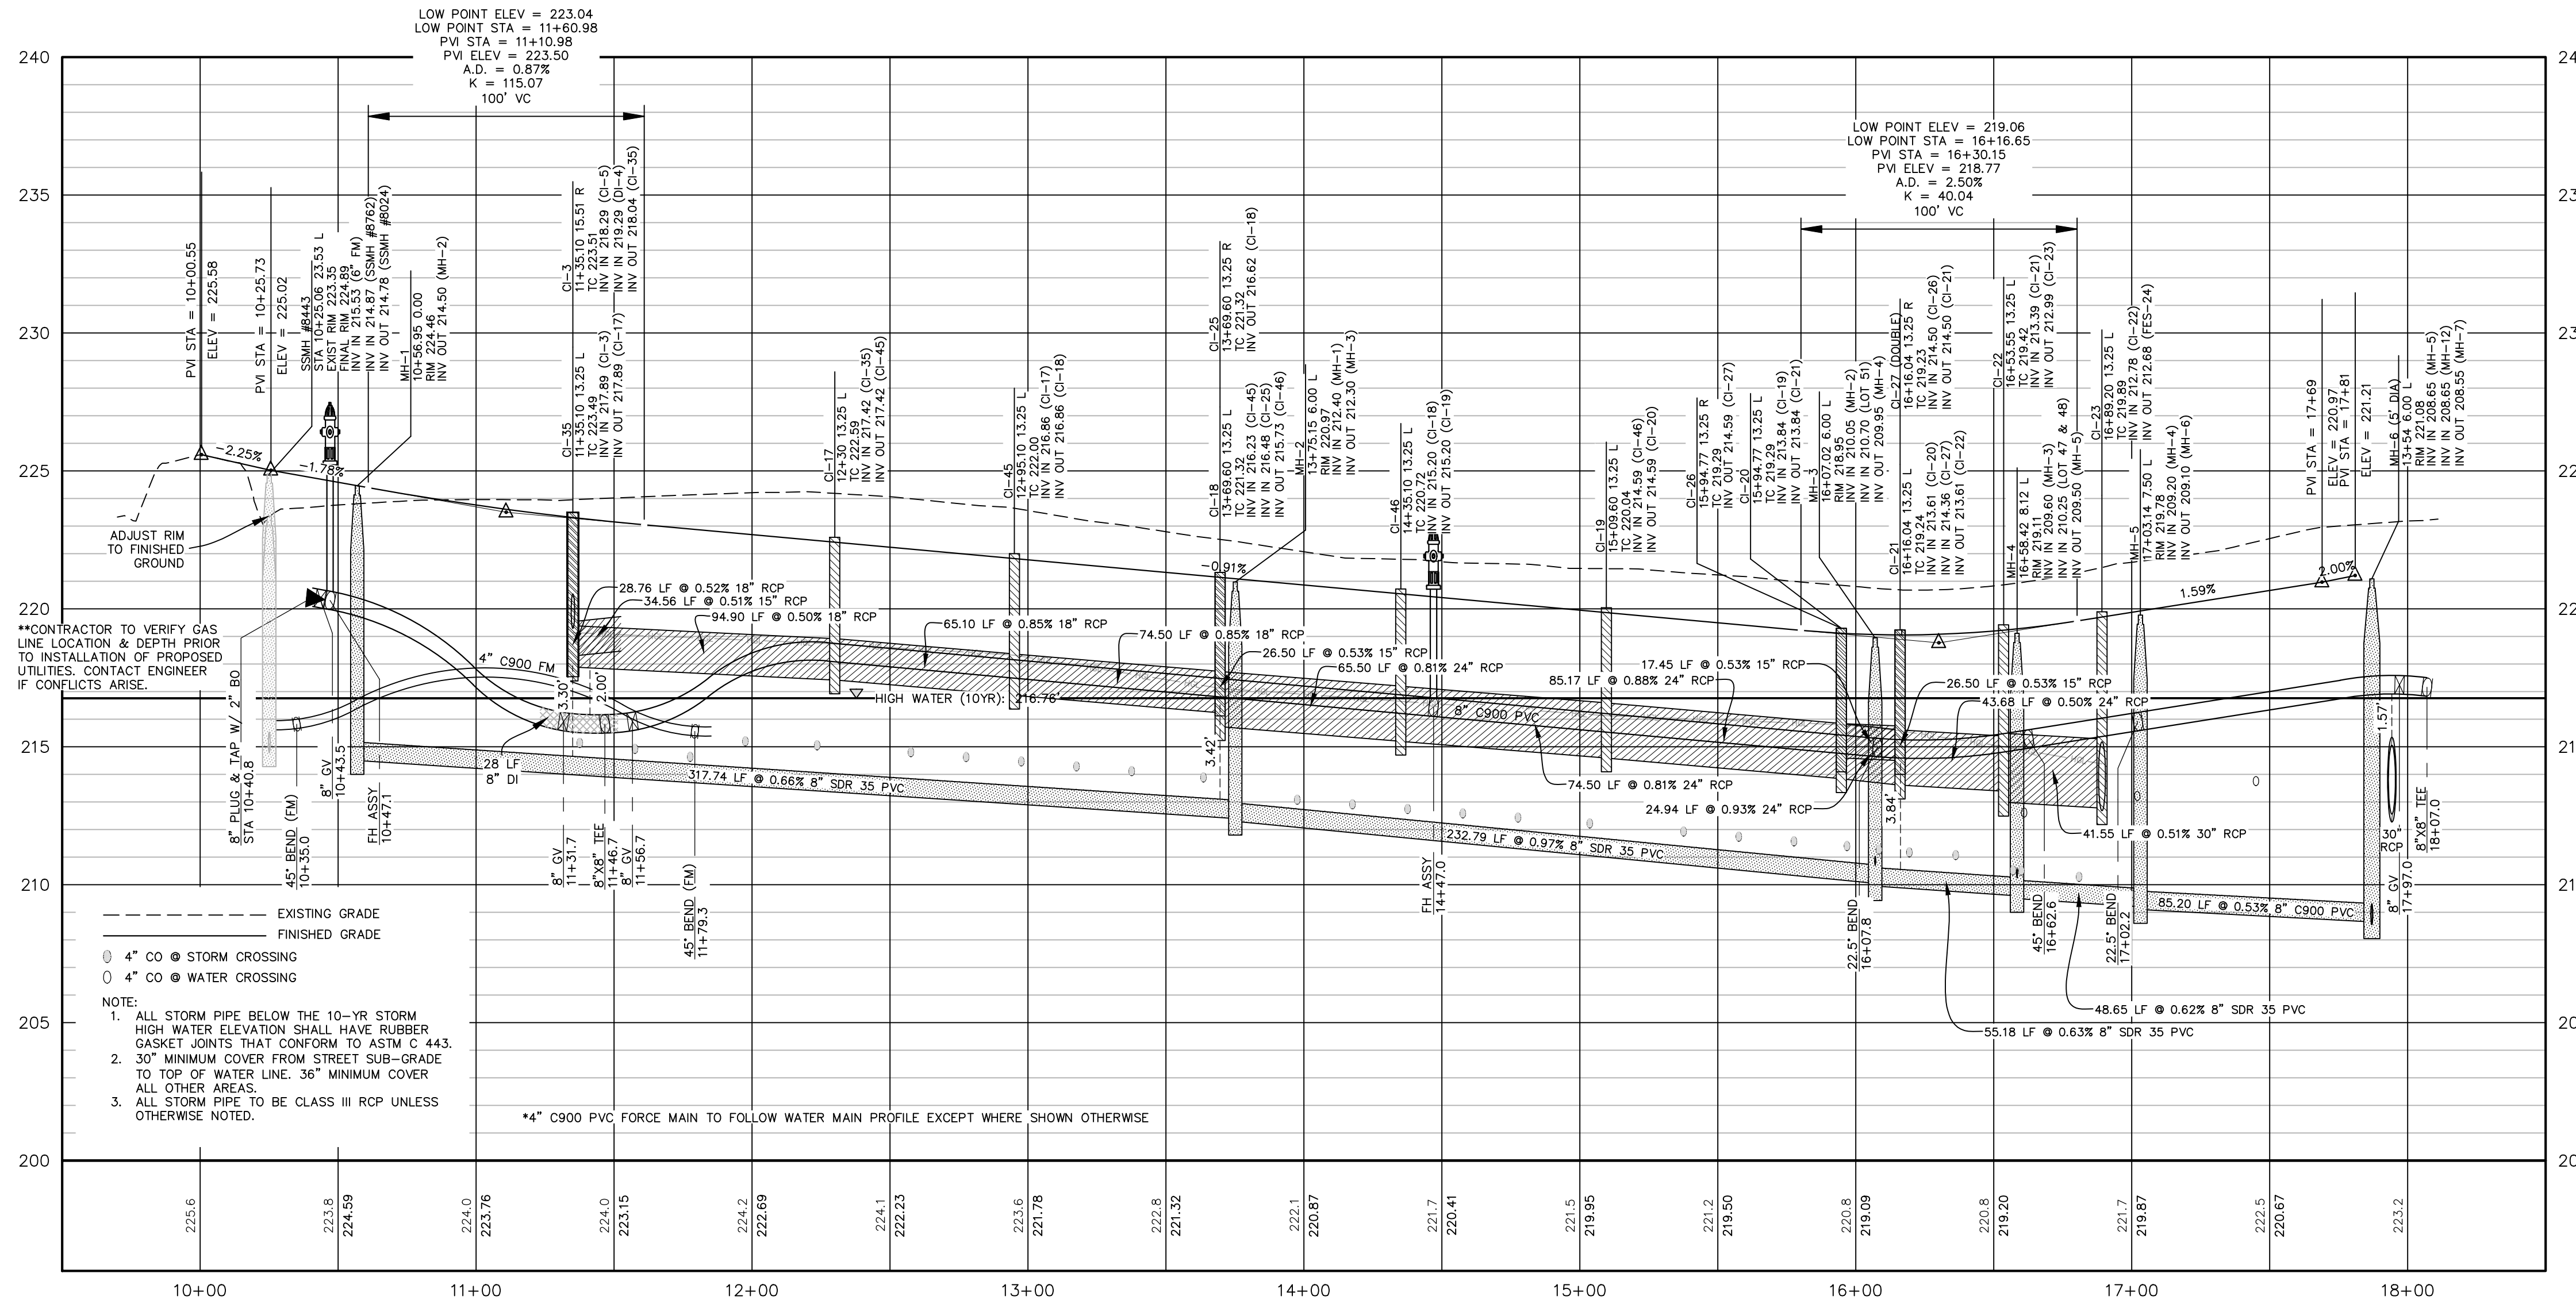

REVISIONS  
**ISSUED FOR CONSTRUCTION**

PROJECT NAME

**HARPER'S MEADOW**

**HARPERS MEADOW STREET PROFILE**

CLIENT

**TRIANGLE LAND PARTNERS, LLC**

PO Box 5548  
Cary, North Carolina 27512  
Phone: (704) 608-3085

PROJECT INFORMATION

DESIGNED BY:	CALEB
DRAWN BY:	CALEB
CHECKED BY:	SCOTT
PROJECT NUMBER:	1896

DRAWING SCALE

HORIZONTAL: 1"=40'  
VERTICAL: 1"=4'

DATE RELEASED

MARCH 22, 2024

SHEET NUMBER

**C-5.0**





REVISIONS  
ISSUED FOR CONSTRUCTION

PROJECT NAME

HARPER'S  
MEADOW

ROSE LANDING  
STREET PROFILE

CLIENT

TRIANGLE LAND  
PARTNERS, LLC

PO Box 5548  
Cary, North Carolina 27512  
Phone: (704) 608-3085

PROJECT INFORMATION

DESIGNED BY:	CALEB
DRAWN BY:	CALEB
CHECKED BY:	SCOTT
PROJECT NUMBER:	1896

DRAWING SCALE


HORIZONTAL: 1"=40'  
VERTICAL: 1"=4'

DATE RELEASED



MARCH 22, 2024

SHEET NUMBER

C-5.1

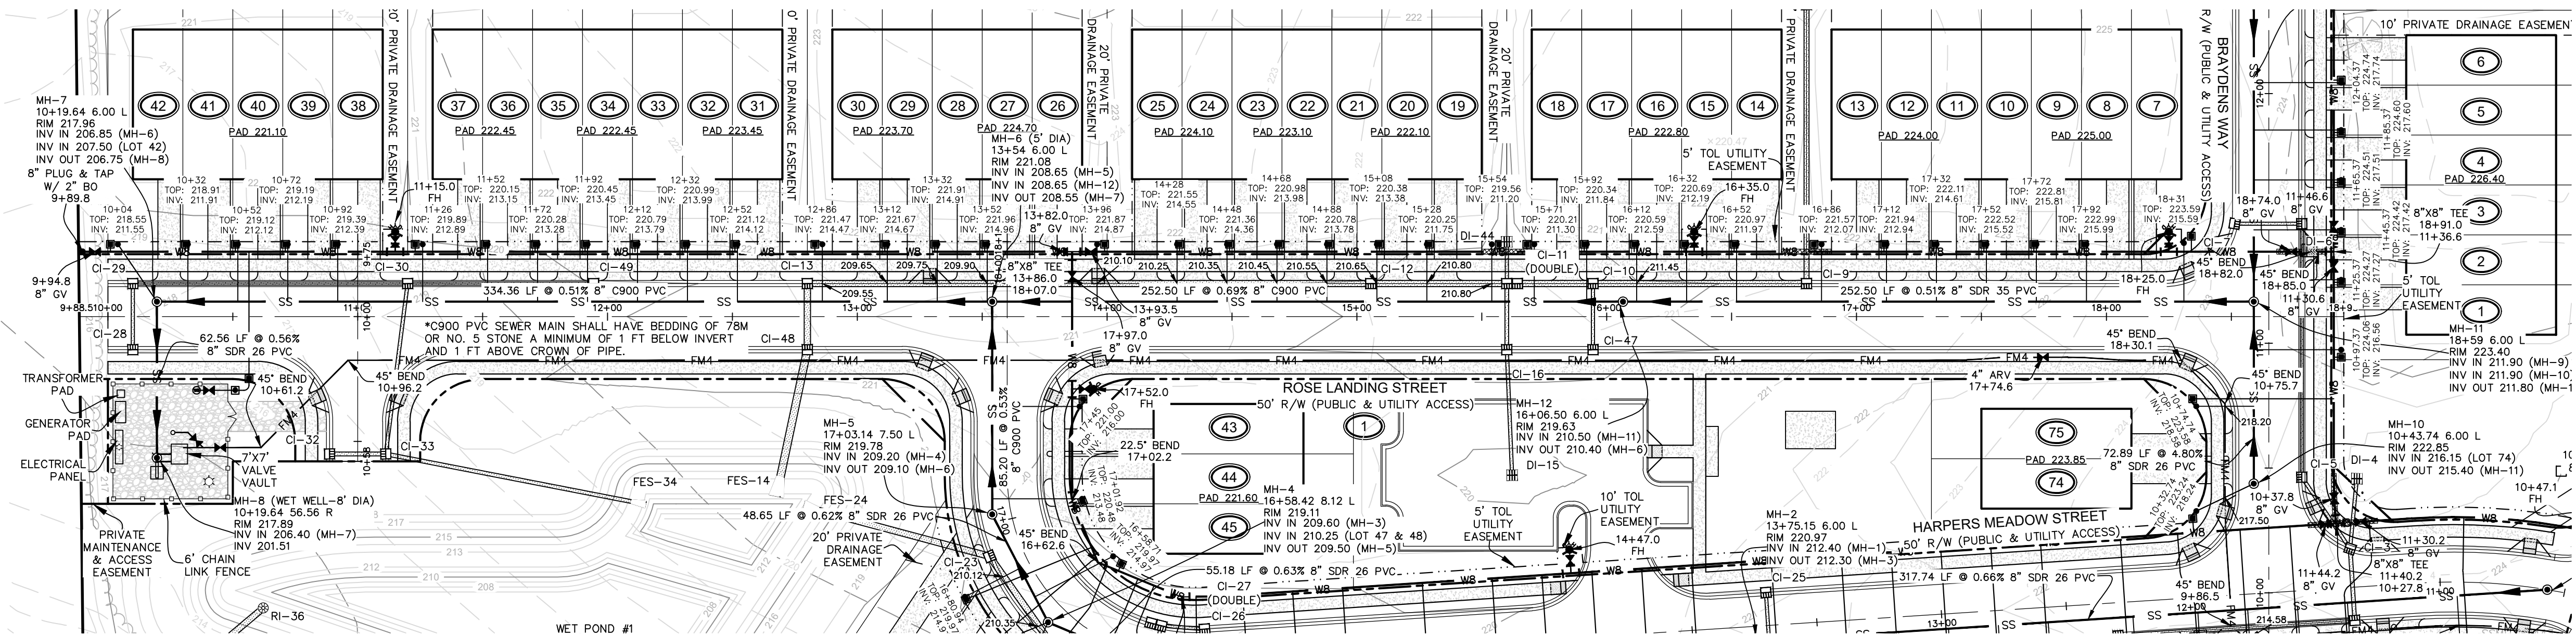

ROSE LANDING STREET  
50' R/W (PUBLIC STREET)  
ROADWAY PROFILE 9+50 TO 19+00

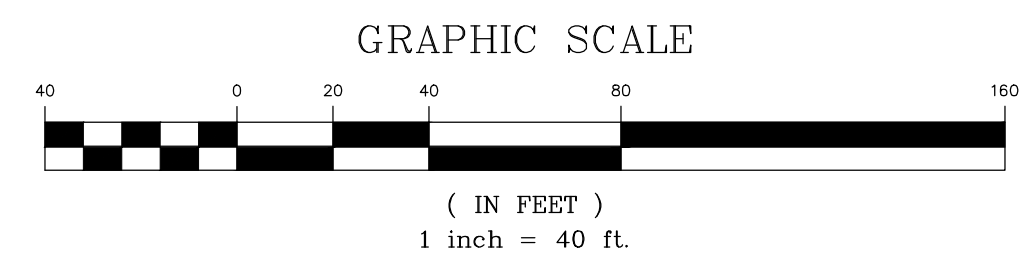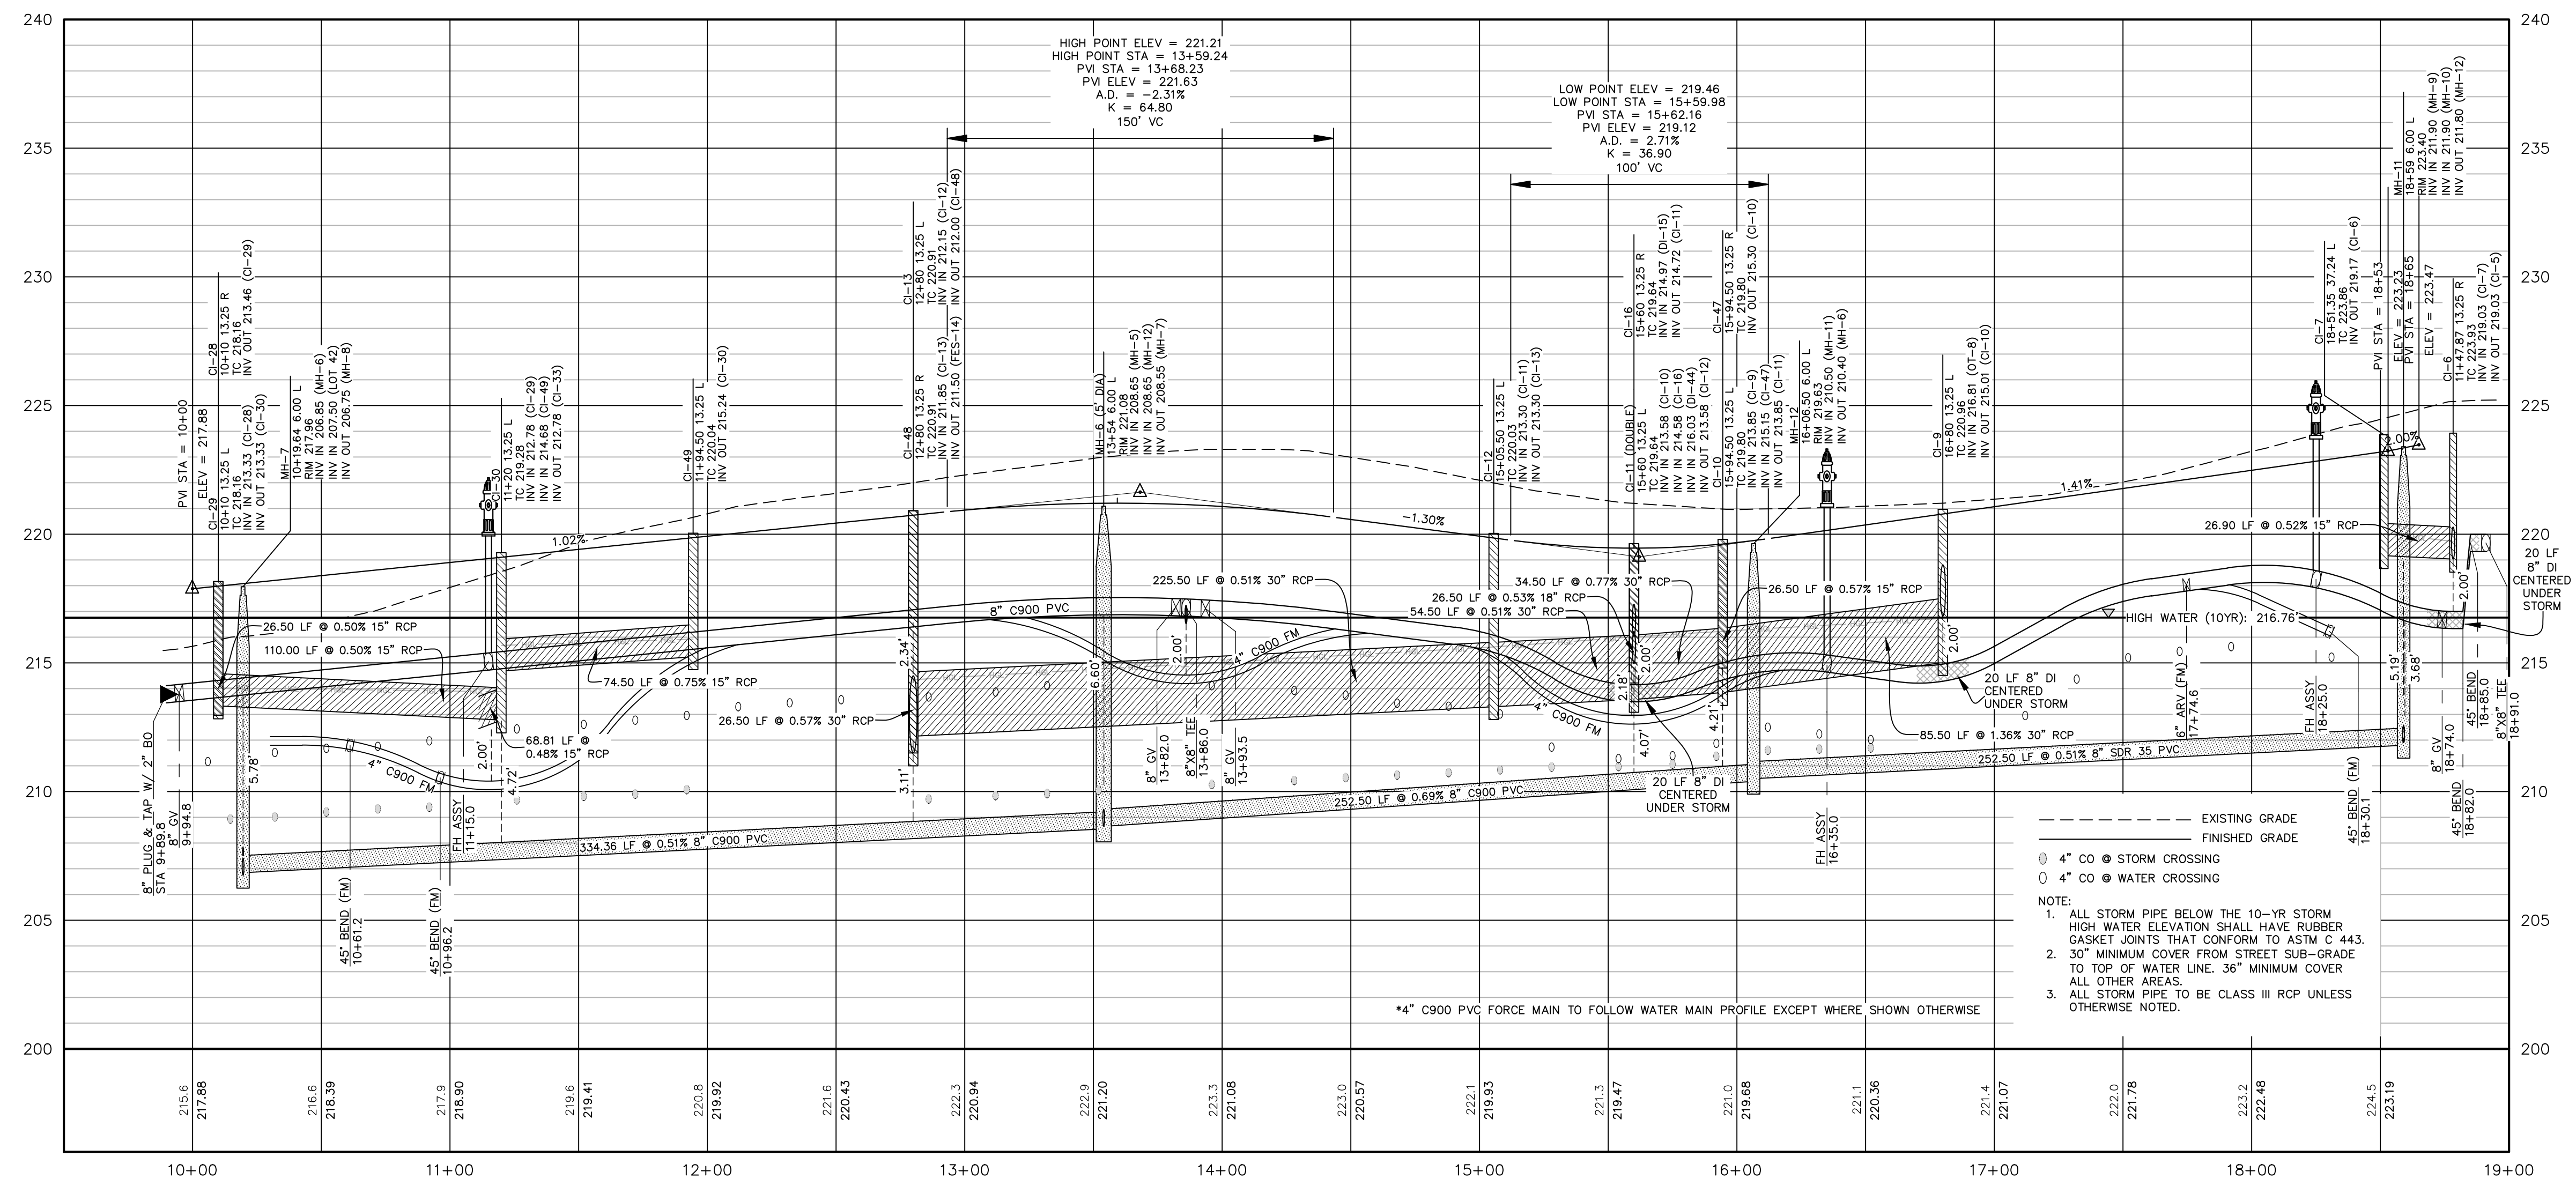





REVISIONS  
ISSUED FOR CONSTRUCTION

PROJECT NAME

**HARPER'S  
MEADOW**

**BRAYDENS WAY  
& STORM  
PROFILES**

CLIENT

**TRIANGLE LAND  
PARTNERS, LLC**

PO Box 5548  
Cary, North Carolina 27512  
Phone: (704) 608-3085

PROJECT INFORMATION

DESIGNED BY:	CALEB
DRAWN BY:	CALEB
CHECKED BY:	SCOTT
PROJECT NUMBER:	1896

DRAWING SCALE


HORIZONTAL: 1"=40'  
VERTICAL: 1"=4'

DATE RELEASED

MARCH 22, 2024


SHEET NUMBER

**C-5.2**

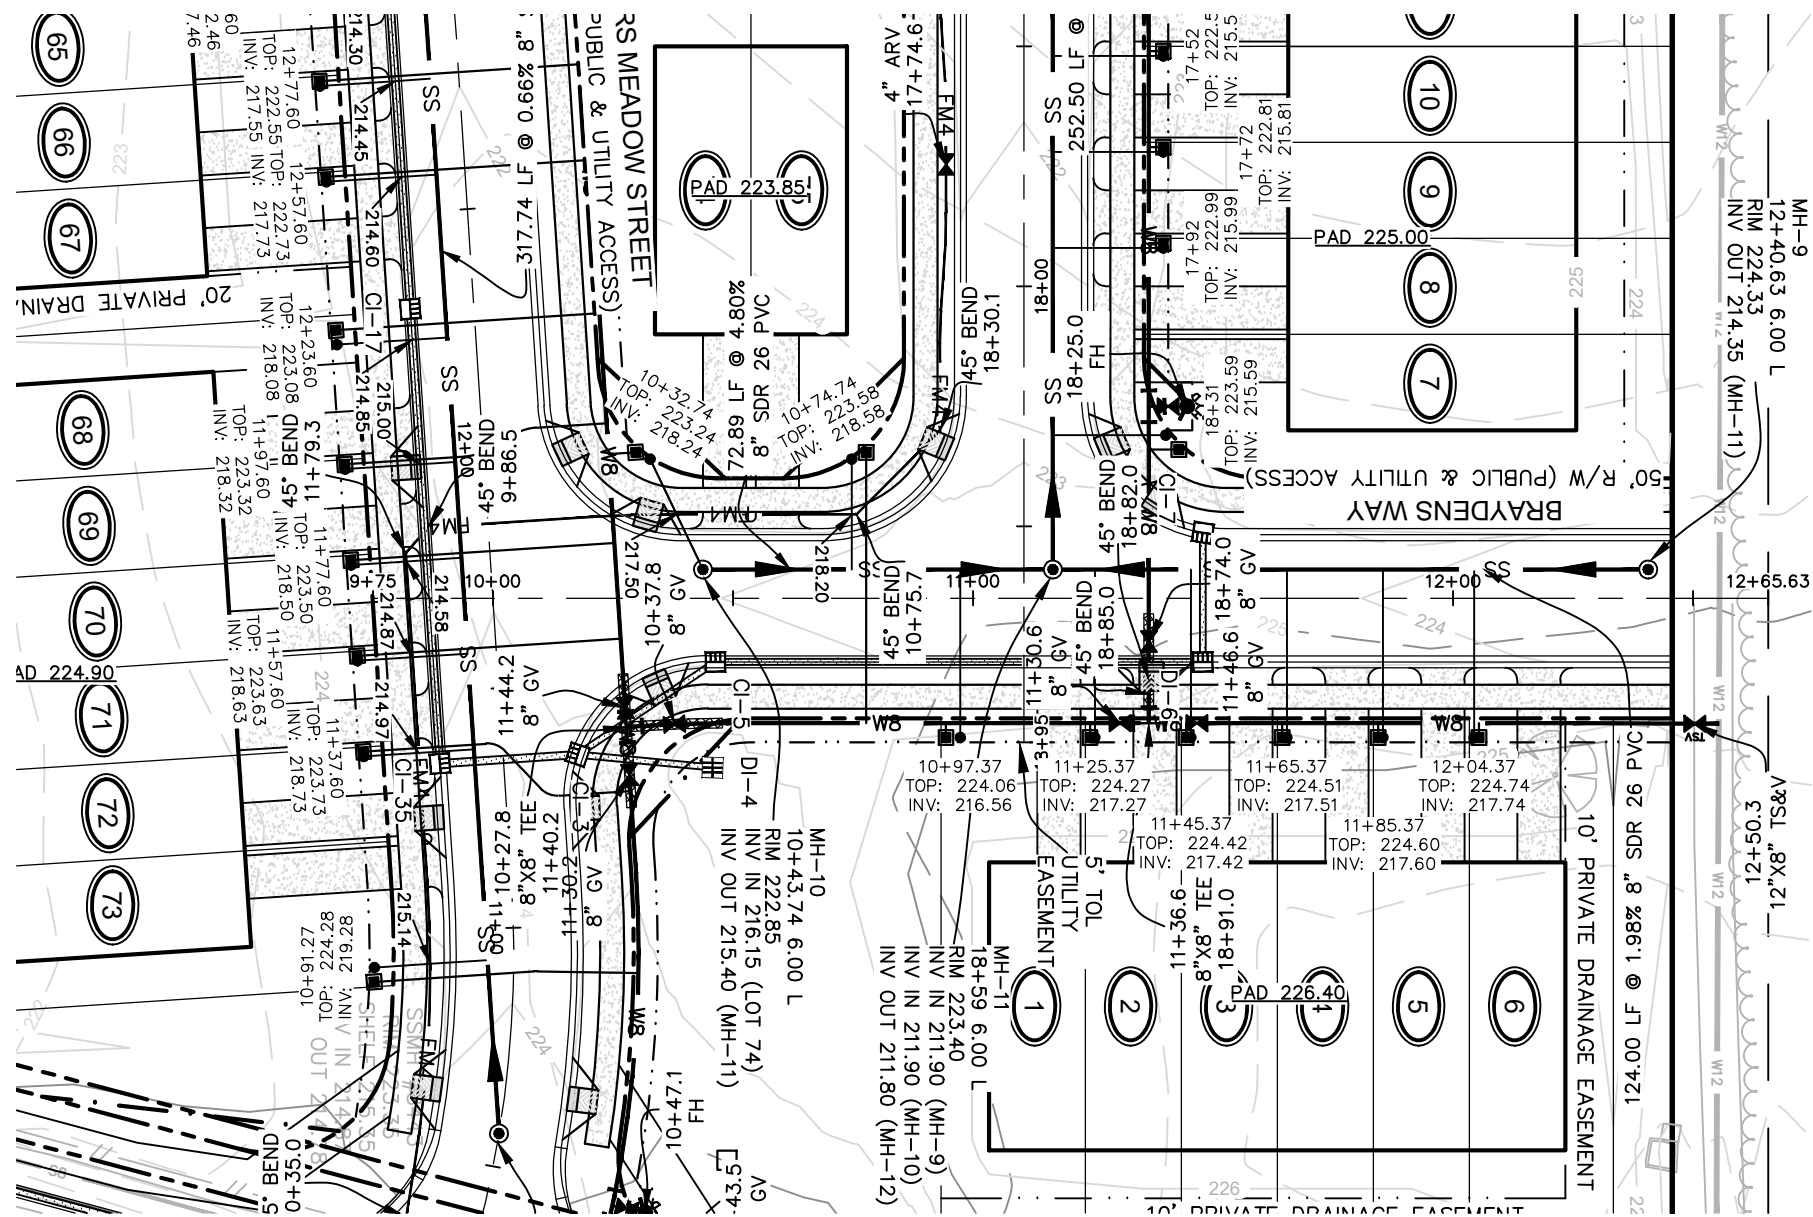


## BRAYDENS WAY

50' R/W (PUBLIC STREET)  
ROADWAY PROFILE 9+50 TO 13+00

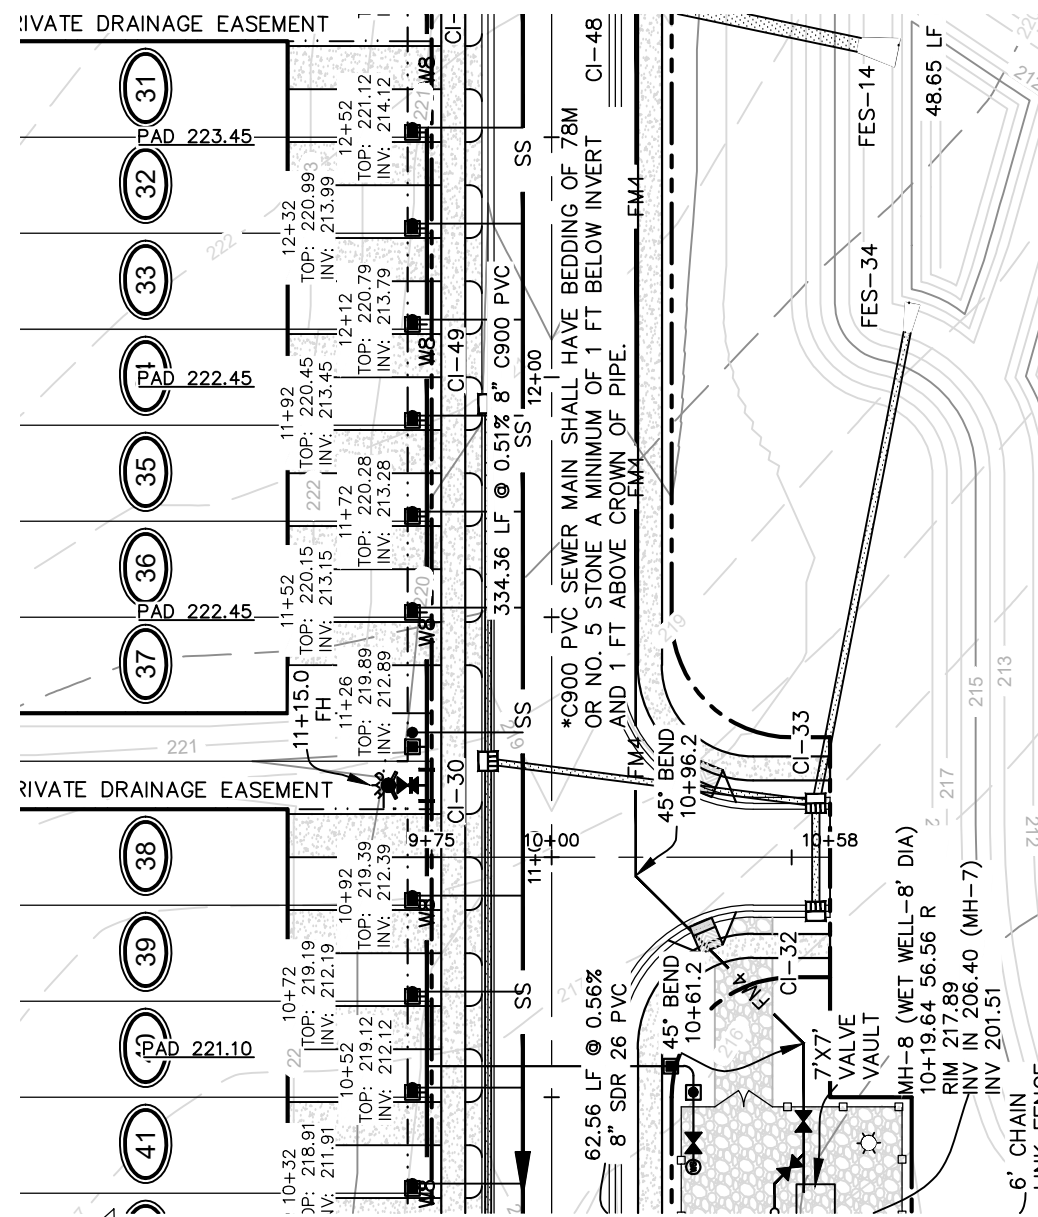





## ROAD STUB

50' R/W (PUBLIC STREET)  
ROADWAY PROFILE 9+50 TO 11+00

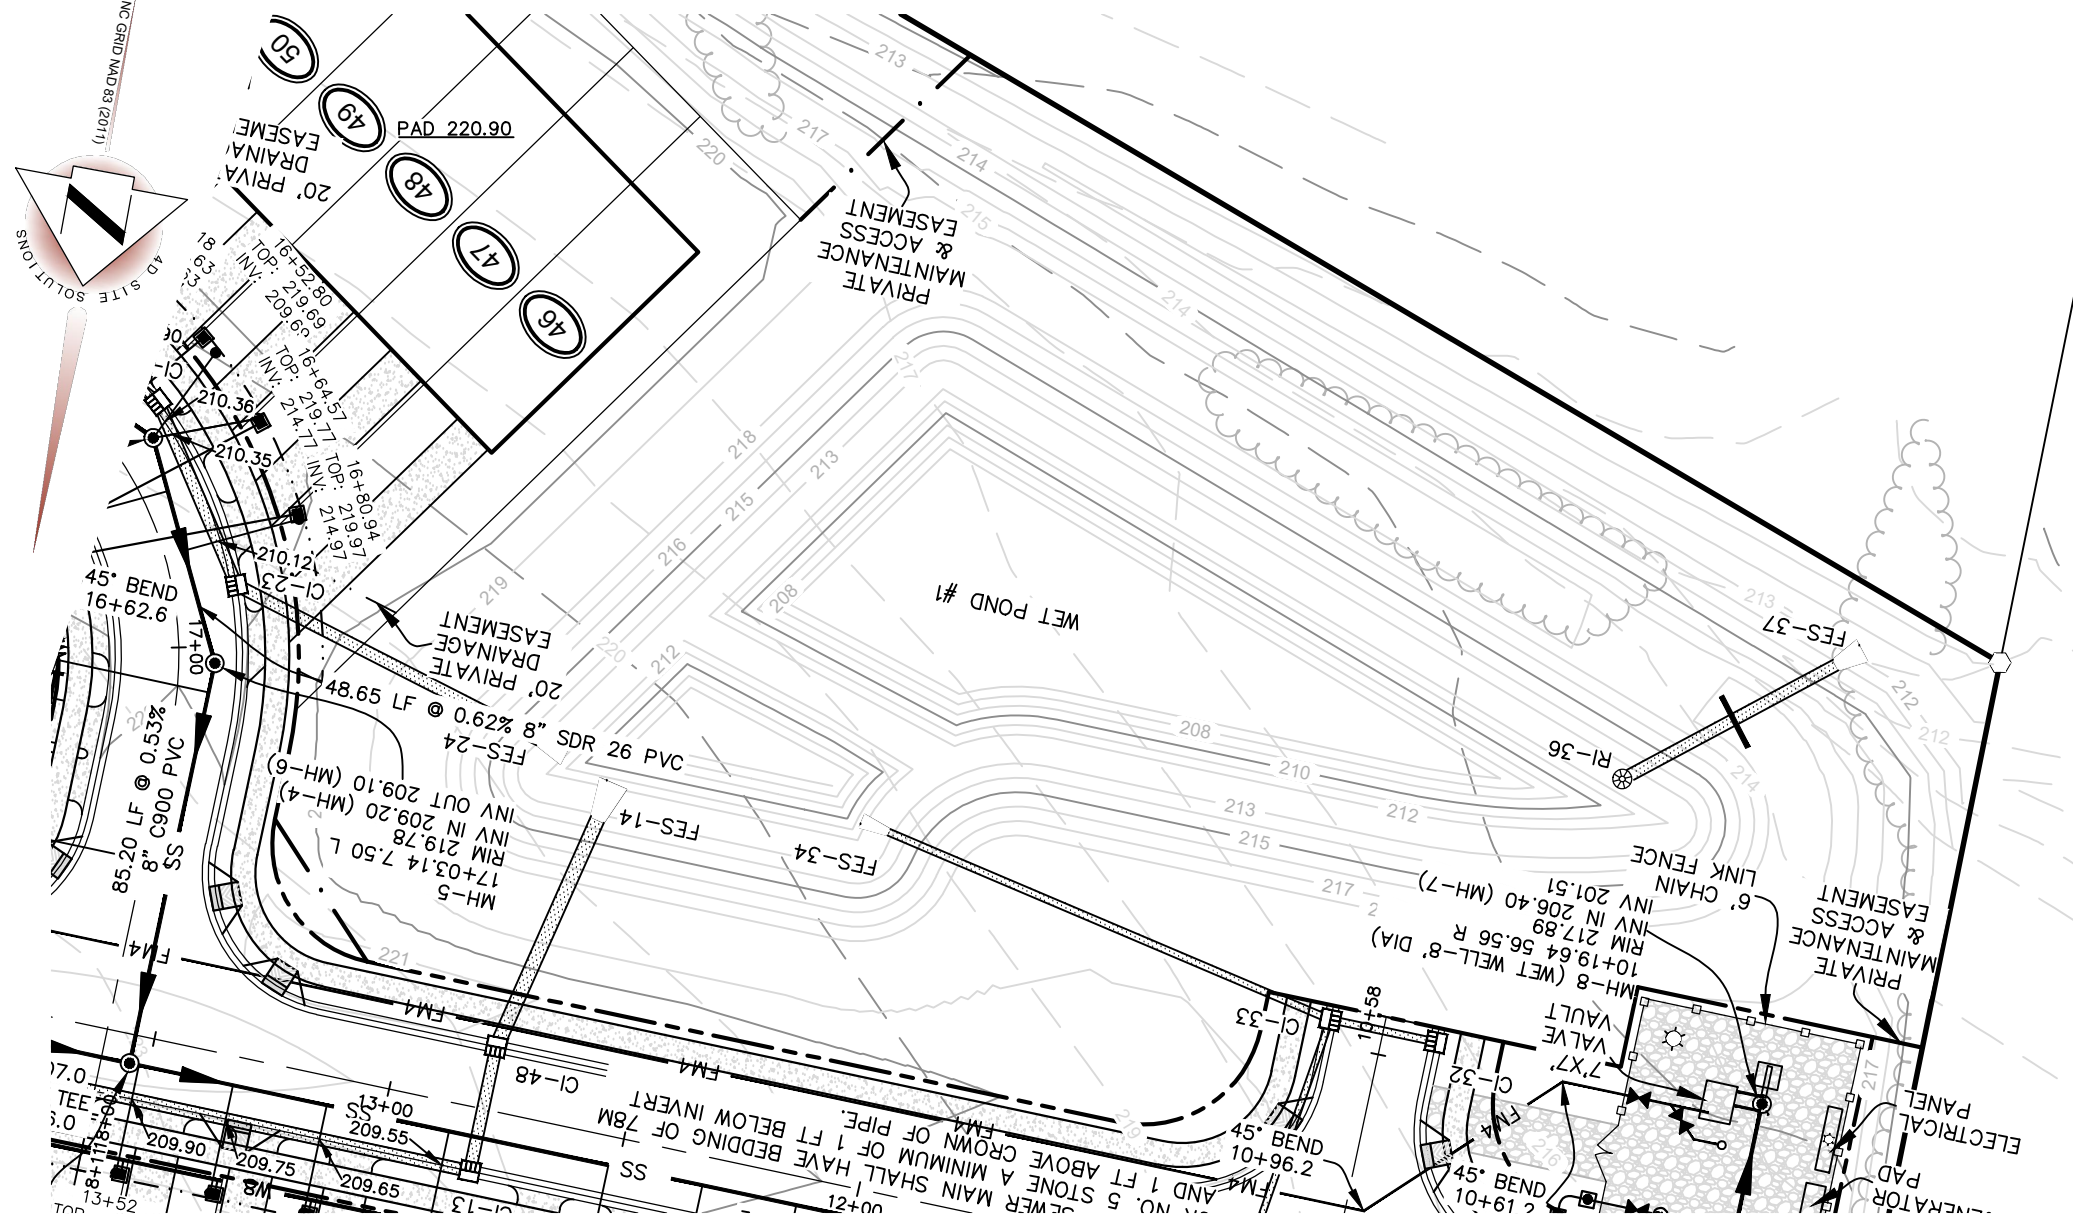

## WET POND #1

STORM DRAIN 9+50 TO 13+50

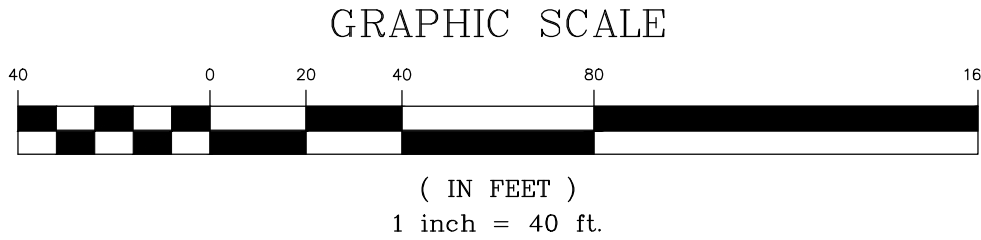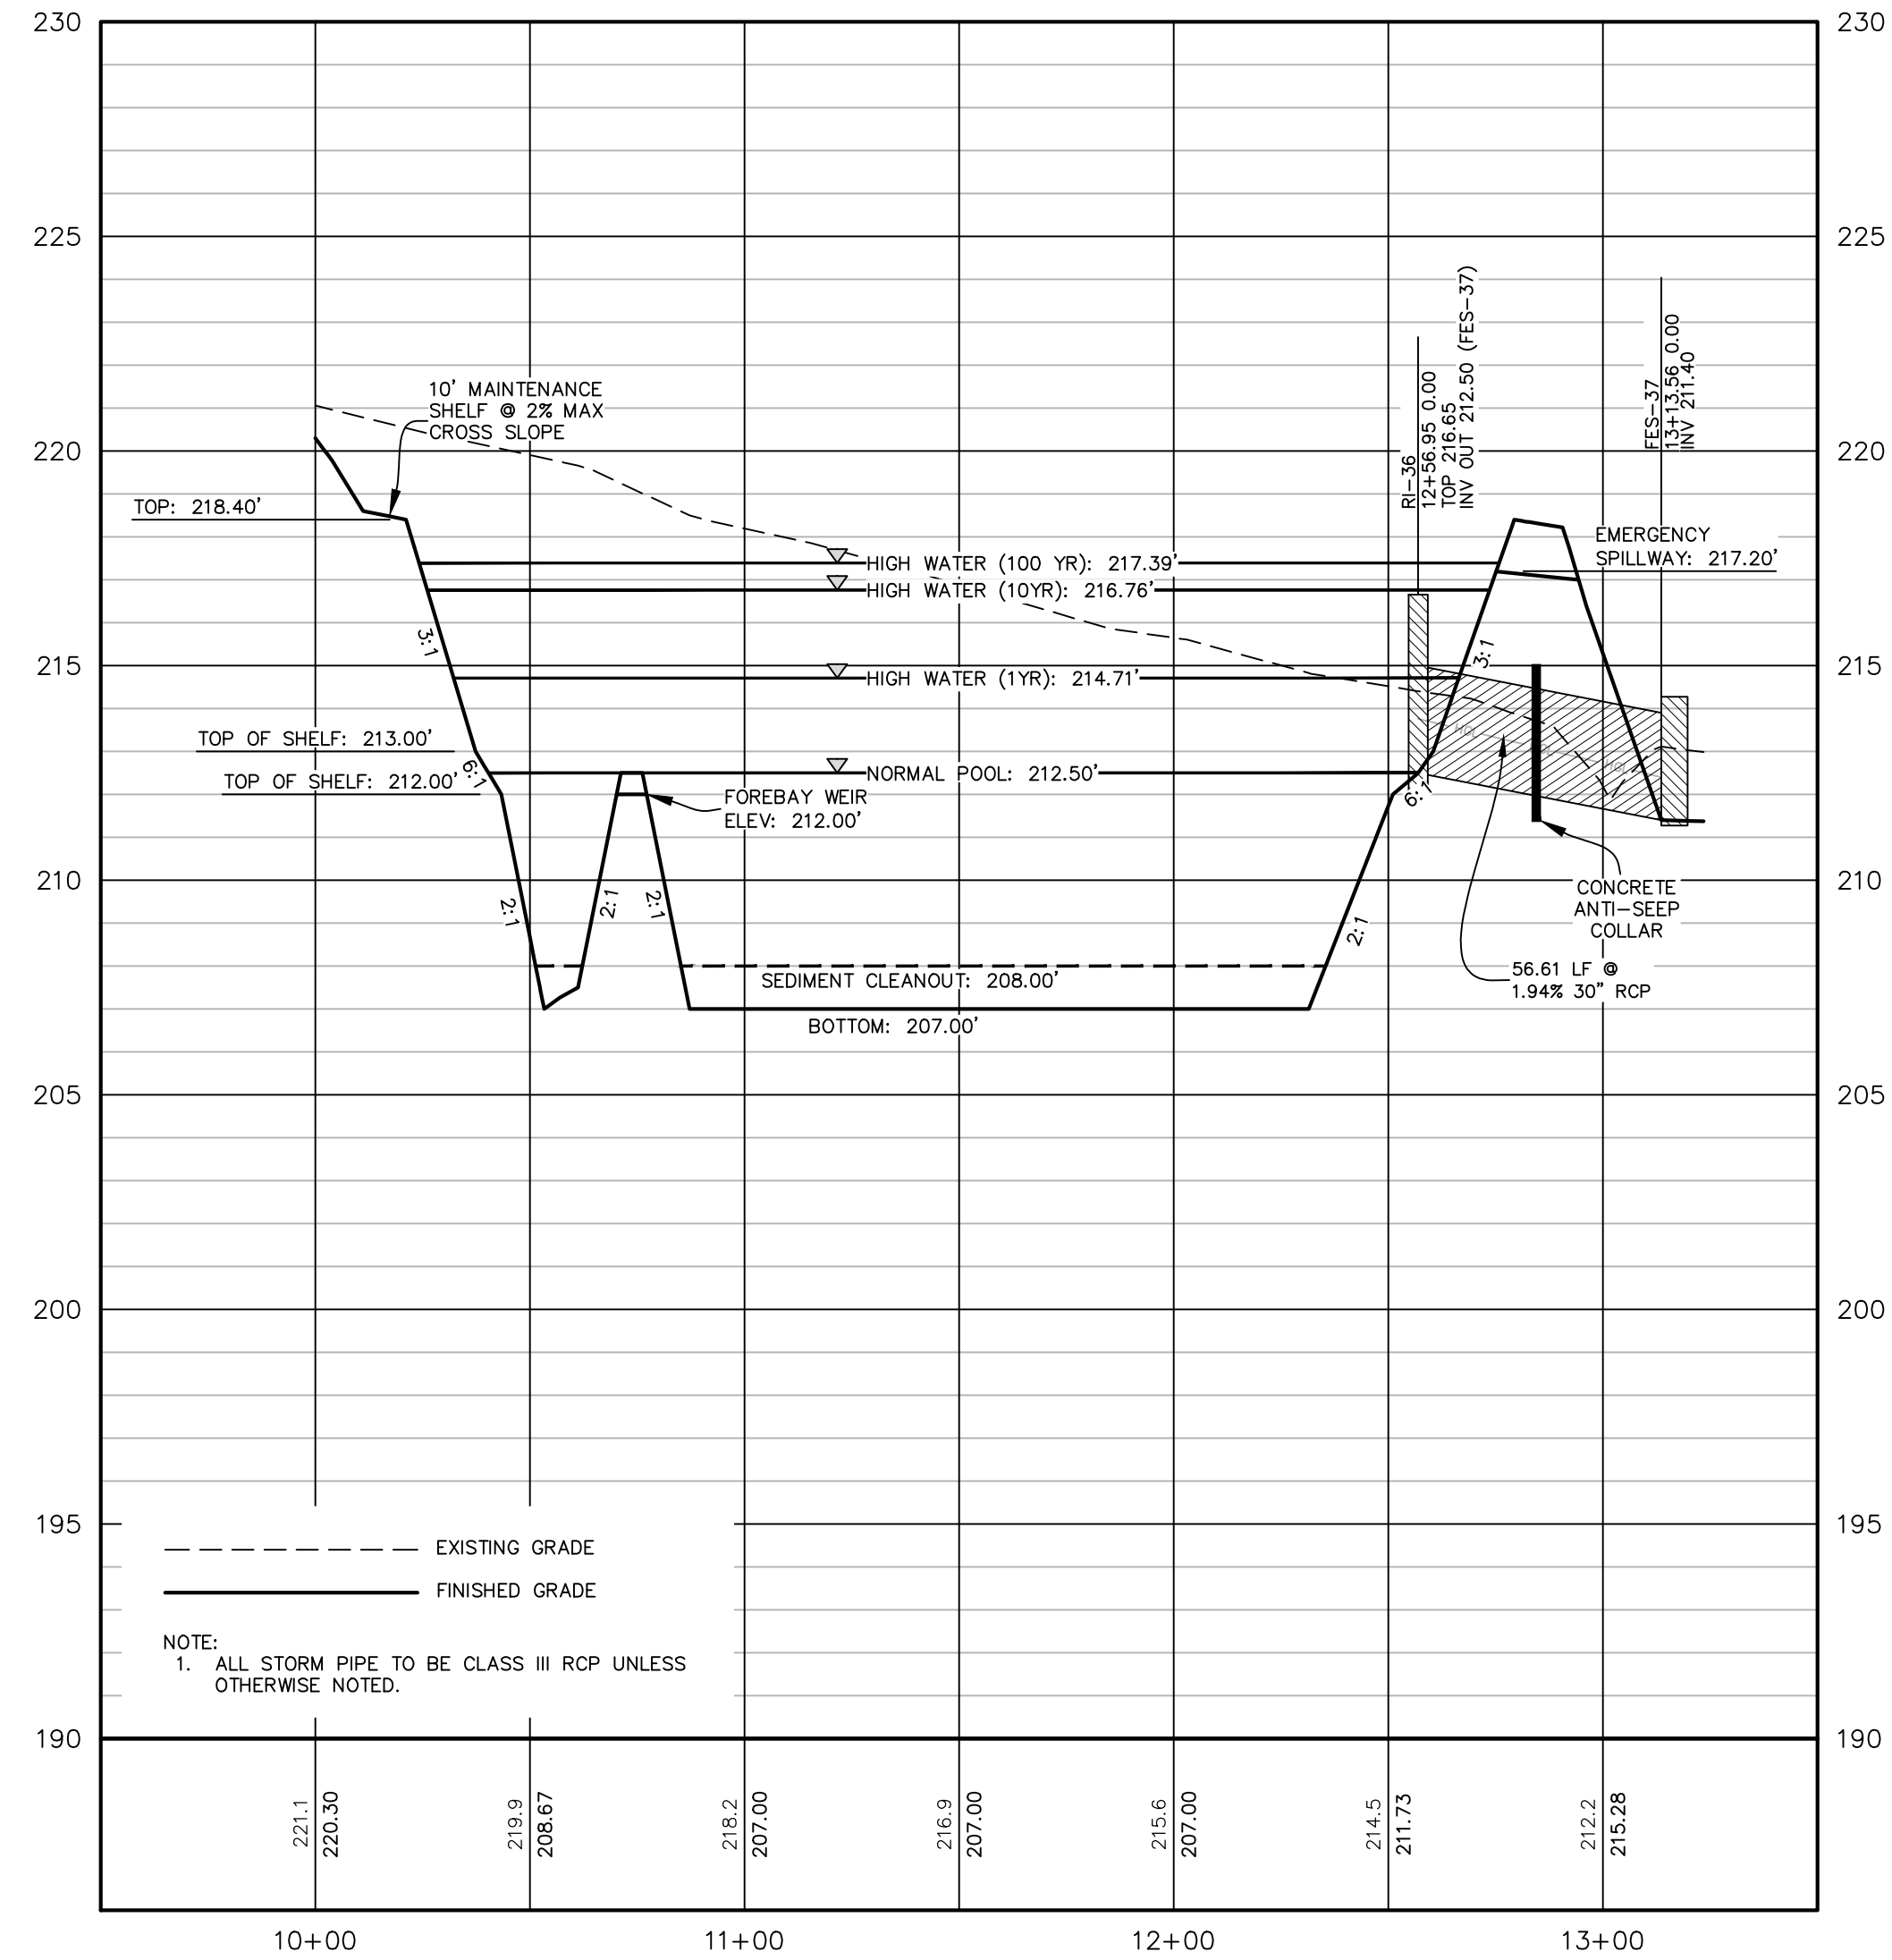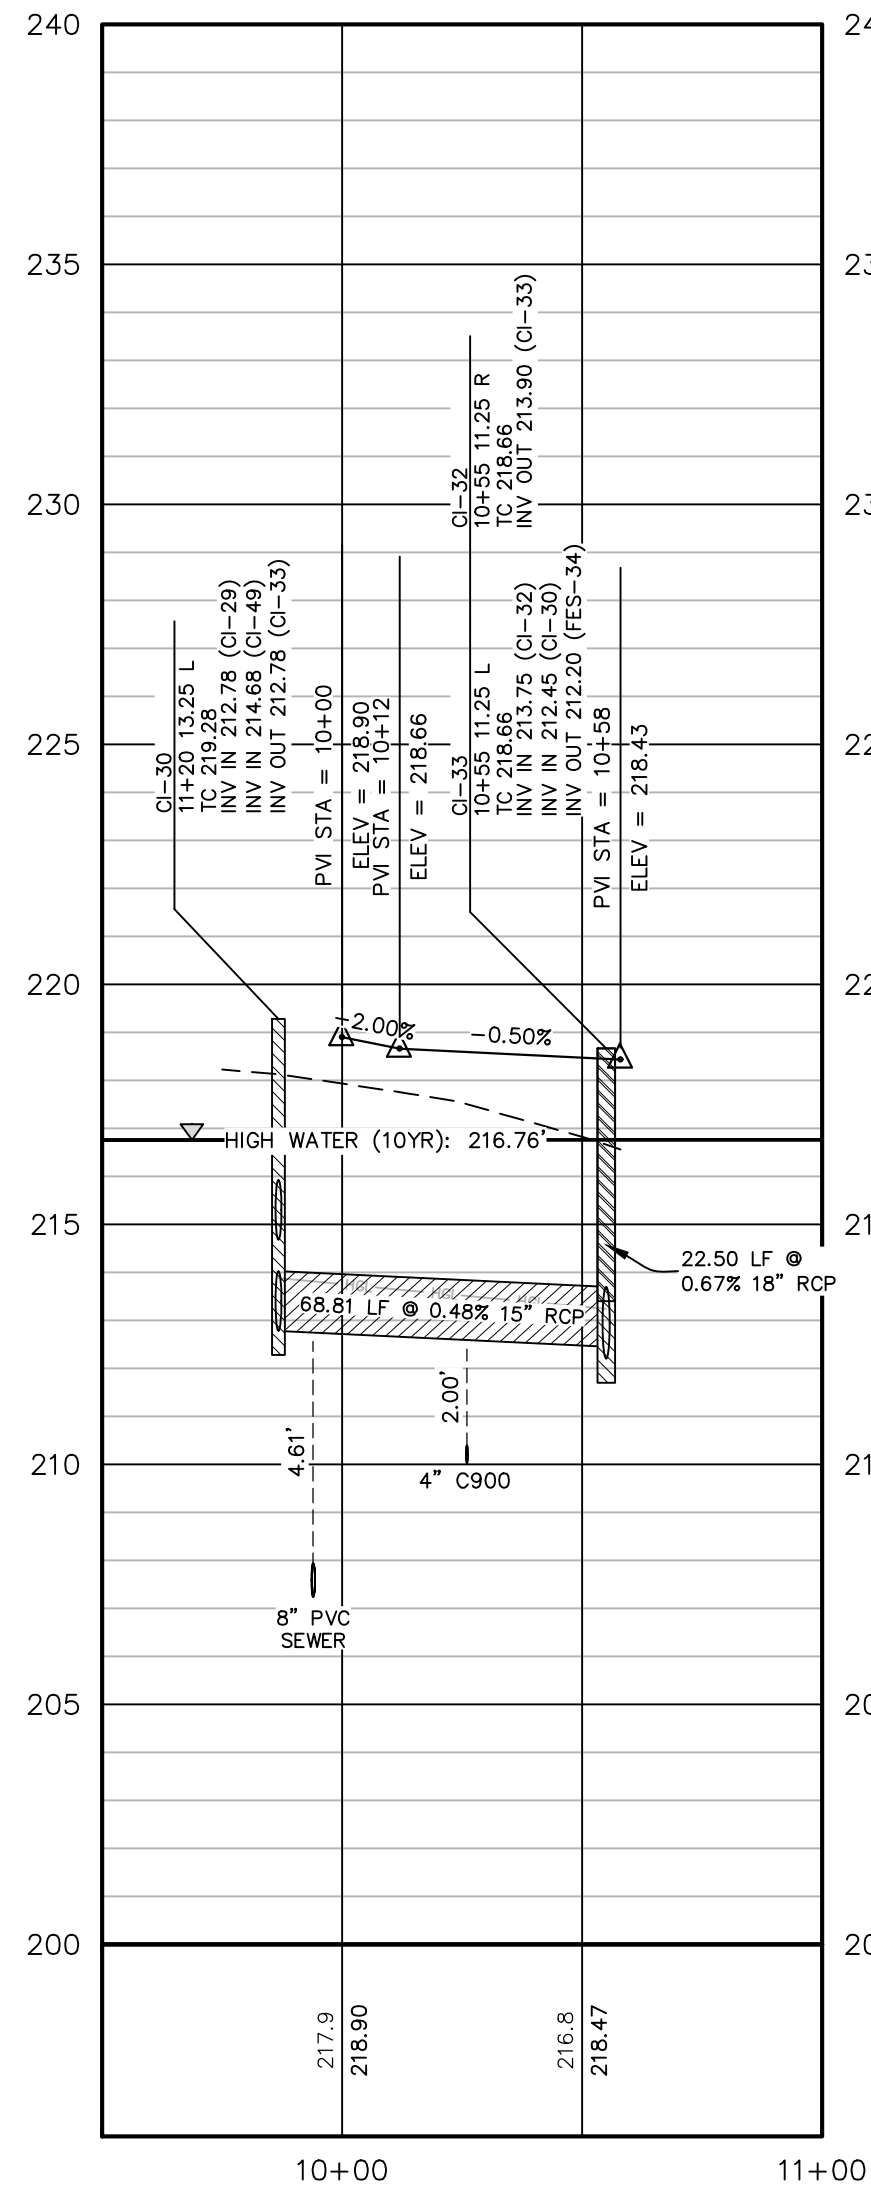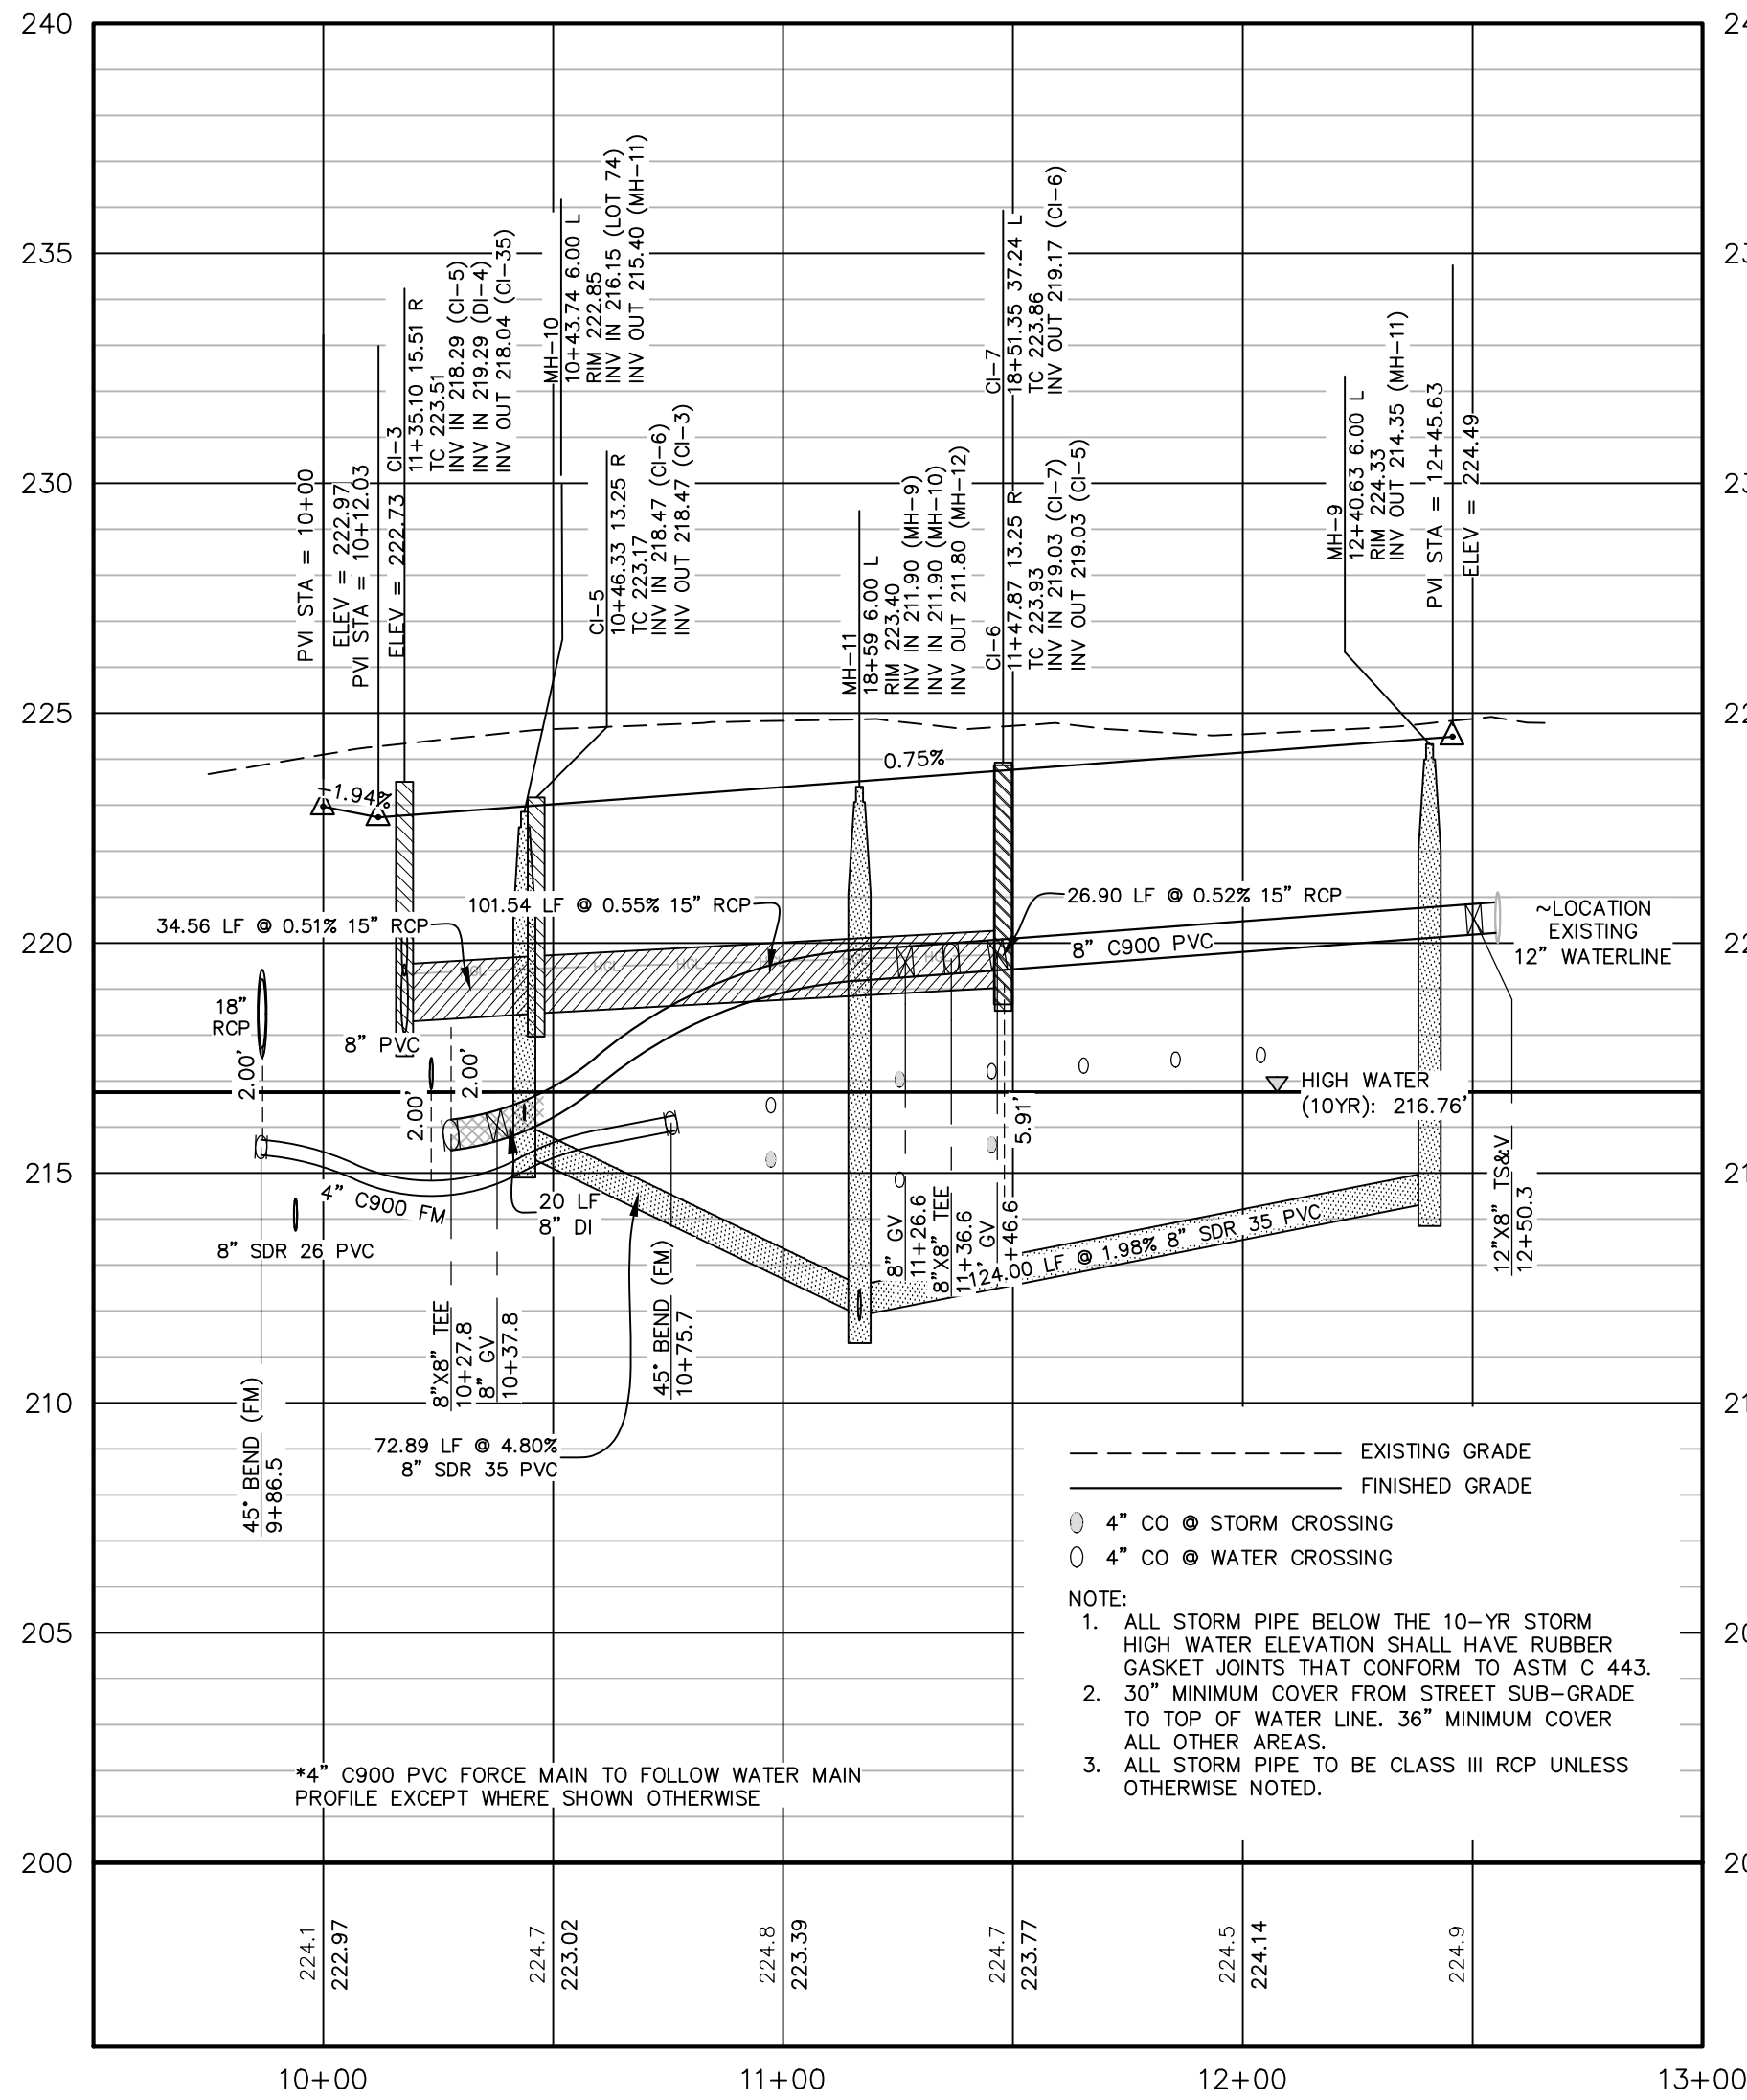





REVISIONS

ISSUED FOR CONSTRUCTION

PROJECT NAME

**HARPER'S  
MEADOW**

CLIENT

**TRIANGLE LAND  
PARTNERS, LLC**

PO Box 5548  
Cary, North Carolina 27512  
Phone: (704) 608-3085

PROJECT INFORMATION

DESIGNED BY:	CALEB
DRAWN BY:	CALEB
CHECKED BY:	SCOTT
PROJECT NUMBER:	1896

DRAWING SCALE


HORIZONTAL: 1"=40'  
VERTICAL: 1"=4'

DATE RELEASED

MARCH 22, 2024



SHEET NUMBER

**C-5.3**

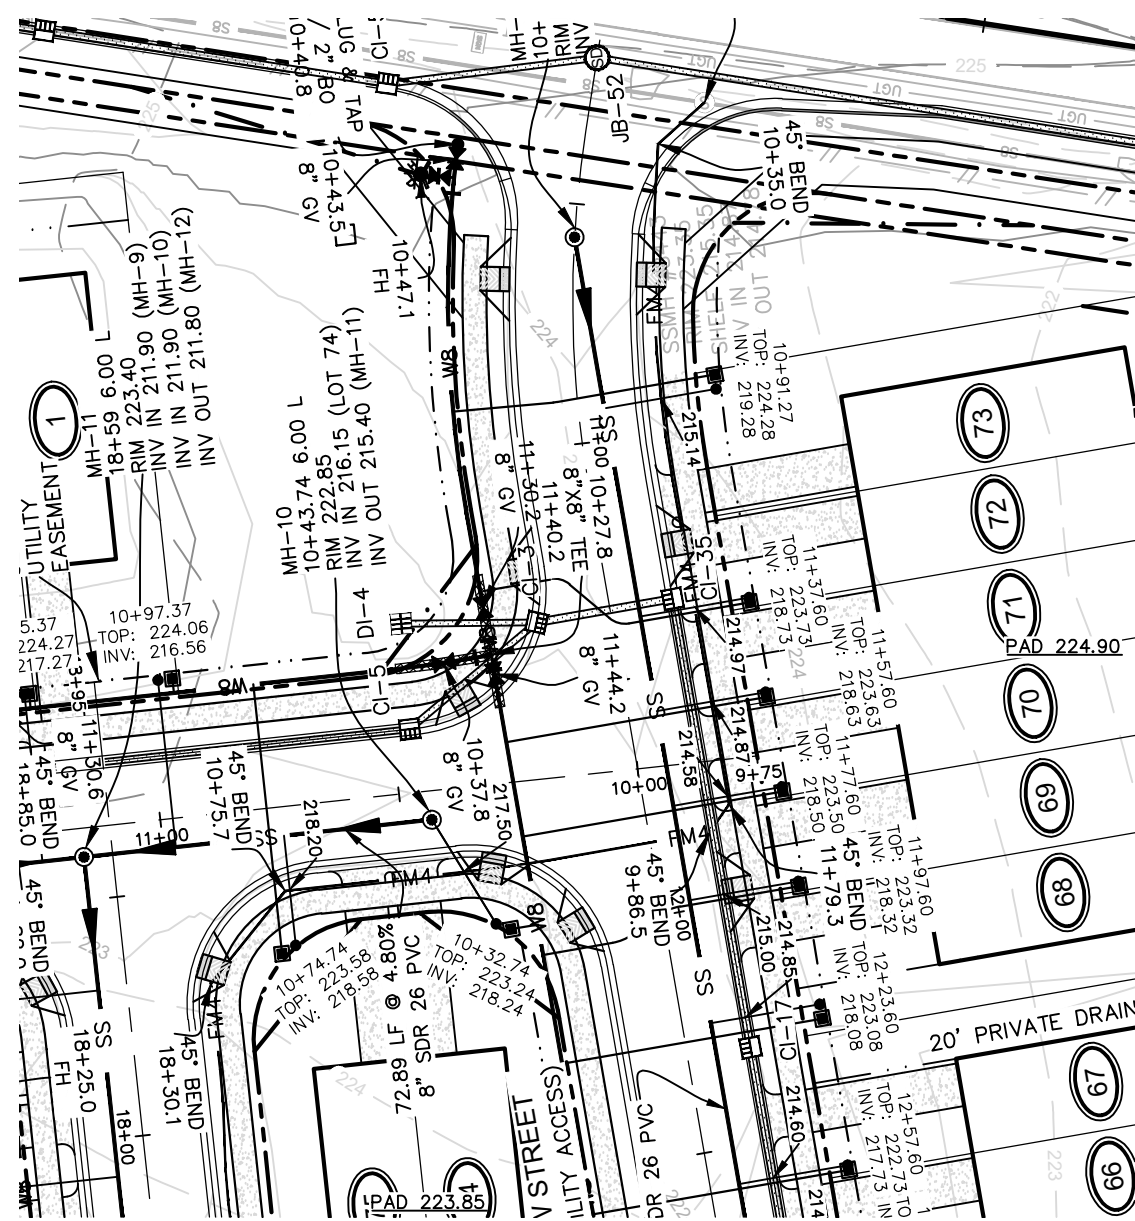



**DI-4 TO CI-5**

STORM DRAIN 9+50 TO 11+00

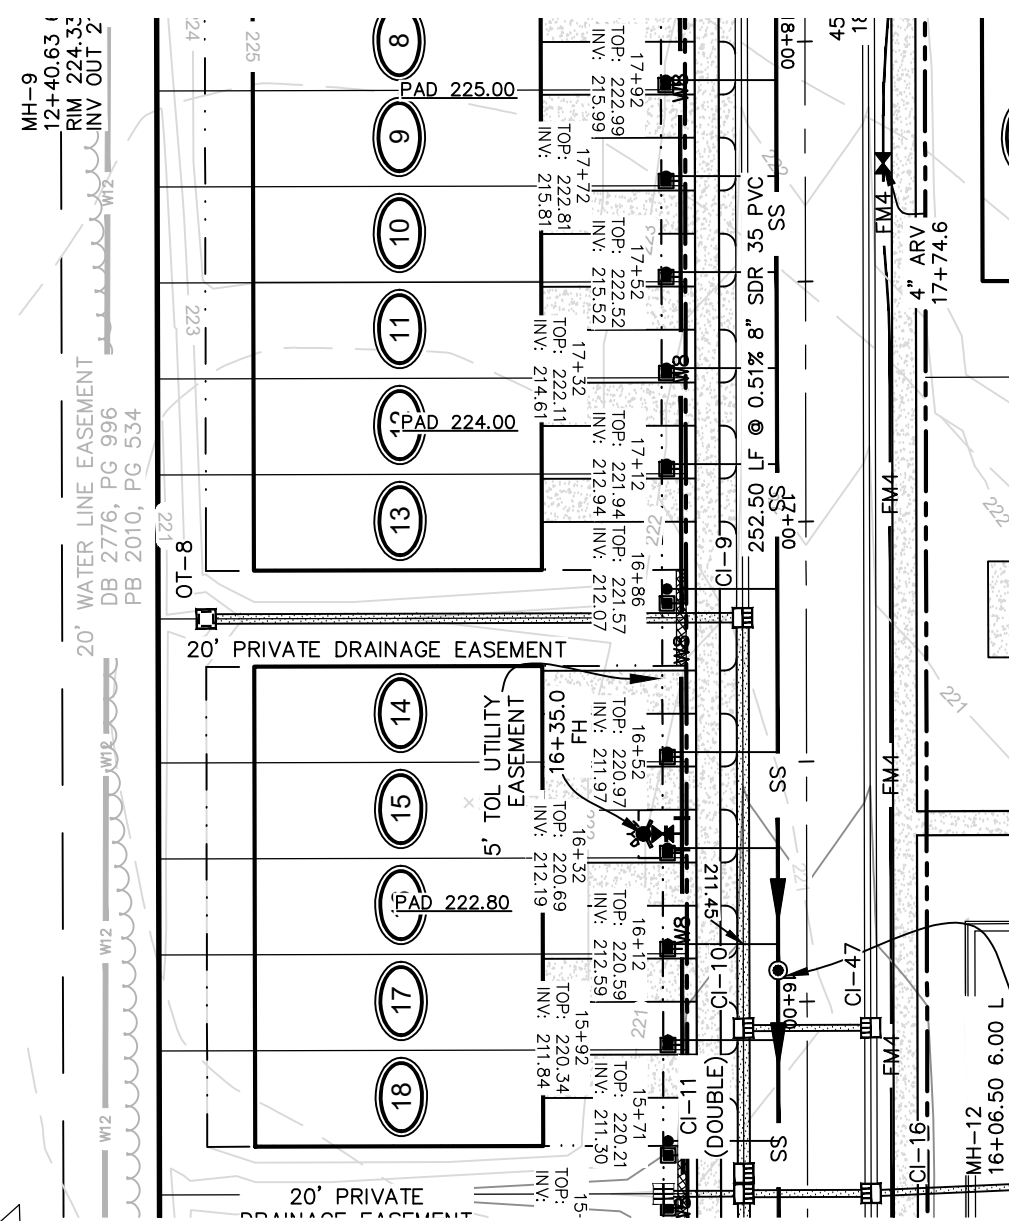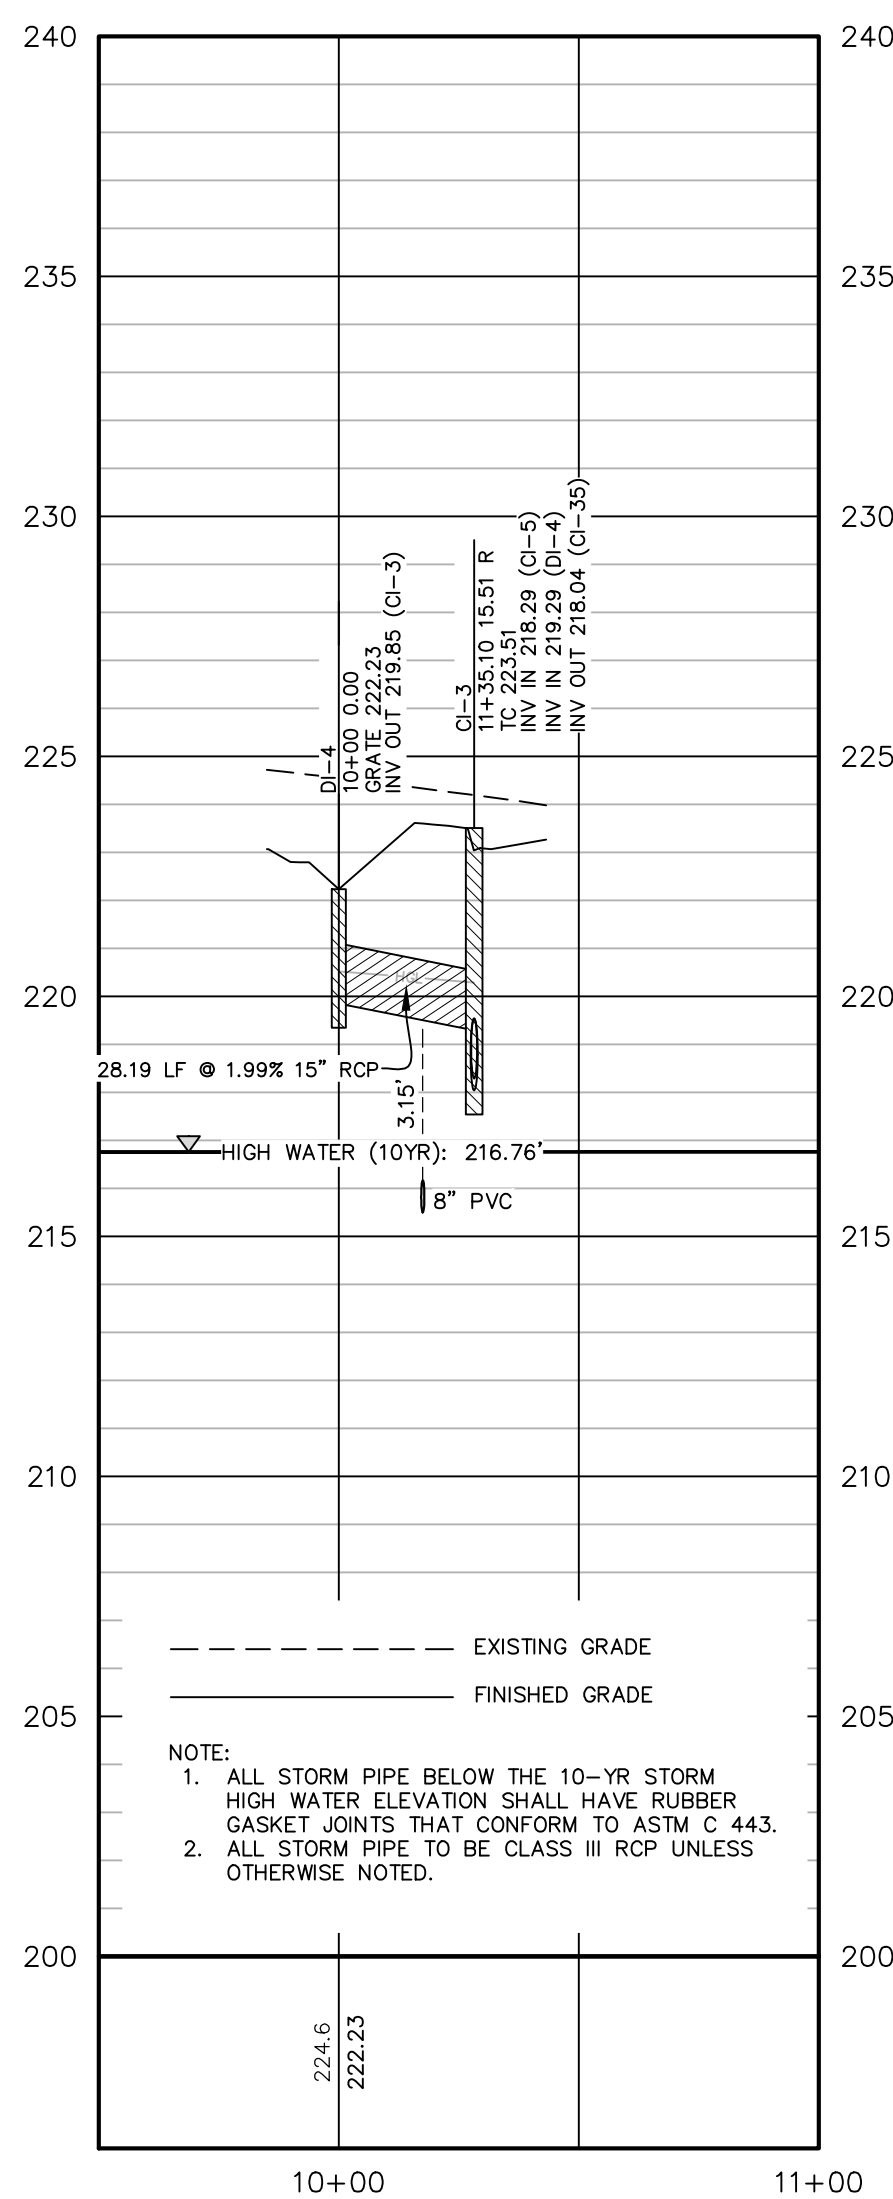



**OT-8 TO CI-9**

STORM DRAIN 9+50 TO 11+50

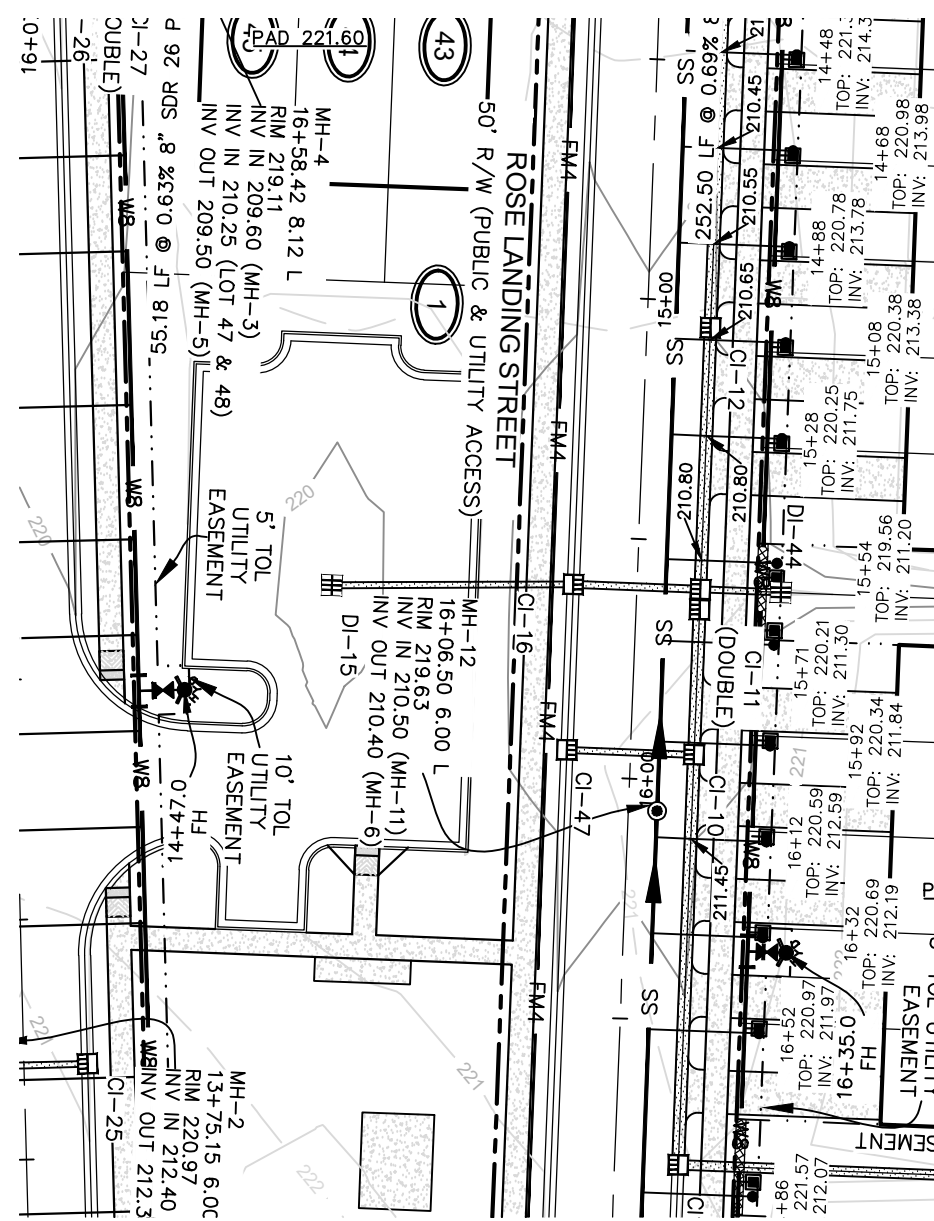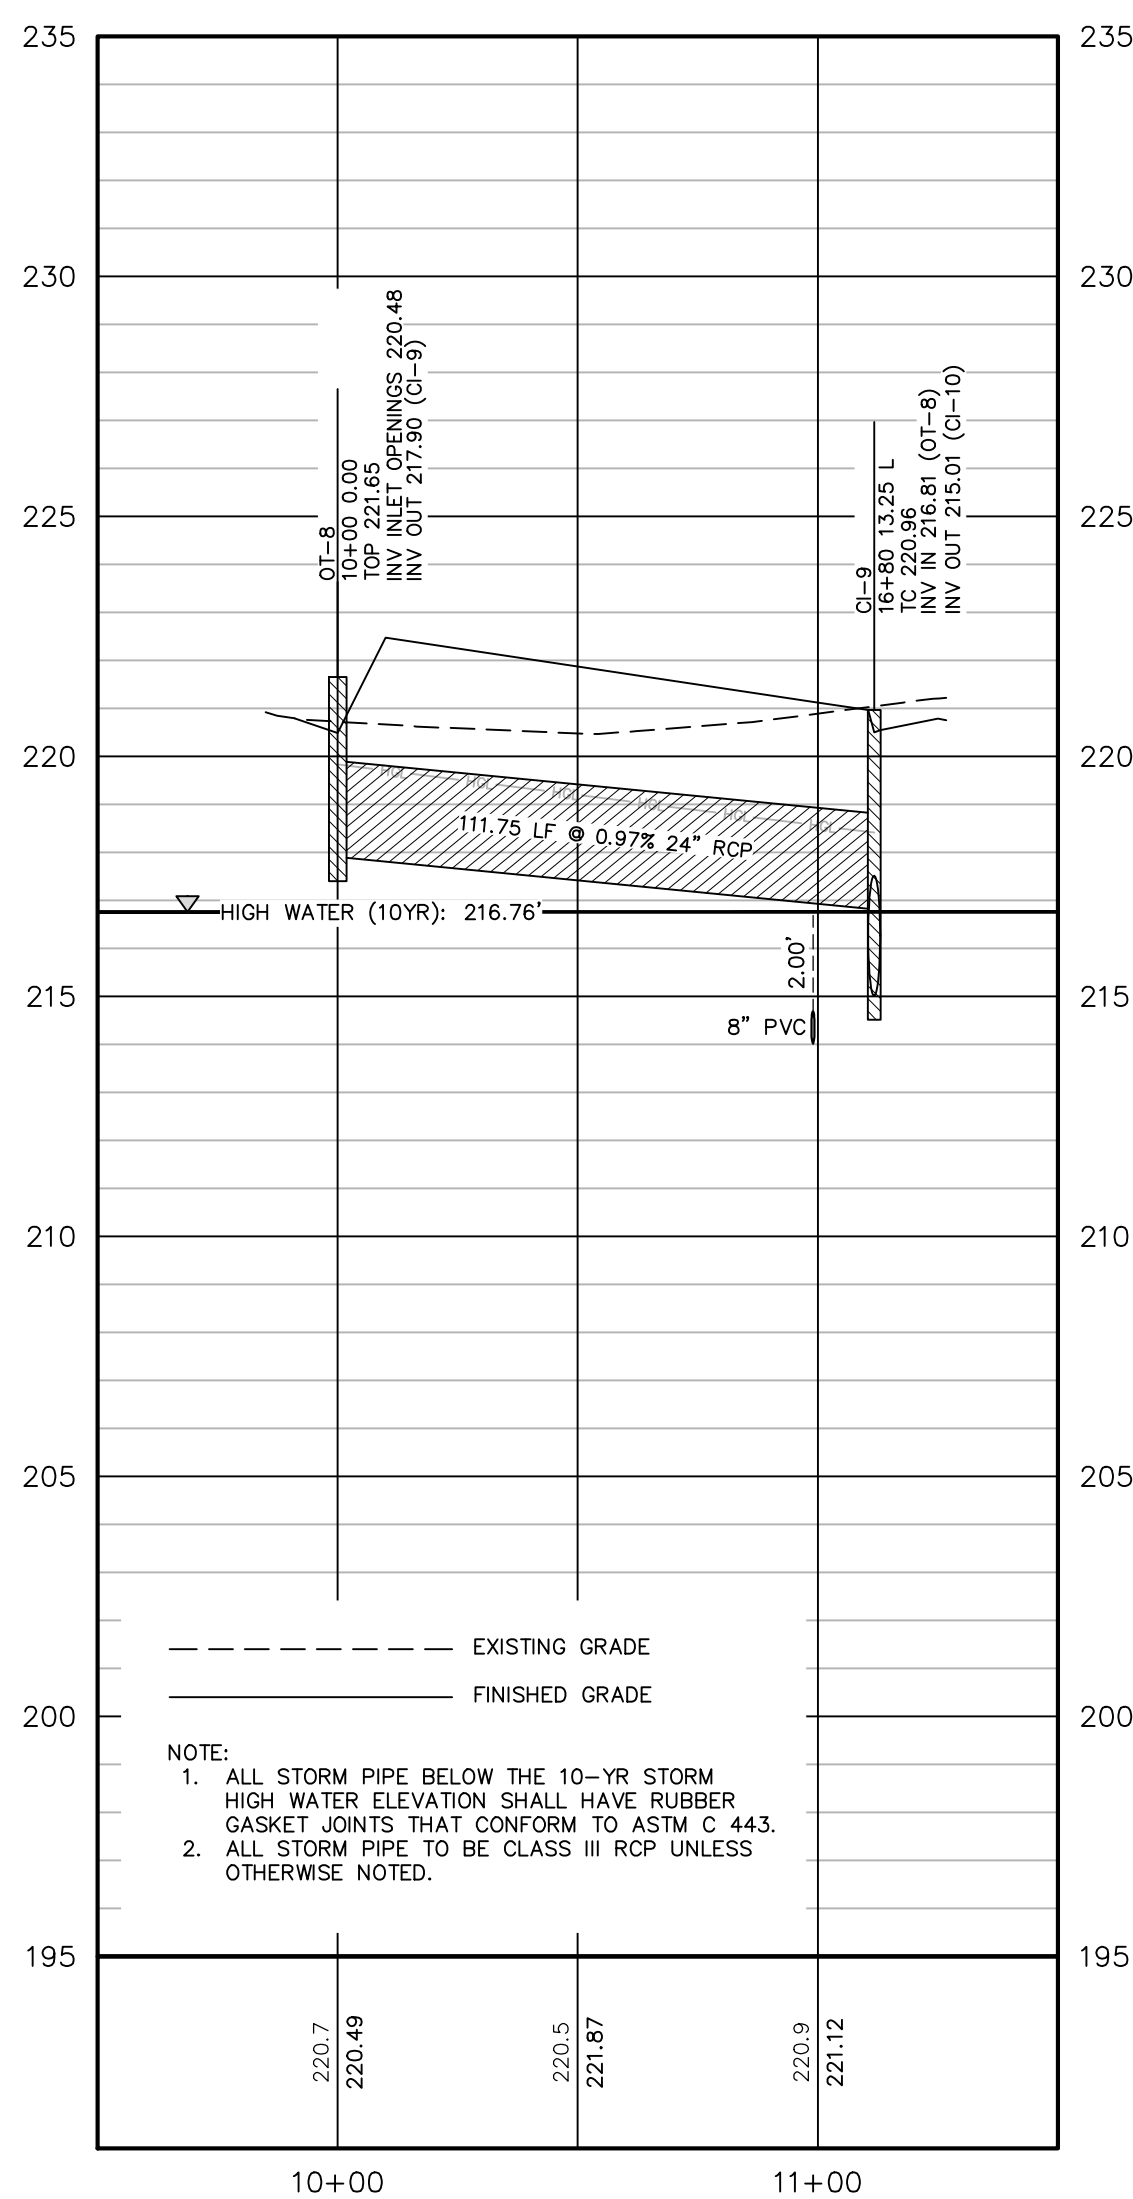



**DI-15 TO CI-16**

STORM DRAIN 9+50 TO 11+00

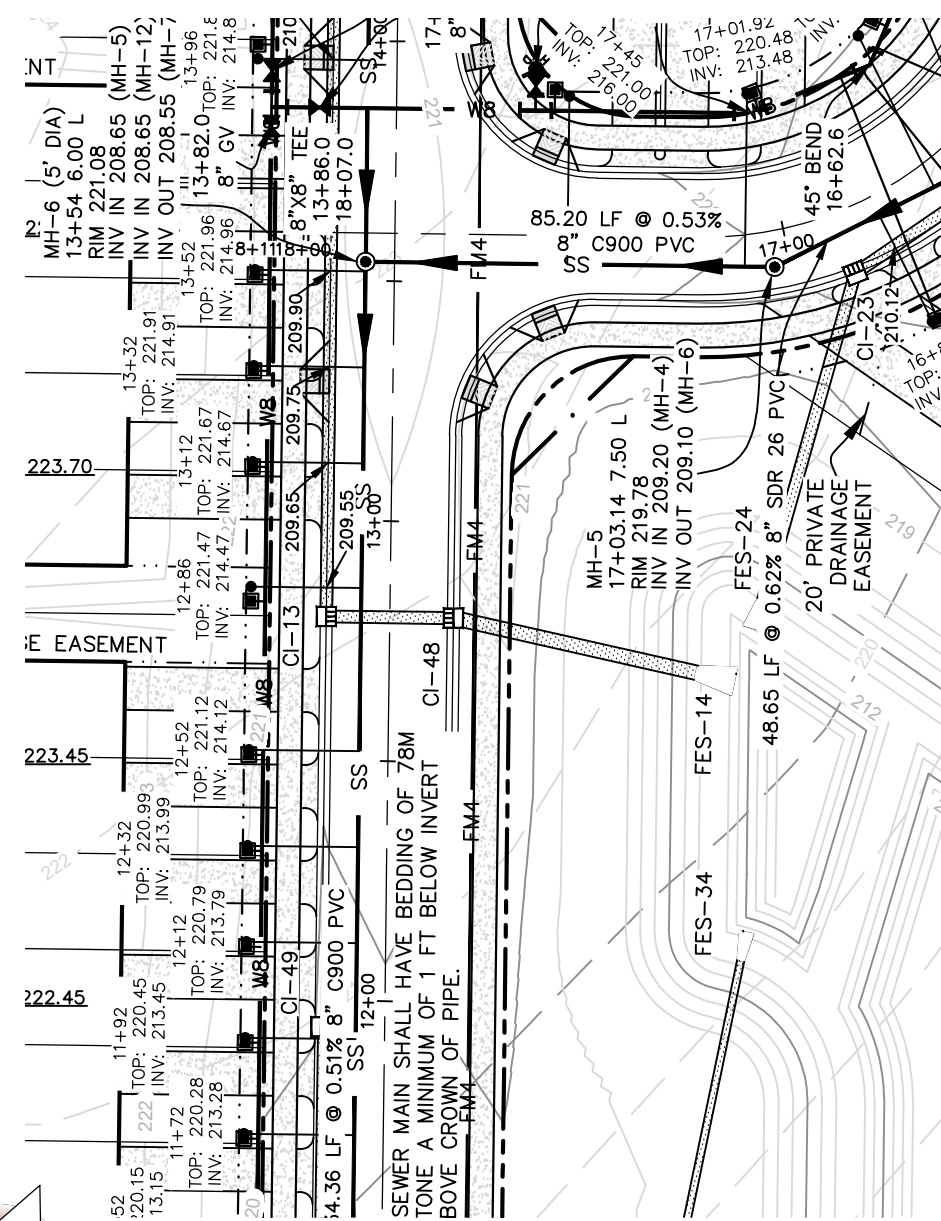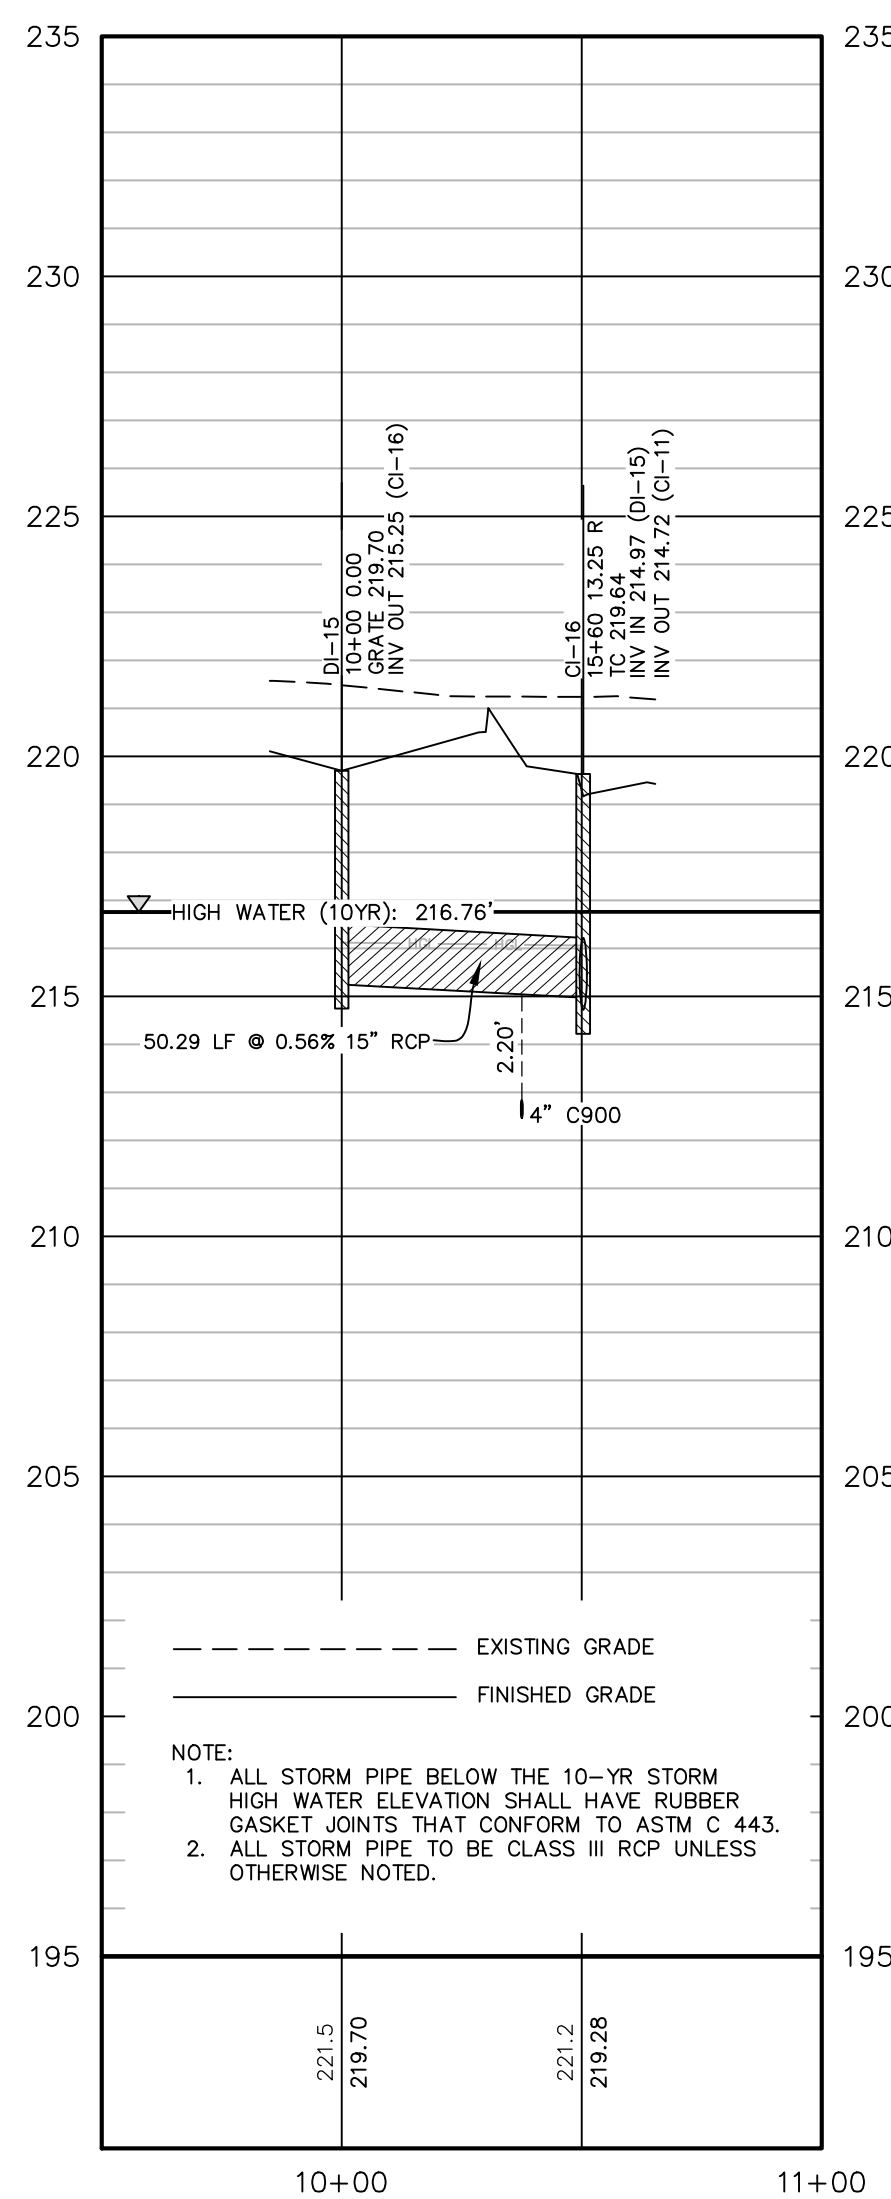

**CI-13 TO FES-14**

STORM DRAIN 9+50 TO 11+00

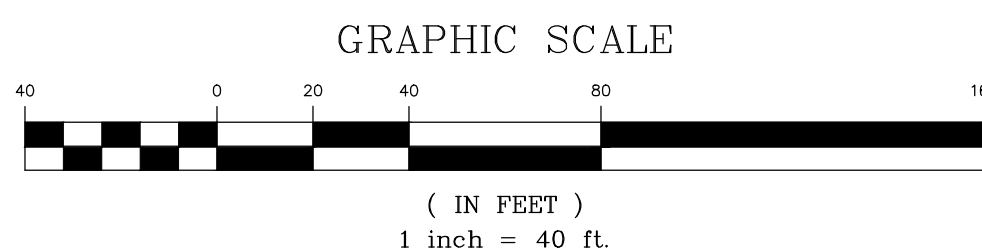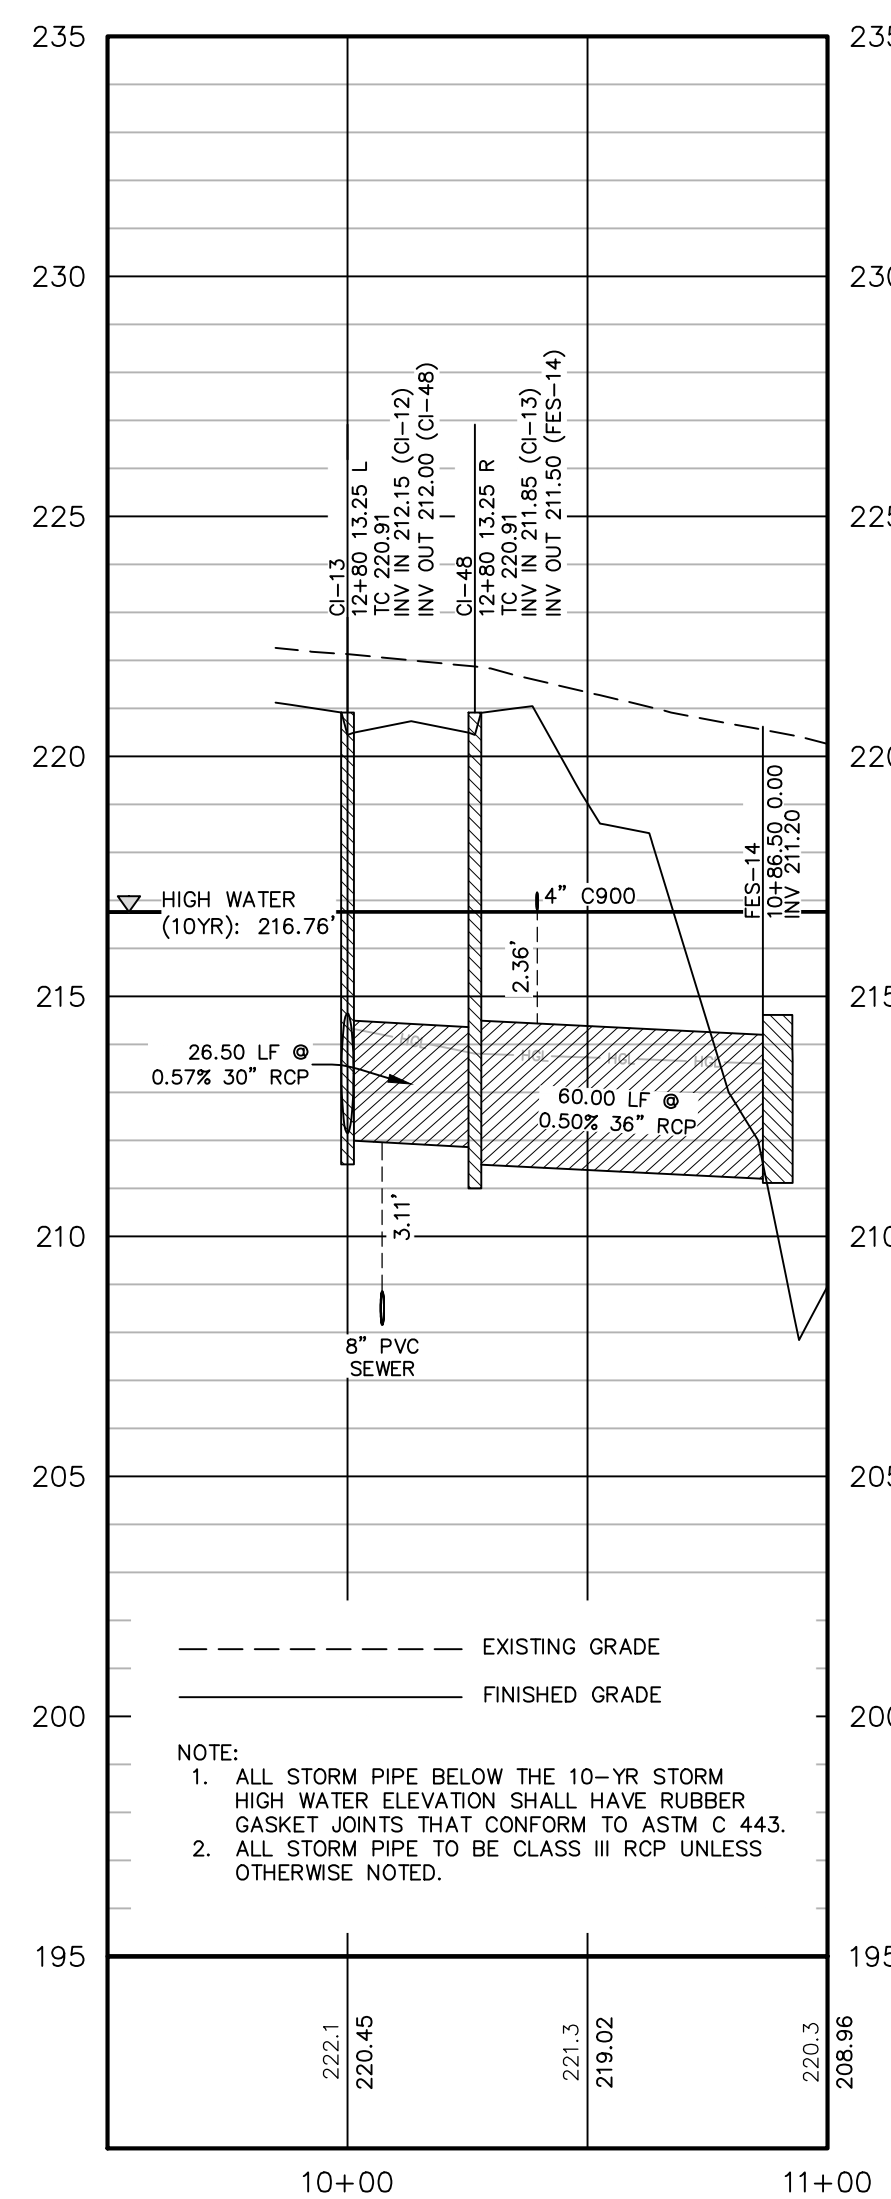





REVISIONS

ISSUED FOR CONSTRUCTION

08-29-24 ADDED MH-7A

PROJECT NAME

**HARPER'S  
MEADOW**

**STORM &  
SEWER  
PROFILES**

CLIENT

**TRIANGLE LAND  
PARTNERS, LLC**

PO Box 5548  
Cary, North Carolina 27512  
Phone: (704) 608-3085

PROJECT INFORMATION

DESIGNED BY:	CALEB
DRAWN BY:	CALEB
CHECKED BY:	SCOTT
PROJECT NUMBER:	1896

DRAWING SCALE


HORIZONTAL: 1"=40'  
VERTICAL: 1"=4'

DATE RELEASED

MARCH 22, 2024



SHEET NUMBER

**C-5.4**

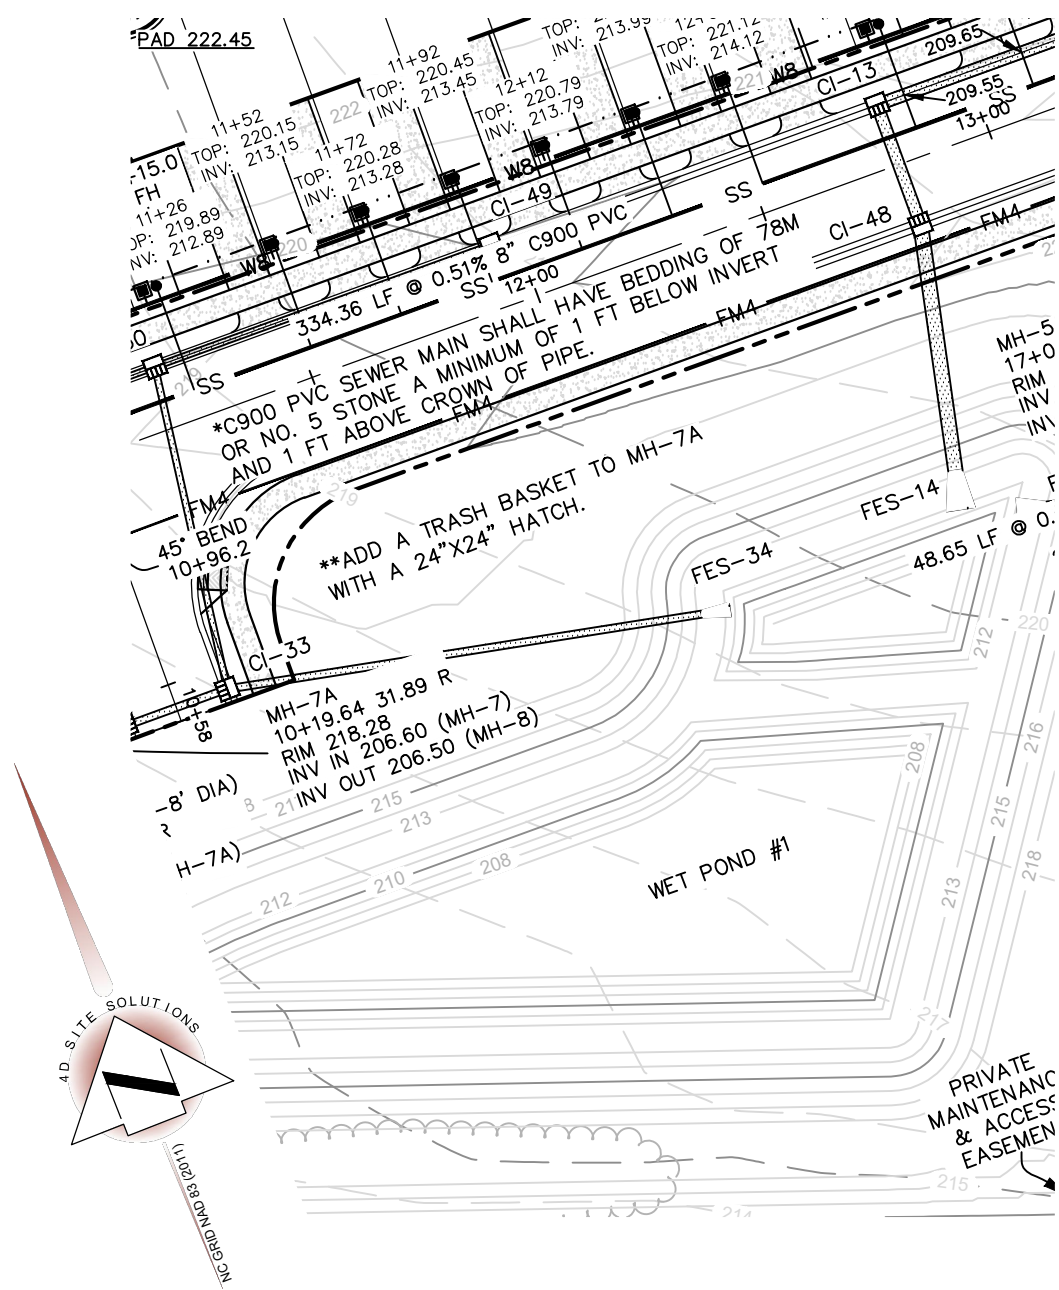



**CI-33 TO FES-34**

STORM DRAIN 9+50 TO 11+00

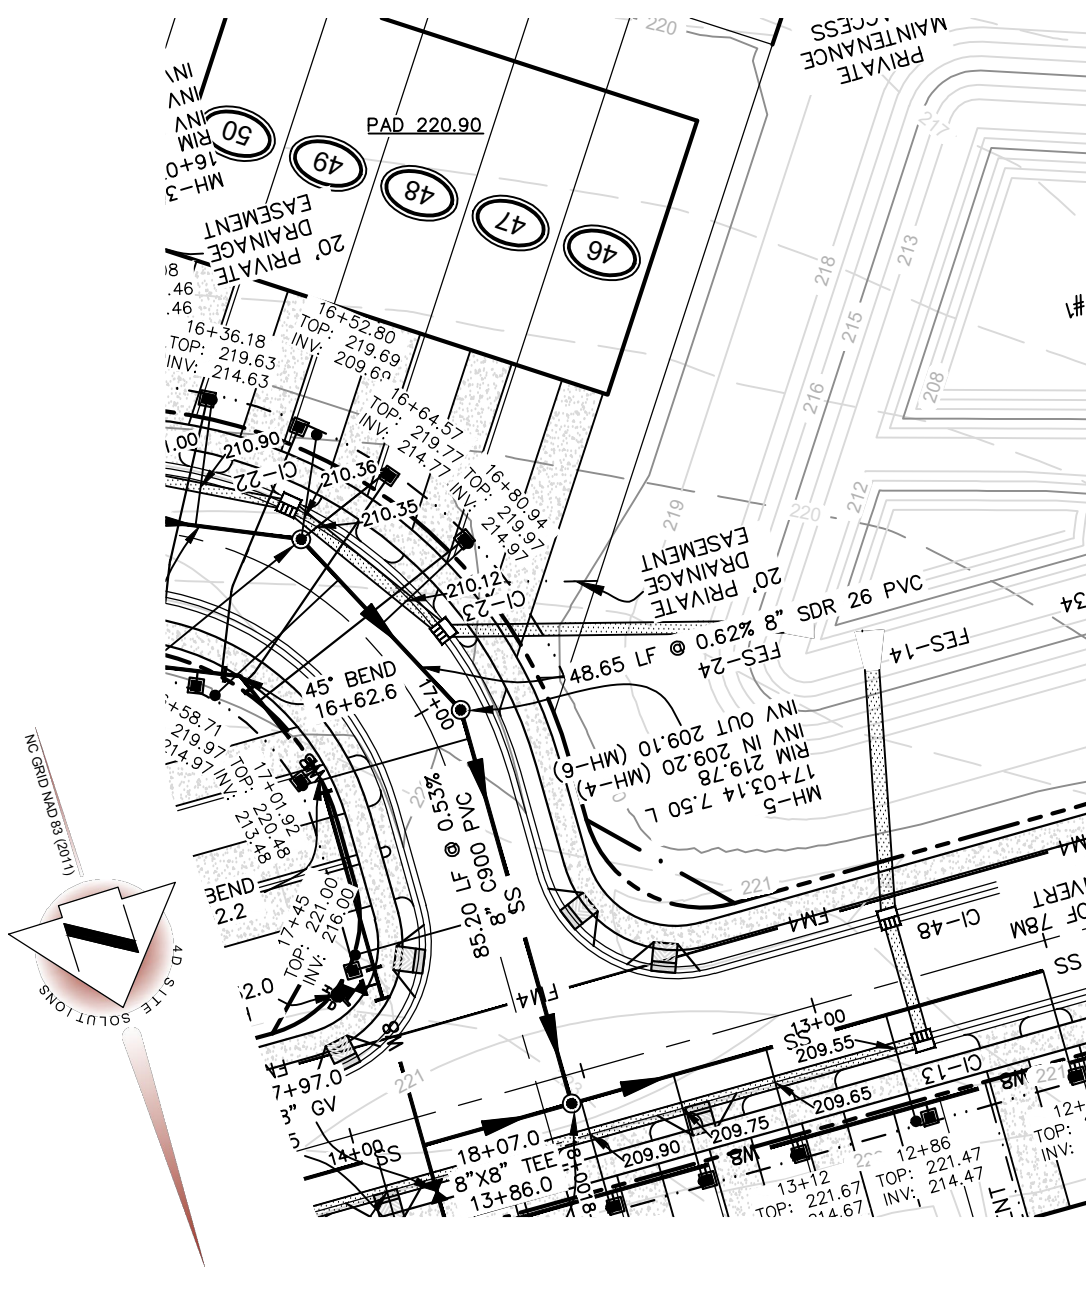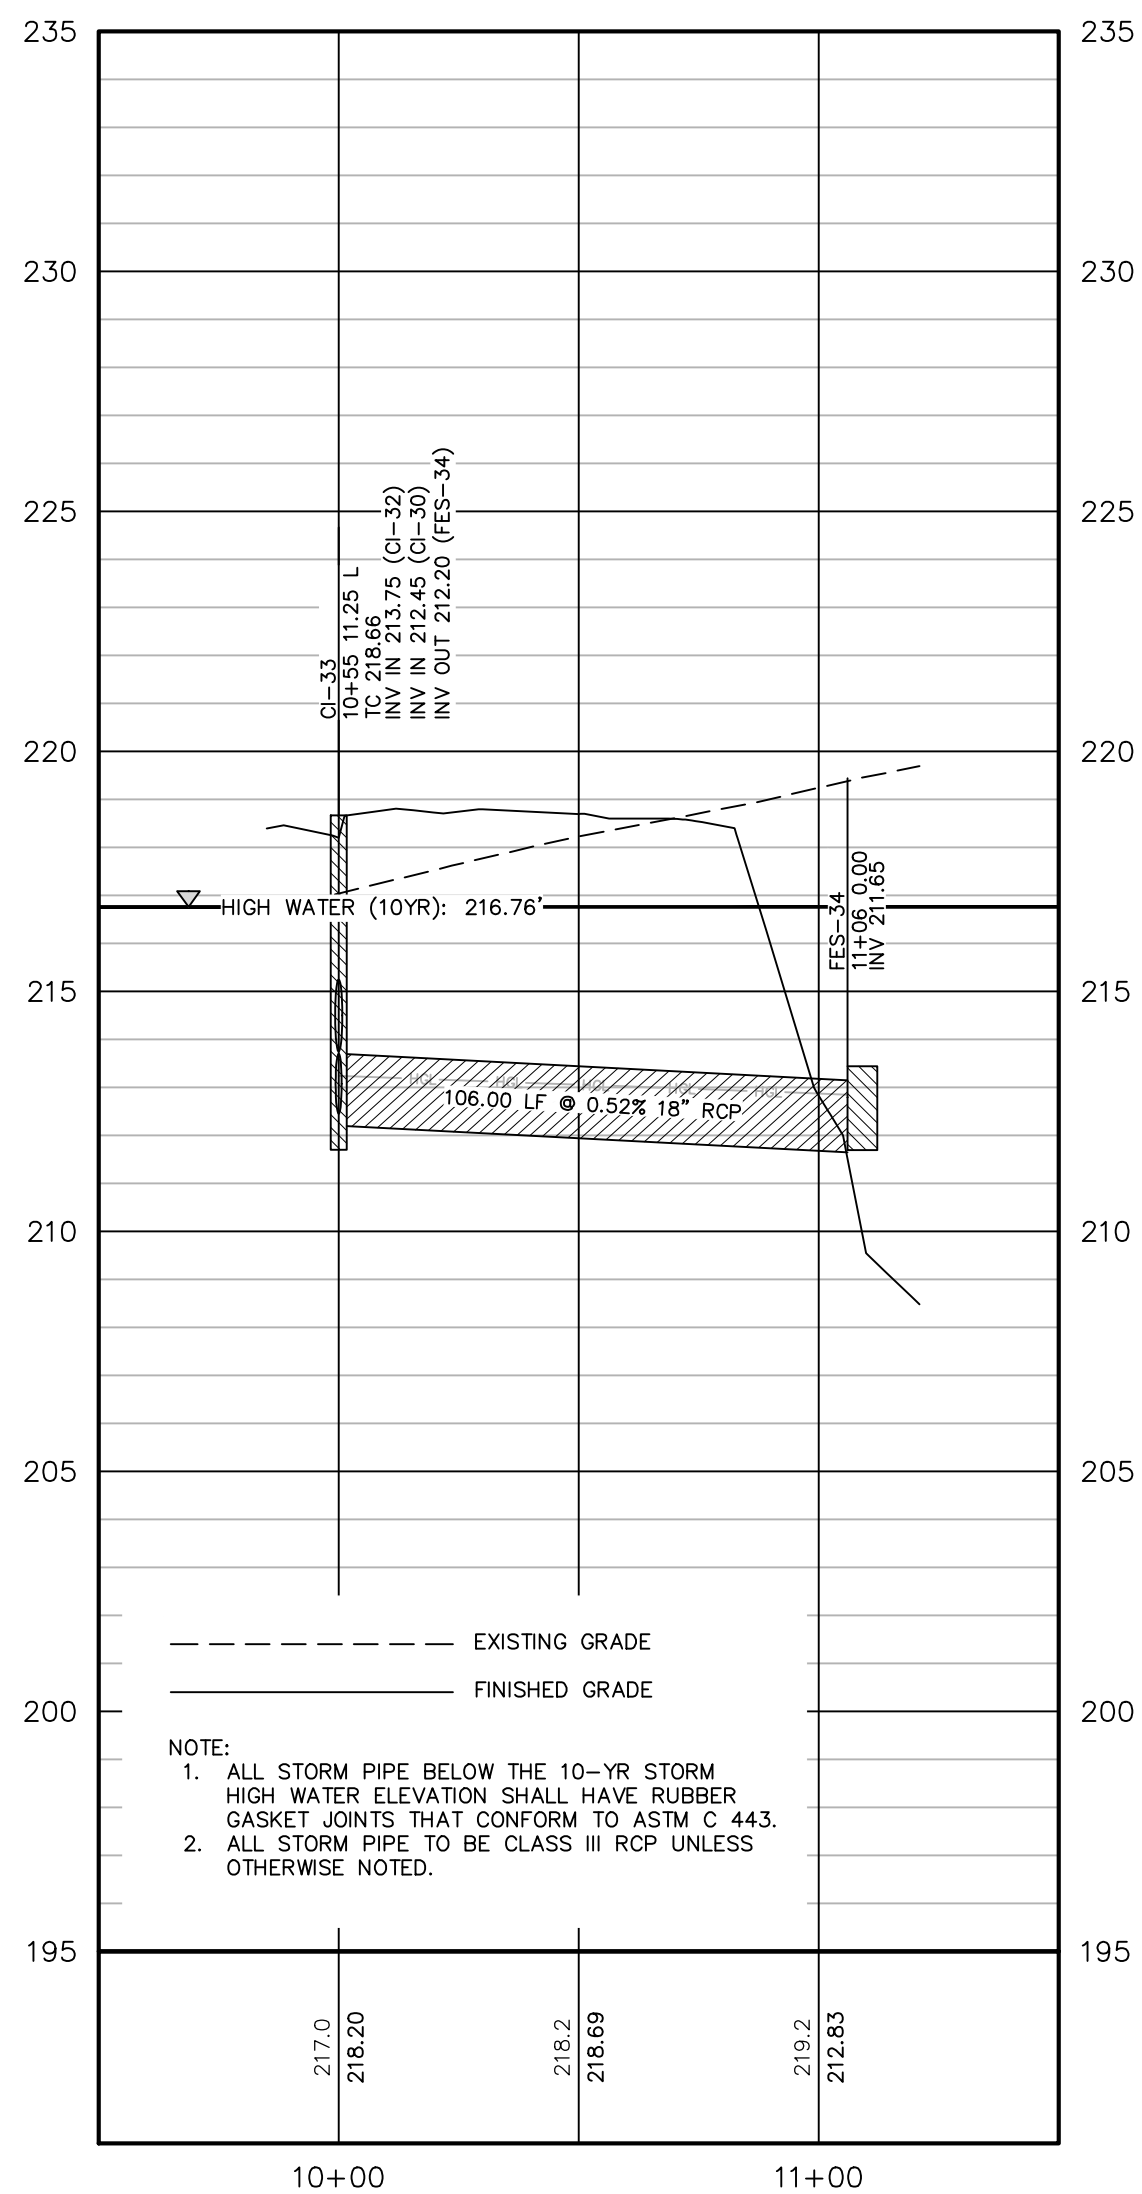



**CI-23 TO FES-24**

STORM DRAIN 9+50 TO 11+00

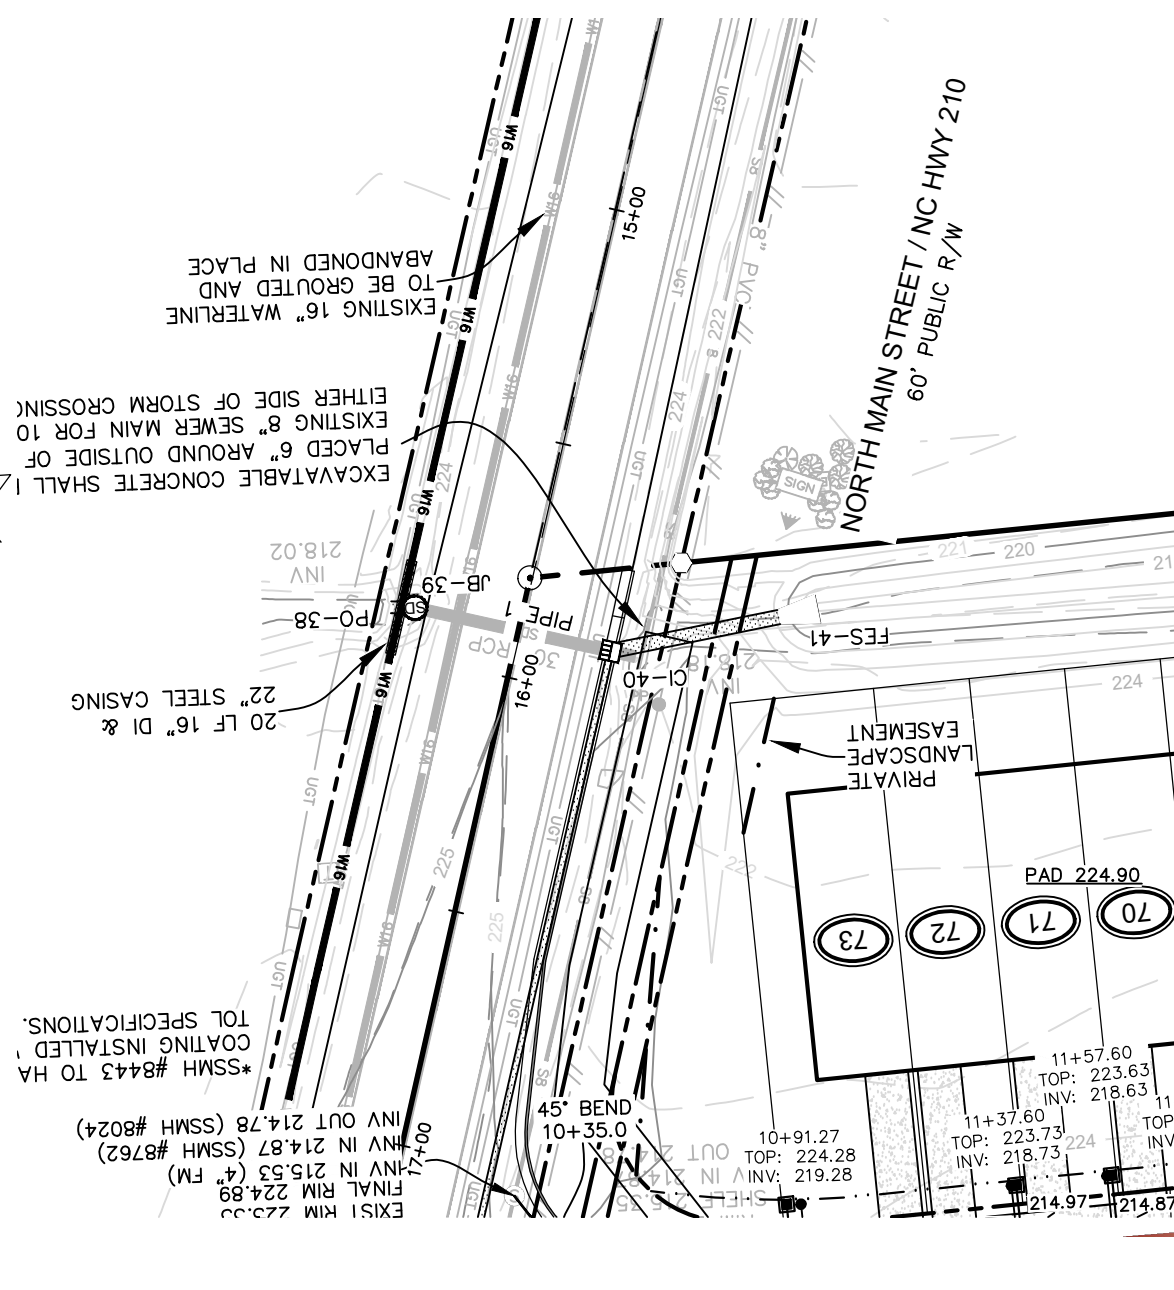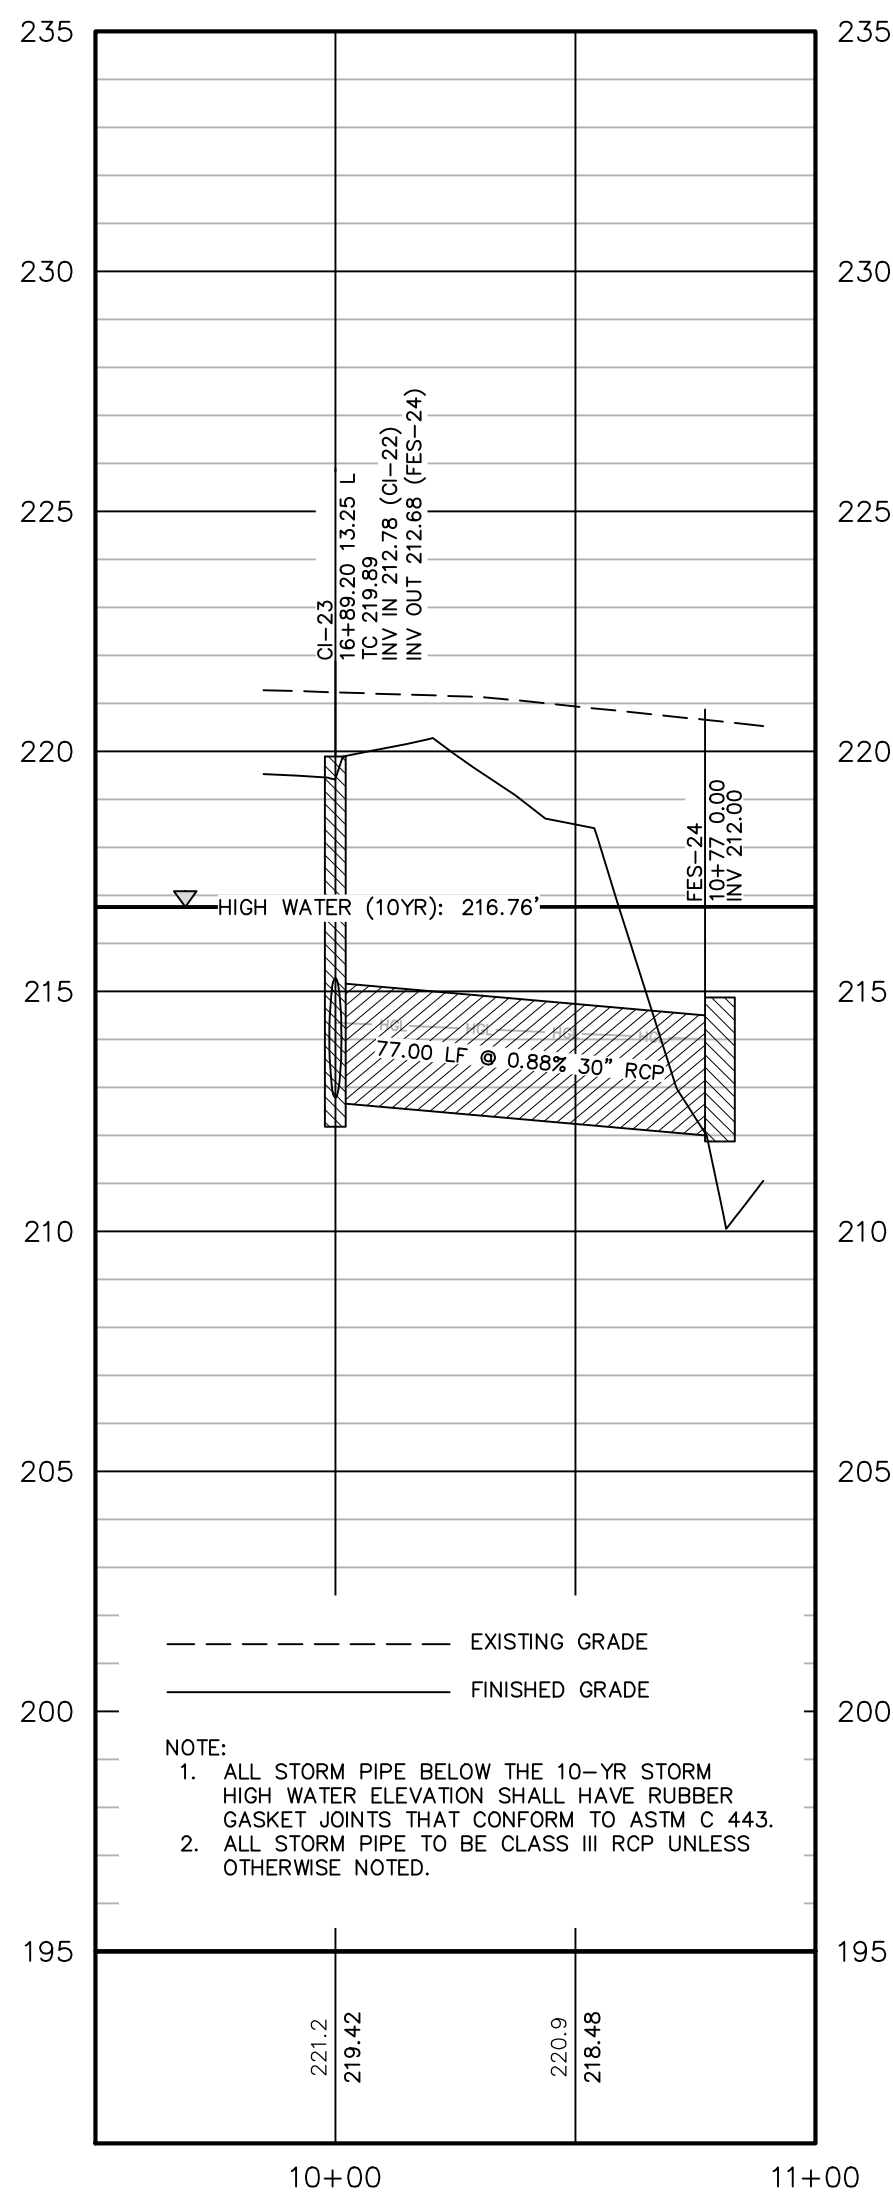



**PO-38 TO FES-41**

STORM DRAIN 9+50 TO 11+50

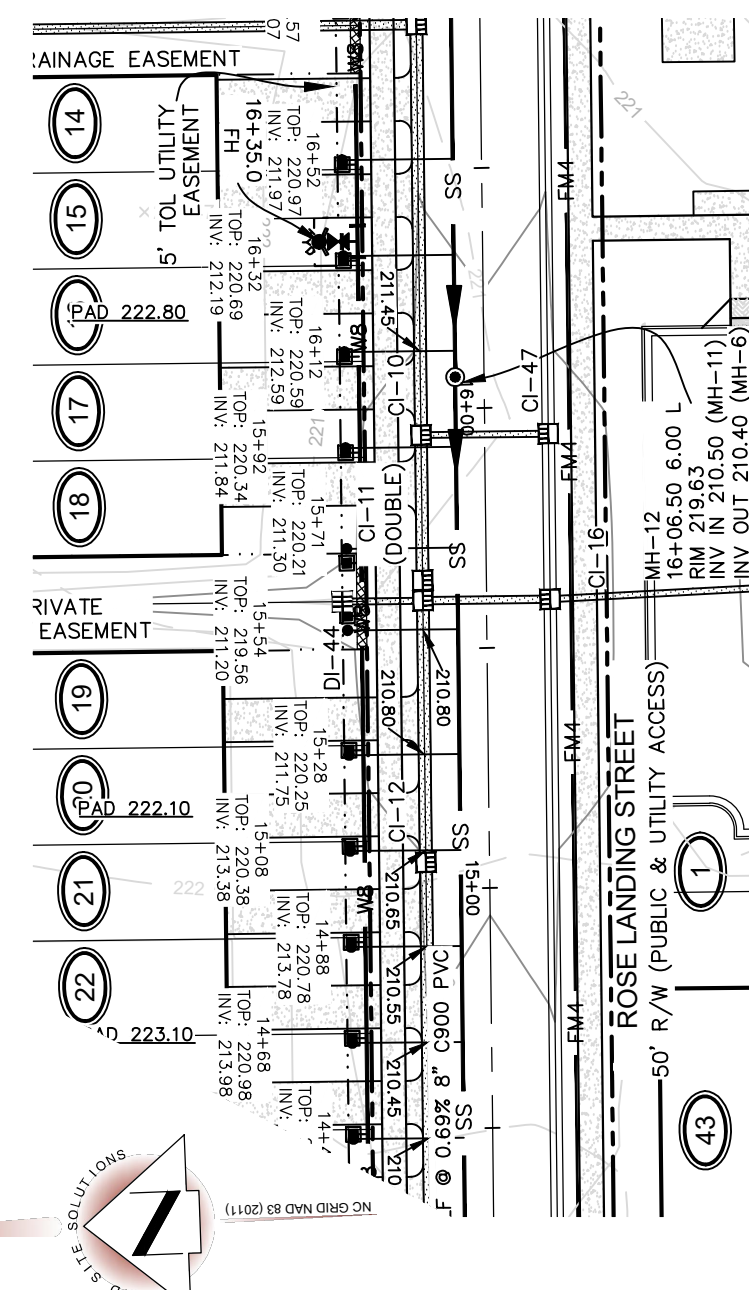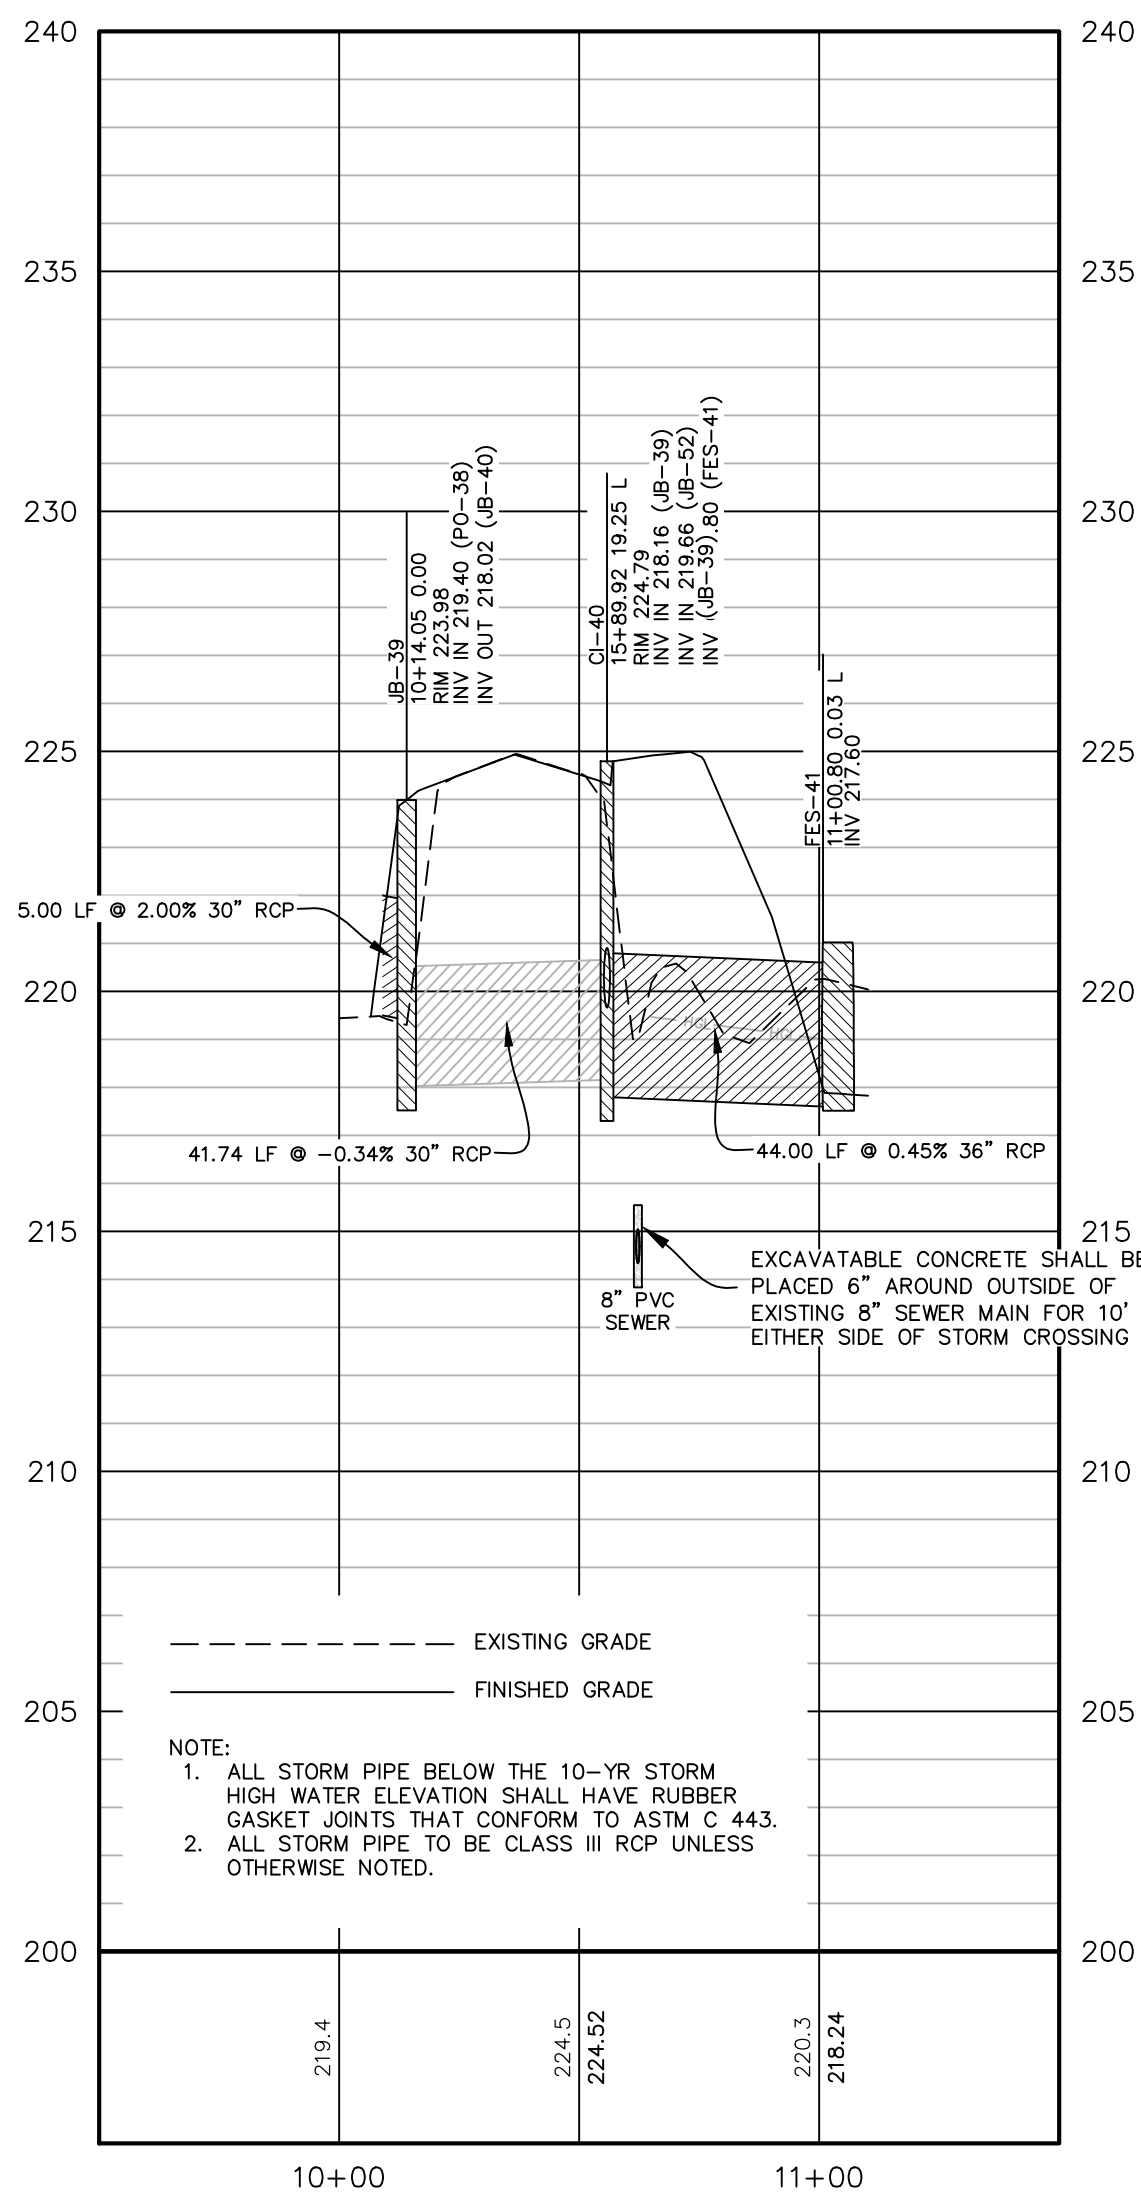



**DI-44 TO CI-11**

STORM DRAIN 9+50 TO 10+50

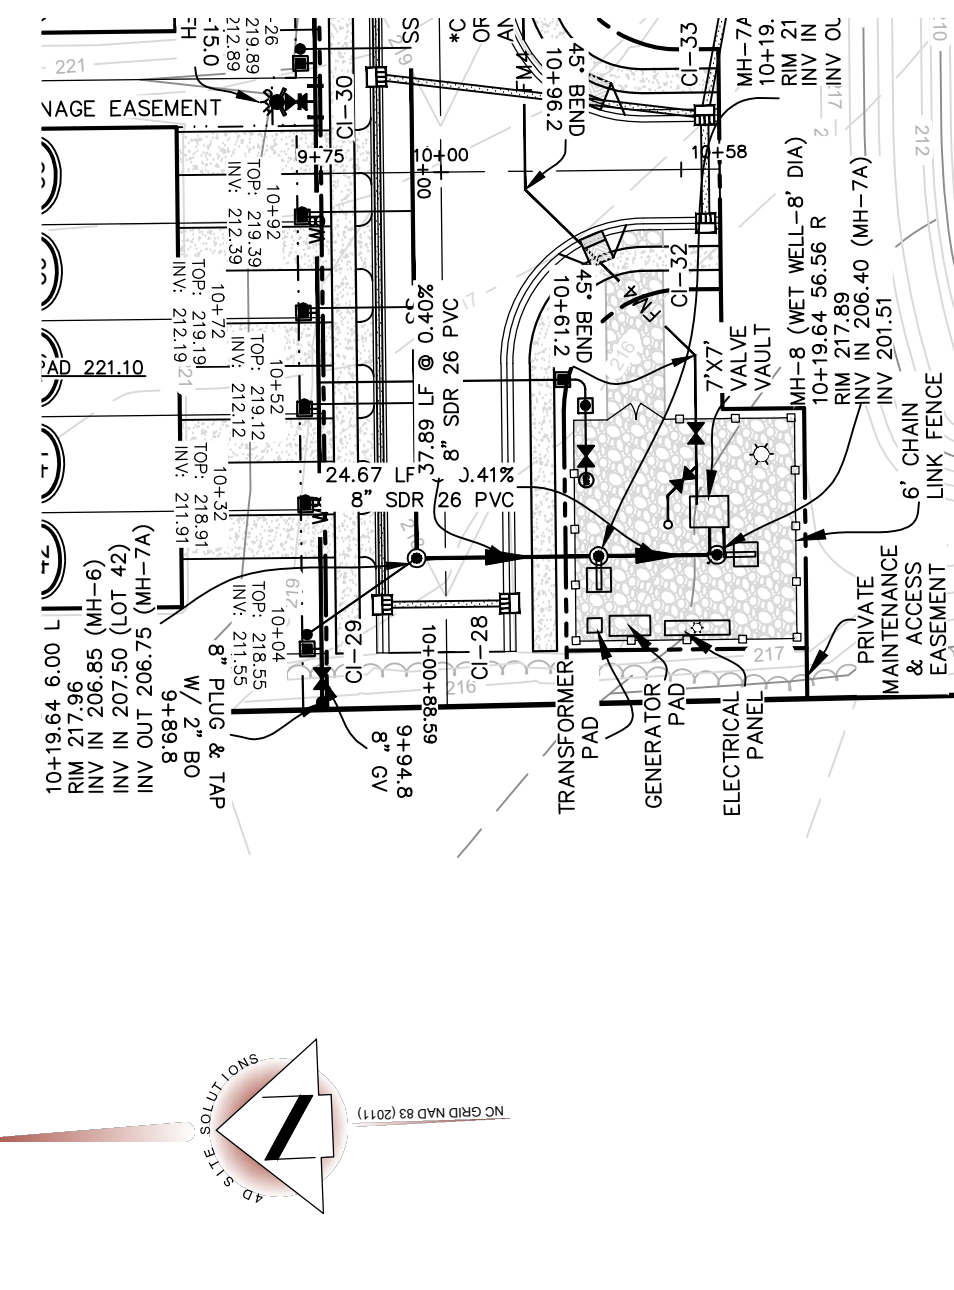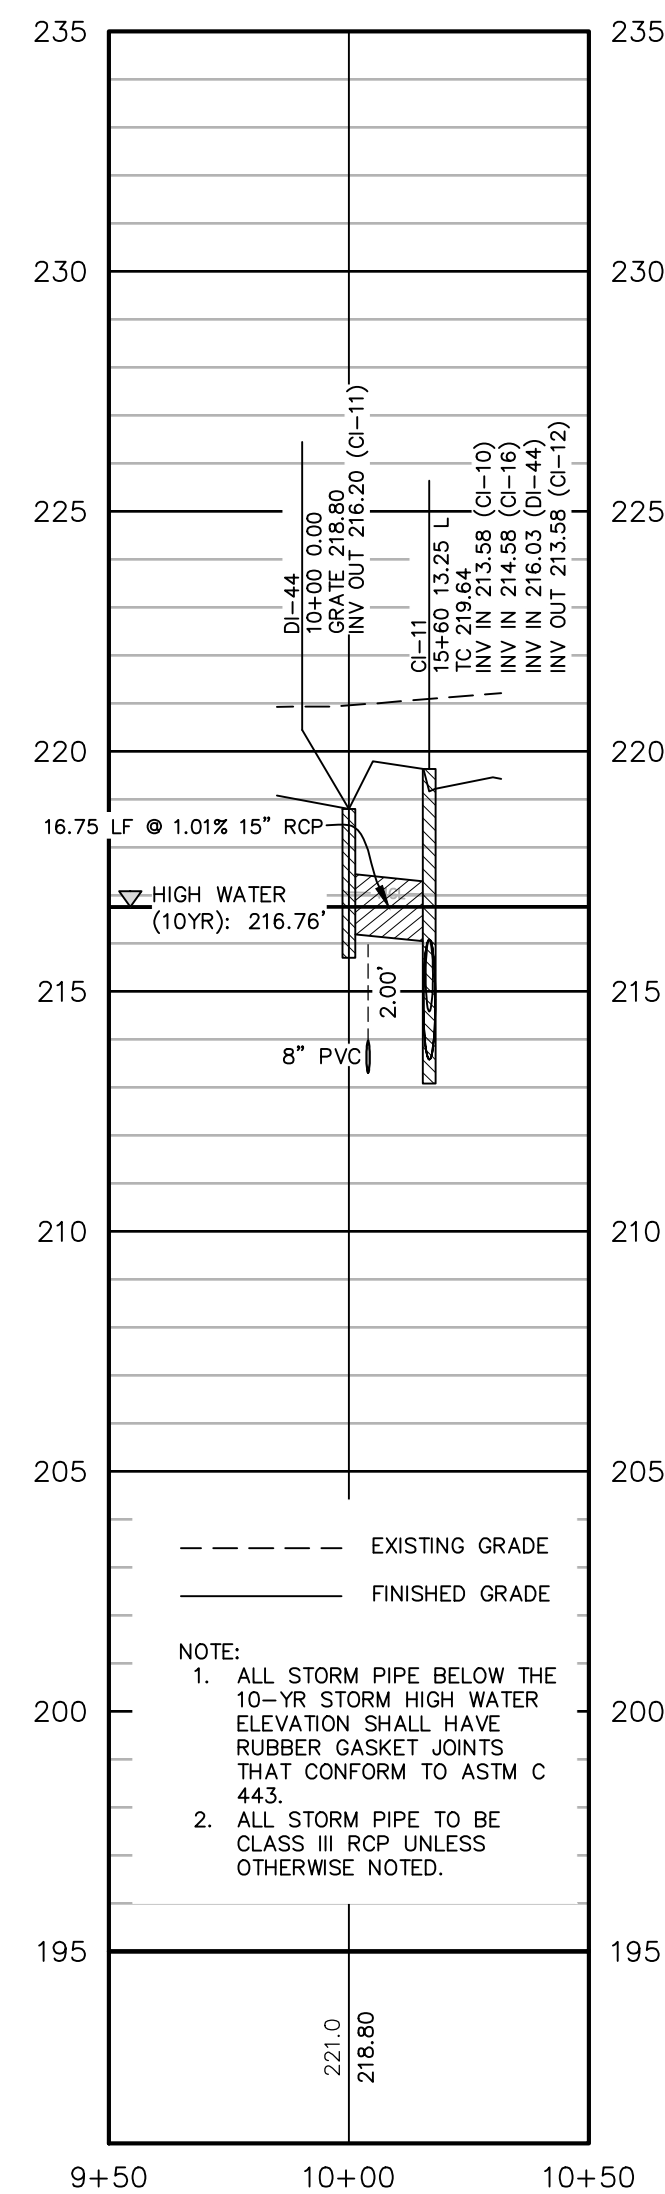

**MH-7 TO MH-8**

SANITARY SEWER 9+50 TO 11+00

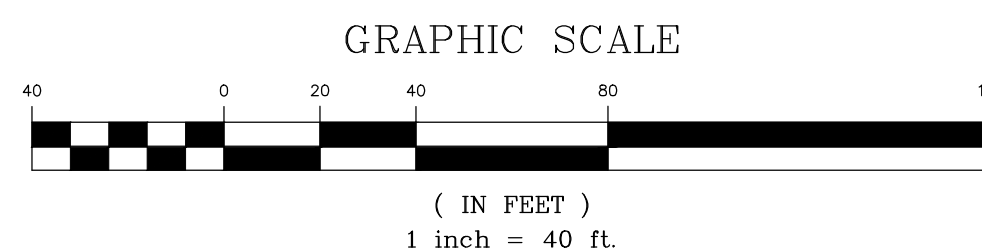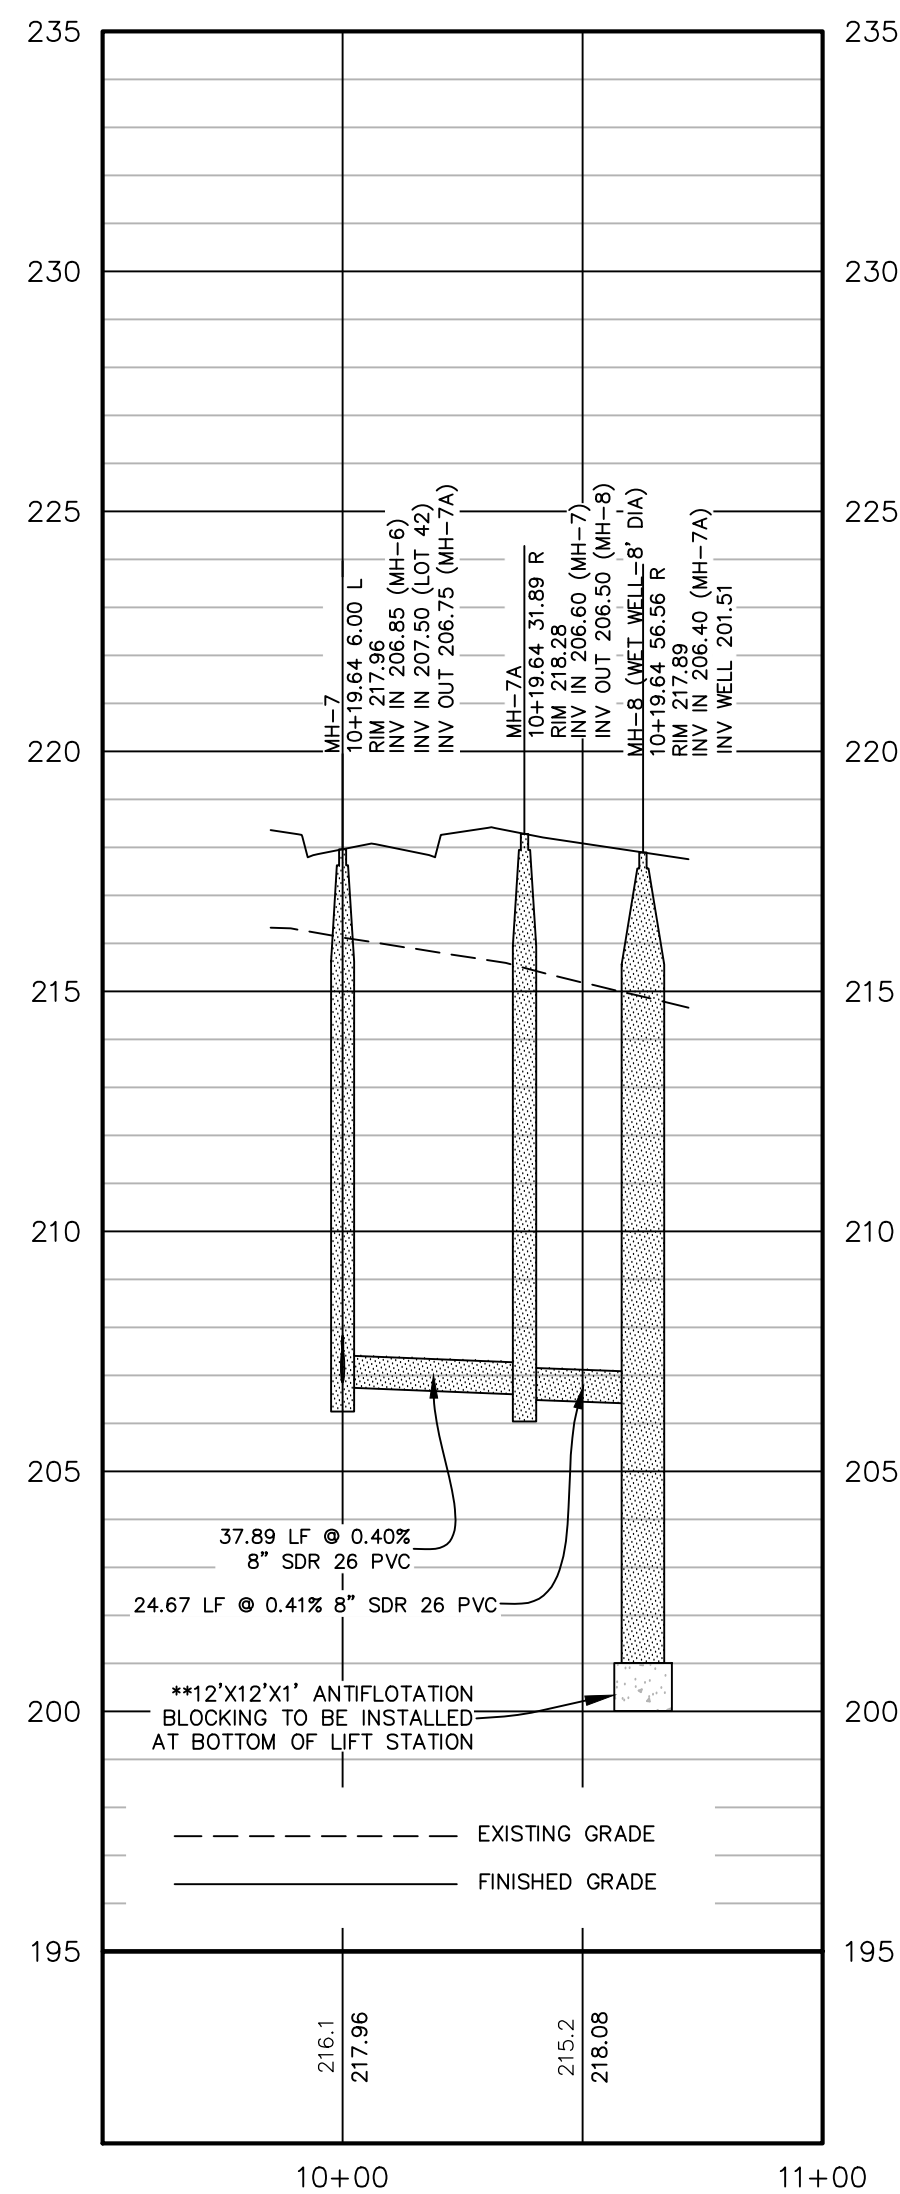





REVISIONS  
**ISSUED FOR CONSTRUCTION**

PROJECT NAME

**HARPER'S MEADOW**

**NORTH MAIN STREET - NC HWY 210 PROFILE**

CLIENT

**TRIANGLE LAND PARTNERS, LLC**

PO Box 5548  
Cary, North Carolina 27512  
Phone: (704) 608-3085

PROJECT INFORMATION

DESIGNED BY:	CALEB
DRAWN BY:	CALEB
CHECKED BY:	SCOTT
PROJECT NUMBER:	1896

DRAWING SCALE


HORIZONTAL: 1"=40'  
VERTICAL: 1"=4'

DATE RELEASED

MARCH 22, 2024



SHEET NUMBER

**C-5.5**

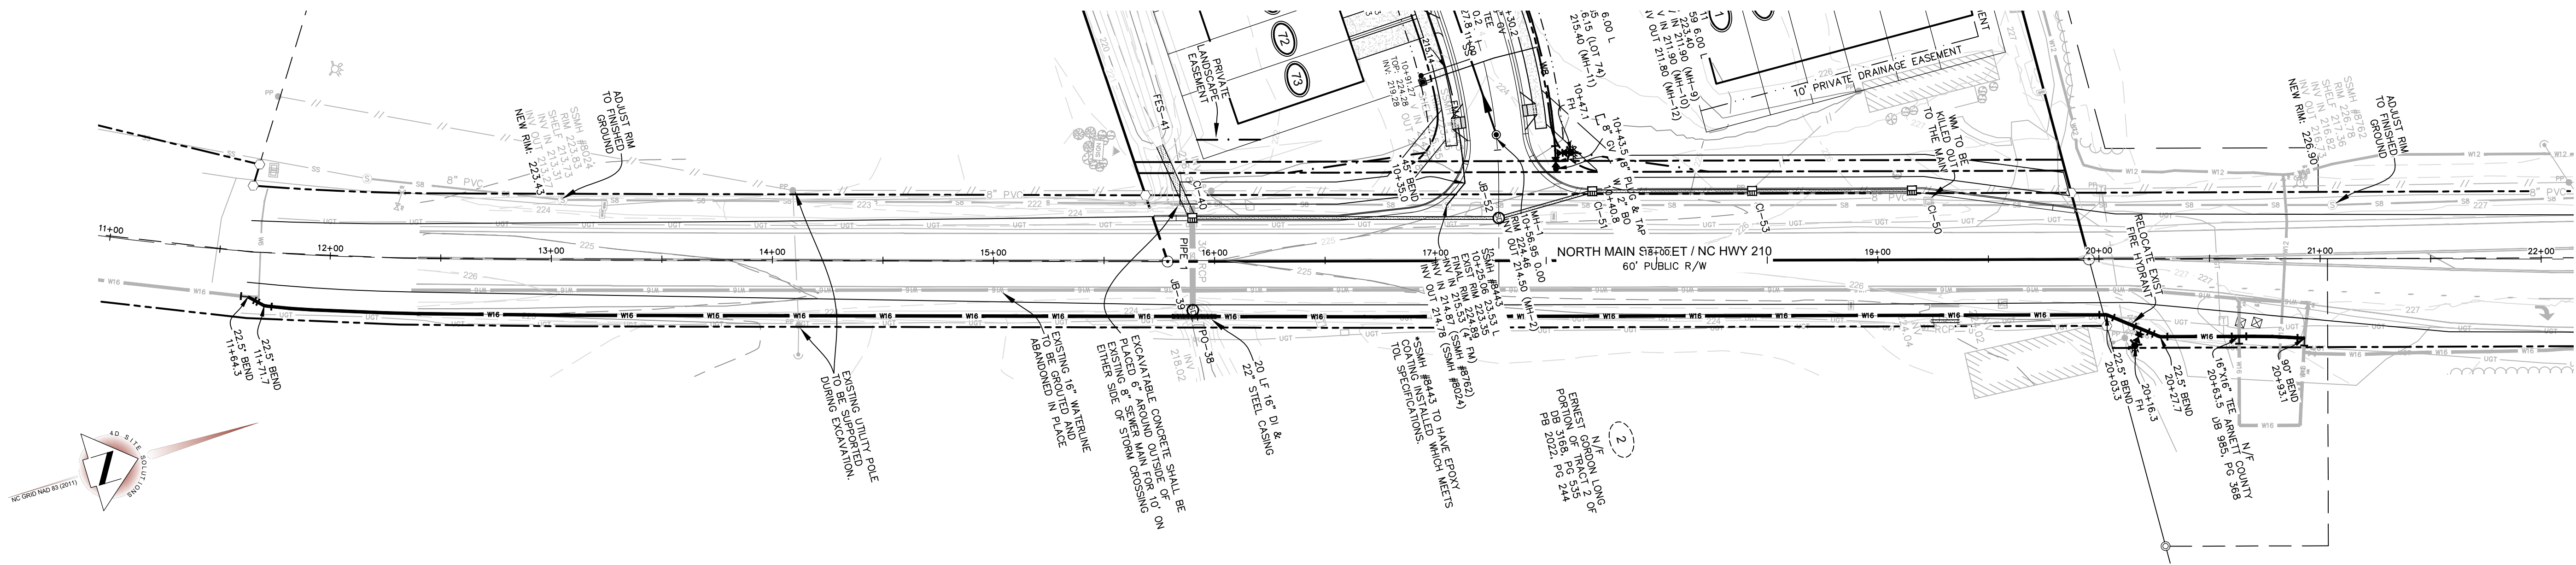

**NORTH MAIN STREET - NC HWY 210 WIDENING**

60' R/W (PUBLIC STREET)  
ROADWAY PROFILE 11+50 TO 22+50

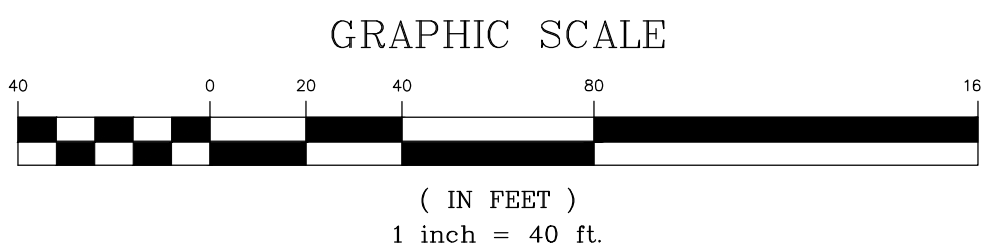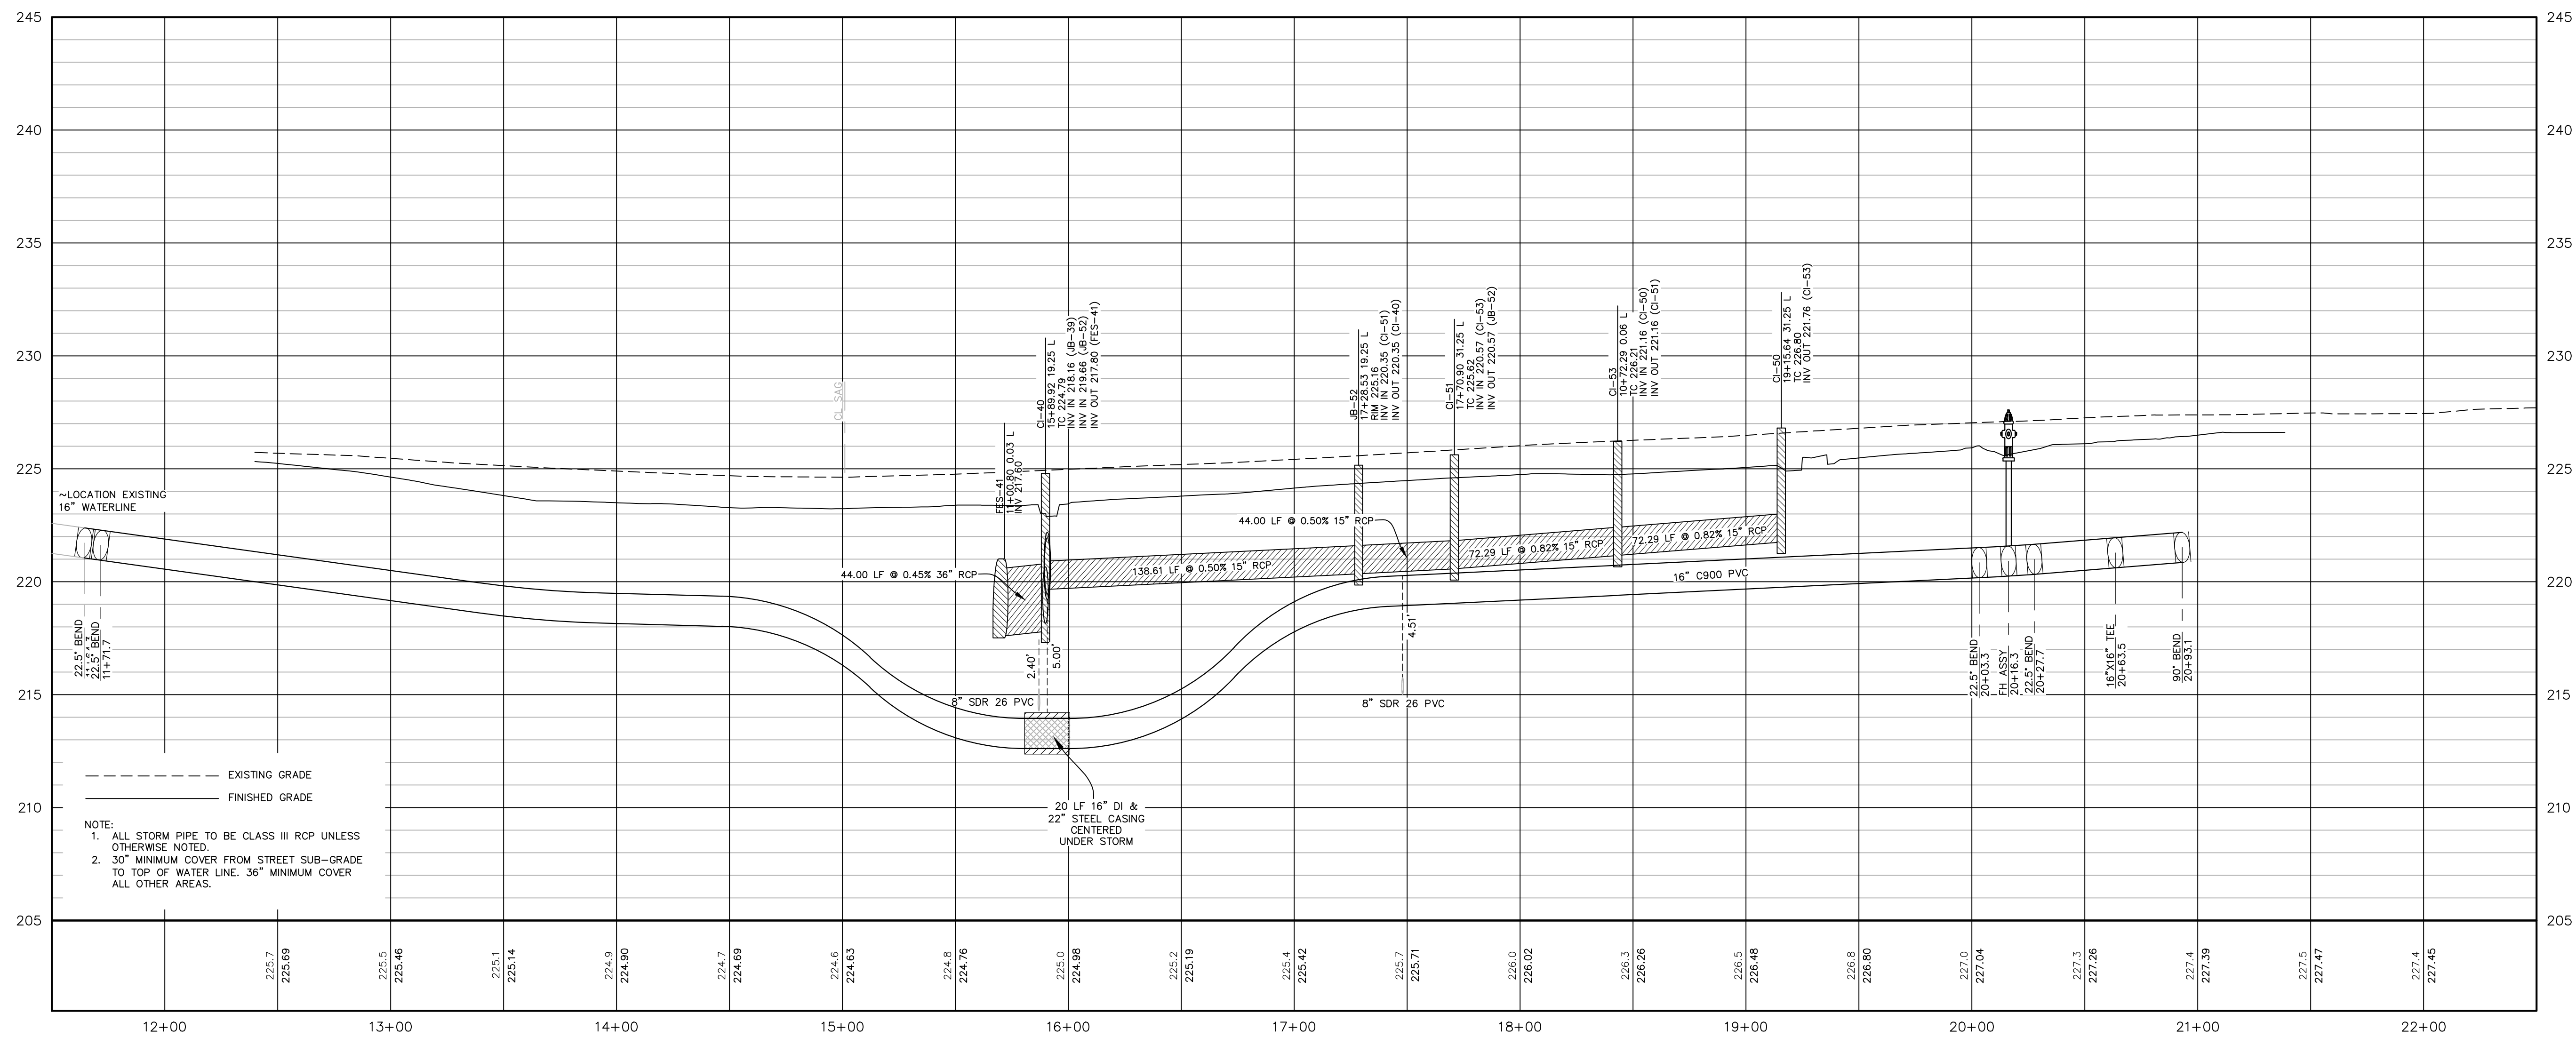





REVISIONS

ISSUED FOR CONSTRUCTION

PROJECT NAME

**HARPER'S  
MEADOW**

CLIENT

**TRIANGLE LAND  
PARTNERS, LLC**

PO Box 5548  
Cary, North Carolina 27512  
Phone: (704) 608-3085

PROJECT INFORMATION

DESIGNED BY:	CALEB
DRAWN BY:	CALEB
CHECKED BY:	SCOTT
PROJECT NUMBER:	1896

DRAWING SCALE

NOT TO SCALE


DATE RELEASED

MARCH 22, 2024

SHEET NUMBER

**C-6.0**


\*STREET TREES TO BE  
SPACED 30 FT O.C.  
EXCLUDING DRIVEWAYS &  
TRAFFIC VISIBILITY ZONES

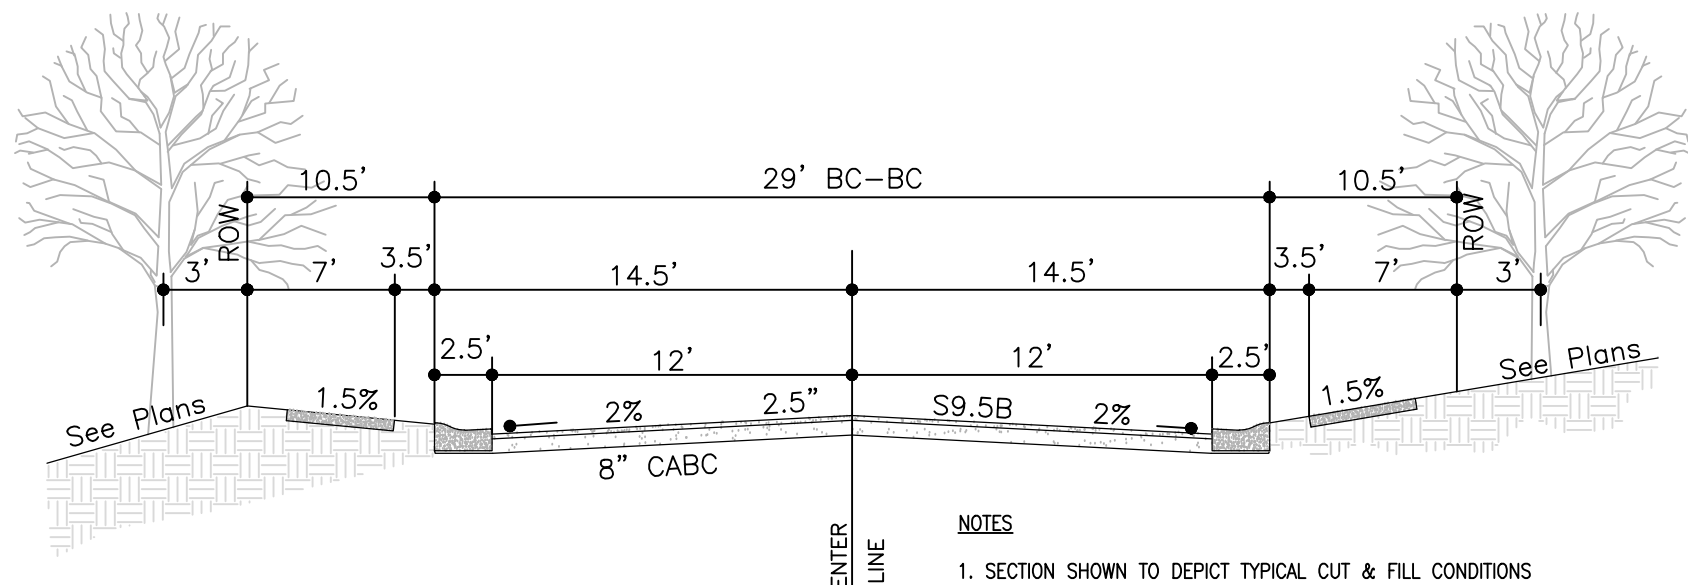


NOTES

- SECTION SHOWN TO DEPICT TYPICAL CUT & FILL CONDITIONS ONLY. GRADING PLAN SHOWS WHETHER SECTION IS IN CUT, FILL OR BOTH.
- A 5' SIDEWALK IS REQUIRED ON BOTH SIDE OF EACH STREET. SEE PLANS FOR LOCATION OF SIDEWALK.
- SIDEWALK SHALL HAVE A MAXIMUM CROSS-SLOPE OF 2% FROM BACK EDGE OF SIDEWALK TOWARD BACK OF CURB.

NTS

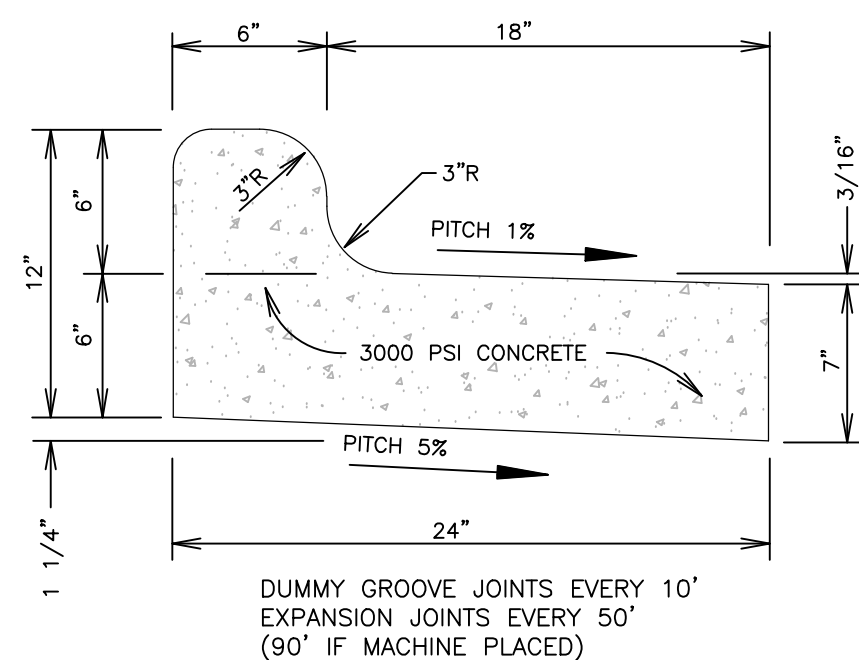


NTS

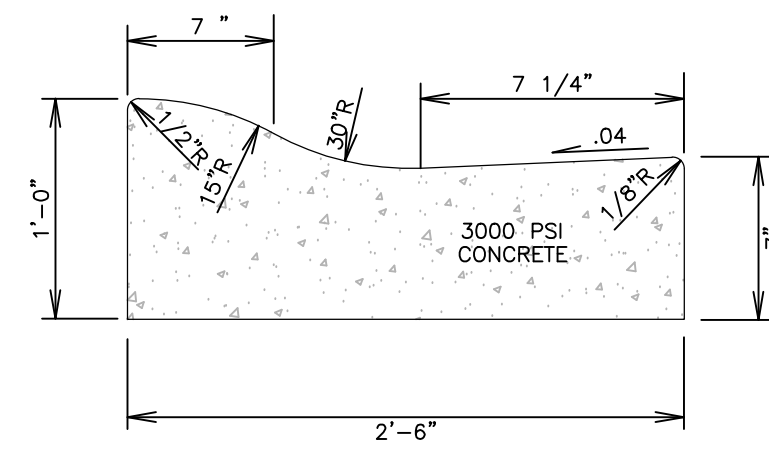

CURB AND GUTTER TO BE POURED  
IN 10' SECTIONS WITH EXPANSION  
JOINTS EVERY 50'  
(90' IF MACHINE PLACED)

NTS

1 ROADWAY TYPICAL SECTION

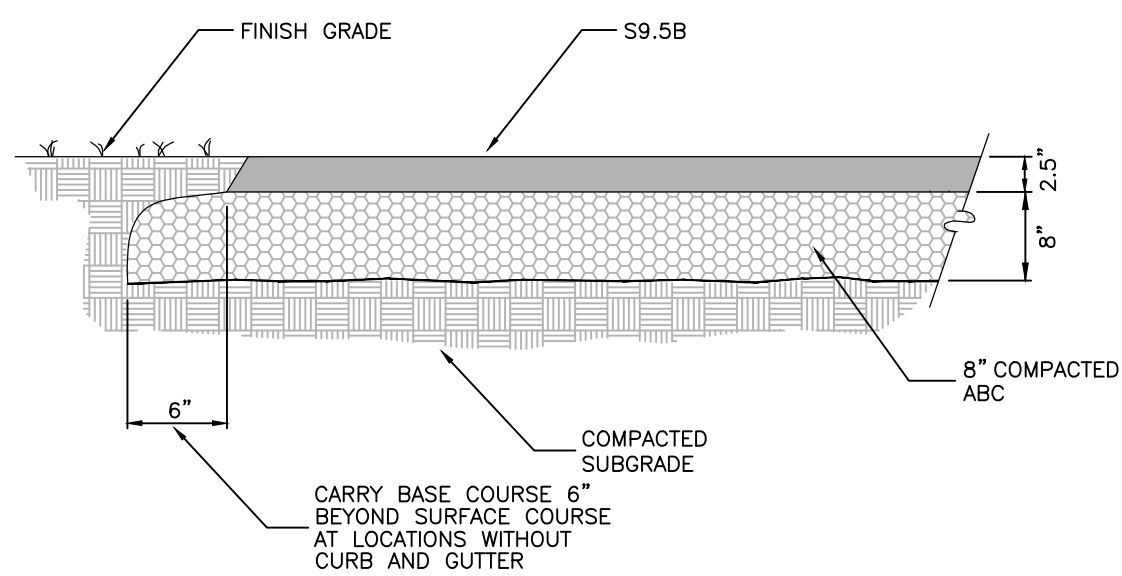


NTS

4 ASPHALT PAVEMENT

- 0.33% (12:1) MAX RAMP SLOPE
- CURB RAMP REQUIRE A (4'-0") MINIMUM LANDING WITH A MAXIMUM CROSS SLOPE AND LONGITUDINAL SLOPE OF 2.00% WHERE PEDESTRIANS PERFORM TURNING MANEUVERS. SLOPE TO DRAIN TO CURB.


PAY LIMITS FOR 1 CURB RAMP

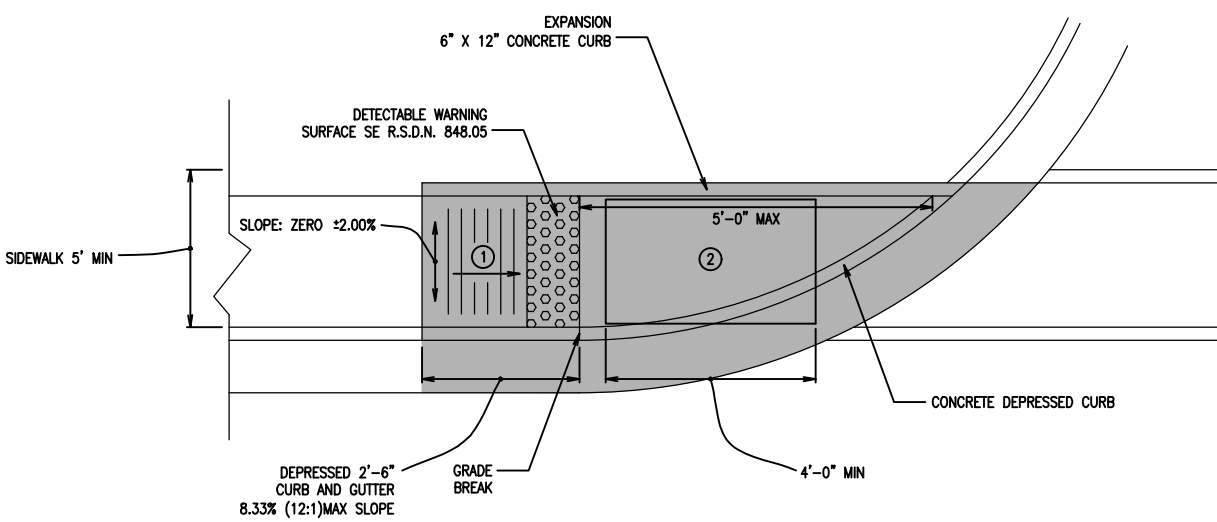

TYPE 1

NTS

7 TYPE 1 CURB RAMP

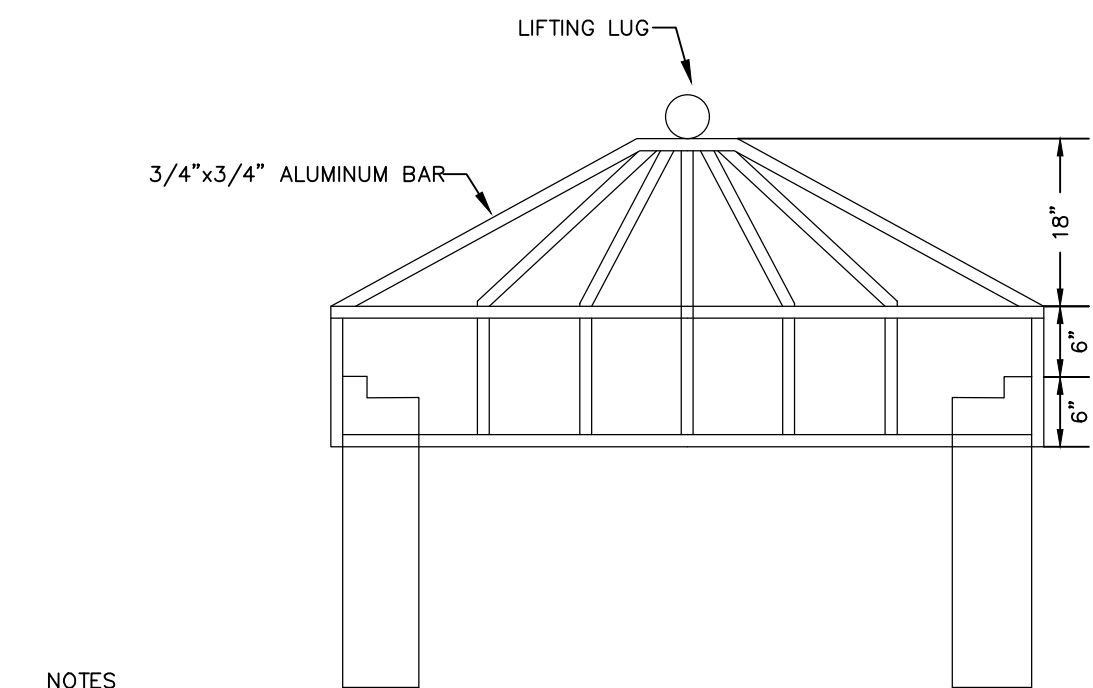

NOTES

- THE MAXIMUM SPACING BETWEEN BARS SHALL NOT EXCEED 5.5 INCHES.
- INSTALL A WALK ACCESS IN THE RACK FOR MAINTENANCE INSIDE THE STRUCTURE.

NTS



11 TRASH RACK

ACCESSIBLE PARKING REQUIREMENTS		
TOTAL PARKING SPACES PROVIDED	MINIMUM NUMBER OF ACCESSIBLE SPACES REQUIRED	MINIMUM NUMBER OF ACCESSIBLE SPACES REQUIRED TO BE VAN ACCESSIBLE
1 TO 25	1	1
26 TO 50	2	1
51 TO 75	3	1
76 TO 100	4	1
101 TO 150	5	1
151 TO 200	6	1
201 TO 300	7	1
301 TO 400	8	1
401 TO 500	9	2
501 TO 1000	2% OF TOTAL	1 IN EVERY 8 ACCESSIBLE SPACES
1001 AND OVER	20 PLUS 1 FOR EACH 100 OVER 1000	1 IN EVERY 8 ACCESSIBLE SPACES

SECTION 4.1.2 (5) OF THE AMERICANS WITH DISABILITIES ACT (ADA). SEE 4.1.2 (5) (6) FOR MEDICAL CARE FACILITIES.

NOTES:

- ALL 12'x18' ACCESSIBLE SPACES (R7-B & R7-1) SHALL BE MOUNTED AT 7 FEET FROM GRADE TO BOTTOM EDGE OF SIGN PANEL (MUTCD). MOUNTING HEIGHT CAN BE REDUCED TO 5 FEET IF PLACED IN AN AREA BETWEEN SIDEWALK AND BUILDING FACE IN WHICH PEDESTRIANS ARE NOT EXPECTED TO USE.
- REFER TO MANUAL ON UNIFORM TRAFFIC CONTROL DEVICES, (MUTCD) U.S. DEPARTMENT OF TRANSPORTATION AND NORTH CAROLINA DEPARTMENT OF TRANSPORTATION SIGNAGE.
- IF ACCESSIBLE ROUTE IS A RAISED SIDEWALK AREA, THEN RAMP ARE REQUIRED AT LOADING ZONE AREA.
- ALL DIMENSIONS, PAVEMENT MARKINGS AND SIGNAGE SHALL COMPLY WITH CURRENT ADA REQUIREMENTS.

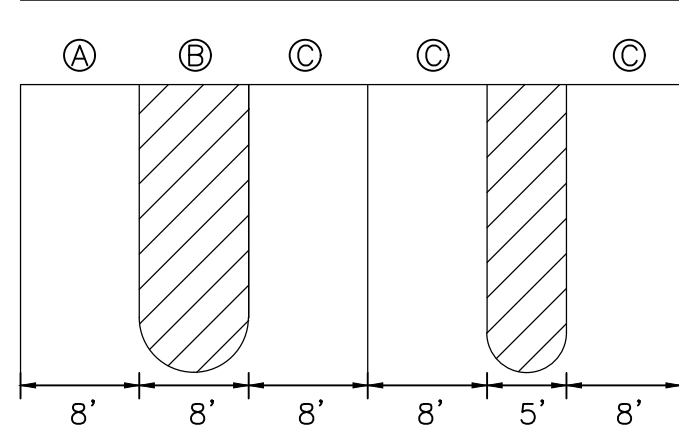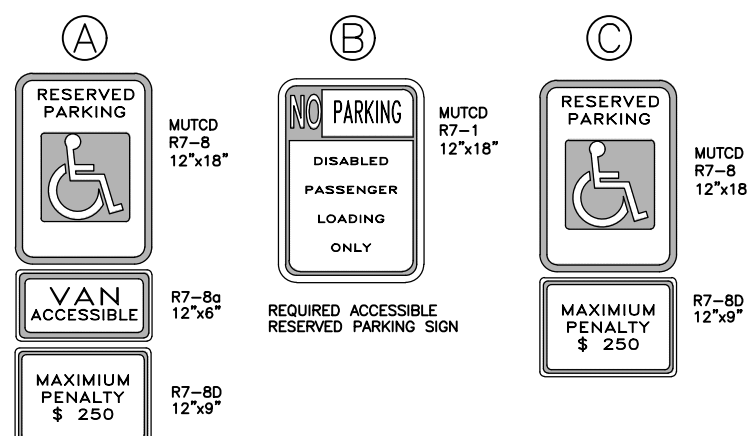


ACCESSIBLE ROUTE  
(SEE NOTE 3)

ONE OUT OF EVERY EIGHT (8) ACCESSIBLE SPACES, BUT NOT LESS THAN ONE, IS REQUIRED TO BE VAN ACCESSIBLE.

PARKING SPACE PAVEMENT MARKINGS

NTS

5 HANDICAP SIGNAGE AND PAVEMENT MARKINGS

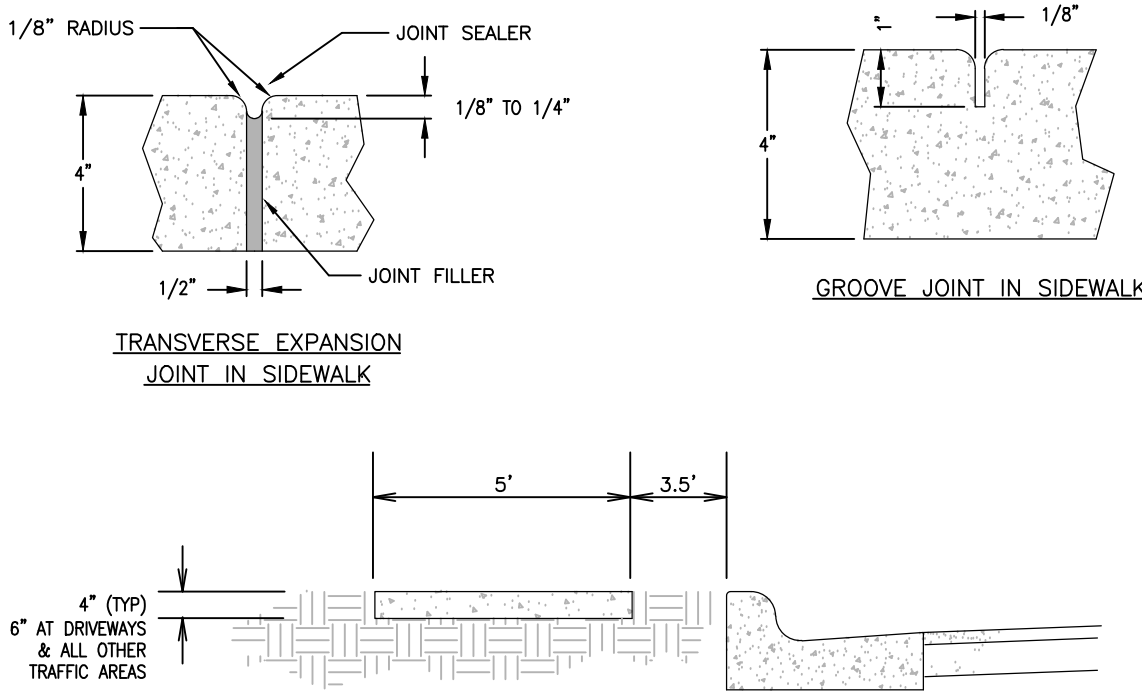


NOTE:

- PROVIDE CONTROL JOINTS AT DISTANCE EQUAL TO WIDTH OF SIDEWALK, PROVIDE 1/2" EXP. JOINTS WITH PRE-MOLDED E.J. FILLER AT MAX. 30' O.C.
- CONCRETE COMPRESSIVE STRENGTH SHALL BE 3000 PSI. IN 28 DAYS.

NTS

8 SIDEWALK WITH CURB

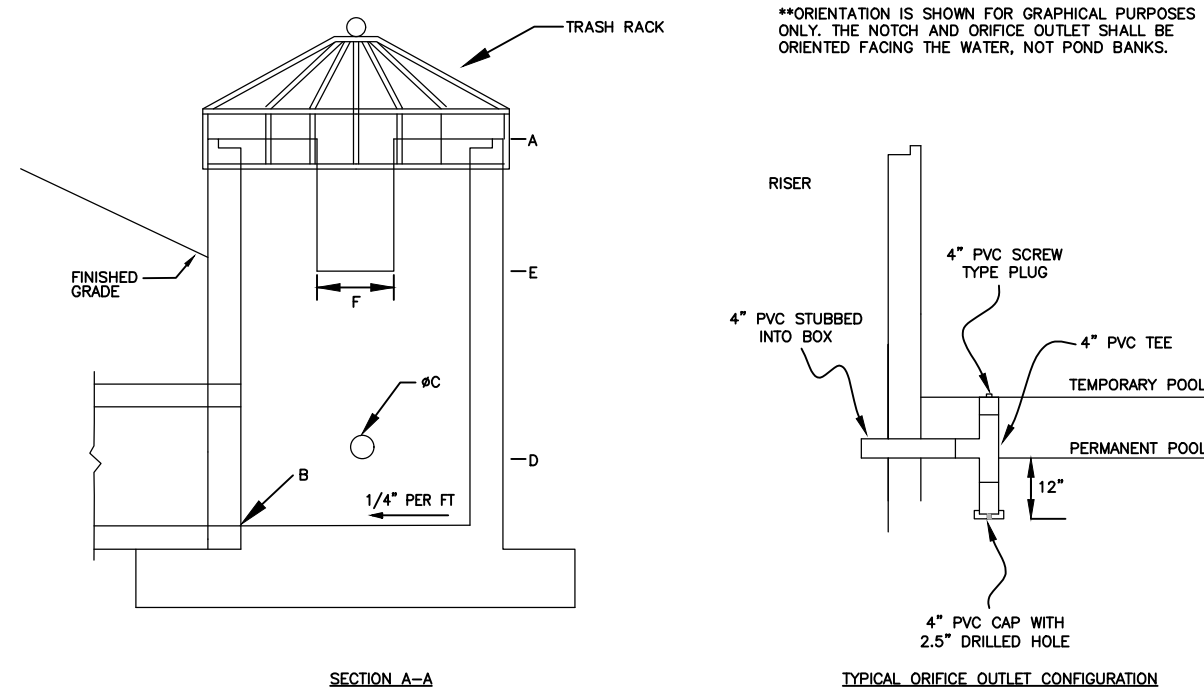


NOTES

- MIN. OUTSIDE Riser DIMENSIONS: L=4', W=3'2" MIN. INSIDE Riser DIMENSIONS: L=3', W=2'2"

NTS

12 STORM BASIN RISER WITH ORIFICE DETAIL


9 SHRUB PLANTING

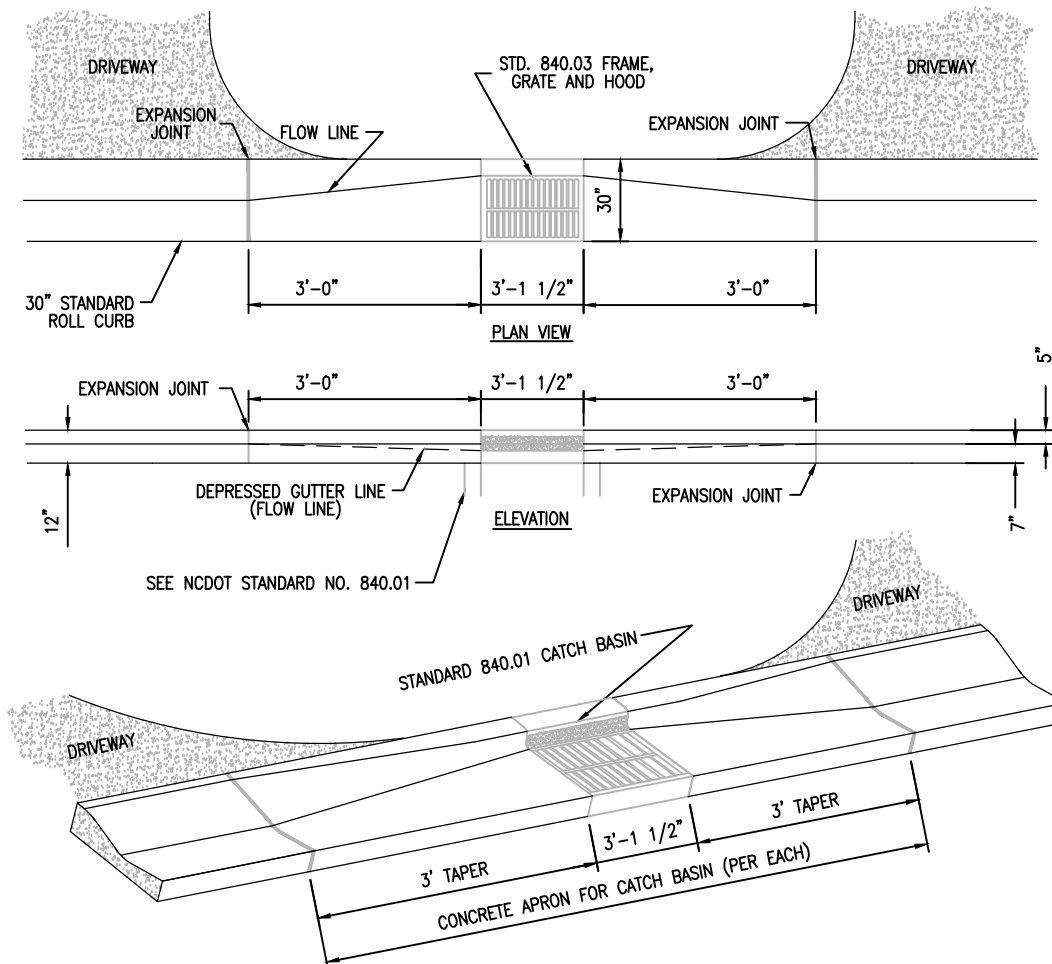

NTS

13 REDUCED LENGTH CURB TRANSITION

10 TREE PLANTING

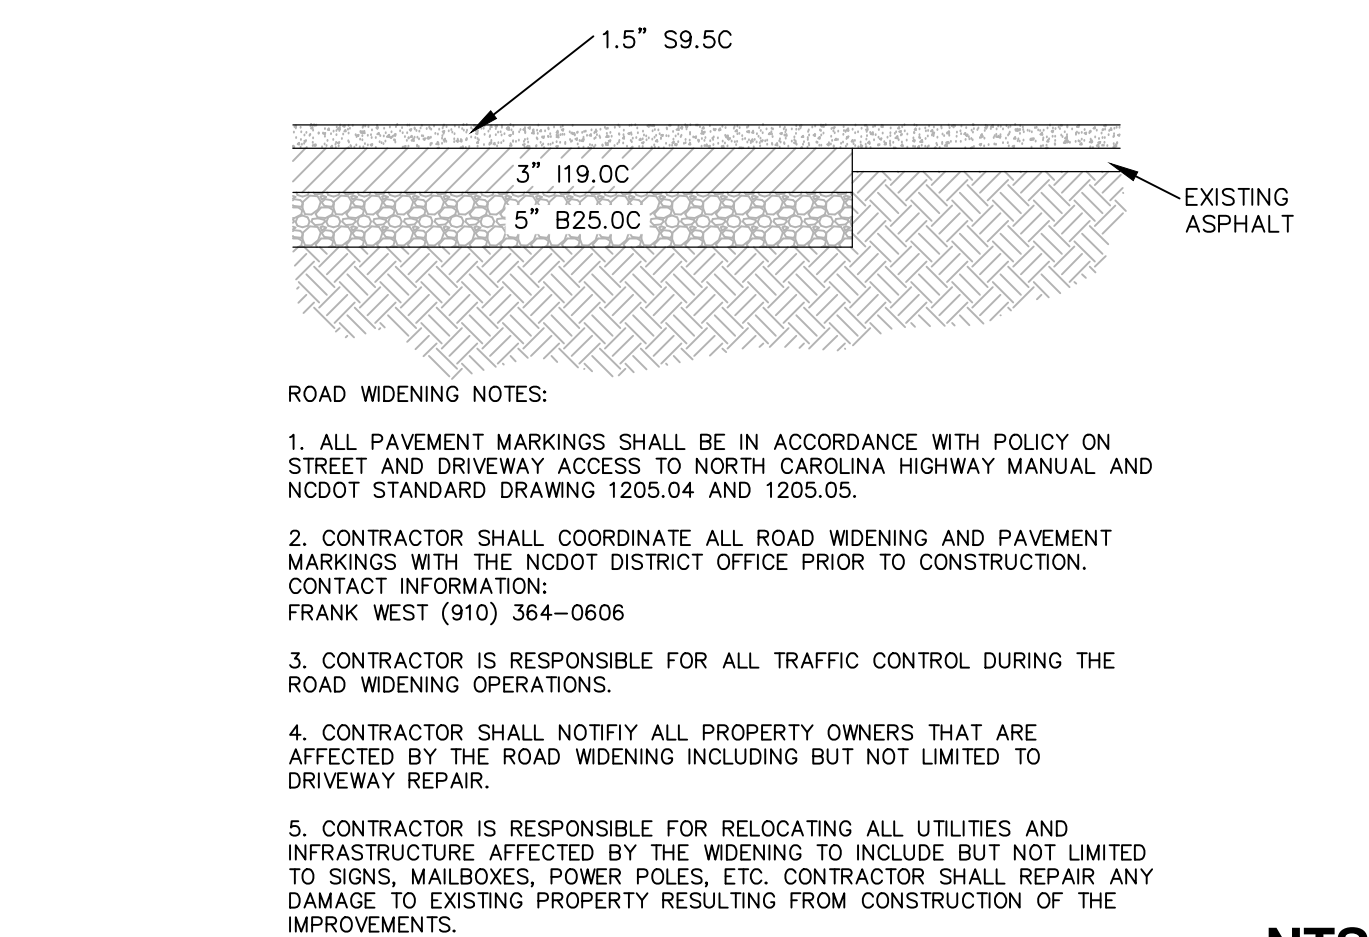

ROAD WIDENING NOTES:

- ALL PAVEMENT MARKINGS SHALL BE IN ACCORDANCE WITH POLICY ON STREET AND DRIVEWAY ACCESS TO NORTH CAROLINA HIGHWAY MANUAL AND NCDOT STANDARD DRAWING 1205.04 AND 1205.05.
- CONTRACTOR SHALL COORDINATE ALL ROAD WIDENING AND PAVEMENT MARKINGS WITH THE NCDOT DISTRICT OFFICE PRIOR TO CONSTRUCTION. CONTACT INFORMATION: FRANK WEST (910) 364-0606
- CONTRACTOR IS RESPONSIBLE FOR ALL TRAFFIC CONTROL DURING THE ROAD WIDENING OPERATIONS.
- CONTRACTOR SHALL NOTIFY ALL PROPERTY OWNERS THAT ARE AFFECTED BY THE ROAD WIDENING INCLUDING BUT NOT LIMITED TO DRIVEWAY REPAIR.
- CONTRACTOR IS RESPONSIBLE FOR RELOCATING ALL UTILITIES AND INFRASTRUCTURE AFFECTED BY THE WIDENING TO INCLUDE BUT NOT LIMITED TO SIGNS, MAILBOXES, POWER POLES, ETC. CONTRACTOR SHALL REPAIR ANY DAMAGE TO EXISTING PROPERTY RESULTING FROM CONSTRUCTION OF THE IMPROVEMENTS.

NTS

14 PAVEMENT WIDENING SECTION



[illegible]

# NTS

The diagram illustrates the construction of a trench for erosion control, showing the trench layout, steel posts, wire fencing, and the placement of baffles to manage water flow and sediment.

**Diagram Labels:**

- DRIVE POSTS 32" INTO THE GROUND MAXIMUM 6' O.C. AND EXCAVATE A 4" X 6" TRENCH UNLESS ALONG THE LINE OF POSTS.
- STEEL POSTS
- STEP 1
- STEP 2
- ATTACH WIRE FENCE TO POSTS AND EXTEND THE BOTTOM OF THE FENCE 6" INTO THE TRENCH AND TURNED OUT 4" IN THE TRENCH.
- ATTACH WIRE FENCE TO POSTS AND EXTEND THE BOTTOM OF THE FENCE 6" INTO THE TRENCH AND TURNED OUT 4" IN THE TRENCH.
- SOIL BACKFILL THE TRENCH AND COMPACT THE SOIL FILL TO ANCHOR THE BOTTOM OF THE SILT FENCE. BURRED FABRIC SHALL NOT BE VISIBLE THE TOP OF THE FABRIC SHALL BE HIGHER THAN THE TRENCH.
- SOIL BACKFILL THE TRENCH AND COMPACT THE SOIL FILL TO ANCHOR THE BOTTOM OF THE SILT FENCE. BURRED FABRIC SHALL NOT BE VISIBLE THE TOP OF THE FABRIC SHALL BE HIGHER THAN THE TRENCH.
- HEIGHT MAX 12"
- POSTS MAX 6' O.C.
- TOP STAY STAY OR EQUIVALENT
- BOTTOM OF FABRIC BURIED 12"
- FABRIC TURNED OUT 4" IN THE TRENCH OR PARALLEL WITH EROSION CONTROL MATTING STRIPES
- FLOW
- STEEL POST DRIVEN 32" INTO GROUND

**NOTES:**

- GRADE THE BARRN SHA AS THE BARRN IS LEVEL.
- INSTALL THE BARRIES AS SHOWN ON THE GRADING PLAN. BARRIES SHALL EXTEND THE FULL WIDTH OF THE BARRN.
- DO NOT SLICE THE FABRIC. USE A CONTINUOUS RICE ACROSS THE BARRN ON THE.
- USE A CONTINUOUS RICE ACROSS THE BARRN AS SHOWN.

**MAINTENANCE**

- INSPECT THE BARRIES EACH ACTIVE DAY ON SITE BUT IN NO CASE LESS THAN ONCE PER WEEK AND AFTER EACH RAINFALL EVENT. MAKE ANY REPAIRS IMMEDIATELY.
- REMOVE SEDIMENT DEPOSITS WHEN THE MEASURE REACHES HALF FULL. TAKE CARE TO AVOID DAMAGING THE BARRIES WHEN THE SEDIMENT IS REMOVED.
- TEMPORARY MEASURE SHALL NOT BE RELIED BY THE CONTRACTOR UNTIL THE ACTION IS APPROVED BY AN AGENCY REPRESENTATIVE. THE ACTION WILL BE APPROVED WHEN THE CONTRIBUTING DRAINAGE AREA IS STABLE.

**4. PLACEMENT OF BARRIES**

- FIRST CELL: 20% OF LENGTH FROM ENTRY POINT
- SECOND CELL: 80% OF LENGTH FROM ENTRY POINT
- THIRD CELL: 15% OF LENGTH FROM SECOND CELL

[illegible]

# NTS

NTS

PIPE OUTLET TO FLAT AREA—  
NO WELL-DEFINED CHANNEL


PLAN

SECTION A-A

GRAVEL OR FABRIC

Diagram illustrating a pipe outlet to a flat area with no well-defined channel. The plan view shows a pipe of diameter  $D$  with a flared outlet of length  $L_A$  and radius  $A$ , discharging into a gravel or fabric filter layer. The section view (A-A) shows the pipe diameter  $D$  and the filter layer.

NTS

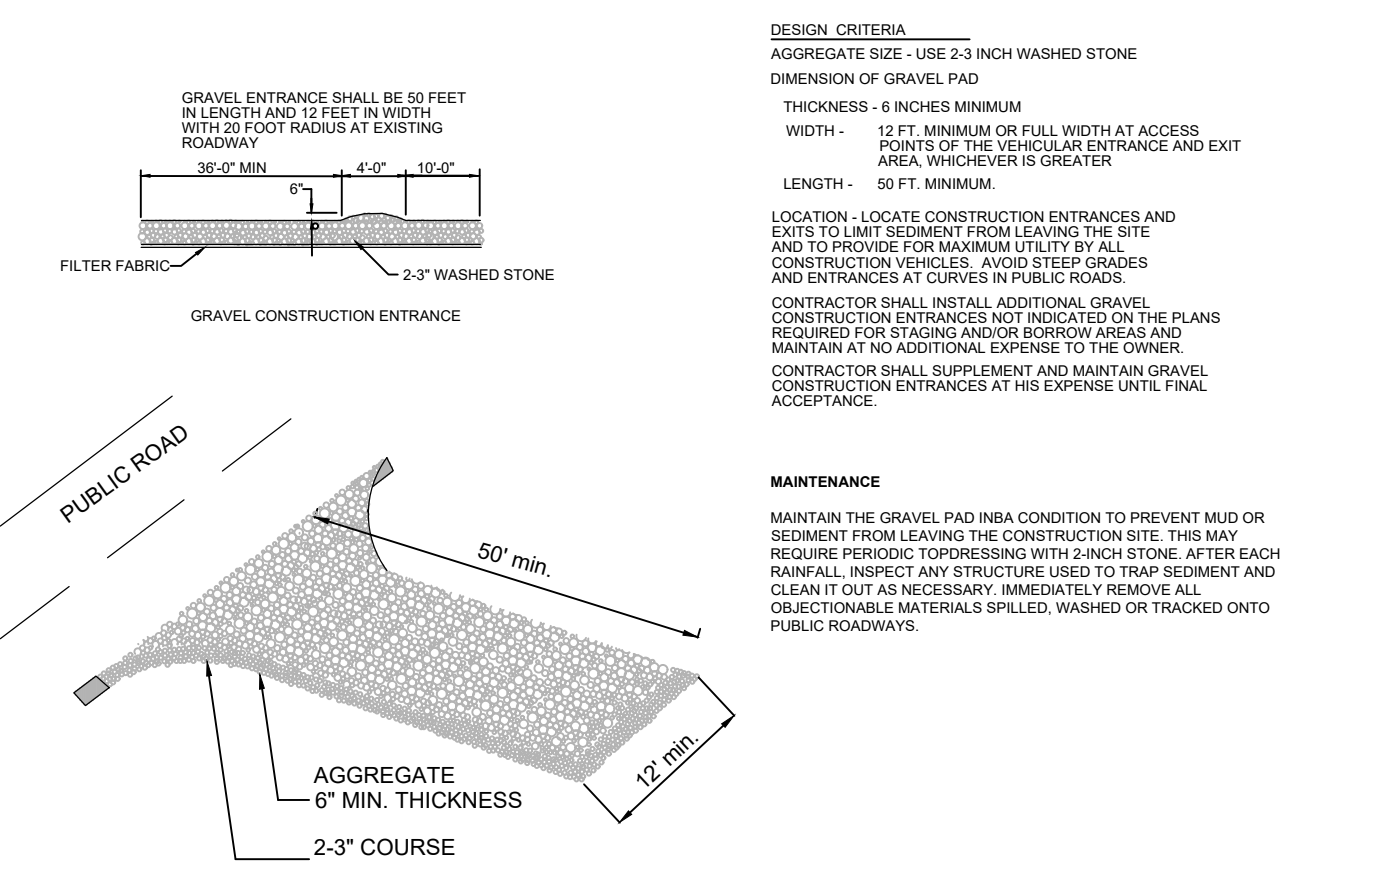


The diagram illustrates a cross-section of a stormwater inlet catchment area. At the top, a rectangular structure is labeled 'STANDARD METAL POSTS 2"-O" IN GRID'. Below this, a '18 GAUGE INWOUND CLOTH (1/4" MESH OPENINGS)' is shown. The main body of the catchment is a trapezoidal area filled with '2-1/2 SLOPE GRAVEL FILTER'. A '5" WHEED STONE PLACED TO A HEIGHT OF 18" MINIMUM ABOVE TOP OF BOX' is indicated at the bottom. The entire structure is surrounded by '18 GAUGE INWOUND CLOTH (1/4" MESH OPENINGS)'. The bottom of the catchment is labeled '2-1/2 SLOPE GRAVEL FILTER'. The diagram is labeled with various construction specifications, including 'UNIFORMITY GRADE A SHALLOW DEPRESSION APPROACHING THE INLET', 'DRIVE 5-FOOT STEEL POSTS 2 FEET INTO THE GROUND SURROUNDING THE INLET, GRACES POSTS EVENLY AROUND THE PERIMETER OF THE INLET, A MAXIMUM OF 4 FEET APART', 'SUBGRADE THE POSTS WITH WIRE MESH INWOUND CLOTH, SECURE THE WIRE MESH TO THE STEEL POSTS AT THE TOP, MIDDLE AND BOTTOM, PLACING A 2' FOOT FLAT OF THE WIRE MESH UNDER THE GRAVEL FOR ANCHORING IS RECOMMENDED', 'PLACE CLEAN GRAVEL (NO.55 OR BETT STONE) ON A 2-1/2 SLOPE WITH A HEIGHT OF 18 INCHES ABOVE THE WIRE AND SANDY TO AN EVEN GRADE', 'ONCE THE CONTRIBUTING DRAINAGE AREA HAS BEEN STABILIZED, REMOVE ACCUMULATED SEDIMENT AND ESTABLISH FINAL DRAINAGE ELEVATIONS', and 'COMPACT THE AREA PROPERLY AND STABILIZE IT WITH GRASS/VEGETATION'.

**MAINTENANCE**

INSPECT THE INLET AT LEAST WEEKLY AND AFTER EACH SIGNIFICANT (10 INCH OR GREATER) RAINFALL EVENT. CLEAR THE MESH WIRE OF ANY DEBRIS OR OTHER OBJECTS TO PROVIDE ADEQUATE FLUSH OR SUBSEQUENT RAINING. THE FIRST STEP TO DRAINAGE MAINTENANCE IS THE WIRE MESH DURING THE SEDIMENT REMOVAL, REPLACE STONE AS NEEDED.

Diagram illustrating a pipe outlet to a flat area with no well-defined channel. The plan view shows a pipe of diameter  $D$  with a flared outlet of length  $A$  discharging into a gravel area. The section view shows the gravel layer of thickness  $L_A$  and depth  $D$ , with a filter layer and fabric underneath. The section is labeled A-A.

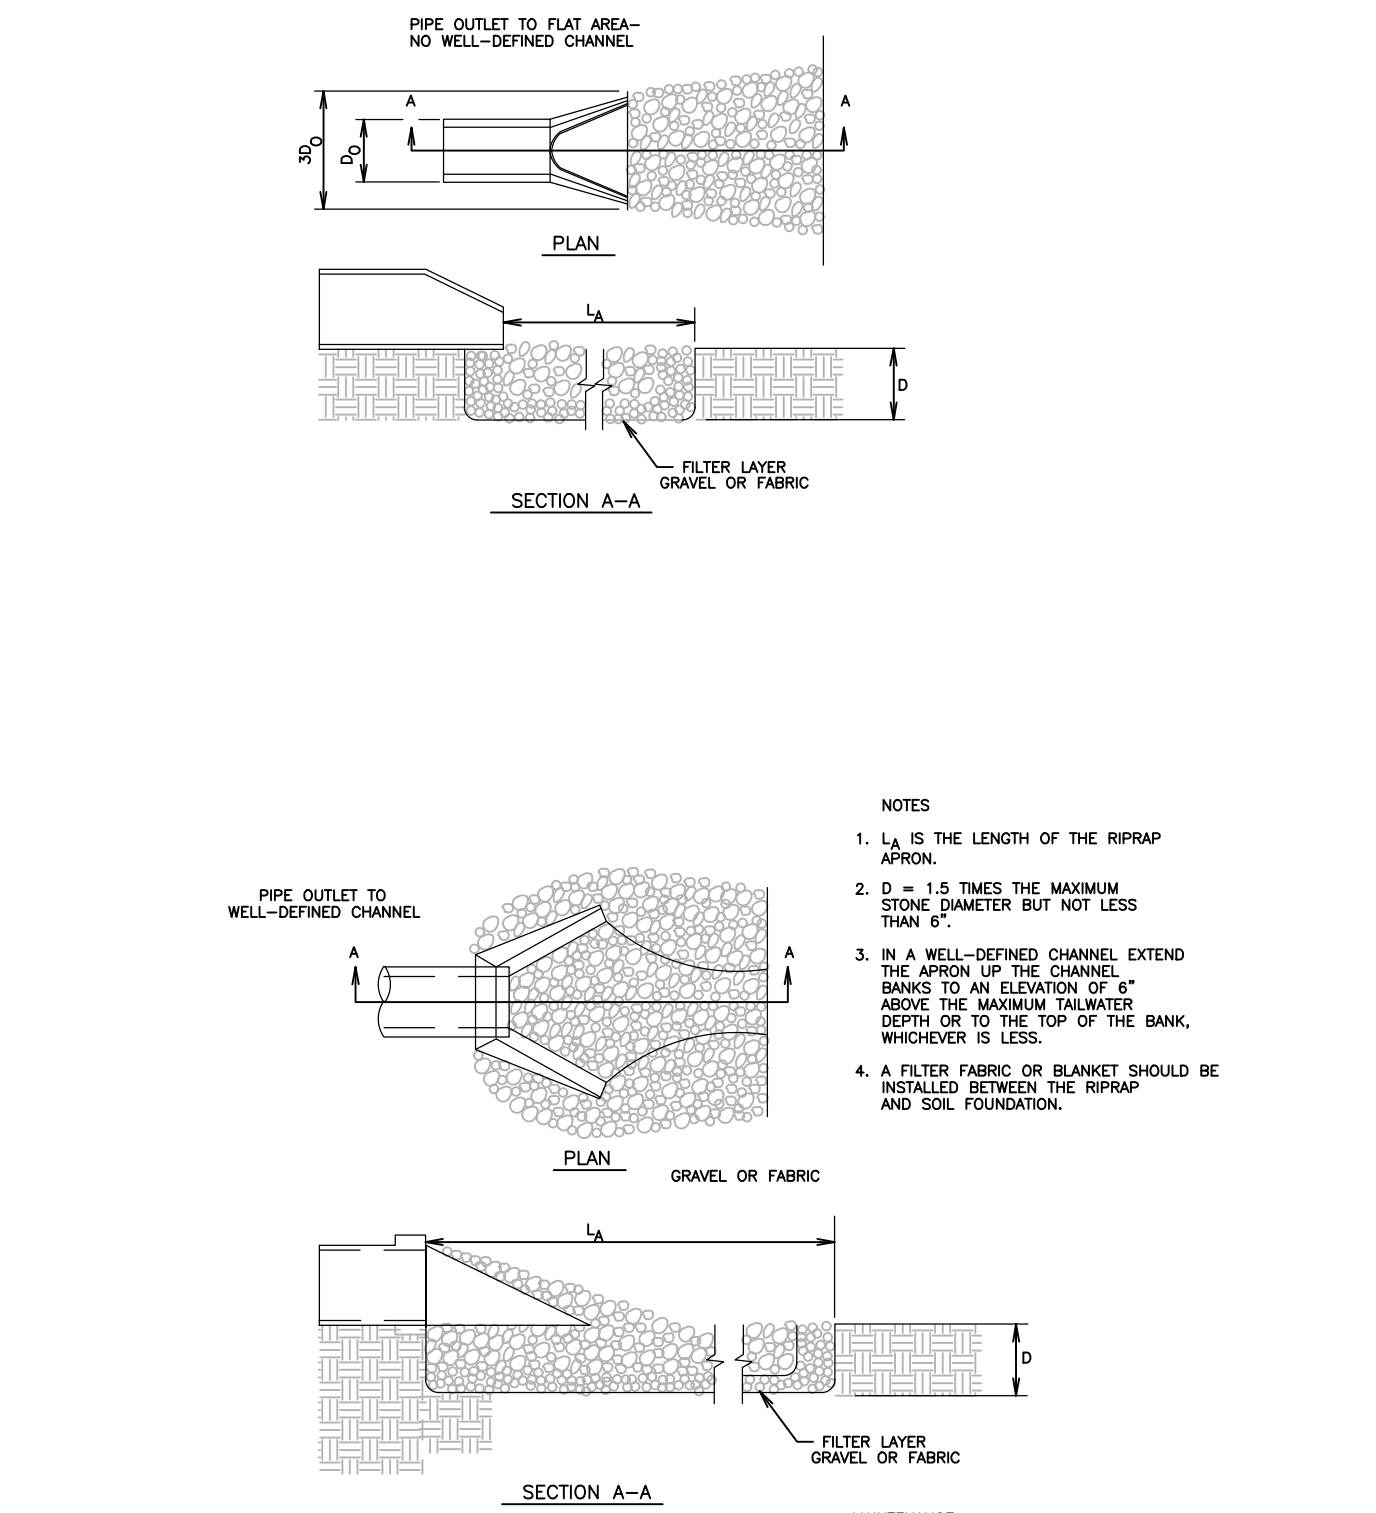

ISSUED FOR CONSTRUCTION

## NTS

## HARPER'S MEADOW

## NTS

## EROSION CONTROL DETAILS

**TRIANGLE LAND  
PARTNERS, LLC**

PO Box 5548  
Cary, North Carolina 27512  
Phone: (704) 608-3085

DESIGNED BY:	CALEB
DRAWN BY:	CALEB
CHECKED BY:	SCOTT
PROJECT NUMBER:	1896

NOT TO SCALE

MARCH 22, 2024

○

# C-6.1







GROUND STABILIZATION AND MATERIALS HANDLING PRACTICES FOR COMPLIANCE WITH THE NCG01 CONSTRUCTION GENERAL PERMIT

Implementing the details and specifications on this plan sheet will result in the construction activity being considered compliant with the Ground Stabilization and Materials Handling sections of the NCG01 Construction General Permit (Sections E and F, respectively). The permittee shall comply with the Erosion and Sediment Control plan approved by the delegated authority having jurisdiction. All details and specifications shown on this sheet may not apply depending on site conditions and the delegated authority having jurisdiction.

SECTION E: GROUND STABILIZATION		
Required Ground Stabilization Timeframes		
Site Area Description	Stabilize within this many calendar days after ceasing land disturbance	Timeframe variations
(a) Perimeter dikes, swales, ditches, and perimeter slopes	7	None
(b) High Quality Water (HQW) Zones	7	None
(c) Slopes steeper than 3:1	7	If slopes are 10' or less in length and are not steeper than 2:1, 14 days are allowed
(d) Slopes 3:1 to 4:1	14	- 7 days for slopes greater than 50' in length and with slopes steeper than 4:1 - 7 days for perimeter dikes, swales, ditches, perimeter slopes and HQW Zones - 10 days for Falls Lake Watershed unless there is zero slope
(e) Areas with slopes flatter than 4:1	14	- 7 days for perimeter dikes, swales, ditches, perimeter slopes and HQW Zones - 10 days for Falls Lake Watershed unless there is zero slope

**Note:** After the permanent cessation of construction activities, any areas with temporary ground stabilization shall be converted to permanent ground stabilization as soon as practicable but in no case longer than 90 calendar days after the last land disturbing activity. Temporary ground stabilization shall be maintained in a manner to render the surface stable against accelerated erosion until permanent ground stabilization is achieved.

GROUND STABILIZATION SPECIFICATION	
Stabilize the ground sufficiently so that rain will not dislodge the soil. Use one of the techniques in the table below:	
Temporary Stabilization	Permanent Stabilization
<ul style="list-style-type: none"><li>• Temporary grass seed covered with straw or other mulches and tackifiers</li><li>• Hydroseeding</li><li>• Rolled erosion control products with or without temporary grass seed</li><li>• Appropriately applied straw or other mulch</li><li>• Plastic sheeting</li></ul>	<ul style="list-style-type: none"><li>• Permanent grass seed covered with straw or other mulches and tackifiers</li><li>• Geotextile fabrics such as permanent soil reinforcement matting</li><li>• Hydroseeding</li><li>• Shrubs or other permanent plantings covered with mulch</li><li>• Uniform and evenly distributed ground cover sufficient to restrain erosion</li><li>• Structural methods such as concrete, asphalt or retaining walls</li><li>• Rolled erosion control products with grass seed</li></ul>
POLYACRYLAMIDES (PAMS) AND FLOCCULANTS	
<ol style="list-style-type: none"><li>1. Select flocculants that are appropriate for the soils being exposed during construction, selecting from the <i>NC DWR List of Approved PAMS/Flocculants</i>.</li><li>2. Apply flocculants at or before the inlets to Erosion and Sediment Control Measures.</li><li>3. Apply flocculants at the concentrations specified in the <i>NC DWR List of Approved PAMS/Flocculants</i> and in accordance with the manufacturer's instructions.</li><li>4. Provide ponding area for containment of treated Stormwater before discharging offsite.</li><li>5. Store flocculants in leak-proof containers that are kept under storm-resistant cover or surrounded by secondary containment structures.</li></ol>	


- EQUIPMENT AND VEHICLE MAINTENANCE**
1. Maintain vehicles and equipment to prevent discharge of fluids.
  2. Provide drip pans under any stored equipment.
  3. Identify leaks and repair as soon as feasible, or remove leaking equipment from the project.
  4. Collect all spent fluids, store in separate containers and properly dispose as hazardous waste (recycle when possible).
  5. Remove leaking vehicles and construction equipment from service until the problem has been corrected.
  6. Bring used fuels, lubricants, coolants, hydraulic fluids and other petroleum products to a recycling or disposal center that handles these materials.

- LITTER, BUILDING MATERIAL AND LAND CLEARING WASTE**
1. Never bury or burn waste. Place litter and debris in approved waste containers.
  2. Provide a sufficient number and size of waste containers (e.g. dumpster, trash receptacle) on site to contain construction and domestic wastes.
  3. Locate waste containers at least 50 feet away from storm drain inlets and surface waters unless no other alternatives are reasonably available.
  4. Locate waste containers on areas that do not receive substantial amounts of runoff from upland areas and does not drain directly to a storm drain, stream or wetland.
  5. Cover waste containers at the end of each workday and before storm events or provide secondary containment. Repair or replace damaged waste containers.
  6. Anchor all lightweight items in waste containers during times of high winds.
  7. Empty waste containers as needed to prevent overflow. Clean up immediately if containers overflow.
  8. Dispose waste off-site at an approved disposal facility.
  9. On business days, clean up and dispose of waste in designated waste containers.

- PAINT AND OTHER LIQUID WASTE**
1. Do not dump paint and other liquid waste into storm drains, streams or wetlands.
  2. Locate paint washouts at least 50 feet away from storm drain inlets and surface waters unless no other alternatives are reasonably available.
  3. Contain liquid wastes in a controlled area.
  4. Containment must be labeled, sized and placed appropriately for the needs of site.
  5. Prevent the discharge of soaps, solvents, detergents and other liquid wastes from construction sites.

- PORTABLE TOILETS**
1. Install portable toilets on level ground, at least 50 feet away from storm drains, streams or wetlands unless there is no alternative reasonably available. If 50 foot offset is not attainable, provide relocation of portable toilet behind silt fence or place on a gravel pad and surround with sand bags.
  2. Provide staking or anchoring of portable toilets during periods of high winds or in high foot traffic areas.
  3. Monitor portable toilets for leaking and properly dispose of any leaked material. Utilize a licensed sanitary waste hauler to remove leaking portable toilets and replace with properly operating unit.

- EARTHEN STOCKPILE MANAGEMENT**
1. Show stockpile locations on plans. Locate earthen-material stockpile areas at least 50 feet away from storm drain inlets, sediment basins, perimeter sediment controls and surface waters unless it can be shown no other alternatives are reasonably available.
  2. Protect stockpile with silt fence installed along toe of slope with a minimum offset of five feet from the toe of stockpile.
  3. Provide stable stone access point when feasible.
  4. Stabilize stockpile within the timeframes provided on this sheet and in accordance with the approved plans and any additional requirements. Soil stabilization is defined as vegetative, physical or chemical coverage techniques that will restrain accelerated erosion on disturbed soils for temporary or permanent control needs.

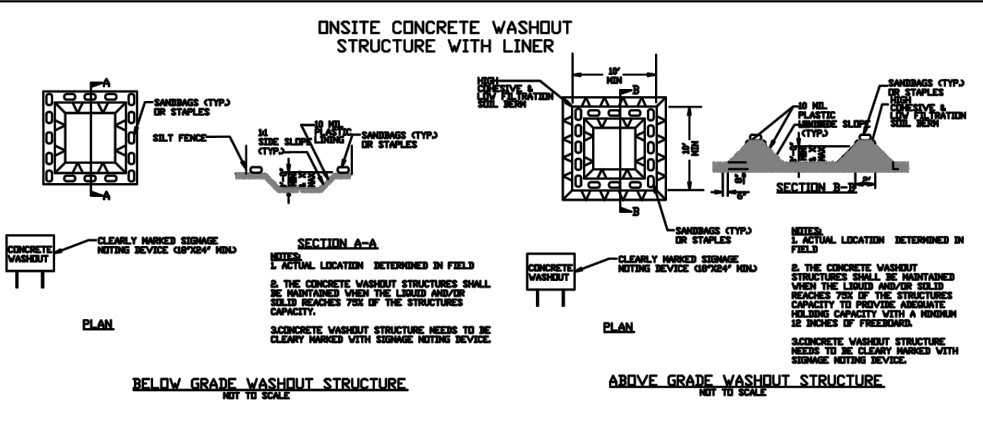

- CONCRETE WASHOUTS**
1. Do not discharge concrete or cement slurry from the site.
  2. Dispose of, or recycle settled, hardened concrete residue in accordance with local and state solid waste regulations and at an approved facility.
  3. Manage washout from mortar mixers in accordance with the above item and in addition place the mixer and associated materials on impervious barrier and within lot perimeter silt fence.
  4. Install temporary concrete washouts per local requirements, where applicable. If an alternate method or product is to be used, contact your approval authority for review and approval. If local standard details are not available, use one of the two types of temporary concrete washouts provided on this detail.
  5. Do not use concrete washouts for dewatering or storing defective curb or sidewalk sections. Stormwater accumulated within the washout may not be pumped into or discharged to the storm drain system or receiving surface waters. Liquid waste must be pumped out and removed from project.
  6. Locate washouts at least 50 feet from storm drain inlets and surface waters unless it can be shown that no other alternatives are reasonably available. At a minimum, install protection of storm drain inlet(s) closest to the washout which could receive spills or overflow.
  7. Locate washouts in an easily accessible area, on level ground and install a stone entrance pad in front of the washout. Additional controls may be required by the approving authority.
  8. Install at least one sign directing concrete trucks to the washout within the project limits. Post signage on the washout itself to identify this location.
  9. Remove leavings from the washout when at approximately 75% capacity to limit overflow events. Replace the tarp, sand bags or other temporary structural components when no longer functional. When utilizing alternative or proprietary products, follow manufacturer's instructions.
  10. At the completion of the concrete work, remove remaining leavings and dispose of in an approved disposal facility. Fill pit, if applicable, and stabilize any disturbance caused by removal of washout.

- HERBICIDES, PESTICIDES AND RODENTICIDES**
1. Store and apply herbicides, pesticides and rodenticides in accordance with label restrictions.
  2. Store herbicides, pesticides and rodenticides in their original containers with the label, which lists directions for use, ingredients and first aid steps in case of accidental poisoning.
  3. Do not store herbicides, pesticides and rodenticides in areas where flooding is possible or where they may spill or leak into wells, stormwater drains, ground water or surface water. If a spill occurs, clean area immediately.
  4. Do not stockpile these materials on-site.

- HAZARDOUS AND TOXIC WASTE**
1. Create designated hazardous waste collection areas on-site.
  2. Place hazardous waste containers under secondary containment.
  3. Do not store hazardous chemicals, drums or bagged materials directly on the ground.

Outdoor Lighting

**Mitchell LED Series**

Mitchell LED  
Mitchell Top Hat LED  
Mitchell LED with ribs, bands and medallions  
Mitchell Open LED  
Mitchell Top Hat LED with ribs, bands and medallions

The energy-efficient fixtures in the Mitchell LED Series enhance the character and prestige of streetscapes and parking lots, as well as pedestrian areas and greenways. These fixtures provide safety and security in commercial settings and complement any neighborhood with their classic, elegant design.

LED (Light Emitting Diode)	50 watts, 75 watts (Mitchell Open)
Mounting heights	12', 13', 16'
Color	Black
Poles	Fiberglass Smooth round concrete Style V Style VI Style VII

For additional information, visit us at [duke-energy.com/OutdoorLighting](http://duke-energy.com/OutdoorLighting) or call us toll free at 866.769.6417.

©2015 Duke Energy Corporation 150282 2/15

## NCG01 GROUND STABILIZATION AND MATERIALS HANDLING

EFFECTIVE: 04/01/19

PART III SELF-INSPECTION, RECORDKEEPING AND REPORTING		
SECTION A: SELF-INSPECTION		
Self-inspections are required during normal business hours in accordance with the table below. When adverse weather or site conditions would cause the safety of the inspection personnel to be in jeopardy, the inspection may be delayed until the next business day on which it is safe to perform the inspection. In addition, when a storm event of equal to or greater than 1.0 inch occurs outside of normal business hours, the self-inspection shall be performed upon the commencement of the next business day. Any time when inspections were delayed shall be noted in the Inspection Record.		
Inspect	Frequency (during normal business hours)	Inspection records must include:
(1) Rain gauge maintained in good working order	Daily	Daily rainfall amounts. If no daily rain gauge observations are made during weekend or holiday periods, and no individual-day rainfall information is available, record the cumulative rain measurement for those unattended days (and this will determine if a site inspection is needed). Days on which no rainfall occurred shall be recorded as "zero." The permittee may use another rain-monitoring device approved by the Division.
(2) E&SC Measures	At least once per 7 calendar days and within 24 hours of a rain event ≥ 1.0 inch in 24 hour	1. Identification of the measures inspected, 2. Date and time of the inspection, 3. Name of the person performing the inspection, 4. Indication of whether the measures were operating properly, 5. Description of maintenance needs for the measure, 6. Description, evidence, and date of corrective actions taken.
(3) Stormwater discharge outfalls (SDOs)	At least once per 7 calendar days and within 24 hours of a rain event ≥ 1.0 inch in 24 hours	1. Identification of the discharge outfalls inspected, 2. Date and time of the inspection, 3. Name of the person performing the inspection, 4. Evidence of indicators of stormwater pollution such as oil sheen, floating or suspended solids or discoloration, 5. Indication of visible sediment leaving the site, 6. Description, evidence, and date of corrective actions taken.
(4) Perimeter of site	At least once per 7 calendar days and within 24 hours of a rain event ≥ 1.0 inch in 24 hours	If visible sedimentation is found outside site limits, then a record of the following shall be made: 1. Actions taken to clean up or stabilize the sediment that has left the site limits, 2. Description, evidence, and date of corrective actions taken, and 3. An explanation as to the actions taken to control future releases.
(5) Streams or wetlands onsite or offsite (where accessible)	At least once per 7 calendar days and within 24 hours of a rain event ≥ 1.0 inch in 24 hours	If the stream or wetland has increased visible sedimentation or a stream has visible increased turbidity from the construction activity, then a record of the following shall be made: 1. Description, evidence and date of corrective actions taken, 2. Records of the required reports to the appropriate Division Regional Office per Part III, Section C, Item (2)(a) of this permit of this permit.
(6) Ground stabilization measures	After each phase of grading	1. The phase of grading (installation of perimeter E&SC measures, clearing and grubbing, installation of storm drainage facilities, completion of all land disturbing activity, construction or redevelopment, permanent ground cover). 2. Documentation that the required ground stabilization measures have been provided within the required timeframe or an assurance that they will be provided as soon as possible.

**NOTE:** The rain inspection resets the required 7 calendar day inspection requirement.



## NCG01 SELF-INSPECTION, RECORDKEEPING AND REPORTING

EFFECTIVE: 04/01/19

PART III SELF-INSPECTION, RECORDKEEPING AND REPORTING	
SECTION B: RECORDKEEPING	
<b>1. E&amp;SC Plan Documentation</b> The approved E&SC plan as well as any approved deviation shall be kept on the site. The approved E&SC plan must be kept up-to-date throughout the coverage under this permit. The following items pertaining to the E&SC plan shall be documented in the manner described:	
Item to Document	Documentation Requirements
(a) Each E&SC Measure has been installed and does not significantly deviate from the locations, dimensions and relative elevations shown on the approved E&SC Plan.	Initial and date each E&SC Measure on a copy of the approved E&SC Plan or complete, date and sign an inspection report that lists each E&SC Measure shown on the approved E&SC Plan. This documentation is required upon the initial installation of the E&SC Measures or if the E&SC Measures are modified after initial installation.
(b) A phase of grading has been completed.	Initial and date a copy of the approved E&SC Plan or complete, date and sign an inspection report to indicate completion of the construction phase.
(c) Ground cover is located and installed in accordance with the approved E&SC Plan.	Initial and date a copy of the approved E&SC Plan or complete, date and sign an inspection report to indicate compliance with approved ground cover specifications.
(d) The maintenance and repair requirements for all E&SC Measures have been performed.	Complete, date and sign an inspection report.
(e) Corrective actions have been taken to E&SC Measures.	Initial and date a copy of the approved E&SC Plan or complete, date and sign an inspection report to indicate the completion of the corrective action.

**2. Additional Documentation**  
In addition to the E&SC Plan documents above, the following items shall be kept on the site and available for agency inspectors at all times during normal business hours, unless the Division provides a site-specific exemption based on unique site conditions that make this requirement not practical:

- (a) This general permit as well as the certificate of coverage, after it is received.
- (b) Records of inspections made during the previous 30 days. The permittee shall record the required observations on the Inspection Record Form provided by the Division or a similar inspection form that includes all the required elements. Use of electronically-available records in lieu of the required paper copies will be allowed if shown to provide equal access and utility as the hard-copy records.
- (c) All data used to complete the Notice of Intent and other inspection records shall be maintained for a period of three years after project completion and made available upon request. [40 CFR 122.41]

PART III SELF-INSPECTION, RECORDKEEPING AND REPORTING	
SECTION C: REPORTING	
<b>1. Occurrences that must be reported</b> Permittees shall report the following occurrences: (a) Visible sediment deposition in a stream or wetland. (b) Oil spills if: <ul style="list-style-type: none"><li>• They are 25 gallons or more,</li><li>• They are less than 25 gallons but cannot be cleaned up within 24 hours,</li><li>• They cause sheen on surface waters (regardless of volume), or</li><li>• They are within 100 feet of surface waters (regardless of volume).</li></ul> (a) Releases of hazardous substances in excess of reportable quantities under Section 311 of the Clean Water Act (Ref: 40 CFR 110.3 and 40 CFR 117.3) or Section 102 of CERCLA (Ref: 40 CFR 302.4) or G.S. 143-215.85. (b) Anticipated bypasses and unanticipated bypasses. (c) Noncompliance with the conditions of this permit that may endanger health or the environment.	
<b>2. Reporting Timeframes and Other Requirements</b> After a permittee becomes aware of an occurrence that must be reported, he shall contact the appropriate Division regional office within the timeframes and in accordance with the other requirements listed below. Occurrences outside normal business hours may also be reported to the Division's Emergency Response personnel at (800) 662-7956, (800) 858-0368 or (919) 733-3300.	
Occurrence	Reporting Timeframes (After Discovery) and Other Requirements
(a) Visible sediment deposition in a stream or wetland	<ul style="list-style-type: none"><li>• <b>Within 24 hours</b>, an oral or electronic notification.</li><li>• <b>Within 7 calendar days</b>, a report that contains a description of the sediment and actions taken to address the cause of the deposition. Division staff may waive the requirement for a written report on a case-by-case basis.</li><li>• If the stream is named on the <a href="#">NC 303(d) list</a> as impaired for sediment-related causes, the permittee may be required to perform additional monitoring, inspections or apply more stringent practices if staff determine that additional requirements are needed to assure compliance with the federal or state impaired waters conditions.</li><li>• <b>Within 24 hours</b>, an oral or electronic notification. The notification shall include information about the date, time, nature, volume and location of the spill or release.</li></ul>
(b) Oil spills and release of hazardous substances per Item 1(b)(1) above	<ul style="list-style-type: none"><li>• <b>A report at least ten days before the date of the bypass, if possible.</b> The report shall include an evaluation of the anticipated quality and effect of the bypass.</li><li>• <b>Within 24 hours</b>, an oral or electronic notification.</li><li>• <b>Within 7 calendar days</b>, a report that includes an evaluation of the quality and effect of the bypass.</li><li>• <b>Within 24 hours</b>, an oral or electronic notification.</li><li>• <b>Within 7 calendar days</b>, a report that contains a description of the noncompliance, and its causes; the period of noncompliance, including exact dates and times, and if the noncompliance has not been corrected, the anticipated time noncompliance is expected to continue; and steps taken or planned to reduce, eliminate, and prevent reoccurrence of the noncompliance. [40 CFR 122.41(i)(6)].</li><li>• Division staff may waive the requirement for a written report on a case-by-case basis.</li></ul>
(c) Anticipated bypasses [40 CFR 122.41(m)(3)]	
(d) Unanticipated bypasses [40 CFR 122.41(m)(3)]	
(e) Noncompliance with the conditions of this permit that may endanger health or the environment [40 CFR 122.41(i)(7)]	

Outdoor Lighting

**Mitchell LED Series**

Light source: LED (white)  
Lumens: 4,332 – 5,678 (fixture dependent)  
Color temperature: 4,000K

	Wattage	Light Pattern	IESNA Backlight – Uplight – Glare (BUG) Rating
Mitchell LED	50	IESNA Type V	B3-U4-G3
Mitchell Top Hat LED	50	IESNA Type V	B3-U3-G3
Mitchell Open LED	75	IESNA Type III	B1-U0-G1
Mitchell LED with Ribs, Bands and Medallions	50	IESNA Type V	B3-U4-G3
Mitchell Top Hat LED with Ribs, Bands and Medallions	50	IESNA Type V	B3-G3-U3

Poles available:

Name	Mounting height	Color
Smooth concrete	12', 16'	Black
Fiberglass	16'	Black
Style V	12', 16'	Black
Style VI	12'	Black
Style VII	13'	Black

©2015 Duke Energy Corporation 151307 7/15



### REVISIONS

ISSUED FOR CONSTRUCTION

### PROJECT NAME

**HARPER'S MEADOW**

### SITE & EROSION CONTROL DETAILS

### CLIENT

**TRIANGLE LAND PARTNERS, LLC**

PO Box 5548  
Cary, North Carolina 27512  
Phone: (704) 608-3085

### PROJECT INFORMATION

DESIGNED BY:	CALEB
DRAWN BY:	CALEB
CHECKED BY:	SCOTT
PROJECT NUMBER:	1896

### DRAWING SCALE

NOT TO SCALE

### DATE RELEASED

MARCH 22, 2024

### SHEET NUMBER

**C-6.3**








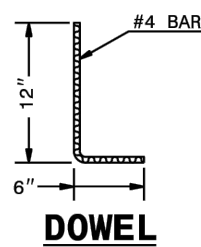


Diagram of Section Y-Y of the base plate. The diagram shows a cross-section of the base plate with a central circular opening. Dimensions include a diameter of 9" for the opening, a width of 8" for the opening, a height of 1 1/8" for the top flange, and a height of 3" for the base plate. A dimension 'H' indicates the total height of the base plate. A 'DOWEL' is shown at the bottom right. A note 'SEE NOTE' points to the base plate. The label 'EXP.' is at the top right.

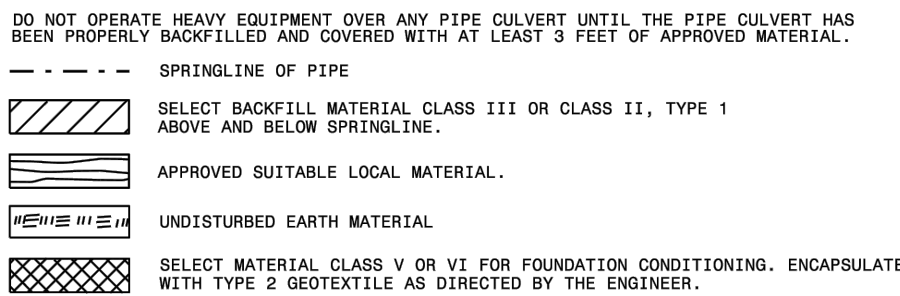

Diameter (inches)	Minimum cover (inches)	Maximum Height of Cover (feet)					
		(Ga)	18	14	12	10	8
12	12	123	155	218	281	344	
15	12	98	123	174	224	275	
18	12	81	102	144	187	228	
21	12	69	87	123	160	195	
24	12	60	76	108	139	171	
27	12		67	95	123	151	
30	12		60	85	111	138	
36	12		50	71	92	113	
42	12			60	78	96	
48	12			52	68	84	
54	12			46	50	74	
60	12				50	62	
66	12					51	
72	12						41

\* FILL HEIGHT IS MEASURED FROM THE TOP OF THE PIPE TO THE BOTTOM OF THE PAVEMENT STRUCTURE


NOTES: FILL HEIGHTS SHOWN WERE CALCULATED USING  
AASHTO LRFD BRIDGE DESIGN SPECIFICATIONS

1' MINIMUM COVER FOR ALL SIDE DRAIN PIPE  
IN ACCORDANCE WITH THE STANDARD SPECIFICATIONS


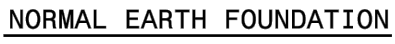
SHEET 3 OF 3  
300.01




ALTERNATE



TYPE #2




TAKE CARE TO FULLY COMPACT HAUNCH ZONE OF PIPE BACKFILL.





LOOSELY PLACED SELECT MATERIAL CLASS III OR CLASS II, TYPE 1 FOR PIPE BEDDING. LEAVE SECTION DIRECTLY BENEATH PIPE UNCOMPACTED AS PIPE SEATING AND BACKFILL WILL ACCOMPLISH COMPACTION.


DO NOT OPERATE HEAVY EQUIPMENT OVER ANY PIPE CULVERT UNTIL THE PIPE CULVERT HAS BEEN PROPERLY BACKFILLED AND COVERED WITH AT LEAST 3 FEET OF APPROVED MATERIAL.





----- SPRINGLINE OF PIPE

 SELECT BACKFILL MATERIAL CLASS III OR CLASS II,  
BELOW SPRINGLINE.

 APPROVED SUITABLE LOCAL MATERIAL ABOVE SPRINGLINE.

 UNDISTURBED EARTH MATERIAL

 SELECT MATERIAL CLASS V OR VI FOR FOUNDATION CONDITIONING. ENCASE  
WITH TYPE 2 GEOTEXTILE AS DIRECTED BY THE ENGINEER.

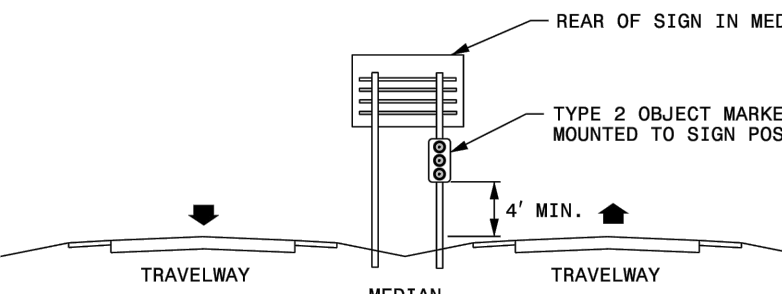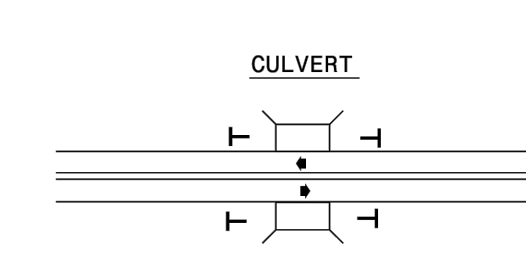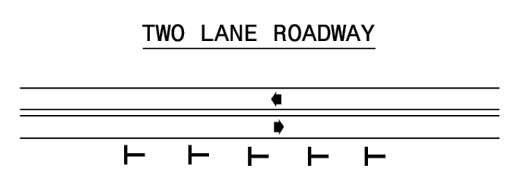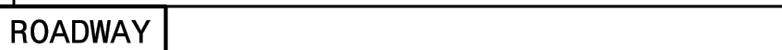


TYPICAL APPLICATIONS OF TYPE 2 OR TYPE 3 OBJECT MARKERS INCLUDES DELINEATION OF BRIDGE PIERS ABUTMENTS, HANDRAILS, CULVERT HEADWALLS, NARROW SHOULDERS, DROP-OFFS, OR OTHER UNDESIRABLE CONDITIONS WHEN GUARDRAIL OR OTHER ROADSIDE PROTECTION IS NOT IN PLACE.

LEGEND


└ OBJECT MARKER

➔ DIRECTION OF TRAFFIC FLOW


SHEET 1 OF 1  
1264.02

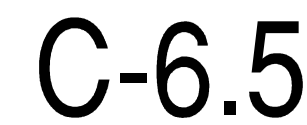




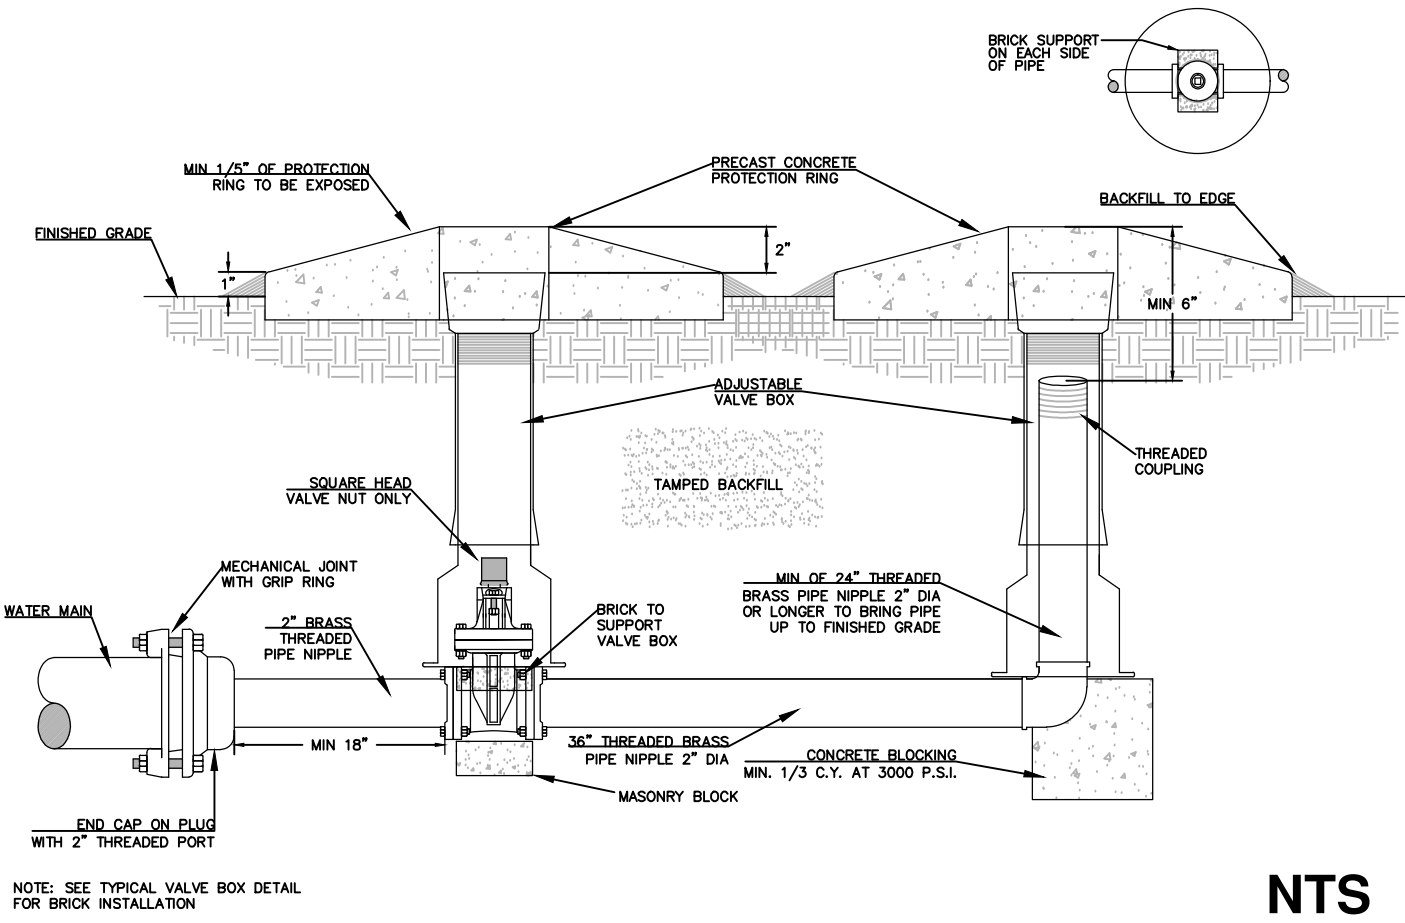

1 PERMANENT BLOW-OFF ASSEMBLY

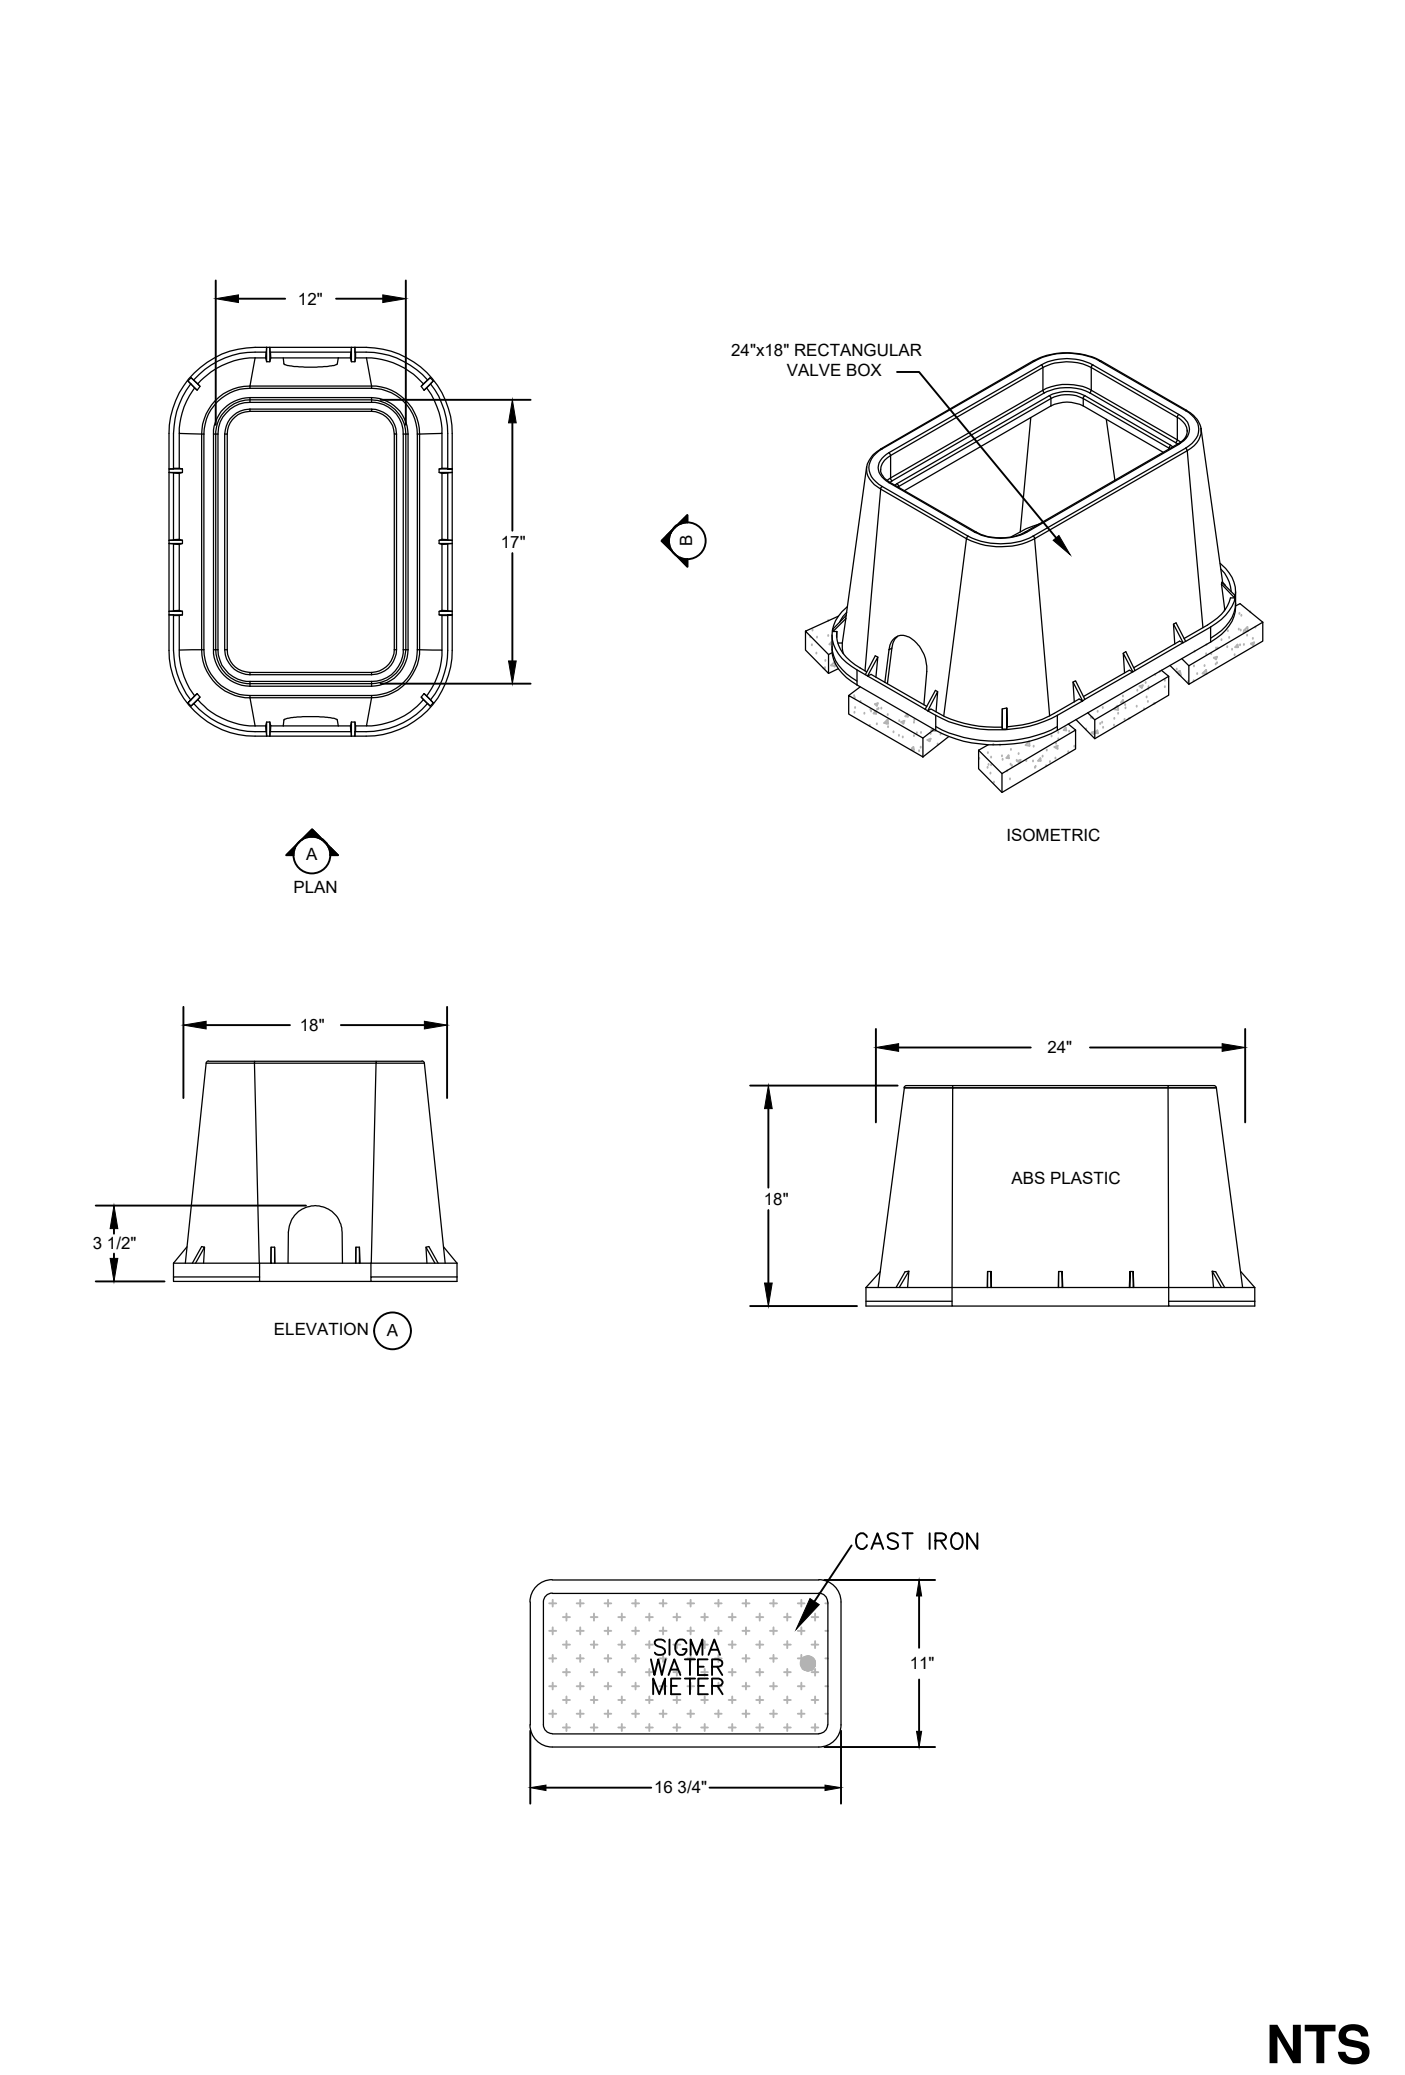


7 METER BOX DETAIL FOR 3/4" SERVICE

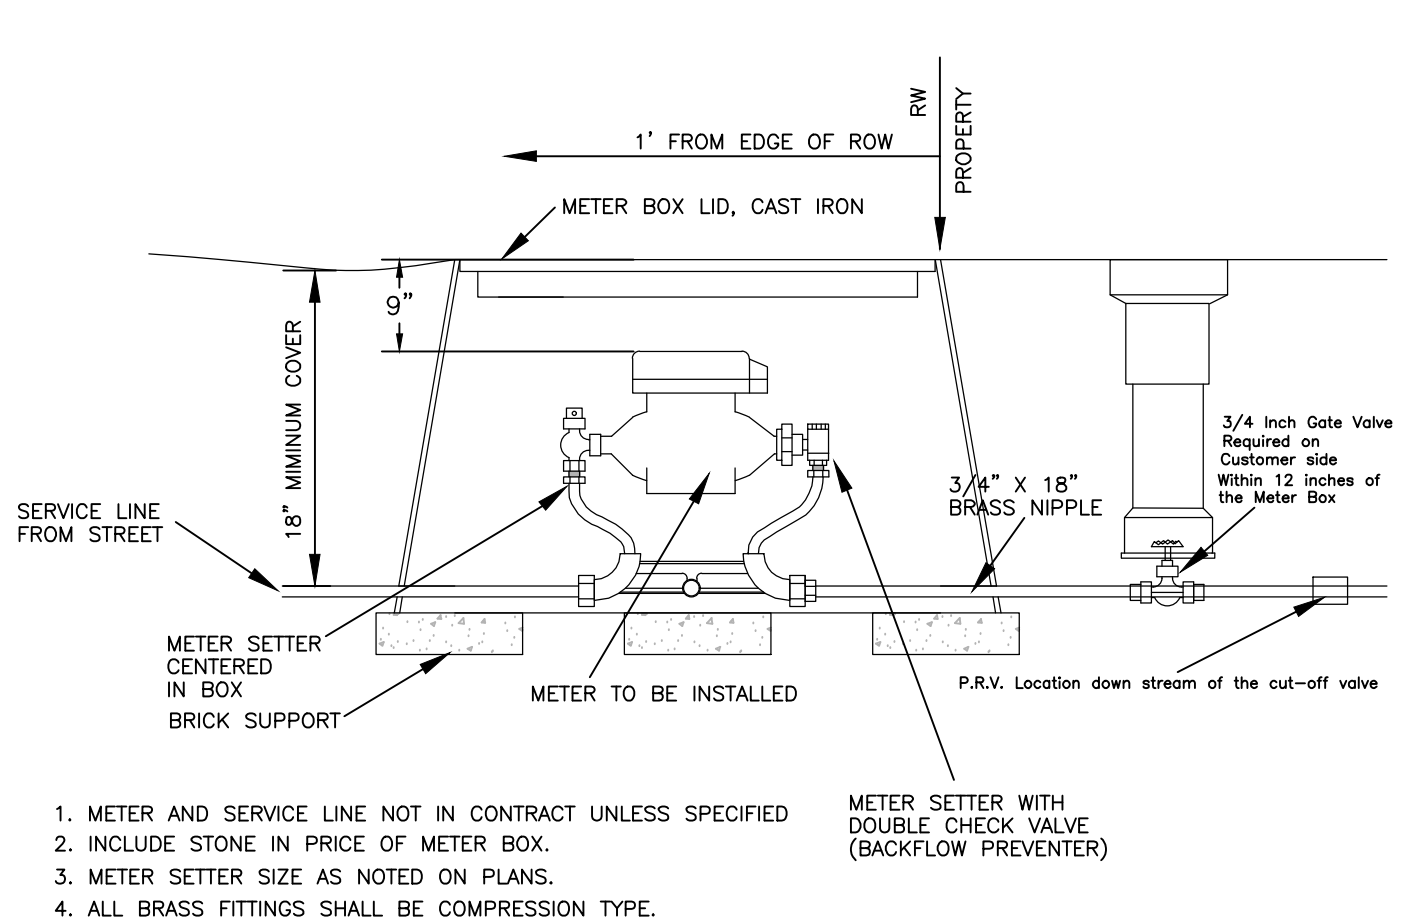


9 TYPICAL 3/4" METER BOX INSTALLATION

LAYING CONDITIONS	DESCRIPTION	PROJECT USE
	FLAT BOTTOM UNDISTURBED EARTH TRENCH, LOOSE BACKFILL	NOT USED.
	FLAT BOTTOMED UNDISTURBED EARTH TRENCH, BACKFILL LIGHTLY CONSOLIDATED TO CENTERLINE OF PIPE.	NOT USED.
	PIPE BEDDED IN 4" MINIMUM JOB EXCAVATED MATERIAL, BACKFILL LIGHTLY CONSOLIDATED TO TOP OF PIPE.	ALL DUCTILE IRON GRAVITY SEWER LINE.
	PIPE BEDDED IN SAND, GRANULAR MATERIAL OR GRADED GRAVEL TO THE DEPTH OF 1/8 PIPE DIAMETER, 4" MIN. JOB EXCAVATED MATERIAL COMPACTED TO 4" ABOVE TOP OF PIPE. (APPROX. 95% STANDARD PROCTOR, AASHTO T-99)	ALL PVC WATER LINE AND PVC FORCE MAIN.
	PIPE BEDDED TO ITS CENTERLINE IN COMPACTED GRANULAR MATERIAL 4" MIN. UNDER PIPE. COMPACTED GRANULAR OR SAND MATERIAL TO 4" ABOVE TOP OF PIPE. (APPROX. 95% STANDARD PROCTOR, AASHTO T-99)	ALL PVC GRAVITY SEWER LINE.


4 TYPICAL LAYING CONDITIONS

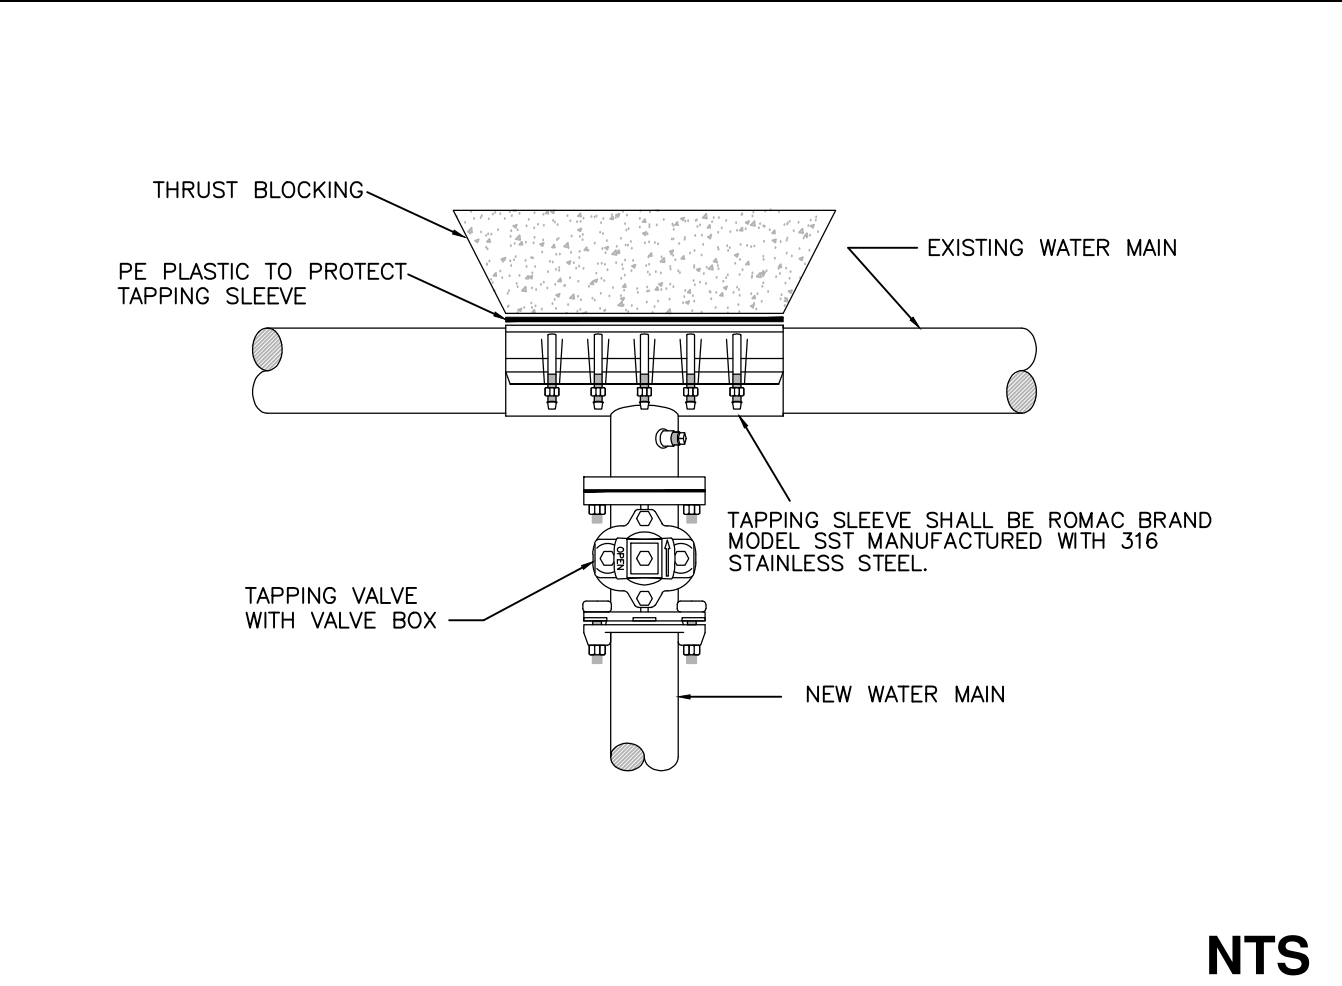


8 TYP. TAPPING SLEEVE & VALVE ASSEMBLY

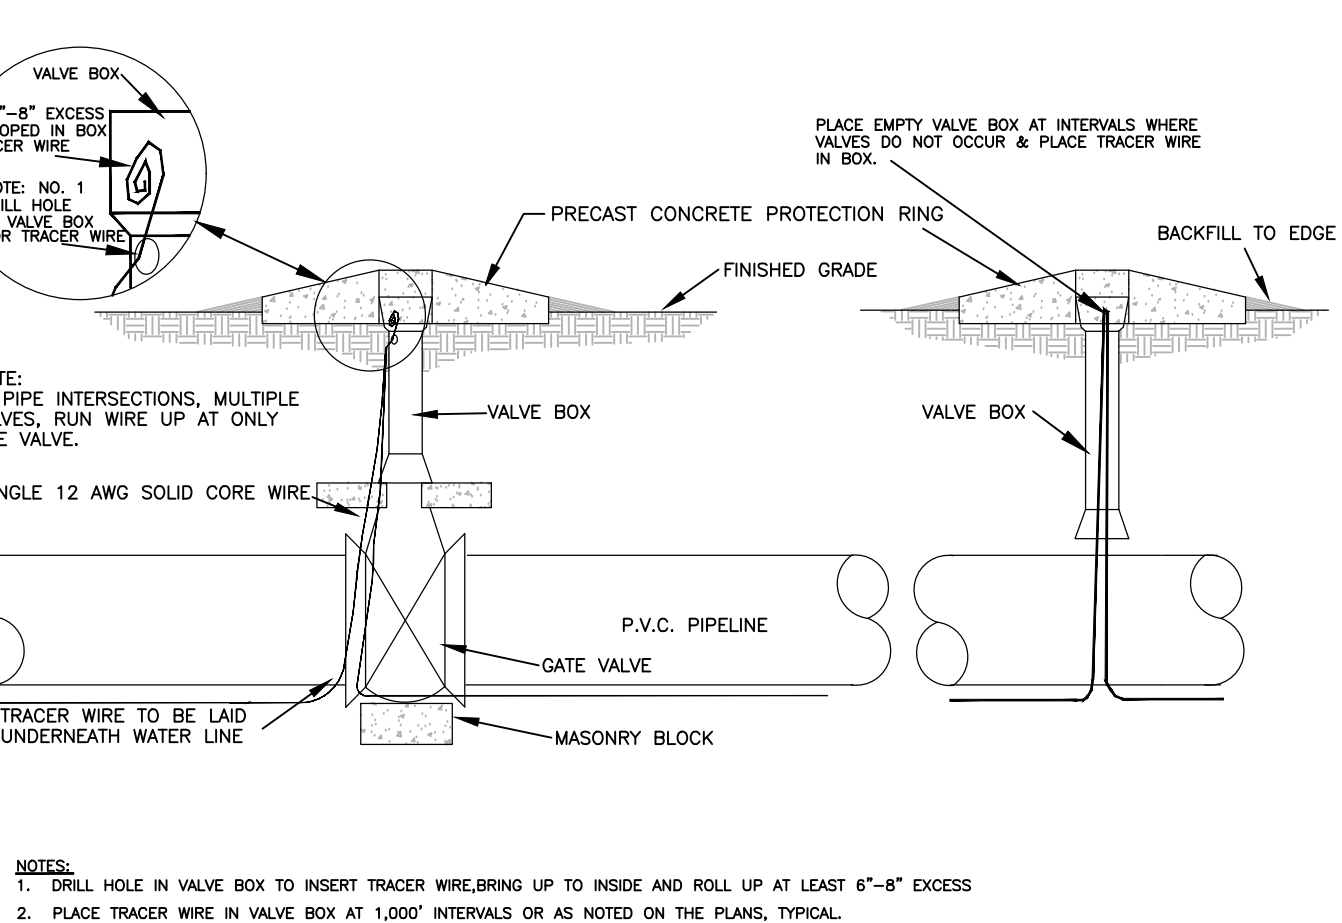


10 TYPICAL TRACER WIRE INSTALLATION

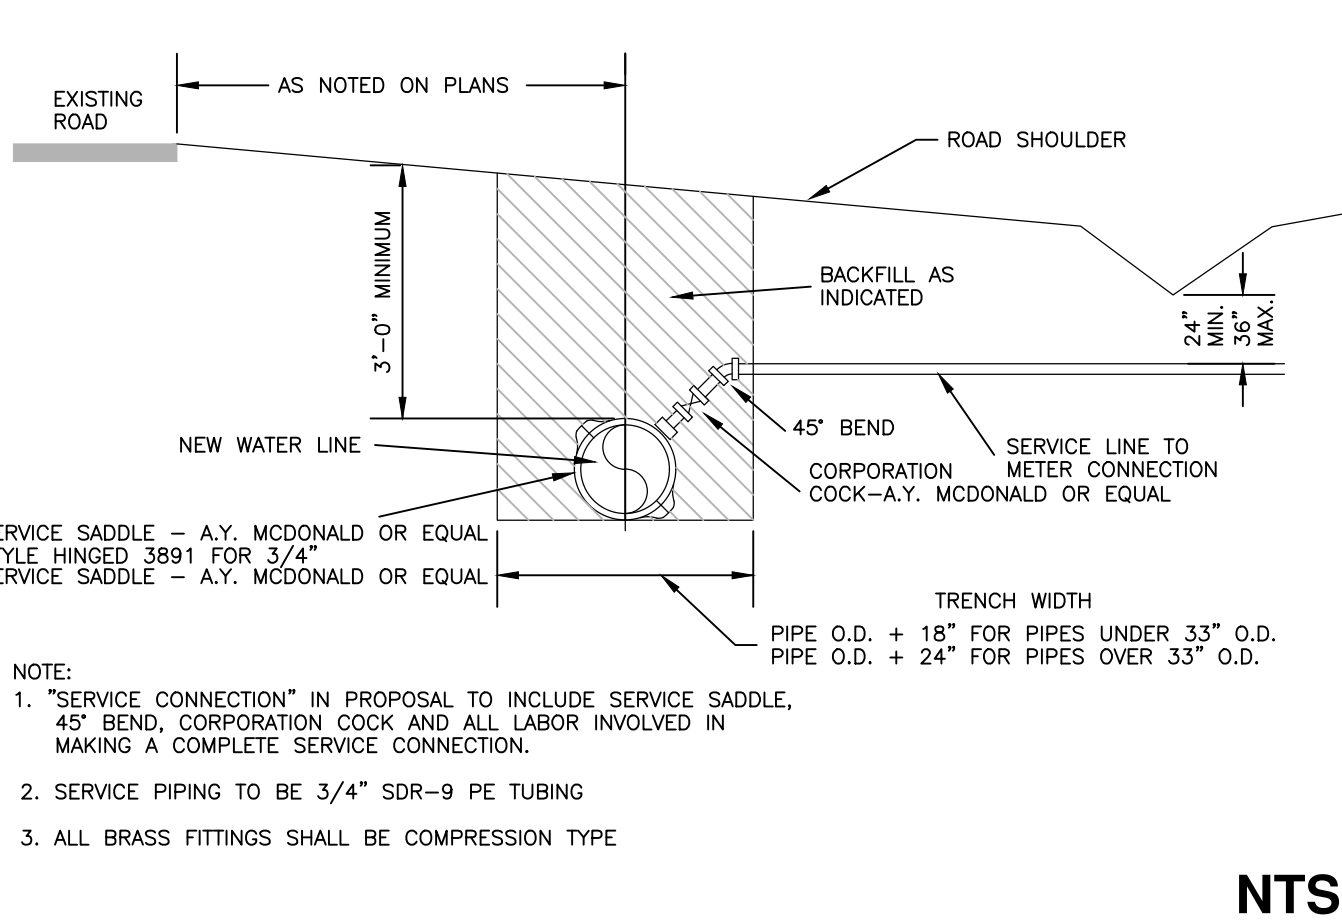


2 TYPICAL WATER SERVICE CONNECTION

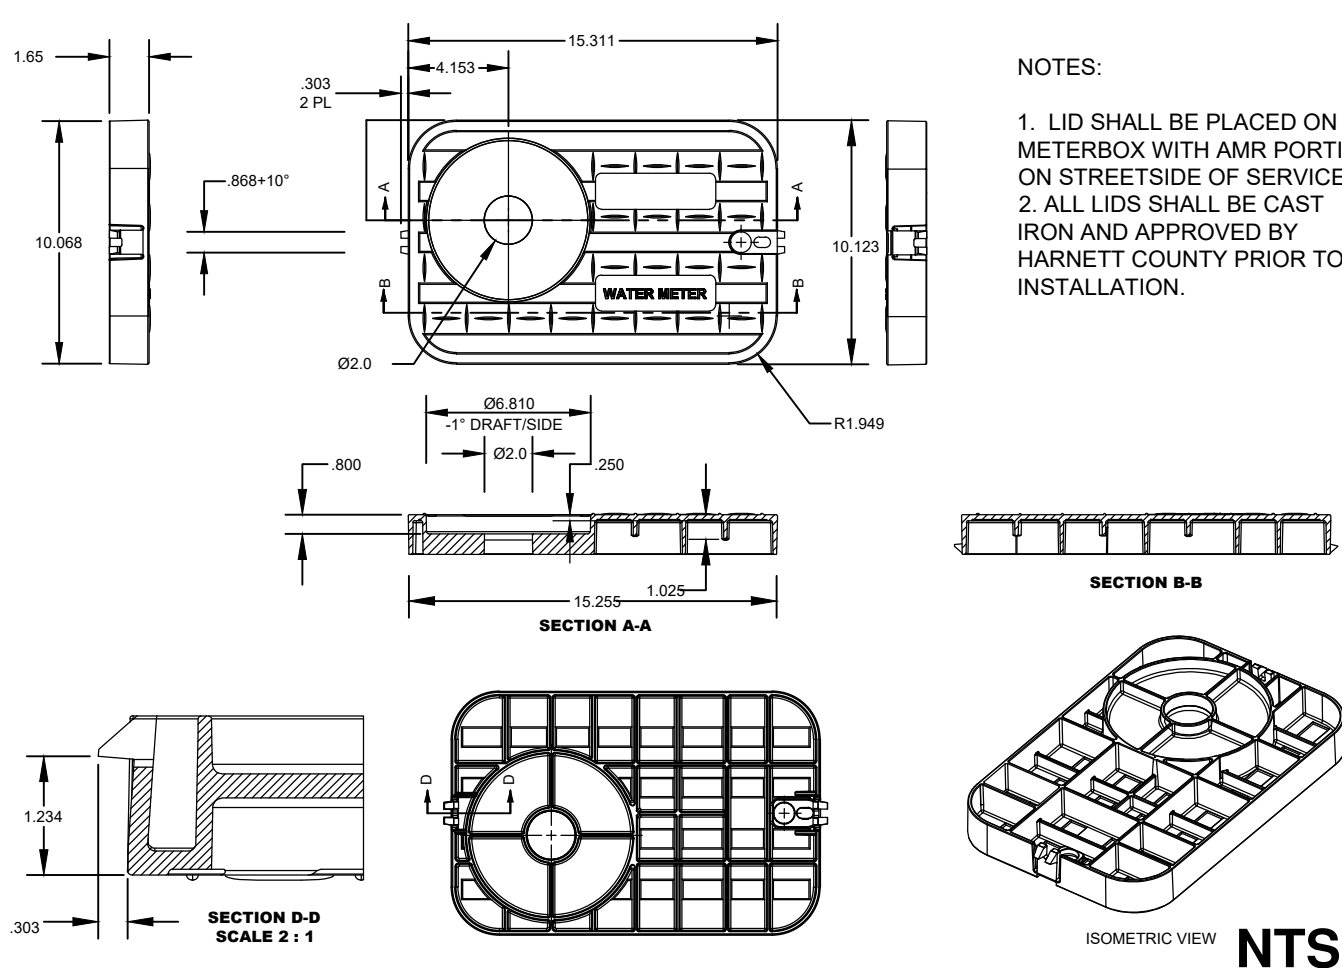


5 METER BOX AMR LID

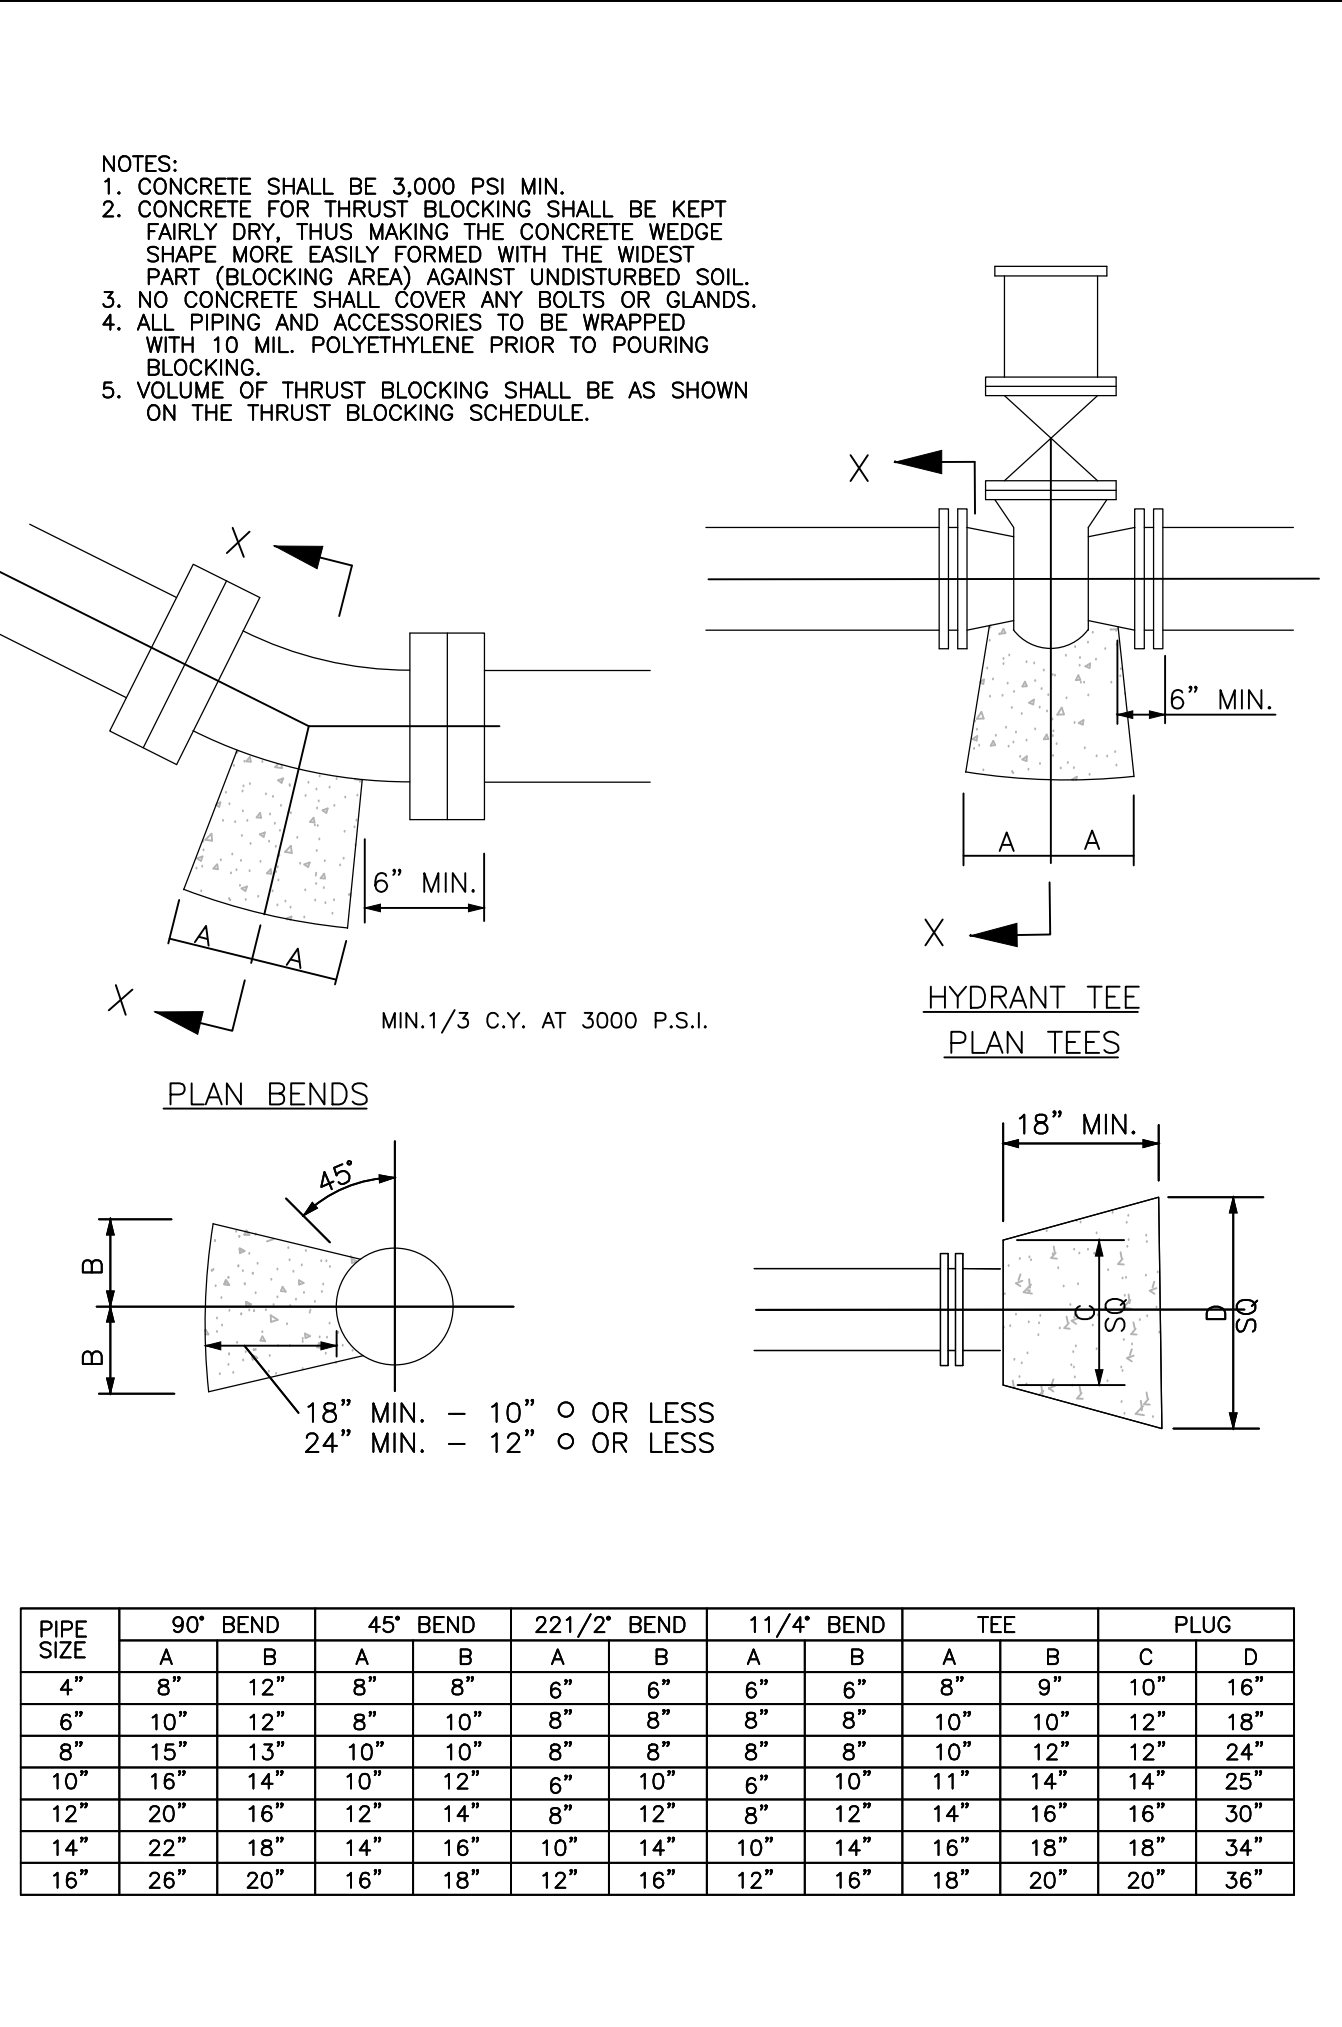


11 THRUST BLOCK DETAIL

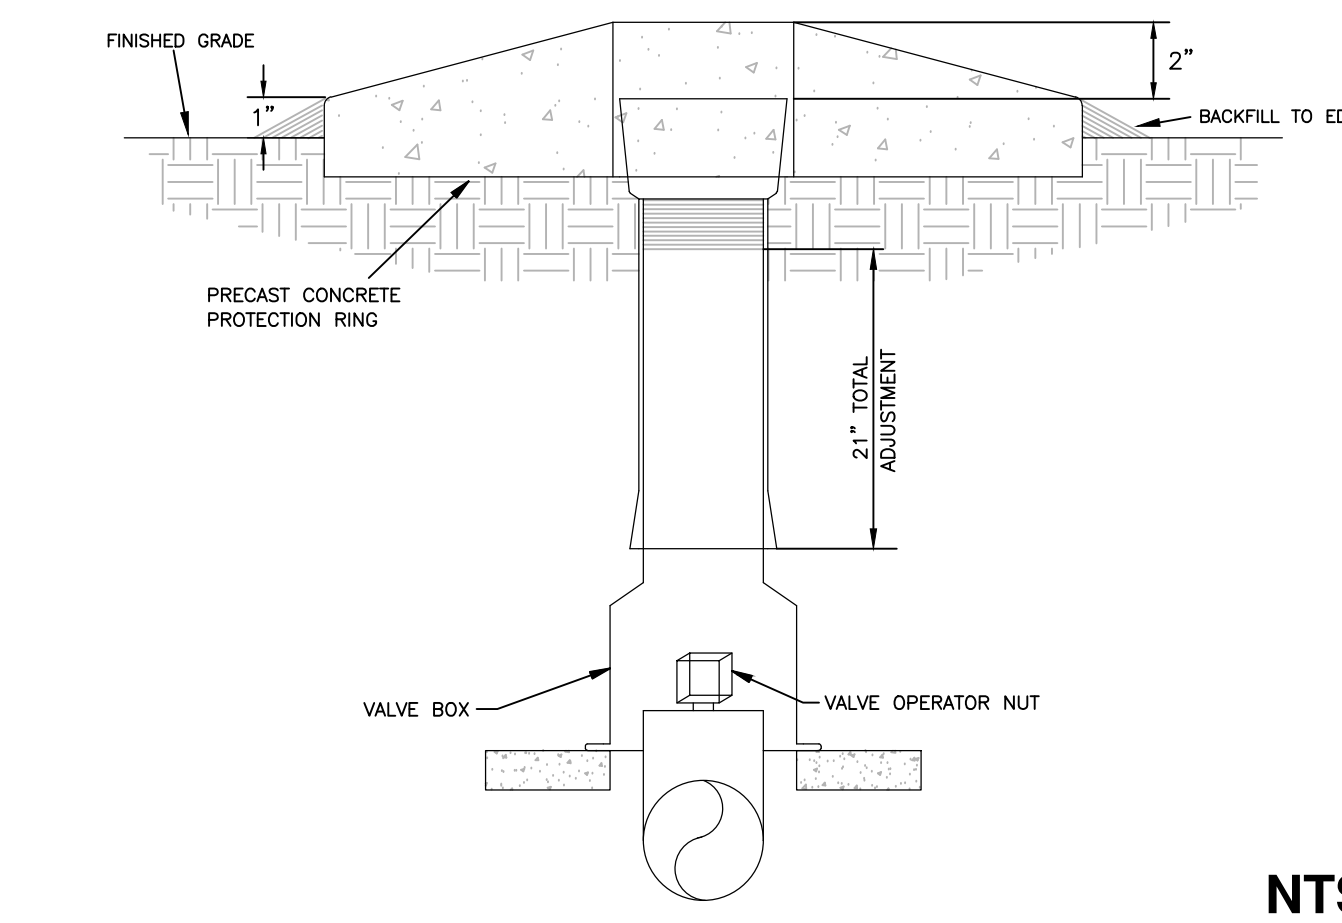

3 TYPICAL VALVE BOX DETAIL

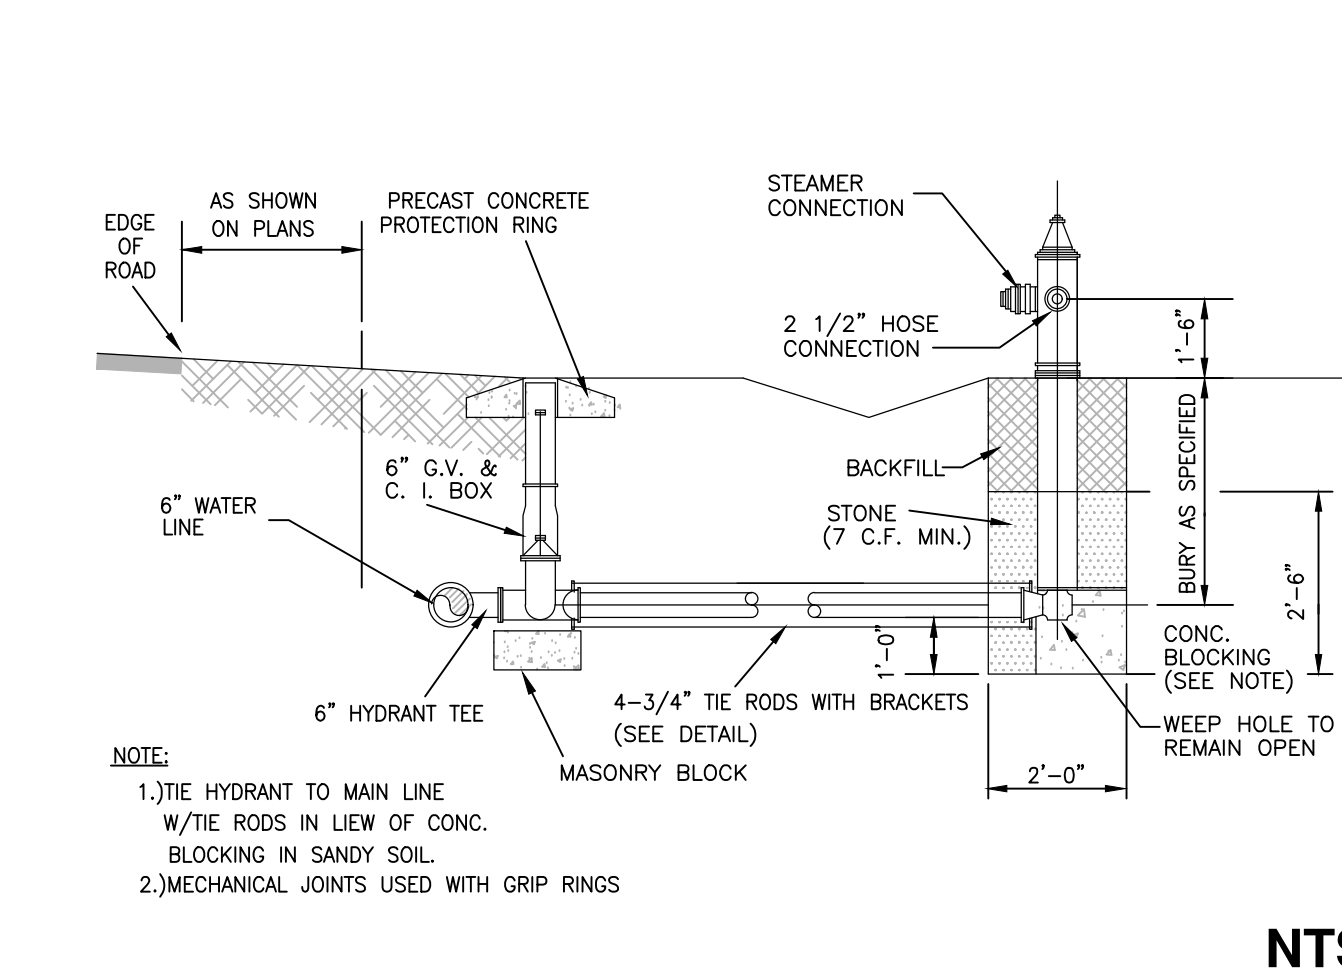

6 FIRE HYDRANT ASSEMBLY INSTALLATION

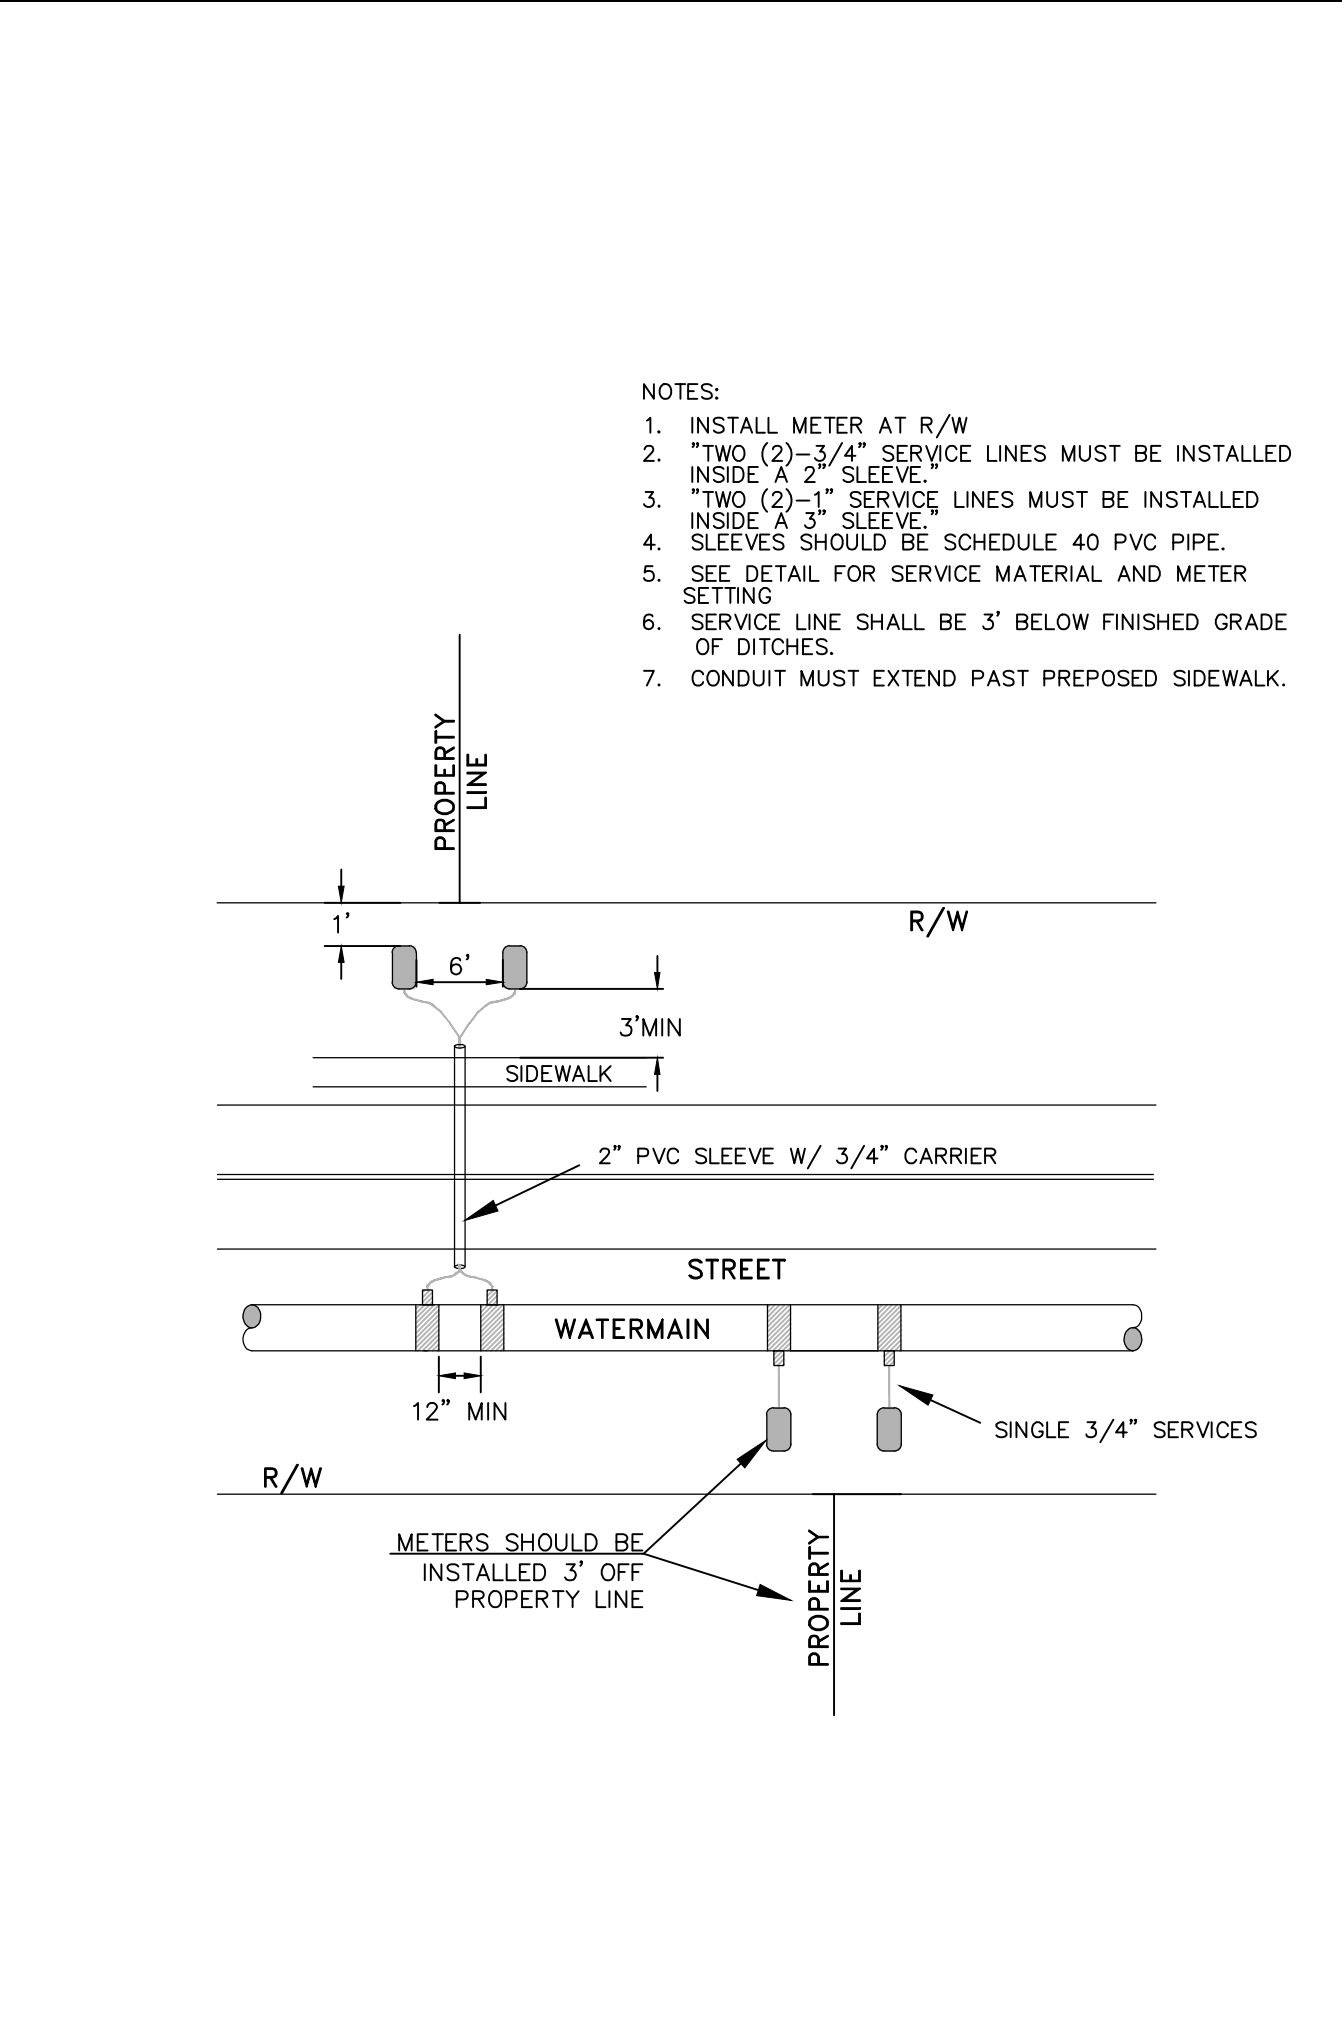

12 TYP. DOMESTIC WATER SERVICE DETAIL



REVISIONS  
ISSUED FOR CONSTRUCTION

PROJECT NAME  
HARPER'S MEADOW

WATER DETAILS

CLIENT  
TRIANGLE LAND PARTNERS, LLC

PO Box 5548  
Cary, North Carolina 27512  
Phone: (704) 608-3085

PROJECT INFORMATION	
DESIGNED BY:	CALEB
DRAWN BY:	CALEB
CHECKED BY:	SCOTT
PROJECT NUMBER:	1896








DRAWING SCALE  
NOT TO SCALE

DATE RELEASED  
MARCH 22, 2024

SHEET NUMBER  
C-6.6



I:\Projects\Land Parcel\1806\Harper's Meadow\DWG\SDWG\1806-02-01.dwg \* 03/22/2024 2:10 PM

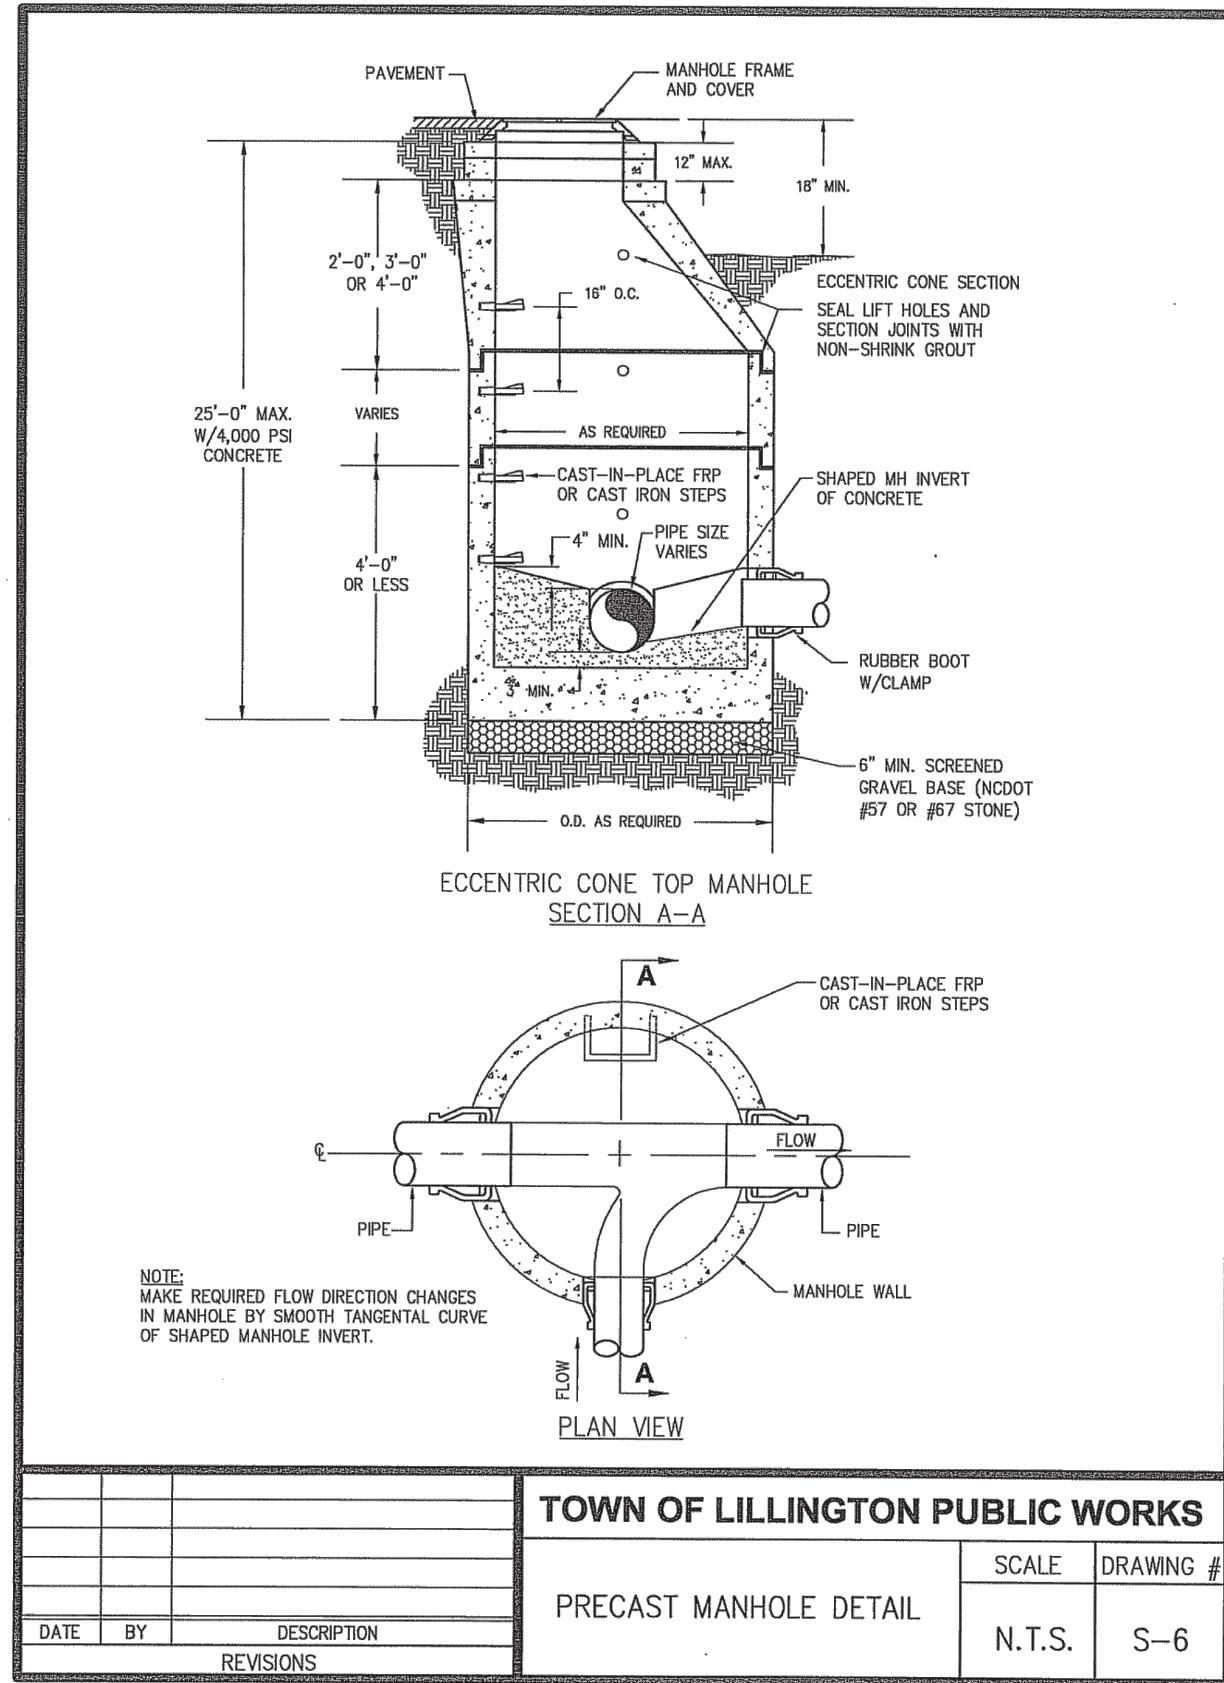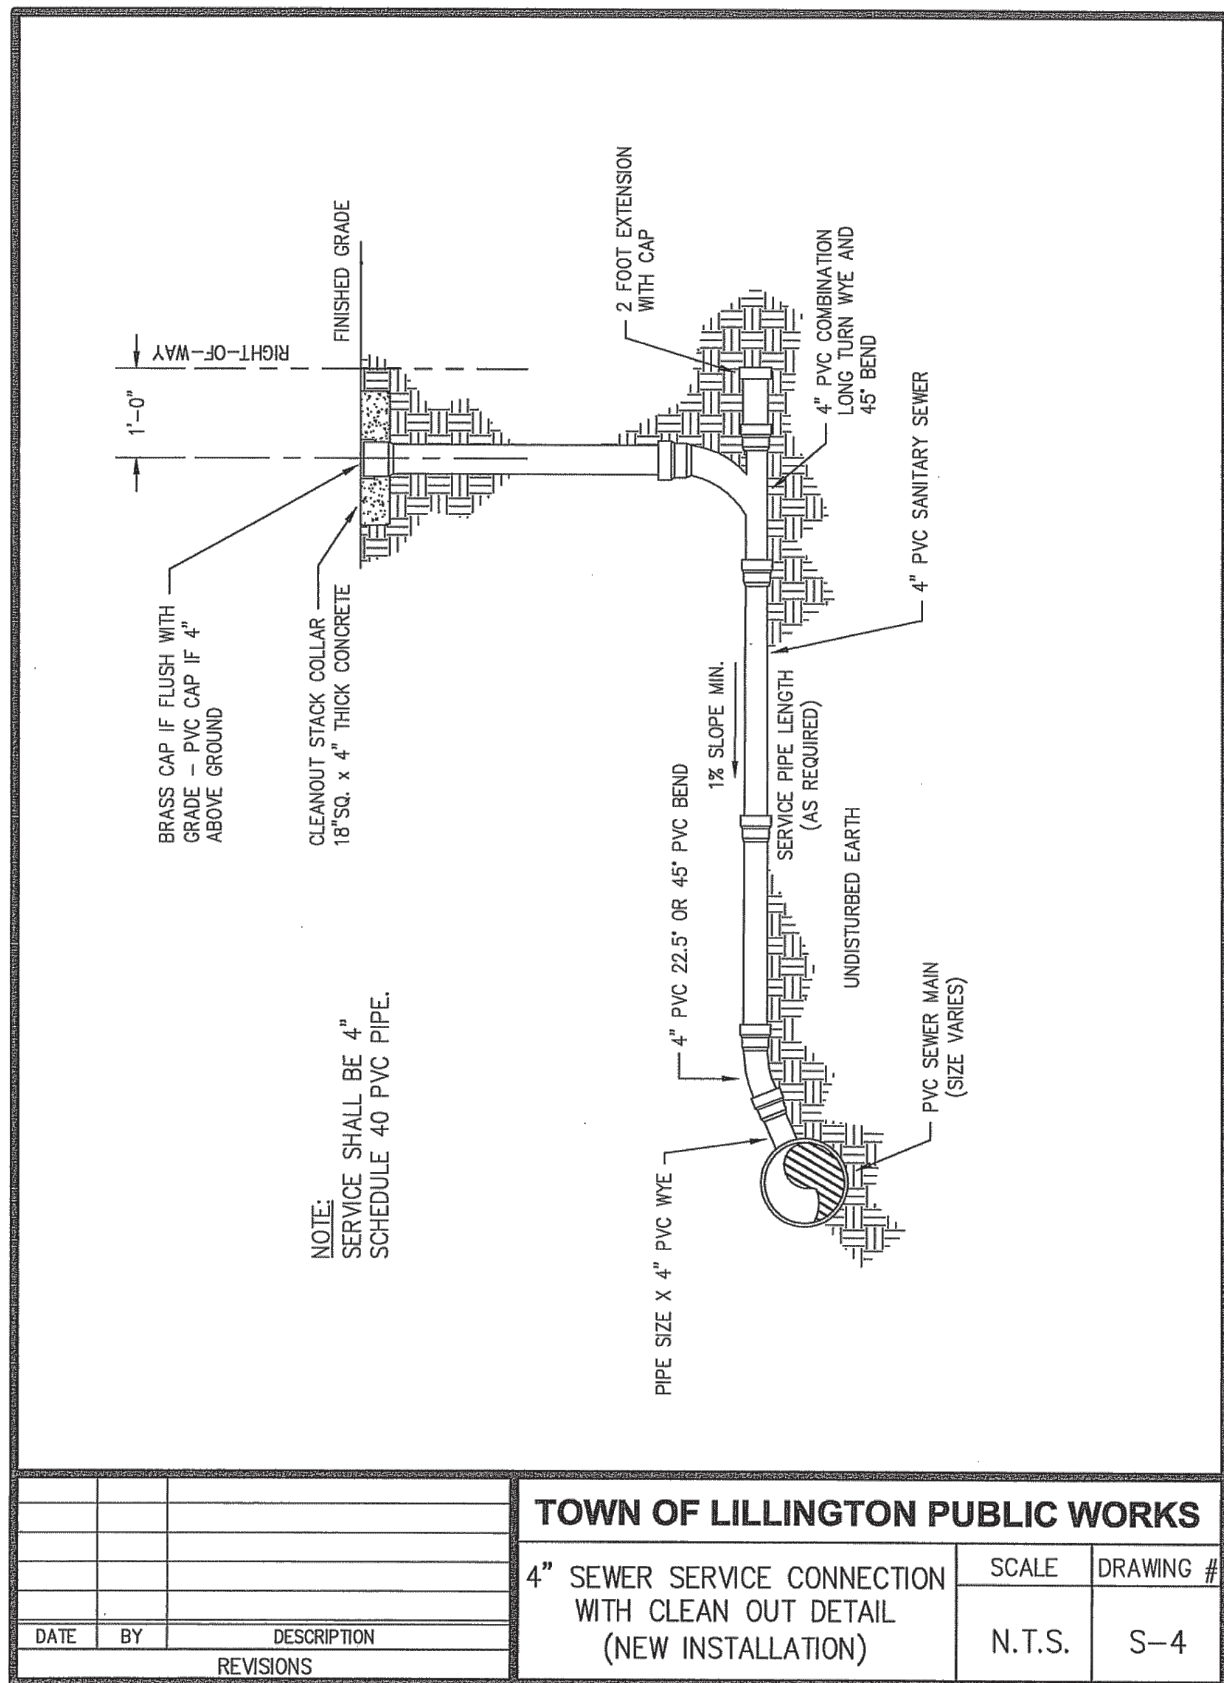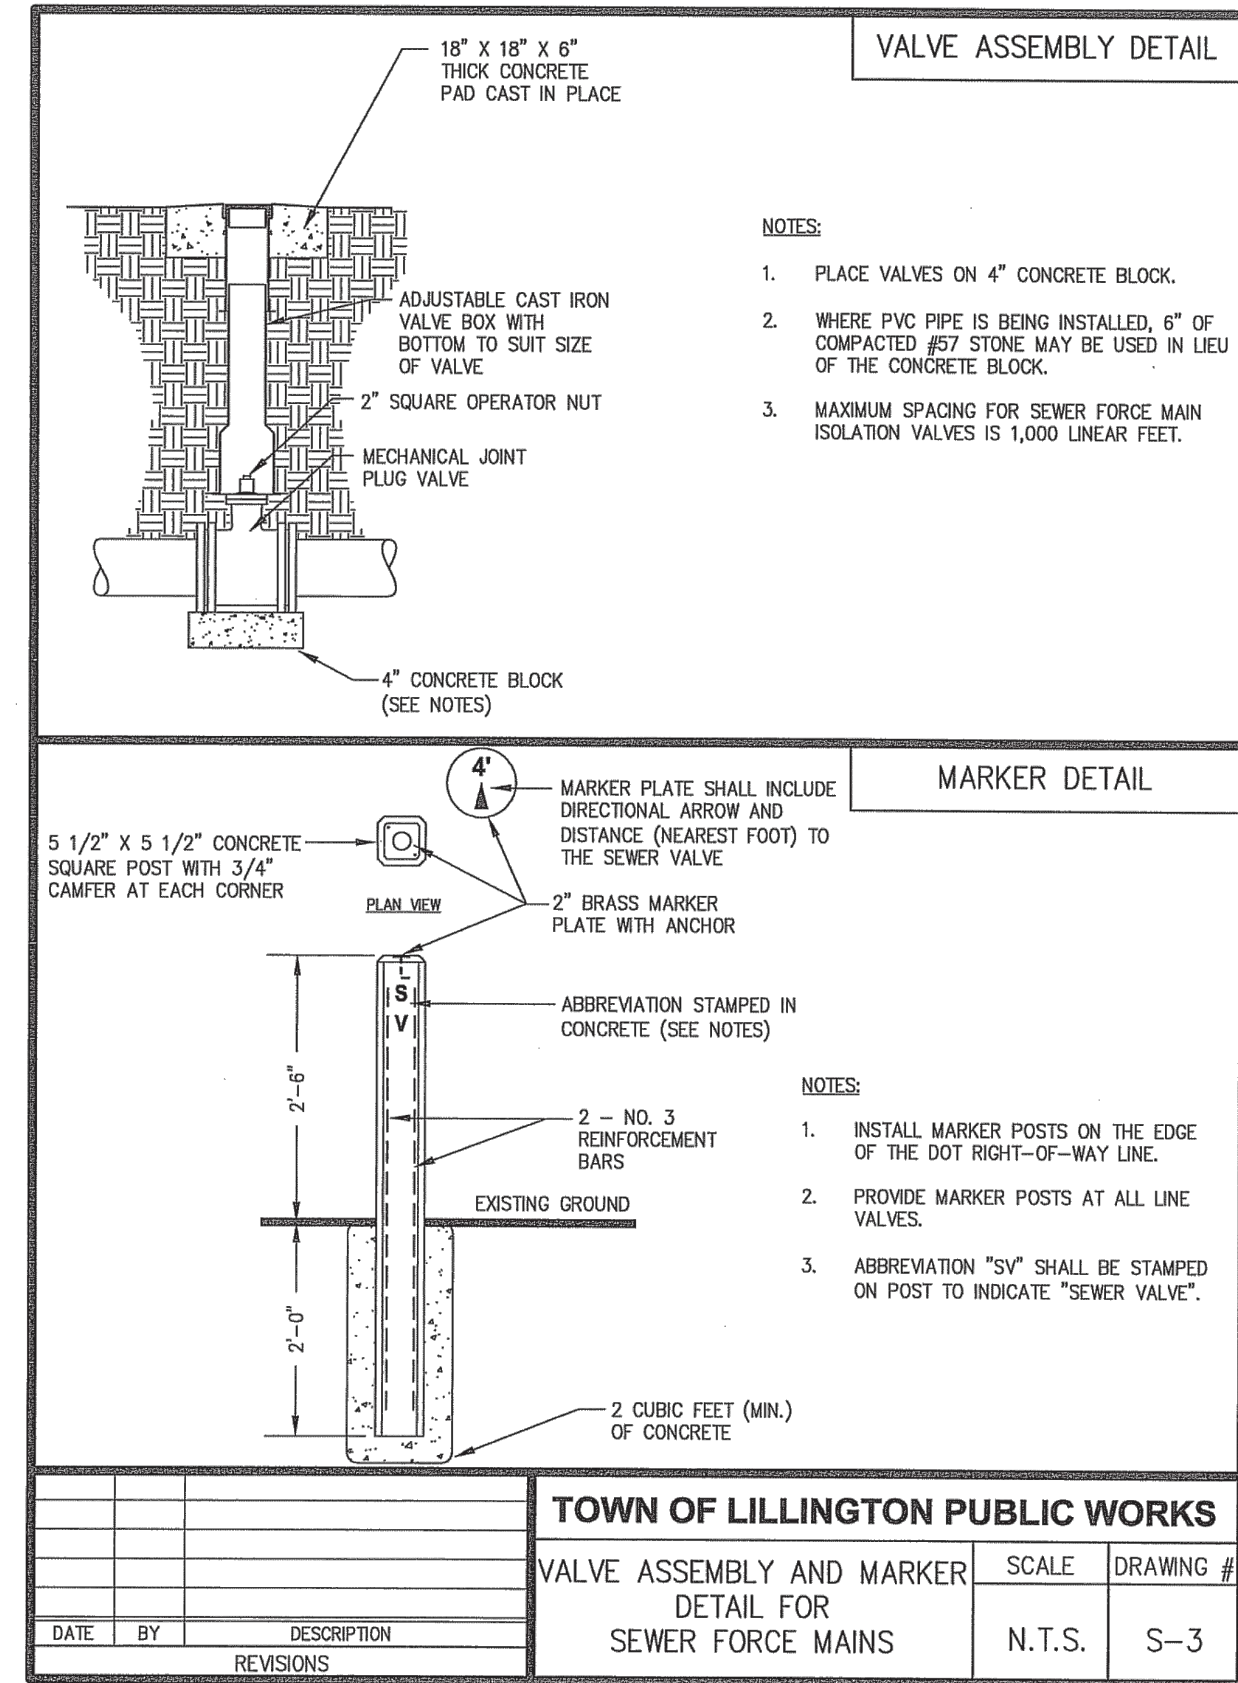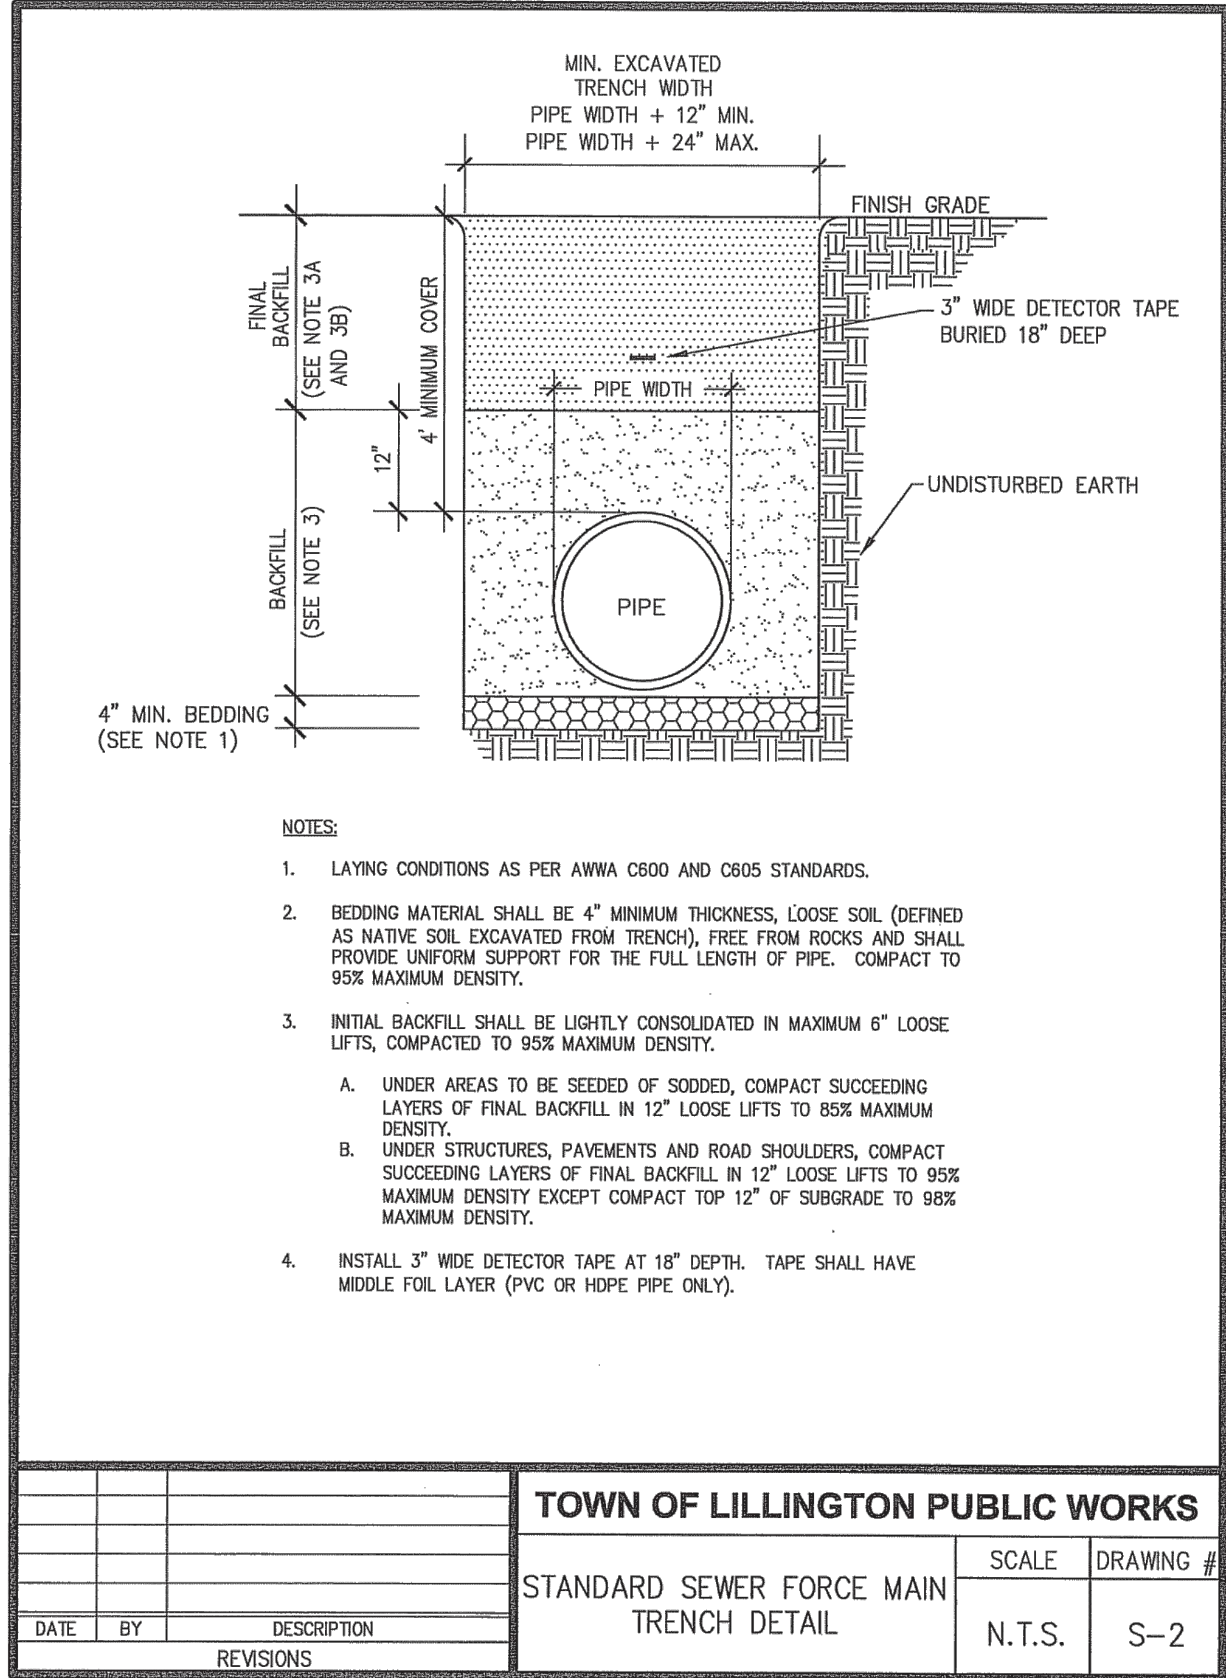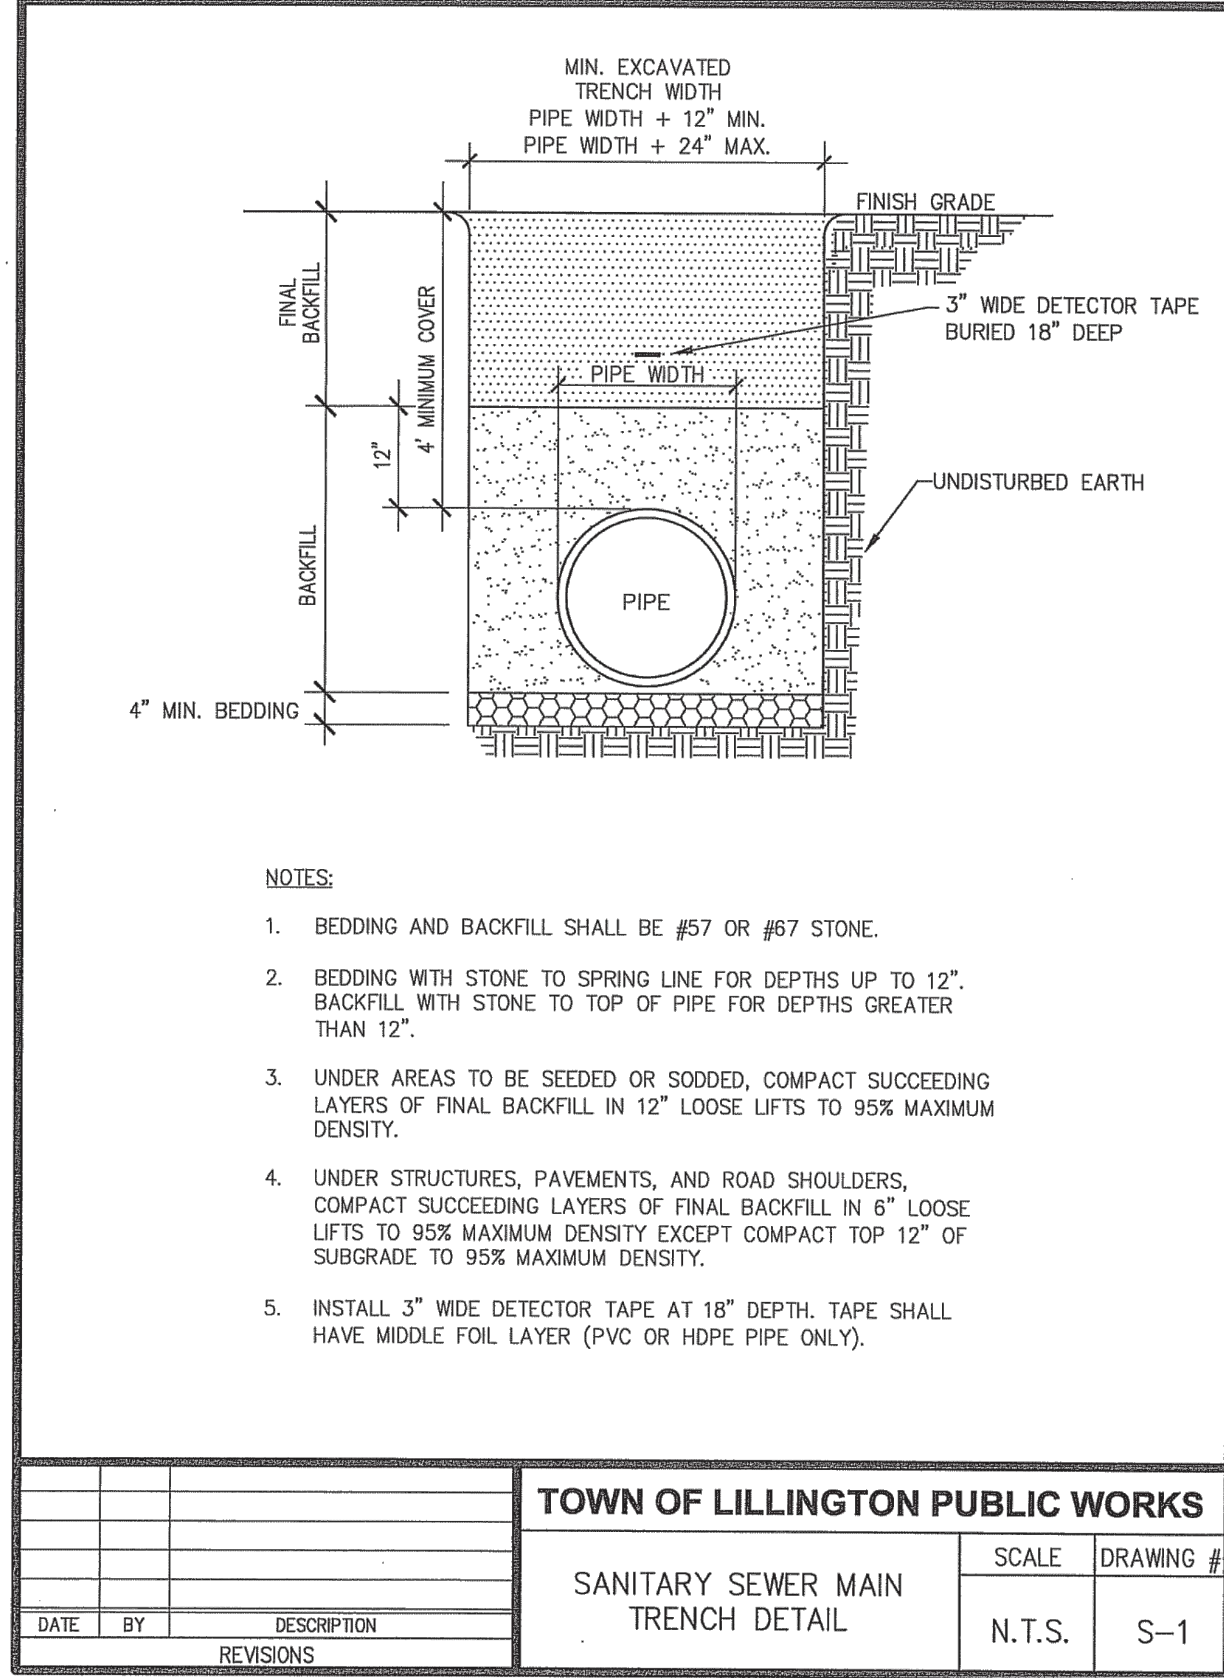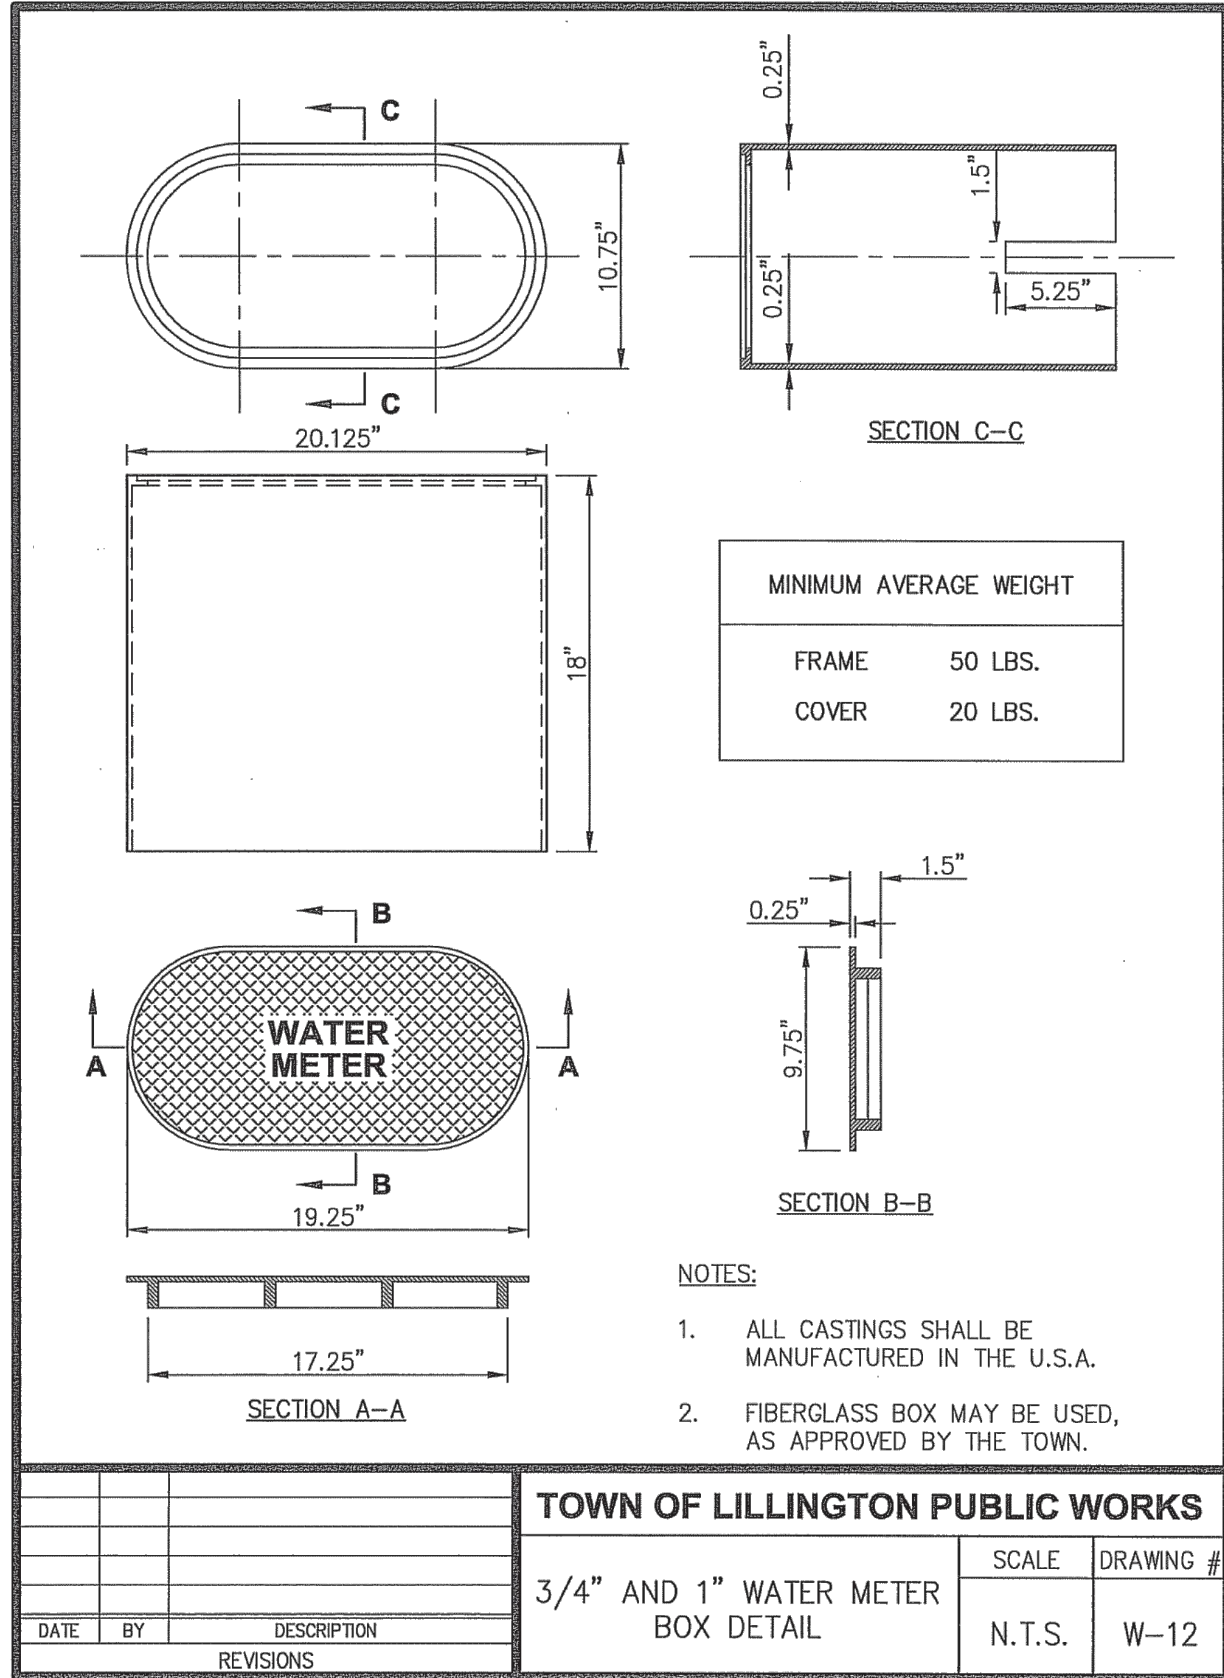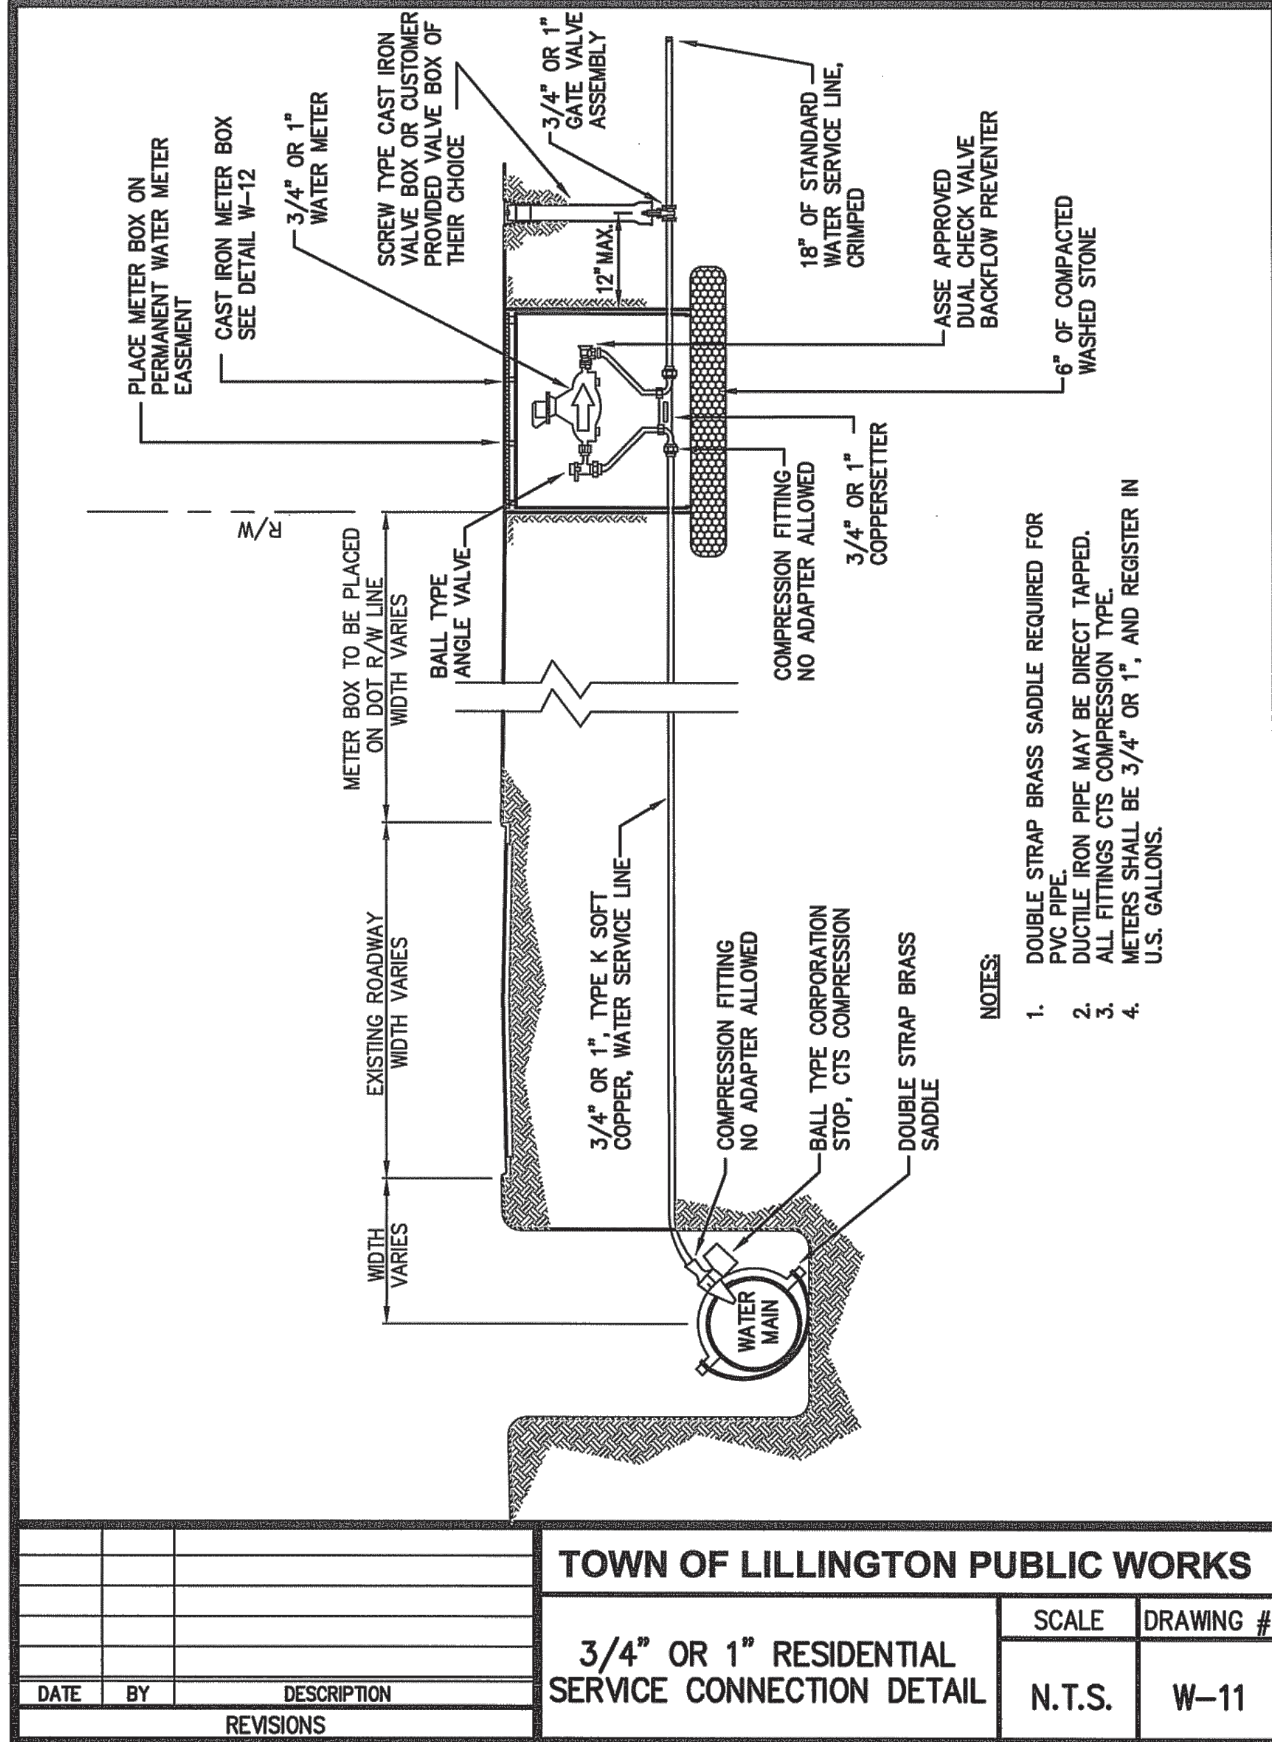

REVISIONS  
**ISSUED FOR CONSTRUCTION**

PROJECT NAME

**HARPER'S MEADOW**

**WATER & SEWER DETAILS**

CLIENT

**TRIANGLE LAND PARTNERS, LLC**

PO Box 5548  
Cary, North Carolina 27512  
Phone: (704) 608-3085

PROJECT INFORMATION

DESIGNED BY:	CALEB
DRAWN BY:	CALEB
CHECKED BY:	SCOTT
PROJECT NUMBER:	1896

DRAWING SCALE

NOT TO SCALE






DATE RELEASED

MARCH 22, 2024

SHEET NUMBER

**C-6.7**



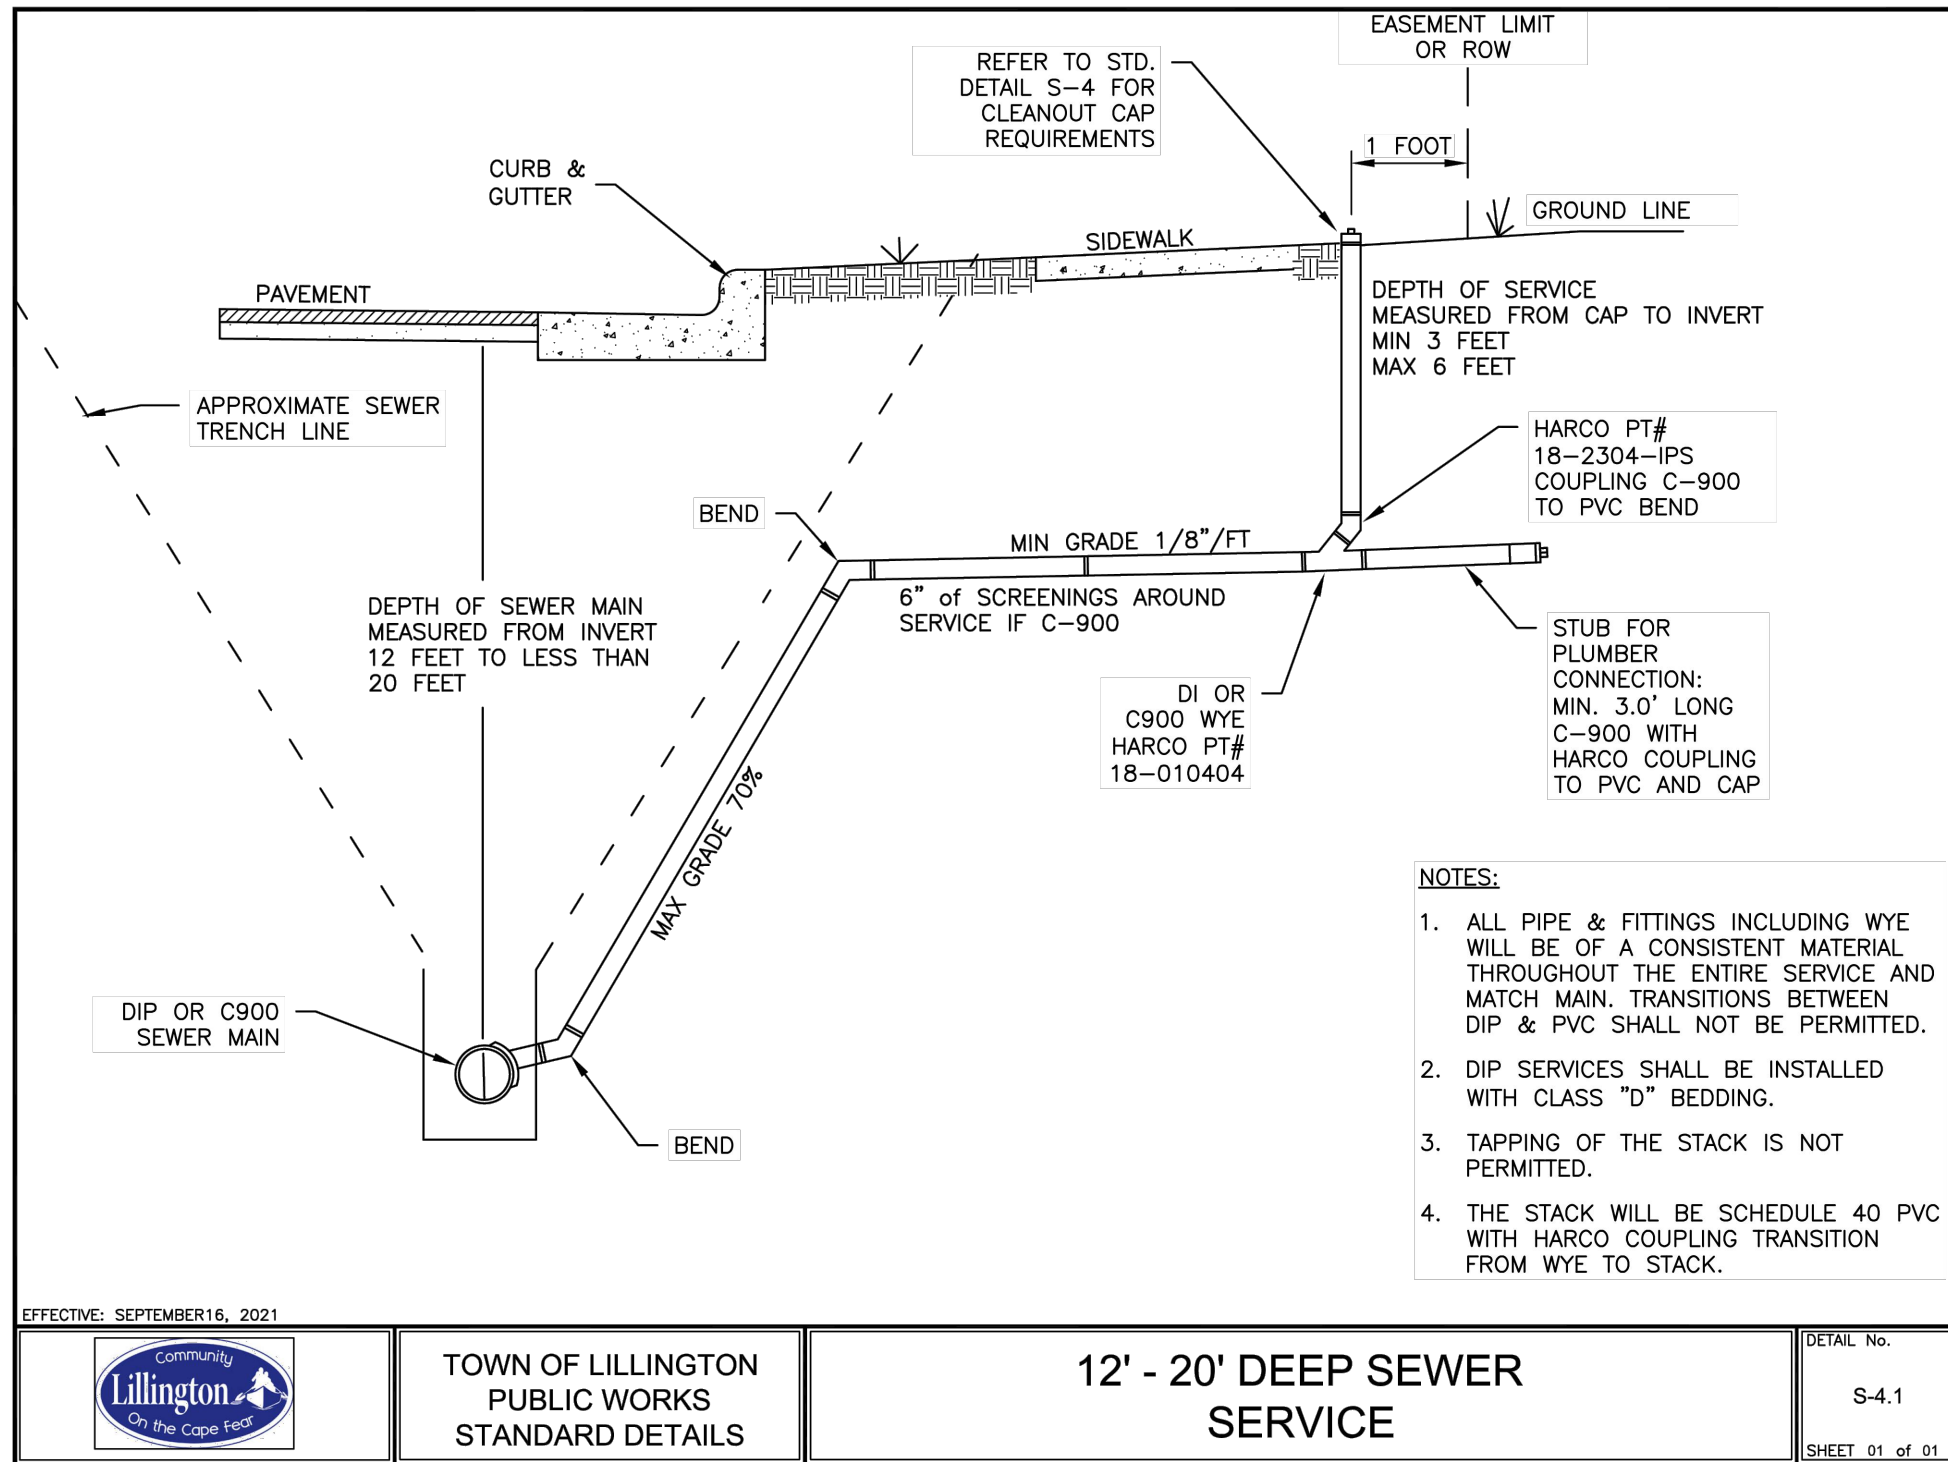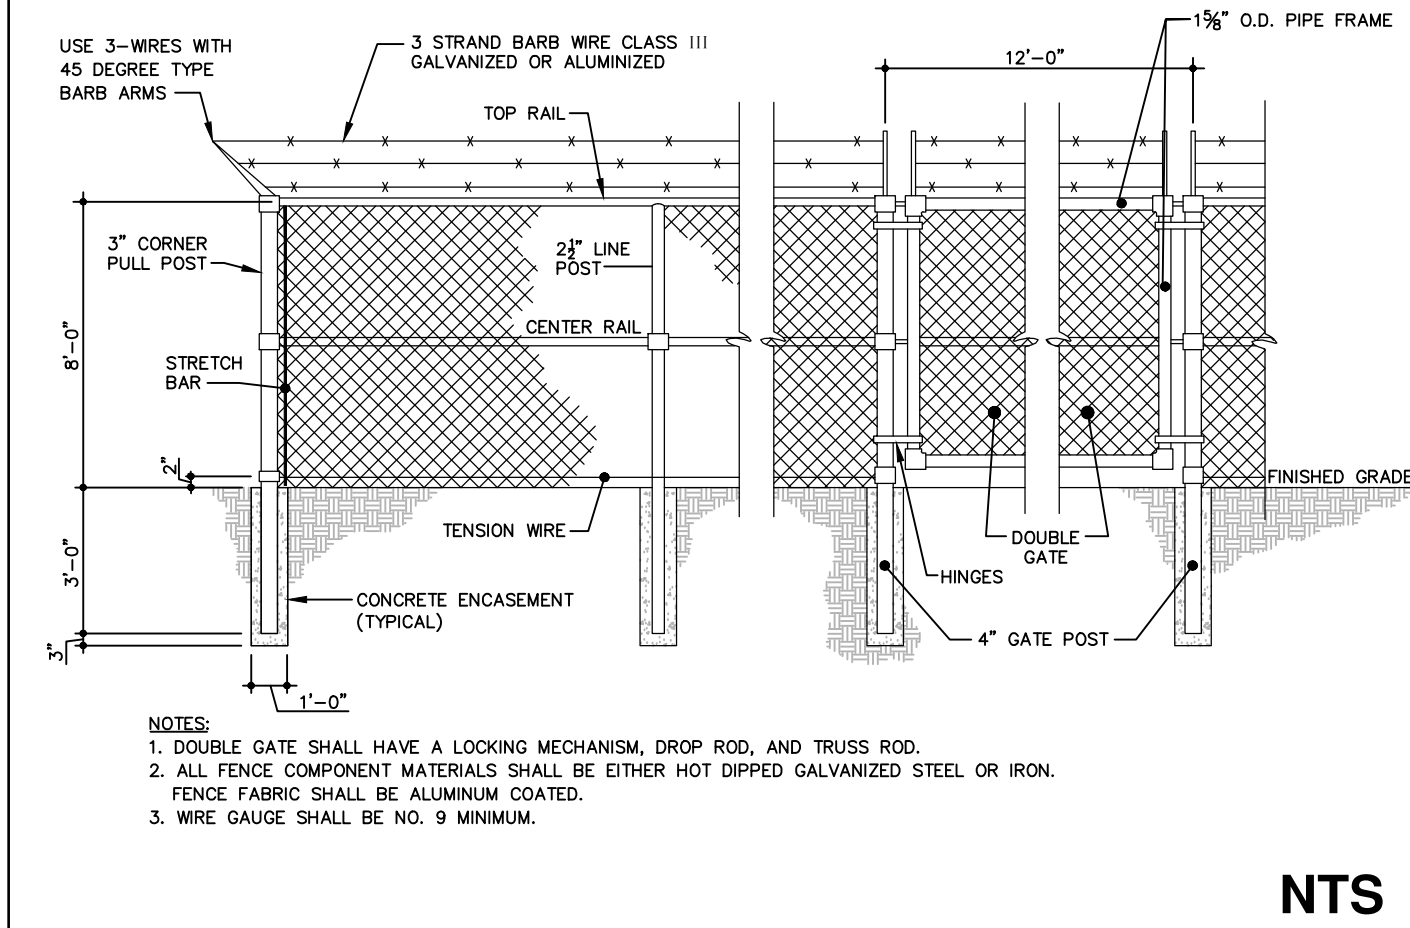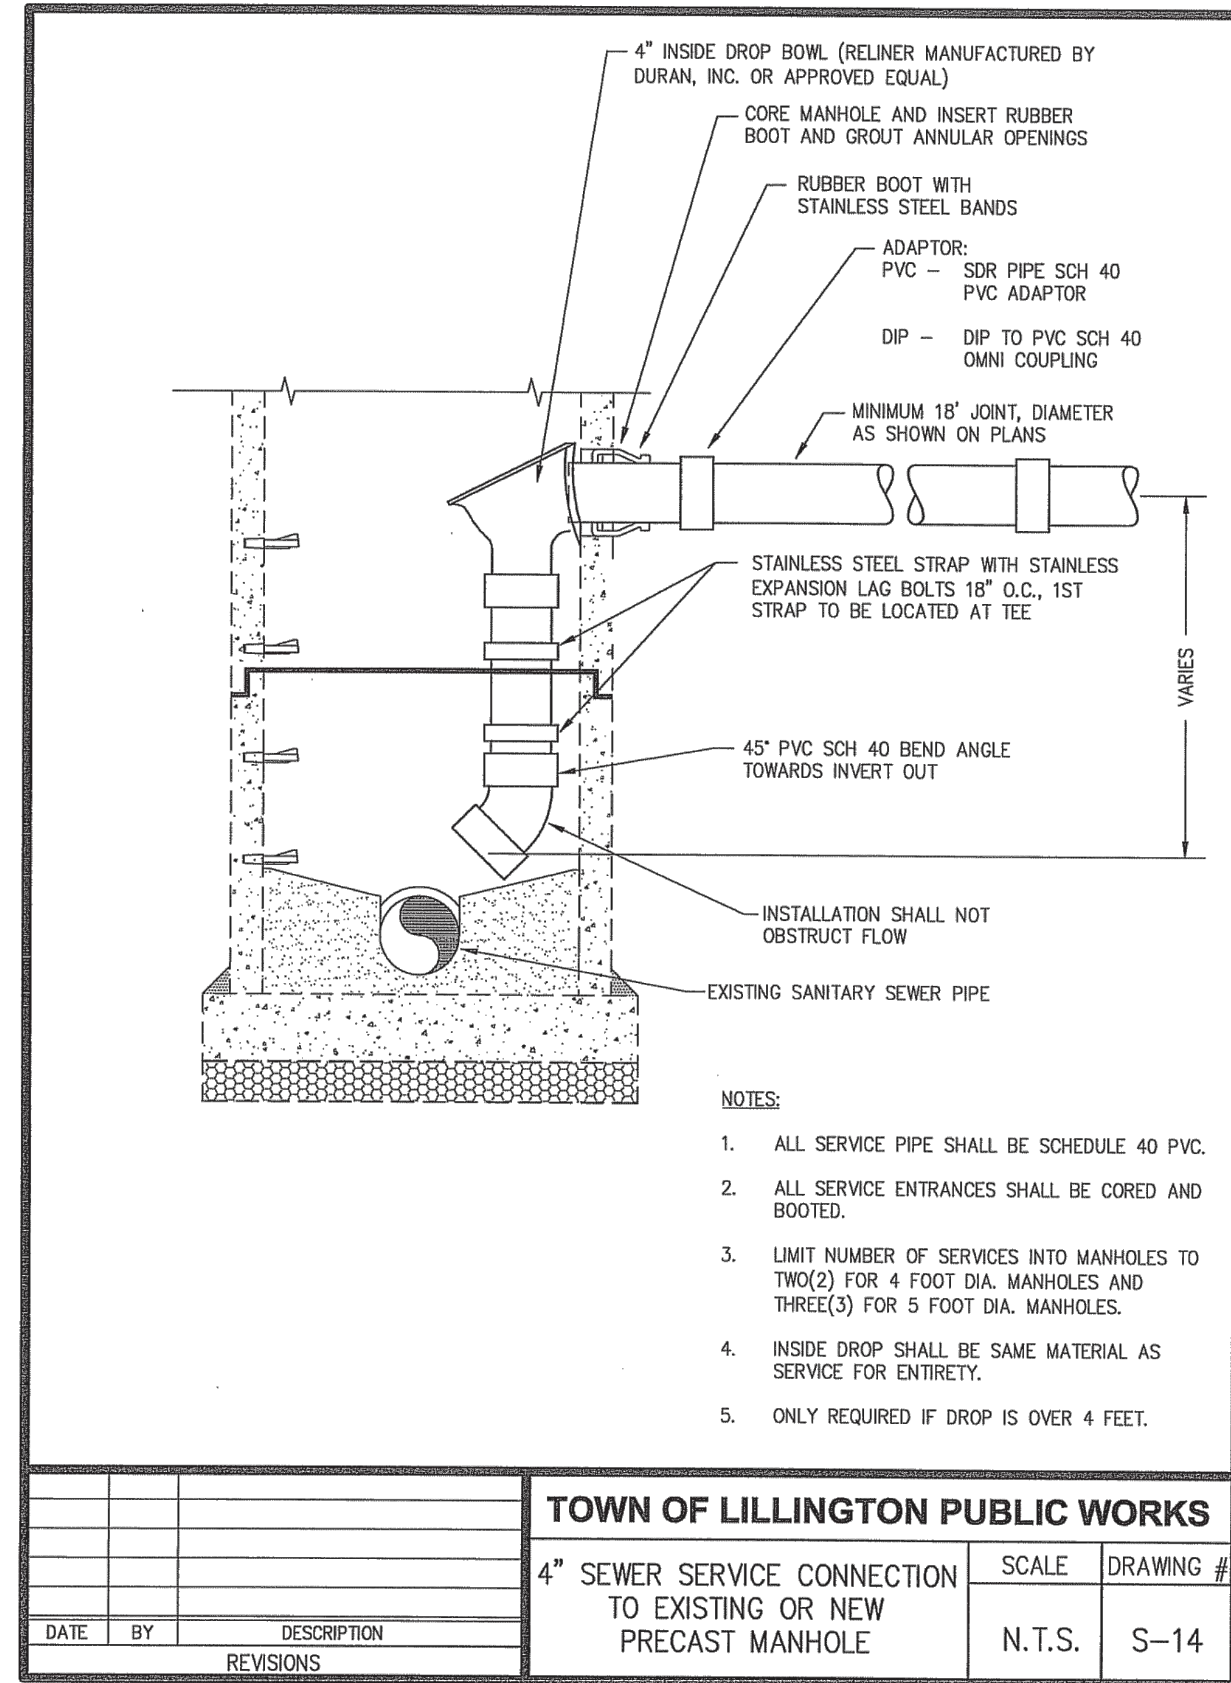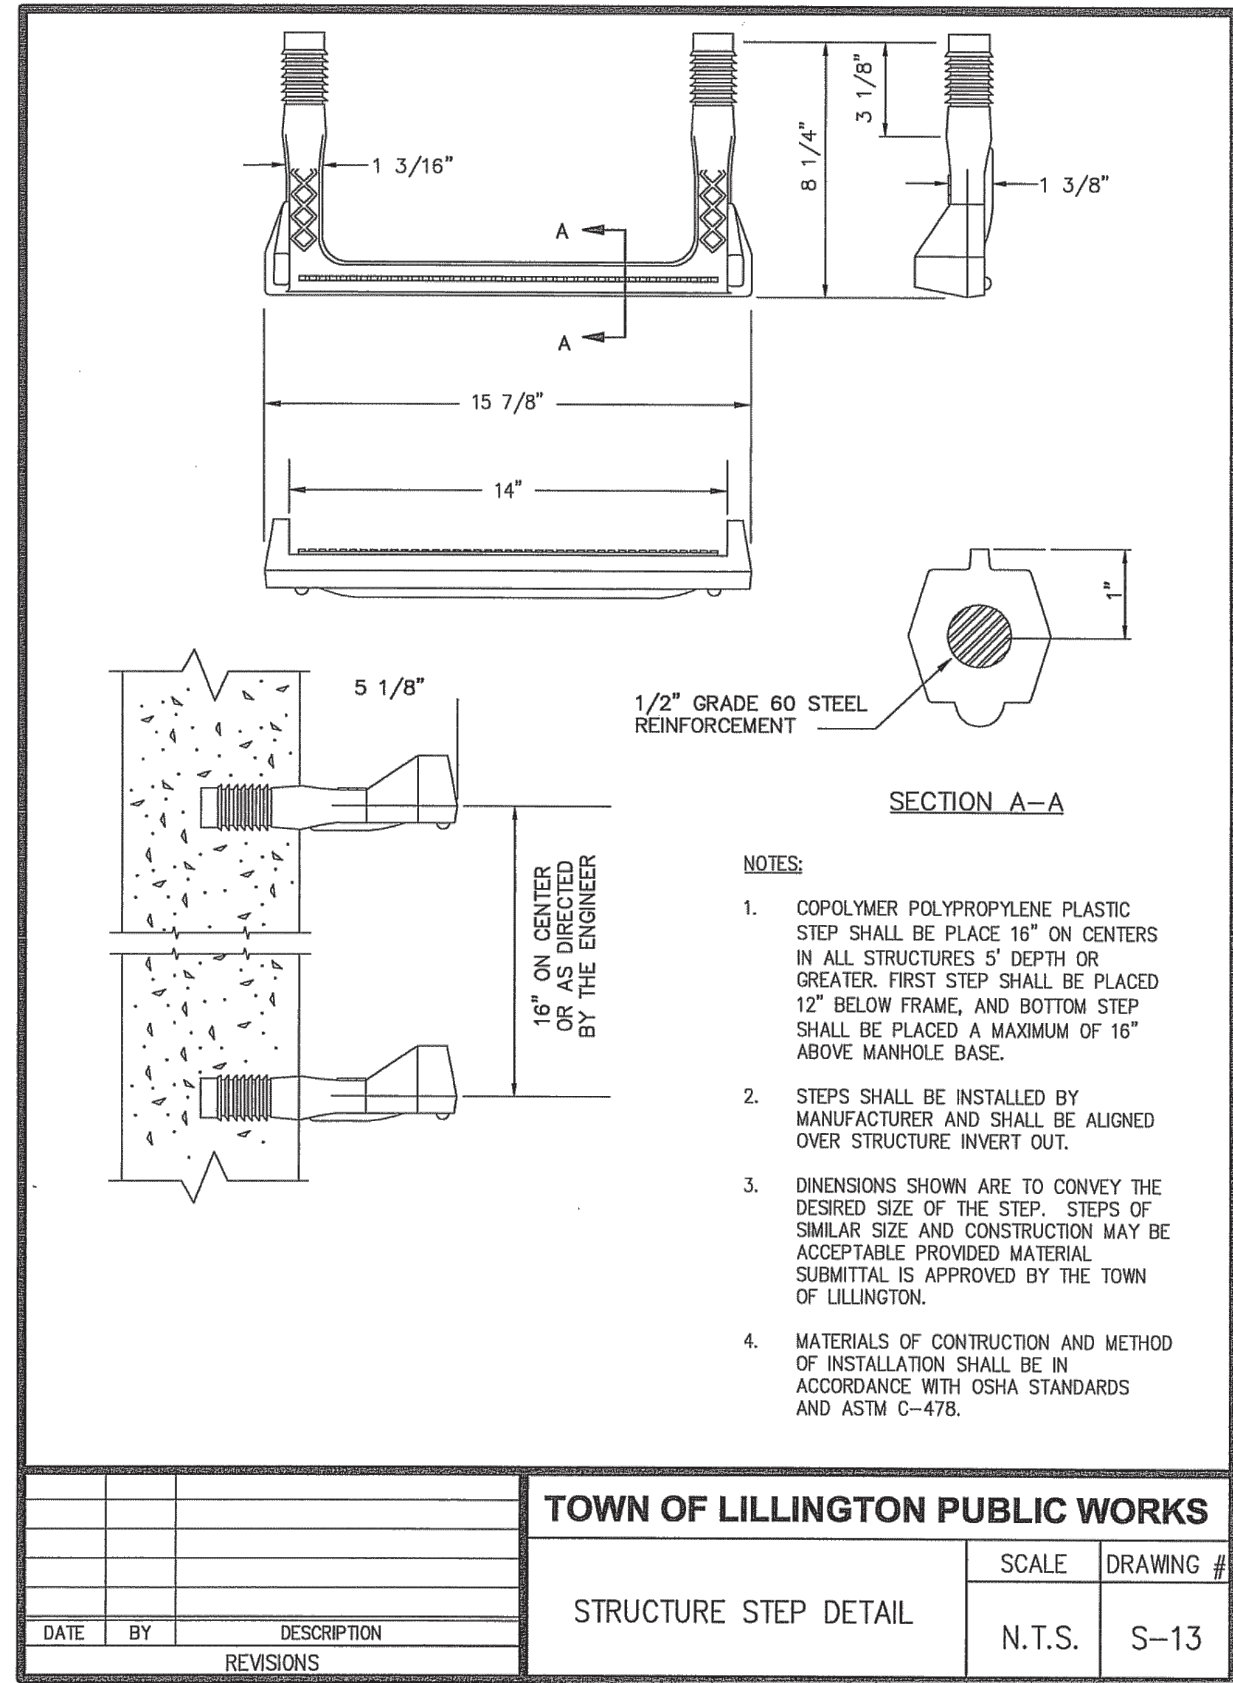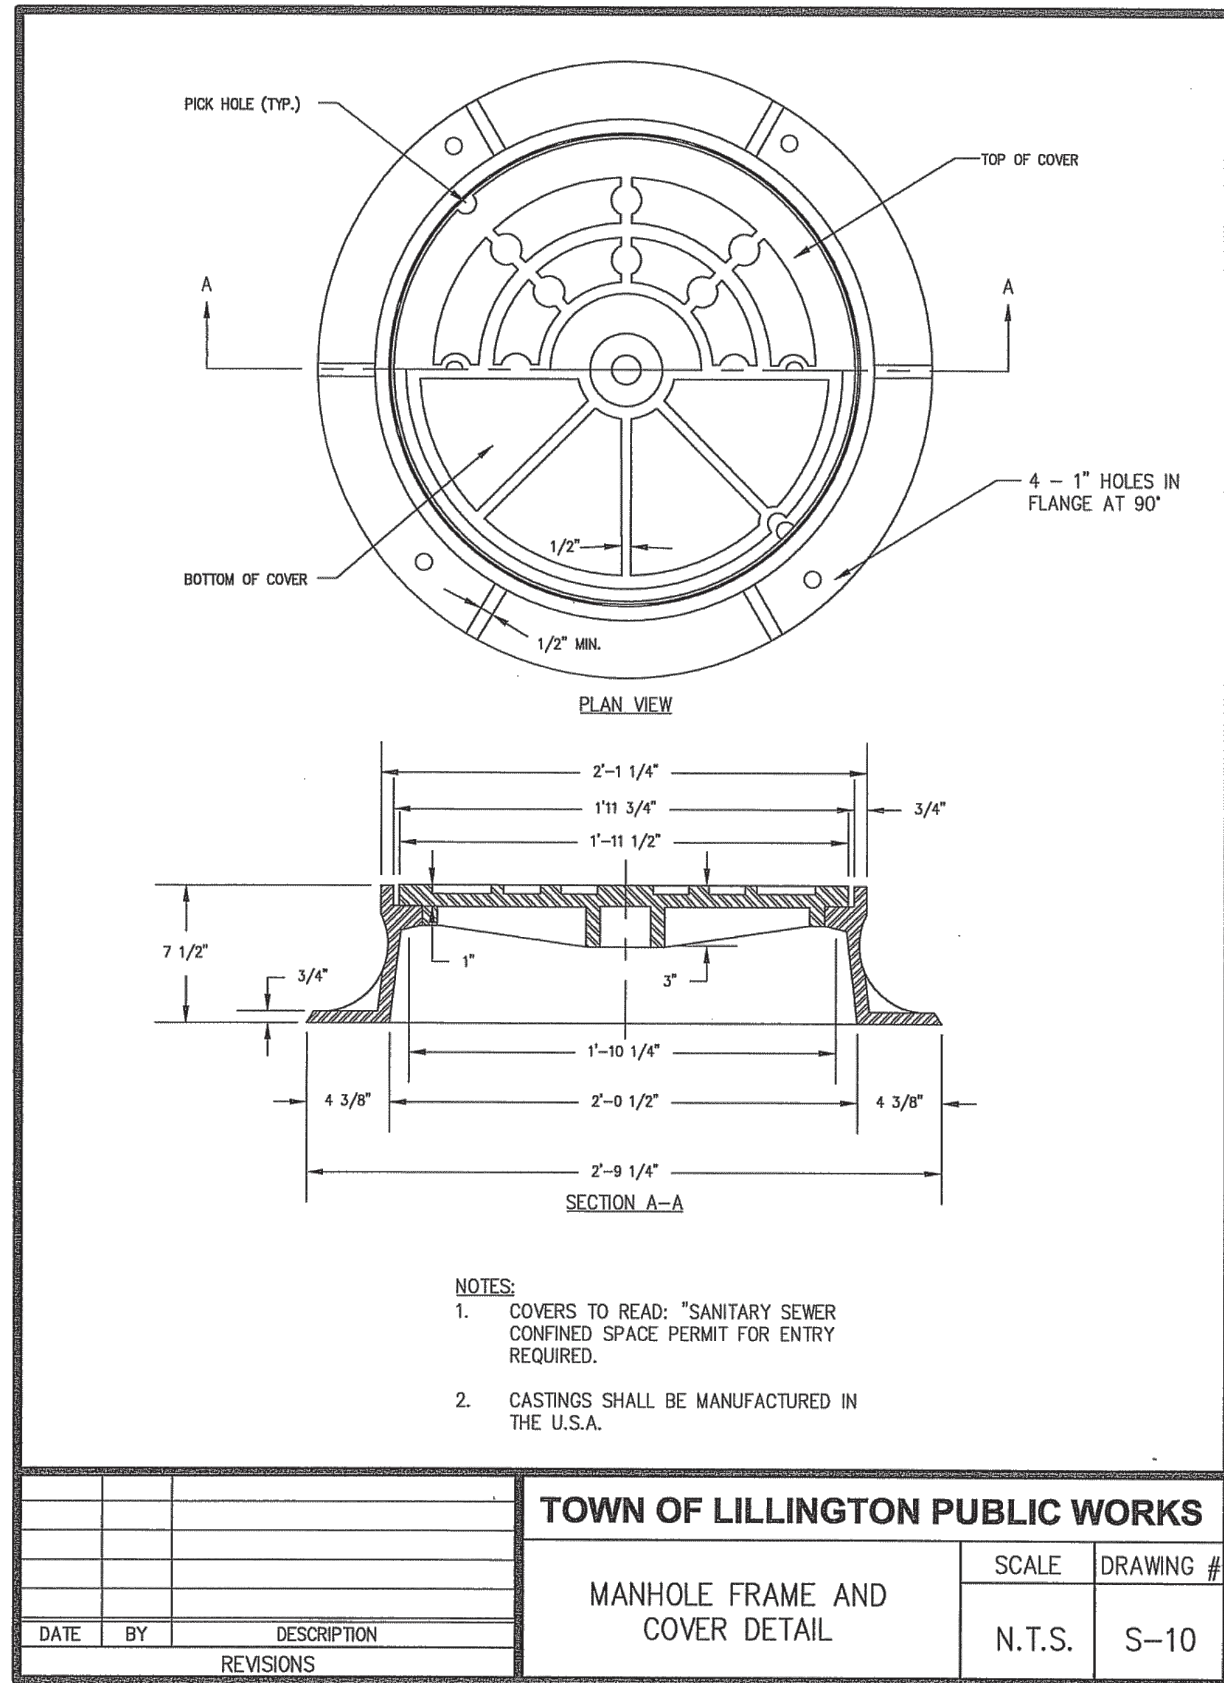

REVISIONS  
ISSUED FOR CONSTRUCTION

PROJECT NAME  
**HARPER'S MEADOW**

SEWER DETAILS

CLIENT  
**TRIANGLE LAND PARTNERS, LLC**

PO Box 5548  
Cary, North Carolina 27512  
Phone: (704) 608-3085



PROJECT INFORMATION	
DESIGNED BY:	CALEB
DRAWN BY:	CALEB
CHECKED BY:	SCOTT
PROJECT NUMBER:	1896

DRAWING SCALE  
NOT TO SCALE


DATE RELEASED  
MARCH 22, 2024

SHEET NUMBER  
**C-6.8**



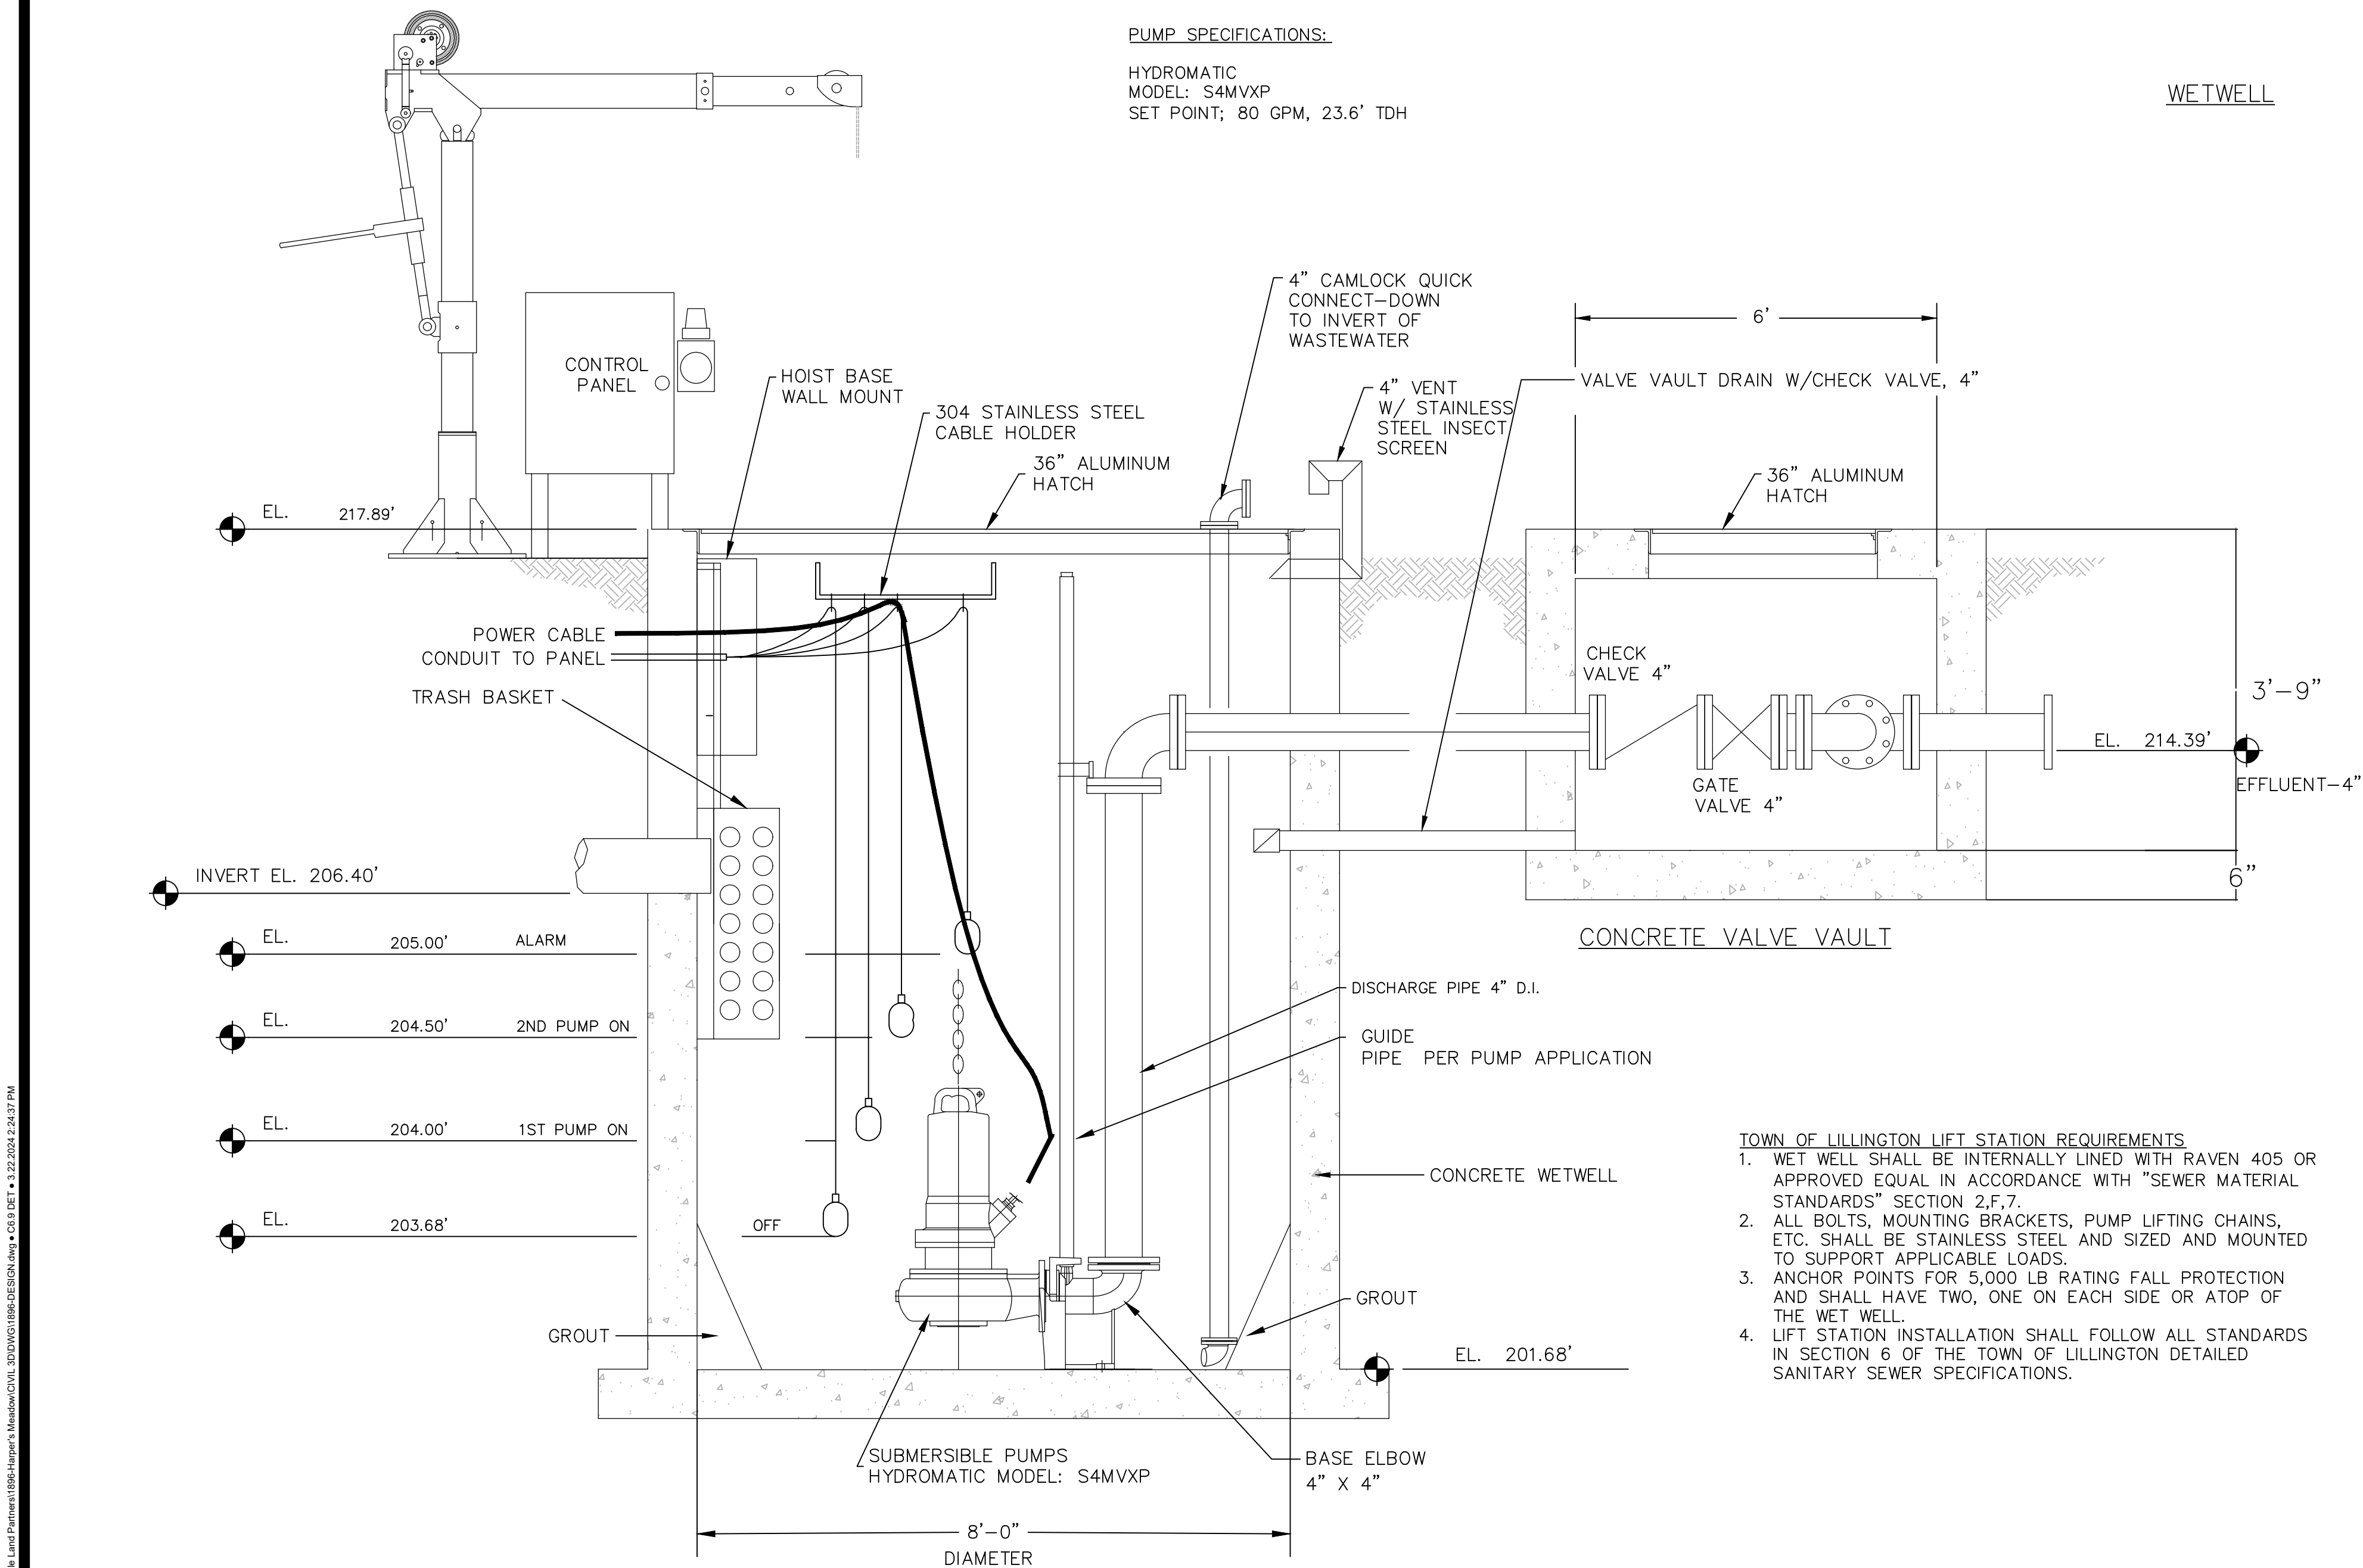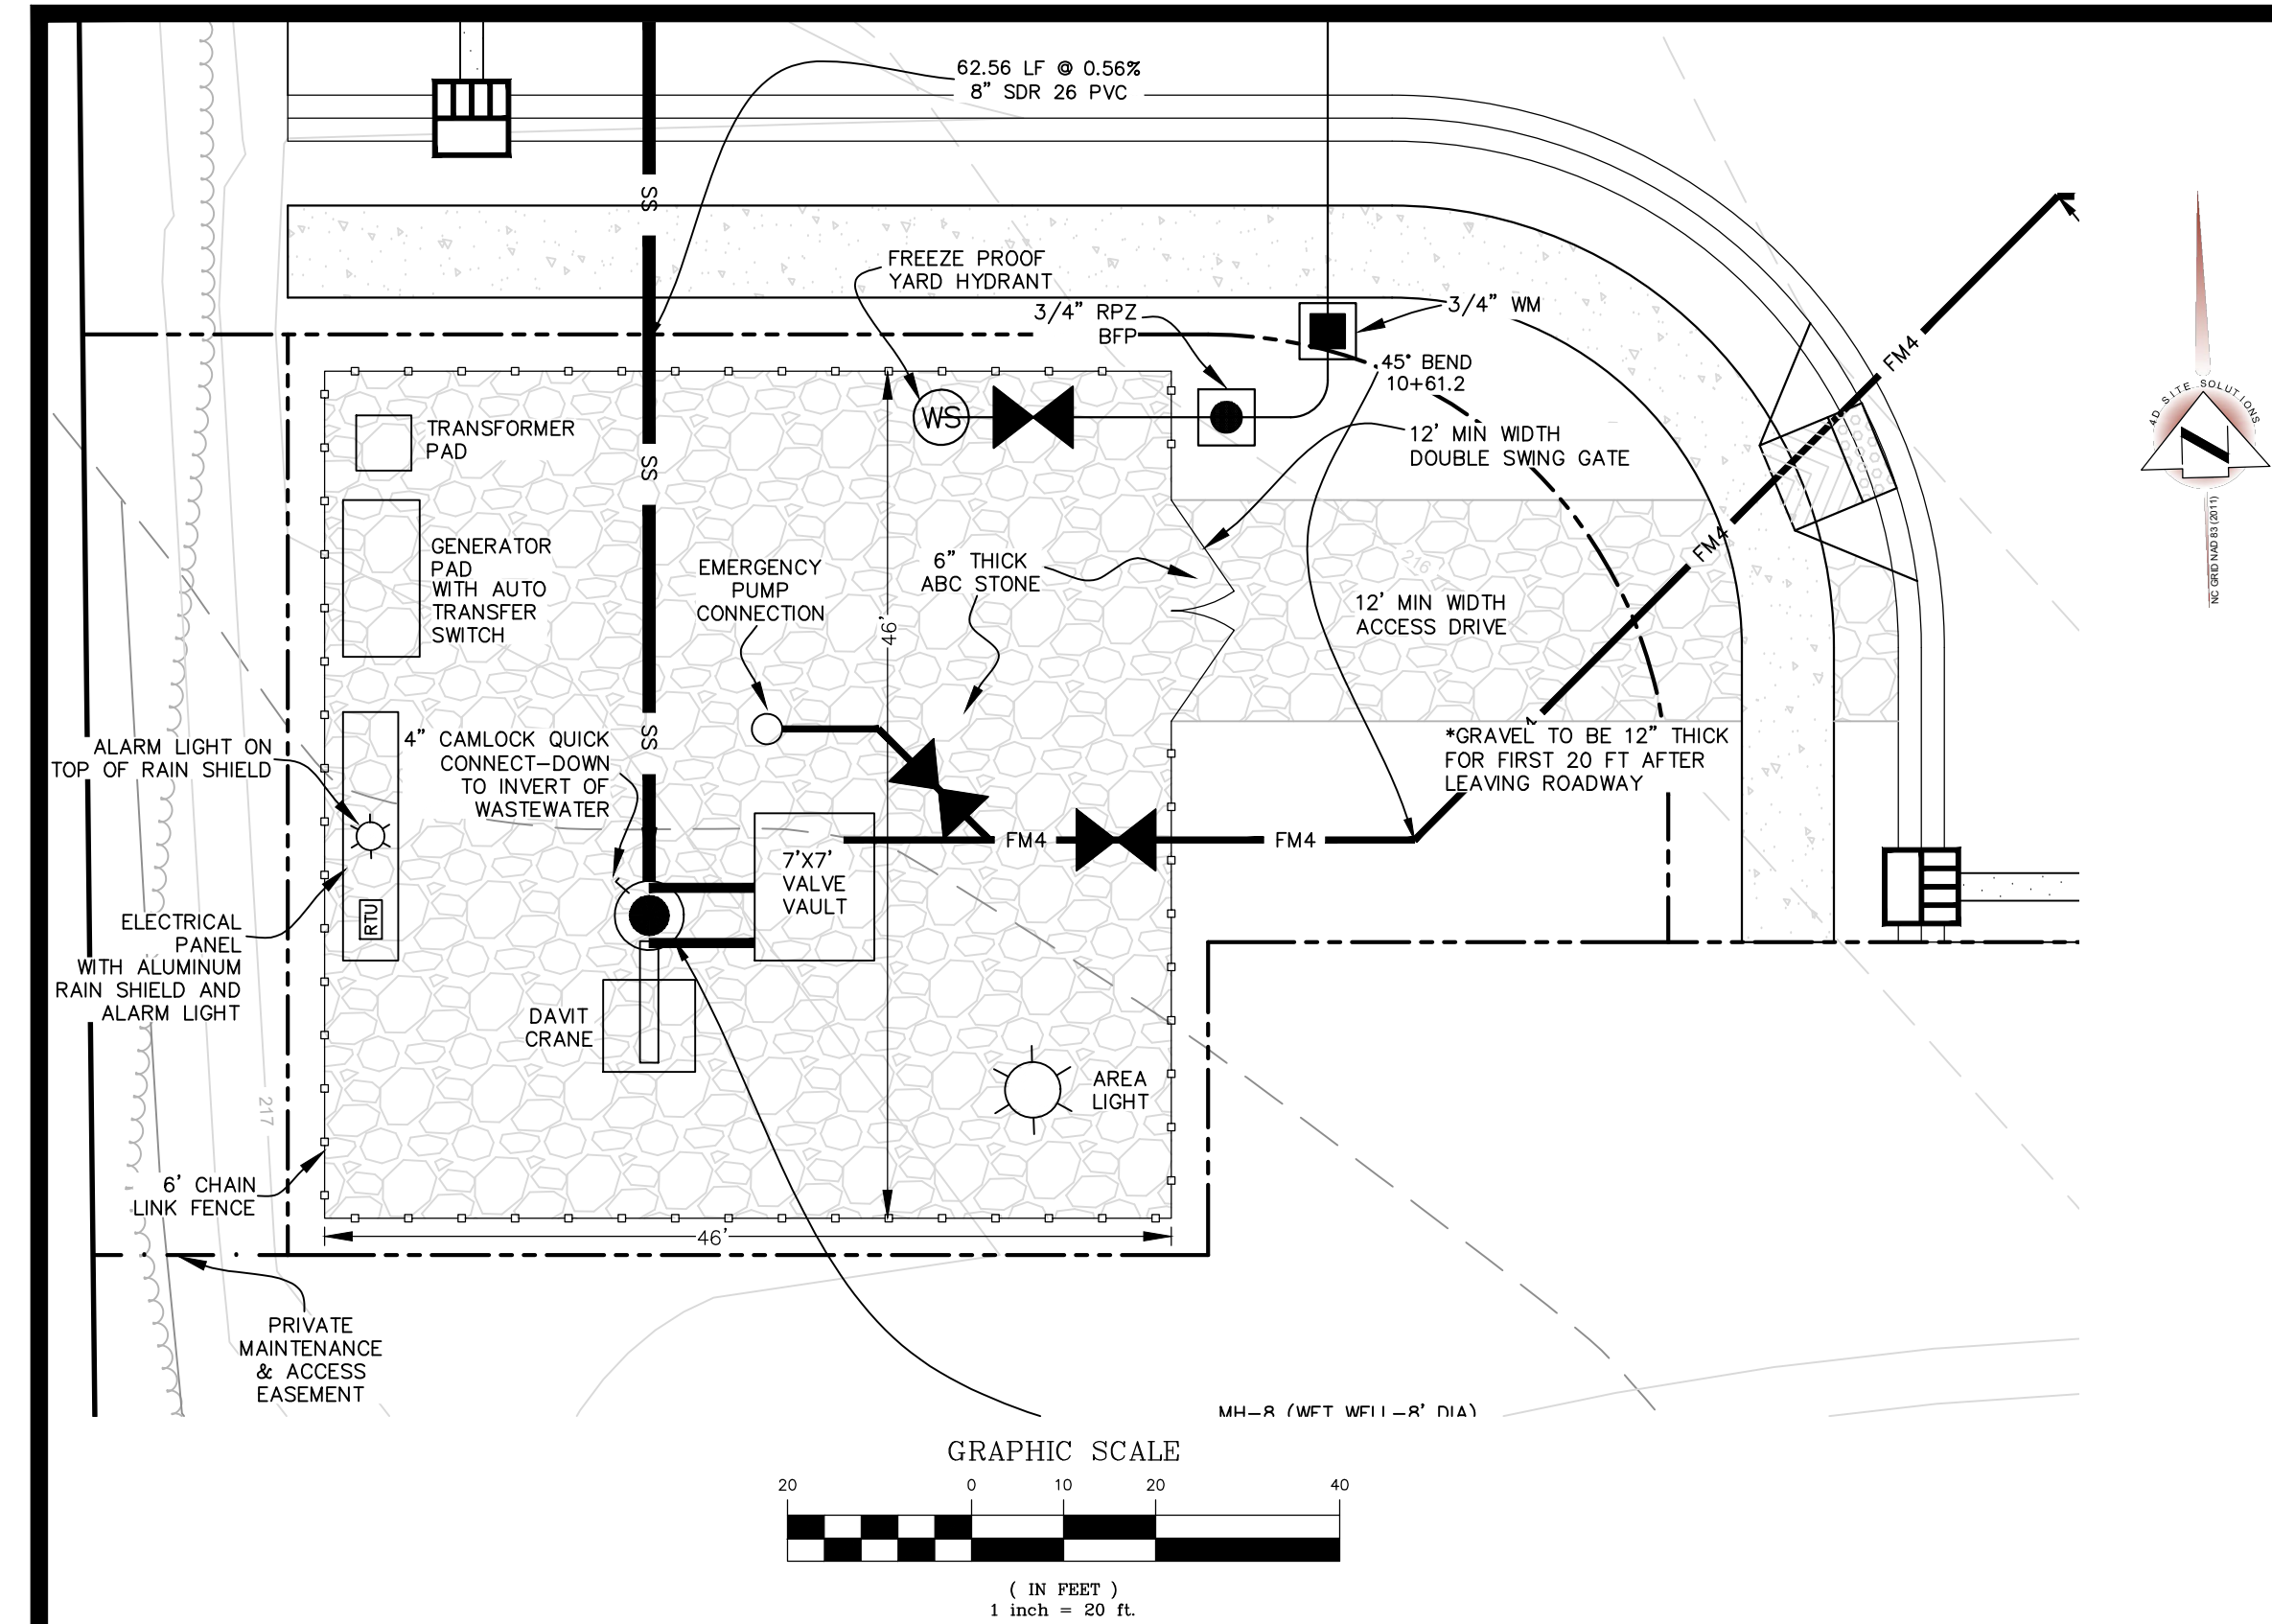


- TOWN OF LILLINGTON LIFT STATION REQUIREMENTS**
1. WET WELL SHALL BE INTERNALLY LINED WITH RAVEN 405 OR APPROVED EQUAL IN ACCORDANCE WITH "SEWER MATERIAL STANDARDS" SECTION 2,F,7.
  2. ALL BOLTS, MOUNTING BRACKETS, PUMP LIFTING CHAINS, ETC. SHALL BE STAINLESS STEEL AND SIZED AND MOUNTED TO SUPPORT APPLICABLE LOADS.
  3. ANCHOR POINTS FOR 5,000 LB RATING FALL PROTECTION AND SHALL HAVE TWO, ONE ON EACH SIDE OR ATOP OF THE WET WELL.
  4. LIFT STATION INSTALLATION SHALL FOLLOW ALL STANDARDS IN SECTION 6 OF THE TOWN OF LILLINGTON DETAILED SANITARY SEWER SPECIFICATIONS.

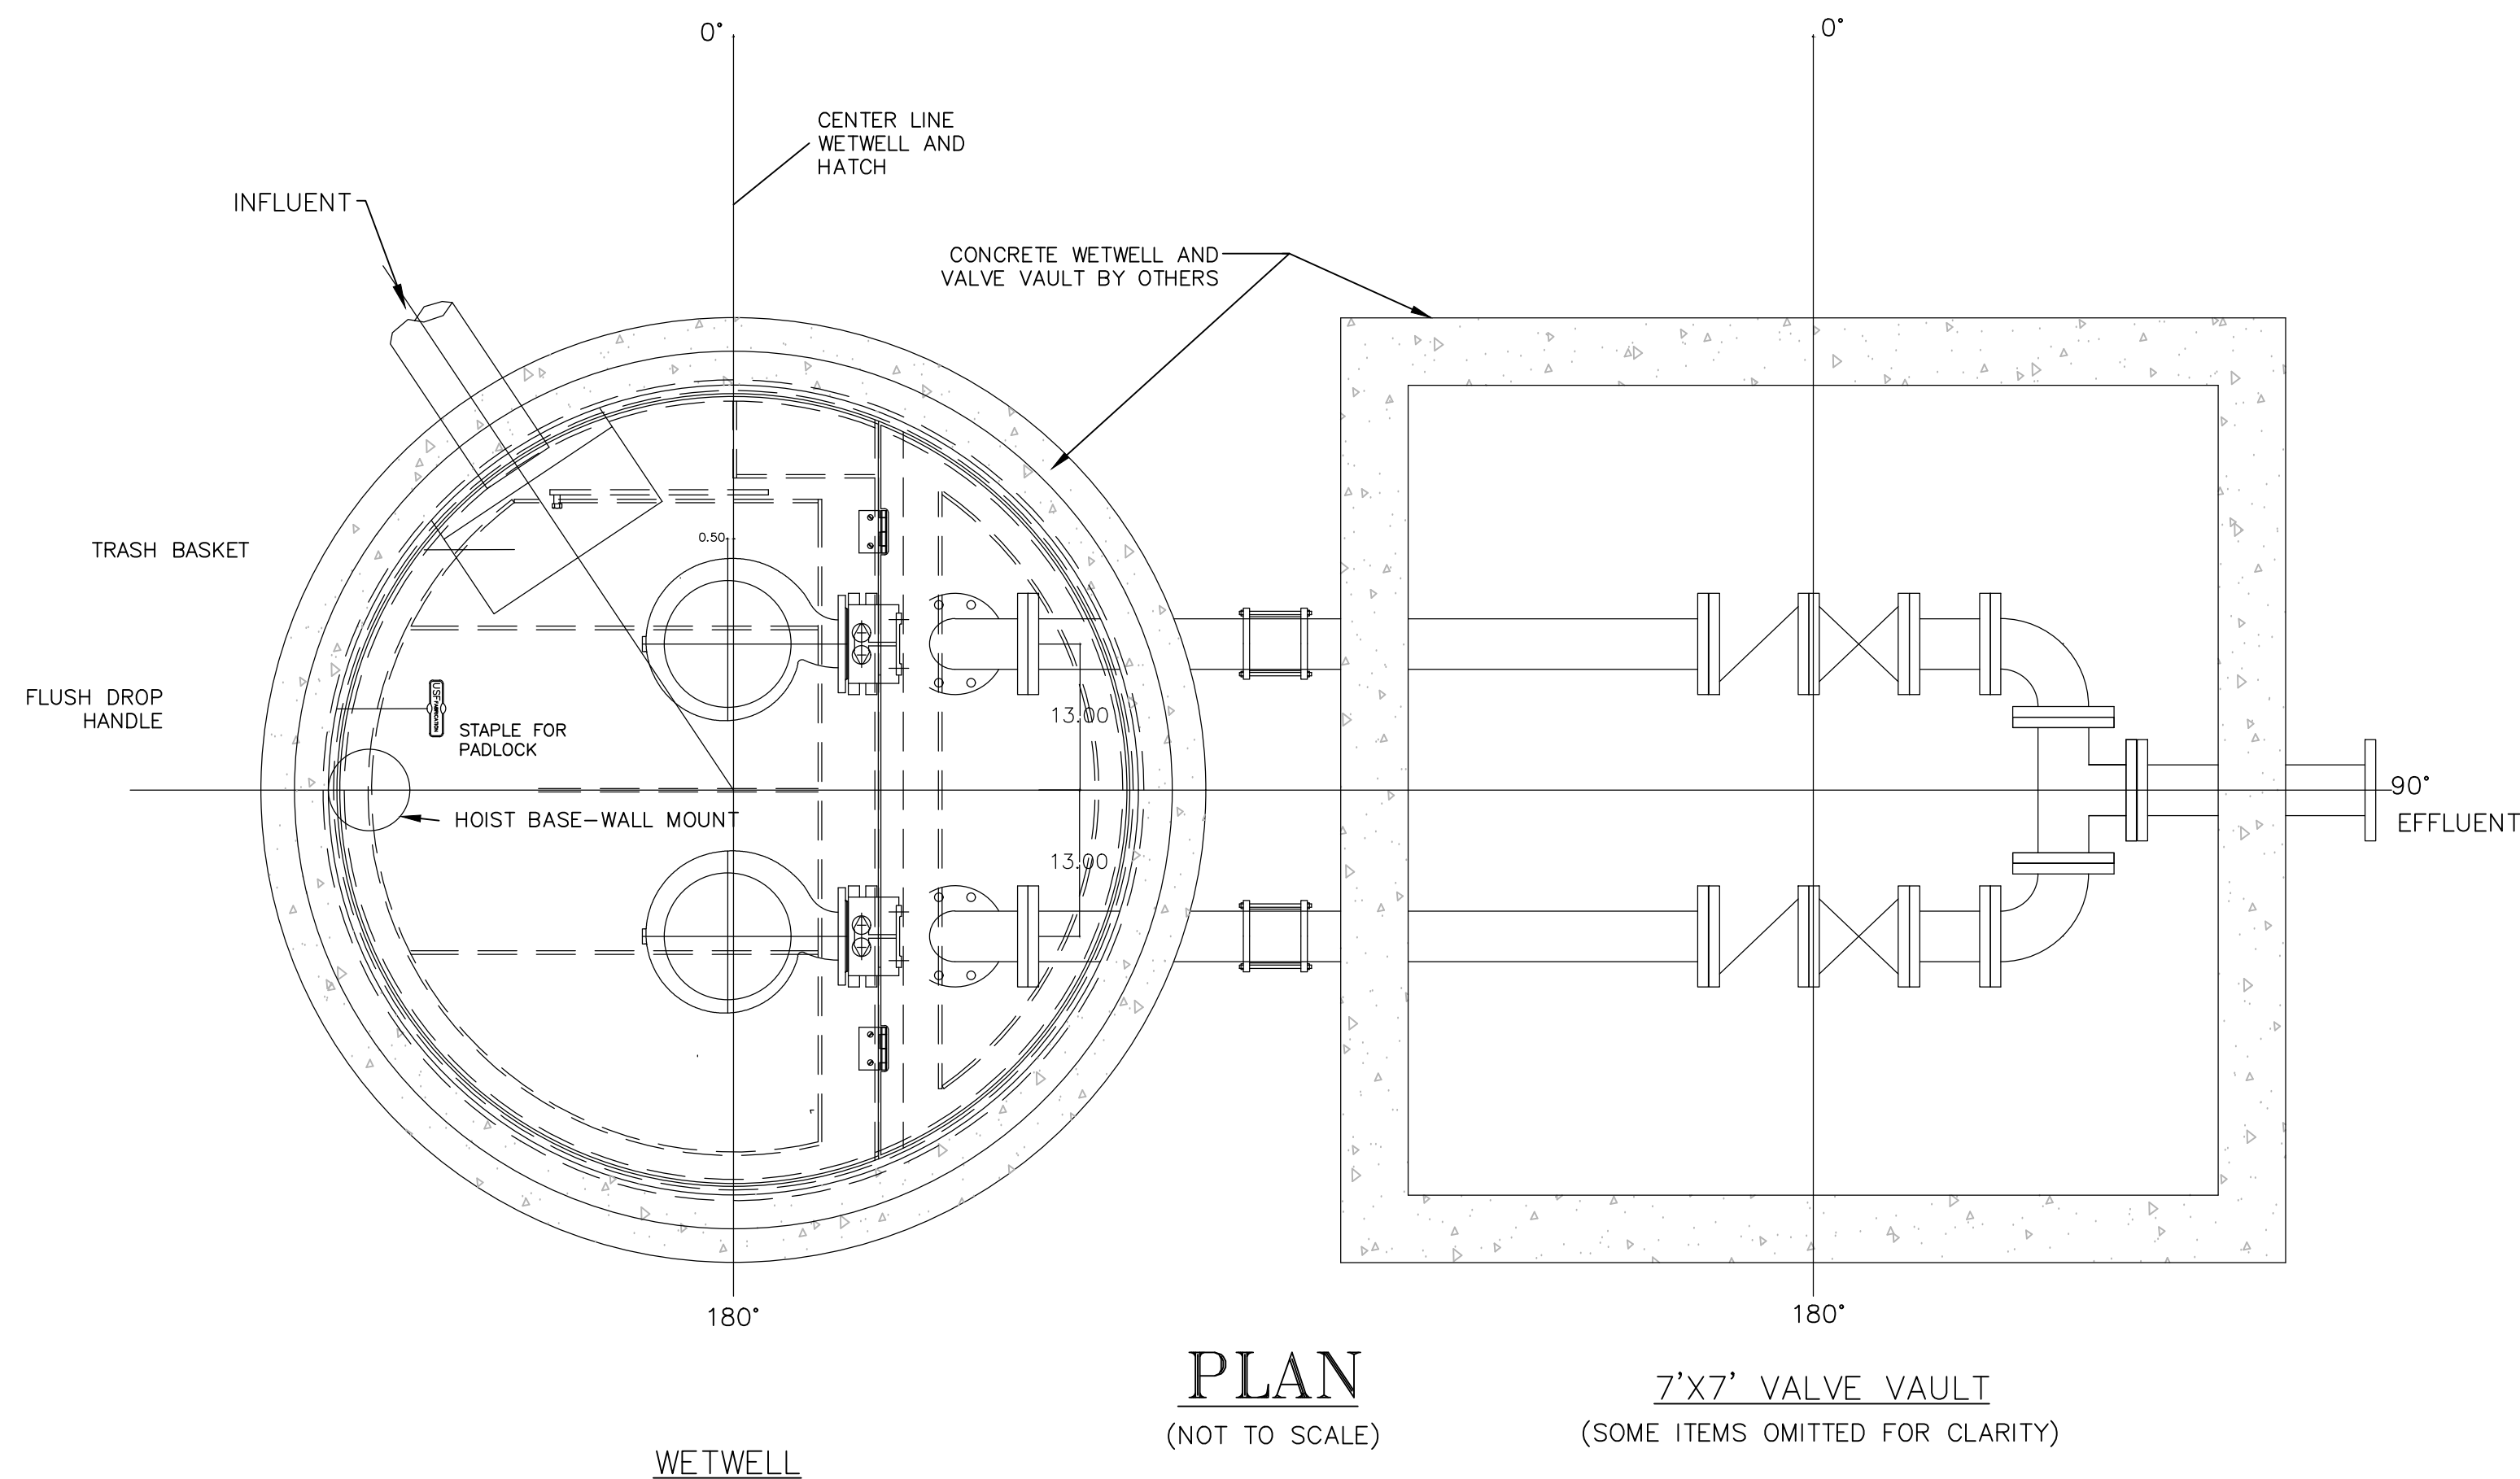

**PLAN**  
(NOT TO SCALE)

**7'X7' VALVE VAULT**  
(SOME ITEMS OMITTED FOR CLARITY)

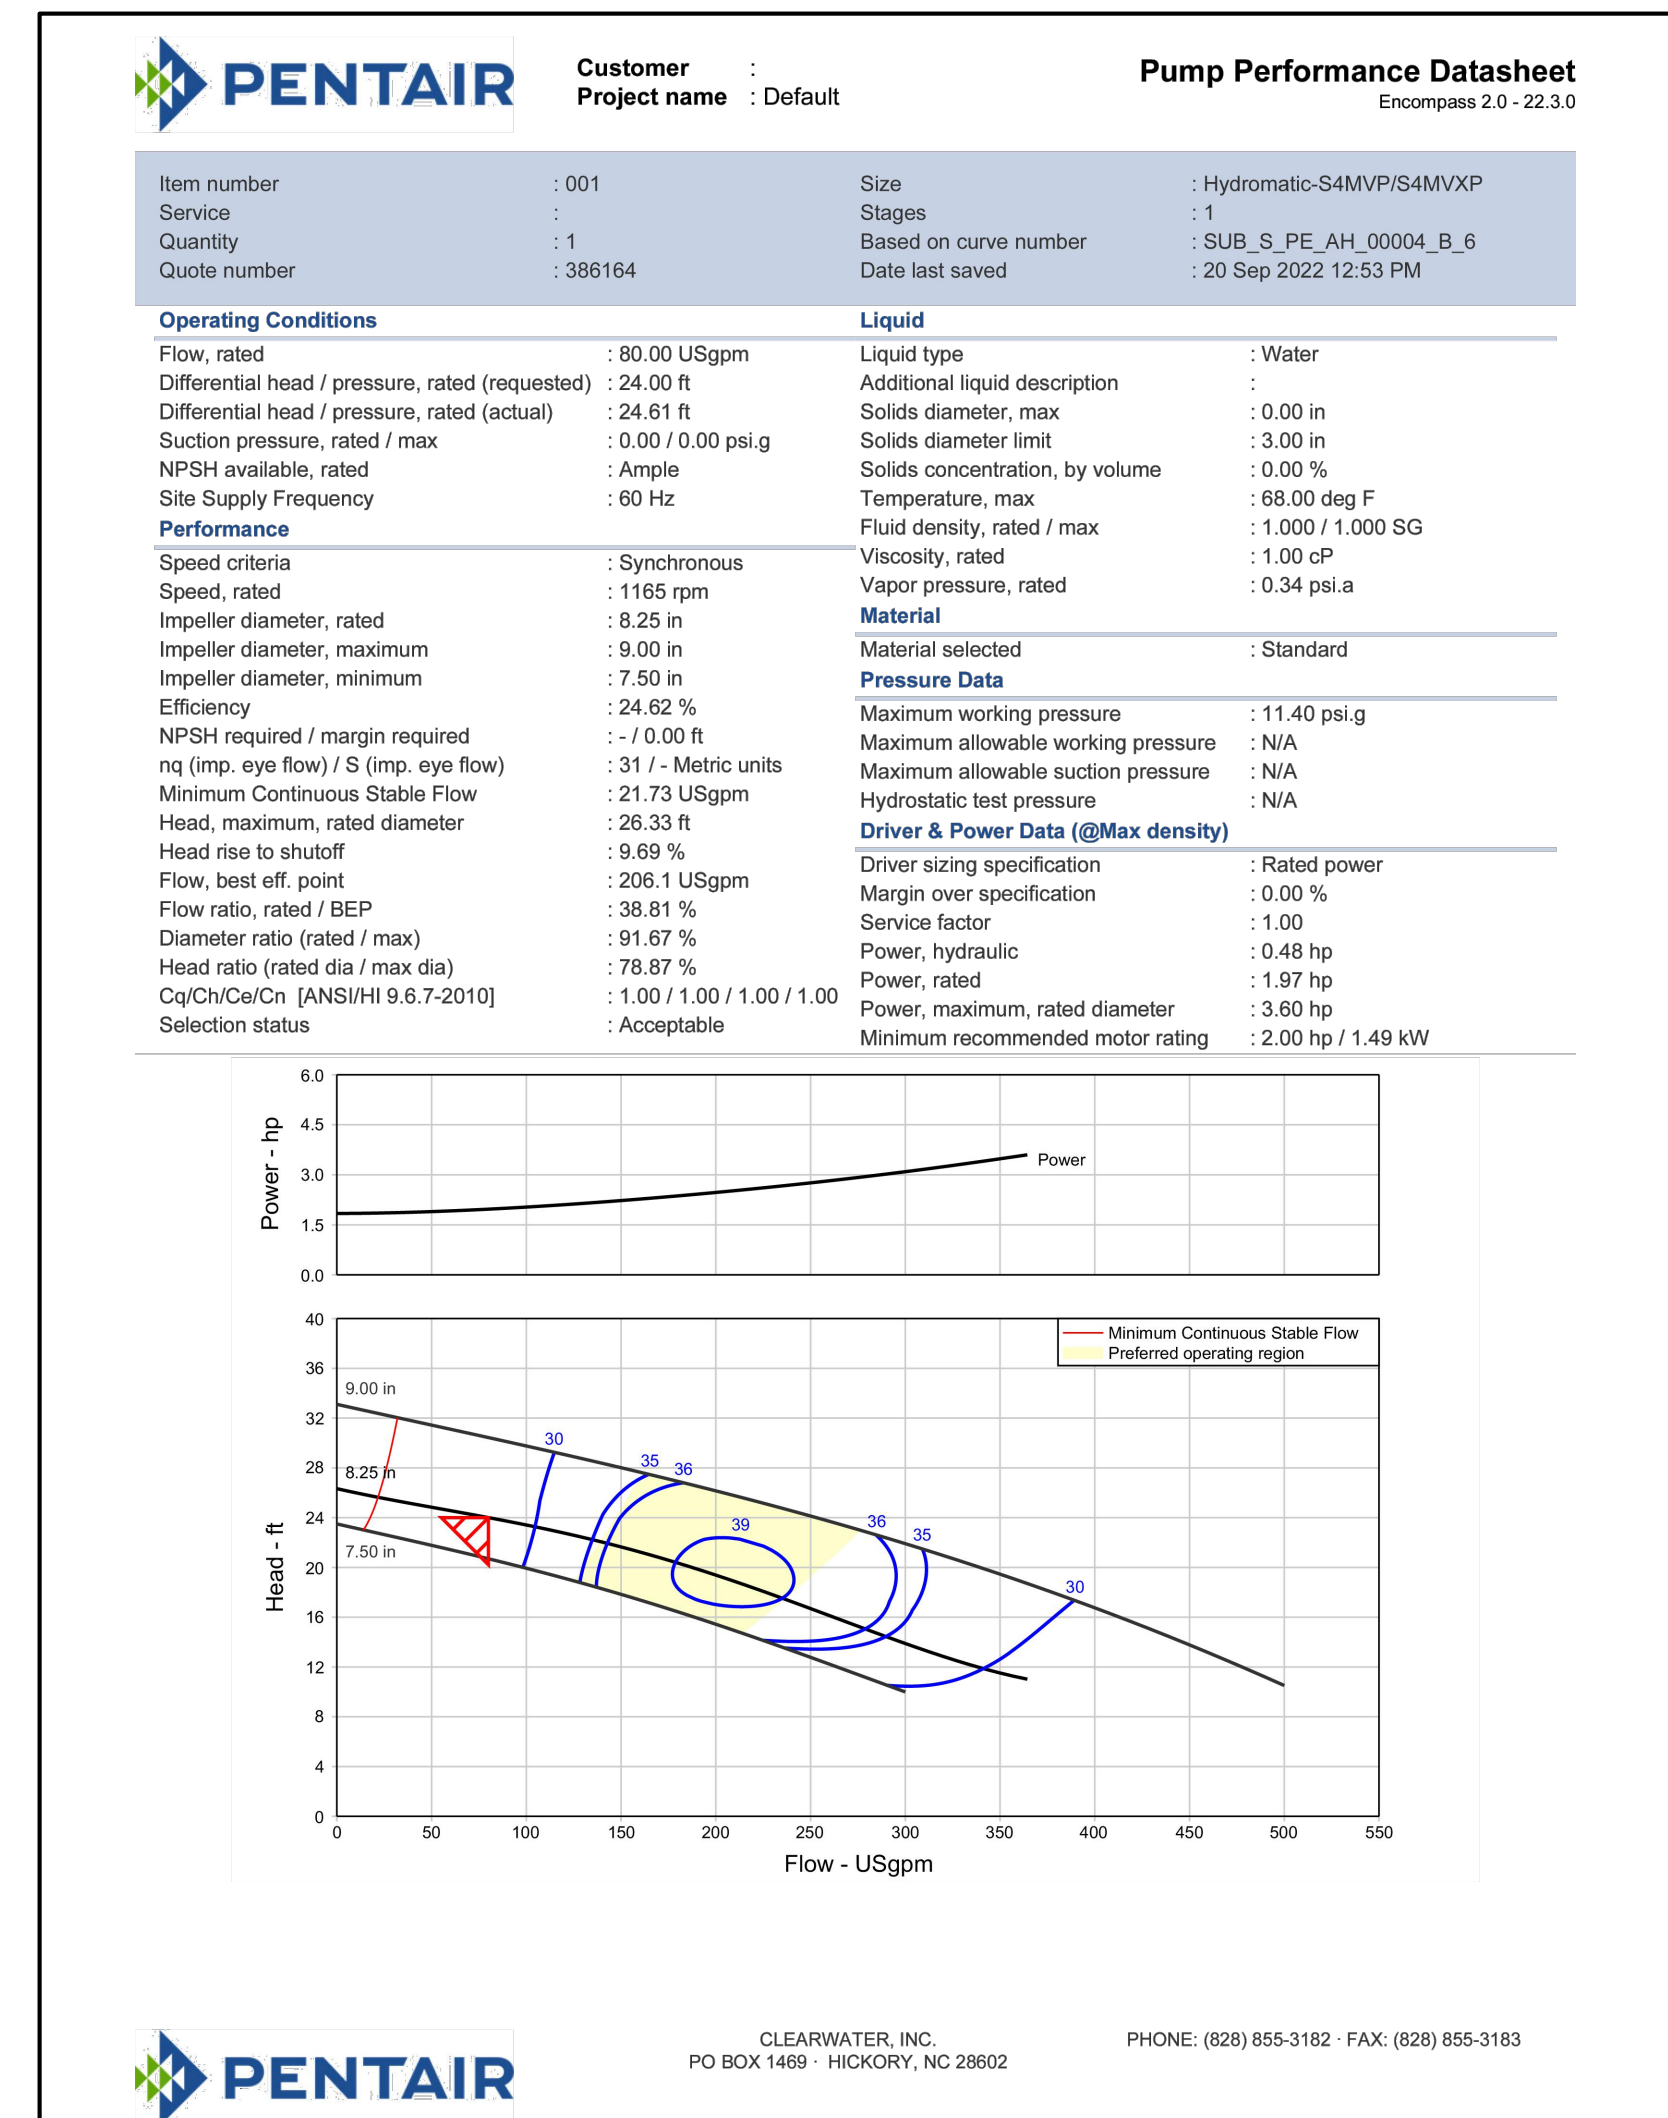

REVISIONS  
**ISSUED FOR CONSTRUCTION**

PROJECT NAME

**HARPER'S MEADOW**

**LIFT STATION DETAILS**

CLIENT

**TRIANGLE LAND PARTNERS, LLC**

PO Box 5548  
Cary, North Carolina 27512  
Phone: (704) 608-3085

PROJECT INFORMATION

DESIGNED BY:	CALEB
DRAWN BY:	CALEB
CHECKED BY:	SCOTT
PROJECT NUMBER:	1896

DRAWING SCALE

NOT TO SCALE

DATE RELEASED

MARCH 22, 2024


SHEET NUMBER

**C-6.9**



LUMINAIRE SCHEDULE

CALLOUT	SYMBOL	LAMP	DESCRIPTION	BALLAST	MOUNTING	MODEL	INPUT WATTS	VOLTS
A		(1) LED	8' LED STRIP WET LOCATION SUITABLE	ELECTRONIC	SURFACE		30	120V 1P 2W

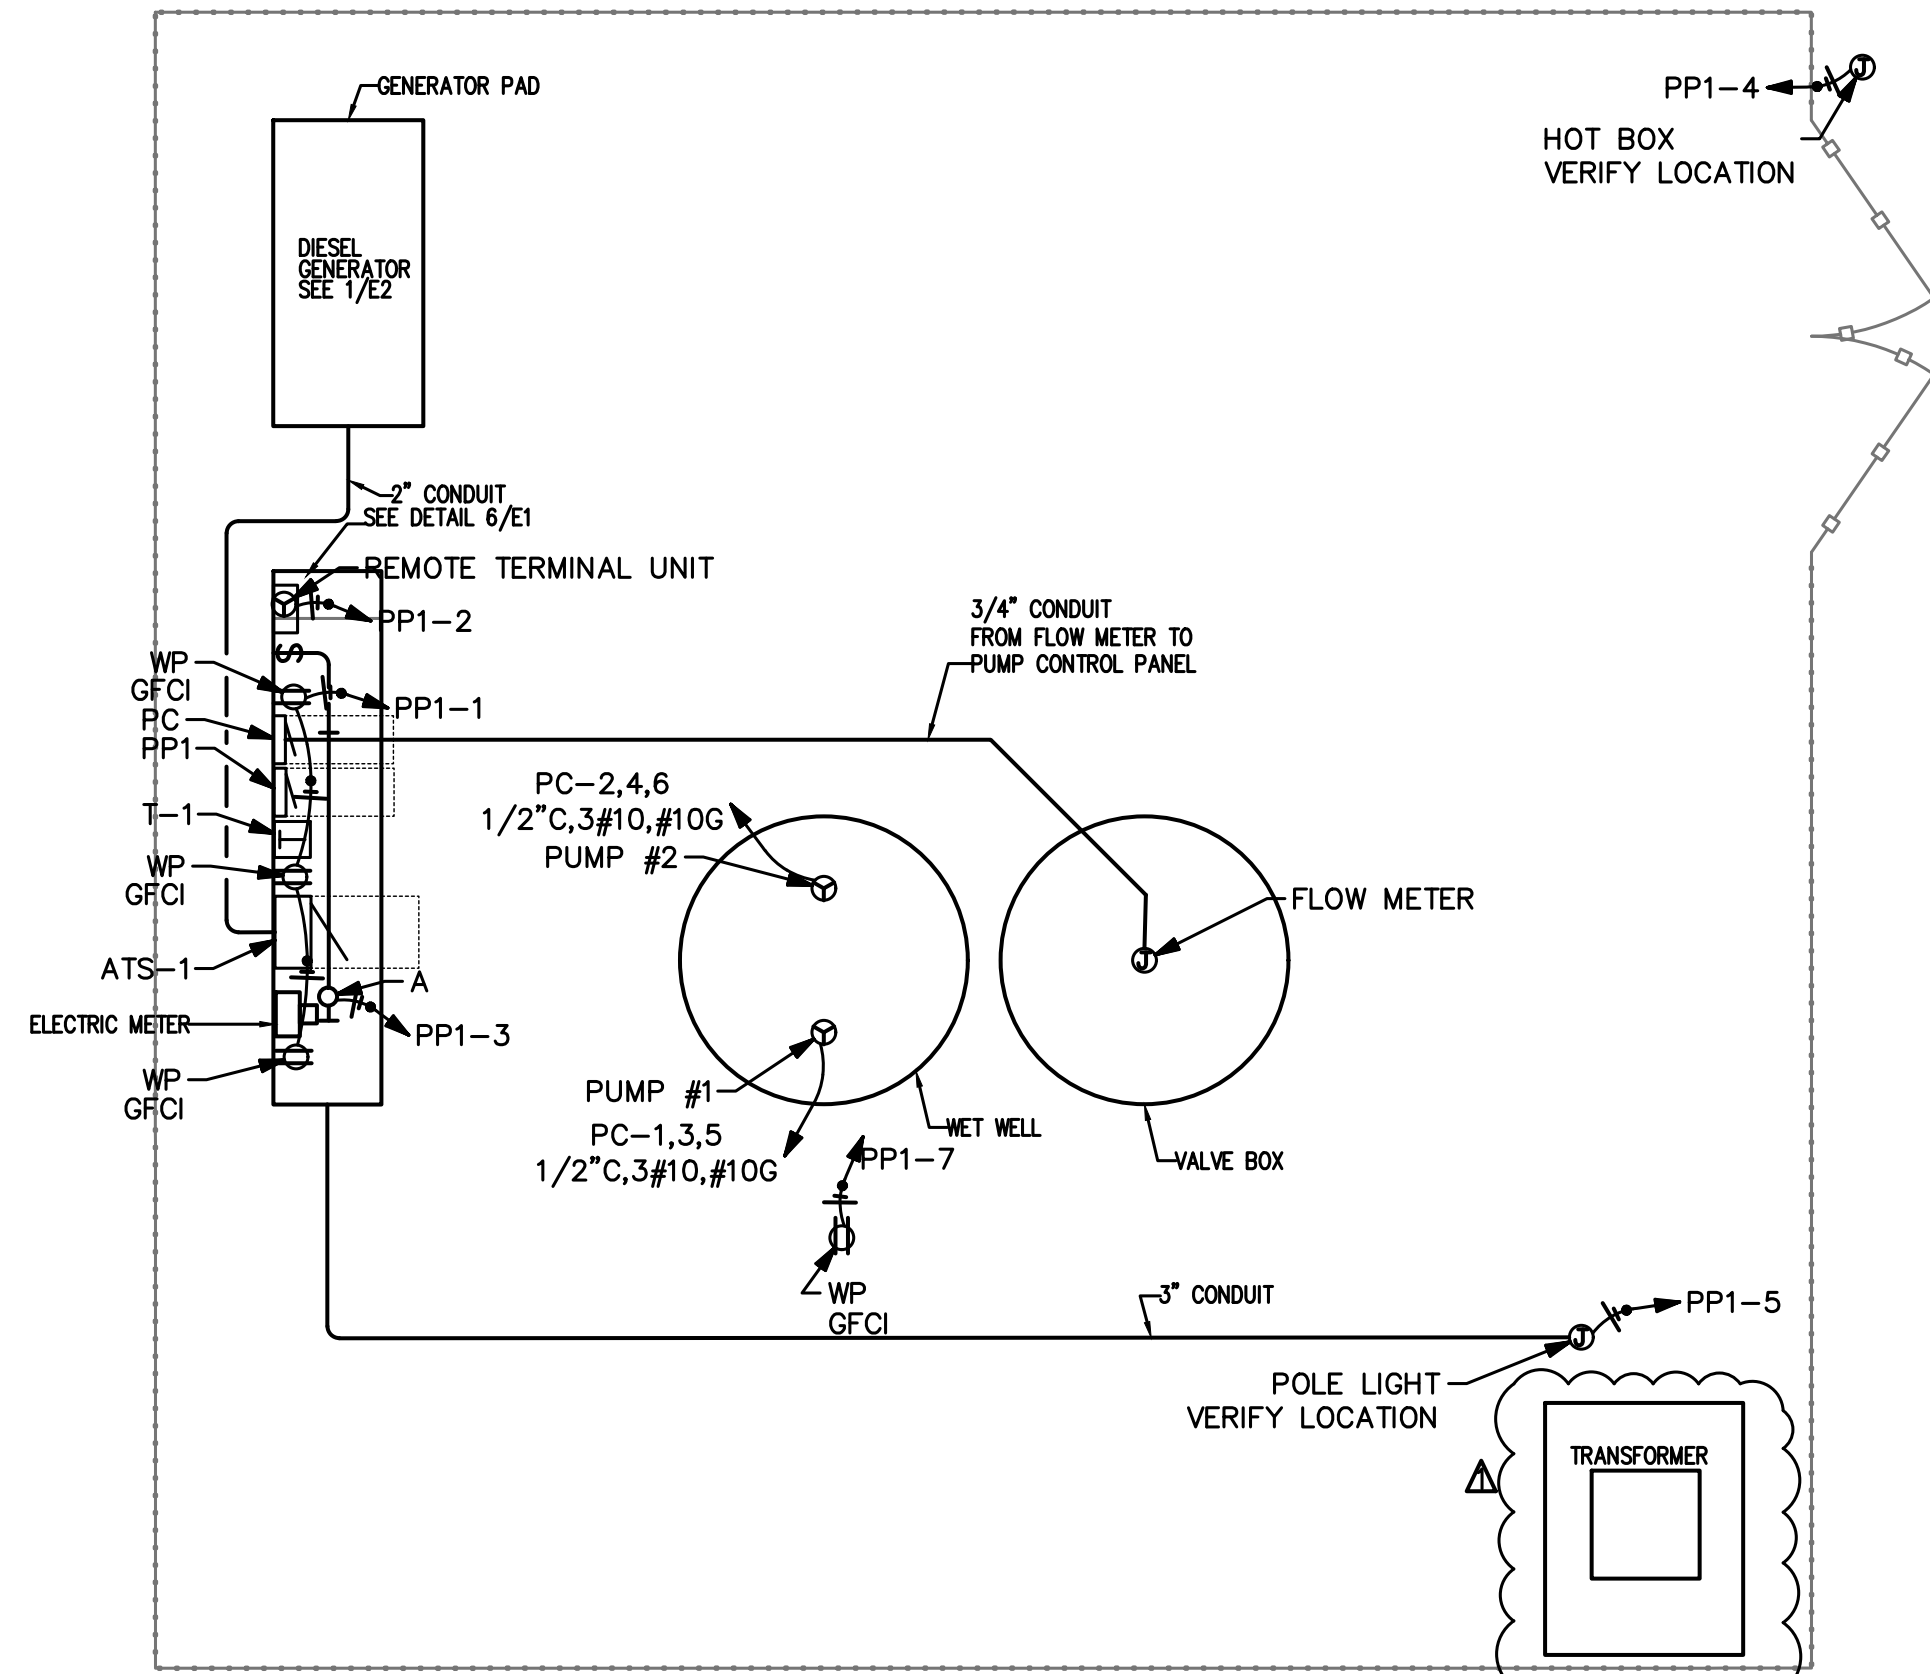


1 SITE ELECTRICAL PLAN  
E1 N.T.S.

NOTE: ALL WIRES (TO INCLUDE FLOATS) LEAVING THE WET WELL SHALL BE SPLICED INSIDE AN ELECTRICAL JUNCTION BOX JUST OUTSIDE THE WET WELL AND PROPERLY LABELED ON BOTH ENDS BEFORE CONTINUING TO THE CONTROL BOX.

ALL ELECTRICAL WORK MUST MEET TOWN OF LILLINGTON STANDARDS

120 V.A.C. FLASHING RED ALARM LIGHT (DAYTIME VISIBLE) & ALARM BELL, WP. BENJAMIN FARADAY OR EQUAL.

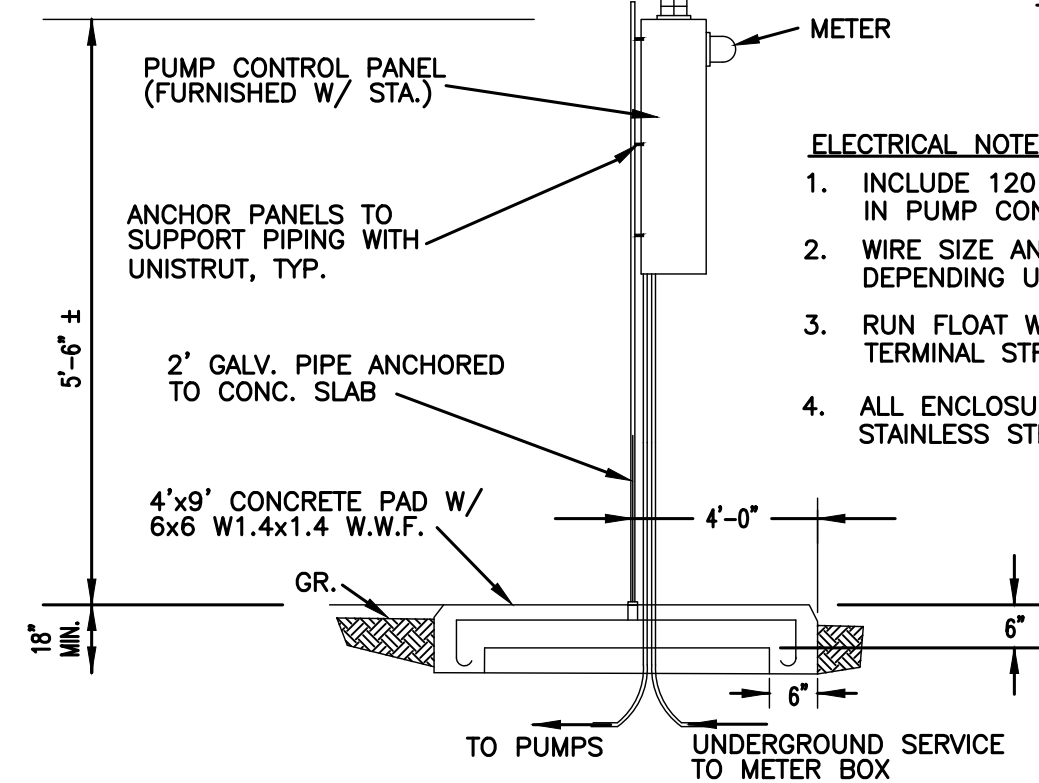

5 CONTROL RACK SIDE VIEW  
E1 N.T.S.

NOTE: SEE ONE LINE DIAGRAM THIS SHEET


ELECTRICAL NOTES:

1. INCLUDE 120 V SERVICE OUTLET IN PUMP CONTROL PANEL.
2. WIRE SIZE AND CONDUIT SIZE MAY VARY DEPENDING UPON PUMP REQUIREMENTS.
3. RUN FLOAT WIRES FROM WETWELL THROUGH TERMINAL STRIP IN JUNCTION BOX TO PANEL.
4. ALL ENCLOSURES SHALL BE NEMA 4X STAINLESS STEEL.


\*NOTES\*

1. BACKING PLATE TO BE 1/4" ALUMINUM. MOUNT TO "I" BEAM POSTS WITH STAINLESS STEEL NUT, BOLTS, AND WASHERS.
2. ALL ELECTRICAL WORK SHALL CONFORM TO LATEST NATIONAL, STATE AND LOCAL CODES AND REQUIREMENTS.
3. SHOW CONDUIT SIZE AND RUNS WITH WIRE SIZE AND NUMBER ON PUMP STATION PLANS.
4. PANEL LAYOUT IS SCHEMATIC ONLY. ADJUST AS NEEDED TO ACCOMMODATE EQUIPMENT. MAINTAIN 4" MIN. CLEARANCE BETWEEN PANELS AND SIDE SHIELDS.
5. ALL ENCLOSURES SHALL BE NEMA 4X RATED AND LOCKABLE.
6. ENCLOSURES SHALL BE MOUNTED TO ALUMINUM BACKING PLATE WITH NYLON SPACERS & STAINLESS STEEL NUTS BOLTS & WASHERS.
7. CONDUIT SHALL BE RIDGID ALUMINUM OR GALVANIZED. MEYERS HUBS SHALL BE USED AT ALL PANEL CONNECTIONS.
8. NO EQUIPMENT SHALL BE MOUNTED LESS THAN 36" ABOVE FINISHED GRADE. MIN. CLEARANCE FROM WORK LIGHT TO STANDING RAIN SHALL BE 6' 6".
9. FOR RAIN HOOD DETAIL SEE 3/E1.

6 CONTROL RACK DETAIL  
E1 N.T.S.

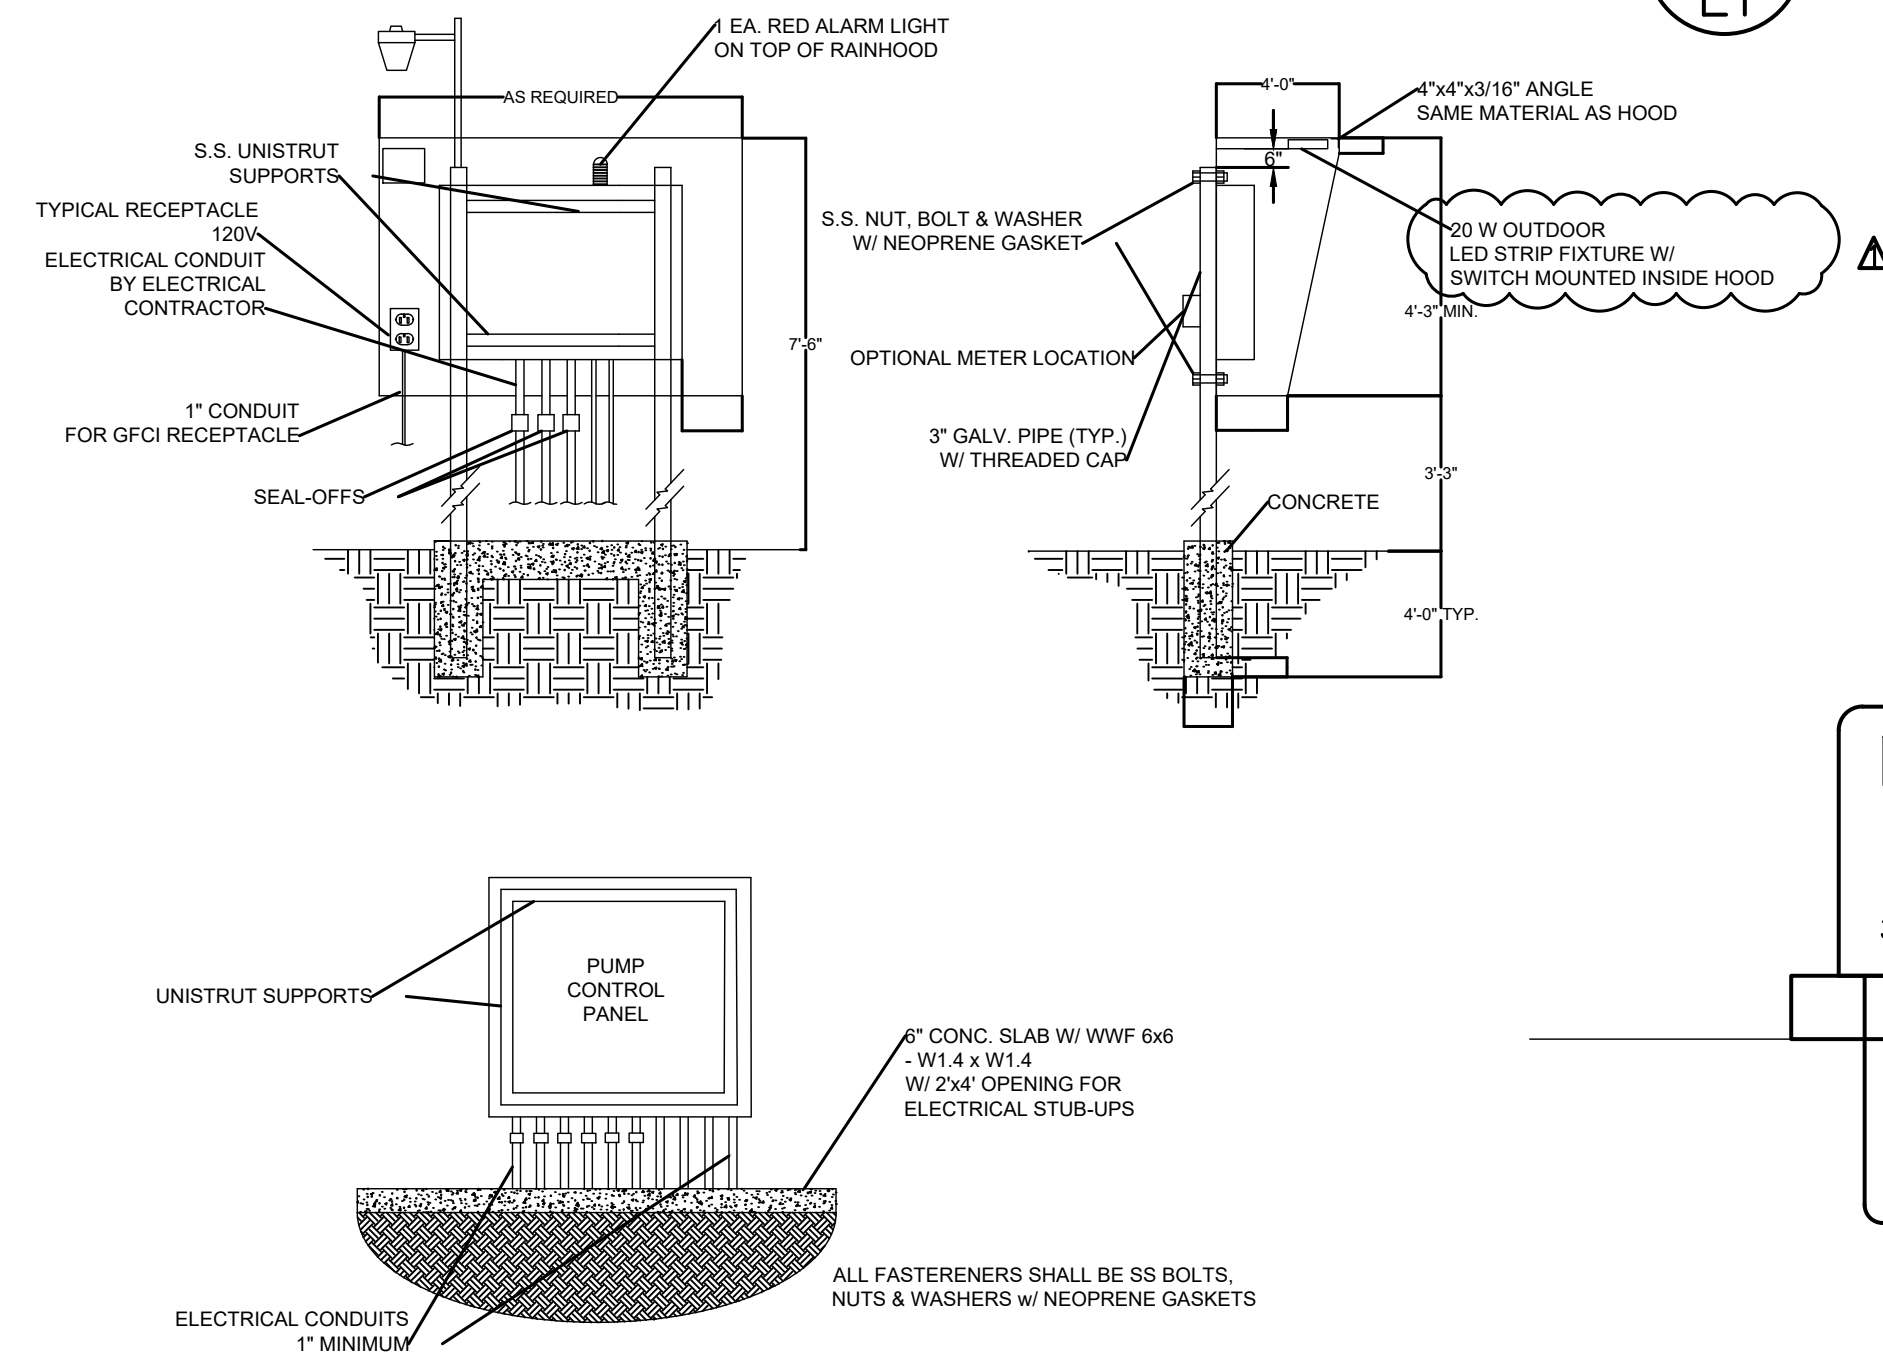

3 RAIN HOOD DETAILS  
E1 N.T.S.

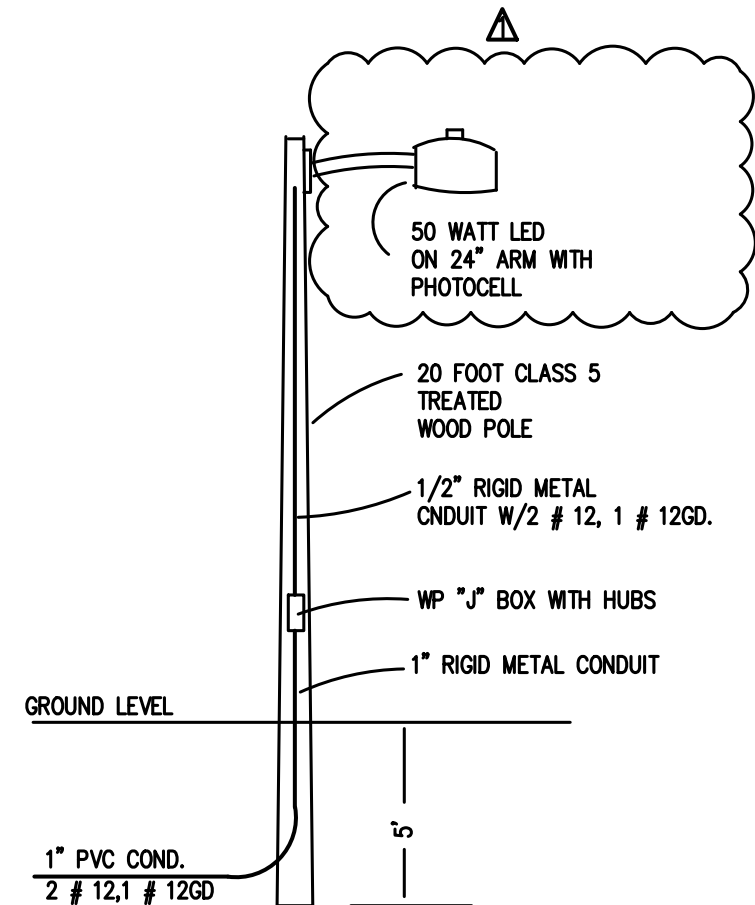


2 EXTERIOR POLE LIGHT  
E1 N.T.S.

GROUNDING ELECTRODE DETAILS

GROUNDING ELECTRODE CONDUCTORS SHALL BE #8 BARE COPPER. OTHER MATERIAL AND INSTALLATION PER NEC 250

1. #8 CONNECT TO METALLIC WATER PIPE AS REQ'D.
2. #8 TO BUILDING STEEL OR FOUNDATION REBAR
3. 3/4"x10' LONG COPPER CLAD GROUNDING ROD W/ #6 COPPER GROUND.

4 ELEC. RISER DETAIL  
E1 N.T.S.

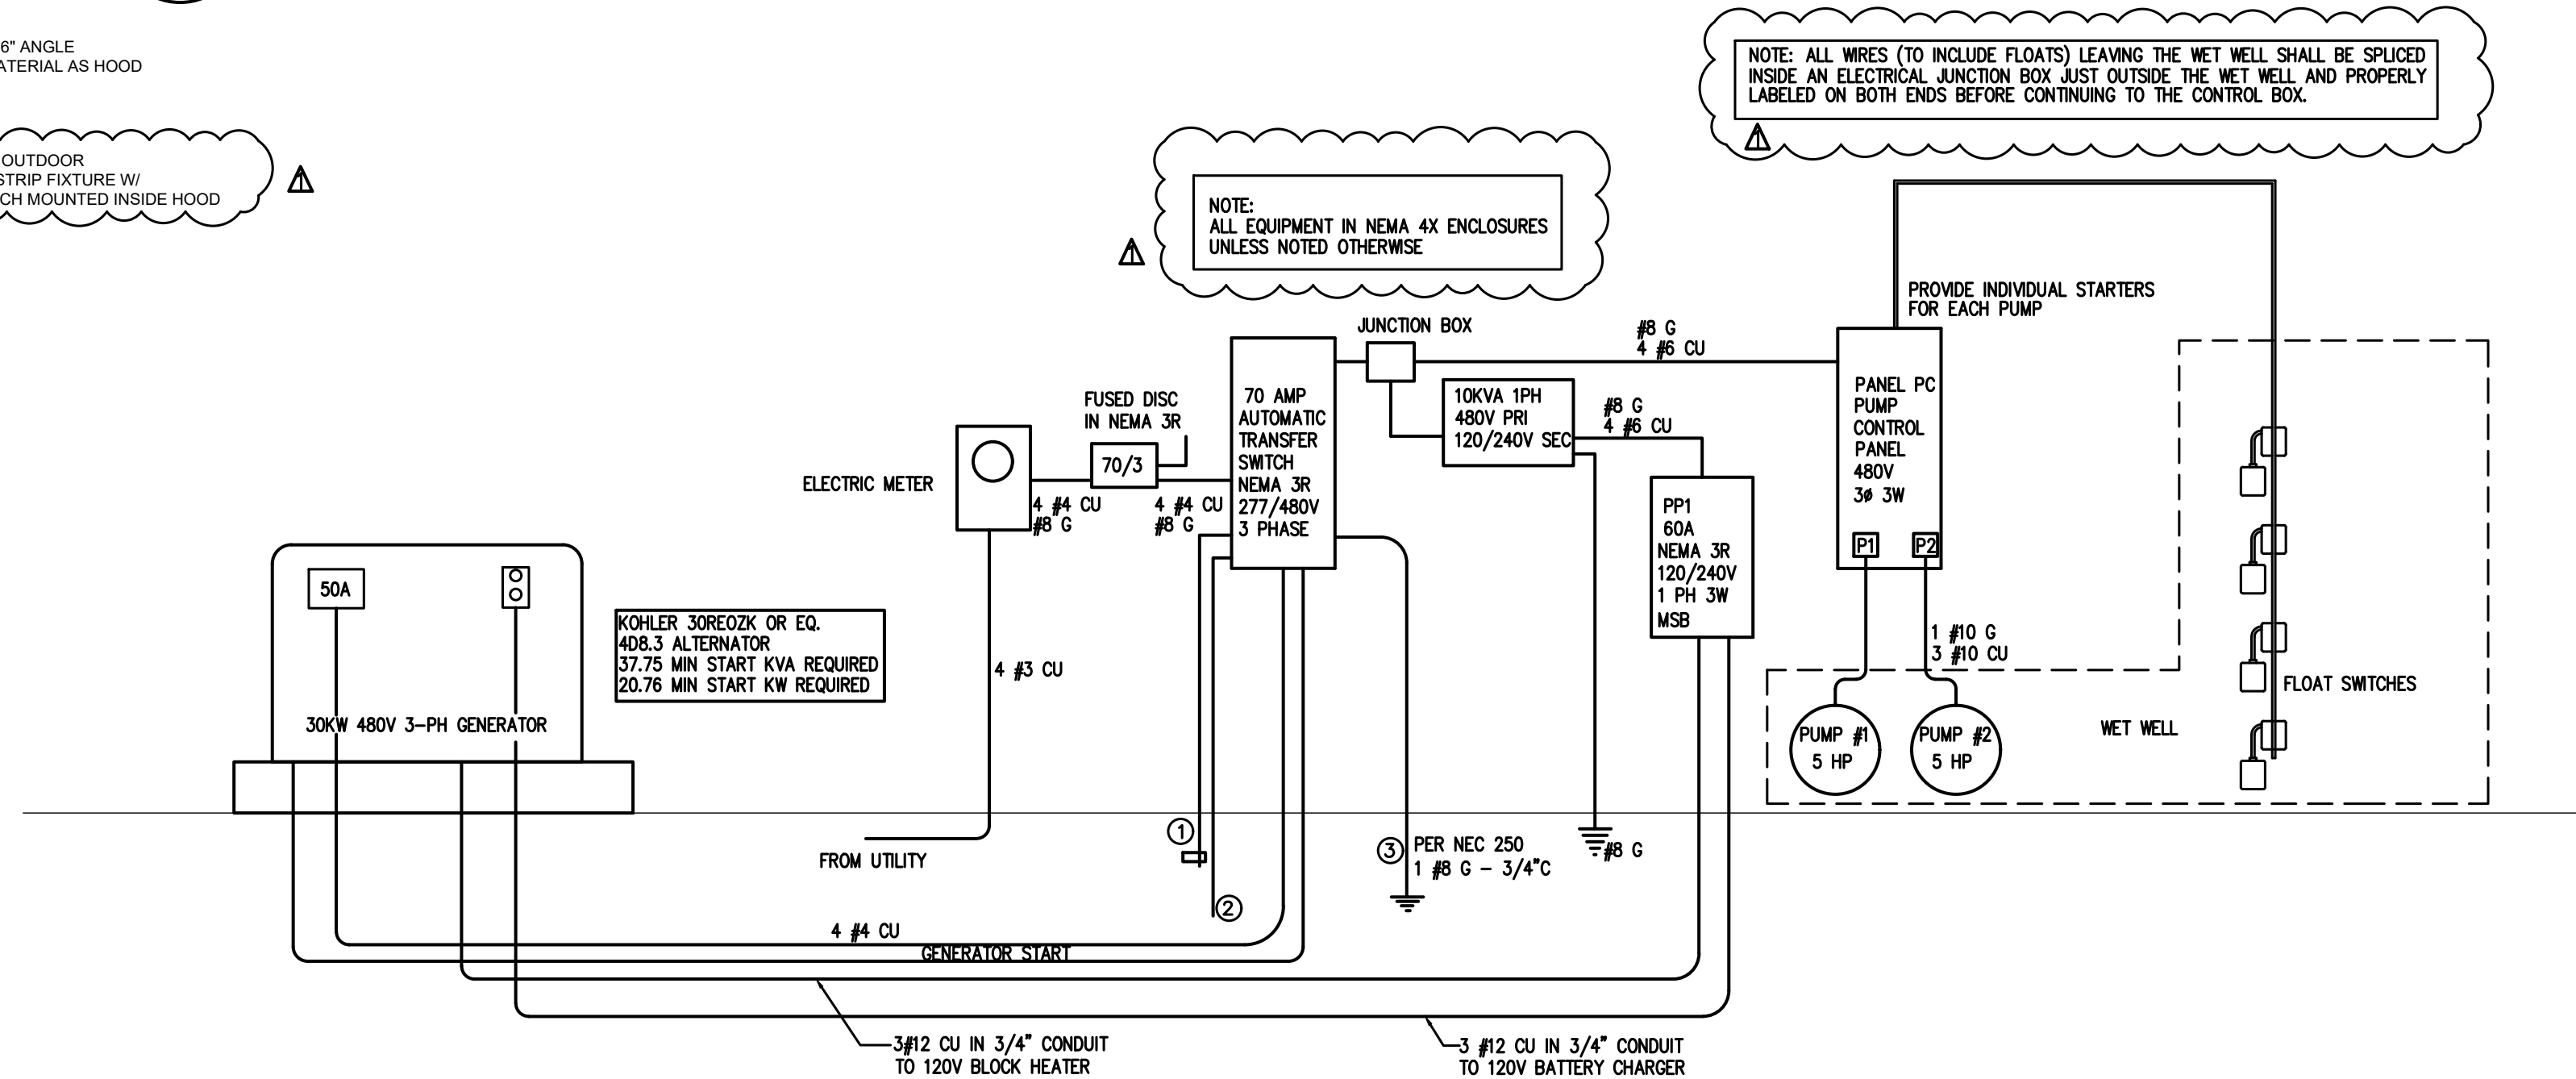

Aug 24, 2023



Coastal Plains Engineering, P.A.

License No. C-3090

285 Locklear Rd  
P.O. Box 1117  
Pembroke, NC 28572  
www.coastalplainseng.com

HARPERS MEADOW  
LIFT STATION

LILLINGTON, NC 27546

DRAWINGS AND THE DESIGN ARE THE PROPERTY OF THE ENGINEER. WHETHER THE PROJECT FOR WHICH THEY ARE PREPARED IS EXECUTED OR NOT, THE DRAWINGS SHALL NOT BE USED BY THE PROJECT OWNER OR ANYONE ELSE FOR ANY OTHER PROJECT.


ADA AND LEGAL DISCLAIMER  
THIS DOCUMENT IS INTENDED TO COMPLY WITH THE REQUIREMENTS OF THE AMERICANS WITH DISABILITIES ACT (ADA). ARCHITECTS AND ENGINEERS ARE NOT LICENSED TO INTERPRET LAWS OR GIVE ADVICE CONCERNING LAWS OR LEGAL MATTERS. THE OWNER SHOULD HAVE THIS DOCUMENT REVIEWED BY HIS ATTORNEY TO DETERMINE IF IT COMPLEYS ADA AND OTHER LAWS.

PROJECT NO	2023-025
DRAWN BY	WJ
CHECKED BY	CSL
DATE	02-20-23
REVISIONS	REVIEW COMMENTS

SHEET NO:

E-1



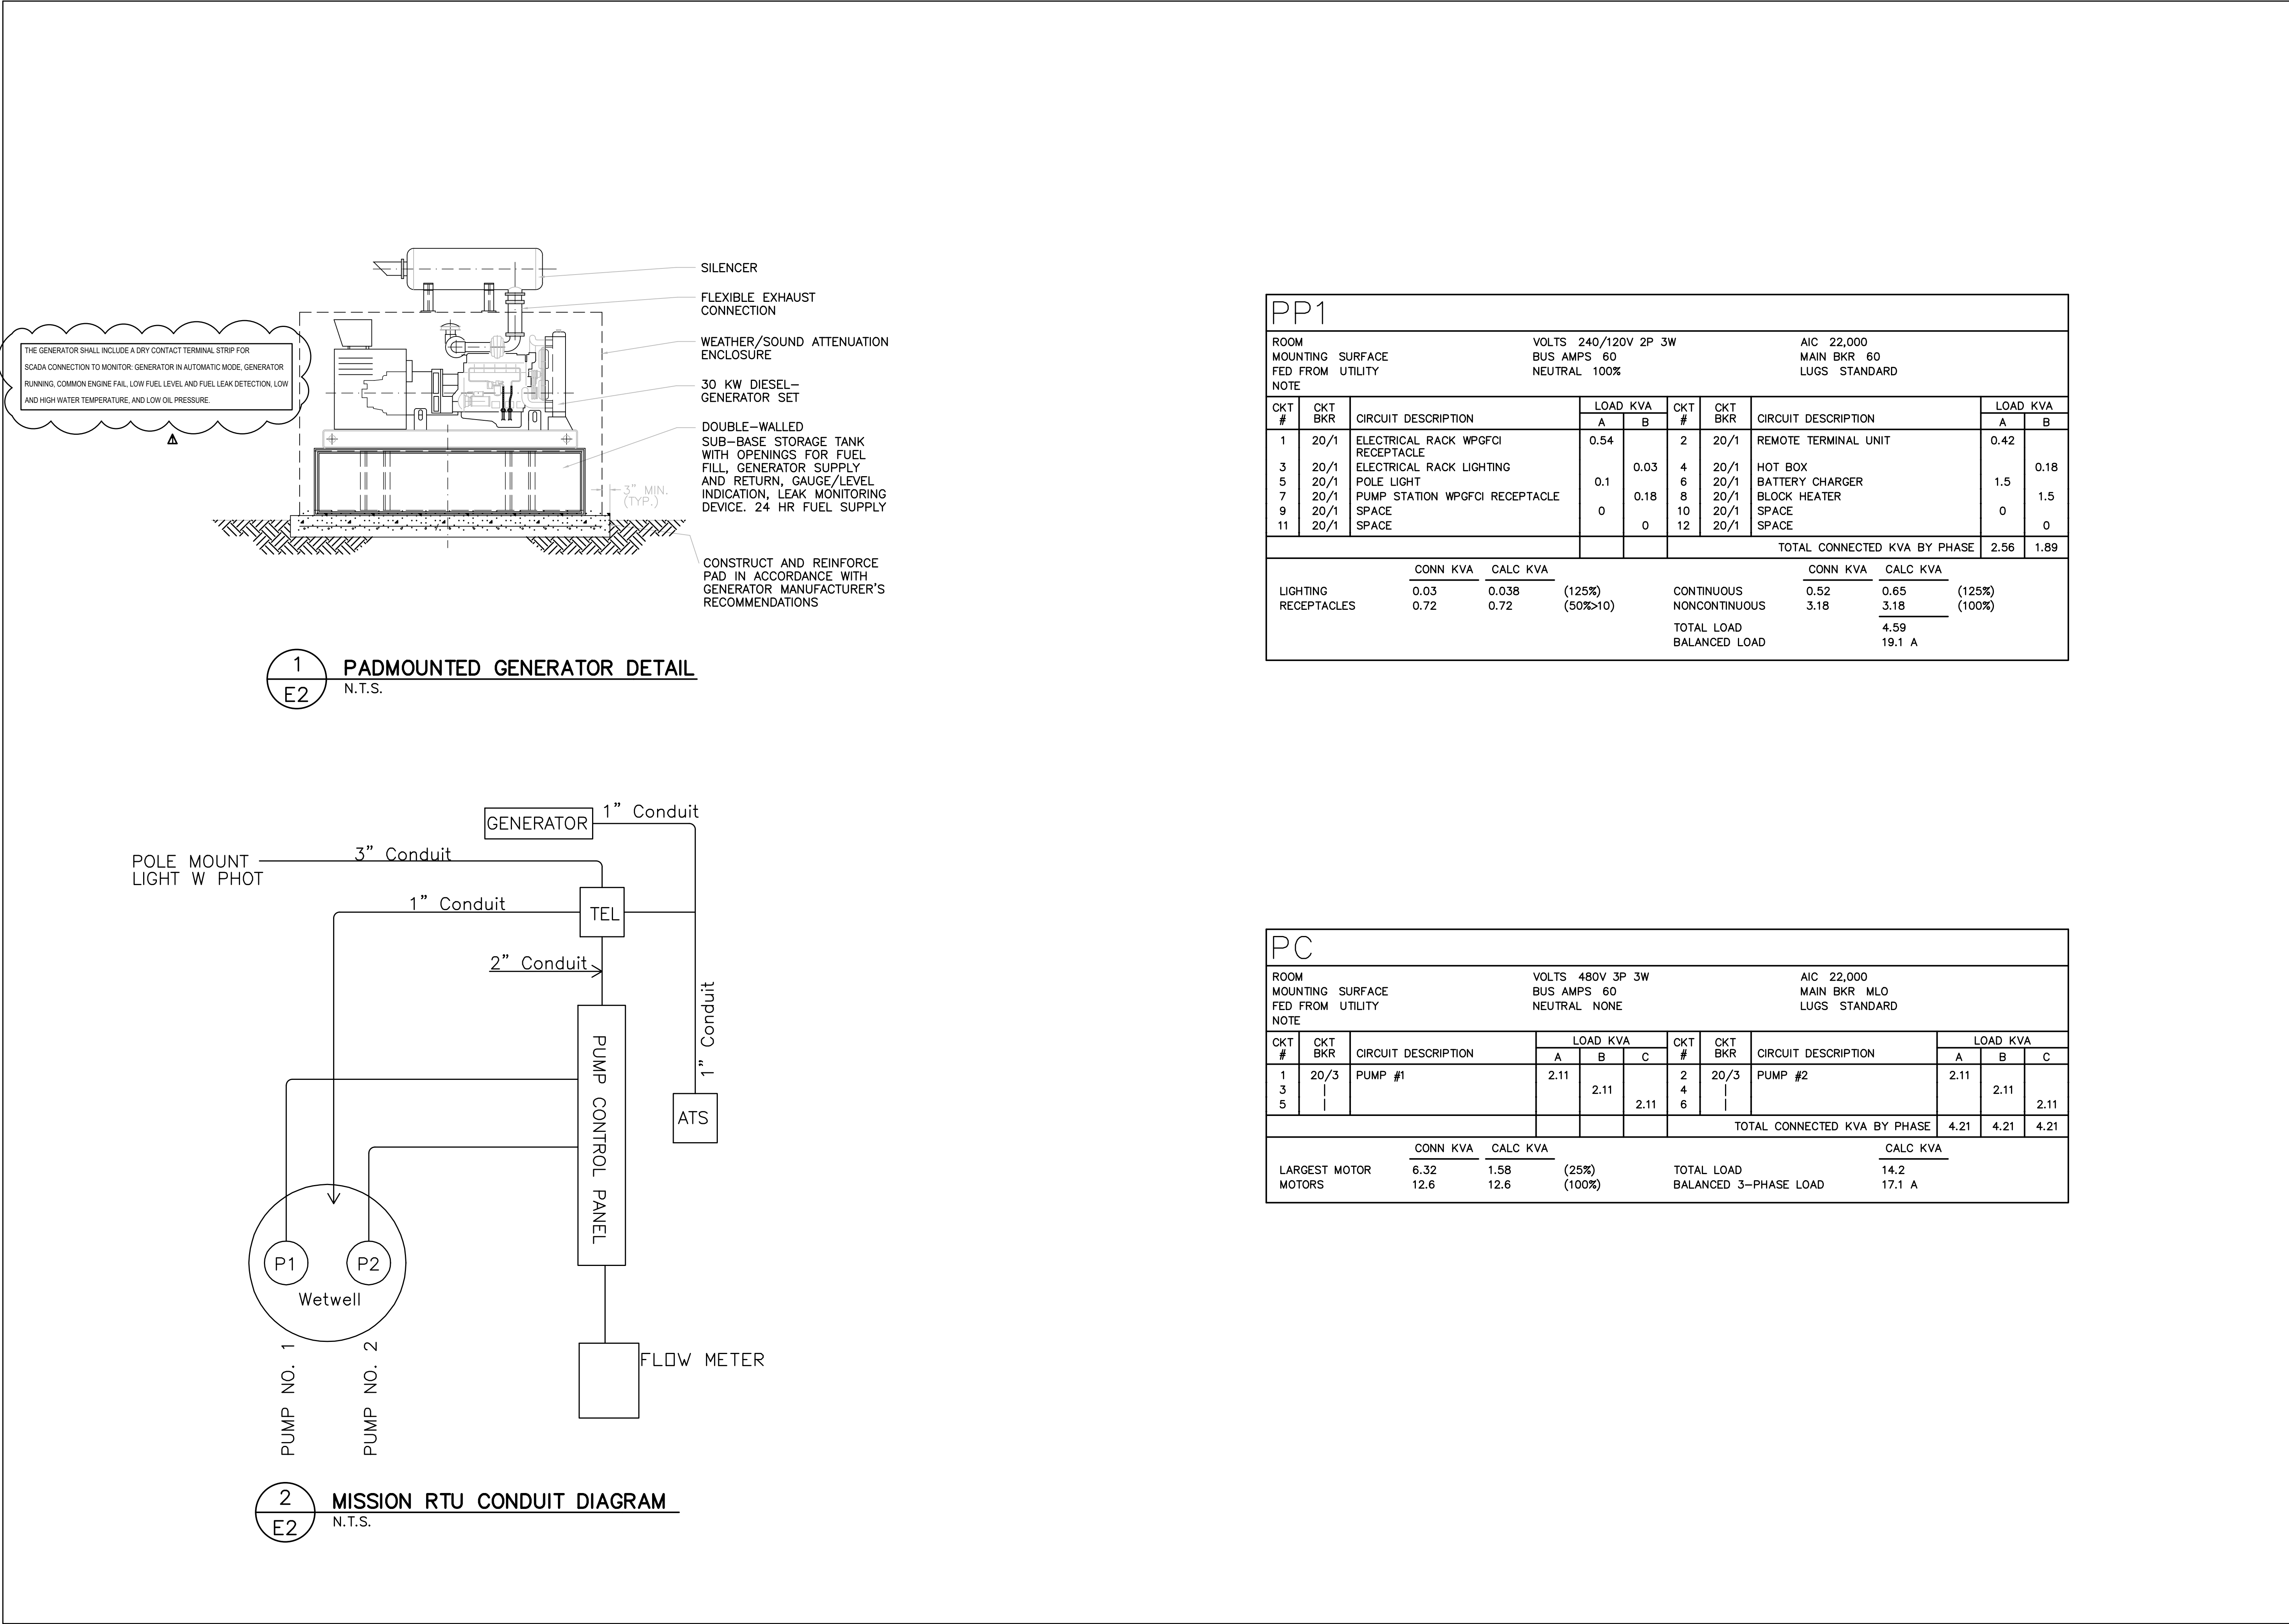

PP1

ROOM			VOLTS 240/120V 2P 3W			AIC 22,000					
MOUNTING SURFACE			BUS AMPS 60			MAIN BKR 60					
FED FROM UTILITY			NEUTRAL 100%			LUGS STANDARD					
NOTE											
CKT #	CKT BKR	CIRCUIT DESCRIPTION	LOAD KVA		CKT #	CKT BKR	CIRCUIT DESCRIPTION	LOAD KVA			
			A	B				A	B		
1	20/1	ELECTRICAL RACK WPGFCI RECEPTACLE	0.54		2	20/1	REMOTE TERMINAL UNIT	0.42			
3	20/1	ELECTRICAL RACK LIGHTING	0.1	0.03	4	20/1	HOT BOX	1.5	0.18		
5	20/1	POLE LIGHT		6	20/1	BATTERY CHARGER					
7	20/1	PUMP STATION WPGFCI RECEPTACLE	0	0.18	8	20/1	BLOCK HEATER	0	1.5		
9	20/1	SPACE		10	20/1	SPACE					
11	20/1	SPACE		12	20/1	SPACE					
					TOTAL CONNECTED KVA BY PHASE				2.56	1.89	
			CONN KVA	CALC KVA				CONN KVA	CALC KVA		
LIGHTING			0.03	0.038	(125%)			0.52	0.65	(125%)	
RECEPTACLES			0.72	0.72	(50%>10)			3.18	3.18	(100%)	
						TOTAL LOAD			4.59		
						BALANCED LOAD			19.1 A		

PC

ROOM		VOLTS 480V 3P 3W				AIC 22,000			
MOUNTING SURFACE		BUS AMPS 60				MAIN BKR MLO			
FED FROM UTILITY		NEUTRAL NONE				LUGS STANDARD			
NOTE									

CKT #	CKT BKR	CIRCUIT DESCRIPTION	LOAD KVA			CKT #	CKT BKR	CIRCUIT DESCRIPTION	LOAD KVA		
			A	B	C				A	B	C
1	20/3	PUMP #1	2.11			2	20/3	PUMP #2	2.11		
3				2.11		4				2.11	
5					2.11	6					2.11
TOTAL CONNECTED KVA BY PHASE									4.21	4.21	4.21

CONN KVA		CALC KVA				CALC KVA	
LARGEST MOTOR	6.32	1.58	(25%)	TOTAL LOAD	14.2		
MOTORS	12.6	12.6	(100%)	BALANCED 3-PHASE LOAD	17.1 A		

Aug 24, 2023

NORTH CAROLINA

PROFESSIONAL

SEAL

2018S

ENGINEER

CHRISTOPHER S. LOCKLEAR

Coastal Plains Engineering, P.A.

288 Locklear Rd  
P.O. Box 1117  
Pembroke, NC 28572  
Phone: 252-338-1117  
www.coastalplainseng.com

License No: C-3090

HARPERS MEADOW

LIFT STATION

LILLINGTON, NC 27546

DRAWINGS AND THE DESIGN ARE THE PROPERTY OF THE ENGINEER. WHETHER THE PROJECT FOR WHICH THEY ARE PREPARED IS EXECUTED OR NOT, THE DRAWINGS SHALL NOT BE USED BY THE PROJECT OWNER OR ANYONE ELSE FOR ANY OTHER PROJECT.

ADA AND LEGAL DISCLAIMER  
THIS DOCUMENT IS INTENDED TO COMPLY WITH THE REQUIREMENTS OF THE AMERICANS WITH DISABILITIES ACT (ADA). ARCHITECTS AND ENGINEERS ARE NOT LICENSED TO INTERPRET LAWS OR GIVE ADVICE CONCERNING LAWS OR LEGAL MATTERS. THE OWNER SHOULD HAVE THIS DOCUMENT REVIEWED BY HIS ATTORNEY TO DETERMINE IF IT COMPLES ADA AND OTHER LAWS.

PROJECT NO: 2023-025

DRAWN BY: WJ

CHECKED BY: CSL

DATE: 02-20-23

REVISIONS:  
B-24-23  
COMMENTS

SHEET NO:

E-2



