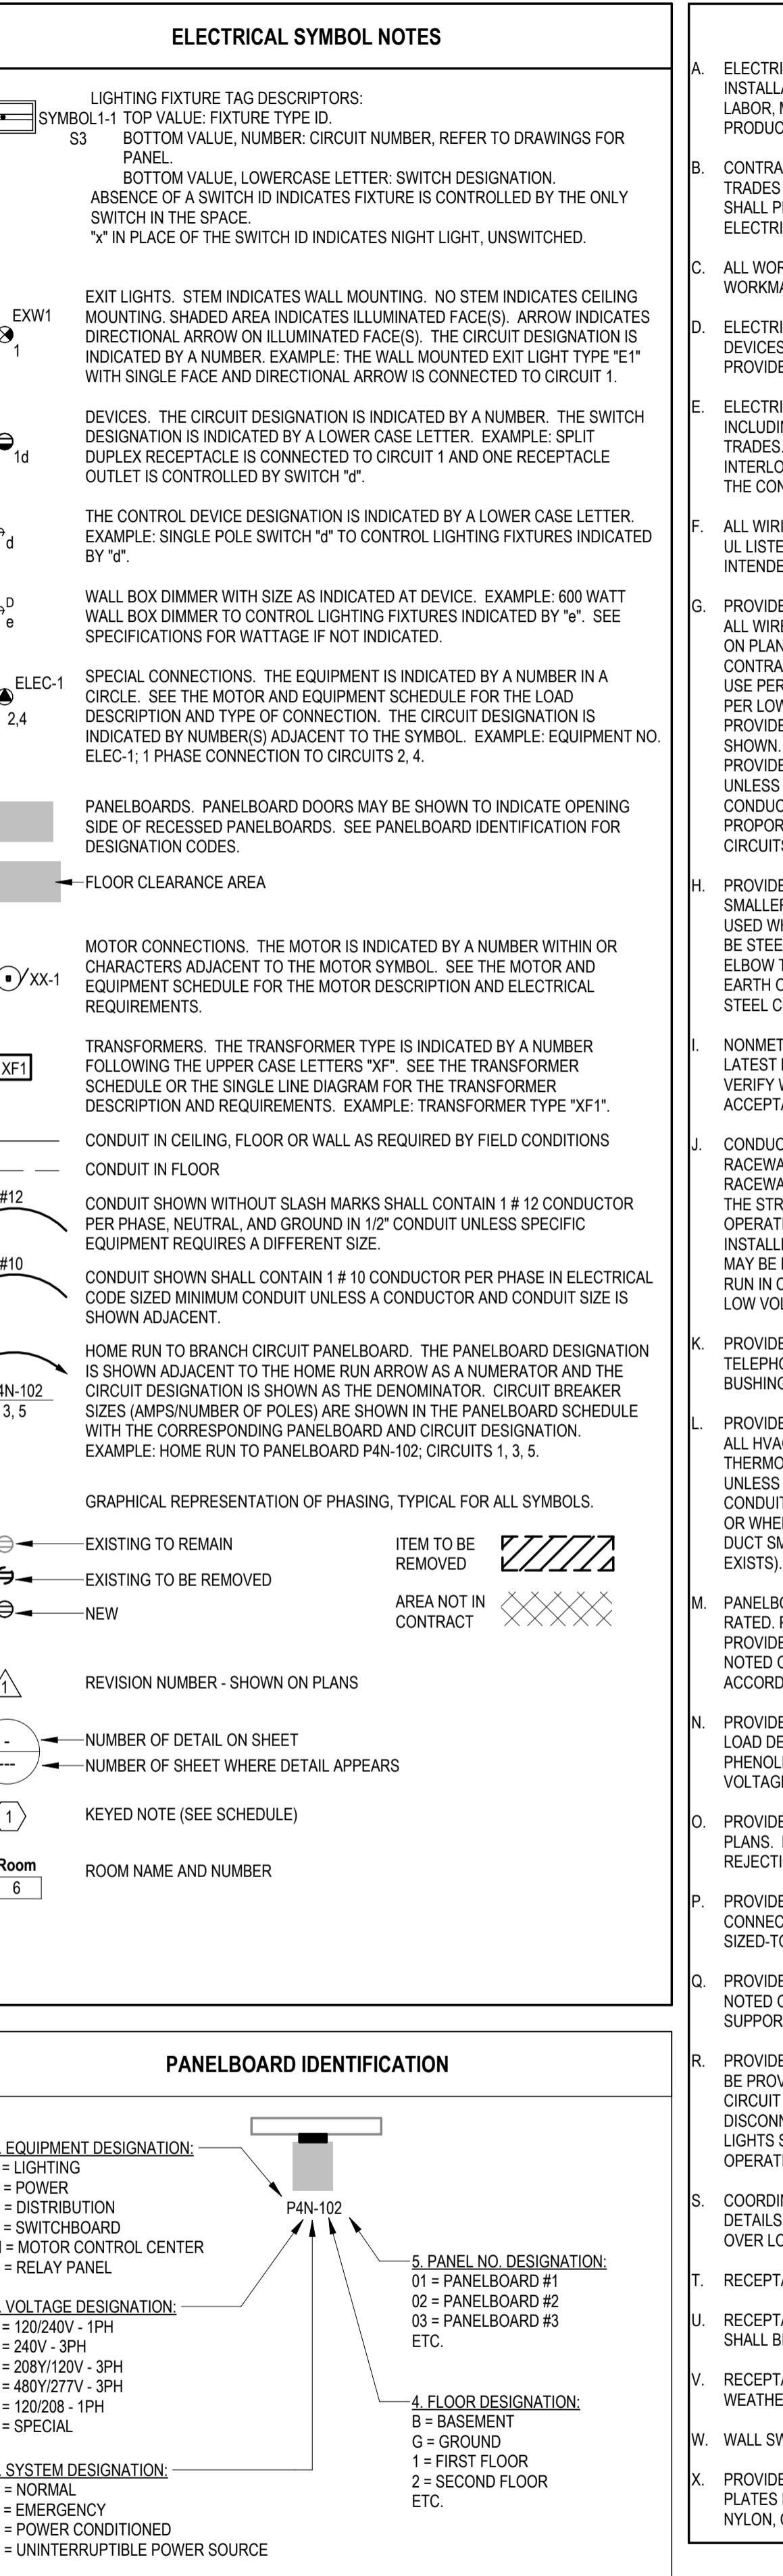
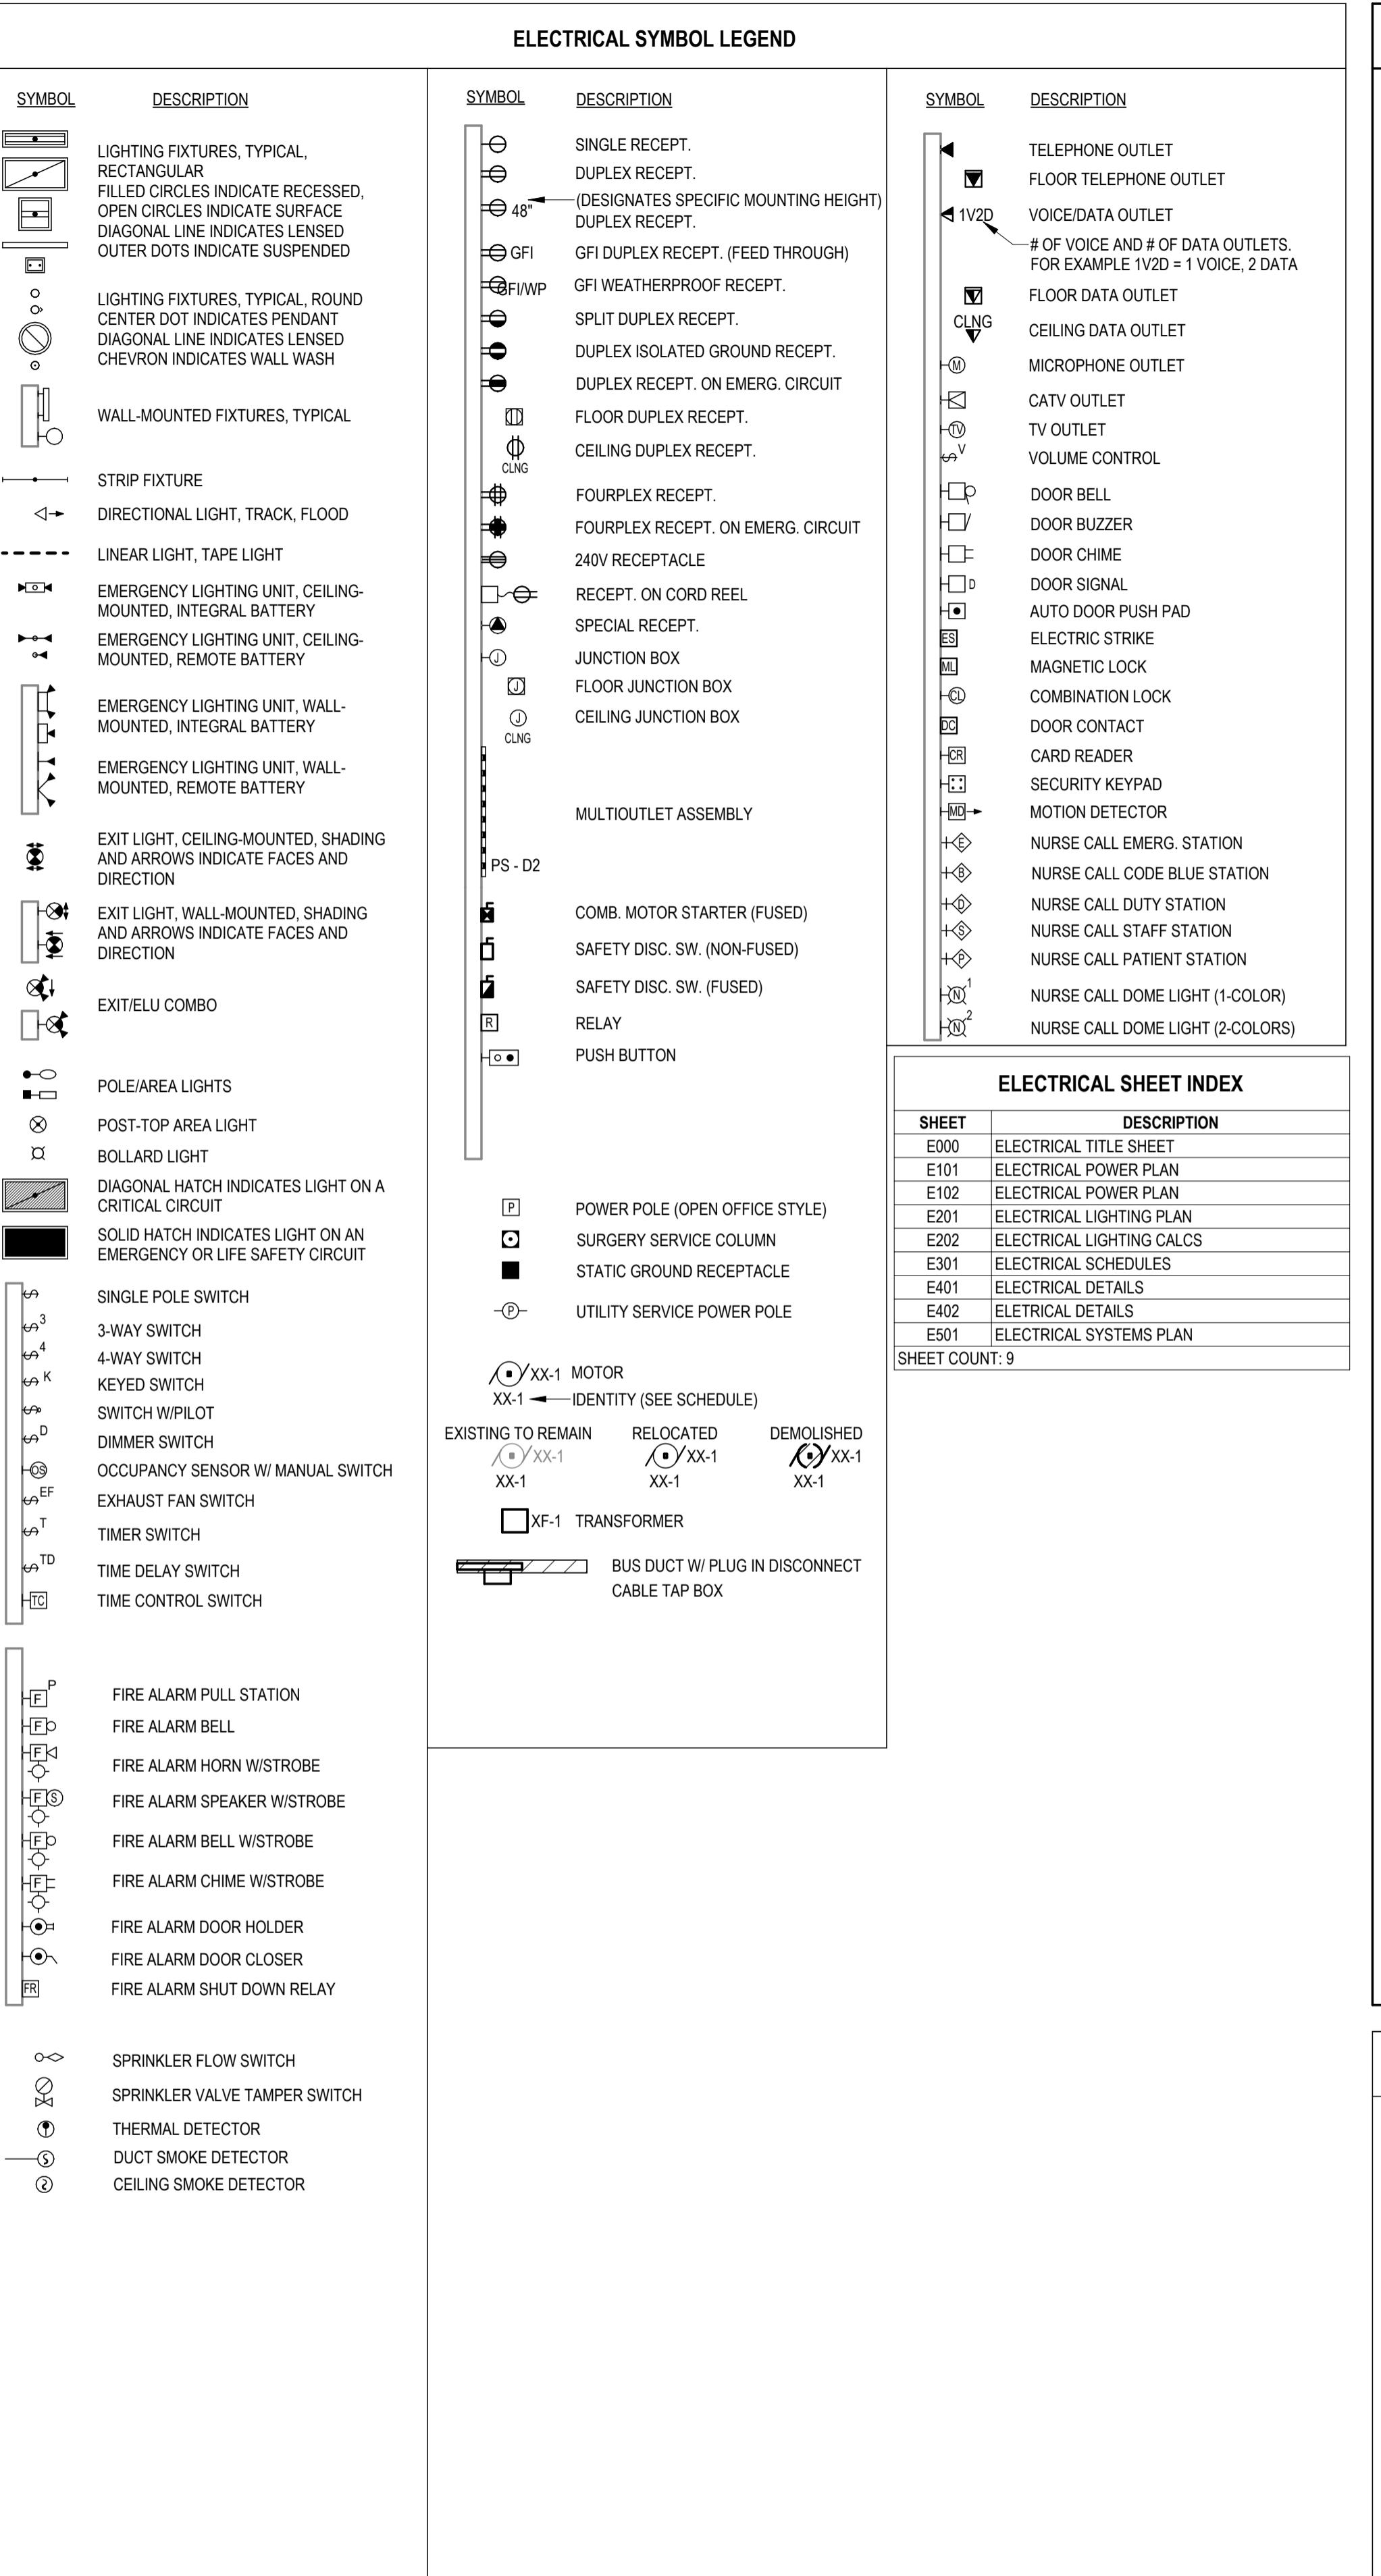


ELECTRICAL ABBREVIATIONS LIST	
1P	1 POLE (2P, 3P, 4P, ETC)
A	AMPERE
AC	ABOVE COUNTER
ACLG	AUTO CEILING
ADO	AUTOMATIC DOOR OPENER
AF	AMP FRAME
AFF	ABOVE FINISHED FLOOR
AGF	ABOVE FINISHED GRADE
AFI	ARC FAULT CIRCUIT
AMU	ANNUNCIATOR
APPROX	APPROXIMATELY
AQ-STAT	AQ-STAT AQUASTAT
ARCH	ARCHITECT, ARCHITECTURAL
AS	AMP SWITCH
AT	AMP TRIP
ATS	AUTOMATIC TRANSFER SWITCH
AUTO	AUTOMATIC
AUX	AUXILIARY
AV	AUDIO VISUAL
AWG	AMERICAN WIRE GAUGE
BATT	BATTERY
BD	BOARD
BLDG	BUILDING
BMS	BUILDING MANAGEMENT SYSTEM
CAB	CABINET
CAT	CATALOG
CATV	CABLE TELEVISION
CB	CIRCUIT BREAKER
CCTV	CLOSED CIRCUIT TELEVISION
CKT	CIRCUIT
CLG	CEILING
COMB	COMBINATION
CMPR	COMPRESSOR
CONN	CONNECTION
CONST	CONSTRUCTION
CONT	CONTINUATION OR CONTINUOUS
CONTR	CONTRACTOR
CONV	CONVECTOR
CP	CIRCULATING PUMP
CRT	CATHODE-RAY TUBE
CT	CURRENT TRANSFORMER
CTR	CENTER
CU	COPPER
DCP	DOMESTIC WATER CIRCULATING PUMP
DEPT	DEPARTMENT
DET	DETACHMENT
DA	DIAMETER
DISC	DISCONNECT
DIST	DISTRIBUTION
DN	DOWN
DPR	DAMPER
DS	SAFETY DISCONNECT SWITCH
DT	DOUBLE THROW
DWG	DRAWING
EC	ELECTRICAL CONTRACTOR
ELEC	ELECTRIC, ELECTRICAL
ELEV	ELEVATOR
ELU	EMERGENCY LIGHTING UNIT
EM	EMERGENCY
EMS	ENERGY MANAGEMENT SYSTEM
EMT	ELECTRICAL METALLIC TUBING
EP	ELECTRIC PNEUMATIC
EQUIP	EQUIPMENT
EWC	ELECTRIC WATER COOLER
EXIST	EXISTING
EXH	EXHAUST
EXP	EXPLOSION PROOF
FA	FIRE ALARM
FABP	FIRE ALARM BOOSTER POWER
FACP	FIRE ALARM CONTROL PANEL
FCU	FAN COIL UNIT
FIXT	FIXTURE
FLR	FLOOR
FLUOR	FLUORESCENT
FU	FUSE
FUDS	FUSED SAFETY DISCONNECT SWITCH
GA	GAUGE
GAL	GALLON
GALV	GALVANIZED
GC	GENERAL CONTRACTOR
GEN	GENERATOR
GFI	GROUND FAULT CIRCUIT INTERRUPTER
GFP	GROUND FAULT PROTECTOR
GND	GROUND
GRS	GALVANIZED RIGID STEEL (CONDUIT)
GYB	GYPSUM BOARD
HOA	HANDS-OFF AUTOMATIC SWITCH
HORIZ	HORIZONTAL
HP	HORSEPOWER
HPP	HIGH POWER FACTOR
HIT	HIGH
HTG	HEATING
HTR	HEATER
HV	HIGH VOLTAGE
HVAC	HEATING, VENTILATING AND AIR CONDITIONING
IC	INTERRUPTING CAPACITY
IG	ISOLATED GROUND
IMC	INTERMEDIATE METAL CONDUIT
INCAND	INCANDESCENT
IR	INFRARED
IW	INTERLOCK WITH
J-BOX	JUNCTION BOX
KV	KILOVOLT
KVA	KILOVOLT-AMPERE
KVAR	KILOVOLT-AMPERE REACTIVE
KW	KILOWATT
KWH	KILOWATT HOUR
LOC	LOCATE OR LOCATION
LTG	LIGHTING
LTG	LIGHTNING
LV	LOW VOLTAGE
MAX	MAXIMUM
MAGS	MAGNETIC STARTER
MIC	MOMENTARY CONTACT
MC	MECHANICAL CONTRACTOR



ELECTRICAL NOTES

- ELECTRICAL PLANS ARE INTENDED TO PROVIDE INFORMATION FOR INSTALLATION OF A COMPLETE ELECTRICAL SYSTEM. PROVIDE ALL ESSENTIAL LABOR, MATERIALS & DEVICES REQUIRED TO PRODUCE A QUALITY END PRODUCT.
- IT IS THE RESPONSIBILITY OF THIS CONTRACTOR TO COORDINATE INSTALLATION OF ELECTRICAL SYSTEMS AND THOSE REQUIRED ELECTRICAL CONNECTIONS TO MAINTAIN NEC REQUIRED CLEARANCES, INCLUDED BUT NOT LIMITED TO AREAS ABOVE ACCESSIBLE CEILINGS.
- ALL WORK SHALL COMPLY WITH THE NATIONAL ELECTRICAL CODE (NEC). WORKMANSHIP SHALL MEET OR EXCEED INDUSTRY STANDARDS.
- ELECTRICAL CONTRACTOR SHALL PROVIDE ALL DISCONNECTS, STARTERS, DEVICES AND ELECTRICAL COMPONENTS UNLESS SPECIFICALLY NOTED AS PROVIDED BY OTHERS.
- ELECTRICAL CONTRACTOR SHALL PROVIDE ALL LINE AND LOAD SIDE WIRING INCLUDING ALL TERMINATIONS TO EQUIPMENT PROVIDED UNDER OTHER TRADES. POWER WIRING TO CONTROL DEVICES SHALL BE PROVIDED BY E.C. INTERLOCK WIRING SHALL BE PROVIDED BY THE CONTRACTOR INSTALLING THE CONTROL DEVICE.
- ALL WIRING, PANELBOARDS, DEVICES AND OTHER LIKE MATERIALS SHALL BE UL LISTED & LABELED. ALL MATERIALS SHALL MEET THE NEC FOR THE INTENDED USE AND INSTALLED IN ACCORDANCE WITH THE NEC.
- TV OUTLETS, VOLUME CONTROLS, NURSE CALL DOME LIGHTS, NURSE CALL DEVICES, TELEPHONE OUTLETS, DATA OUTLETS, AND FIRE ALARM DEVICES. THE CIRCUIT DESIGNATION IS INDICATED BY A NUMBER. THE SWITCH DESIGNATION IS INDICATED BY A LOWER CASE LETTER. EXAMPLE: SPLIT DUPLEX RECEPTACLE IS CONNECTED TO CIRCUIT 1 AND ONE RECEPTACLE OUTLET IS CONTROLLED BY SWITCH "a".
- THE CONTROL DEVICE DESIGNATION IS INDICATED BY A LOWER CASE LETTER. EXAMPLE: SINGLE POLE SWITCH "d" TO CONTROL LIGHTING FIXTURES INDICATED BY "d".
- WALL BOX DIMMER WITH SIZE AS INDICATED AT DEVICE. EXAMPLE: 600 WATT WALL BOX DIMMER TO CONTROL LIGHTING FIXTURES INDICATED BY "e". SEE SPECIFICATIONS FOR WATTAGE IF NOT INDICATED.
- SPECIAL CONNECTIONS, THE EQUIPMENT IS INDICATED BY A NUMBER IN A CIRCLE. SEE THE MOTOR AND EQUIPMENT SCHEDULE FOR THE LOAD DESCRIPTION AND TYPE OF CONNECTION. THE CIRCUIT DESIGNATION IS INDICATED BY NUMBER(S) ADJACENT TO THE SYMBOL. EXAMPLE: EQUIPMENT NO. ELEC-1; 1 PHASE CONNECTION TO CIRCUITS 2, 4.
- PANELBOARDS. PANELBOARD DOORS MAY BE SHOWN TO INDICATE OPENING SIDE OF RECESSED PANELBOARDS. SEE PANELBOARD IDENTIFICATION FOR DESIGNATION CODES.
- FLOOR CLEARANCE AREA
- MOTOR CONNECTIONS. THE MOTOR IS INDICATED BY A NUMBER WITHIN OR CHARACTERS ADJACENT TO THE MOTOR SYMBOL. SEE THE MOTOR AND EQUIPMENT SCHEDULE FOR THE MOTOR DESCRIPTION AND ELECTRICAL REQUIREMENTS.
- TRANSFORMERS. THE TRANSFORMER TYPE IS INDICATED BY A NUMBER FOLLOWING THE UPPER CASE LETTER "XF". SEE THE TRANSFORMER SCHEDULE OR THE SINGLE LINE DIAGRAM FOR THE TRANSFORMER DESCRIPTION AND REQUIREMENTS. EXAMPLE: TRANSFORMER TYPE "XF1".
- CONDUIT IN CEILING, FLOOR OR WALL AS REQUIRED BY FIELD CONDITIONS CONDUIT IN FLOOR
- CONDUIT SHOWN WITHOUT SLASH MARKS SHALL CONTAIN 1 #12 CONDUCTOR PER PHASE, NEUTRAL, AND GROUND IN 1/2" CONDUIT UNLESS SPECIFIC EQUIPMENT REQUIRES A DIFFERENT SIZE.
- CONDUIT SHOWN SHALL CONTAIN 1 #10 CONDUCTOR PER PHASE IN ELECTRICAL CODE SIZE MINIMUM CONDUIT UNLESS A CONDUCTOR AND CONDUIT SIZE IS SHOWN ADJACENT.
- HOME RUN TO BRANCH CIRCUIT PANELBOARD. THE PANELBOARD DESIGNATION IS SHOWN ADJACENT TO THE HOME RUN ARROW AS A NUMERATOR AND THE CIRCUIT DESIGNATION IS SHOWN AS THE DENOMINATOR. CIRCUIT BREAKER SIZES (AMPS/NUMBER OF POLES) ARE SHOWN IN THE PANELBOARD SCHEDULE AND CIRCUIT DESIGNATION. EXAMPLE: HOME RUN TO PANELBOARD P4N-102; CIRCUITS 1, 3, 5.
- PROVIDE ONE-INCH EMPTIY CONDUITS EXTENDING ABOVE CEILING FOR ALL TELEPHONE AND DATA OUTLETS SHOWN ON PLANS. PROVIDE PROTECTIVE BUSHINGS ON ENDS OF CONDUIT. ALL CABLING IS PROVIDED BY OTHERS.
- WHERE PENETRATIONS ARE MADE THROUGH A REQUIRED FIRE-RESISTIVE WALL, FLOOR, OR PARTITION FOR THE PURPOSE OF RUNNING RACEWAY CARRYING ELECTRICAL, TELEPHONE, TELEVISION, OR LOCAL COMMUNICATION AND/OR SIGNALING CIRCUITS, THE OPENING AROUND THE RACEWAY SHALL BE FIRE STOPPED PER THE STATE BUILDING CODE. COORDINATION WITH THE GENERAL CONTRACTOR SHALL BE MAINTAINED TO ENSURE THAT THIS FIRE STOPPING IS ACCOMPLISHED. USE APPROVED ASSEMBLES SUCH AS THE FOLLOWING:
 - CONDUIT PENETRATIONS OF 1, 2, 3, & 4 HOUR GYP BOARD WALLS - U. L. #WL1001
 - CONDUIT PENETRATIONS OF 2, 3, & 4 HOUR CONCRETE OR BLOCK WALLS - U. L. #CAJ1001
 - CONDUIT PENETRATIONS OF 2, 3, & 4 HOUR CONCRETE FLOORS - U. L. #CAJ1001
 - CONDUIT PENETRATIONS OF 1 HOUR GYPBOARD CEILING ASSEMBLY - L526
 - MULT. CONDUIT PENETRATIONS OF 2, 3, & 4 HOUR CONCRETE OR BLOCK WALL OR FLOOR - CAJ1042
- FLOOR BOX RECEPTACLE LOCATIONS TO BE COORDINATED WITH ELECTRICAL CONTRACTOR, FURNITURE CONTRACTOR, AND MILLWORK.

ISSUED FOR CONSTRUCTION


E&M CONCRETE
308 JARCO DRIVE
FUQUAY-VARINA, NC 27526

PROJECT: 224S91
 DATE ISSUED: 8/20/2024
 REV DATE DESCRIPTION
 1 11/13/25 AS BUILTS

DRAWN BY: JCD
 CHECK BY: BDL
 ELECTRICAL POWER
 11/21/2025


E101

KEYNOTES	
1	JUNCTION BOX FOR SIGN POWER. COORDINATE EXACT SIGN REQUIREMENTS WITH OWNER OR SIGN PROVIDER.
2	ELECTRICAL CONTRACTOR TO COORDINATE MOUNTING HEIGHTS FOR MICROWAVES WITH ARCHITECT.

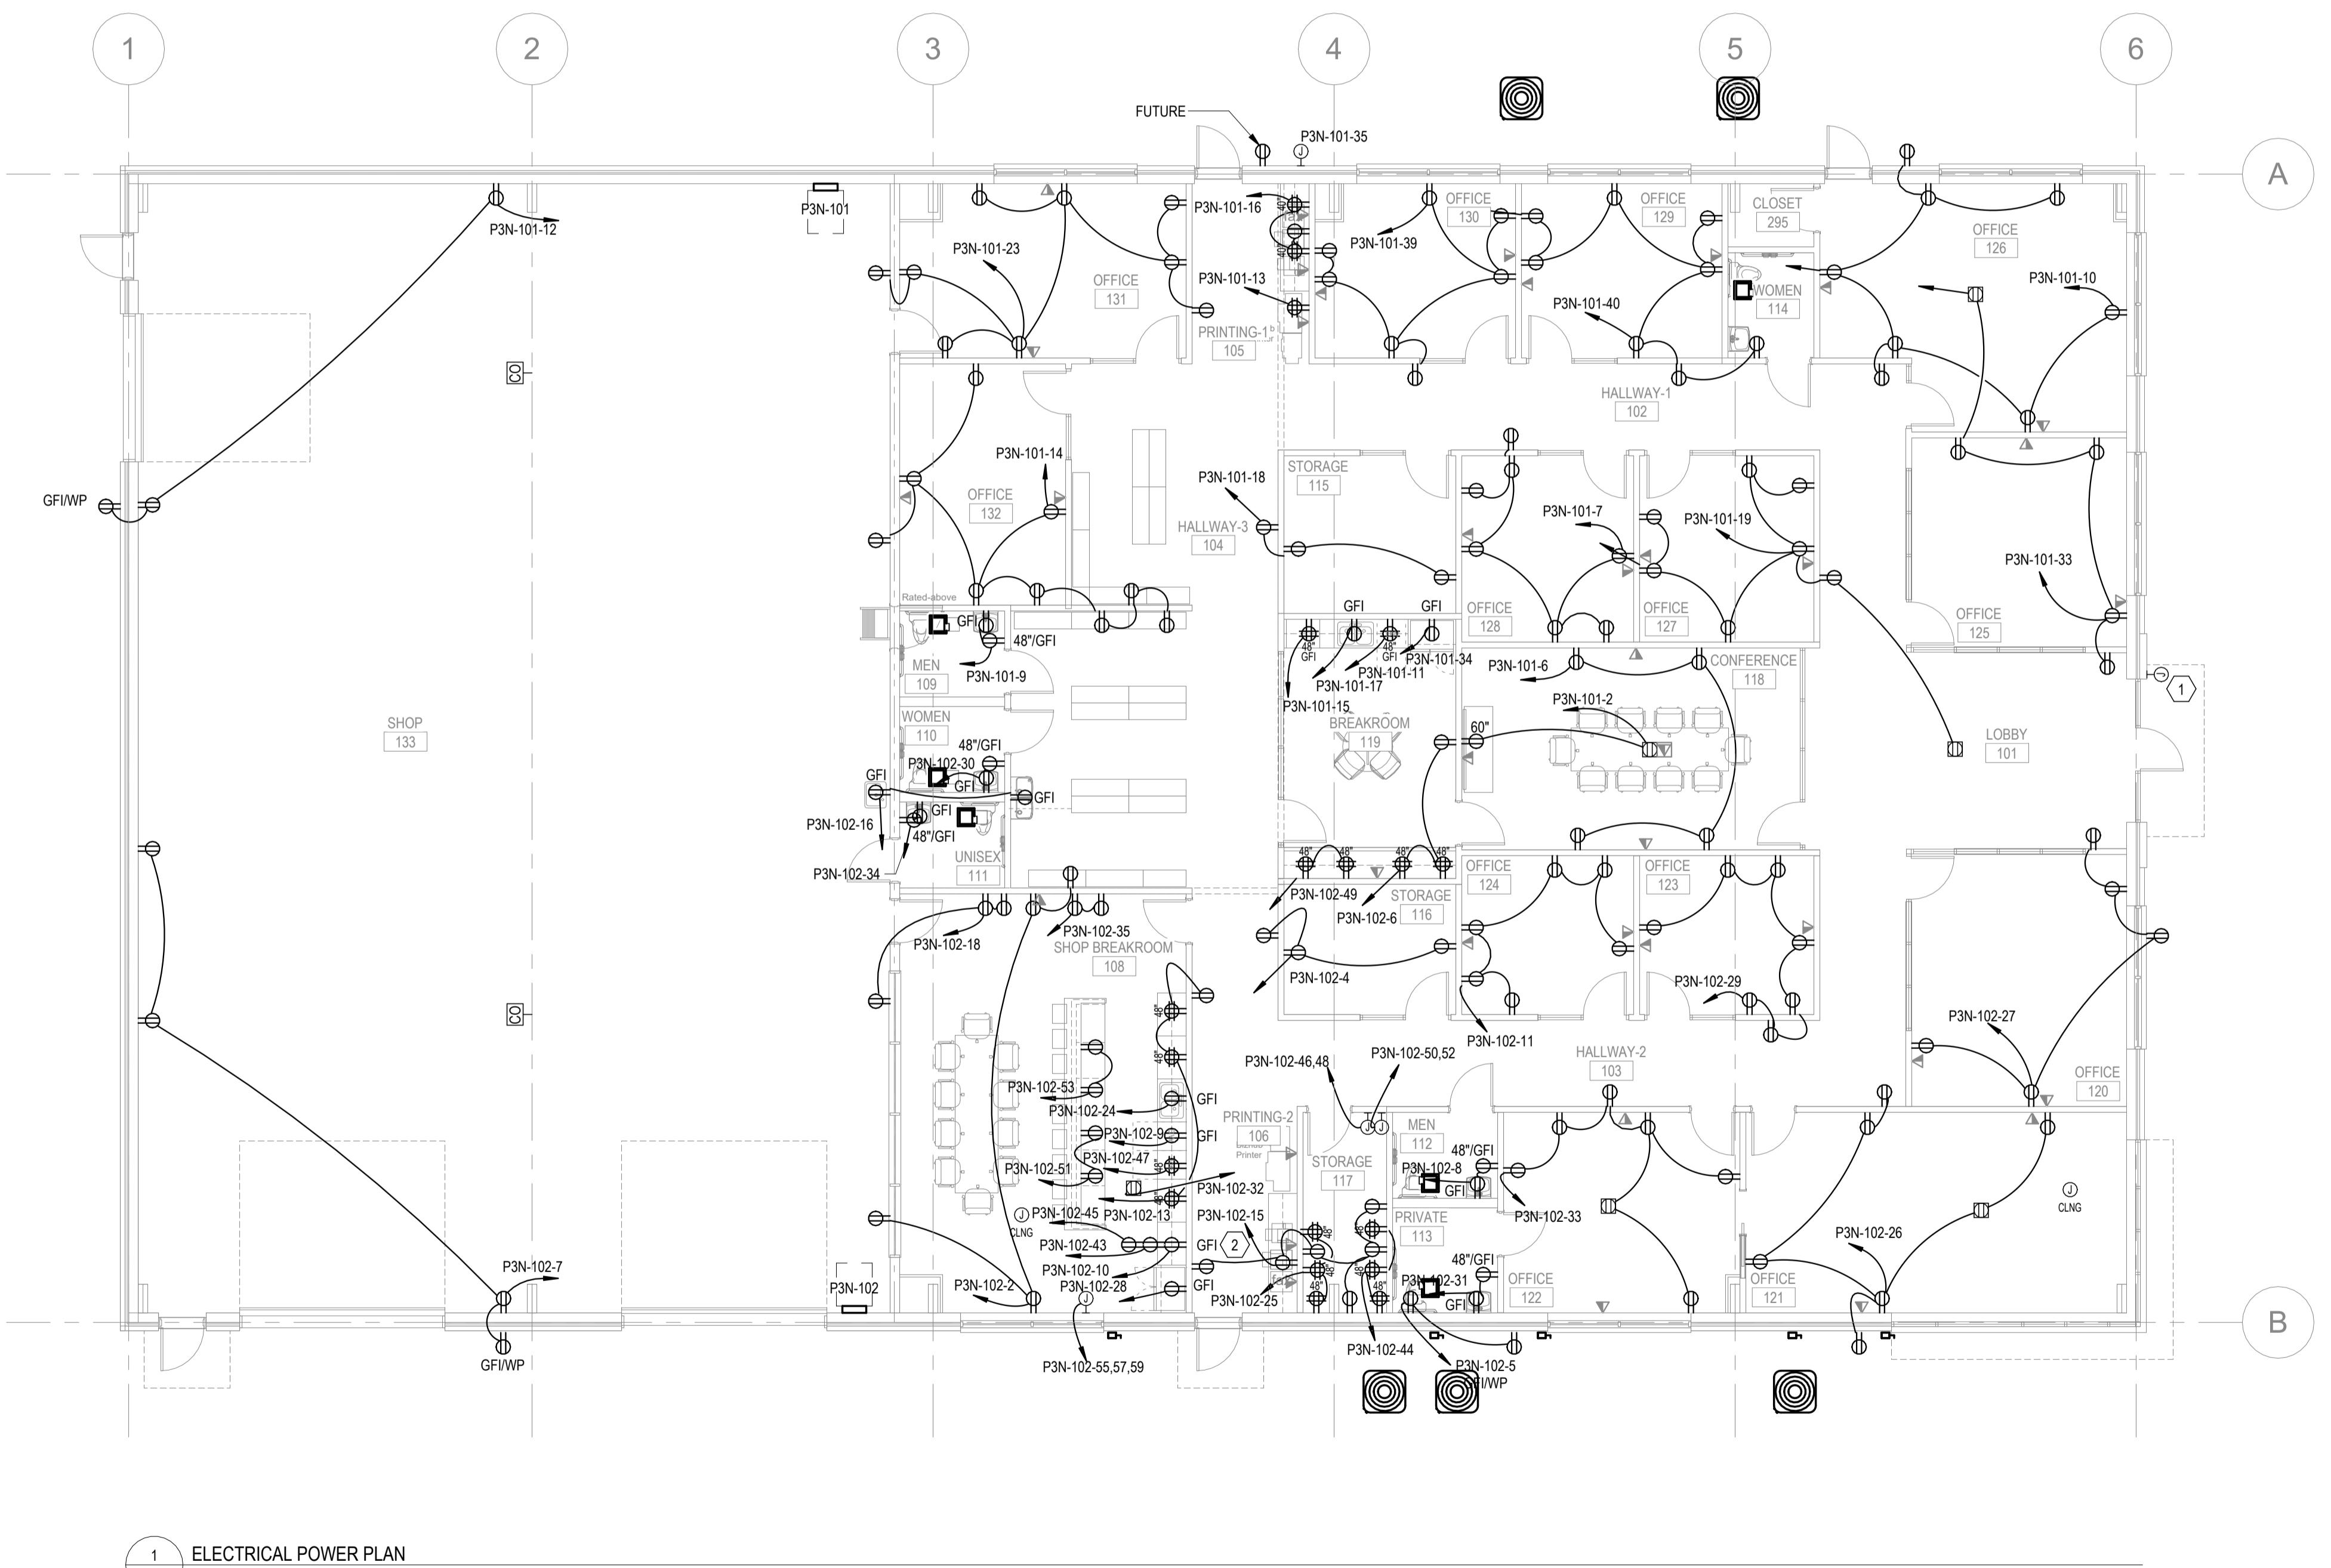

THESE DRAWINGS ARE THE PROPERTY OF KAIROS PROJECT GROUP. THESE DOCUMENTS HAVE BEEN PREPARED SPECIFICALLY FOR THE PROJECT DESCRIBED IN THE ADDRESS BAR. THEY ARE NOT SUITABLE FOR USE IN OTHER PROJECTS OR IN OTHER LOCATIONS WITHOUT WRITTEN APPROVAL FROM THE ENGINEER.

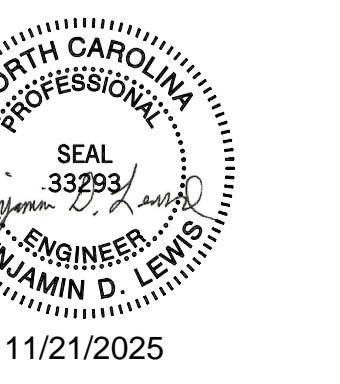11/13/25



ISSUED FOR CONSTRUCTION


**E&M CONCRETE
 308 JARCO DRIVE
 FUQUAY-VARINA, NC 27526**

PROJECT: 224S91
 DATE ISSUED: 8/20/2024
 REV DATE DESCRIPTION
 1 11/13/25 AS BUILTS



THESE DRAWINGS ARE THE PROPERTY OF KAIROS PROJECT GROUP. THESE DOCUMENTS HAVE BEEN PREPARED SPECIFICALLY FOR THE PROJECT DESCRIBED IN THE ADDRESS BAR. THEY ARE NOT SUITABLE FOR USE IN OTHER PROJECTS OR IN OTHER LOCATIONS WITHOUT WRITTEN APPROVAL FROM THE ENGINEER. REPRODUCTION IS PROHIBITED IF SIGNATURES ON COVER SHEET DO NOT APPEAR. THIS IS NOT AN AUTHORIZED COPY.

DRAWN BY: JCD
 CHECK BY: BDL
 ELECTRICAL POWER PLAN
 11/21/2025

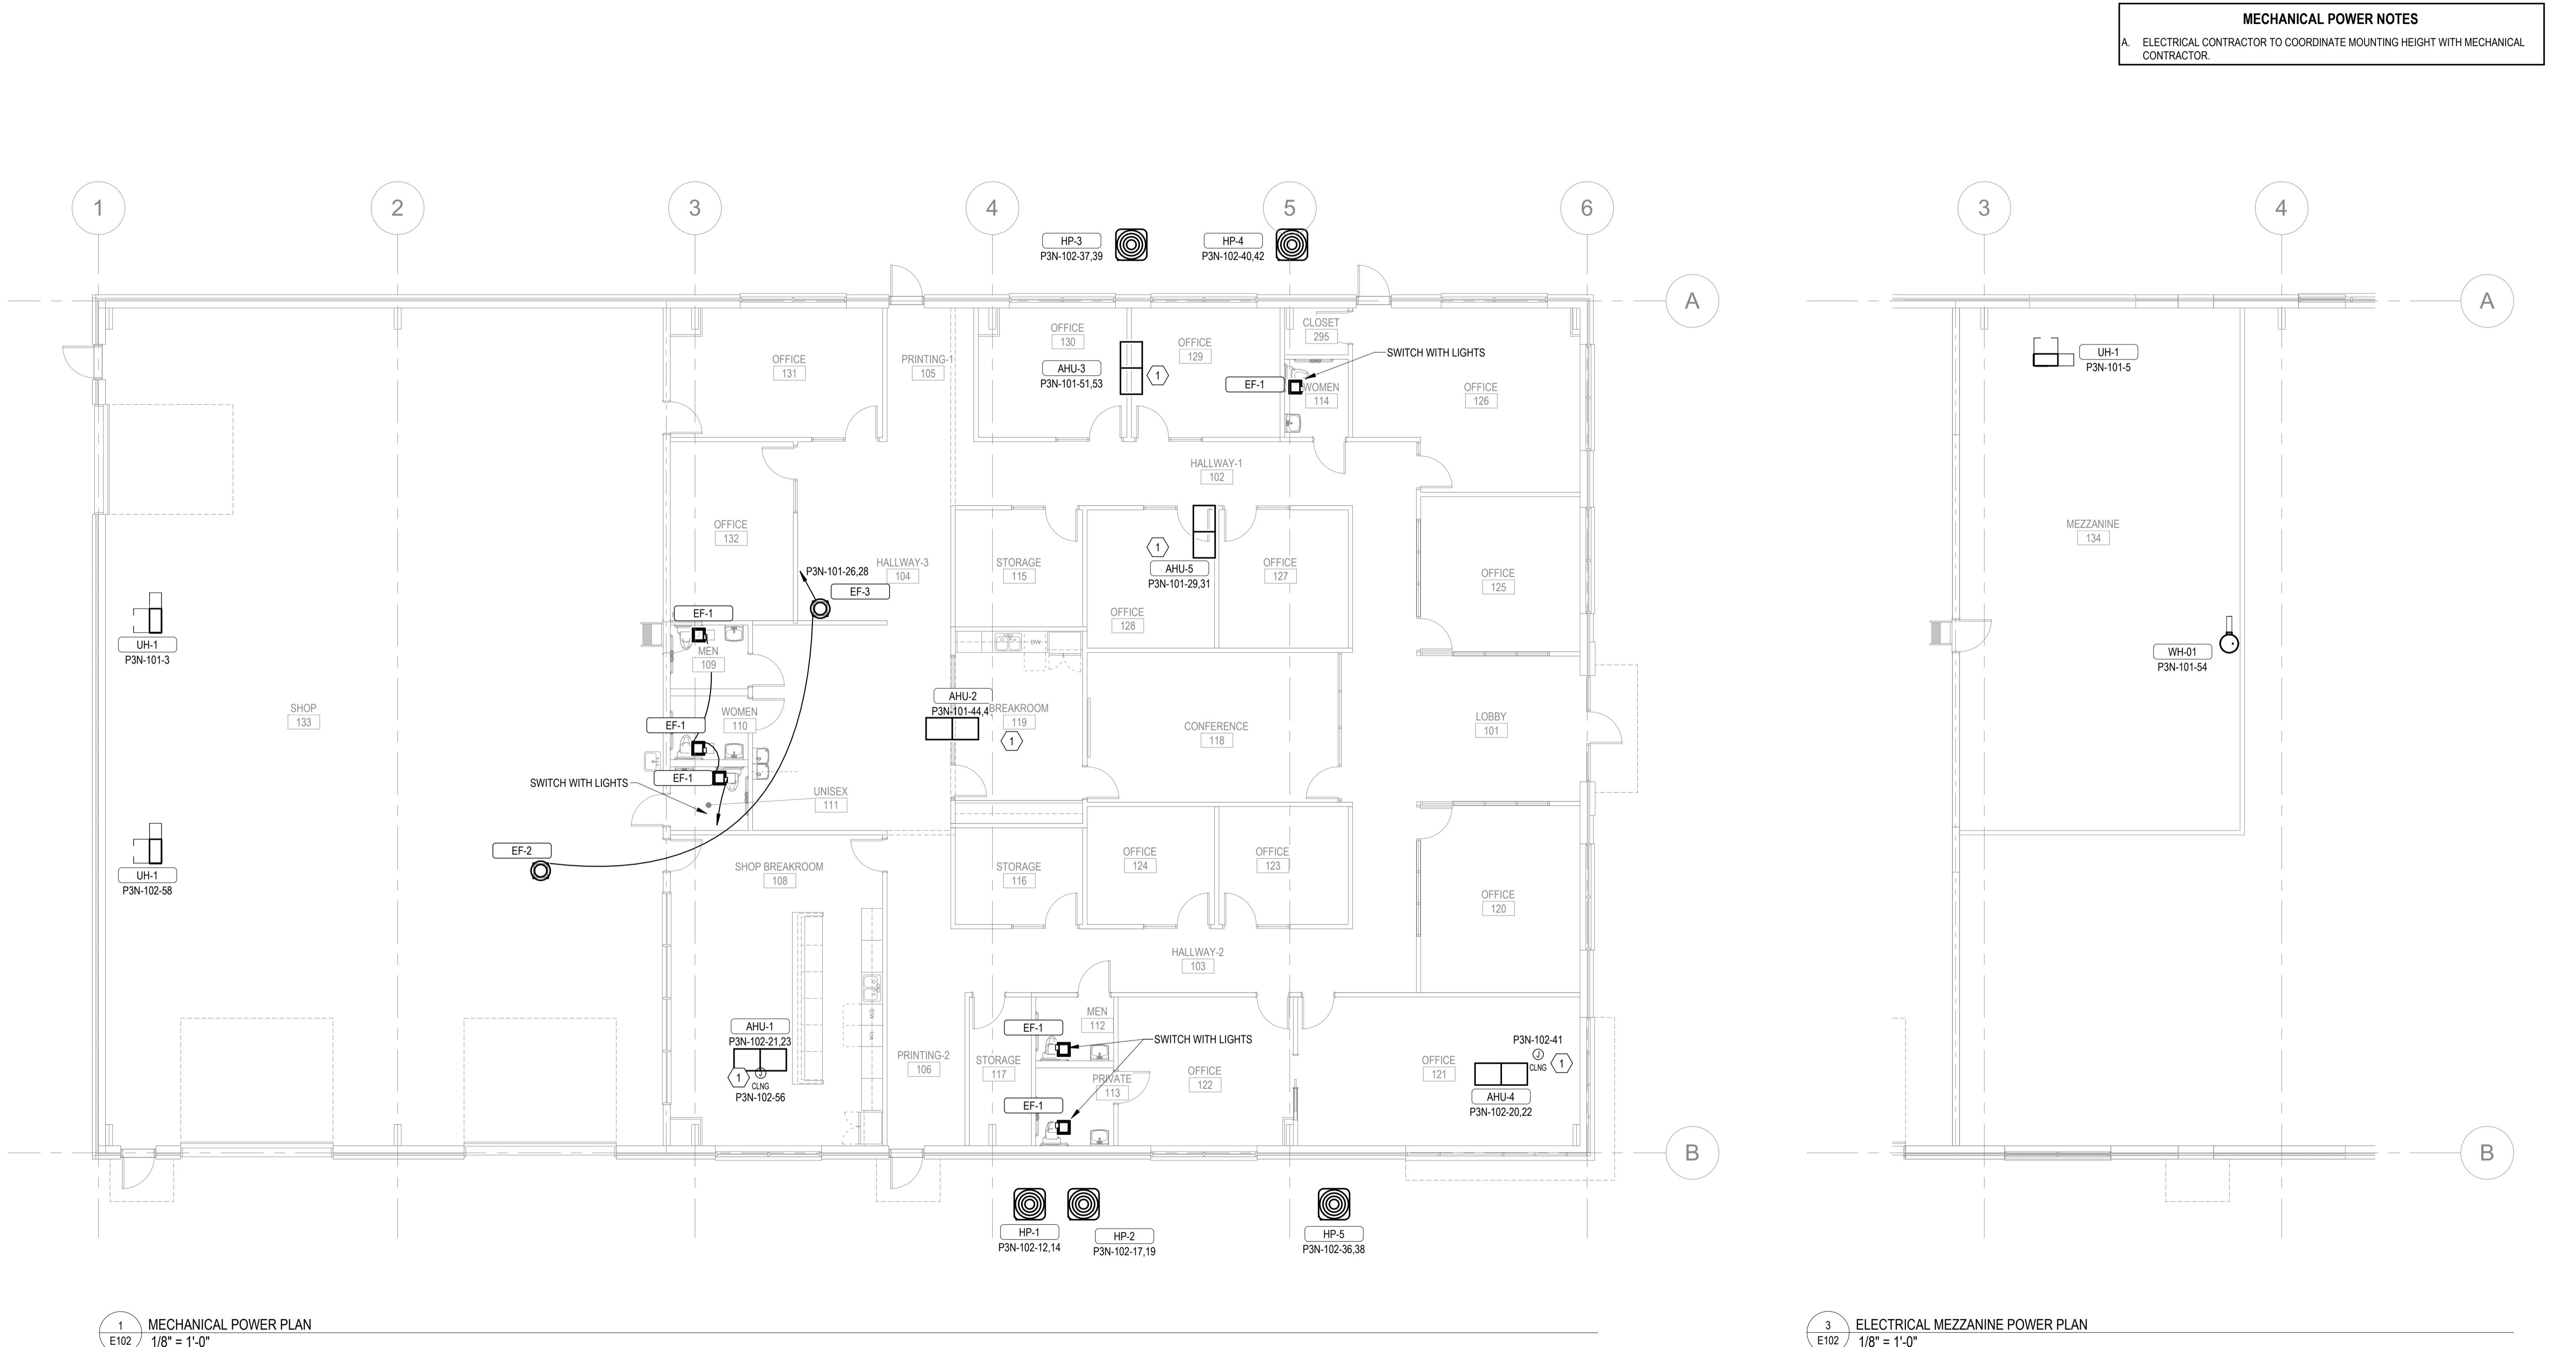SEAL
 33293
 BENJAMIN D. LEWIS
 ENGINEER
 11/21/2025




E102

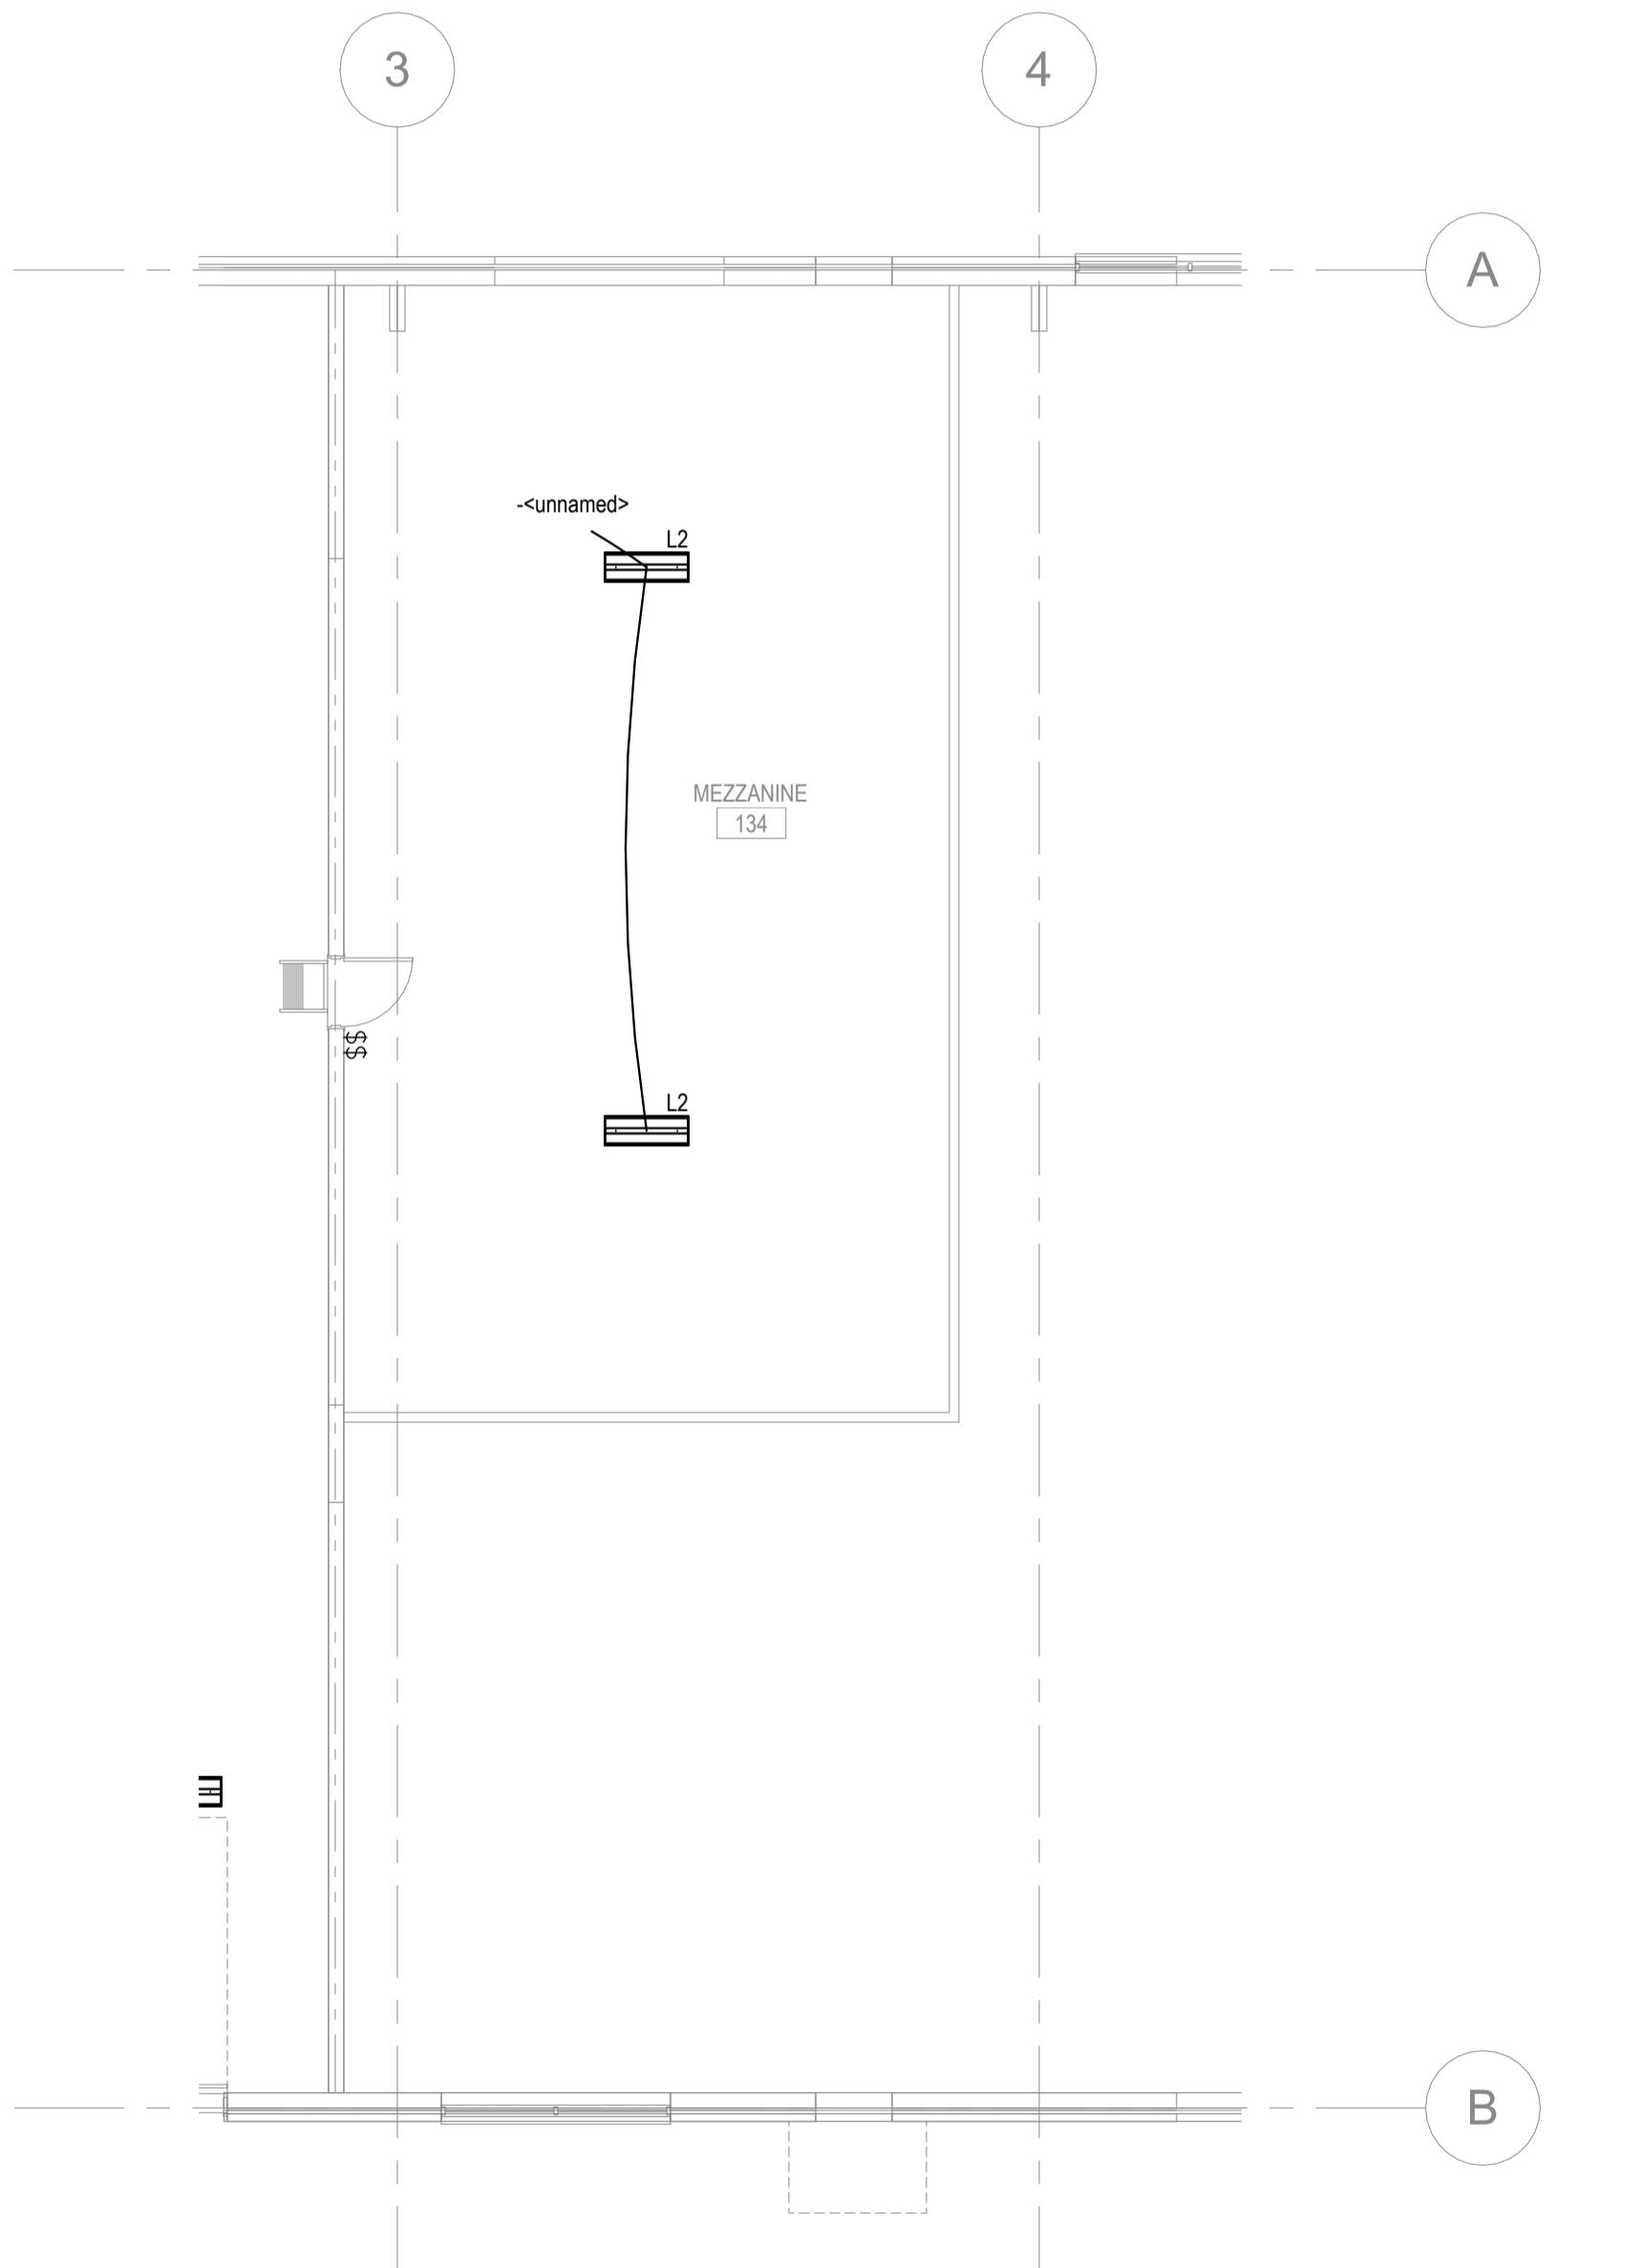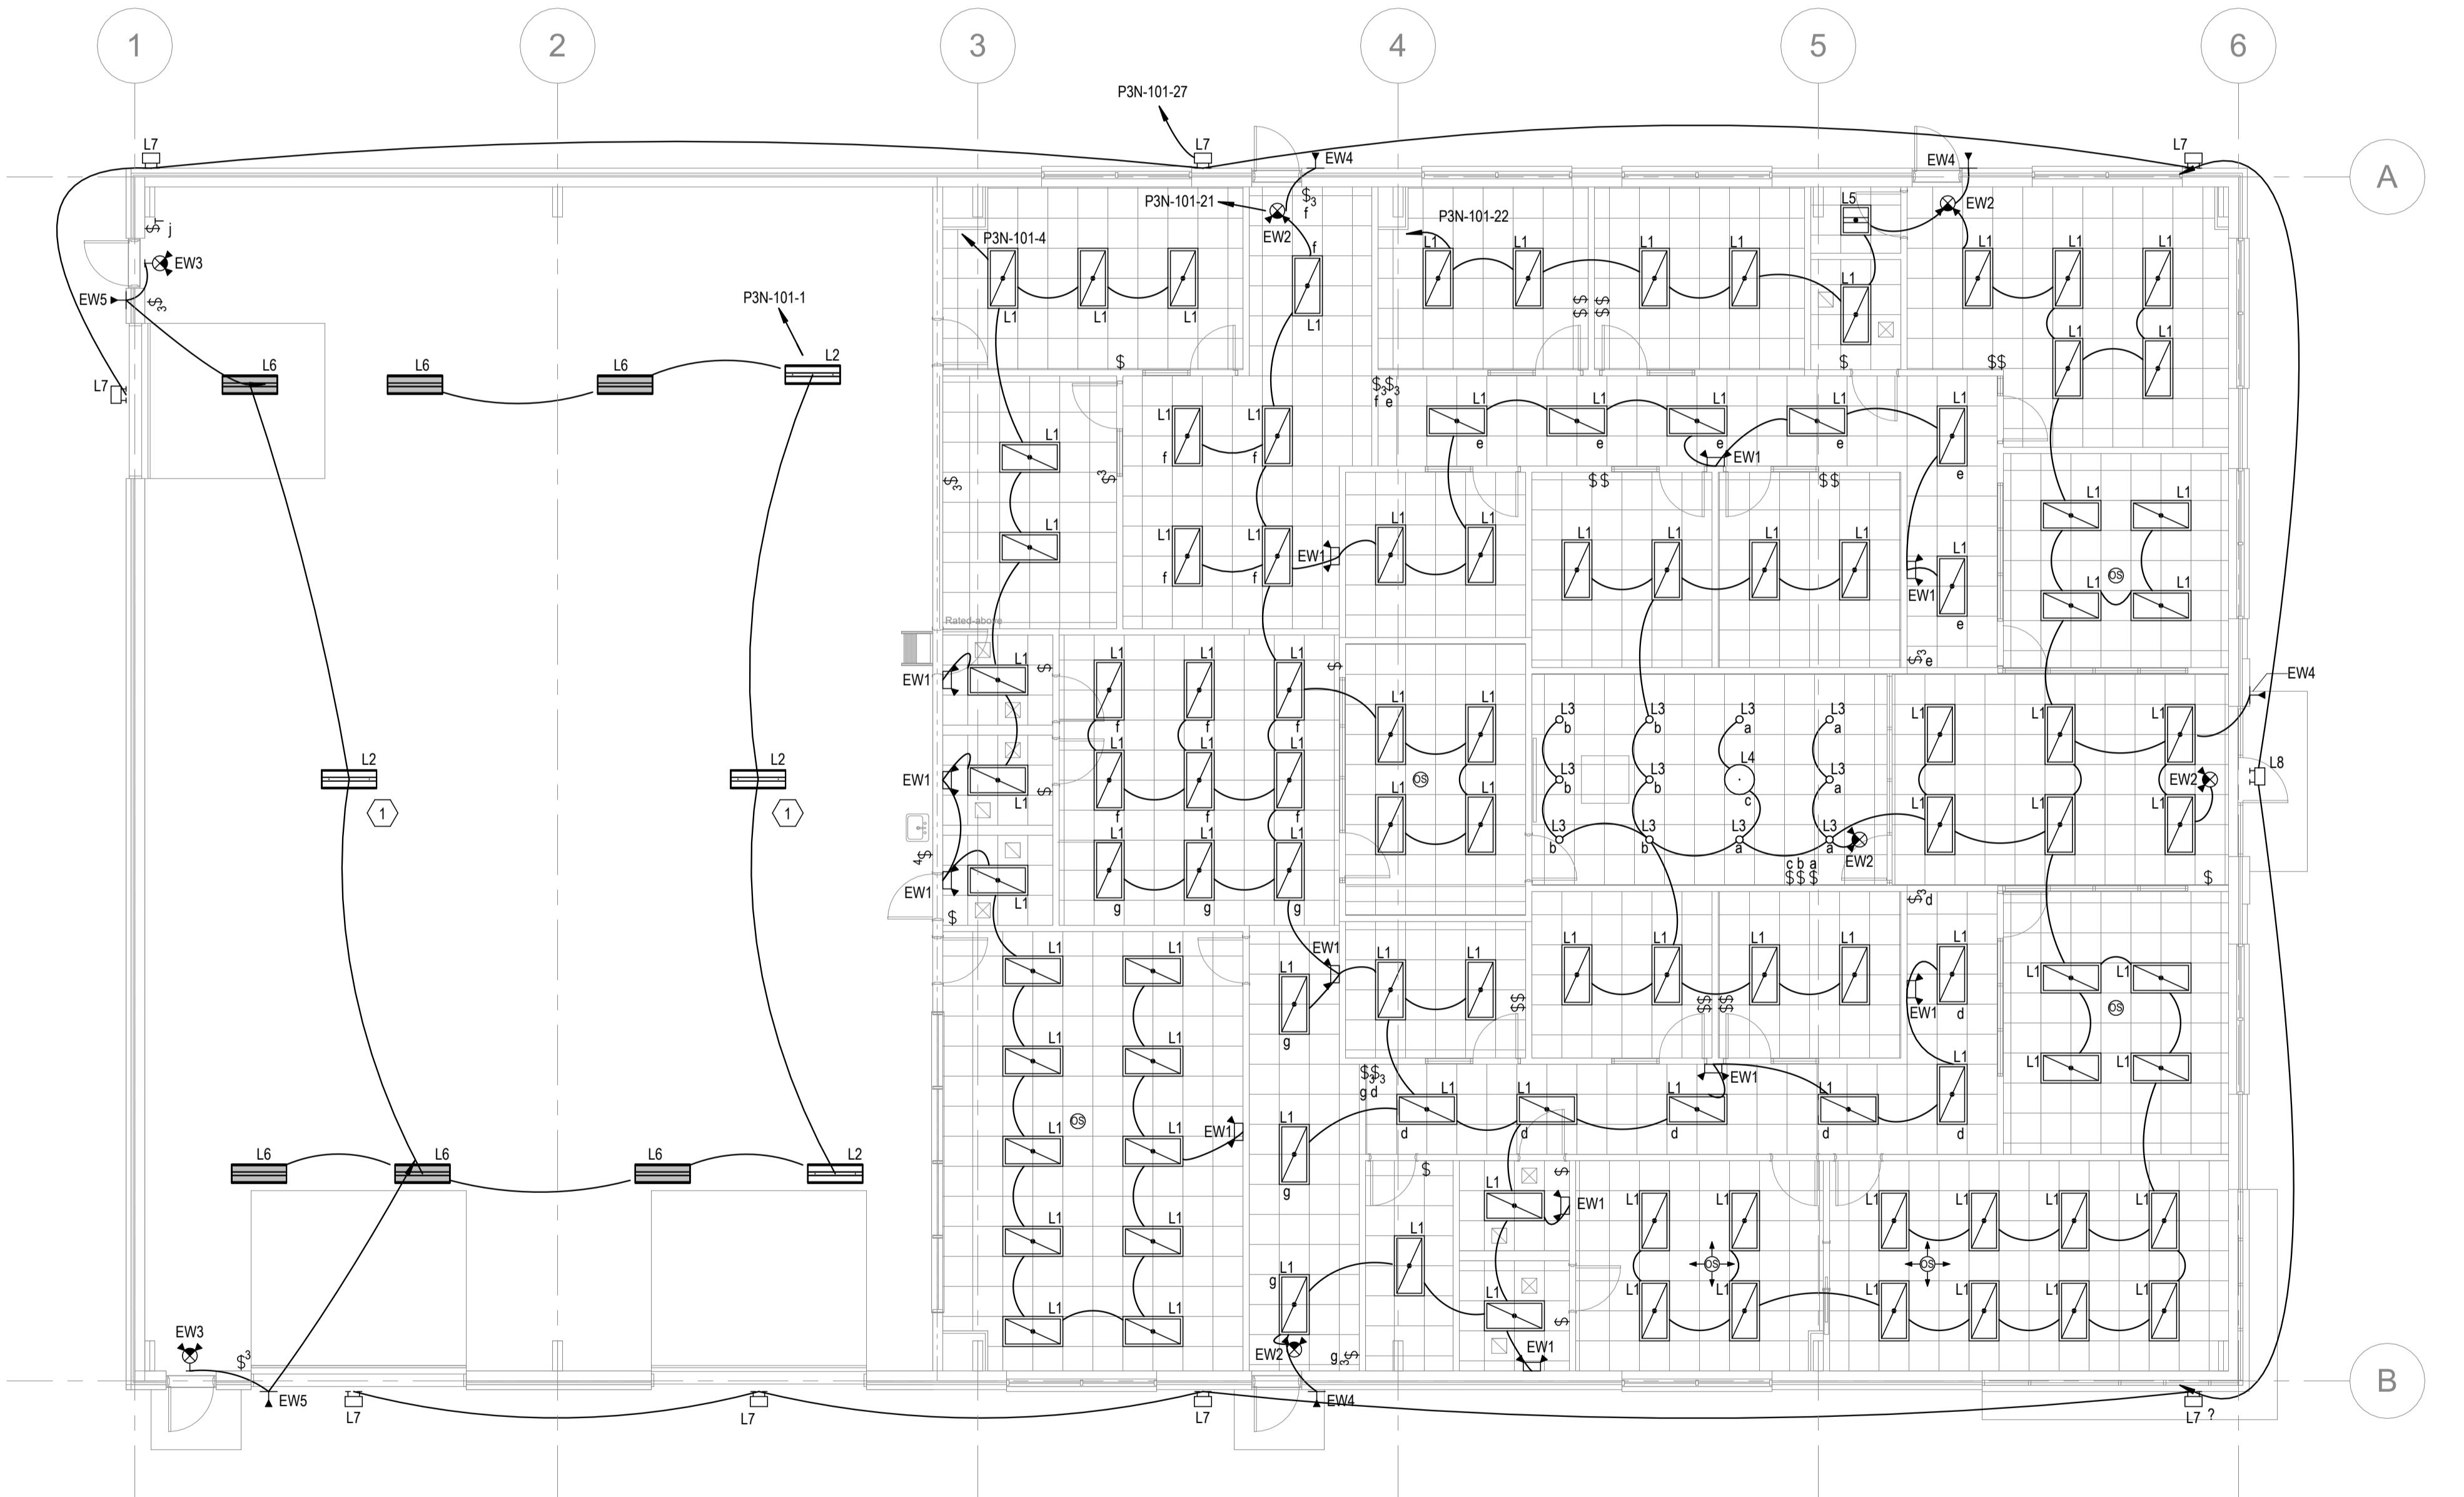

KEYNOTES
 1 LIGHTS TO BE SWITCHED FROM BREAKER.

LIGHTING NOTES
 A. ELECTRICAL CONTRACTOR TO COORDINATE EXACT FIXTURE COUNT, POSITION, AND MOUNTING HEIGHT OF WALL PACKS WITH ARCHITECT.

THESE DRAWINGS ARE THE PROPERTY OF KAIROS PROJECT GROUP. THESE DOCUMENTS HAVE BEEN PREPARED SPECIFICALLY FOR THE PROJECT DESCRIBED IN THE ADDRESS BAR. THEY ARE NOT SUITABLE FOR USE ON OTHER PROJECTS OR IN OTHER LOCATIONS WITHOUT WRITTEN APPROVAL FROM THE ENGINEER. REPRODUCTION IS PROHIBITED IF SIGNATURES ON COVER SHEET DO NOT APPEAR. THIS IS NOT AN AUTHORIZED COPY.

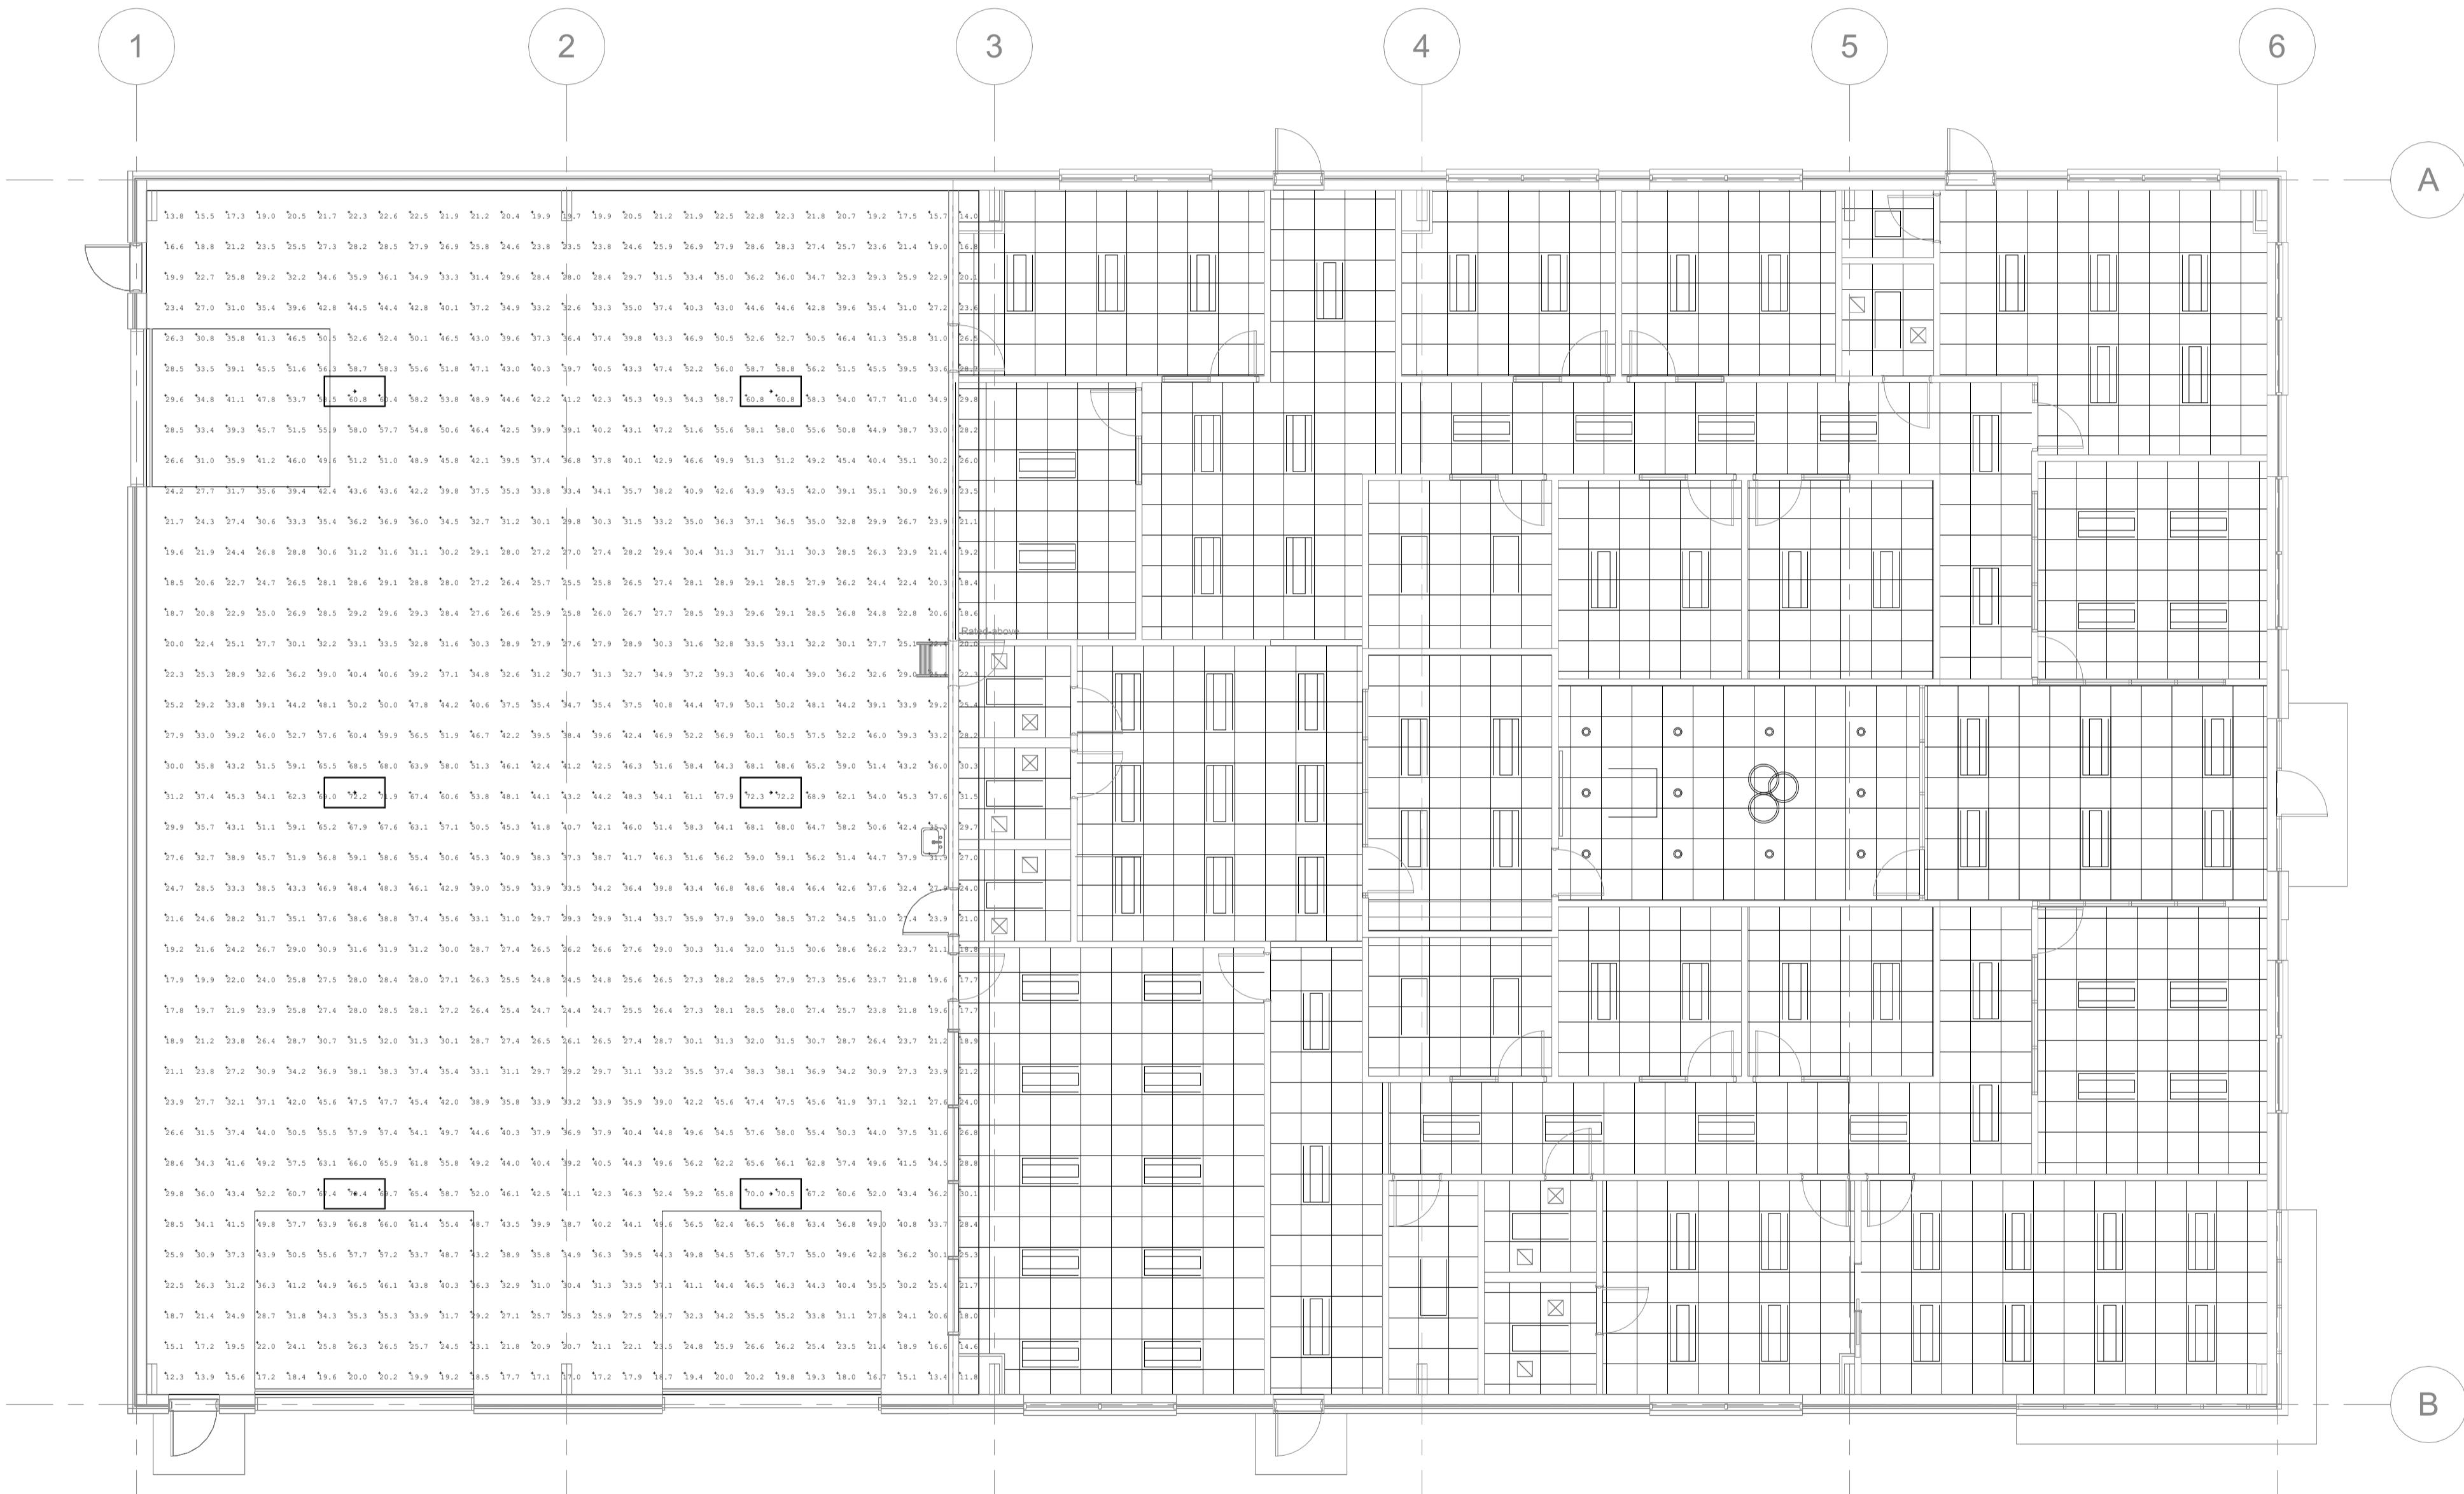

Calculation Summary					
Label	CalcType	Units	Avg	Max	Min
Warehouse_Workplane	Illuminance	Fc	38.22	74.0	12.7
			3.01	5.83	

FOOTCANDLE LIGHT GUIDE		
AREA	AVERAGE (FC)	RANGE (FC)
WAREHOUSE & STORAGE		
OPEN WAREHOUSE	20	10 - 30
COMMERCIAL OFFICE		
OPEN OFFICE	40	30 - 50
PRIVATE OFFICE	40	30 - 50
CONFERENCE ROOM	30	
RESTROOM	18	7.5 - 30
BREAK ROOM	15	5 - 20
INDUSTRIAL/MANUFACTURING		
SIMPLE ASSEMBLY	30	15 - 60
LARGE COMPONENT	30	15 - 60
MEDIUM COMPONENT	50	25 - 100
RETAIL		
GENERAL	50	
DEPARTMENT STORE	40	20 - 80

2 ELECTRICAL LIGHTING PLAN
1/8" = 1'-0"



11/21/2025

2018 APPENDIX B
BUILDING CODE SUMMARY FOR ALL COMMERCIAL PROJECTS

ELECTRICAL DESIGN
(PROVIDE ON THE ELECTRICAL SHEETS IF APPLICABLE)

ELECTRICAL SUMMARY

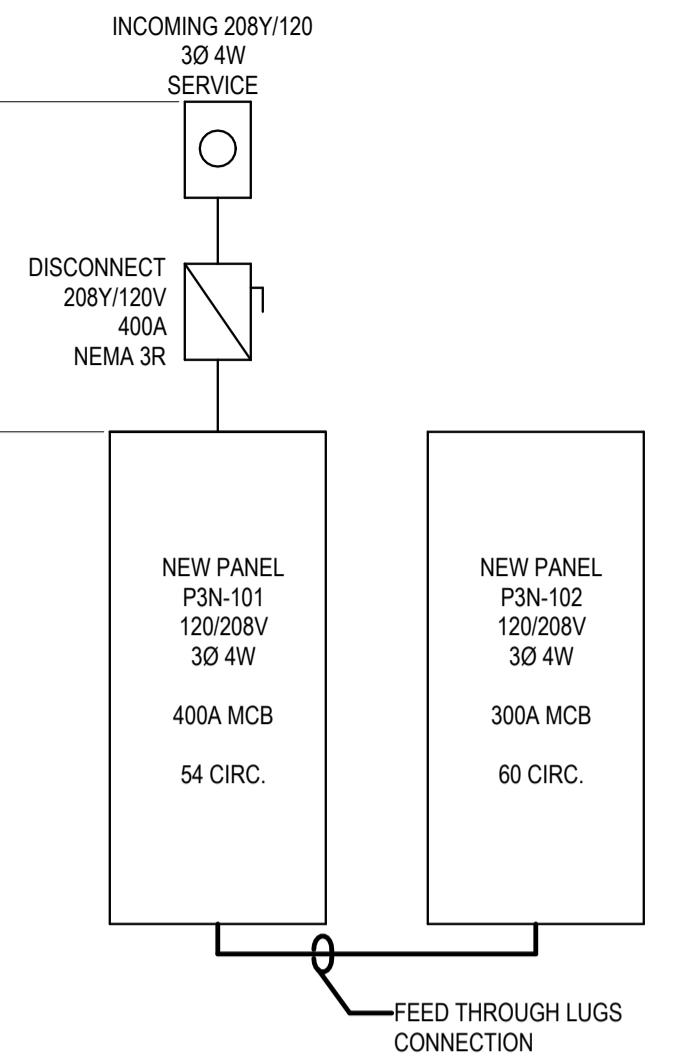
ELECTRICAL SYSTEM AND EQUIPMENT

Method of Compliance: Energy Code: Prescriptive Performance
ASHRAE 90.1: Prescriptive Performance


Lighting schedule (each fixture type)
lamp type required in fixture
number of lamps in fixture
ballast type used in the fixture
number of ballasts in fixture
total wattage per fixture
total interior wattage specified vs. allowed (whole building or space by space)
total exterior wattage specified vs. allowed

Additional Efficiency Package Options
(When using the 2018 NCECC; not required for ASHRAE 90.1)

- C406.2 More Efficient Mechanical Equipment
- C406.3 Reduced Lighting Power Density
- C406.4 Enhanced Digital Lighting Controls
- C406.5 On-Site Renewable Energy
- C406.6 Dedicated Outdoor Air System
- C406.7 Reduced Energy Use in Service Water Heating



1 POWER RISER
NOT TO SCALE

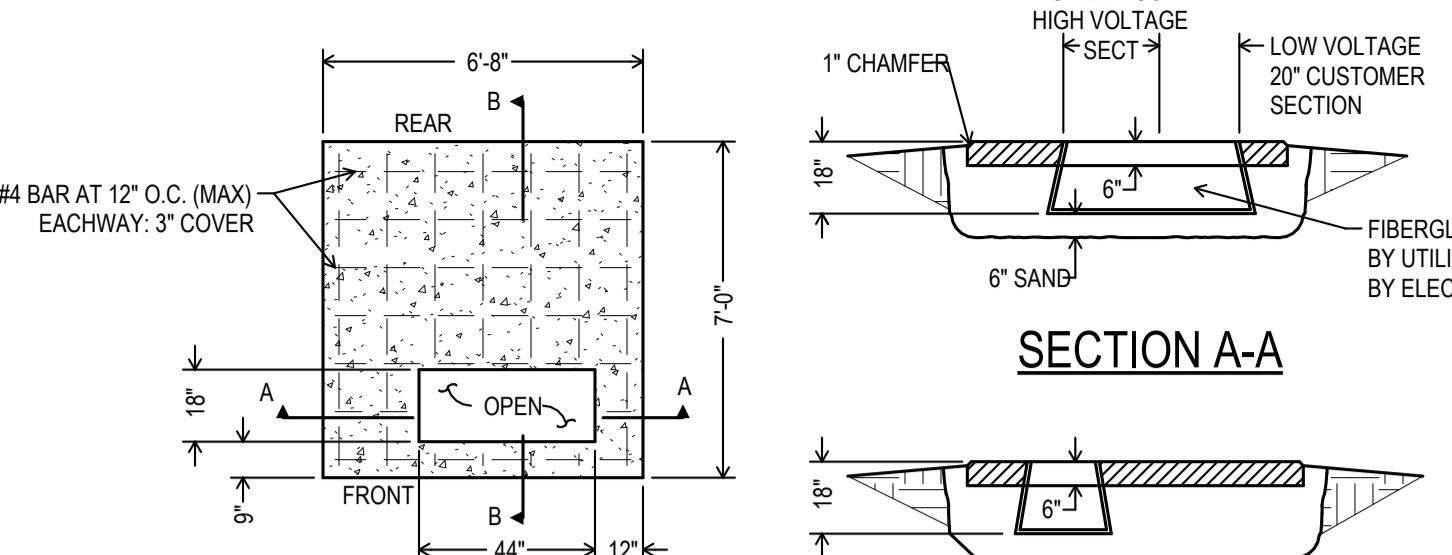

KEYNOTES

1 SEE LIGHTING FIXTURE SCHEDULE FOR MORE INFORMATION.

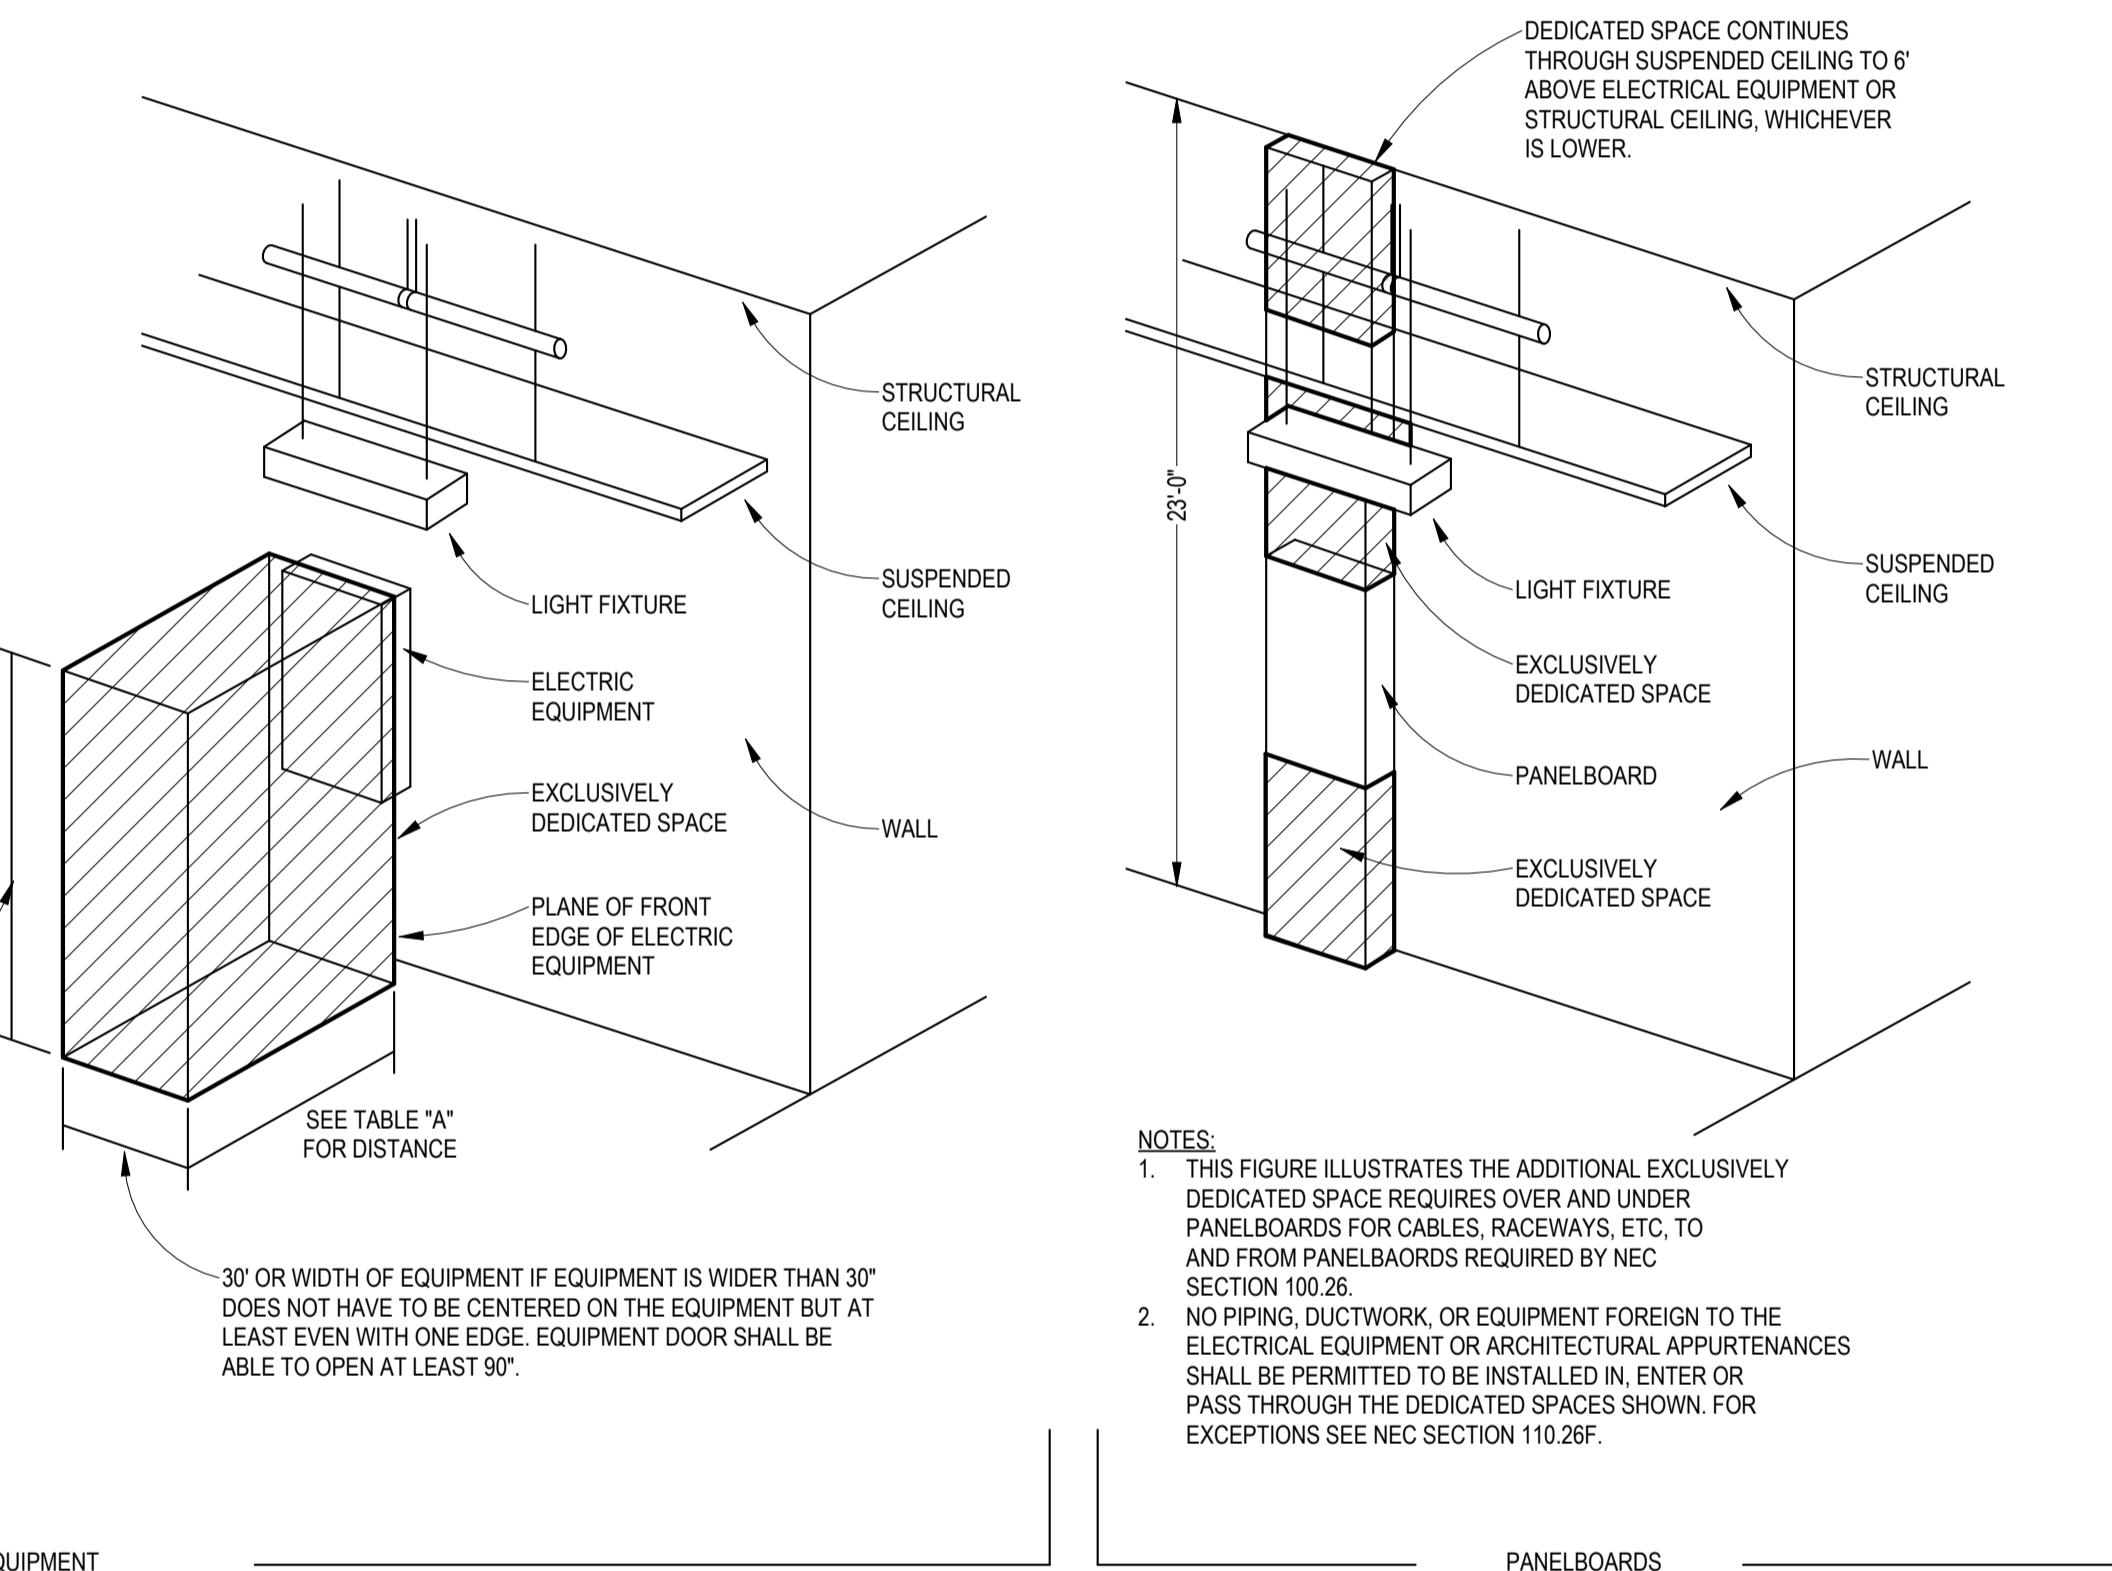
PLAN VIEW

NOTES:

1. AIR ENTRAINED CONCRETE-4000 PSI AFTER 28 DAYS, MAX AGGREGATE 3/4".
2. STEEL FLOAT FINISH.
3. REINFORCEMENT: TYPE A-305 NEW BILLET STOCK A.S.T.M. GRADE 60.
4. ALL REINFORCING SHALL BE #4 BAR 12" O.C. EACHWAY. WIRE TIE ALL CROSSINGS.
5. IF THE ANTICIPATED FORECAST TEMPERATURE IS 35° OR LESS, THE PAD SHALL BE INSULATED WITH EITHER BLANKETS OR POLY AND STRAW FOR A MINIMUM OF 3 DAYS.
6. APPLY MEMBRANE CURING COMPOUND, MEETING A.S.T.M. C-309, AT MANUFACTURERS PRESCRIBED RATE AFTER REMOVAL OF FORMS.
7. CHAMFERED EDGE ALONG OUTSIDE EDGES SHALL BE 1".
8. A SAFE OPERATING CLEARANCE OF A MINIMUM OF 6'-0" IS NEEDED IN FRONT OF THE TRANSFORMER.
9. IF NECESSARY, ELECTRICAL CONTRACTOR MAY REMOVE TOP LIP OF FIBERGLASS SLEEVE IN THE LOW VOLTAGE SECTION.
10. FIBERGLASS SLEEVE SHALL BE FURNISHED BY UTILITY COMPANY, INSTALLED BY ELECTRICAL CONTRACTOR.

SECTION B-B

2 3 PHASE 30 TO 300 KVA TRANSFORMER PAD
NOT TO SCALE



ALL ELECTRIC EQUIPMENT

PANELBOARDS


TABLE "A" WORKING CLEARANCES			
VOLTAGE TO GROUND	CONDITION: 1 (MINIMUM CLEARANCE)	2	3
NOMINAL			
0-150	3'	3'	3'
151-600	3'	3 1/2'	4'

WHERE THE "CONDITIONS" ARE AS FOLLOWS:


1. EXPOSED LIVE PARTS ON ONE SIDE AND NO LIVE OR GROUND PARTS ON THE OTHER SIDE OF THE WORKING SPACE, OR EXPOSED LIVE PARTS ON BOTH SIDES EFFECTIVELY GUARDED BY SUITABLE WOOD OR OTHER INSULATING MATERIALS. INSULATED WIRE OR INSULATED BUSBARS OPERATING AT NOT OVER 300 VOLTS SHALL NOT BE CONSIDERED LIVE PARTS.
2. EXPOSED LIVE PARTS ON ONE SIDE AND GROUNDED PARTS ON THE OTHER SIDE.
3. EXPOSED LIVE PARTS ON BOTH SIDES OF THE WORK SPACE (NOT GUARDED AS PROVIDED IN CONDITION 1) WITH THE OPERATOR BETWEEN.

NOTES:
1. THIS FIGURE ILLUSTRATES THE WORKING SPACE IN FRONT OF ELECTRICAL EQUIPMENT REQUIRED BY NEC SECTION 110.26.
2. THIS INCLUDES BUT IS NOT LIMITED TO PANELBOARDS, SAFETY SWITCHES, MOTOR STARTERS, JUNCTION BOXES, AND OTHER ELECTRICAL EQUIPMENT.


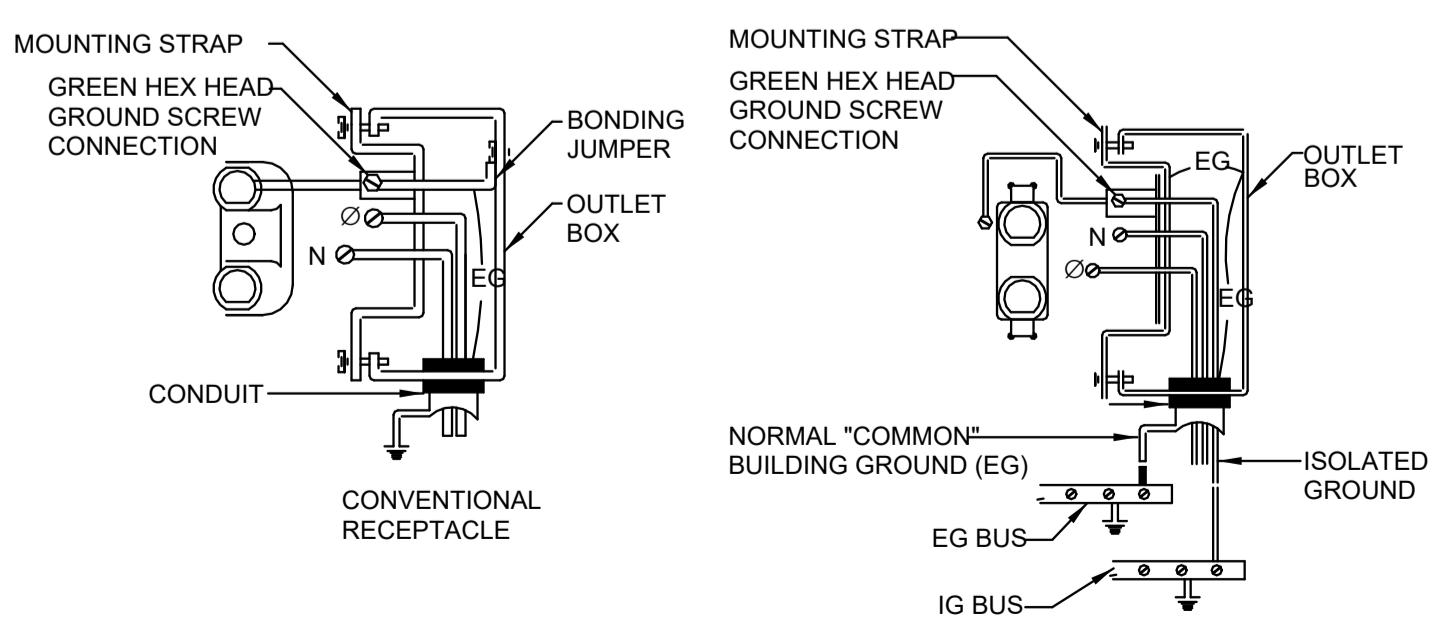
3 DEDICATED WORKING SPACE
NOT TO SCALE



4 RECEPTACLE WIRING DETAIL
NOT TO SCALE

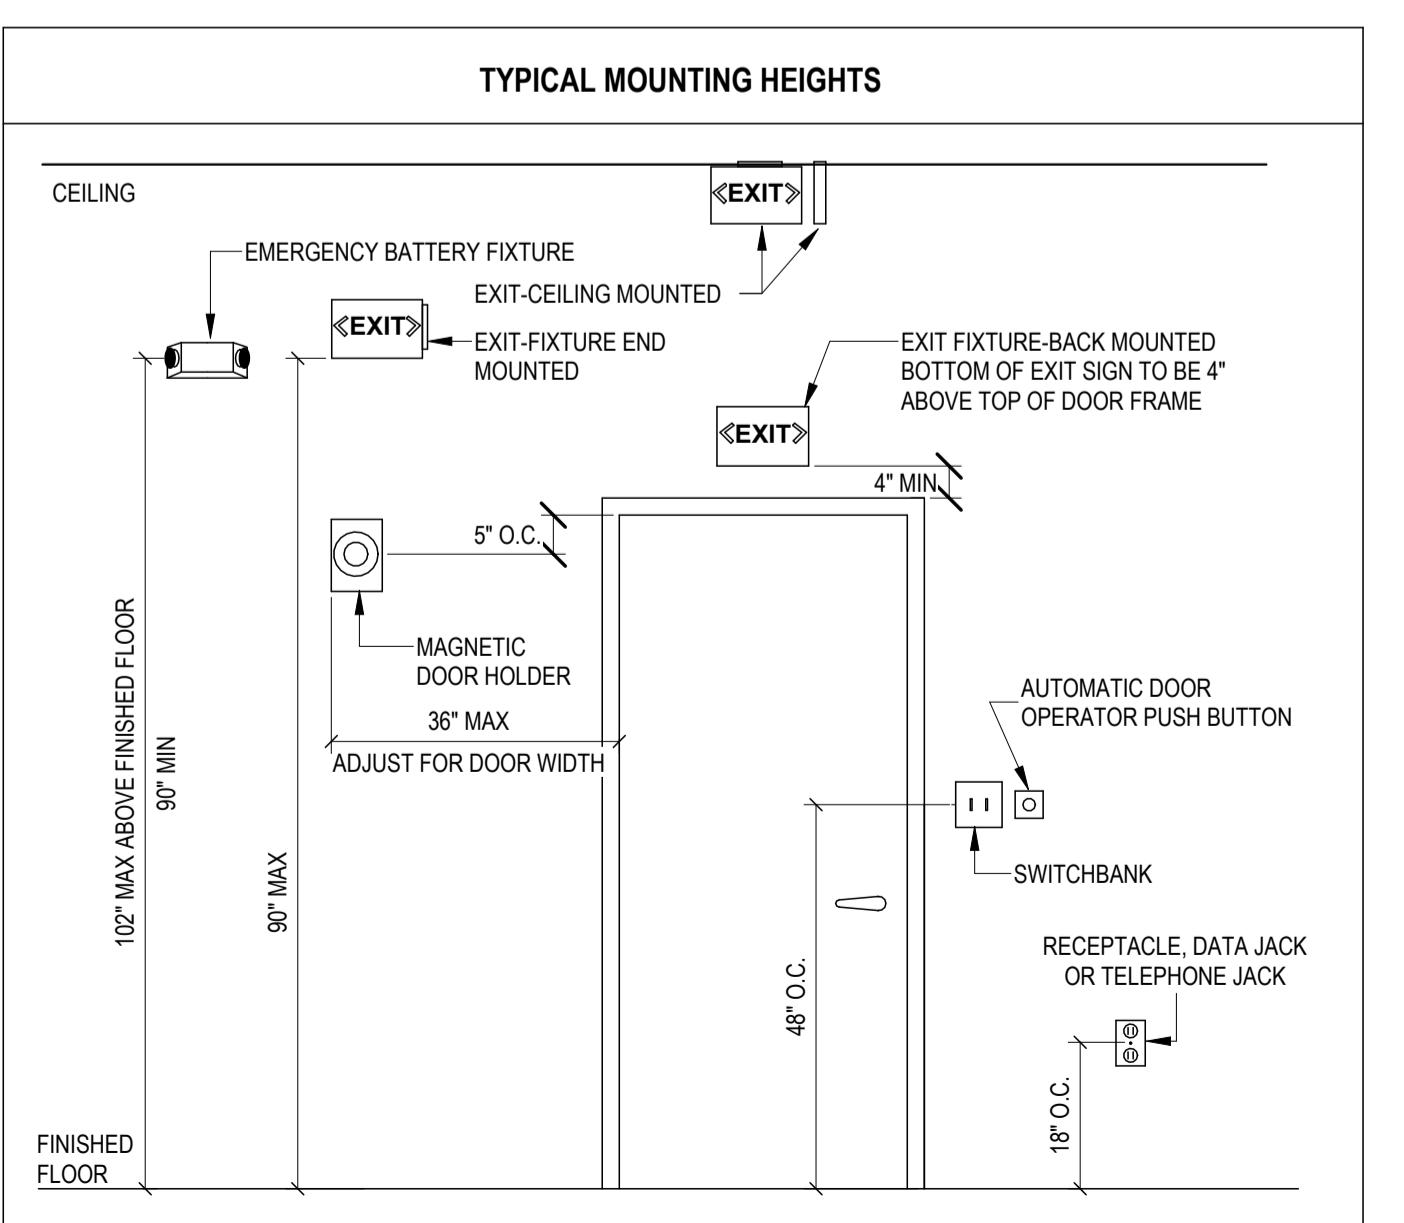

5 TYPICAL MOUNTING HEIGHTS
NOT TO SCALE

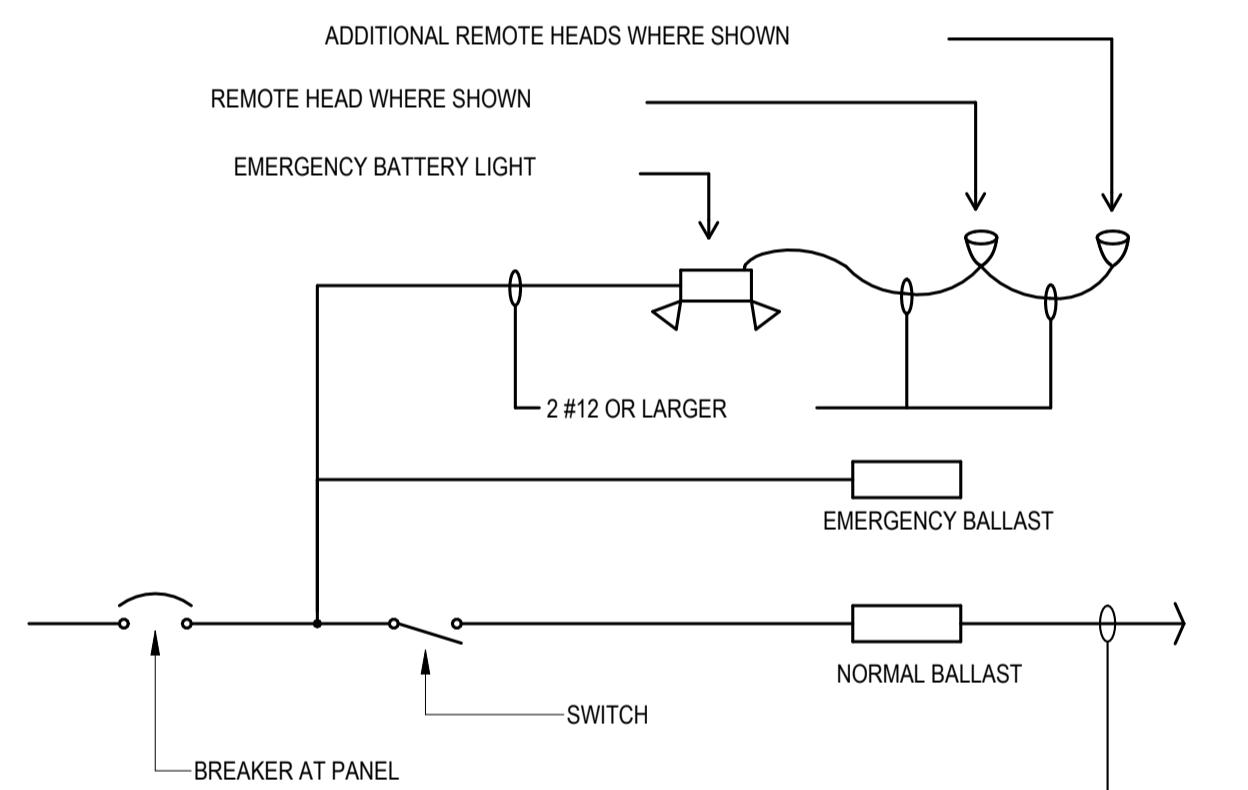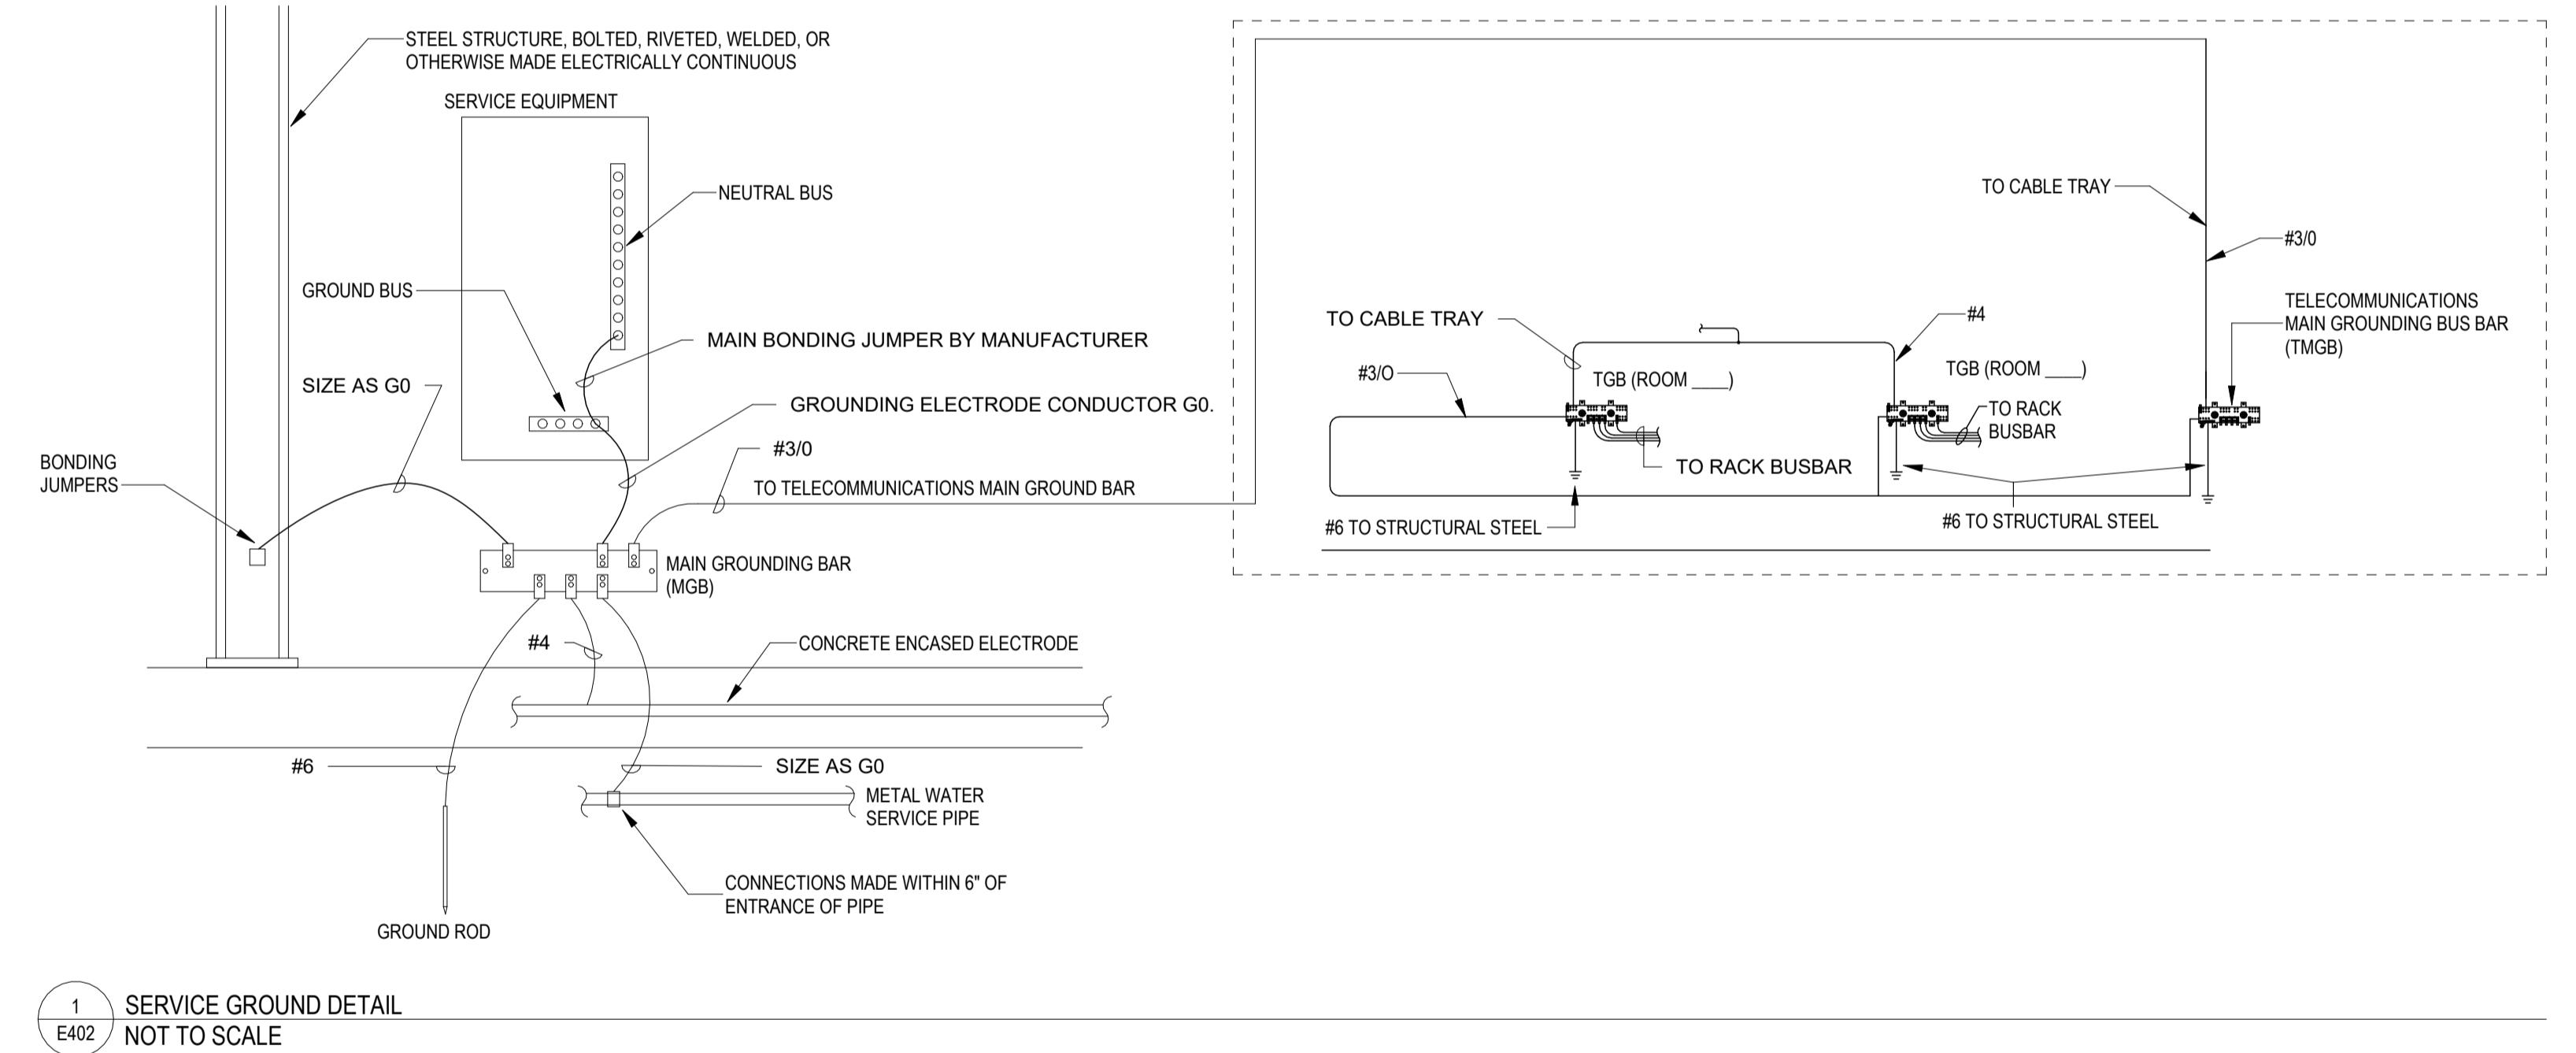



ISSUED FOR CONSTRUCTION

E&M CONCRETE
308 JARCO DRIVE
FUQUAY-VARINA, NC 27526

PROJECT: 224S91
DATE ISSUED: 8/20/2024
REV DATE DESCRIPTION

DRAWN BY: JCD
CHECK BY: BDL
ELECTRICAL SYSTEMS PLAN
11/21/2025

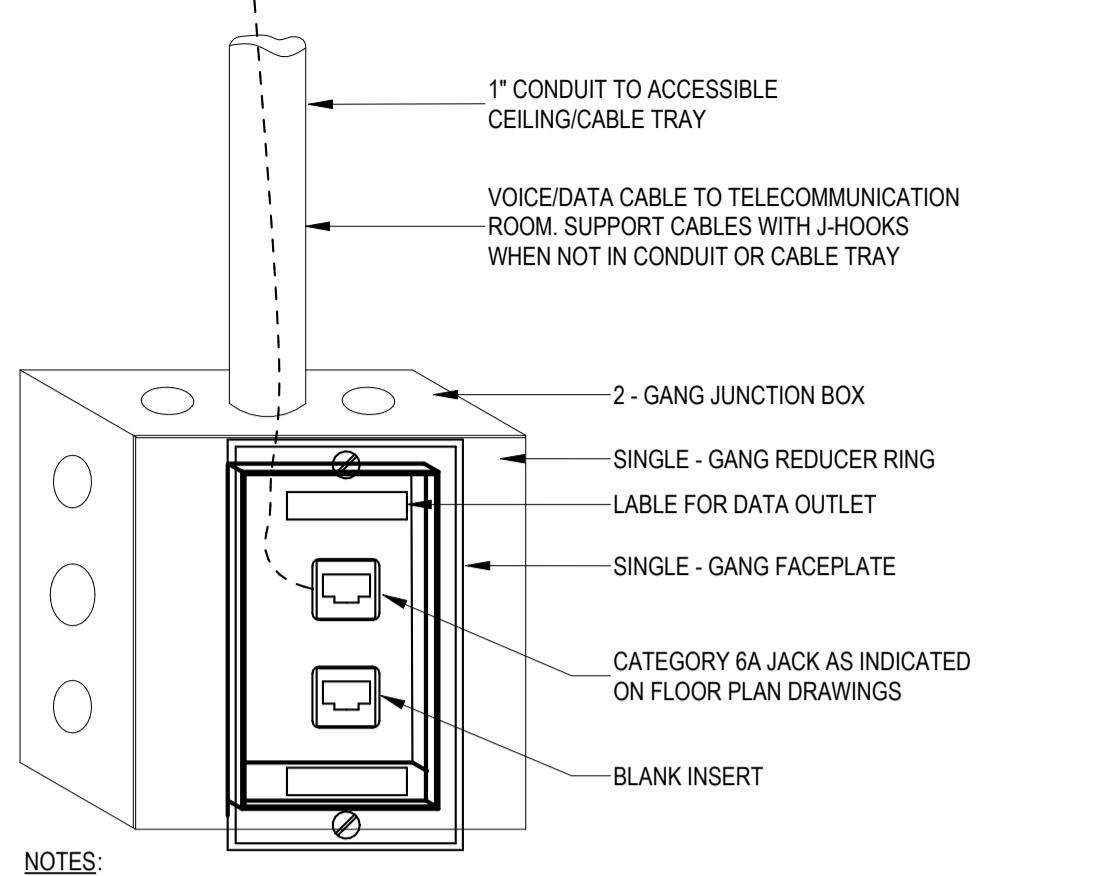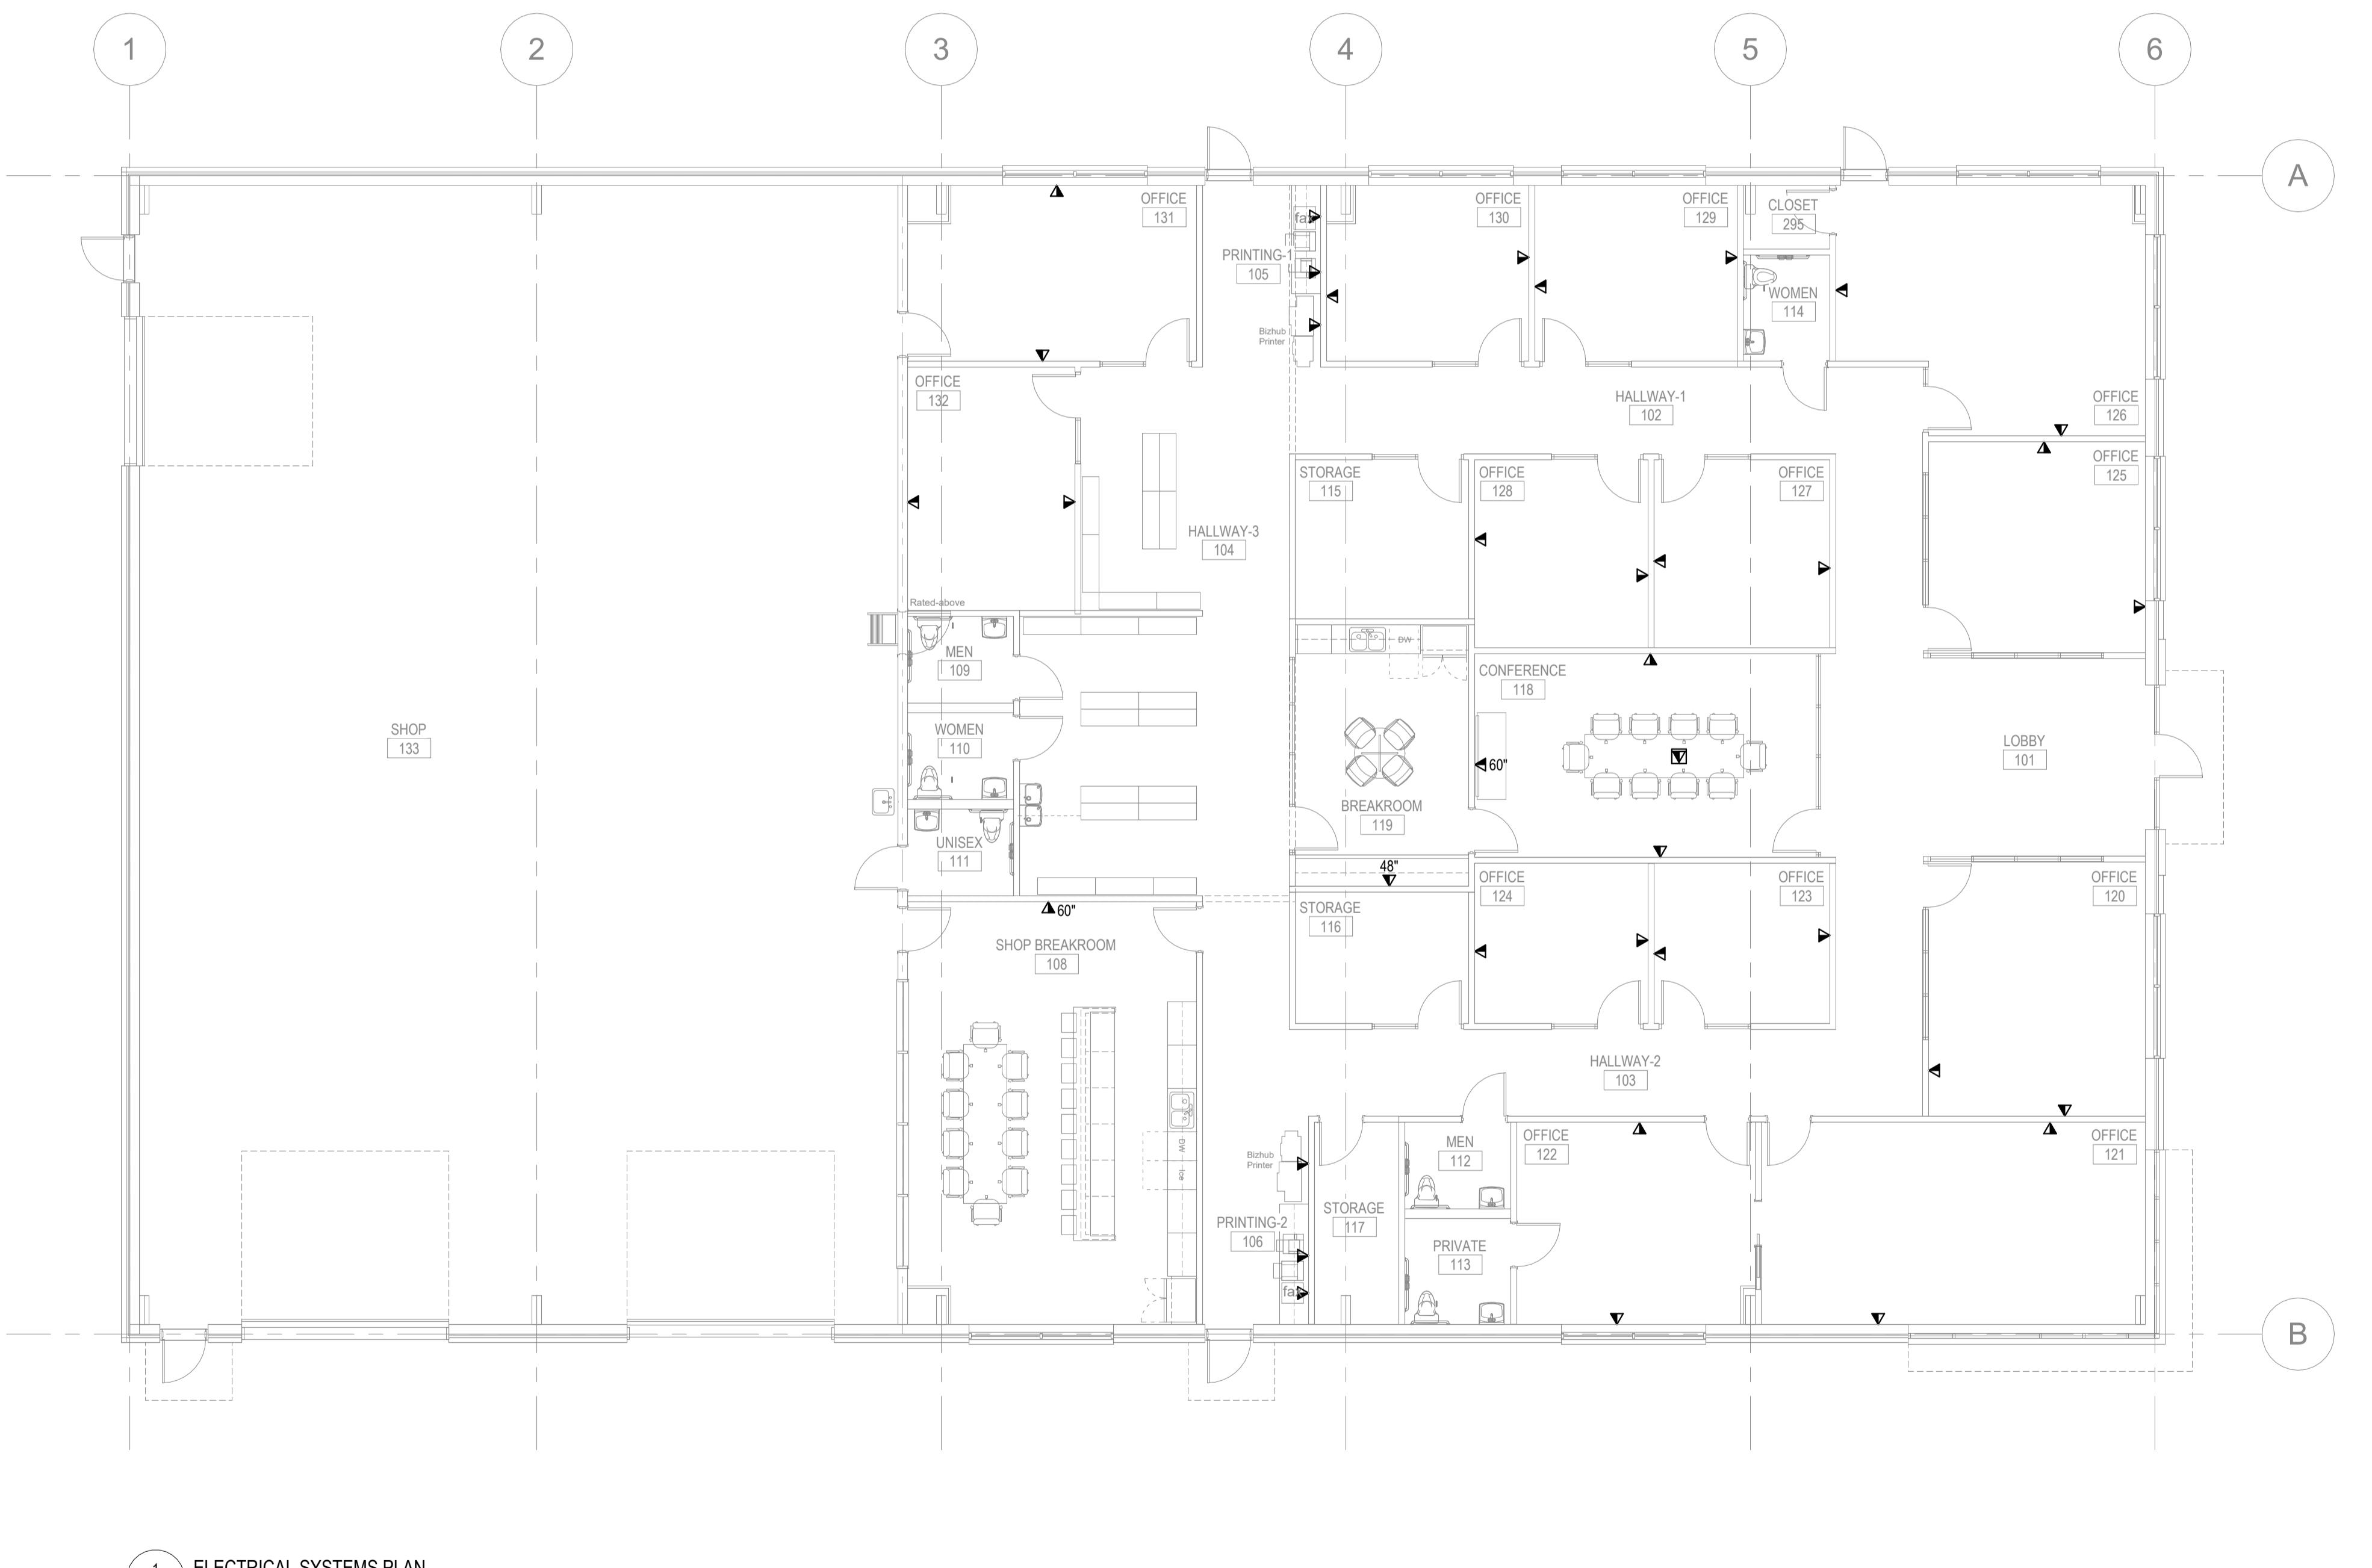
E501




NOTES:

1. TERMINATE VOICE AND DATA OUTLETS WITH T568B/T568A PIN-OUT SEQUENCE.
2. ROUTE CABLES TO TELECOMMUNICATION ROOMS AND TERMINATE ON RACK-MOUNTED CATEGORY 6A PATCH PANELS.
3. LABEL VOICE AND DATA JACK WITH THE TELECOMMUNICATION ROOM NUMBER, PATCH PANEL NUMBER AND JACK POSITION NUMBER (EX. 005-A-18).
4. INSTALL BLANK INSERT ON OPEN PORTS WHEN JACKS ARE NOT INSTALLED WHEN VOICE/DATA OUTLETS ARE INSTALLED AT MODULAR FURNITURE OR FLOOR BOX LOCATIONS, PROVIDED COMPATIBLE ADAPTER PLATES.

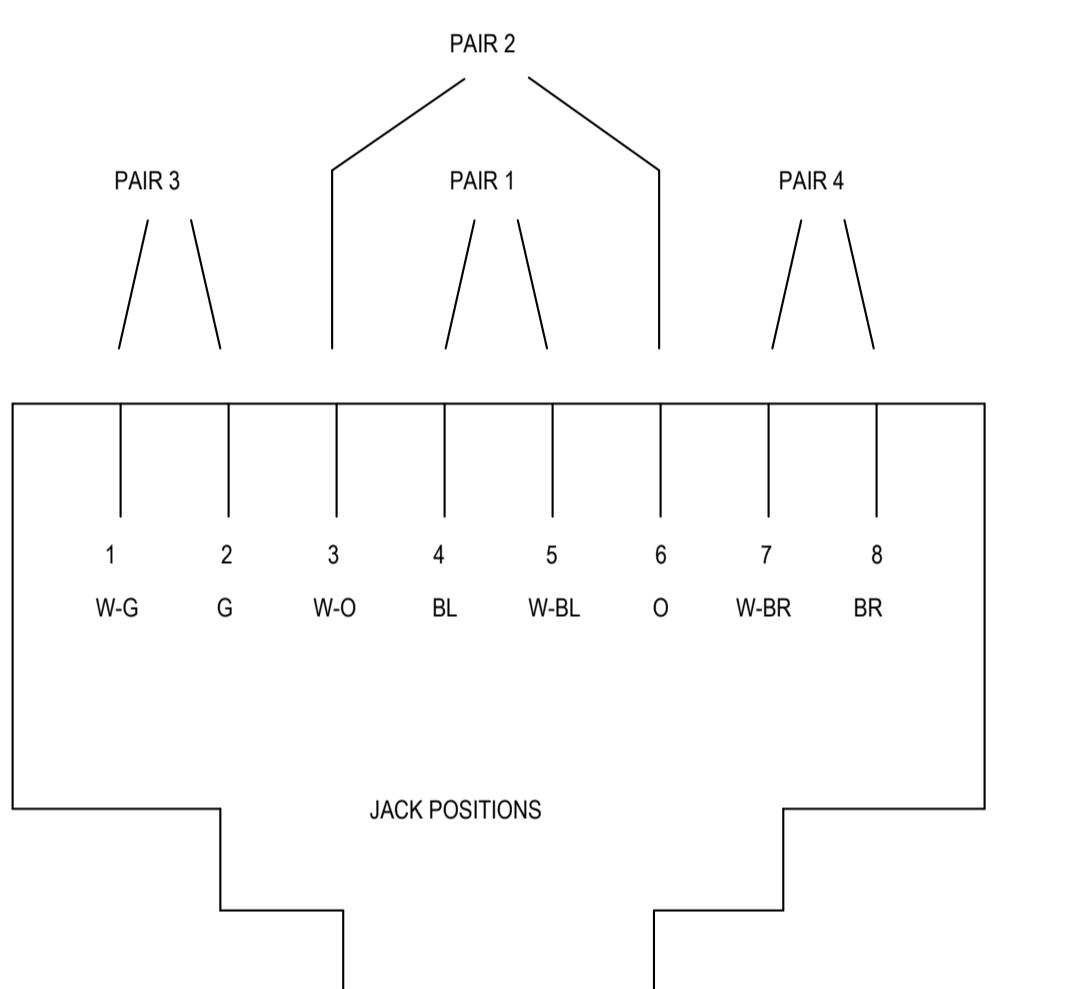
4 E501 2-PORT SINGLE DROP VOICE/DATA OUTLET DETAIL
NOT TO SCALE



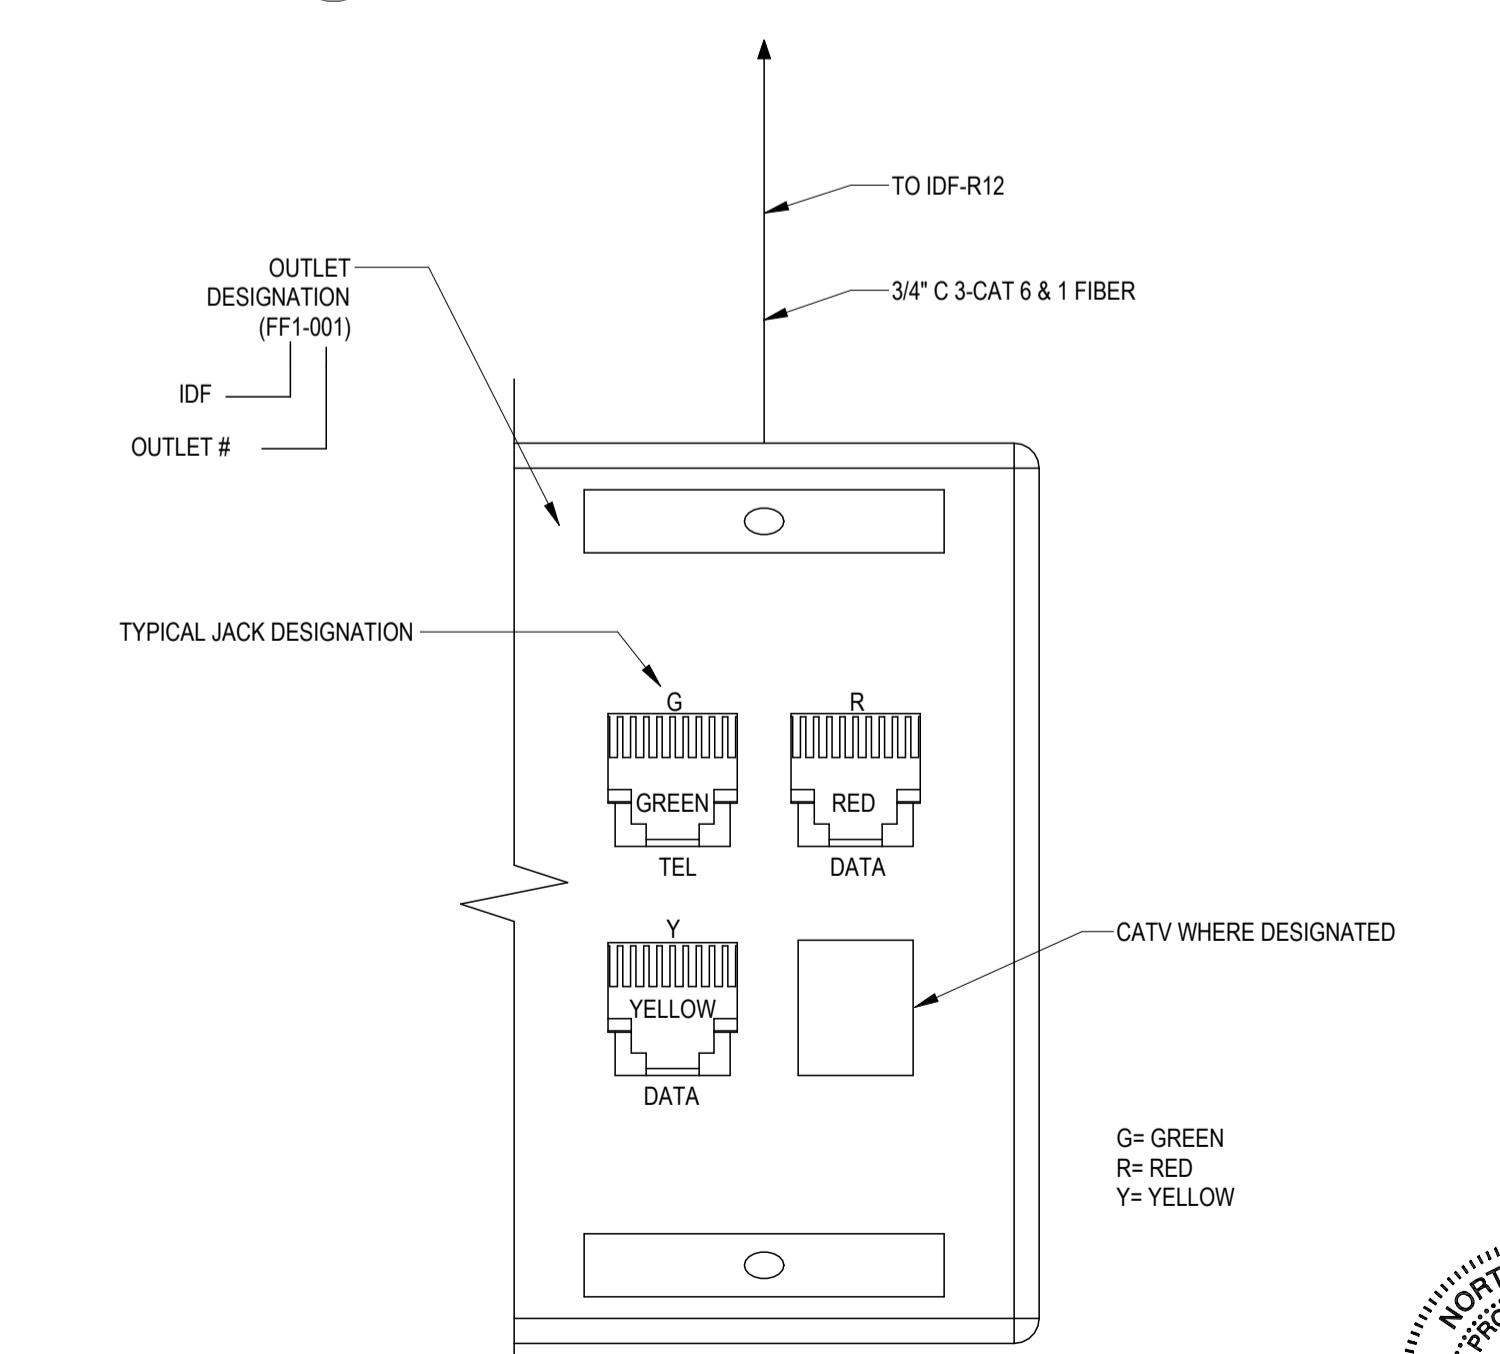3 E501 T568A JACK PINOUT DETAIL
NOT TO SCALE



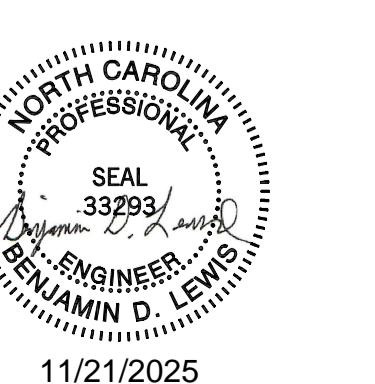2 E501 TYPICAL TELEPHONE/DATA DEVICE DETAIL 4 PORT
NOT TO SCALE



THESE DRAWINGS ARE THE PROPERTY OF KAIROS PROJECT GROUP. THESE DOCUMENTS HAVE BEEN PREPARED SPECIFICALLY FOR THE PROJECT DESCRIBED IN THE ADDRESS BAR. THEY ARE NOT SUITABLE FOR USE ON OTHER PROJECTS OR IN OTHER LOCATIONS WITHOUT WRITTEN APPROVAL FROM THE ENGINEER.








































































ISSUED FOR CONSTRUCTION

E&M CONCRETE
308 JARCO DRIVE
FUQUAY-VARINA, NC 27526

PROJECT: 224S91		
DATE ISSUED:	8/20/2024	
REV	DATE	DESCRIPTION

THESE DRAWINGS ARE THE PROPERTY OF KAIROS PROJECT GROUP. THESE DOCUMENTS HAVE BEEN PREPARED SPECIFICALLY FOR THE PROJECT DESCRIBED IN THE ADDRESS BAR. THEY ARE NOT SUITABLE FOR USE ON OTHER PROJECTS OR IN OTHER LOCATIONS WITHOUT WRITTEN APPROVAL FROM THE ENGINEER. REPRODUCTION IS PROHIBITED IF SIGNATURES ON COVER SHEET DO NOT APPEAR. THIS IS NOT AN AUTHORIZED COPY.

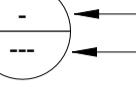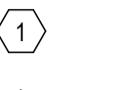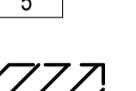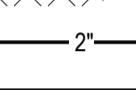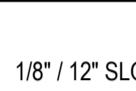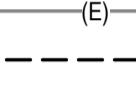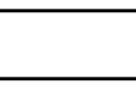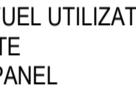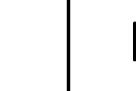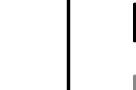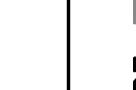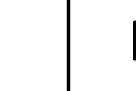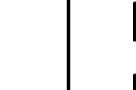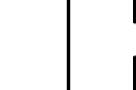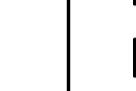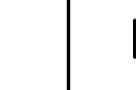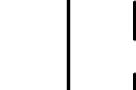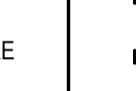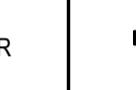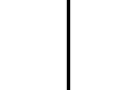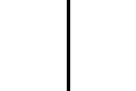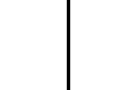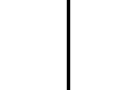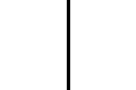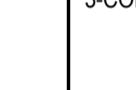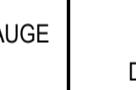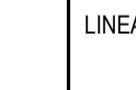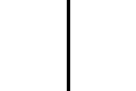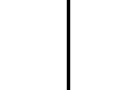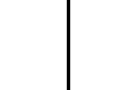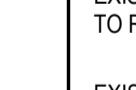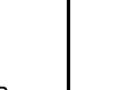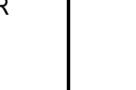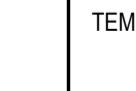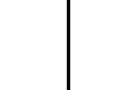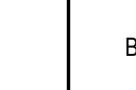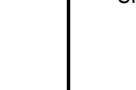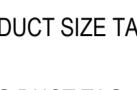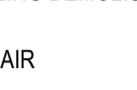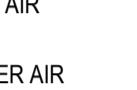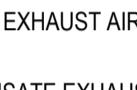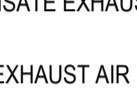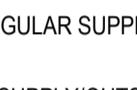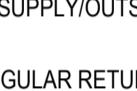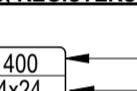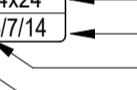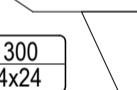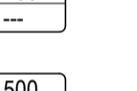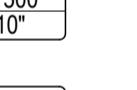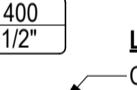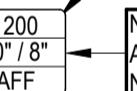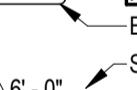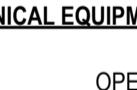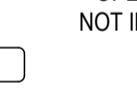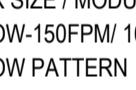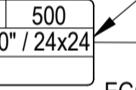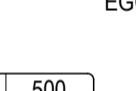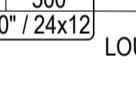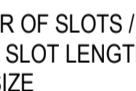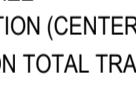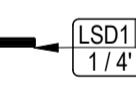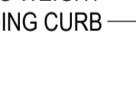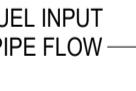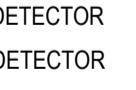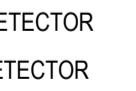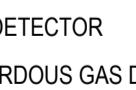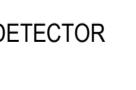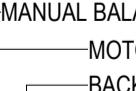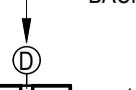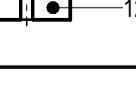 DRAWN BY: CAR
CHECK BY: BDL
HVAC TITLE SHEET
SEAL 33293
ENGINEER BENJAMIN D. LEWIS
11/21/2025

GENERAL MECHANICAL SYMBOLS	HVAC SYMBOLS	PIPING SYMBOLS
              	                                          	                                                          <img alt="12'X10' 24x24"

ISSUED FOR CONSTRUCTION

E&M CONCRETE
308 JARCO DRIVE
FUQUAY-VARINA, NC 27526



PROJECT: 224S91
DATE ISSUED: 8/20/2024
REV DATE DESCRIPTION
1 11/13/25 AS BUILTS

DRAWN BY: CAR
CHECK BY: BDL

HVAC FLOOR PLAN

M101

KEYNOTES	
1	MOUNT GAS HEATER 12' A.F.F. REFER TO DETAIL #8 ON SHEET M401.
2	CONTRACTOR SHALL INSTALL BIRDSCREEN AT END OF DUCT FROM ROOF MOUNTED EXHAUST FAN. REFER TO DETAIL #7 ON SHEET M401.
3	ALL EXHAUST OUTLETS SHALL MAINTAIN A MINIMUM DISTANCE OF AT LEAST 10' FROM ANY AND ALL AIR INLET INTAKES.
4	CONTRACTOR TO INSTALL VISIBLE/AUDIBLE ALARM NEXT TO THERMOSTAT WITH KEY SWITCH AND TESTING FUNCTION FOR EACH DUCT MOUNTED SMOKE DETECTOR.
5	CONTRACTOR TO INSTALL LOUVER TO MATCH LOCATION INDICATED ON ARCHITECTS ELEVATION.

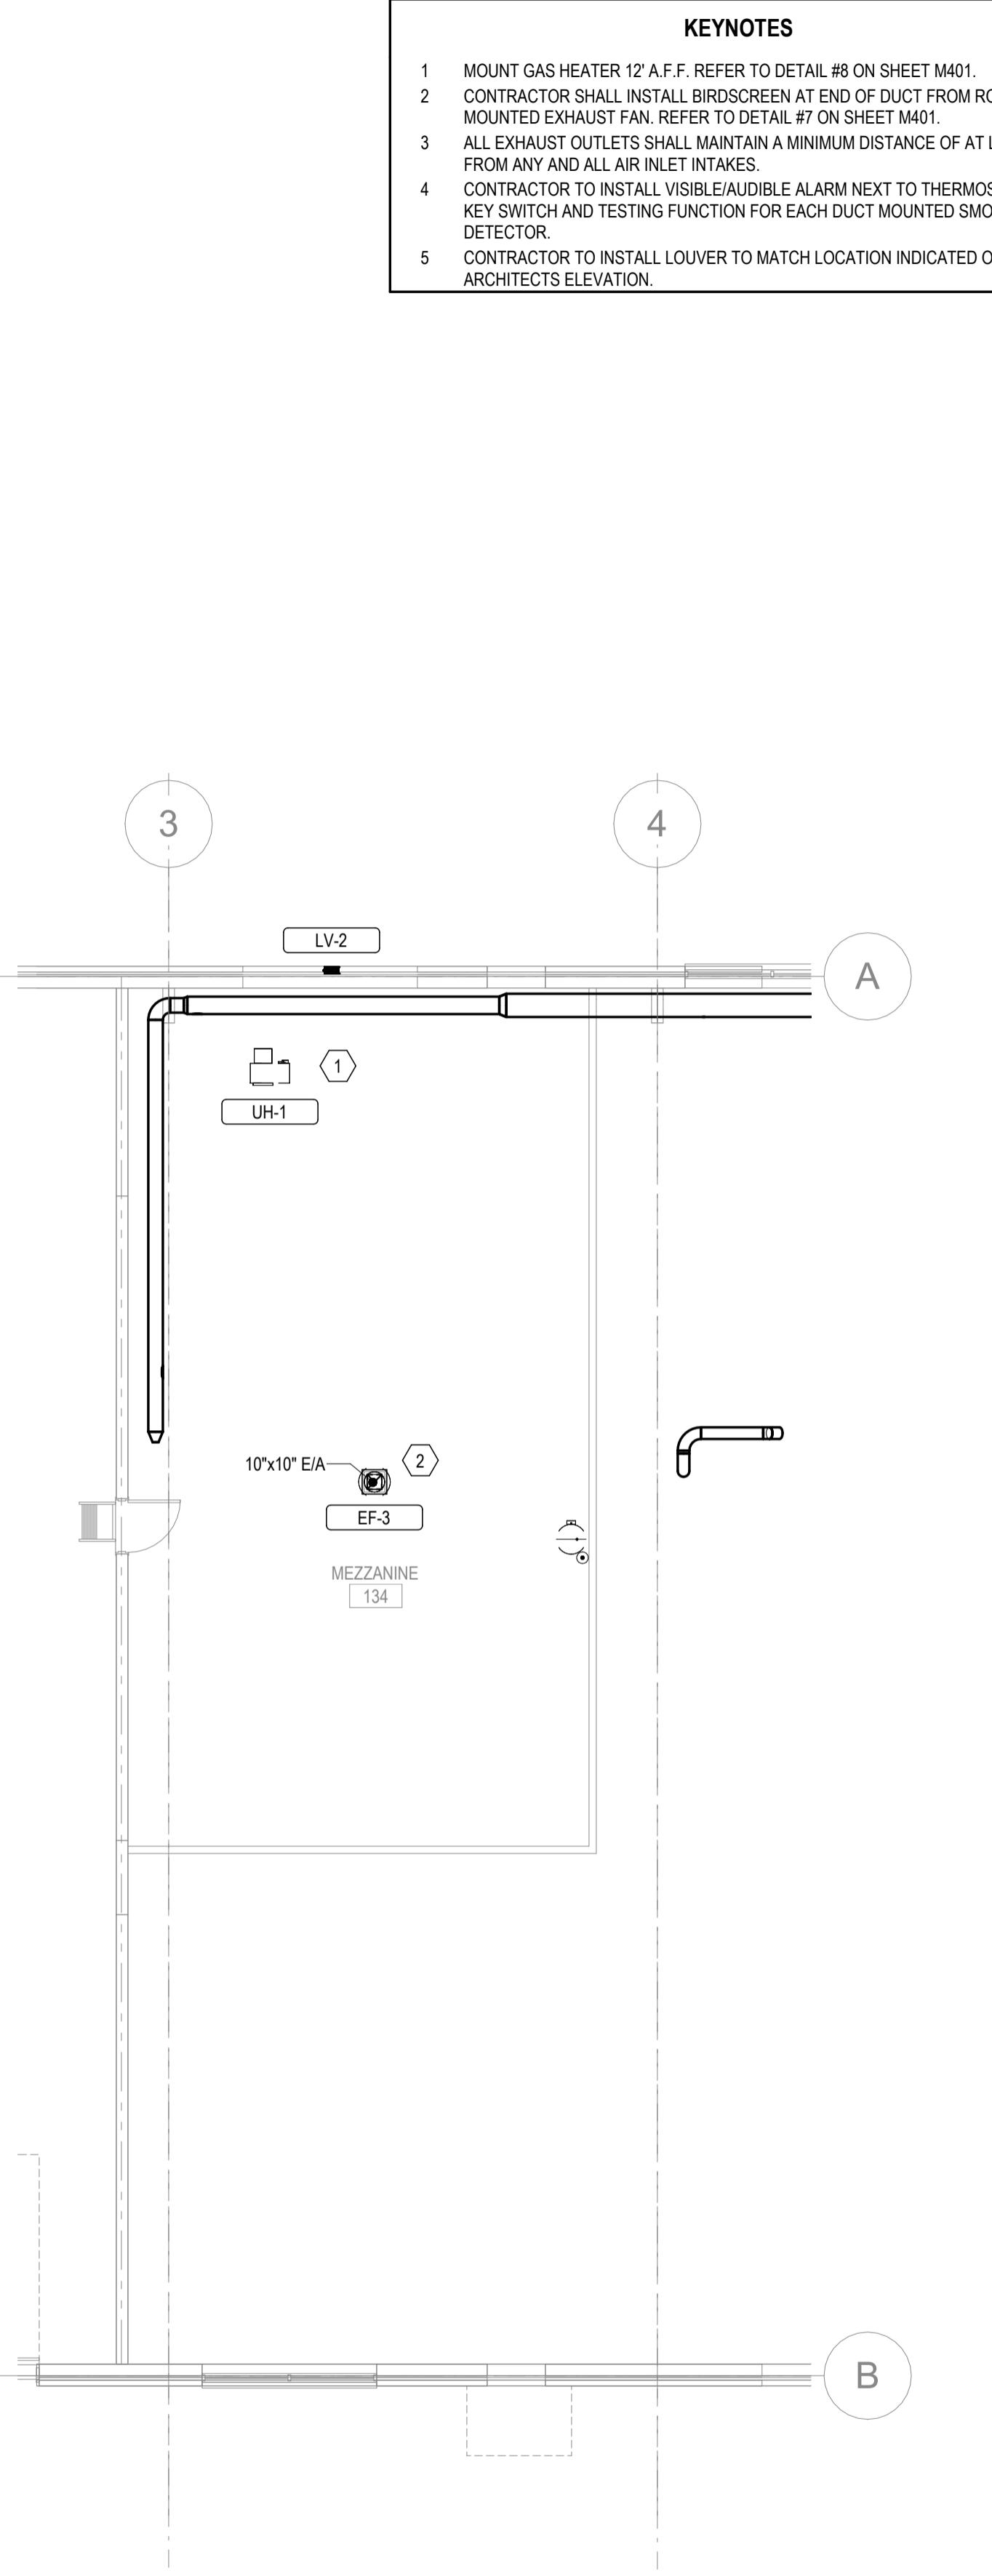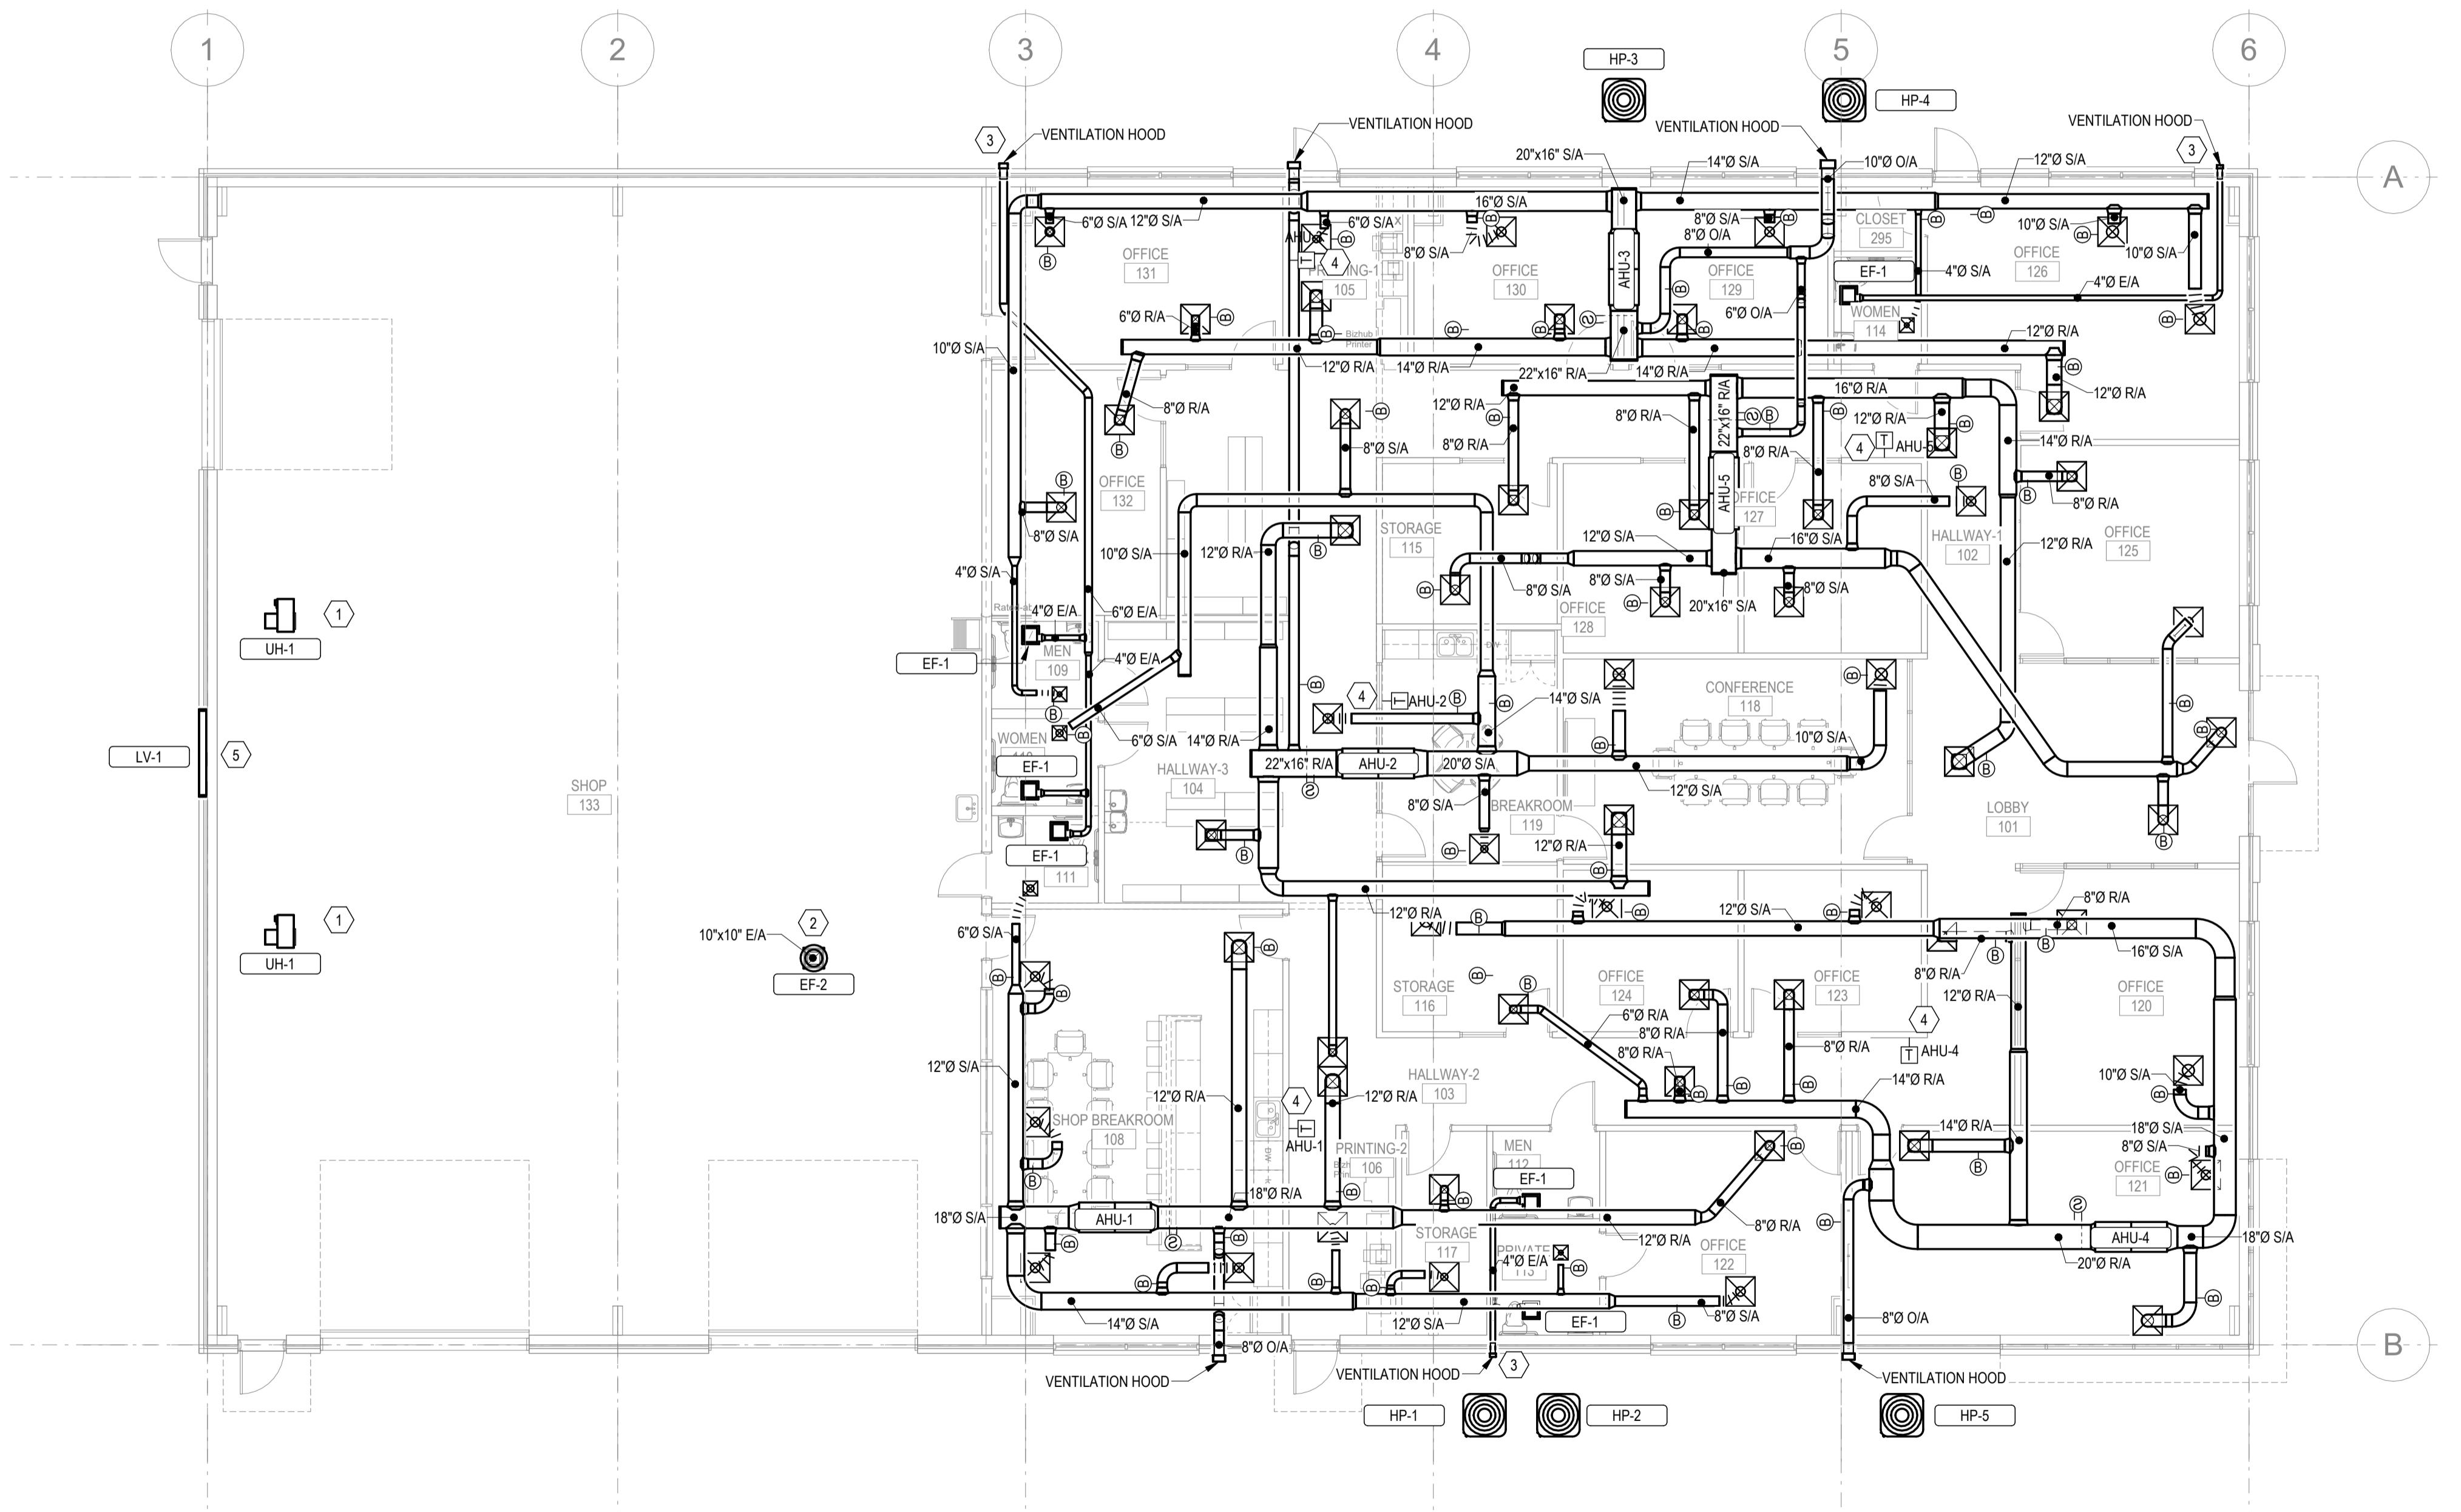

1

2

PROJECT: 224S91
DATE ISSUED: 8/20/2024

REV	DATE	DESCRIPTION
1	11/13/25	AS BUILTS

DRAWN BY: CAR
CHECK BY: BDL

HVAC REFLECTED
CEILING PLAN

M201

Architectural floor plan showing a building layout with various rooms, windows, and door symbols. The plan is divided into sections labeled 1 through 6 along the top edge. A vertical line labeled 'A' is on the right, and a vertical line labeled 'B' is on the bottom right. Numerous callouts point to specific components, each with a label and a dimension table.

Section 1: Shows a vertical line with a door symbol and a window symbol.

Section 2: Shows a vertical line with a door symbol and a window symbol.

Section 3: Shows a vertical line with a door symbol and a window symbol. Callouts point to components with labels and dimensions:

- SD1 350 8" / 24x24
- RD1 155 6" / 24x24
- SD1 150 6" / 24x24
- RD1 180 10" / 24x24
- SD1 220 8" / 24x24
- RD1 250 8" / 24x24
- SD1 290 8" / 24x24
- RD1 325 12" / 24x24
- SD1 60 4" / 12x12
- SD1 220 8" / 24x24
- RD1 180 8" / 24x24
- SD1 200 8" / 24x24
- SD1 170 10" / 24x24
- SD1 220 8" / 24x24
- SD1 170 10" / 24x24
- SD1 200 8" / 24x24
- SD1 165 6" / 24x24
- SD1 160 10" / 24x24
- SD1 270 8" / 24x24
- SD1 270 8" / 24x24
- SD1 270 8" / 24x24
- SD1 210 8" / 24x24
- SD1 150 6" / 24x24
- SD1 120 6" / 24x24
- SD1 60 4" / 12x12
- SD1 340 8" / 24x24
- SD1 60 4" / 12x12
- SD1 370 10" / 24x24

Section 4: Shows a vertical line with a door symbol and a window symbol. Callouts point to components with labels and dimensions:

- SD1 250 8" / 24x24
- RD1 220 8" / 24x24
- SD1 60 4" / 12x12
- SD1 295 10" / 24x24
- RD1 520 12" / 24x24
- SD1 250 8" / 24x24
- RD1 200 8" / 24x24
- SD1 220 8" / 24x24
- SD1 170 10" / 24x24
- SD1 200 8" / 24x24
- SD1 140 8" / 24x24
- SD1 330 8" / 24x24
- SD1 285 8" / 24x24
- SD1 285 8" / 24x24
- SD1 400 10" / 24x24
- SD1 190 8" / 24x24
- SD1 370 10" / 24x24

Section 5: Shows a vertical line with a door symbol and a window symbol. Callouts point to components with labels and dimensions:

- SD1 250 8" / 24x24
- RD1 220 12" / 24x24
- SD1 250 8" / 24x24
- RD1 140 8" / 24x24
- SD1 285 8" / 24x24
- SD1 285 8" / 24x24
- SD1 150 8" / 24x24
- RD1 360 8" / 24x24
- SD1 400 10" / 24x24

Section 6: Shows a vertical line with a door symbol and a window symbol. Callouts point to components with labels and dimensions:

- SD1 295 10" / 24x24
- SD1 295 10" / 24x24

1 HVAC REFLECTED CEILING PLAN
M201 1/8" = 1'-0"

ISSUED FOR CONSTRUCTION

E&M CONCRETE
308 JARCO DRIVE
FUQUAY-VARINA, NC 27526

2018 ICC NC MECHANICAL VENTILATION CALCULATIONS - AHU-1													
Room Name	Occupancy Category	Area (Az)	Occupancy Density (PEOPLE / 1000 SF)	Occupancy (Pz)	Occupancy Based		Area Based		Breathing Zone Outdoor Airflow (Vb = Rp * Pz + Ra * Az)	ASHRAE Zone Air Distribution Effectiveness (Ez)	Zone Outdoor Airflow (Voz = Vb / Ez)	Exhaust Rate	
					CFM / Person (Rp)	CFM (Ra * Az)	CFM / SF (Ra)	CFM (Ra * Az)					
UNISEX	Toilets - public	44.0 SF	0	0	0 CFM	0 CFM	0.06 CFM/SF	2.64 CFM	2.64 CFM	0.8	3 CFM	50 CFM	
OFFICE	Office space	231.0 SF	5	2	5 CFM	10 CFM	0.06 CFM/SF	13.86 CFM	23.86 CFM	0.8	30 CFM	0 CFM	
SHOP	Breakrooms	585.1 SF	50	30	5 CFM	150 CFM	0.06 CFM/SF	35.11 CFM	185.11 CFM	0.8	231 CFM	0 CFM	
MEN	Toilets - public	44.0 SF	0	0	0 CFM	0 CFM	0.06 CFM/SF	2.64 CFM	2.64 CFM	0.8	3 CFM	50 CFM	
PRIVATE	Toilets - private	53.8 SF	0	0	0 CFM	0 CFM	0.06 CFM/SF	3.23 CFM	3.23 CFM	0.8	4 CFM	50 CFM	
STORAGE	Storage rooms	81.8 SF	0	0	0 CFM	0 CFM	0.12 CFM/SF	9.81 CFM	9.81 CFM	0.8	12 CFM	0 CFM	
PRINTING-2	Corridors	105.7 SF	0	0	0 CFM	0 CFM	0.06 CFM/SF	6.34 CFM	6.34 CFM	0.8	8 CFM	0 CFM	
		1145.4 SF		32							292 CFM	150 CFM	
OUTDOOR AIR INTAKE FLOW RATE (CFM):					292								
EXHAUST FLOW RATE PLUS 8% FOR PRESSURIZATION (CFM):					162								
FINAL VENT. AIR REQUIREMENT (GREATER OF THE ABOVE CFM):					292								
AHU-1 TO PROVIDE 300 CFM OF OUTSIDE AIR.													

2018 ICC NC MECHANICAL VENTILATION CALCULATIONS - AHU-2													
Room Name	Occupancy Category	Area (Az)	Occupancy Density (PEOPLE / 1000 SF)	Occupancy (Pz)	Occupancy Based		Area Based		Breathing Zone Outdoor Airflow (Vb = Rp * Pz + Ra * Az)	ASHRAE Zone Air Distribution Effectiveness (Ez)	Zone Outdoor Airflow (Voz = Vb / Ez)	Exhaust Rate	
					CFM / Person (Rp)	CFM (Ra * Az)	CFM / SF (Ra)	CFM (Ra * Az)					
WOMEN	Toilets - public	44.0 SF	0	0	0 CFM	0 CFM	0.06 CFM/SF	2.64 CFM	2.64 CFM	0.8	3 CFM	50 CFM	
HALLWAY-3	Corridors	718.6 SF	0	0	0 CFM	0 CFM	0.06 CFM/SF	43.12 CFM	43.12 CFM	0.8	54 CFM	0 CFM	
CONFERENCE	Conference/meeting	332.7 SF	50	17	5 CFM	85 CFM	0.06 CFM/SF	19.96 CFM	104.96 CFM	0.8	131 CFM	0 CFM	
BREAKROOM	Breakrooms	217.2 SF	50	11	5 CFM	55 CFM	0.06 CFM/SF	13.03 CFM	68.03 CFM	0.8	85 CFM	0 CFM	
		1312.6 SF		28							273 CFM	50 CFM	
OUTDOOR AIR INTAKE FLOW RATE (CFM):					273								
EXHAUST FLOW RATE PLUS 8% FOR PRESSURIZATION (CFM):					54								
FINAL VENT. AIR REQUIREMENT (GREATER OF THE ABOVE CFM):					273								
AHU-2 TO PROVIDE 285 CFM OF OUTSIDE AIR.													

2018 ICC NC MECHANICAL VENTILATION CALCULATIONS - AHU-3													
Room Name	Occupancy Category	Area (Az)	Occupancy Density (PEOPLE / 1000 SF)	Occupancy (Pz)	Occupancy Based		Area Based		Breathing Zone Outdoor Airflow (Vb = Rp * Pz + Ra * Az)	ASHRAE Zone Air Distribution Effectiveness (Ez)	Zone Outdoor Airflow (Voz = Vb / Ez)	Exhaust Rate	
					CFM / Person (Rp)	CFM (Ra * Az)	CFM / SF (Ra)	CFM (Ra * Az)					
OFFICE	Office space	235.3 SF	5	2	5 CFM	10 CFM	0.06 CFM/SF	14.12 CFM	24.12 CFM	0.8	30 CFM	0 CFM	
OFFICE	Office space	195.0 SF	5	1	5 CFM	5 CFM	0.06 CFM/SF	11.70 CFM	16.70 CFM	0.8	21 CFM	0 CFM	
MEN	Toilets - public	44.0 SF	0	0	0 CFM	0 CFM	0.06 CFM/SF	2.64 CFM	2.64 CFM	0.8	3 CFM	50 CFM	
OFFICE	Office space	164.9 SF	5	1	5 CFM	5 CFM	0.06 CFM/SF	9.90 CFM	14.90 CFM	0.8	19 CFM	0 CFM	
OFFICE	Office space	170.3 SF	5	1	5 CFM	5 CFM	0.06 CFM/SF	10.22 CFM	15.22 CFM	0.8	19 CFM	0 CFM	
WOMEN	Toilets - public	44.1 SF	0	0	0 CFM	0 CFM	0.06 CFM/SF	2.64 CFM	2.64 CFM	0.8	3 CFM	50 CFM	
CLOSET	Storage rooms	26.4 SF	0	0	0 CFM	0 CFM	0.12 CFM/SF	3.17 CFM	3.17 CFM	0.8	4 CFM	0 CFM	
OFFICE	Office space	338.0 SF	5	2	5 CFM	10 CFM	0.06 CFM/SF	20.28 CFM	30.28 CFM	0.8	38 CFM	0 CFM	
PRINTING-1	Corridors	102.7 SF	0	0	0 CFM	0 CFM	0.06 CFM/SF	6.16 CFM	6.16 CFM	0.8	8 CFM	0 CFM	
		1320.7 SF		7							145 CFM	100 CFM	
OUTDOOR AIR INTAKE FLOW RATE (CFM):					145								
EXHAUST FLOW RATE PLUS 8% FOR PRESSURIZATION (CFM):					108								
FINAL VENT. AIR REQUIREMENT (GREATER OF THE ABOVE CFM):					145								
AHU-3 TO PROVIDE 300 CFM OF OUTSIDE AIR.													

2018 ICC NC MECHANICAL VENTILATION CALCULATIONS - AHU-4													
Room Name	Occupancy Category	Area (Az)	Occupancy Density (PEOPLE / 1000 SF)	Occupancy (Pz)	Occupancy Based		Area Based		Breathing Zone Outdoor Airflow (Vb = Rp * Pz + Ra * Az)	ASHRAE Zone Air Distribution Effectiveness (Ez)	Zone Outdoor Airflow (Voz = Vb / Ez)	Exhaust Rate	
CFM / Person (Rp)	CFM (Ra * Az)	CFM / SF (Ra)	CFM (Ra * Az)										

<tbl_r cells="1" ix="1" maxcspan="14" maxrspan

THESE DRAWINGS ARE THE PROPERTY OF KAIROS PROJECT GROUP. THESE DOCUMENTS HAVE BEEN PREPARED SPECIFICALLY FOR THE PROJECT DESCRIBED IN THE ADDRESS BAR. THEY ARE NOT SUITABLE FOR USE ON OTHER PROJECTS OR IN OTHER LOCATIONS WITHOUT WRITTEN APPROVAL FROM THE ENGINEER. REPRODUCTION IS PROHIBITED IF SIGNATURE OR COVER SHEET DOES NOT APPEAR. THIS IS NOT AN AUTHORIZED COPY.

2018 ICC NC MECHANICAL VENTILATION CALCULATIONS - SHOP & MEZZANINE															
Room Name	Occupancy Category	Area (Az)	Occupancy Density (PEOPLE / 1000 SF)	Occupancy (Pz)	Occupancy Based			Area Based			Breathing Zone Outdoor Airflow (Vb = Rp * Pz + Ra * Az)	ASHRAE Zone Air Distribution Effectiveness (Ez)	Zone Outdoor Airflow (Voz = Vb / Ez)	Exhaust Rate	
					CFM / Person (Rp)	CFM (Ra * Az)	CFM / SF (Ra)	CFM (Ra * Az)							
SHOP	Warehouses	4138.8 SF	0	0	0 CFM	0 CFM	0.06 CFM/SF	248.33 CFM	248.33 CFM	0.8	310 CFM	0 CFM			
MEZZANINE	Warehouses	1298.8 SF	0	0	0 CFM	0 CFM	0.06 CFM/SF	77.93 CFM	77.93 CFM	0.8	97 CFM	0 CFM			
		5437.6 SF		0							408 CFM	0 CFM			
OUTDOOR AIR INTAKE FLOW RATE (CFM): 408															
EXHAUST FLOW RATE PLUS 8% FOR PRESSURIZATION (CFM): 0															
FINAL VENT. AIR REQUIREMENT (GREATER OF THE ABOVE CFM): 408															
LV-1 TO PROVIDE 160 CFM OF OUTSIDE AIR EACH. LV-2 TO PROVIDE 100 CFM OF OUTSIDE AIR.															

AIR HANDLING UNIT SUMMARY SCHEDULE																			
ID	MANUFACTURER	MODEL NO.	QTY	VENTILATION DESIGN AIRFLOW	SUPPLY FAN DESIGN AIRFLOW	RETURN/EXHAUST FAN DESIGN AIRFLOW	NET COOLING CAP	LENGTH	WIDTH	HEIGHT	UNIT WEIGHT	FLA	MCA	MOCP	VOLT	PH	FREQ	INTERLOCK CONDENSING UNIT ID	REMARKS
AHU-1	CARRIER	FV4CNB006L00	1	300 CFM	1600 CFM	1300 CFM	48000 Btu/h	1'-10 1/16"	1'-9 1/8"	4'-5 7/16"	172 lb	4.3 A	5.4 A	15.0 A	208 V	1	60 Hz	HP-1	PROVIDE 8 KW OF AUXILIARY HEAT.
AHU-2	CARRIER	FV4CNB006L00	1	285 CFM	2000 CFM	1715 CFM	60000 Btu/h	1'-10 1/16"	2'-0 11/16"	4'-11 3/16"	207 lb	6.8 A	8.5 A	15.0 A	208 V	1	60 Hz	HP-2	PROVIDE 8 KW OF AUXILIARY HEAT.
AHU-3	CARRIER	FV4CNB006L00	1	300 CFM	2000 CFM	1700 CFM	60000 Btu/h	1'-10 1/16"	2'-0 11/16"	4'-11 3/16"	207 lb	6.8 A	8.5 A	15.0 A	208 V	1	60 Hz	HP-3	PROVIDE 8 KW OF AUXILIARY HEAT.
AHU-4	CARRIER	FV4CNB006L00	1	330 CFM	2000 CFM	1670 CFM	60000 Btu/h	1'-10 1/16"	2'-0 11/16"	4'-11 3/16"	207 lb	6.8 A	8.5 A	15.0 A	208 V	1	60 Hz	HP-4	PROVIDE 8 KW OF AUXILIARY HEAT.
AHU-5	CARRIER	FV4CNB006L00	1	160 CFM	2000 CFM	1840 CFM	60000 Btu/h	1'-10 1/16"	2'-0 11/16"	4'-11 3/16"	207 lb	6.8 A	8.5 A	15.0 A	208 V	1	60 Hz	HP-5	PROVIDE 8 KW OF AUXILIARY HEAT.

SPLIT SYSTEM AIR SOURCE HEAT PUMP																			
ID	MANUFACTURER	MODEL NO.	QTY	NOMINAL COOLING CAP	COMPRESSOR			SEER	EER	UNIT DIMENSIONS			UNIT WEIGHT	MCA	MOCP	VOLT	PH	FREQ	INTERLOCK
					RLA	REFRIGERANT TYPE	SEER			LENGTH	WIDTH	HEIGHT							
HP-1	CARRIER	25TPA748A003	1	4.0 ton	25.80 A	R-410A	17	12	2'-11"	2'-11"	3'-9 11/16"	294 lb	33.5 A	60.0 A	208 V	1	60 Hz	AHU-1	
HP-2	CARRIER	25TPA760A003	1	5.0 ton	26.90 A	R-410A	17	12	2'-11"	2'-11"	3'-9 11/16"	295 lb	35.1 A	60.0 A	208 V	1	60 Hz	AHU-2	
HP-3	CARRIER	25TPA760A003	1	5.0 ton	26.90 A	R-410A	17	12	2'-11"	2'-11"	3'-9 11/16"	295 lb	35.1 A	60.0 A	208 V	1	60 Hz	AHU-3	
HP-4	CARRIER	25TPA760A003	1	5.0 ton	26.90 A	R-410A	17	12	2'-11"	2'-11"	3'-9 11/16"	295 lb	35.1 A	60.0 A	208 V	1	60 Hz	AHU-4	
HP-5	CARRIER	25TPA760A003	1	5.0 ton	26.90 A	R-410A	17	12	2'-11"	2'-11"	3'-9 11/16"	295 lb	35.1 A	60.0 A	208 V	1	60 Hz	AHU-5	

GAS-FIRED UNIT HEATER SCHEDULE																		
ID	MANUFACTURER																	

ISSUED FOR CONSTRUCTION

**E & M CONCRETE
 308 JARCO DRIVE
 FUQUAY-VARINA, NC 27526**


PROJECT: 224S91
 DATE ISSUED: 8/20/2024
 REV DATE DESCRIPTION

DRAWN BY: CAR
 CHECK BY: BDL
 HVAC DETAILS


11/21/2025

M401


THESE DRAWINGS ARE THE PROPERTY OF KAIROS PROJECT GROUP. THESE DOCUMENTS HAVE BEEN PREPARED SPECIFICALLY FOR THE PROJECT DESCRIBED IN THE ADDRESS BAR. THEY ARE NOT SUITABLE FOR USE ON OTHER PROJECTS OR IN OTHER LOCATIONS WITHOUT WRITTEN APPROVAL FROM THE ENGINEER.

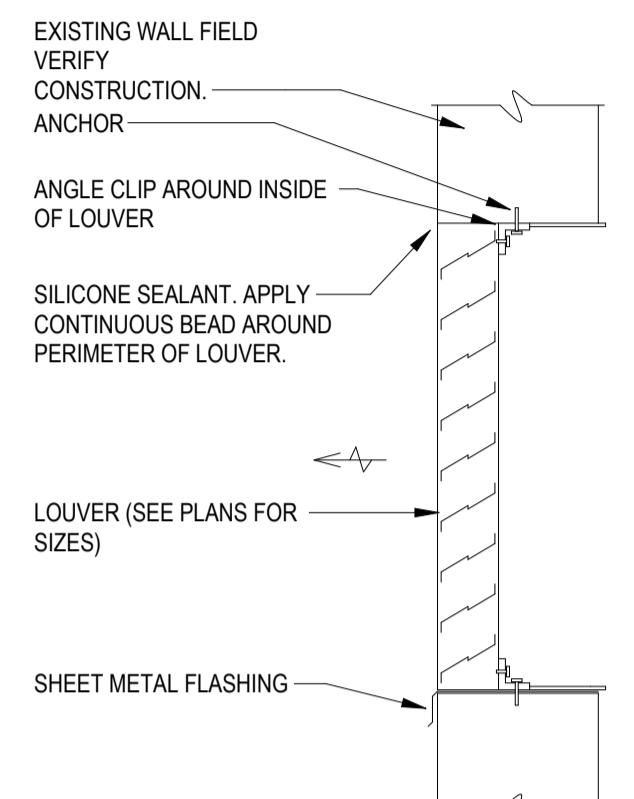

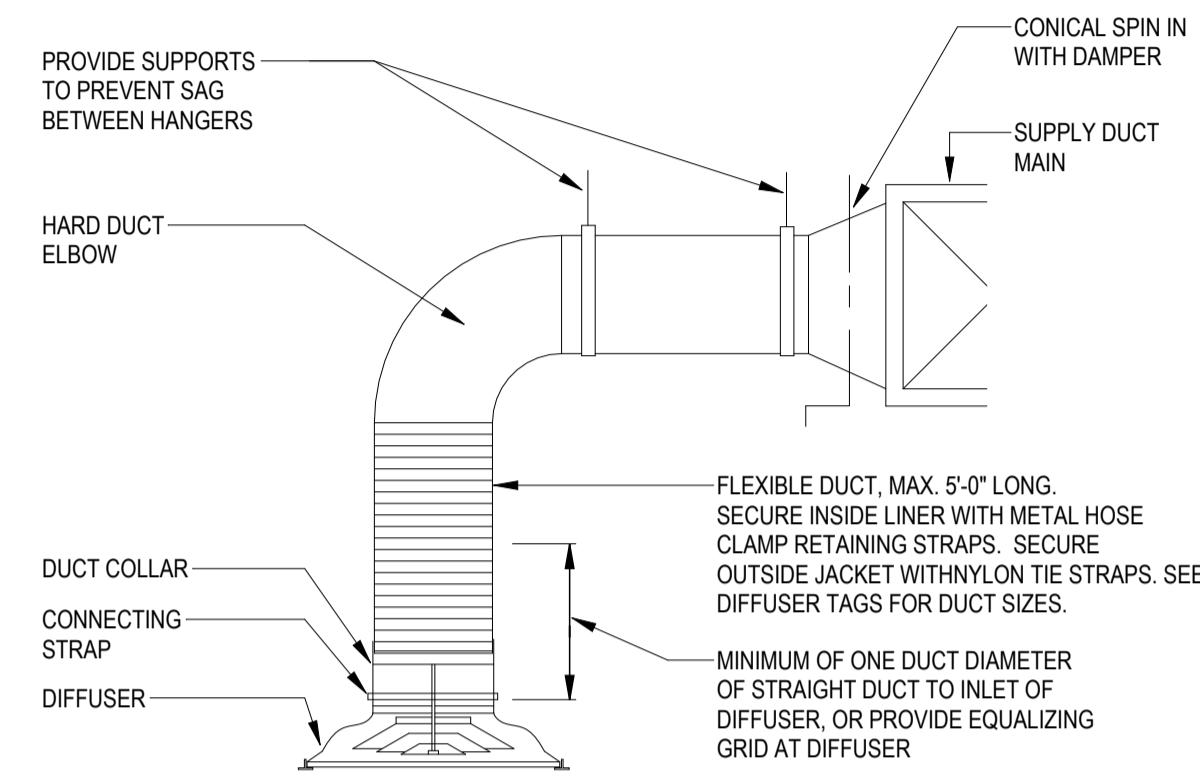
4 LOUVER ASSEMBLY DETAIL
 M401 NOT TO SCALE



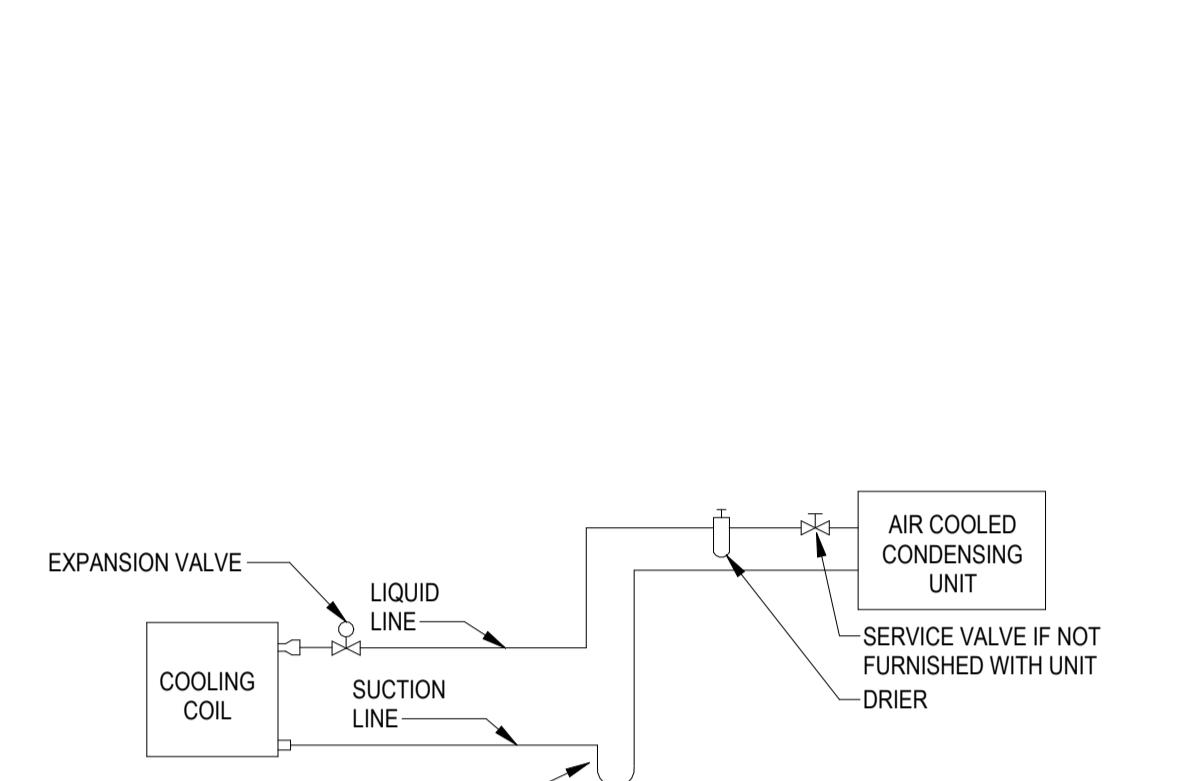
3 DIFFUSER FLEXIBLE DUCT CONNECTION
 M401 NOT TO SCALE



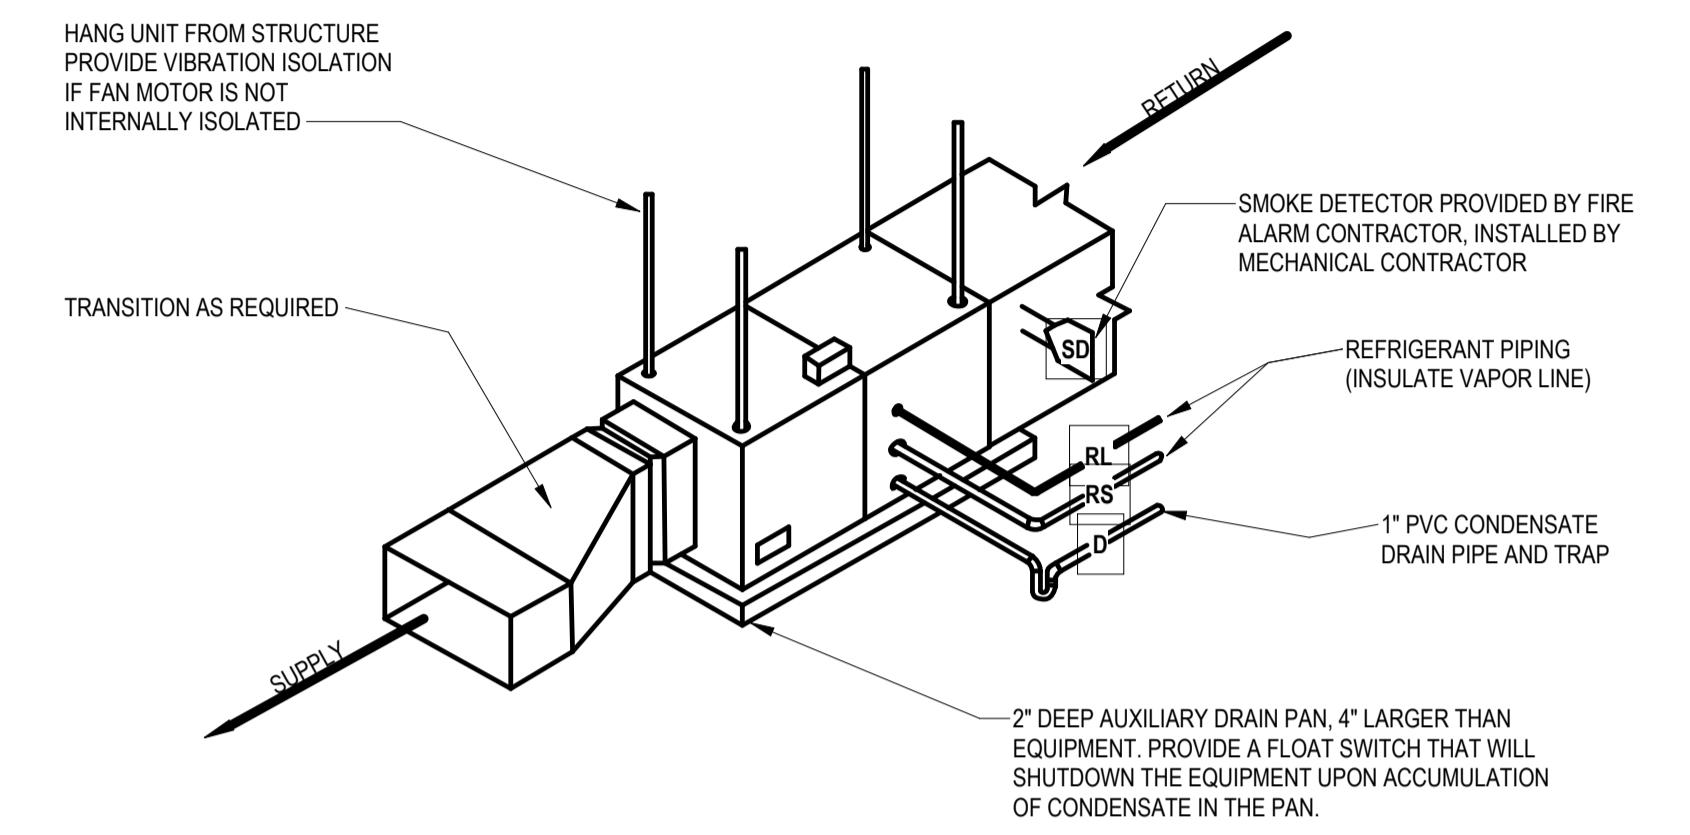
2 SPLIT SYSTEM FAN COIL UNIT PIPING SCHEMATIC
 M401 NOT TO SCALE



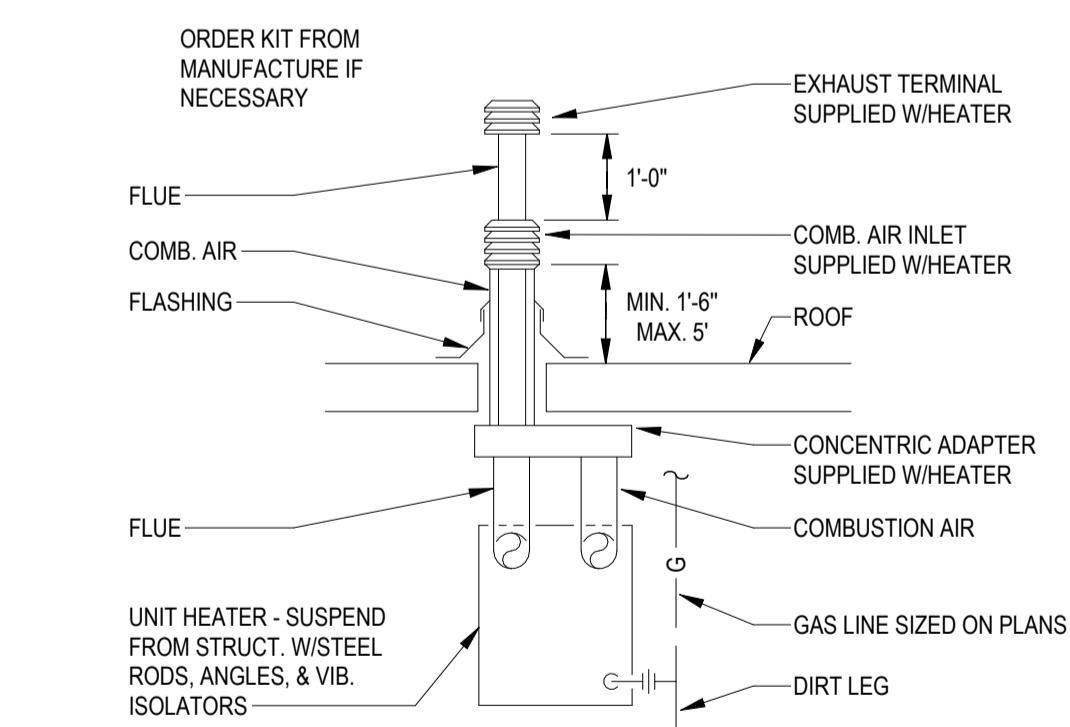
1 AHU HORIZONTAL MOUNTING DETAIL
 M401 NOT TO SCALE



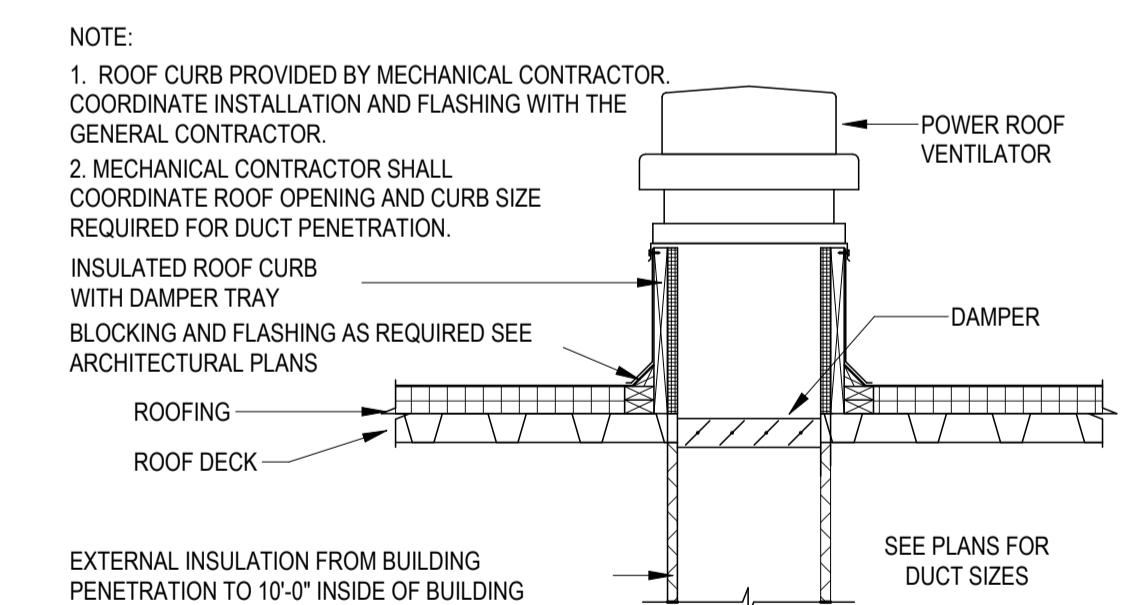
8 GAS FIRED UNIT HEATER DETAIL
 M401 NOT TO SCALE



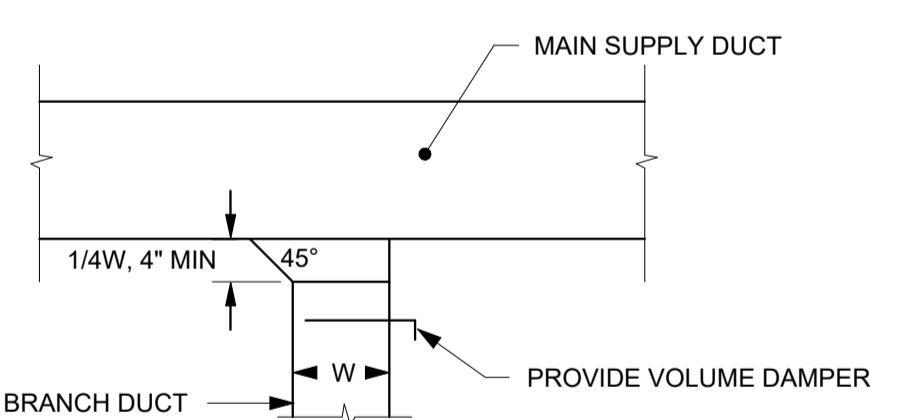7 POWER ROOF VENTILATOR DETAIL
 M401 NOT TO SCALE



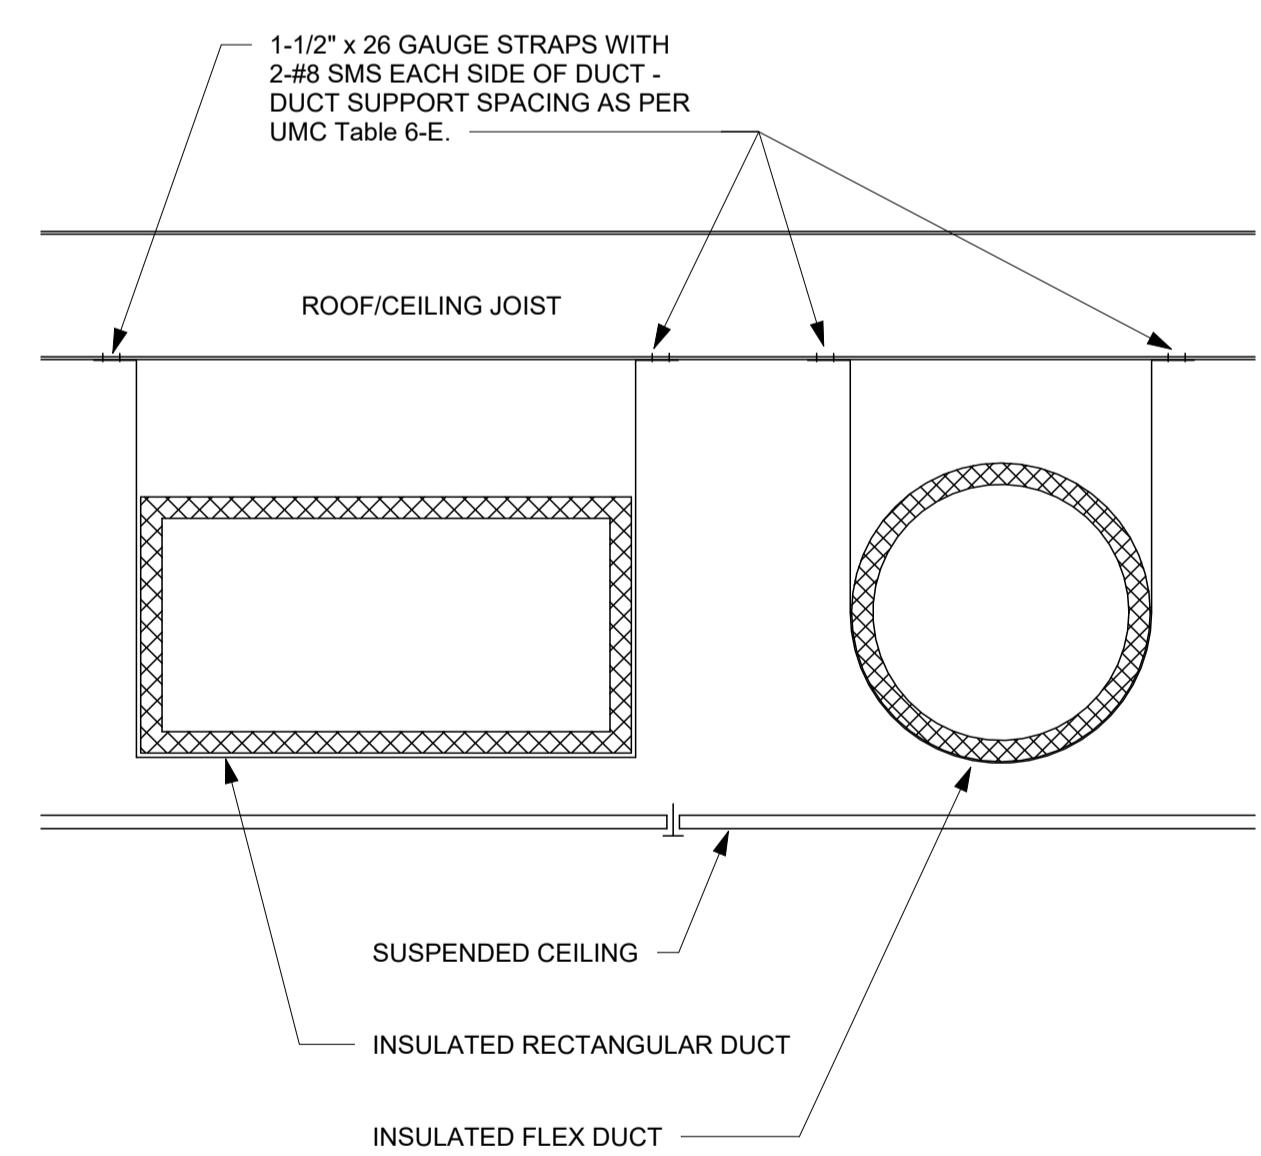6 DUCT TAKE-OFF DETAIL
 M401 NOT TO SCALE



5 DUCT SUPPORT DETAIL
 M401 NOT TO SCALE



GENERAL MECHANICAL SYMBOLS		PLUMBING AND PIPING SYMBOLS	
	REVISION NUMBER - SHOWN ON PLANS	CHWR	CHILLED WATER RETURN
	POINT WHERE NEW CONNECTS TO EXISTING	CHWS	CHILLED WATER SUPPLY
	NUMBER OF DETAIL ON SHEET	CD	CONDENSATE DRAINAGE
	NUMBER OF SHEET WHERE DETAIL APPEARS	CWR	CONDENSER WATER RETURN
	KEYNOTE	CWS	CONDENSER WATER SUPPLY
	CONTINUATION SYMBOL	GWR	GEOTHERMAL WATER RETURN
Room 4	ROOM NAME AND NUMBER	GWS	GEOTHERMAL WATER SUPPLY
	ITEM TO BE DEMOLISHED	HWR	HEATING WATER RETURN
	AREA NOT IN CONTRACT	HWS	HEATING WATER SUPPLY
2"	PIPE SIZE TAG (DIAMETER)	G	NATURAL GAS
	ABOVE GROUND PIPING	PG	PROPANE GAS
1/8" / 12" SLOPE	PIPE SLOPE TAG	REF-L	REFRIGERANT-LIQUID
	BELOW GROUND PIPING	REF-S	REFRIGERANT-SUCTION
INVERT: -105' - 1"	PIPE INVERT ELEVATION TAG	REF-HG	REFRIGERANT-HOT GAS
(E)	EXISTING PIPE TAG	STM	STEAM
	PIPING BEING DEMOLISHED	CDR	CONDENSATE RETURN
		CWV	COMBINATION WASTE & VENT
		CA	COMPRESSED AIR
		CW	DOMESTIC COLD WATER
		H-CW	HARD COLD WATER
		S-CW	SOFT COLD WATER
		F-CW	FILTERED COLD WATER
		RO	REVERSE OSMOSIS WATER
		HW	HOT WATER
		HW 140°	HOT WATER 140°
		HW-R	HOT WATER RECIRCULATION
		HW-R 140°	HOT WATER RECIRCULATION 140°
		GV	GREASE VENT
		GW	GREASE WASTE
		IW	INDIRECT WASTE
		OV	OIL VENT
		OW	OIL WASTE
		PD	PUMP DISCHARGE
		V	SANITARY VENT
		SS	SANITARY SEWER
		SHWR	SOLAR HOT WATER RETURN
		SHWS	SOLAR HOT WATER SUPPLY
		SD	STORM DRAINAGE
		OSD	OVERFLOW STORM DRAINAGE
			PIPE ACCESSORY TAGS
			1Φ1 2" SHUTOFF BALL VALVE
			1 2" STRAINER
			1/2" PRIMER TRAP PRIMER
			2" M-CNTRL ELEC. CONTROL
			T/P TMV-XX THERMOSTATIC MIXING
			1/2" TMV EMERG. THERMOSTATIC
			2" PRV PRESS REDUCING
			2" DOM. WM DOM. WATER METER
			1 1/2" DOM. WM IRRIGATION WATER METER
			DRAIN TAGS
			DRAIN SIZE
			4" FD-1 TYPE (SEE SCHEDULE) 4" AD-2
			4" FD-3P "P" - INDICATES PRIMER CONNECTION
			4" SD-29
			4" SD-12 FLOW CONTROL DRAIN
			4" SD-15 STORM DRAIN
			4" SD-1 COMBINATION DRAINS
			6" SD-1
			4000 SF
			PLUMBING FIXTURE TAGS
			TYPE (SEE SCHEDULE)
			Fixture Units
			PIPE ACCESSORY TAG
			4" WCO
			4" WCO
			* NOTE *
			ALL OF GENERAL NOTES ON THIS SHEET ARE TO BE APPLIED TO ALL OTHER DRAWINGS IN THIS SET. THE SYMBOLS AND ABBREVIATIONS SHOWN ON THIS SHEET MAY OR MAY NOT BE USED IN THIS SET OF DRAWINGS.

MBING NOTES

ALL WORK SHALL BE DONE IN ACCORDANCE WITH THE LATEST EDITION OF THE STATE CODE AS WELL AS ALL LOCAL AND OTHER APPLICABLE CODES.

ALL WORK SHALL BE PERFORMED BY EXPERIENCED AND SKILLED CRAFTSMEN.

FIELD VERIFY ALL NEW WATER, WASTE, AND VENT PIPING CONNECTIONS AND PROVIDE NEW CONNECTIONS AS REQUIRED FOR PROPERLY OPERATING SYSTEMS.

FIELD VERIFY LOCATION AND INVERTS OF SITE UTILITIES PRIOR TO INSTALLATION.

ROUTE DOMESTIC WATER, FIRE PROTECTION, SANITARY SEWER, AND STORM SEWER SERVICES TO SITE UTILITIES 5'-0" FROM BUILDING UNLESS NOTED OTHERWISE. REFER TO CIVIL PLANS.

WASTE AND VENT PIPING BELOW FLOOR AND THROUGH FLOOR SHALL BE 2" MINIMUM.

PROVIDE CLEANOUT IN ACCESSIBLE LOCATION AT THE BASE OF ALL PLUMBING RISERS.

WATER LINES BELOW GRADE SHALL BE TYPE "K" COPPER (NO MECHANICAL JOINTS BELOW GRADE) AND ABOVE GRADE TYPE "L". CROSS-LINKED POLYETHYLENE PIPING IS ACCEPTABLE, SO LONG AS ALL LOCAL BUILDING CODES ARE ADHERED TO. SUPPORT AS REQUIRED AND SHALL BE HYDROSTATICALLY TESTED FOR TWO HOURS AT 100 PSIG. ALL WATER PIPING AT WATER FIXTURES SHALL BE PROVIDED WITH 18" AIR CHAMBERS OR SHOCK ARRESTORS. STOPS SHALL BE PROVIDED ON HOT AND COLD-WATER LINES. WATER PIPING SHALL BE INSULATED WITH 1" CLOSED CELL RUBBER. THE ENTIRE WATER SYSTEM SHALL BE DISINFECTED PRIOR TO PLACING INTO SERVICE.

SANITARY SEWER LINES SHALL BE PVC AND SLOPED TOWARD DRAINAGE DIRECTION AT A MINIMUM OF 1/4" PER FOOT FOR 2-1/2" AND SMALLER PIPING. SLOPE SHALL BE 1/8" PER FOOT FOR PIPING SIZES 3" - 6".

WHERE APPLICABLE, ANY DEVICE THAT SHALL SERVE A SPECIAL FUNCTION SUCH AS PROCESSING OR ICE STORAGE, AND CONNECTS TO WATER SUPPLY AND DRAIN, SHALL BE PROTECTED AGAINST BACKFLOW WITH APPROVED BACKFLOW PREVENTION DEVICE.

PROVIDE PRESSURE REDUCING VALVE IF STREET PRESSURE EXCEEDS 80 PSIG.

SHOULD WATER PRESSURE BE TOO LOW TO PROPERLY CYCLE FLUSH VALVE FIXTURES, A BOOSTER PUMP SHALL BE REQUIRED. SUFFICIENT WATER PRESSURE IS ASSUMED FOR PROPER PLUMBING OPERATION.

THE PLUMBING CONTRACTOR SHALL PROVIDE ALL OPENINGS REQUIRED FOR THE PLUMBING WORK AND SHALL INSTALL FIRE RATED SLEEVES WHEREVER PENETRATIONS OF RATED WALLS OR FLOORS ARE MADE. THE PATCHING SHALL BE BY THE PLUMBING CONTRACTOR. THE PLUMBING CONTRACTOR SHALL REVIEW ALL UTILITY SITE PLANS AND ARCHITECTURAL SITE PLANS FOR WORK BY OTHERS.

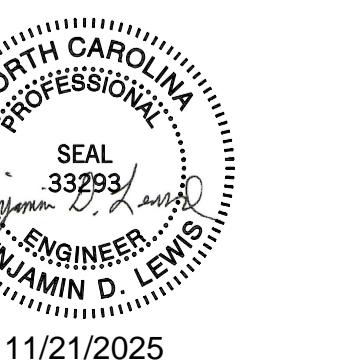
LOCATION OF UTILITIES (WASTE AND WATER LINES, MANHOLES, ETC...) THAT ARE TO BE CONNECTED TO ARE ASSUMED. IT SHALL BE THE RESPONSIBILITY OF THE PLUMBING CONTRACTOR TO VERIFY THESE LOCATIONS AND MAKE THE FINAL CONNECTION AS REQUIRED.

ALL FLOOR DRAINS AND TRENCH DRAINS, IF APPLICABLE, SHALL BE PROVIDED WITH TRAP PRIMERS.

UMBING SHEET INDEX

PLUMBING TITLE SHEET
PLUMBING PLAN
PLUMBING ISOMETRIC PLAN - DOMESTIC WATER
PLUMBING ISOMETRIC PLAN - SANITARY
PROPANE GAS PLAN
PROPANE GAS ISOMETRIC PLAN
PLUMBING SCHEDULES/DETAILS


PR
DA
REV




P000

ISSUER FOR CONSTRUCTION

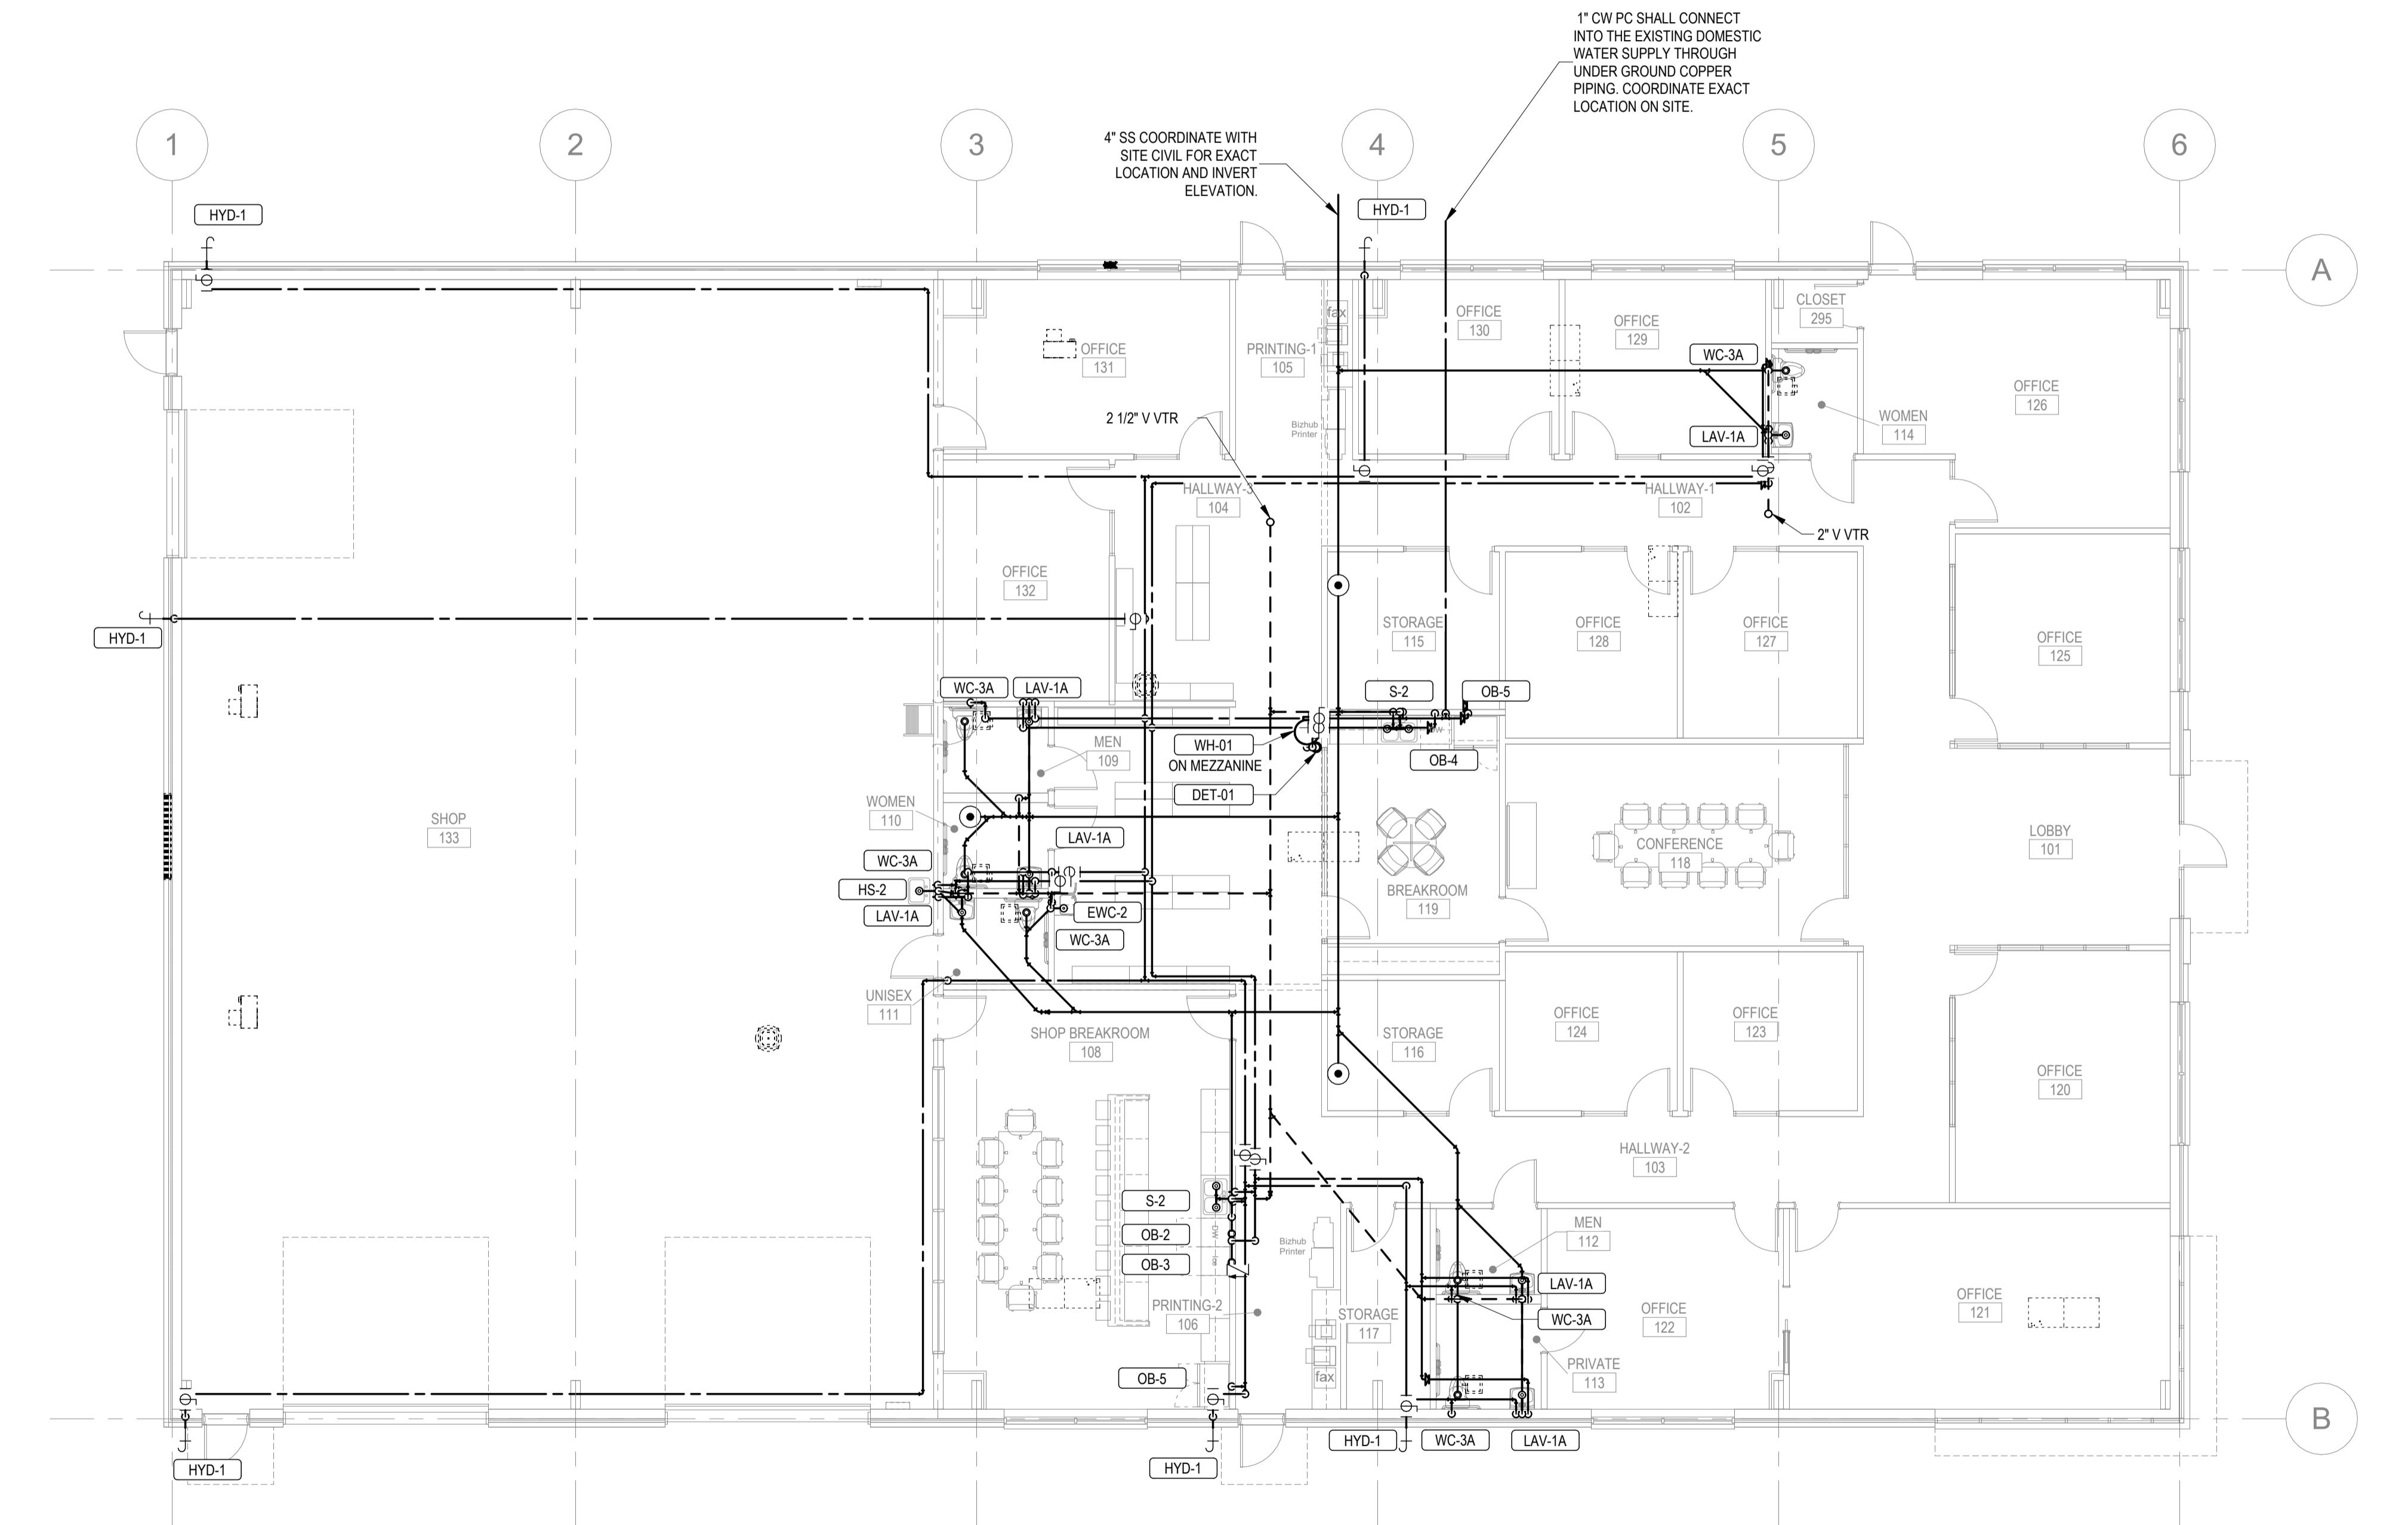ISSUED FOR CONSTRUCTION



1
P101 PLUMBING FLOOR PLAN
1/8" = 1'-0"

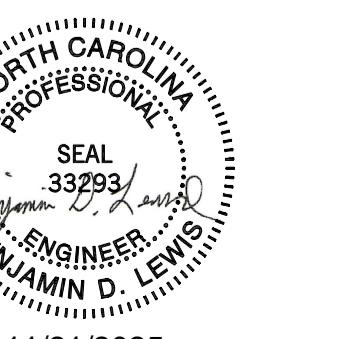

DRAWN BY
CHECK BY

PLUMBING PLAN

1

P101



20 SOMMERSVILLE PARK ROAD
RALEIGH, NC 27603
NC FIRM # C-3824



ISSUED FOR CONSTRUCTION F&M CONCRETE

**E&M CONCRETE
308 JARCO DRIVE
FUQUAY-VARINA, NC 27526**

JECT: 224S91
E ISSUED: 8/20/2024

WN BY: KLB
CK BY: BDL

PLUMBING ISOMETRIC
PLAN - DOMESTIC
WATER

B301

P301

KEYNOTES

1 PC SHALL ROUTE PIPE OVERHEAD, KEEPING PIPING TIGHT TO ROOF.

KEYNOTES

1 PC SHALL ROUTE PIPE OVERHEAD, KEEPING PIPING TIGHT TO ROOF.

THESE DRAWINGS ARE THE PROPERTY OF KAROS PROJECT GROUP. THESE DOCUMENTS HAVE BEEN PREPARED SPECIFICALLY FOR THE PROJECT DESCRIBED IN THE ADDRESS BAR. THEY ARE NOT SUITABLE FOR USE ON OTHER PROJECTS OR IN OTHER LOCATIONS WITHOUT WRITTEN APPROVAL FROM THE ENGINEER. REPRODUCTION IS PROHIBITED IF SIGNATURE ON COVER SHEET DOES NOT APPEAR. THIS IS NOT AN AUTHORIZED COPY.

DOMESTIC WATER RISER DIAGRAM

1 P301

11/21/2025

ISSUED FOR CONSTRUCTION
E&M CONCRETE
308 JARCO DRIVE
FUQUAY-VARINA, NC 27526

PROJECT: 224S91
 DATE ISSUED: 8/20/2024
 REV DATE DESCRIPTION
 1 11/13/25 AS BUILTS


DRAWN BY: KLB
 SEAL 33293
 CHECK BY: BDL

PLUMBING ISOMETRIC
 PLAN - SANITARY

11/21/2025

P302


THESE DRAWINGS ARE THE PROPERTY OF KAIROS PROJECT GROUP. THESE DOCUMENTS HAVE BEEN PREPARED SPECIFICALLY FOR THE PROJECT DESCRIBED IN THE ADDRESS BAR. THEY ARE NOT SUITABLE FOR USE ON OTHER PROJECTS OR IN OTHER LOCATIONS WITHOUT WRITTEN APPROVAL FROM THE ENGINEER. REPRODUCTION IS PROHIBITED IF SIGNATURE ON COVER SHEET DOES NOT APPEAR. THIS IS NOT AN AUTHORIZED COPY.

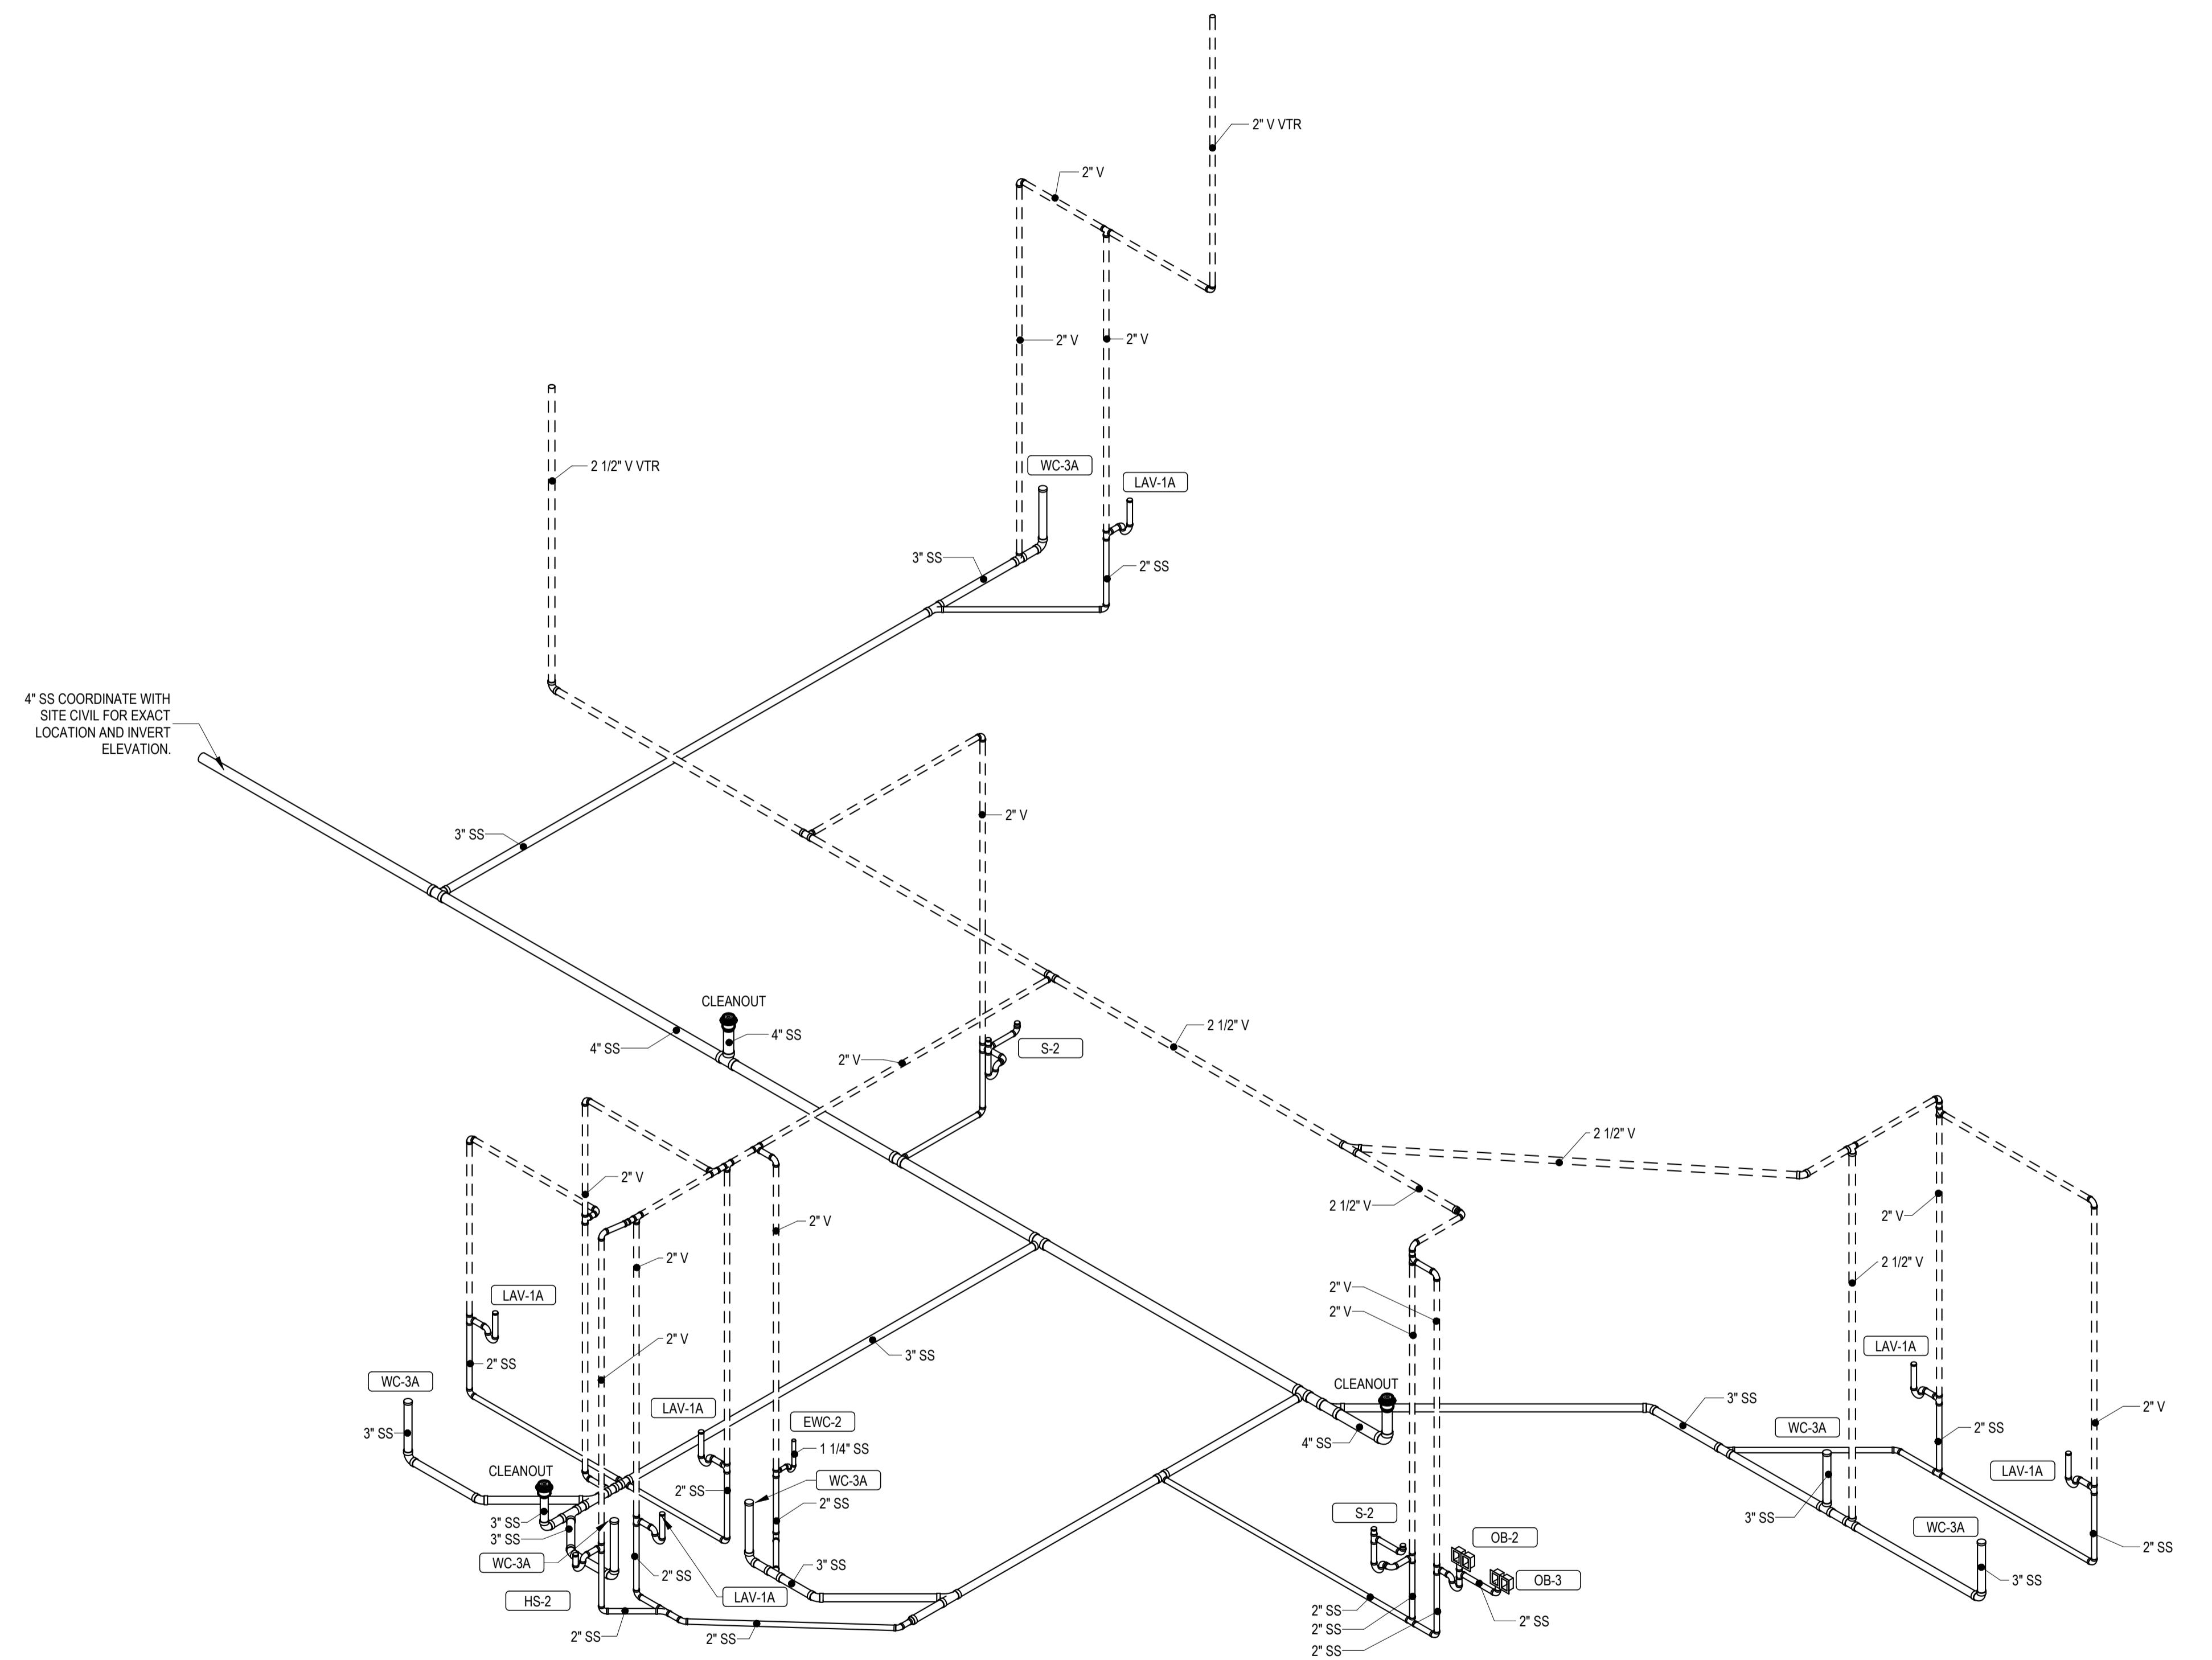

NOTE:
 1. PROVIDE AGA APPROVED SHUTOFF VALVE.
 2. PROVIDE DIRT LEG AT EACH APPARANCE.
 3. ALL PIPING SHALL BE SCHEDULE 40 CARBON STEEL.
 4. GAS PIPING INLET PRESSURE 11.0 IN. W.C. WITH A PRESSURE DROP OF .50 IN. W.C.
 5. GAS PIPING SIZED PER 2018 NC FUEL GAS CODE TABLE 402.4(28)

PROPANE GAS PIPE LENGTH		
System Type	Length	
MP_Propane Gas	177' - 11 27/32"	

PROPANE GAS DEMAND		
Family	Identity Mark	Fuel Load
Gas-Fired Unit Heater	UH-1	30000 Btu/h
Gas-Fired Unit Heater	UH-1	30000 Btu/h
Gas-Fired Unit Heater	UH-1	30000 Btu/h
Grand total: 3		90000 Btu/h

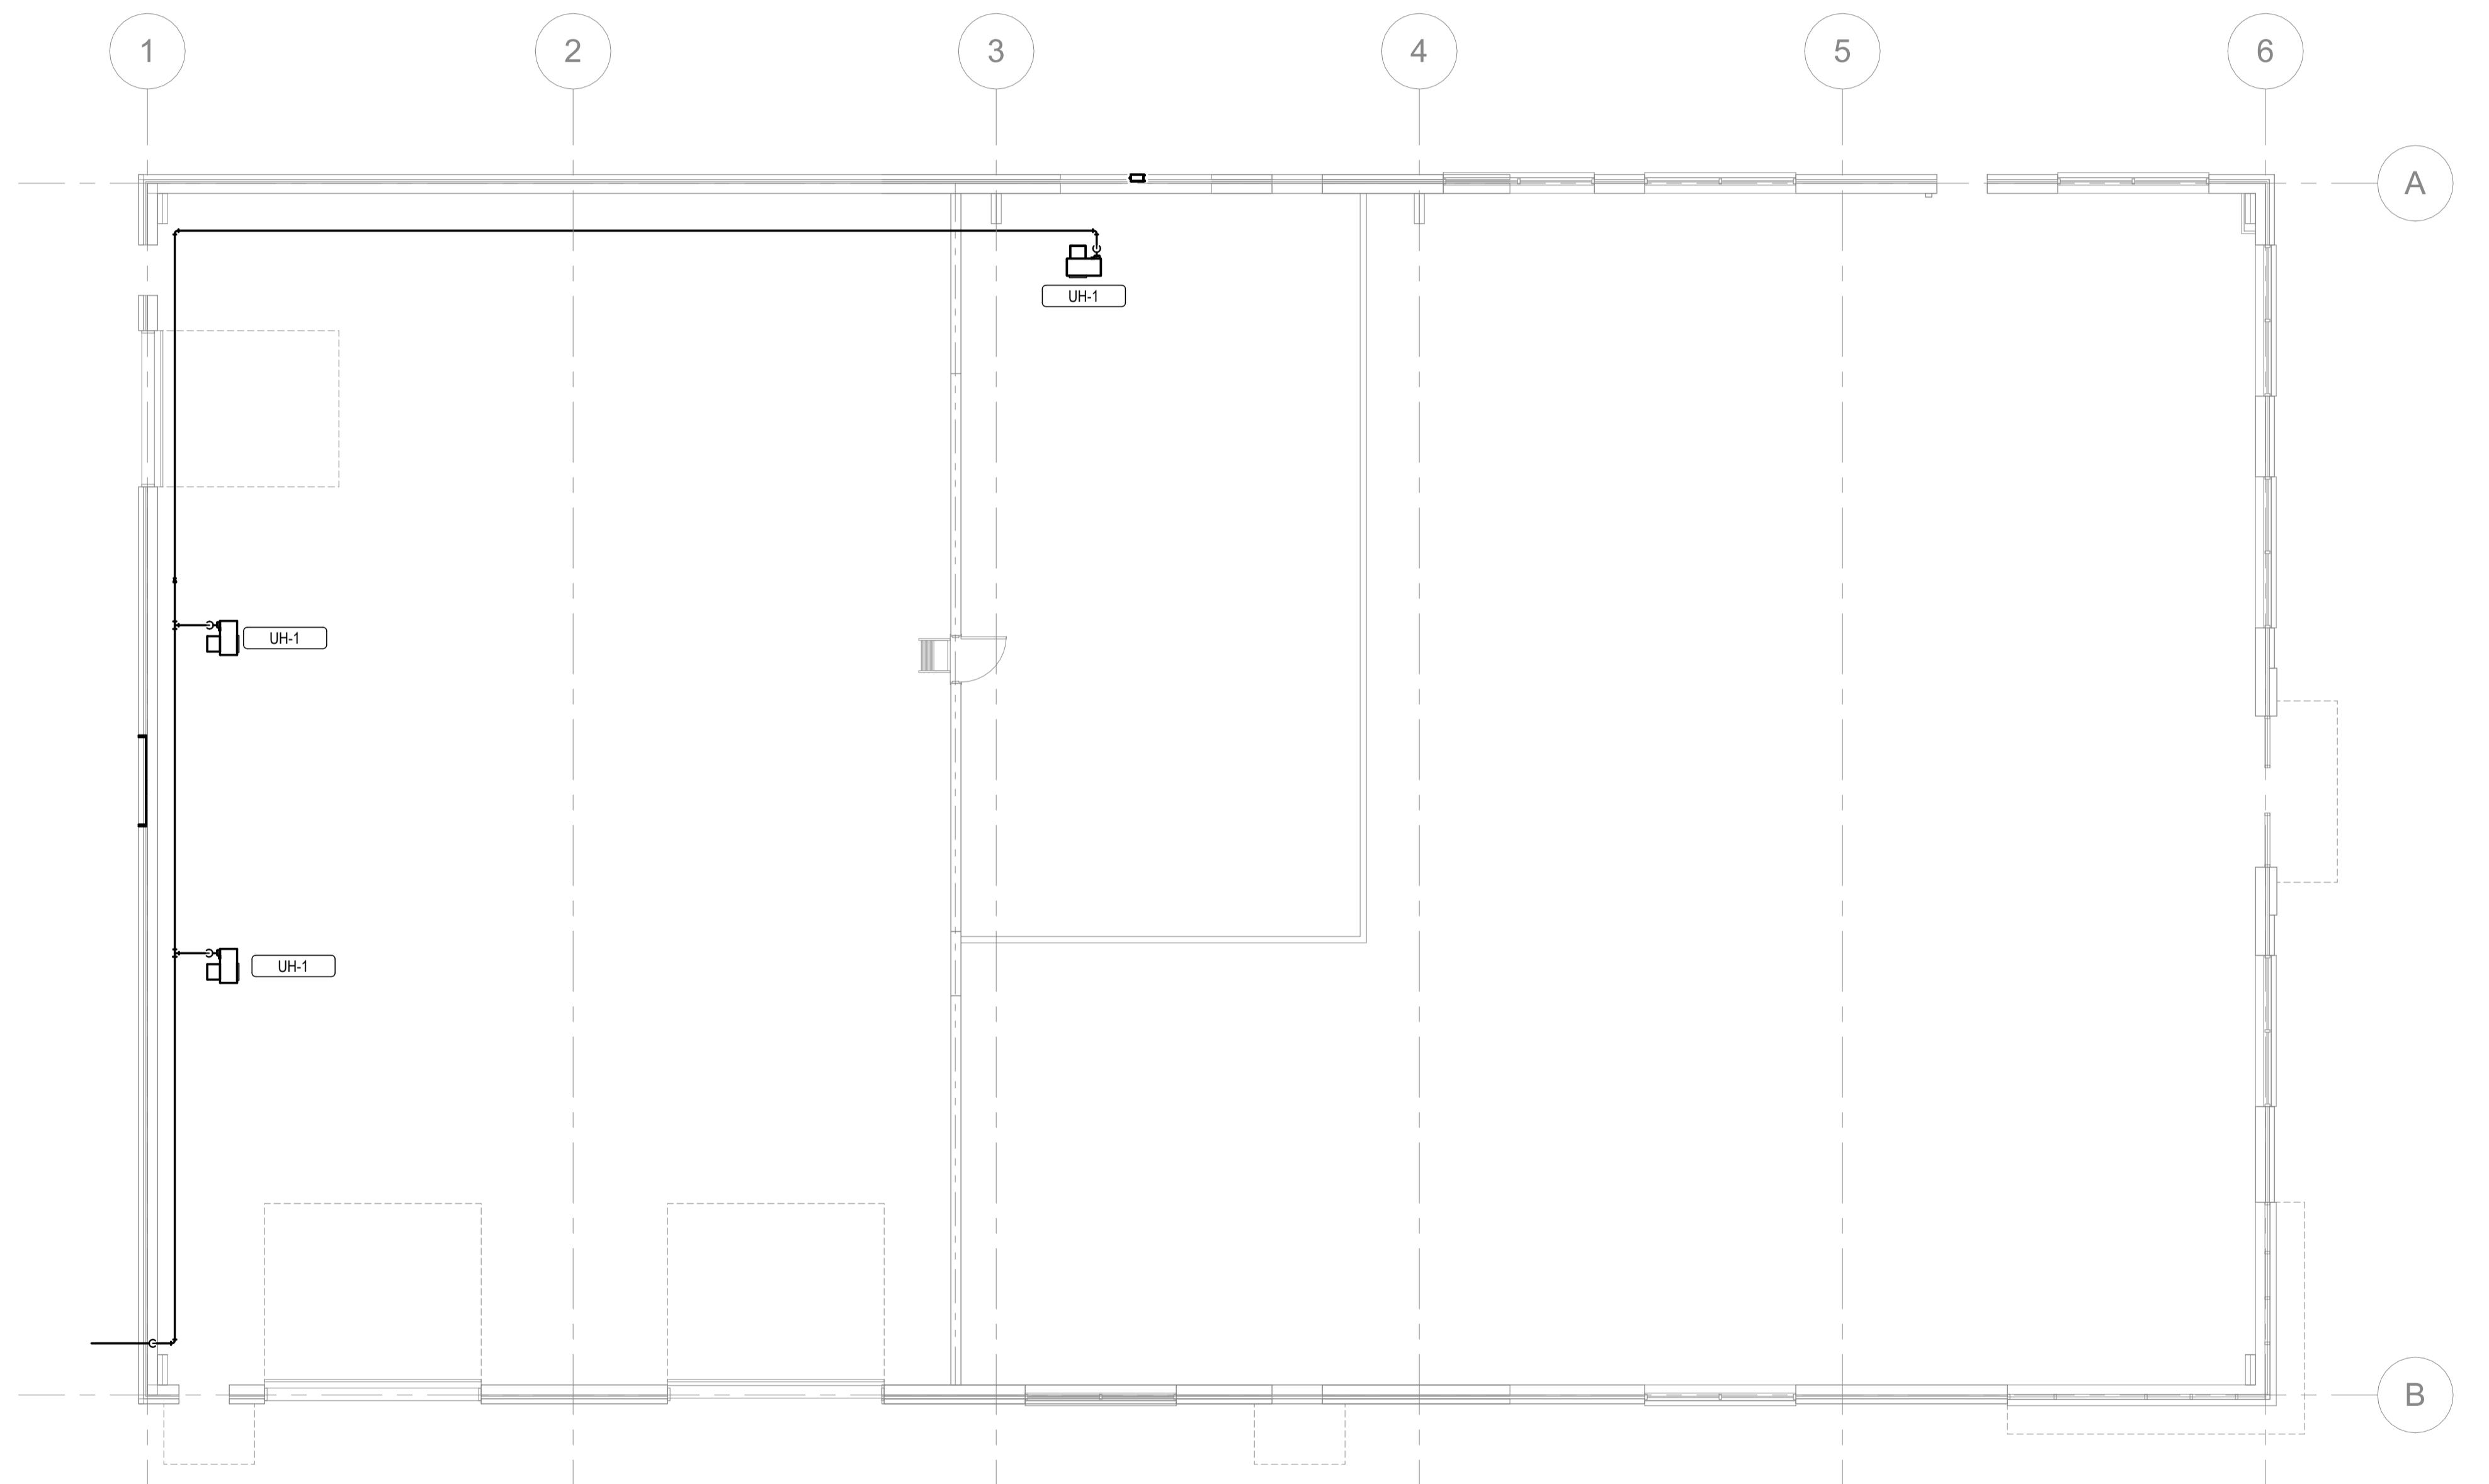

1 PROPANE GAS FLOOR PLAN
 P401 1/8" = 1'-0"



11/21/2025

THESE DRAWINGS ARE THE PROPERTY OF KAIROS PROJECT GROUP. THESE DOCUMENTS HAVE BEEN PREPARED SPECIFICALLY FOR THE PROJECT DESCRIBED IN THE ADDRESS BAR. THEY ARE NOT SUITABLE FOR USE ON OTHER PROJECTS OR IN OTHER LOCATIONS WITHOUT WRITTEN APPROVAL FROM THE ENGINEER.

