

HARNETT COUNTY HEALTH DEPARTMENT
ENVIRONMENTAL HEALTH SECTION
307 W. CORNELIUS HARNETT BLVD.
LILLINGTON, NC 27546
910-893-7547 PHONE
910-893-9371 FAX

Application for Repair

EMAIL ADDRESS: _____

NAME Cynthia Deloris McKay PHONE NUMBER 919-499-7574

PHYSICAL ADDRESS 4195 McNeill Rd Sanford, NC 27332

MAILING ADDRESS (IF DIFFERENT THAN PHYSICAL) _____

IF RENTING, LEASING, ETC., LIST PROPERTY OWNER NAME _____

SUBDIVISION NAME _____ LOT #/TRACT # _____ STATE RD/HWY _____ SIZE OF LOT/TRACT _____
Type of Dwelling: Modular Mobile Home Stick built Other _____

Number of bedrooms 3 Basement

Garage: Yes No Dishwasher: Yes No Garbage Disposal: Yes No

Water Supply: Private Well Community System County

Directions from Lillington to your site: Be fore Hy 421 to McNeill Rd to Broadway Rd
make left for Garage to McNeill Rd
make left at first double wide on right

In order for Environmental Health to help you with your repair, you will need to comply by completing the following:

1. A "surveyed and recorded map" and "deed to your property" must be attached to this application. Please inform us of any wells on the property by showing on your survey map.
2. The outlet end of the tank and the distribution box will need to be uncovered and property lines flagged. After the tank is uncovered, property lines flagged, underground utilities marked, and the orange sign has been placed, you will need to call us at 910-893-7547 to confirm that your site is ready for evaluation.

Your system must be repaired within 30 days of issuance of the Improvement Permit or the time set within receipt of a violation letter. (Whichever is applicable.)

By signing below, I certify that all of the above information is correct to the best of my knowledge. False information will result in the denial of the permit. The permit is subject to revocation if the site plan, intended use, or ownership changes.

Cynthia Deloris McKay 2-5-2019
Signature Date

2137

HOMEOWNER INTERVIEW FORM

It is important that you answer the following questions for our inspectors. Please do not leave any blanks if possible, and answer all questions to the best of your ability. Thank You.

Have you received a violation letter for a failing system from our office? YES NO
Also, within the last 5 years have you completed an application for repair for this site? YES NO

Year home was built (or year of septic tank installation) _____
Installer of system 1990 - Grace Real Estate
Septic Tank Pumper _____
Designer of System _____

1. Number of people who live in house? 1 # adults _____ # children _____ # total 1
2. What is your average estimated daily water usage? _____ gallons/month or day _____ county water. If HCPU please give the name the bill is listed in _____

3. If you have a garbage disposal, how often is it used? daily weekly monthly none
4. When was the septic tank last pumped? in 2018 How often do you have it pumped? three times in one year
5. If you have a dishwasher, how often do you use it? daily every other day weekly year
6. If you have a washing machine, how often do you use it? daily every other day weekly monthly
7. Do you have a water softener or treatment system? YES NO Where does it drain? _____

8. Do you use an "in tank" toilet bowl sanitizer? YES NO
9. Are you or any member in your household using long term prescription drugs, antibiotics or chemotherapy? YES NO If yes please list _____
10. Do you put household cleaning chemicals down the drain? YES NO If so, what kind? _____

1 per septic tank treatment +
11. Have you put any chemicals (paints, thinners, etc.) down the drain? YES NO
12. Have you installed any water fixtures since your system has been installed? YES NO If yes, please list any additions including any spas, whirlpool, sinks, lavatories, bath/showers, toilets 1

13. Do you have an underground lawn watering system? YES NO
14. Has any work been done to your structure since the initial move into your home such as, a roof, gutter drains, basement foundation drains, landscaping, etc? If yes, please list ROOF
15. Are there any underground utilities on your lot? Please check all that apply:
 Power Phone Cable Gas Water

16. Describe what is happening when you are having problems with your septic system, and when was this first noticed?
Tank keeps filling up had Tank pumped out 3 times in 2018 close to end of year

17. Do you notice the problem as being patterned or linked to a specific event (i.e., wash clothes, heavy rains, and household guests?) YES NO If Yes, please list Heavy RAIN & washing clothes

Certificate of Completion

No 4093

Owner Deloris McKoy Address Swann Station
(MUST BE FILLED IN) (MAILING ADDRESS)

Contractor Johnny Knight Address _____
(MAILING ADDRESS)

Location of Premises SR 1224 Lot 5 Hunters Point
(SUBDIVISION, STREET OR ROAD NAME OR NUMBER, LOT NO.)

Details of Septic Tank System

Kind of Material for Tank: Concrete Other _____

Size of Tank: Capacity 1000 Gallons


Subsurface Drainage Field No. of Ditches 3 Exact Length of each Ditch 100 Width of Ft. Ditches 3 Depth of Ft. Ditches 22 Inches

Square Feet in Absorption Field 900

Surface Drainage Required _____ Linear Ft.

Inspected by John Bond R.S.
(SANTARIAN)


Permit No. 4089 Date 08/16/89

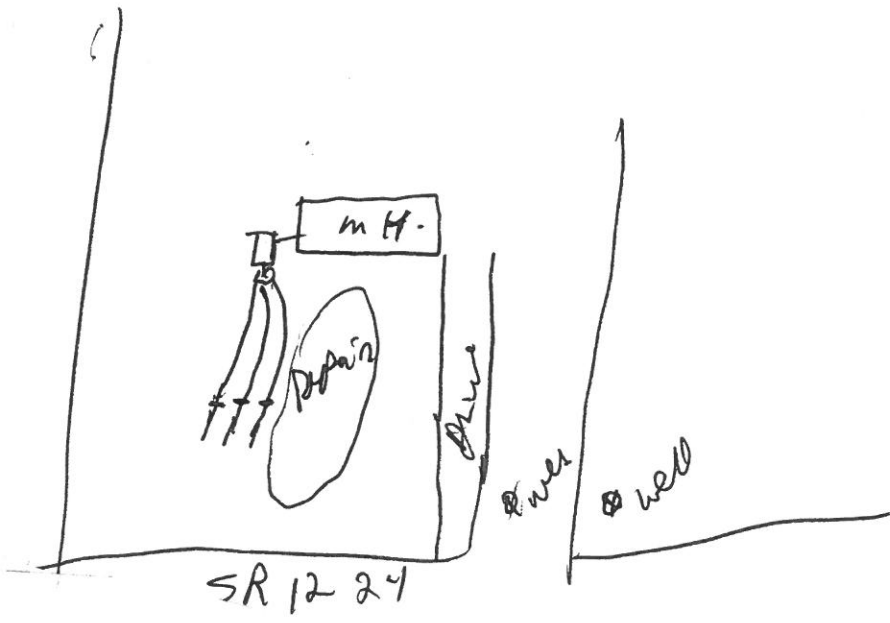


12.20
 4/1/88
 1/8/88
 1/8/88

MAGNETIC 1988
 SCALE 1" = 100'

CERTIFICATION OF SUBDIVISION REVIEW
 BY HARNETT COUNTY HEALTH DEPARTMENT
 THE LOTS ON THIS PLAN HAVE BEEN TENTATIVELY DESIGNATED FOR
 MINIMUM SIZE AND SOIL REQUIREMENTS FOR SEWAGE DISPOSAL AND
 WATER SUPPLY SYSTEM, BASED ON THIS REVIEW, IT APPEARS THAT
 LOTS ON THIS PLAN MEET APPROPRIATE REGULATIONS. NOTE THAT
 THIS PRELIMINARY CERTIFICATION DOES NOT REPRESENT APPROVAL
 OR A RESULT FOR ANY SITE WORK. FINAL APPROVAL REQUIRES
 INSURANCE OF THE APPROPRIATE HARNETT CO. HEALTH DEPARTMENT
 PERMITS FOR SPECIFIC USE AND SITING IN ACCORDANCE WITH
 REGULATIONS IN FORCE AT THE TIME OF PERMITTING.
 DATE 1/11/88
 MICHAEL D. EAKEN, SOIL SCIENTIST

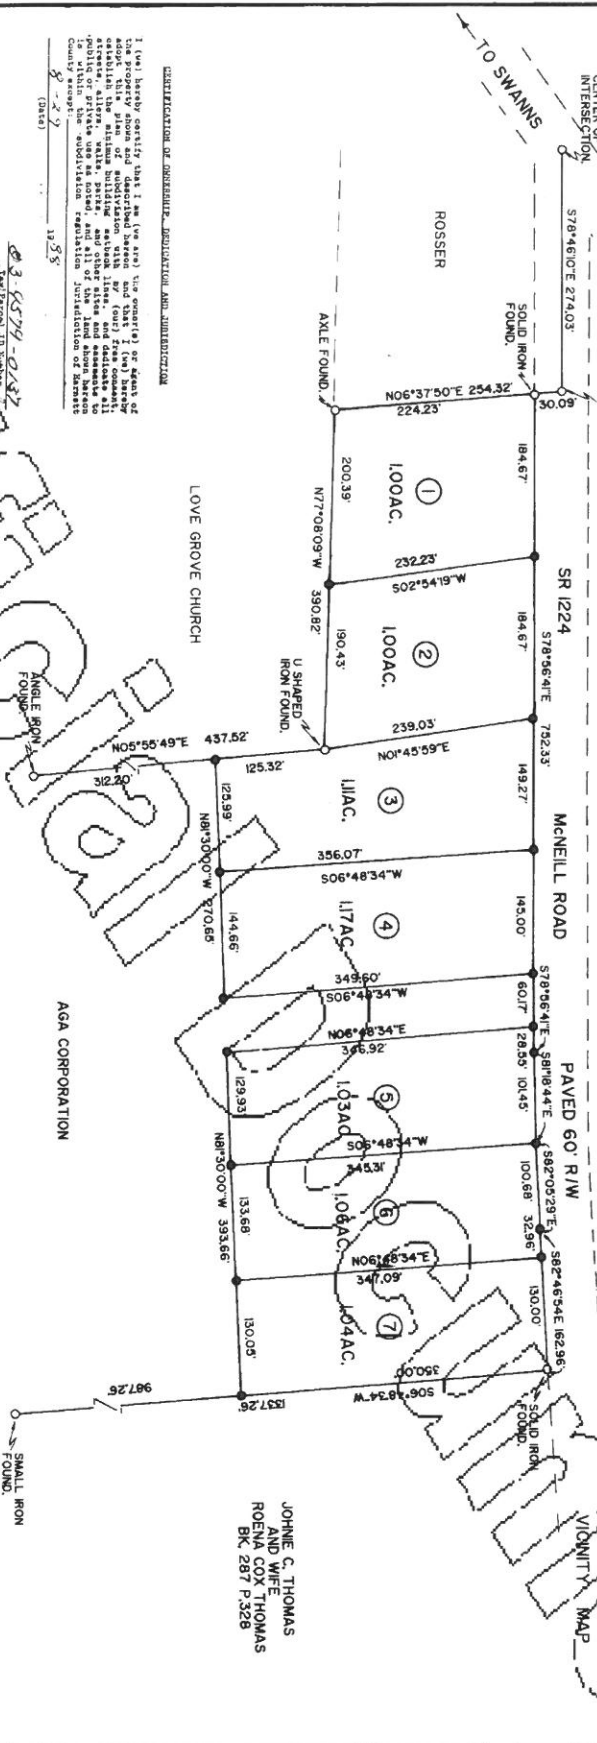

1 (we) hereby certify that I am (we are) the owner(s) or agent(s) of the property shown and described herein and that I (we) have established the minimum building setback lines (and) front, side, and rear yard setbacks, and other rules and regulations to be observed within the subdivision jurisdiction of Harnett County, North Carolina.

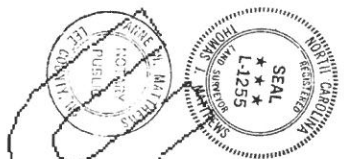

3-8579-0-817
 1/8/88
 1/8/88
 1/8/88

NOTE:
 ●..... INDICATES SOLID IRON SET.
 ACRAGE, CALCULATED BY
 D.M.D. ME HOD.
 WATER SUPPLY..... WELLS
 SEWER..... SEPTIC TANKS.
 MINIMUM BUILDING SETBACK
 LINE 30' FRONT, 15' BACK AND
 10' SIDES.
 OWNER: AGA CORPORATION
 P.O. BOX 819
 SANFORD N.C. 27330
 SURVEYOR: THOMAS J. MATTHEWS
 P.O. BOX 828
 SANFORD N.C. 27330

TOTAL ACRES 7.41 ACRES

REFERENCE:
 BARNETT C. COONE
 AND WIFE
 EUNA BELLE COONE
 BK. 775 P. 827



HUNTERS POINTE

HARNETT COUNTY NORTH CAROLINA

TWP. BARBEQUE	#
DATE COMPLETE 8/29/88	
SCALE: 1" = 100'	
REVISIONS	

PC# D Side 6a-c

PC # Side 6a-c

Mail To: Cynthia Delois McKoy, Rt. 3, Box 81 Lot 3, Cameron, NC 28326

CORPORATION WARRANTY DEED-Form CWD-402, 07057 Printed and for sale by James Williams & Co., Inc., Yadkinville, N. C.

STATE OF NORTH CAROLINA, Harnett County.

THIS DEED, Made this 8th day of August, 1989, by and between Aga Corporation, P.O. Box 2825, Sanford, NC 27331-2825

a Corporation of Lee County and State of North Carolina, hereinafter called Grantor, and Cynthia Delois McKoy, Rt. 3, Box 81 lot 3, Cameron, NC 28326 of Moore County and State of North Carolina, hereinafter called Grantee.

WITNESSETH: That the Grantor, for and in consideration of the sum of Ten Dollars and other good and valuable considerations to him in hand paid by the Grantee, the receipt whereof is hereby acknowledged, has given, granted, bargained, sold and conveyed, and by these presents does give, grant, bargain, sell, convey and confirm unto the Grantee, his heirs and/or successors and assigns, premises in Barbecue Township, Harnett County, North Carolina, described as follows:

Lot No. 5 as shown on map entitled "Hunters Pointe", dated August 29, 1988, prepared by Thomas J. Matthews, R. L. S., and recorded in Plat Cabinet D, Slide 52C, Harnett County Registry.

THE ABOVE REFERRED PROPERTY IS SUBJECT TO THE FOLLOWING:

- 1. All permanent mobile homes shall be a size of at least 500 square feet, underpinned, and no more than 15 years old at date of installation, unless approved by the developer.
2. All recreational vehicles or other temporary housing shall NOT be continuously placed on any lot for a period to exceed 90 days.
3. Each owner shall keep his lot free of trash so as to present a pleasing appearance, particularly NO junk automobiles.
4. Outside toilets are prohibited.

THESE COVENANTS ARE TO RUN WITH THE LAND AND SHALL BE BINDING ON ALL PERSONS CLAIMING UNDER THEM UNTIL DECEMBER 1ST, 2000.

Subject to all EASEMENTS of record.

Parcel No. 03-9579-0137-05

North Carolina Excise Tax 9-5-89 6.00



FILED 81 SEP 5 10 07 AM '89

TRANSFER RECORDED IN THE OFFICE OF HARNETT COUNTY TAX SUPERVISOR ON # 03-9579-0137-05 TAX SUPERVISOR BY JLB



AG CORPORATION Holder Barney G Coone et ux Euna Belle Coone See Book No. 864 Page 791

The above described premises, with all the appurtenances thereto belonging, or in any wise appertaining, unto the Grantee, his heirs and assigns forever. The Grantor warrants and defends the said title to the same against the lawful claims of all persons...

AGA CORPORATION By: [Signature] Vice President

STATE OF NORTH CAROLINA Lee COUNTY. I, Beverly Eurr, a notary public, do hereby certify that Van R. Geese, Secretary of AGA Corporation, is duly authorized to execute this deed...



STATE OF NORTH CAROLINA, Harnett COUNTY. The foregoing certificate(s) of Beverly Eurr-notary Lee Co is (are) certified to be correct. This instrument was presented for registration this 5 day of September, 1989, at 10:07 A.M., P.M., and duly recorded in the office of the Register of Deeds of Harnett County, North Carolina, in Book 892, Page 81. This the 5 day of September, A.D., 1989. Gayle D. Holder Register of Deeds Cynthia J. Humke Assistant, Deputy Register of Deeds

This Deed drawn by THIS INSTRUMENT DRAWN BY CLYDE K. ATKINS ATTORNEY AT LAW