

Harnett County Department of Public Health

Well Abandonment Permit Application

APPLICANT INFORMATION

Eric Crabtree (910) 988-7081
Applicant/Owner Phone Number
194 Burrel Wilson Dr. Broadway, NC 27505
Street Address, City, State, Zip Code

PROPERTY INFORMATION

Street Address 194 Burrel Wilson Dr. Subdivision/Lot # _____
Parcel # _____ PIN # _____

Directions to the Site

Brief description of the well location (ex. front yard, behind out building, front yard, etc.)

In Backyard


***Please include a Site Plan of your property showing the location of the well. If the well is underground, it must be uncovered prior to the department's site visit.**

Please Complete the Following Information:

Date Well Was Constructed _____ Grouted: Yes No
Above Ground or Below Ground Total Depth of Well _____
Well Type: Drilled Bored Hand dug Diameter _____ inches

I have thoroughly read and completed this Application and certify that the information provided herein is true, complete and correct to the best of my knowledge and is given in good faith. Representatives of the Harnett County Health Department and State Officials are granted right of entry to conduct necessary inspections to determine compliance with applicable rules.

I understand that I am solely responsible for the proper identification and labeling of all property lines, underground utility lines, and making the site accessible so that a well can be properly constructed according to the permit.


Property Owner's or Owner's Legal Representative Signature Required Date 8/27/2020

If you have any questions please contact Environmental Health Division at 910-893-7547

HTE# 08 500-21301

Harnett County Department of Public Health

20575

PERMIT # 25212

Operation Permit

New Installation Septic Tank Repair Nitrification Line Expansion

PROPERTY LOCATION: Holly Springs Ch Road

Name: (owner) Jerry Parsons

SUBDIVISION _____

LOT # _____

System Installer: D. Strickland

Registration # _____

1051A

Basement with plumbing: Garage Number of Bedrooms 4

Type of Water Supply: Community Public Well Distance from well 100 feet

System Type: E-2 Flow Types V and VI Systems expire in 5 years.


(In accordance with Table V a)

Owner must contact Health Department 6 months prior to expiration for permit renewal.

← To SA

~~100~~ Road

This system has been installed in compliance with applicable North Carolina General Statutes, Rules for Sewage Treatment and Disposal, and all conditions of the Improvement Permit and Construction Authorization.

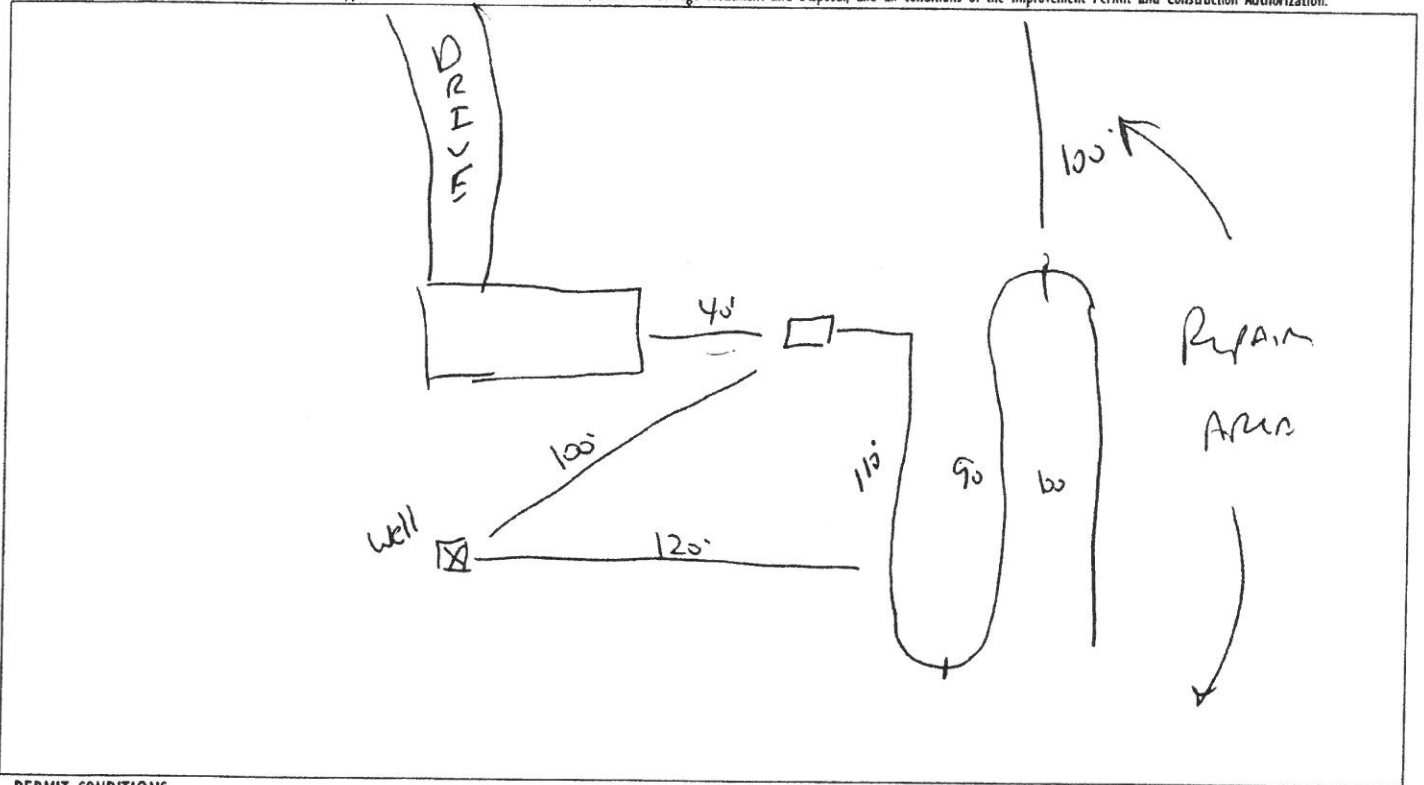

PERMIT CONDITIONS:

- I. Performance: System shall perform in accordance with Rule .1961.
- II. Monitoring: As required by Rule .1961.
- III. Maintenance: As required by Rule .1961. Other: _____
Subsurface system operator required? Yes No
If yes, see attached sheet for additional operation conditions, maintenance and reporting.
- IV. Operation: _____
- V. Other: _____

Following are the specifications for the sewage disposal system on the above captioned property.

Type of system: Conventional Other E-2 Flow Septic Tank: 1000 gallons Pump Tank: _____ gallons
 Subsurface No. of exact length width of depth of
 Drainage Field ditches 1 of each ditch 300 feet ditches 2 feet ditches 18.24 inches
 French Drain Required: _____ Linear feet

Authorized State Agent

[Signature]

Date 02-23-09

Improvement Permit

A building permit cannot be issued with only an Improvement Permit

ISSUED TO: Jerry Parsons
Type of Structure: SFD - 58 x 68 4BR
Proposed Wastewater System Type: GRAVEL
Projected Daily Flow: 480 GPD
Number of bedrooms: 4 Number of Occupants: 8 max

PROPERTY LOCATION: Holly Springs Ch Rd
SUBDIVISION:
LOT #:

Site Improvements required prior to Construction Authorization Issuance: 1/2 of AC
NOTE: There appears to be an old well (well house) on property - All parts of septic system must be 100' from well or well must be properly abandoned

Pump Required: [] Yes [] No [X] May be required based on final location and elevations of facilities
Type of Water Supply: [] Community [X] Public [] Well Distance from well 100 feet
Permit conditions: Meet on site for final layout maintain all setbacks
Stub out plumbing shall be at ground level or higher where shown. NOTE All parts of septic system must be 100' from old well/well house or well to be properly abandoned permit
Authorized State Agent: J. W. [Signature] Date: 12-3-08 SEE ATTACHED SITE SKETCH Required

The issuance of this permit by the Health Department in no way guarantees the issuance of other permits. The permit holder is responsible for checking with appropriate governing bodies in meeting their requirements. This site is subject to revocation if the site plan, plat, or the intended use changes. The Improvement Permit shall not be affected by a change in ownership of the site. This permit is subject to compliance with the provisions of the Laws and Rules for Sewage Treatment and Disposal and to conditions of this permit.

Construction Authorization (Required for Building Permit)

The construction and installation requirements of Rules 1950, 1952, 1954, 1955, 1956, 1957, 1958, and 1959 are incorporated by references into this permit and shall be met. Systems shall be installed in accordance with the attached system layout.

ISSUED TO: Jerry Parsons
PROPERTY LOCATION: Holly Springs Ch Rd
Facility Type: SFD-58x68-4BR [X] New [] Expansion [] Repair
Basement? [] Yes [X] No Basement Fixtures? [] Yes [X] No
Type of Wastewater System** GRAVEL (Initial) Wastewater Flow: 480 GPD
(See note below, if applicable [X]) 25% Reduction system (Repair)

Installation Requirements/Conditions
Septic Tank Size 1000 gallons
Pump Tank Size gallons
Number of trenches 1
Exact length of each trench 400 feet
Trenches shall be installed on contour at a Maximum Trench Depth of: 18 inches
(Trench bottoms shall be level to +/- 1/4" in all directions)
Trench Spacing: 9 Feet on Center
Soil Cover: 6 inches (Maximum soil cover shall not exceed 36" above the trench bottom)
Pump Requirements: ft. TDH vs. GPM
Aggregate Depth: 6 inches below pipe, 2 inches above pipe, 12 inches total
Conditions:

**If applicable: I understand the system type specified is different from the type specified on the application. I accept the specifications of this permit.

Owner/Legal Representative Signature: Date:

This Construction Authorization is subject to revocation if the site plan, plat, or the intended use changes. The Construction Authorization shall not be transferred when there is a change in ownership of the site. This Construction Authorization is subject to compliance with the provisions of the Laws and Rules for Sewage Treatment and Disposal and to the conditions of this permit. SEE ATTACHED SITE SKETCH

Authorized State Agent: J. W. [Signature] Date: 12-3-08
Construction Authorization Expiration Date: 12-3-2013

HTE# D8-500-21301

Permit # 25212

Harnett County Department of Public Health Site Sketch

ISSUED TO: Jerry Parsons

PROPERTY LOCATOR: Holly Springs Ch. Road

SUBDIVISION

LOT # 10.01 ac

Authorized State Agent: Jo Whites


Date: 12-3-08

Permit

← To SR 1273

50' EASEMENT

413'

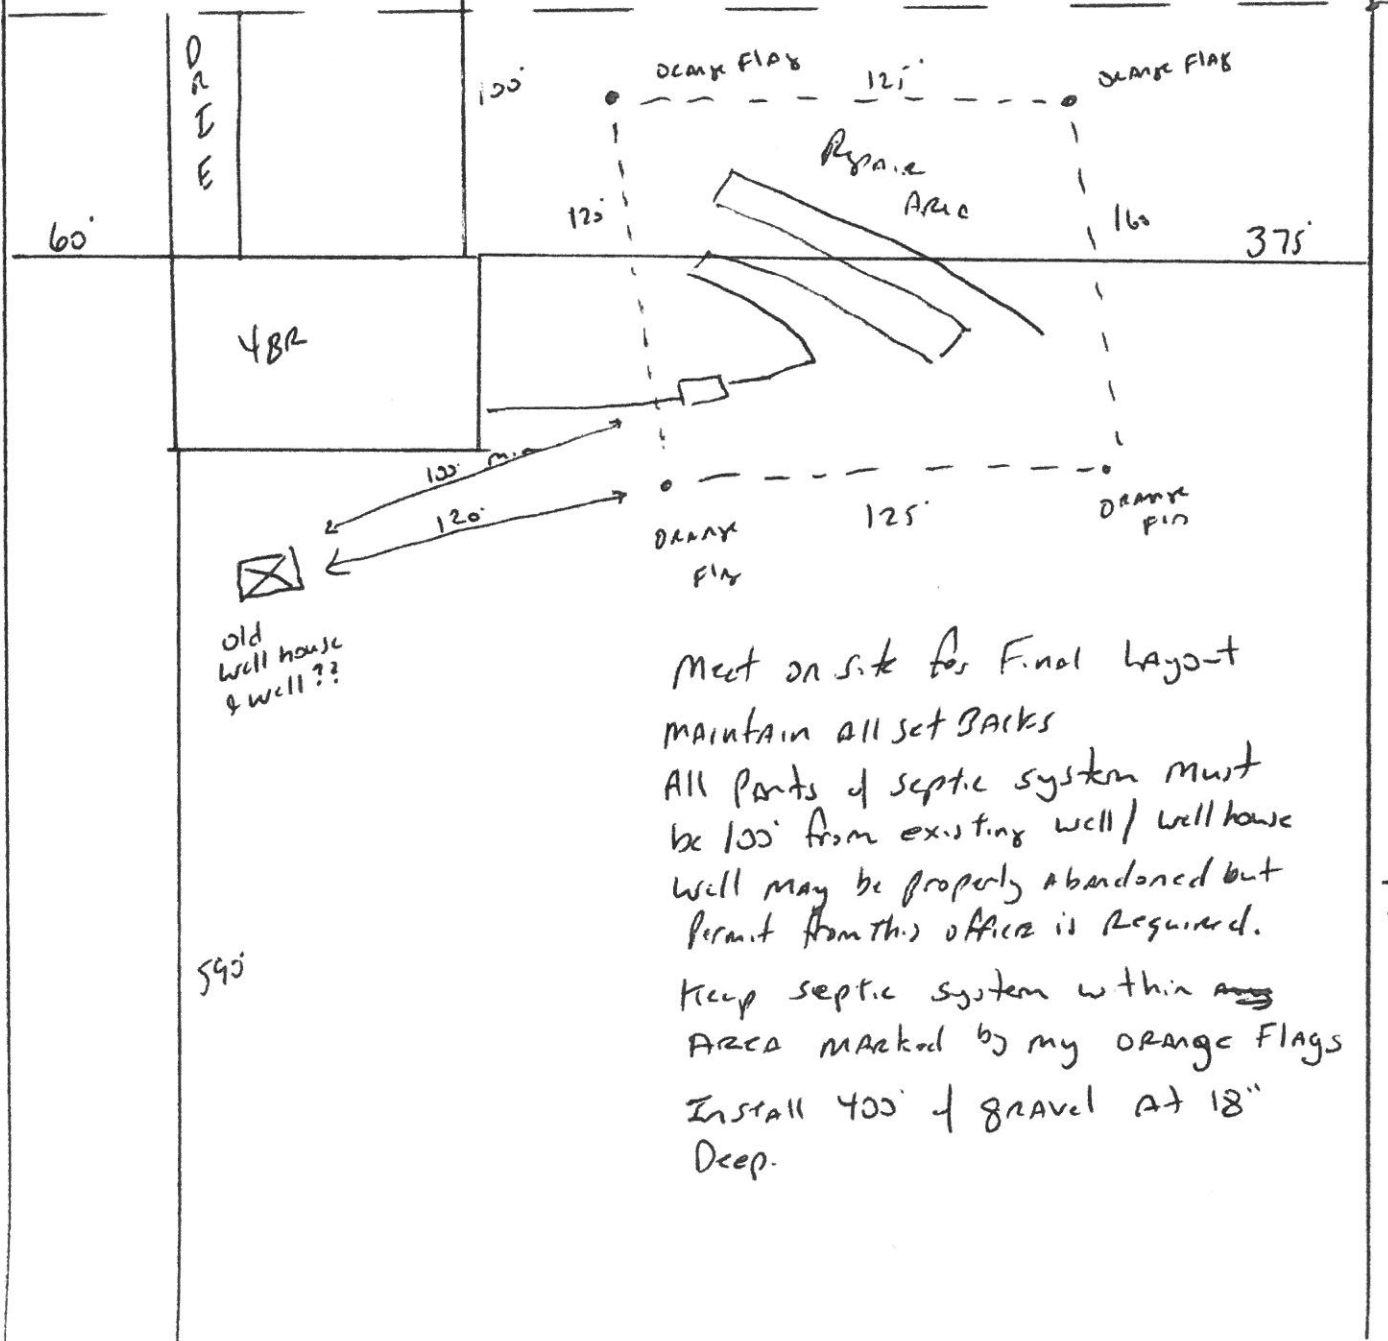

Meet on site for Final layout
 maintain all set backs
 All parts of septic system must
 be 100' from existing well / well house
 well may be properly abandoned but
 permit from this office is required.
 Keep septic system within any
 Area marked by my ORANGE FLAGS
 Install 400' of gravel at 18"
 Deep.

827