

HARNETT COUNTY HEALTH DEPARTMENT  
ENVIRONMENTAL HEALTH SECTION  
307 W. CORNELIUS HARNETT BLVD.  
LILLINGTON, NC 27546  
910-893-7547 PHONE  
910-893-9371 FAX

### Application for Repair

EMAIL ADDRESS: erica.mustard@gnccel.com  
NAME Richard & Erica Mustard PHONE NUMBER 910-964-0386  
PHYSICAL ADDRESS 26 Albert Ct. Sanford NC 27332  
MAILING ADDRESS (IF DIFFERENT THAN PHYSICAL) N/A

IF RENTING, LEASING, ETC., LIST PROPERTY OWNER NAME N/A  
C. Cameron Pines

SUBDIVISION NAME LOT #/TRACT # STATE RD/HWY SIZE OF LOT/TRACT

Type of Dwelling:  Modular  Mobile Home  Stick built  Other \_\_\_\_\_

Number of bedrooms 3  Basement

Garage: Yes  No  Dishwasher: Yes  No  Garbage Disposal: Yes  No

Water Supply:  Private Well  Community System  County

Directions from Lillington to your site: Take 27 to Buffalo Lake Rd - Turn left -  
Then turn left into Cameron Pines Subdivision - Take first  
Right onto Albert Ct - 26 Albert Ct. on Right.

**In order for Environmental Health to help you with your repair, you will need to comply by completing the following:**

1. A "surveyed and recorded map" and "deed to your property" must be attached to this application. Please inform us of any wells on the property by showing on your survey map.
2. The outlet end of the tank and the distribution box will need to be uncovered and property lines flagged. After the tank is uncovered, property lines flagged, underground utilities marked, and the orange sign has been placed, you will need to call us at 910-893-7547 to confirm that your site is ready for evaluation.

Your system must be repaired within 30 days of issuance of the Improvement Permit or the time set within receipt of a violation letter. (Whichever is applicable.)

By signing below, I certify that all of the above information is correct to the best of my knowledge. False information will result in the denial of the permit. The permit is subject to revocation if the site plan, intended use, or ownership changes.

[Signature]  
Signature

08-05-2021  
Date

# HOMEOWNER INTERVIEW FORM

It is important that you answer the following questions for our inspectors. Please do not leave any blanks if possible, and answer all questions to the best of your ability. Thank You.

Have you received a violation letter for a failing system from our office?  YES  NO  
Also, within the last 5 years have you completed an application for repair for this site?  YES  NO

Year home was built (or year of septic tank installation) 2010  
Installer of system \_\_\_\_\_  
Septic Tank Pumper \_\_\_\_\_  
Designer of System \_\_\_\_\_

1. Number of people who live in house? 3 # adults 3 # children 6 # total
2. What is your average estimated daily water usage? \_\_\_\_\_ gallons/month or day \_\_\_\_\_ county water. If HCPU please give the name the bill is listed in Richard Mustard
3. If you have a garbage disposal, how often is it used?  daily  weekly  monthly
4. When was the septic tank last pumped? 3/2019 How often do you have it pumped? 3 yrs
5. If you have a dishwasher, how often do you use it?  daily  every other day  weekly
6. If you have a washing machine, how often do you use it?  daily  every other day  weekly  monthly
7. Do you have a water softener or treatment system?  YES  NO Where does it drain?  
\_\_\_\_\_

8. Do you use an "in tank" toilet bowl sanitizer?  YES  NO
9. Are you or any member in your household using long term prescription drugs, antibiotics or chemotherapy?  YES  NO If yes please list \_\_\_\_\_
10. Do you put household cleaning chemicals down the drain?  YES  NO If so, what kind?  
\_\_\_\_\_
11. Have you put any chemicals (paints, thinners, etc.) down the drain?  YES  NO
12. Have you installed any water fixtures since your system has been installed?  YES  NO If yes, please list any additions including any spas, whirlpool, sinks, lavatories, bath/showers, toilets \_\_\_\_\_
13. Do you have an underground lawn watering system?  YES  NO
14. Has any work been done to your structure since the initial move into your home such as, a roof, gutter drains, basement foundation drains, landscaping, etc? If yes, please list No
15. Are there any underground utilities on your lot? Please check all that apply:  
 Power  Phone  Cable  Gas  Water

16. Describe what is happening when you are having problems with your septic system, and when was this first noticed?  
leach field appears to be backed up/blocked- water stands in backyard

17. Do you notice the problem as being patterned or linked to a specific event (i.e., wash clothes, heavy rains, and household guests?)  YES  NO If Yes, please list washing clothes, dishwasher



HTE# 10-5-24732

# Harnett County Department of Public Health

PERMIT # 26167

## Operation Permit

21654

New Installation  Septic Tank  Nitrification Line  Repair  Expansion

PROPERTY LOCATION: 1115

Name: (owner) Wynn Const. SUBDIVISION Cameron Pines LOT # 16

System Installer: Randy Batten Registration # \_\_\_\_\_

Basement with plumbing:  Garage  Number of Bedrooms 3


Type of Water Supply:  Community  Public  Well Distance from well 100 feet

System Type: Pump to Quick 4 chambers III B Types V and VI Systems expire in 5 years.

(In accordance with Table V a)

Owner must contact Health Department 6 months prior to expiration for permit renewal.

This system has been installed in compliance with applicable North Carolina General Statutes, Rules for Sewage Treatment and Disposal, and all conditions of the Improvement Permit and Construction Authorization.

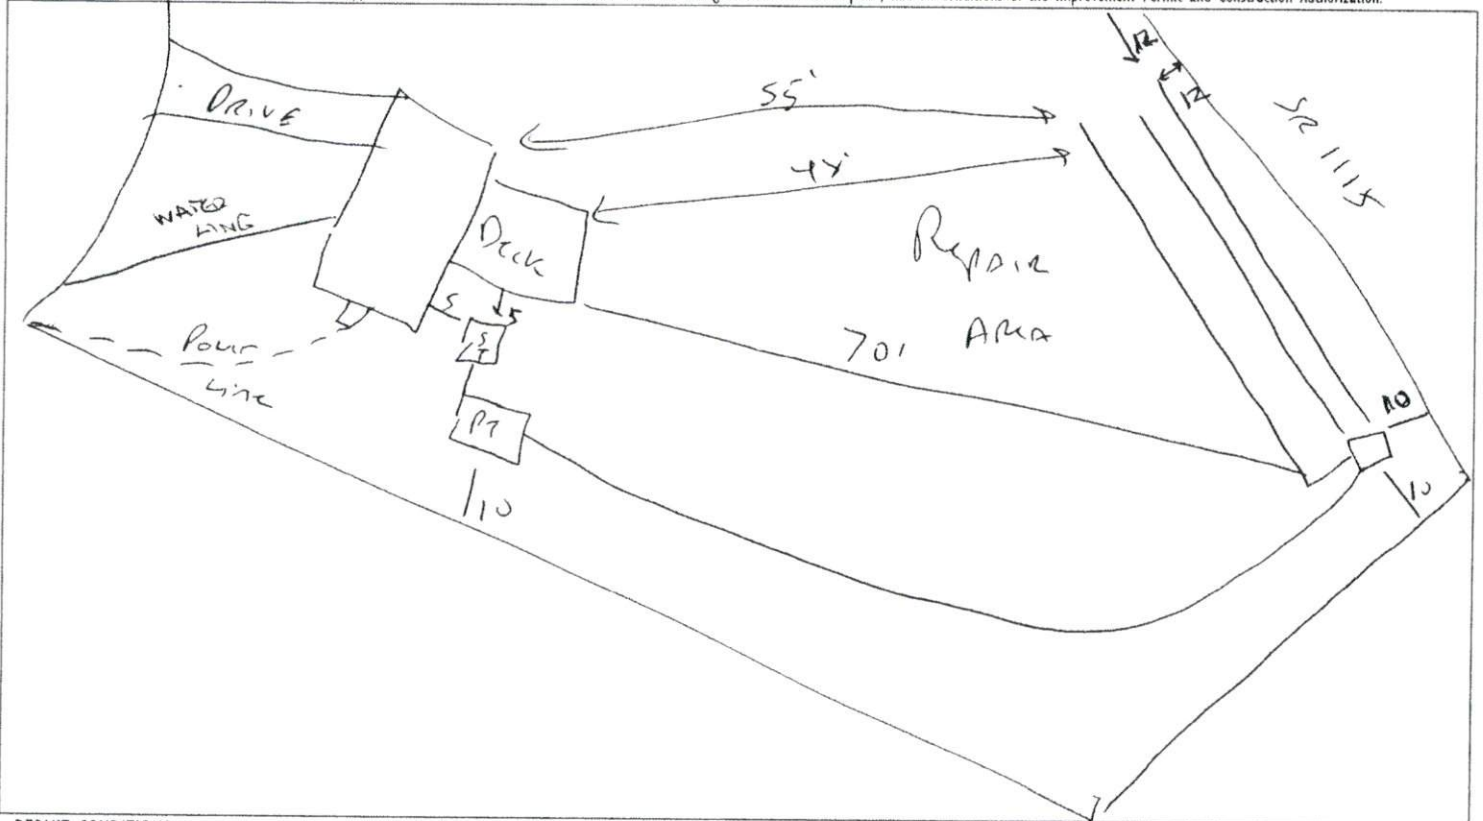

### PERMIT CONDITIONS:


- I. Performance: System shall perform in accordance with Rule .1961.
- II. Monitoring: As required by Rule .1961.
- III. Maintenance: As required by Rule .1961. Other: \_\_\_\_\_  
Subsurface system operator required? Yes  No   
If yes, see attached sheet for additional operation conditions, maintenance and reporting.
- IV. Operation: \_\_\_\_\_
- V. Other: \_\_\_\_\_

QHW 10-4-10 D-Box  \_\_\_\_\_ Pump  \_\_\_\_\_ Alarm  \_\_\_\_\_ H2O Line  \_\_\_\_\_ PWR Line

Following are the specifications for the sewage disposal system on the above captioned property.

Type of system:  Conventional  Other Pumps Quick 4 chambers Septic Tank: 1000 gallons Pump Tank: 1000 gallons  
 Subsurface No. of exact length width of depth of  
 Drainage Field ditches 3 of each ditch 40 feet ditches 3 feet ditches 18-24 inches  
 French Drain Required: \_\_\_\_\_ Linear feet

Authorized State Agent [Signature] REHS Date 11/2/10

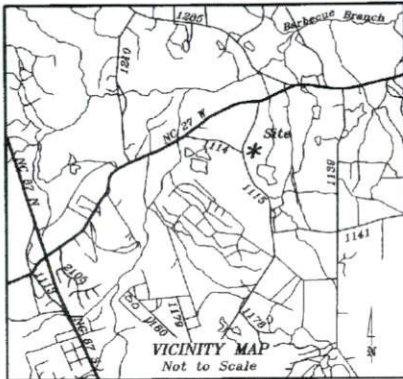

**LEGEND:**

- Lines Surveyed
- - - Lines Not Surveyed
- Right of Way Lines
- EP/RS Existing Iron Pipe or Stake
- ECM Existing Concrete Monument
- EPK Existing P.K. Nail
- PKS P.K. Nail Set
- ISS Iron Stake Set
- CSS Cotton Spindle Set
- RSS Railroad Spike
- ELS Existing Lightwood Stake
- PP Power Pole
- OEE Overhead Electric Lines
- Trans. Electric Transformer
- [ ] Street Address
- TP Telephone Pedestal
- MH Manhole
- WM Water Meter
- Emt. Easement
- R/W Right-of-Way
- C/L Centerline
- P.C. Plat Cabinet
- D.B. Deed Book
- P.B. Plat Book
- B.M. Book of Maps
- PIN Parcel Identifier
- Ac. Acres
- Sq. Ft. square feet
- CP Computed Point

N.C.G.S. North Carolina Geodetic Survey  
 NAD 87 North American Datum of 1987  
 NAD 83 North American Datum of 1983

**NOTES:**  
 \* Iron Stakes set at all property corners unless noted otherwise.  
 \* Areas determined by coordinate method.  
 \* All distances/dimensions are Horizontal.  
 \* ground distances unless otherwise indicated.

DEPARTMENT OF TRANSPORTATION  
 DIVISION OF HIGHWAYS  
 PROPOSED SUBDIVISION ROAD  
 CONSTRUCTION STANDARDS CERTIFICATION

APPROVED C.W. McGOE  
 DISTRICT ENGINEER RDP  
 DATE: 10/24/07

ONLY NCDOT APPROVED STRUCTURES ARE TO BE CONSTRUCTED ON PUBLIC RIGHT-OF-WAY  
 ALL LOTS SHALL BE SERVED BY THE INTERNAL STREET SYSTEM ONLY.

THE 10' X 70' SIGHT TRIANGLES TAKES PRECEDENCE OVER ANY SIGN EASEMENTS.

**NOTE:**  
 ALL DRAINAGE EASEMENTS SHALL BE DEDICATED AS PUBLIC AND IT SHALL BE THE RESPONSIBILITY OF THE PROPERTY OWNERS TO MAINTAIN THE DRAINAGE EASEMENTS AND ANY DRAINAGE STRUCTURES THEREIN, SO AS TO MAINTAIN THE INTEGRITY OF THE DRAINAGE SYSTEM AND INSURE POSITIVE DRAINAGE.

A 15' CONSTRUCTION EASEMENT SHALL BE RESERVED ON BOTH SIDES OF ALL PROPOSED STREETS.

THE OWNER, DEVELOPER, OR CONTRACTOR SHALL SET THE CENTERLINE OF THE EXISTING ROADWAY DITCH BACK TO A MINIMUM OF 12 FEET FROM THE EXISTING /PROPOSED EDGE OF PAVEMENT ALONG ALL ROAD FRONT LOTS.

See Sheet One of Two for additional notes, seals, certifications, approvals and signatures

HARNETT COUNTY, N.C.

FILED DATE 11-29-07 TIME 2:38 P.M.  
 MAP NUMBER 2007-1002

REGISTER OF DEEDS  
 KIMBERLY S. HARGROVE

By: Angela J. Byrd, Deputy  
 Register of Deeds

RECORDED IN HARNETT COUNTY, MAP NUMBER 2007 - 1002

**NOTE:**  
 4 10' x 70' Sight Triangle shall be placed at all street intersections as shown hereon.

SR 1114 90' Public R/W  
 Blanchard Road



**Note:**  
 Buffalo Lake Road is on the NC DOT Thoroughfare plan.

Harnett County  
 Minimum Building  
 Setback Requirements  
 RA-20R, RA-20M, RA-30 & RA-40

FRONT: 35' from R/W  
 REAR: 25'  
 SIDE: 10'  
 CORNER LOT SIDE: 20'

State of North Carolina  
 County of Harnett

I hereby certify that this record plat complies with the subdivision regulations of Harnett County, NC, and that this plat has been approved for recording in the Register of Deeds in Harnett County.

Date \_\_\_\_\_ Planning Director


**Notes**  
 Street Lights and Fire Hydrants shall be installed per Harnett County Regulations.

I hereby certify that the development depicted hereon has been granted final approval by the Harnett County Development Review Board pursuant to the regulations set forth by 6-811 Adjoining, Environmental, Environmental Planning, and Public Utilities of Harnett County, N.C. Subject to recordation in the Harnett County Office of Registrar of Deeds within sixty days of the date below.

[Signature] 11-29-07  
 Planning Director

**FEMA FLOOD HAZARD STATEMENT**  
 Lots shown on this plat are not located within the FEMA 100 year Flood Hazard Area as shown on FEMA map No. 37105000401  
 Effective Date: October 3, 2006

See Sheet One of Two for Continuation

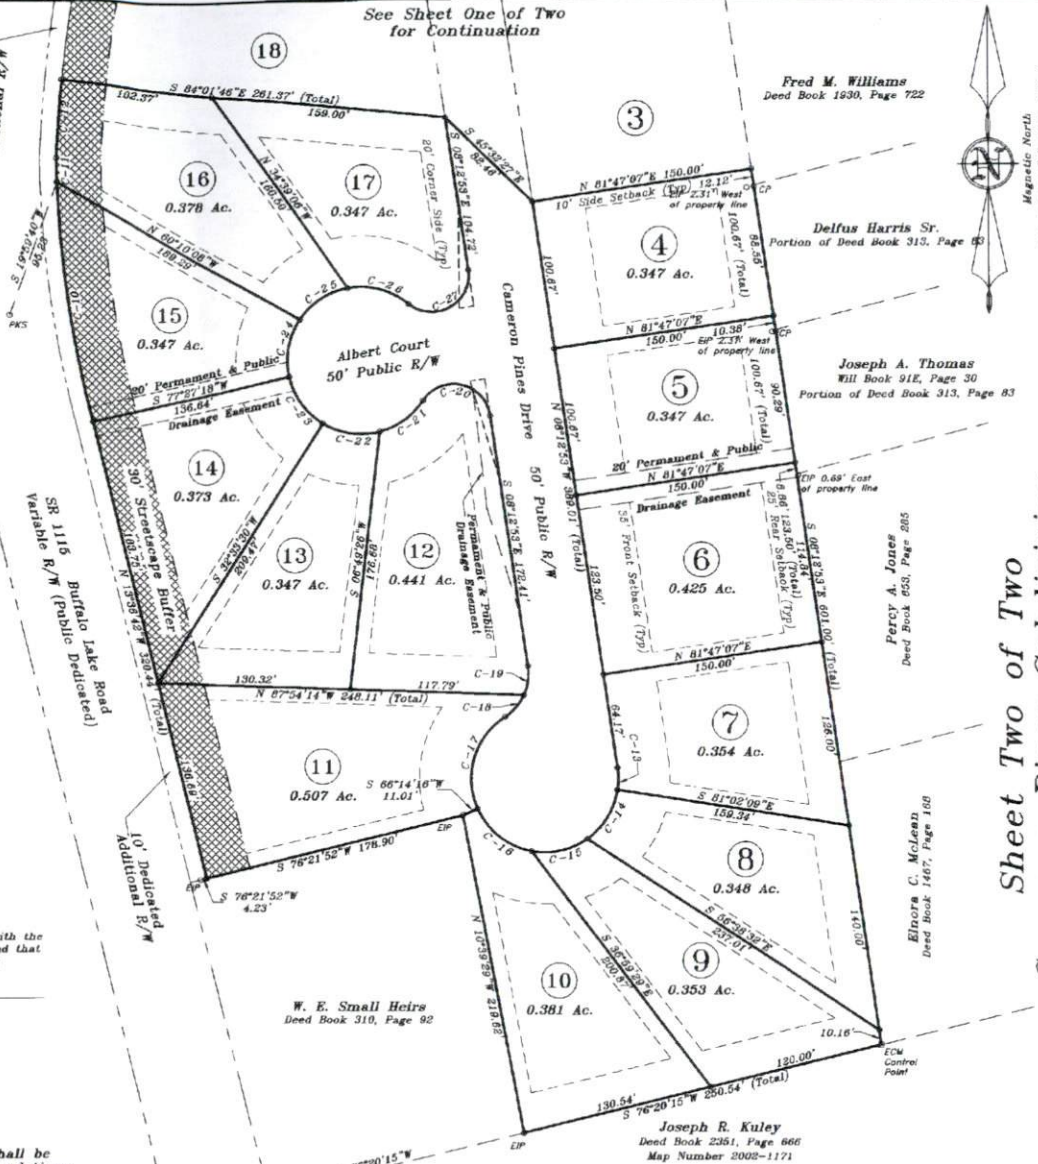

Sheet Two of Two  
 Cameron Pines Subdivision

**STANCIL & ASSOCIATES,**  
 Professional Land Surveyor, P.A.  
 98 East Depot Street, P. O. Box 780, Angier, N.C. 27501  
 Phone: 919-639-2133 Fax: 919-639-2802

DATE: 11-01-06 SURVEYED BY: HGF  
 SCALE: 1" = 60' DRAWN BY: PAN  
 CHECKED & CLOSURE BY: LHDQ-574 R.

SURVEYED FOR AND OWNED BY:  
**James Matthews Custom Homes, LLC**  
 782 Penny Road Angier, NC 27501 919-694-1366

TOWNSHIP: BARBEQUE COUNTY: HARNETT  
 STATE: NORTH CAROLINA PARCEL ID: 038566 0024  
 ZONE: RA-20R PARCEL NUMBER: 6087-63-7335.000

Revisions:  
 Flow Path 07-04-07  
 Road Number 10-03-07

Scale: 60' Horizontal, 30' Vertical

W. E. Small Heirs  
 Deed Book 310, Page 92


References  
 Deed Book 2139, Page 103  
 Plat Cabinet "C", Slide 168-A  
 Others as shown and/or noted

**Notes**  
 Property shown hereon is not currently located in a watershed district.  
 Lots to be served by individual septic tanks and Harnett County Municipal Water.  
 No lot shown hereon shall have direct access to SR 1115 Buffalo Lake Road.  
 The individual lot owners shall be responsible for maintaining the drainage easements and streetscape buffers on the respective lots.

Curve	Radius	Length	Delta	Chord	Chord Bear.
C-10	755.35	164.60	12°29'08"	164.38	N 08°14'01" W
C-11	755.35	16.43	1°14'44"	16.43	N 01°22'05" W
C-12	982.35	53.58	3°07'31"	53.58	N 04°24'29" W
C-13	50.00	14.89	17°10'44"	14.92	S 00°26'59" W
C-14	50.00	40.00	45°50'15"	36.94	S 35°27'49" W
C-15	50.00	40.00	45°50'15"	36.94	S 77°43'02" W
C-16	50.00	46.58	55°36'01"	46.64	N 51°33'45" W
C-17	50.00	70.89	81°13'55"	65.10	N 16°51'13" W
C-18	35.00	39.00	32°44'26"	19.73	N 41°08'06" W
C-19	35.00	30.12	32°56'38"	19.85	N 08°10'26" E
C-20	35.00	60.30	138°11'29"	46.71	N 77°18'34" W
C-21	30.00	36.01	42°11'10"	35.99	S 54°41'20" W
C-22	50.00	40.00	45°50'15"	36.94	S 81°17'59" W
C-23	50.00	40.00	45°50'15"	36.94	S 35°27'49" W
C-24	50.00	40.52	46°26'15"	39.42	N 10°40'26" E
C-25	50.00	40.00	45°50'15"	36.94	N 08°40'39" E
C-26	50.00	43.85	50°14'40"	42.40	S 79°00'55" E
C-27	35.00	60.30	138°11'29"	46.71	N 60°55'49" E

Map#2007-1003




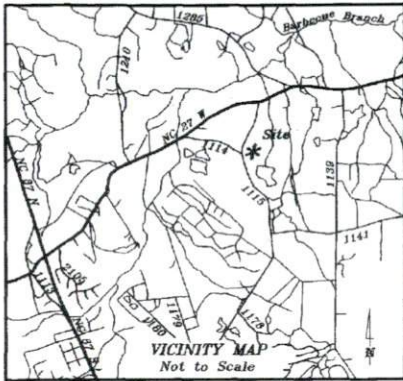

Curve	Radius	Length	Delta	Chord	Chord Bear.
C-1	982.35'	182.27'	8°52'50"	152.12'	N 10°24'40" E
C-2	982.35'	206.61'	12°03'03"	206.23'	N 20°52'38" E
C-3	982.35'	46.98'	2°44'25"	46.98'	N 28°18'22" E
C-4	25.00'	34.75'	79°38'28"	32.02'	S 17°48'17" E
C-5	335.00'	177.79'	30°24'32"	175.71'	S 38°29'17" E
C-6	25.00'	35.70'	82°00'50"	32.81'	S 62°19'39" E
C-7	25.00'	37.08'	84°58'50"	33.77'	S 34°18'32" W
C-8	205.00'	195.90'	30°24'00"	193.15'	N 27°54'56" W
C-9	25.00'	46.05'	100°58'52"	32.80'	S 79°38'56" W

Note:  
Buffalo Lake Road is on the  
NC DOT Thoroughfare plan.

Notes  
Street Lights and Fire Hydrants shall be  
installed per Harnett County Regulations.

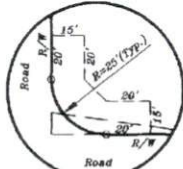

Typical Sign Easement

Note:  
A 10' x 70' Sight Triangle takes  
precedence over sign easement.

Harnett County  
Minimum Building  
Setback Requirements  
RA-20R, RA-20M, RA-30 & RA-40

FRONT: 35' from R/W  
REAR: 20'  
SIDE: 10'  
CORNER LOT SIDE: 20'

See Sheet Two of Two  
for additional notes, seals  
certifications, approvals  
signatures and references.

LEGEND:

—	Lines Surveyed	TP	Telephone Pedestal
- - -	Lines Not Surveyed	MH	Manhole
—	Right of Way Lines	WM	Water Meter
—	EP/IES Existing Iron Pipe or Stake	Emt.	Easement
—	ECM Existing Concrete Monument	R/W	Right-of-Way
—	EPK Existing P.K. Nail	C/L	Centerline
—	PKS P.K. Nail Set	P.C.	Plat Cabinet
—	ISS Iron Stake Set	D.B.	Deed Book
—	CSS Cotton Spindle Set	P.B.	Plat Book
—	RRS Railroad Spike	B.M.	Book of Maps
—	EIS Existing Lightwood Stake	Number	Parcel Identifier
—	FP Power Pole	PIN	Number
—	OEE Overhead Electric Lines	Ac.	Acre
—	Trans. Electric Transformer	Sq. Ft.	square feet
[ ]	Street Address	CP	Computed Point

N.C.G.S. North Carolina Geodetic Survey  
NAD 27 North American Datum of 1927  
NAD 83 North American Datum of 1983

NOTES:  
\* Iron Stakes set at all property corners  
unless noted otherwise.  
\* Areas determined by coordinate method.  
\* All distances/dimensions are horizontal  
ground distances unless otherwise indicated.

North Carolina  
Harnett County

I, Thomas Lester Stancil, certify that this plat was drawn under my supervision from (an actual survey made under my supervision) (deed description recorded in Book [ ] on Page [ ], etc.) (other), that the ratio of precision as calculated by latitudes and departures is 1:10,000, that the boundaries not surveyed are shown as broken lines plotted from information found as shown hereon; that this plat was prepared in accordance with the standards of practice as amended. Witness my original signature, license number and seal this the [ ] day of [ ] A.D. 2007.



Surveyor  
L-1512  
License Number  
I hereby certify that this survey crosses a subdivision of land within the area of Harnett County, NC, which has no ordinance that regulates survey operations.  
Thomas Lester Stancil, P.L.S.

State of North Carolina  
County of Harnett

I hereby certify that this record plat complies with the subdivision regulations of Harnett County, NC, and that this plat has been approved for recording in the Register of Deeds in Harnett County.

Date Planning Director  
State of North Carolina  
County of Harnett  
Shirley Burnett  
Review Officer of Harnett County,  
certify that the map or plat to which this certification is  
affixed meets all statutory requirements for recording.  
Shirley Burnett 11/29/07  
Review Officer Date

HARNETT COUNTY, N.C.  
FILED DATE 11-29-07 TIME 2:38 P.M.  
MAP NUMBER 2007-1002  
REGISTER OF DEEDS  
KIMBERLY S. HARGROVE  
By: Angela J. Bryd, Deputy  
Register of Deeds  
RECORDED IN HARNETT COUNTY, MAP NUMBER 2007 - 1002

FEMA FLOOD HAZARD STATEMENT  
Lots shown on this plat are not  
located within the FEMA 100 year  
Flood Hazard Area as shown on  
FEMA map No. 3710958600J  
Effective Date: October 3, 2006


DEPARTMENT OF TRANSPORTATION  
DIVISION OF HIGHWAYS  
PROPOSED SUBDIVISION ROAD  
CONSTRUCTION STANDARDS CERTIFICATION  
APPROVED C.N. MCGEE  
DISTRICT ENGINEER RDP  
DATE 10/24/07

I hereby certify that the development depicted hereon has been granted final approval by the Harnett County Development Review Commission pursuant to the regulations set forth by E-911 Adopting Ordinance. Health, Fire Marshal, Planning, and Public Utilities of Harnett County, NC. Subject to recording in the Harnett County Office of Registrar of Deeds within thirty days of the date below.  
11-29-07  
[Signature] Board Chairman

Certificate of Ownership and Dedication  
I (we) hereby certify that I am (we are) the owner(s) or agent of the property shown and described hereon, which is located in the subdivision jurisdiction of Harnett County, North Carolina and that I (we) hereby adopt this plat of subdivision with my (our) free consent and establish minimum building setback lines as noted. I further certify that I (we) have not been involved as an owner, lessor, option holder or had any legal or equitable interest in any property adjacent to or located directly across a street, easement, road or right-of-way from the property shown and described hereon.  
10/23/2007 James H. Matthews  
Date Owner or Agent

NOTE:  
A 10' x 70' Sight Triangle shall be placed at all street intersections as shown hereon.  
FOR REGISTRATION REGISTER OF DEEDS  
KIMBERLY S. HARGROVE  
HARNETT COUNTY, NC  
2007 NOV 29 02:38:10 PM  
BK. 2007 PG. 1002-1004 FEE: \$42.00  
INSTRUMENT # 2007021054

Notes  
Property shown hereon is not currently located in a watershed district.  
Lots to be served by individual septic tanks and Harnett County Municipal Water.  
No lot shown hereon shall have direct access to SR 1115 Buffalo Lake Road.  
The individual lot owners shall be responsible for maintaining the drainage easements and streetscape buffers on the respective lots.

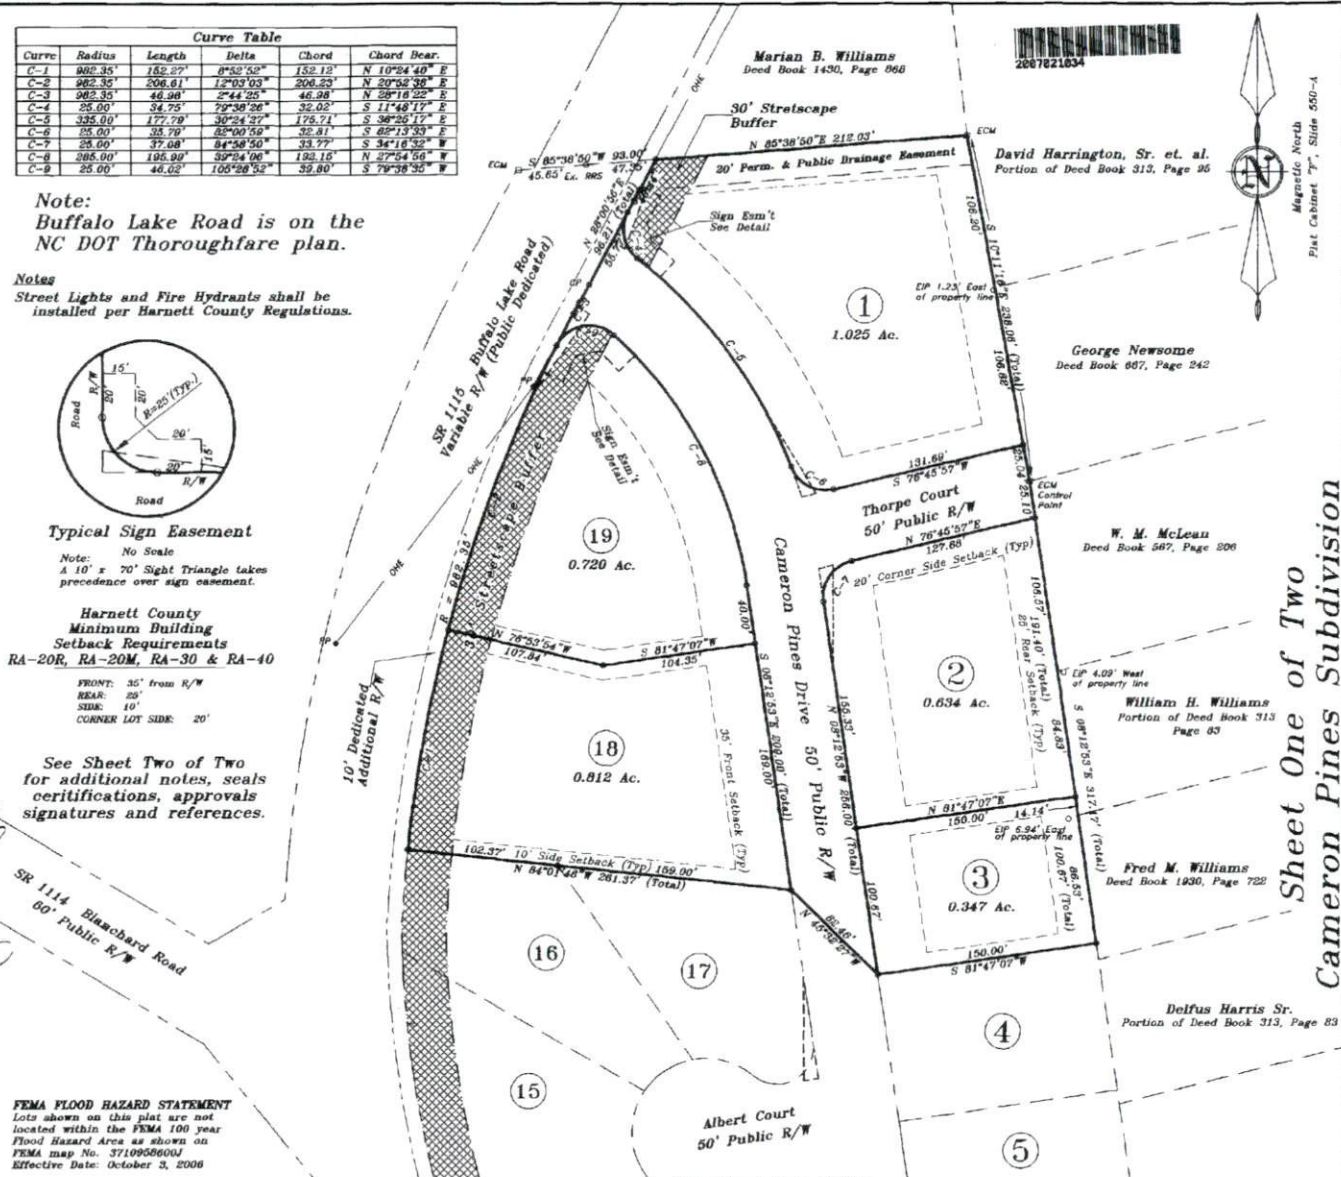

STANCIL & ASSOCIATES,  
Professional Land Surveyor, P.A.  
98 East Depot Street,  
P. O. Box 730, Angier, N.C. 27501  
Phone: 919-659-2602  
Fax: 919-659-2602

DATE: 11-01-06 SURVEYED BY: HGF  
SCALE: 1" = 60' DRAWN BY: PAN  
FIELD BOOK  
SEE FILE  
DRAWING FILE NO.  
LHRQ-574 Q

SURVEYED FOR AND OWNED BY:  
James Matthews Custom Homes, LLC  
782 Penny Road  
Angier, NC 27501 919-894-1388  
COUNTY: HARNETT  
PARCEL ID: 039086 0024  
BARBECUE  
NORTH CAROLINA  
PARCEL NUMBER: 9567-63-7335-000

Revisions:  
Plat Plus 07-04-07  
LHRQ-574 Q  
Revised Name 10-23-07



Sheet One of Two  
Cameron Pines Subdivision



FOR REGISTRATION REGISTER OF DEEDS  
KIMBERLY S. HARGROVE  
HARNETT COUNTY, NC  
2010 DEC 07 04:44:44 PM  
BK:2814 PG:462-464 FEE:\$22.00  
NC REV STAMP:\$370.00  
INSTRUMENT # 2010017605

HARNETT COUNTY TAX ID#

03-9586-0024-94

12-7-10 BY KNO

Revenue: \$370.00

Tax #:

**Prepared By:** Nathan M. Garren, a licensed North Carolina attorney. Delinquent taxes, if any to be paid by the closing attorney to the tax collector upon disbursement of closing proceeds.

**Mail To:** Grantee

STATE OF NORTH CAROLINA

GENERAL WARRANTY DEED

COUNTY OF HARNETT

THIS DEED, made this 30th day of November, 2010, by and between WYNN CONSTRUCTION, INC. (hereinafter "Grantor") with a mailing address of 2550 Capitol Drive, Suite 105, Creedmoor, NC 27522 and RICHARD A. MUSTARD and ERICA F. MUSTARD (hereinafter "Grantees") with a mailing address of 26 Albert Court, Sanford, NC 27332.

WITNESSETH:

THAT Grantor in consideration of Ten Dollars (\$10.00) and other valuable consideration to it paid by Grantees, the receipt of which is hereby acknowledged, has and by these presents does grant, bargain, sell and convey, unto Grantees, their successors, heirs and assigns, all of its interest in that certain tract or parcel of land located in Harnett County and described as being all of Lot 16, containing 0.378 acres, more or less, Cameron Pines Subdivision, according to survey entitled "Cameron Pines Subdivision, Surveyed for and Owned by: James Matthews Custom Homes, LLC," by Stancil & Associates, Professional Land Surveyor, P.A., dated November 1, 2006 and recorded November 29, 2007, in Book of Maps 2007, at Pages 1002 and 1003, reference to which is hereby made for a more complete and accurate description. See Deed Book 2738, Page 64, Harnett County Registry for further reference. The property being conveyed is not the primary residence of the Grantor.



TO HAVE AND TO HOLD the said land, together with all privileges and appurtenances as thereunto belonging unto the said Grantees in fee simple.

And the Grantor covenants with the Grantees, that the Grantor is seized of the premises in fee simple, has the right to convey the same in fee simple, that title is marketable and free and clear of all encumbrances, and that Grantor will warrant and defend the title against the lawful claims of all persons whomsoever except for the exceptions hereinafter stated.

Title to the property hereinabove described is subject to the following exceptions:

1. Ad Valorem taxes for the year 2010 and thereafter.
2. Restrictive covenants and easements of record.

IN WITNESS WHEREOF, the Grantor has caused this instrument to be signed in its corporate name by its duly authorized officer the day and year first above written.

Wynn Construction, Inc.

By: Nancy R. Wynn (SEAL)  
Nancy R. Wynn, Vice President

STATE OF NORTH CAROLINA  
COUNTY OF GRANVILLE

I, Nathan M. Garren, a Notary Public, for the County of Granville, State of North Carolina do hereby certify that Nancy R. Wynn, Vice President of Wynn Construction, Inc., a North Carolina corporation, personally appeared before me this day and, for and on behalf of said corporation, acknowledged the execution of the foregoing instrument.

Witness my hand and official stamp or seal this 30th day of November, 2010.

Nathan M. Garren  
Notary Public

My Commission Expires: October 8, 2012



