

Septic Tank relocation

App# EH2110-0011

# Harnett County Department of Public Health Improvement Permit

A building permit cannot be issued with only an Improvement Permit

ISSUED TO: \_\_\_\_\_ PROPERTY LOCATION: \_\_\_\_\_  
 SUBDIVISION YORKSHIRE PLANTATION LOT # 171  
 NEW  REPAIR  EXPANSION  Site Improvements required prior to Construction Authorization Issuance:  
 Type of Structure: \_\_\_\_\_  
 Proposed Wastewater System Type: \_\_\_\_\_  
 Projected Daily Flow: \_\_\_\_\_ GPD  
 Number of bedrooms: \_\_\_\_\_ Number of Occupants: \_\_\_\_\_ max  
 Basement  Yes  No  
 Pump Required:  Yes  No  May be required based on final location and elevations of facilities  
 Type of Water Supply:  Community  Public  Well Distance from well \_\_\_\_\_ feet Permit valid for:  Five years  
 Permit conditions: \_\_\_\_\_  No expiration

Authorized State Agent: \_\_\_\_\_ Date: \_\_\_\_\_ SEE ATTACHED SITE SKETCH  
 The issuance of this permit by the Health Department in no way guarantees the issuance of other permits. The permit holder is responsible for checking with appropriate governing bodies in meeting their requirements. This site is subject to revocation if the site plan, plat, or the intended use changes. The Improvement Permit shall not be affected by a change in ownership of the site. This permit is subject to compliance with the provisions of the Laws and Rules for Sewage Treatment and Disposal and to conditions of this permit.

## Construction Authorization (Required for Building Permit)

The construction and installation requirements of Rules .1950, .1952, .1954, .1955, .1956, .1957, .1958, and .1959 are incorporated by references into this permit and shall be met. Systems shall be installed in accordance with the attached system layout.

ISSUED TO: Stephanie Donovan PROPERTY LOCATION: 14 Gloucester Ct (SR2561)  
 SUBDIVISION \_\_\_\_\_ LOT # \_\_\_\_\_  
 Facility Type: Laundry room addition  New  Expansion  Repair  
 Basement?  Yes  No Basement Fixtures?  Yes  No  
 Type of Wastewater System\*\* \_\_\_\_\_ (Initial) Wastewater Flow: \_\_\_\_\_ GPD  
 (See note below, if applicable ) New Tank Only (Repair)

**Installation Requirements/Conditions**  
 Septic Tank Size 1000 gallons Number of trenches \_\_\_\_\_  
 Pump Tank Size \_\_\_\_\_ gallons Exact length of each trench \_\_\_\_\_ feet Trench Spacing: \_\_\_\_\_ Feet on Center  
 Trenches shall be installed on contour at a Soil Cover: \_\_\_\_\_ inches  
 Maximum Trench Depth of: \_\_\_\_\_ inches (Maximum soil cover shall not exceed  
 (Trench bottoms shall be level to +/- 1/4" 36" above the trench bottom)  
 in all directions)  
 Pump Requirements: \_\_\_\_\_ ft. TDH vs. \_\_\_\_\_ GPM \_\_\_\_\_ inches below pipe  
 Aggregate Depth: \_\_\_\_\_ inches above pipe  
 Conditions: Addition was built and it encroaches to within 3 foot of the septic tank. new septic tank will be placed 5 foot from the house foundation. Old tank removed  
**WATER LINES (INCLUDING IRRIGATION) MUST BE 10FT. FROM ANY PART OF SEPTIC SYSTEM OR REPAIR AREA.**  
**NO UTILITIES ALLOWED IN INITIAL OR REPAIR DRAIN FIELD AREA.**

\*\*If applicable: I understand the system type specified is different from the type specified on the application. I accept the specifications of this permit.  
 Owner/Legal Representative Signature: \_\_\_\_\_ Date: \_\_\_\_\_

This Construction Authorization is subject to revocation if the site plan, plat, or the intended use changes. The Construction Authorization shall not be transferred when there is a change in ownership of the site. This Construction Authorization is subject to compliance with the provisions of the Laws and Rules for Sewage Treatment and Disposal and to the conditions of this permit. SEE ATTACHED SITE SKETCH

Authorized State Agent: Mohammed REHS Date: 11-05-21  
 Construction Authorization Expiration Date: 11-05-26

Septic Tank relocation


Application # EH2110-0011

### Harnett County Department of Public Health Site Sketch

Property Location: 14 Gloucester Ct (SR2561)

Issued To: Stephanie Donovan Subdivision YORKSHIRE PLANTATION Lot # 171

Authorized State Agent: [Signature] R.E.H.S. Date: 11-05-21

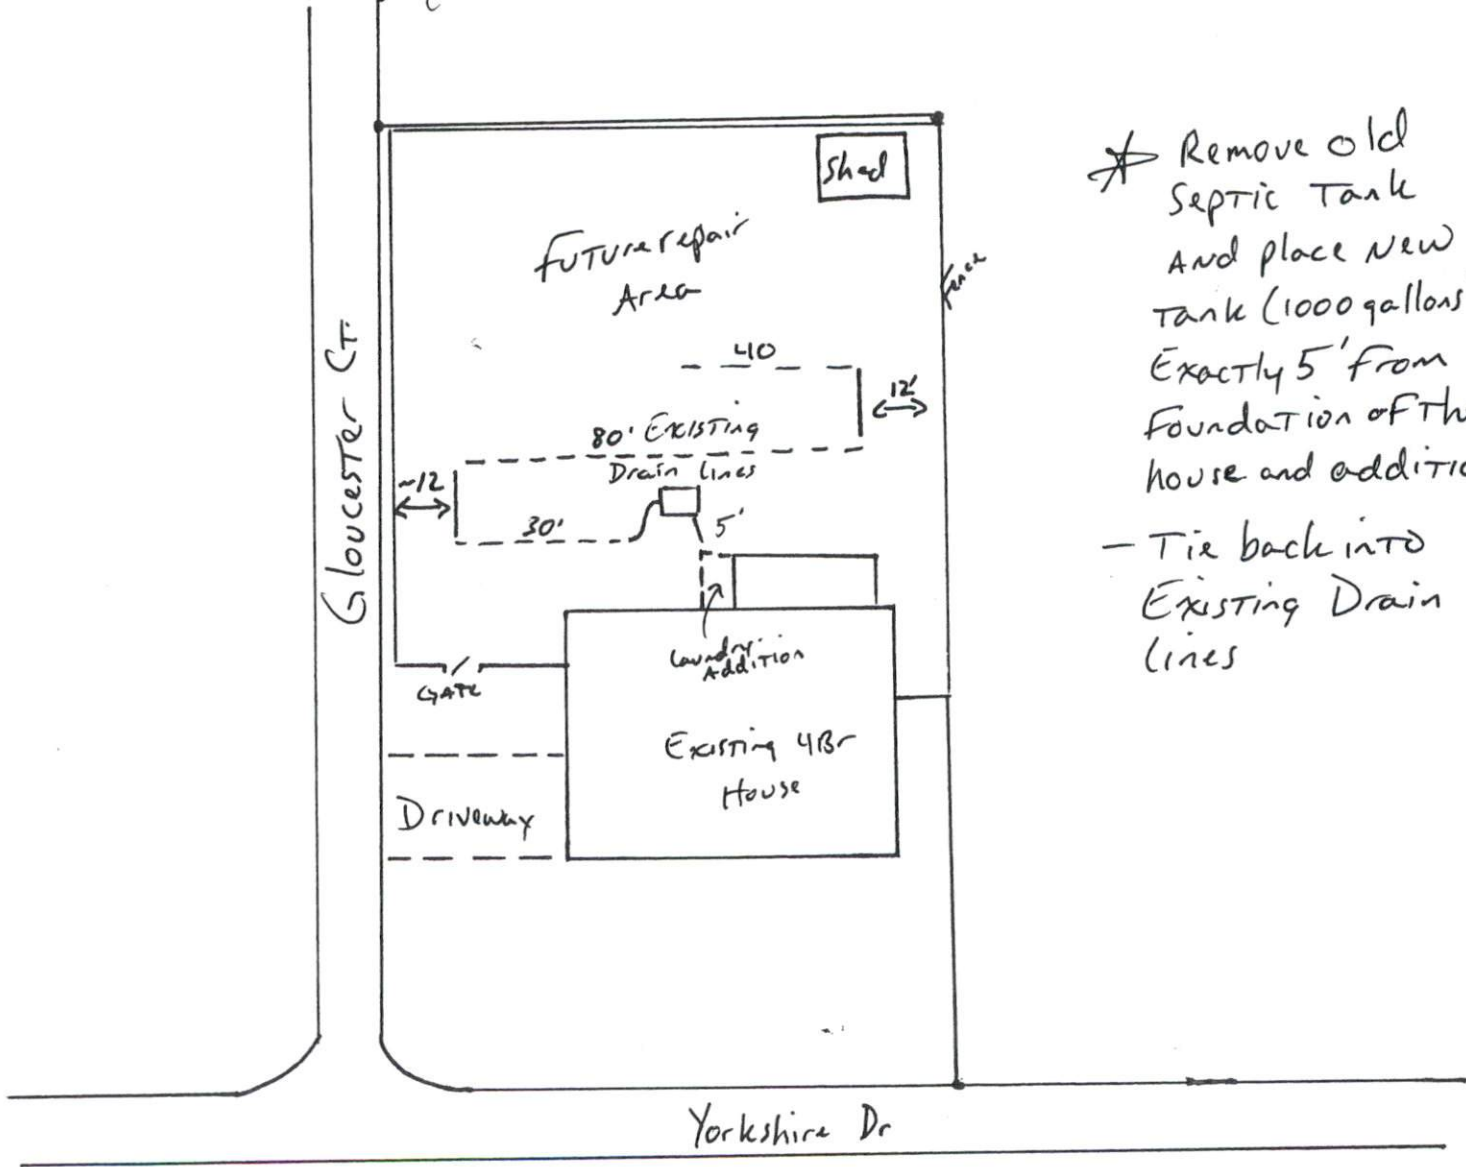

This drawing is for illustrative purposes only. System installation must meet all pertinent laws, rules, and regulations.