




**Harnett**  
C O U N T Y  
NORTH CAROLINA

GIS/E-911 Addressing

November 27, 2023

- County Boundary
- Address Numbers
- Road Centerlines
- Parcels

~~800~~ house 75'x95', front door facing S. River Rd

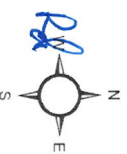

Harnett County GIS