

Harnett County Department of Public Health

Well Abandonment Permit Application

APPLICANT INFORMATION

Tarheel Restoration Inc. (919) 916.9682
Applicant/Owner ~~XXXXX~~ Phone Number

188 Shady Brook Ln. Fuquay Varina NC. 27526
Street Address, City, State, Zip Code

PROPERTY INFORMATION

Street Address 188 Shady Brook Ln. Subdivision/Lot # N/A

Parcel # PIN # 0653-99-064-000

Directions to the Site

GPS System

Brief description of the well location (ex. front yard, behind out building, front yard, etc.)
Rear left of property

***Please include a Site Plan of your property showing the location of the well. If the well is underground, it must be uncovered prior to the department's site visit.**

Please Complete the Following Information:

Date Well Was Constructed circa 50 years Grouted: Yes No
Above Ground or Below Ground Total Depth of Well Approx. 100
Well Type: Drilled Bored Hand dug Diameter 10" inches

I have thoroughly read and completed this Application and certify that the information provided herein is true, complete and correct to the best of my knowledge and is give in good faith. Representatives of the Harnett County Health Department and State Officials are granted right of entry to conduct necessary inspections to determine compliance with applicable rules.

I understand that I am solely responsible for the proper identification and labeling of all property lines, underground utility lines, and making the site accessible so that a will can be properly constructed according to the permit

Bruce C. [Signature] c.o.o Tarheel Restoration Inc. 18 NOV 2024
Property Owner's of Owner's Legal Representative Signature Required Date

If you have any questions please contact Environmental Health Division at 910-893-7547

LOT 3 INFORMATION:
 PIN: 0653-99-0640 000
 FRONT: .35
 CORNER SIDE: 20'
 REAR: 25'
 MAX. BUILDING HEIGHT: .35

LOT 3
 PIN: 0653-99-7891 000
 P/D: 080653 0103 01
 N/F KERIN, JON F & KERIN LYNN, J
 DB 2748 PG 302
 PB 2005 PG 859






LEGEND


- ⊗ COMPUTED POINT
- EXISTING BOUNDARY CORNER FOUND
- BOUNDARY CORNER SET (3/4" IPS)
- GUY WIRE
- UTILITY POLE
- EXISTING IRON PIPE
- EXISTING IRON REBAR
- 3/4" IRON PIPE SET
- DEED BOOK
- PAGE
- PLAT BOOK
- RIGHT OF WAY
- NOW OR FORMERLY
- RETRACED BOUNDARY LINE
- BOUNDARY LINE BY DEED
- EXISTING EASEMENT
- RIGHT OF WAY LINE
- BUILDING SETBACKS
- FENCE
- GRAVEL

CLASS OF SURVEY: A
 POSITIONAL ACCURACY: 0.06'
 TYPE OF GPS FIELD PROCEDURE: NC CORRS NETWORK
 DATES OF SURVEY: AUGUST 2024
 DATUM/EPOCH: NAD83/NSRS2011/SPC
 COMBINED GRID FACTOR(S): 0.999872380
 CGF SCALE POINT: CONTROL CORNER #1
 UNITS: US SURVEY FEET

- NOTES**
1. THE PROPERTY LIES IN ZONE "X" PER NATIONAL FLOOD INSURANCE PROGRAM FLOOD INSURANCE RATE MAP COMMUNITY NUMBERS 372006400 & 3720064200. DATED 10/03/2008.
 2. ALL DISTANCES ARE HORIZONTAL, GROUND DISTANCES AND ALL BEARINGS ARE BASED ON GPS OBSERVATION, NAD 83 / NSRS 2011, NORTH CAROLINA STATE PLANE UNLESS OTHERWISE SHOWN.
 3. SITE ZONED "RA-3J" FOR HARNETT COUNTY PER HARNETT COUNTY GIS.
 4. AREAS COMPUTED BY COORDINATE METHOD.
 5. THIS SURVEY WAS PREPARED BY BATEMAN CIVIL SURVEY COMPANY, UNDER THE SUPERVISION OF JOSHUA ROBERT DAVIDSON, PLS.
 6. THIS MAP HAS NOT BEEN REVIEWED BY A LOCAL GOVERNMENT AGENCY FOR COMPLIANCE WITH ANY APPLICABLE LAND DEVELOPMENT REGULATIONS.
 7. SURVEY WAS MADE IN NO INVESTIGATION OR INDEPENDENT SEARCH FOR EASEMENTS OF RECORD, ENCUMBRANCES, RESTRICTIVE COVENANTS, OWNERSHIP TITLE EVIDENCE, OR ANY OTHER FACTS THAT AN ACCURATE AND CURRENT TITLE SEARCH MAY DISCLOSE.
 8. NO INVESTIGATION INTO THE EXISTENCE OF JURISDICTIONAL WETLANDS OR RIPARIAN BUFFERS BY THIS FIRM.
 9. THE SCALE PURPOSE OF THIS MAP IS TO SHOW THE PROPOSED 26.0' X 48.0' MONOSLAB STRUCTURE FOR PERMITTING.
 10. NOT ALL FEATURES WERE SURVEYED DURING THIS SURVEY. STRUCTURES & FEATURES SHOWN ARE PER OWNERS INSTRUCTIONS WHILE CONDUCTING THIS SURVEY.

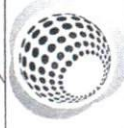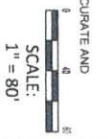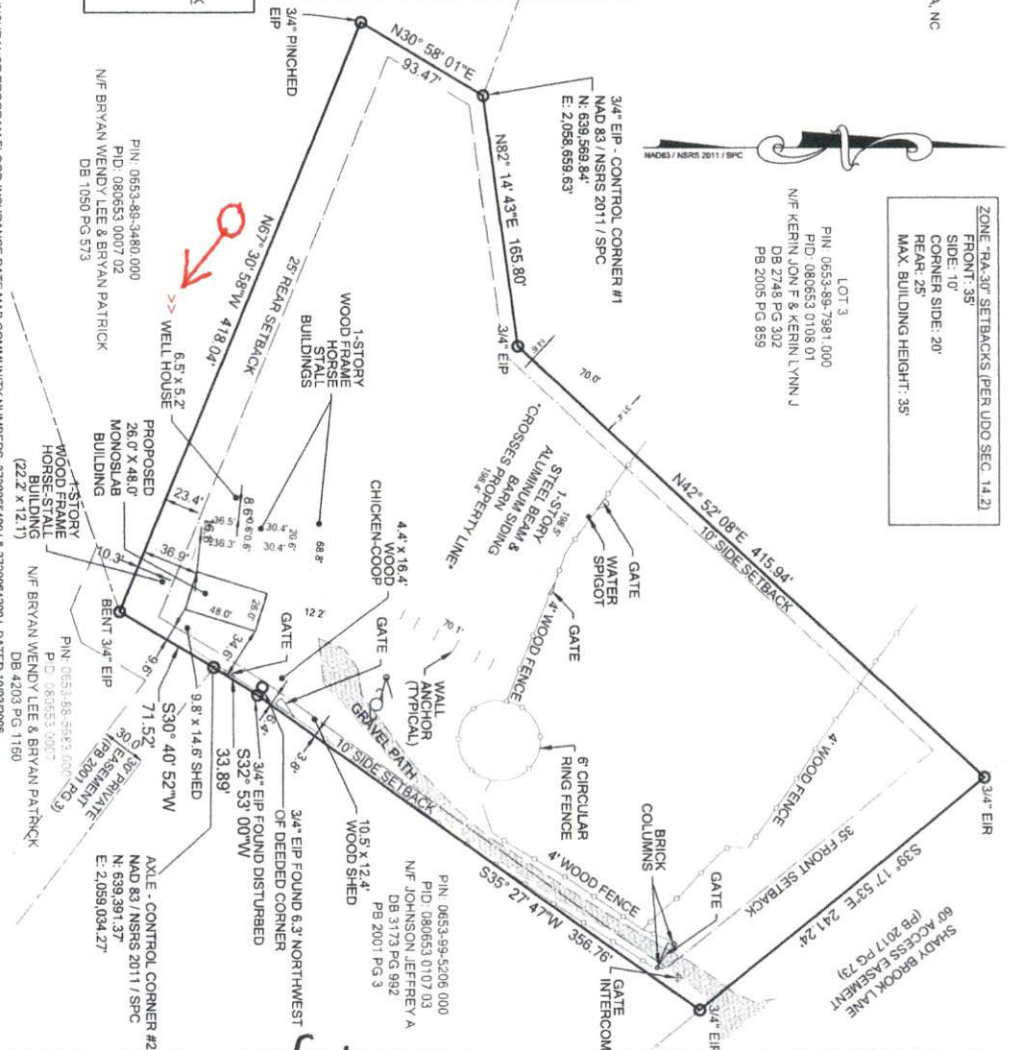

BATEMAN CIVIL SURVEY COMPANY
 ENGINEERS • SURVEYORS • PLANNERS
 2524 RELIANCE AVENUE, ALEX, NC 27539
 PHONE: (919) 577-1090 FAX: (919) 577-1081
 INFO@BATEMANCIVILSURVEY.COM
 NCELS # FRM# C-2278

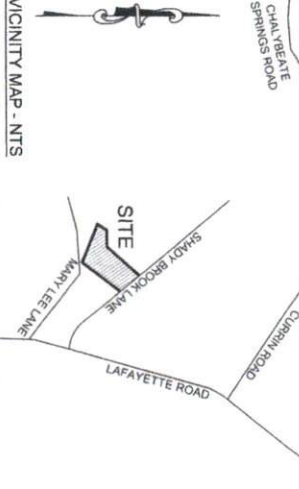

VICINITY MAP - NTS

I, JOSHUA R. DAVIDSON, CERTIFY THAT THIS MAP WAS DRAWN UNDER MY SUPERVISION AND PROPERTY LINES SHOWN ARE BASED ON DEEDS OR PLATS AS REFERENCED. THAT THIS PLAN HAS BEEN PREPARED FOR LAYOUT AND PERMITTING PURPOSES ONLY AND IS NOT A BOUNDARY SURVEY, AND THAT THIS MAP MEETS THE REQUIREMENTS OF THE STANDARDS OF PRACTICE FOR LAND SURVEYING IN NORTH CAROLINA (21 NCAAC 96, 1600).

JOSHUA R. DAVIDSON, PLS
 NC LICENSE NO. L-5350
 DATE

THIS MAP IS CONSIDERED PRELIMINARY, NOT FOR RECORDATION, CONVEYANCE OR SALES UNLESS SIGNED AND SEALED BY THE LICENSED SURVEYOR.

BUILDER TO VERIFY HOUSE LOCATION, DIMENSIONS AND REVIEW TOTAL IMPERVIOUS NOTED ON THIS PLOT PLAN

PLOT PLAN EXCLUSIVELY FOR TAR HEEL RESTORATION

190 SHADY BROOK LANE, FUQUAY-VARINA, NC
 HECTORS CREEK TOWNSHIP, HARNETT COUNTY
 DATE: 10/28/24 DRAWN BY: BMN CHECKED BY: JRD
 REFERENCE: PB 2005 PG 159 BCS# 240697 SCALE: 1" = 80'