



Harnett County Department of Public Health

Well Abandonment Permit Application

Harnett County Government Complex 307 W. Cornelius Harnett Boulevard Lillington, NC 27546

ph: 910-893-7550 fax: 910-893-9429

APPLICANT INFORMATION

Acme well service Co Inc (919) 215-5957 Applicant/Owner Phone Number

101 E. Roosevelt St Street Address, City, State, Zip Code

PROPERTY INFORMATION

Street Address 765 Brick Mill Rd Subdivision/Lot #

Parcel # PIN #

Directions to the Site

421 S out of Lillington pass Campbell unver. Turn L onto (27) Airport Rd, take first R. onto Brickmill Rd. House on right just before Coats Elementary

Brief description of the well location (ex. front yard, behind out building, front yard, etc.) Well is across street, down hill from power pole

*Please include a Site Plan of your property showing the location of the well. If the well is underground, it must be uncovered prior to the department's site visit.

Please Complete the Following Information:


Date Well Was Constructed n/a Grouted: Yes [] No [] Above Ground [X] or Below Ground [] Total Depth of Well n/a Well Type: Drilled [] Bored [X] Hand dug [] Diameter inches

I have thoroughly read and completed this Application and certify that the information provided herein is true, complete and correct to the best of my knowledge and is give in good faith. Representatives of the Harnett County Health Department and State Officials are granted right of entry to conduct necessary inspections to determine compliance with applicable rules.

I understand that I am solely responsible for the proper identification and labeling of all property lines, underground utility lines, and making the site accessible so that a will can be properly constructed according to the permit.

Signature Date 11/18/24 Property Owner's or Owner's Legal Representative Signature Required

If you have any questions please contact Environmental Health Division at 910-893-7547

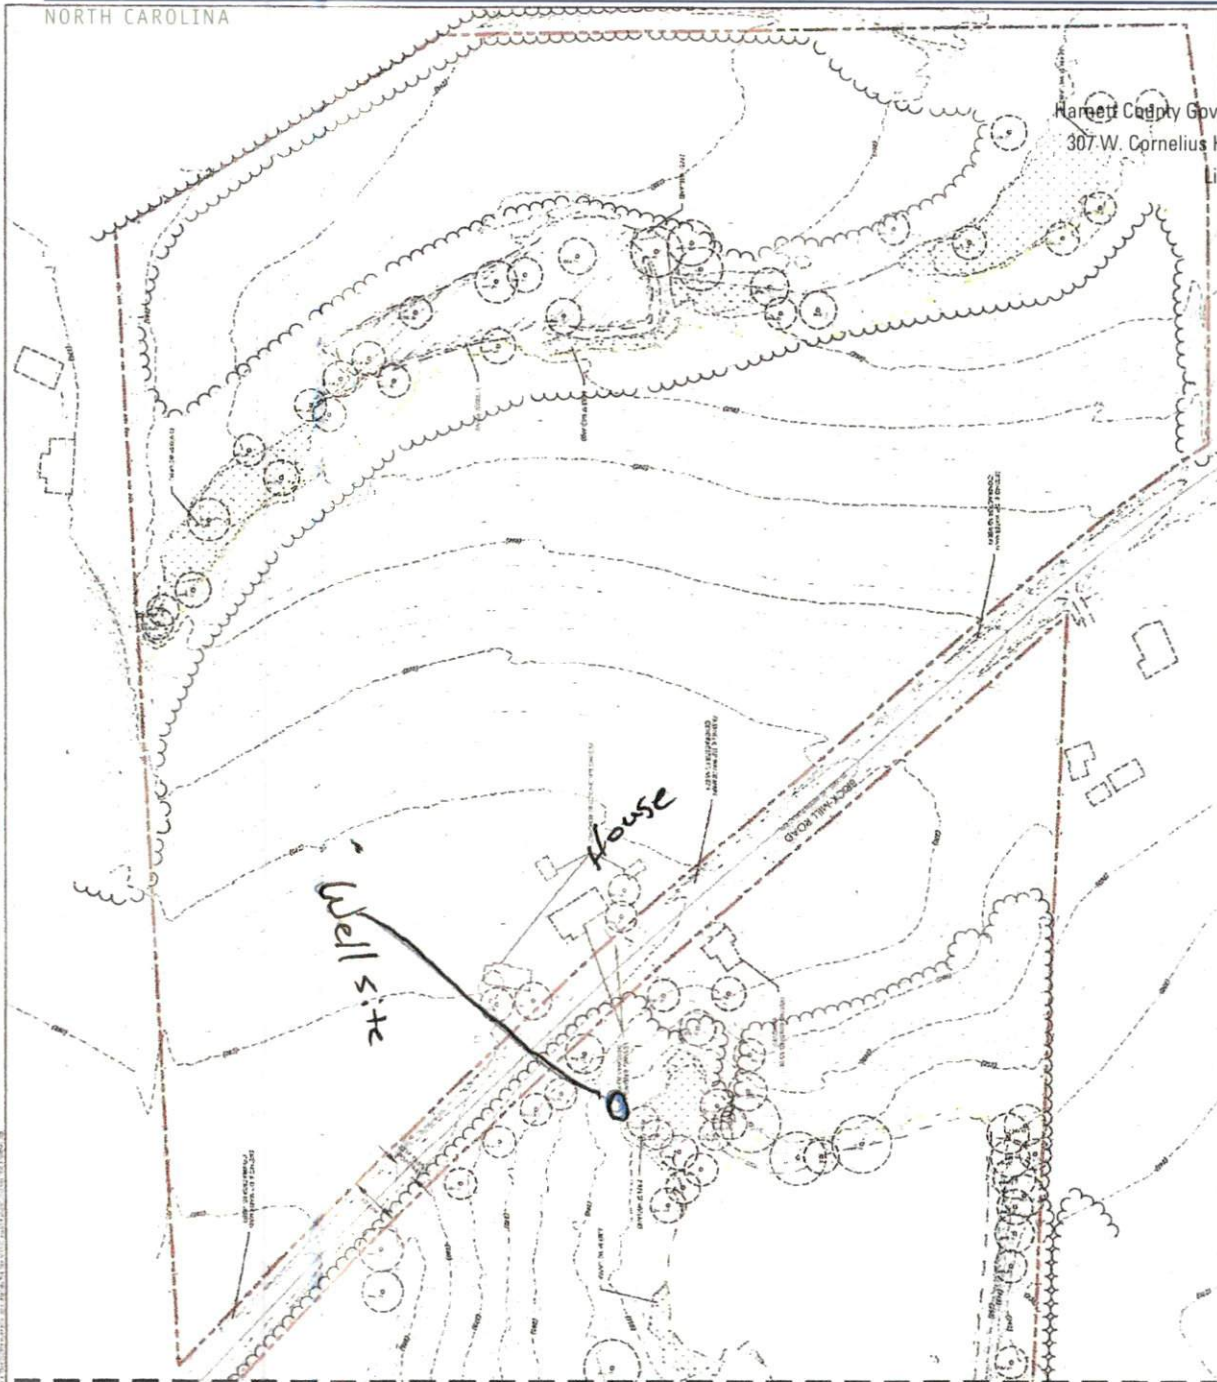


MATCH LINE C004



Proj. 0403-41-1313-003
Rev. 04/05/2003

C003
APRIL 14, 2003
HARNETT COUNTY

1. DATE OF PLAN
2. PLAN NUMBER
3. PROJECT NAME
4. PROJECT NUMBER
5. PROJECT LOCATION

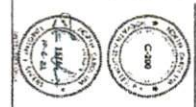

EXISTING
CONDITIONS

BRICK MILL ESTATES
765 BRICK MILL ROAD
HARNETT COUNTY
COATS, NORTH CAROLINA

HORVATH ASSOCIATES
1000 ALBERT AVENUE, SUITE 200
RANDOLPH COUNTY, NC 28134
TEL: 704-771-2200
FAX: 704-771-2201
WWW.HORVATHASSOCIATES.COM

