

HARNETT COUNTY HEALTH DEPARTMENT 10-259360nj  
ENVIRONMENTAL HEALTH SECTION, PO BOX 09, LILLINGTON, NC 893-7547  
APPLICATION FOR IMPROVEMENT PERMIT

DATE 10/22/93

NAME FRANK OLIVER SR. TELEPHONE NO. 893-9753

ADDRESS (current) 9513 KATHLEEN LANE LILLINGTON, N.C. 27546

PROPERTY OWNER \_\_\_\_\_

SUBDIVISION NAME HIGHLAND HILLS LOT NO. 34

PROPERTY ADDRESS 9513 KATHLEEN LN. LILLINGTON STATE ROAD NO. \_\_\_\_\_

DO YOU HAVE A LEGAL DEED TO THIS PROPERTY? YES  IF NO \_\_\_\_\_  
PLEASE SHOW A PURCHASE AGREEMENT OR AUTHORIZATION OF AUTHORITY  
IF NO EXPLAIN \_\_\_\_\_

DIRECTIONS 27 W. to Doc's RR. take a left to micro-tower  
take a right highland hills is right off micro tower

SIZE OF LOT OR TRACT 3.48 AC.

- 1. Type of dwelling DW-MA Basement with plumbing \_\_\_\_\_
- 2. Number of Bedrooms 3 Garage \_\_\_\_\_
- 3. Dishwasher  \_\_\_\_\_
- 4. Garbage Disposal \_\_\_\_\_

WATER SUPPLY - PRIVATE WELL \_\_\_\_\_ COMMUNITY SYSTEM \_\_\_\_\_ COUNTY

A plot plan must be attached to this application showing: 1) Setting of dwelling, 2) Desired placement of septic tank system and 3) well placement.

Place stakes at the exact location of dwelling and at each corner of lot.

An on site inspection must be made, which consists of a soil evaluation.

A zoning permit must be obtained from the Planning Department before an improvement permit can be issued by this department.


This certifies that all the above information is correct to the best of my knowledge and any false information will result in the denial of permit. Once the permit is issued, the permit is good for a period of 5 years. The permit is subject to revocation if site plans or the intended use change.

Signature of Owner Frank Oliver Sr.

Revised (3-93) or Authorized Agent ONLY.

11-12-93 PC to # hold for pick-up FO

SCALE 1" = 100'

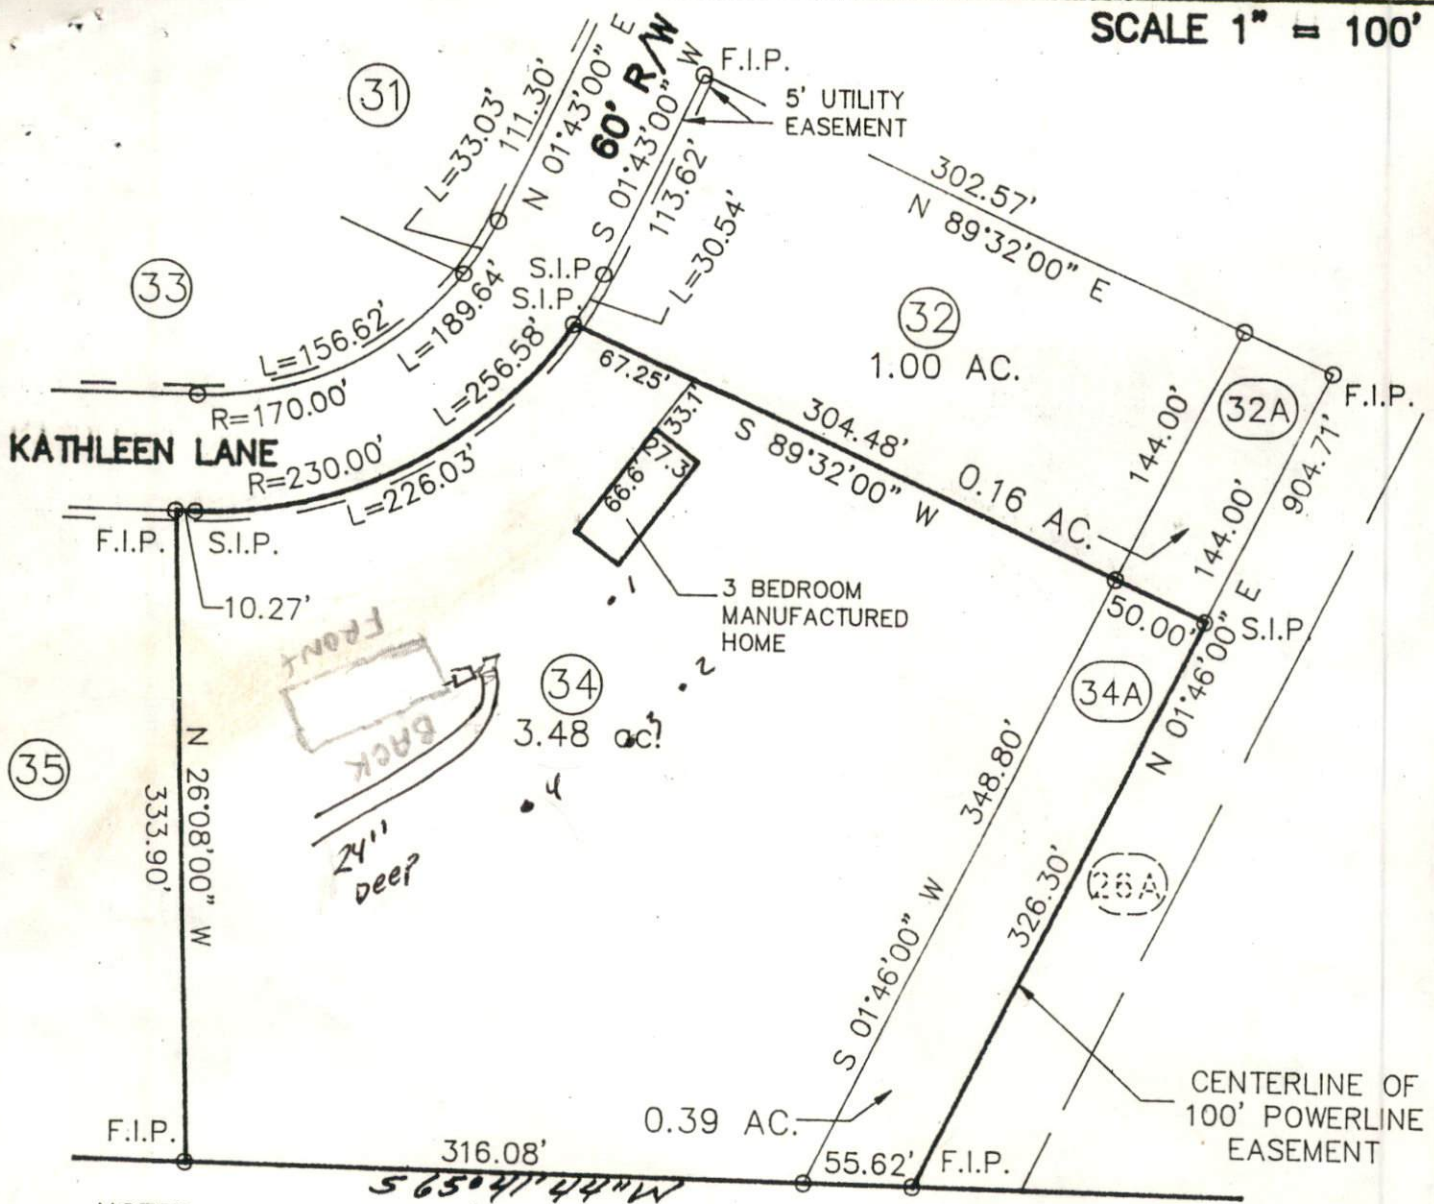

NOTES

1. F.I.P. - DENOTES FOUND IRON PIPE
2. S.I.P. - DENOTES SET IRON PIPE
3. THIS PROPERTY IS NOT WITHIN A FLOOD HAZARD AREA AS DELINEATED BY H.U.D.

I, LARRY K. ALLEN, CERTIFY THAT THIS PLAT WAS DRAWN UNDER MY SUPERVISION FROM AN ACTUAL SURVEY MADE UNDER MY SUPERVISION (DEED DESCRIPTION RECORDED IN PLAT CABINET #F, SLIDE 139-A & 139-A(A)) THAT BOUNDARIES NOT SURVEYED ARE SHOWN AS BROKEN LINES AND DRAWN FROM DEEDS AS INDICATED: THAT THE RATIO OF PRECISION AS CALCULATED IS 1: 15,000, : THAT THIS PLAT WAS PREPARED IN ACCORDANCE WITH G.S. 47-30 AS AMENDED. WITNESS MY ORIGINAL SIGNATURE, REGISTRATION NUMBER AND SEAL THIS 4th DAY OF MARCH, A.D., 1993.

*Larry K. Allen*  
 LARRY K. ALLEN, SURVEYOR  
 L-2454  
 REGISTRATION NUMBER

SEAL OR STAMP

STATE OF NORTH CAROLINA, LEE COUNTY

I, MARILYN ALLEN, A NOTARY PUBLIC OF THE COUNTY, AND STATE AFORESAID, CERTIFY THAT LARRY K. ALLEN, A REGISTERED LAND SURVEYOR PERSONALLY APPEARED BEFORE ME THIS DAY AND ACKNOWLEDGED THE EXECUTION OF THE FOREGOING INSTRUMENT. WITNESS MY HAND AND OFFICIAL STAMP OR SEAL, THIS 4th DAY OF MARCH, 1992.

SURVEY OF HILAND HILLS SUBDIVISION P. - FARNETT CO. - N.C.	OWNER STONEHEDGE PROPERTIES INC. RT. 6, BOX 300-B SANFORD, N.C.
	2454 9)499-5812