

HARNETT COUNTY HEALTH DEPARTMENT
ENVIRONMENTAL HEALTH SECTION
307 W. CORNELIUS HARNETT BLVD.
LILLINGTON, NC 27546
910-893-7547 PHONE
910-893-9371 FAX

Application for Repair

EMAIL ADDRESS: Tylerkz78@gmail.com

NAME Tyler Krantz

PHONE NUMBER 919-279-2801

PHYSICAL ADDRESS 254 TROY DRIVE FUQUAY VARENA 27526

(and mailing)
MAILING ADDRESS (IF DIFFERENT THAN PHYSICAL) _____

IF RENTING, LEASING, ETC., LIST PROPERTY OWNER NAME _____

Layout att'd

HILLIARD PLACE

20

SUBDIVISION NAME

LOT #/TRACT #

STATE RD/HWY

SIZE OF LOT/TRACT

Type of Dwelling: Modular Mobile Home Stick built Other _____

Number of bedrooms 3 Basement

Garage: Yes No Dishwasher: Yes No

Garbage Disposal: Yes No

Water Supply: Private Well Community System County

Directions from Lillington to your site: 401 N TO RAWLS CHURCH ROAD RIGHT ON RAWLS TO
HILLIARD PLACE ON RIGHT, HILLIARD TO LEFT ON TROY DRIVE

In order for Environmental Health to help you with your repair, you will need to comply by completing the following:

1. A "surveyed and recorded map" and "deed to your property" must be attached to this application. Please inform us of any wells on the property by showing on your survey map.
2. The outlet end of the tank and the distribution box will need to be uncovered and property lines flagged. After the tank is uncovered, property lines flagged, underground utilities marked, and the orange sign has been placed, you will need to call us at 910-893-7547 to confirm that your site is ready for evaluation.

Your system must be repaired within 30 days of issuance of the Improvement Permit or the time set within receipt of a violation letter. (Whichever is applicable.)

By signing below, I certify that all of the above information is correct to the best of my knowledge. False information will result in the denial of the permit. The permit is subject to revocation if the site plan, intended use, or ownership changes.

Signature

Tyler Krantz

Date

6/25/14

6/30/14
N

HOMEOWNER INTERVIEW FORM

It is important that you answer the following questions for our inspectors. Please do not leave any blanks if possible, and answer all questions to the best of your ability. Thank You.


Have you received a violation letter for a failing system from our office? YES NO
Also, within the last 5 years have you completed an application for repair for this site? YES NO

Year home was built (or year of septic tank installation) 1998
Installer of system _____
Septic Tank Pumper _____
Designer of System _____

1. Number of people who live in house? 2 # adults 2 # children _____ # total
2. What is your average estimated daily water usage? _____ gallons/month or day _____ county water. If HCPU please give the name the bill is listed in ANNIE / TYLER KRANTZ
3. If you have a garbage disposal, how often is it used? daily weekly monthly
4. When was the septic tank last pumped? 2012 How often do you have it pumped? _____
5. If you have a dishwasher, how often do you use it? daily every other day weekly
6. If you have a washing machine, how often do you use it? daily every other day weekly monthly
7. Do you have a water softener or treatment system? YES NO Where does it drain?


8. Do you use an "in tank" toilet bowl sanitizer? YES NO
9. Are you or any member in your household using long term prescription drugs, antibiotics or chemotherapy? YES NO If yes please list _____
10. Do you put household cleaning chemicals down the drain? YES NO If so, what kind?

11. Have you put any chemicals (paints, thinners, etc.) down the drain? YES NO
12. Have you installed any water fixtures since your system has been installed? YES NO If yes, please list any additions including any spas, whirlpool, sinks, lavatories, bath/showers, toilets _____
13. Do you have an underground lawn watering system? YES NO
14. Has any work been done to your structure since the initial move into your home such as, a roof, gutter drains, basement foundation drains, landscaping, etc? If yes, please list _____
15. Are there any underground utilities on your lot? Please check all that apply:
 Power Phone Cable Gas Water
16. Describe what is happening when you are having problems with your septic system, and when was this first noticed?
FILL BED LINES ARE FULL OF WATER DUE TO BROKEN DISTRIBUTION BOX
2 MONTHS
more than broken D-Box also,
17. Do you notice the problem as being patterned or linked to a specific event (i.e., wash clothes, heavy rains, and household guests)? YES NO If Yes, please list _____

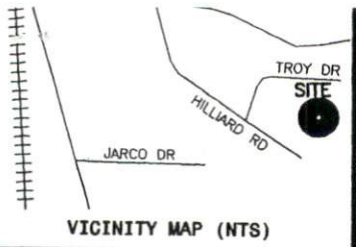


LEGEND

- NTS NOT TO SCALE
- EIP EXISTING IRON PIPE
- PP POWER POLE
- W/M WATER METER
- TB TELEPHONE BOX
- IPS IRON PIPE SET
- CP&L TRANSFORMER
- CATV CABLE TV BOX
- L POLE LIGHT POLE
- OHPL OVERHEAD POWER LINE
- F.E.S. FLARED END SECTION (PIPE)
- RCP REINFORCED CONC. PIPE
- B.O.C. BACK OF CURB
- F.H. FIRE HYDRANT
- C/O SEWER CLEAN OUT
- EIS EXISTING IRON STAKE
- M.H. MANHOLE
- ECM EXISTING CONCRETE MONUMENT
- P.K. PARKER KALON NAIL

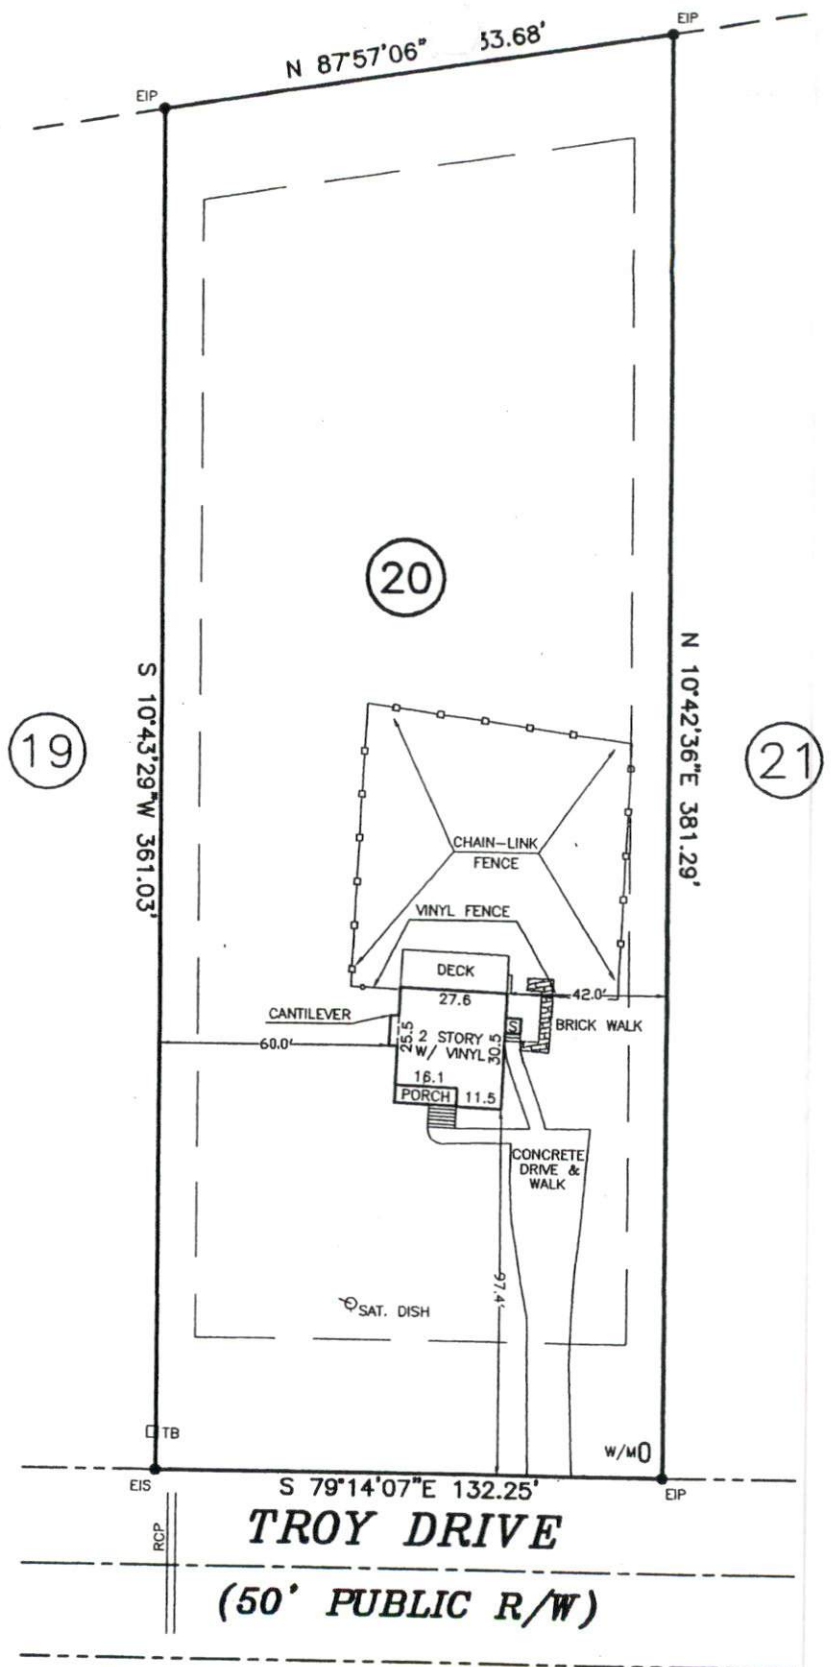

NOTE: SHOWN IS LOT 20 OF HILLIARD PLACE S/D
REF: P.C.#F SLIDE 213A

AREA = 1.126 ACRES
254 TROY DRIVE

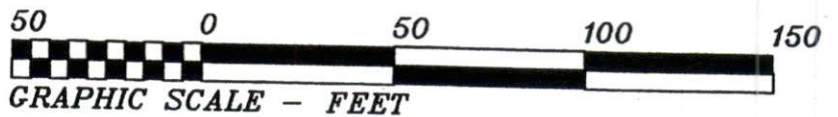

THIS IS TO CERTIFY THAT THIS MAP WAS PREPARED FROM AN ACTUAL SURVEY OF THE PREMISES, MADE UNDER MY SUPERVISION, AND THAT THERE ARE NOT ANY ENCROACHMENTS, EXCEPT AS NOTED TO THE BEST OF MY KNOWLEDGE. THAT THE RATIO OF PRECISION AS CALCULATED BY LATITUDES AND DEPARTURES IS 1:10,000. THIS MAP WAS PREPARED FOR TITLE COMPANY USE AND IS NOT INTENDED FOR RECORDATION OR



SURVEY FOR:

TYLER F. KRANTZ
ANNE M. KRANTZ

HECTOR'S CREEK TWP., HARNETT CO., N.C.
SCALE 1" = 50' DECEMBER 19, 2011

HARNEY COUNTY HEALTH DEPARTMENT
ENVIRONMENTAL HEALTH SECTION

No 12812

OPERATIONS PERMIT

Name: (owner) Walters + Batchelor Const. New Installation Septic Tank
Property Location: SR# 1415 Repairs Nitrification Line
Subdivision Hilliard Place Lot # 20
TAX ID# _____ Quadrant # _____
Contractor: Johnny Jones Registration # _____

Basement with Plumbing: Garage:
Water Supply: Well Public Community
Distance From Well: _____ ft.

Following are the specifications for the sewage disposal system on above captioned property.

Type of system: Conventional Other Polystyrene Aggregate Trench System 111115-95-3R
Size of tank: Septic Tank: 1000 gallons Pump Tank: _____ gallons
Subsurface Drainage Field No. of ditches 1 exact length of each ditch 260 ft. width of ditches 3 ft. depth of ditches 18-36 in.
French Drain: _____ Linear feet

PERMIT NO. 15734 Date: 8-17-99
Inspected by: Thomas J. Boyer R.S.
Environmental Health Specialist

