

HARNETT COUNTY HEALTH DEPARTMENT
ENVIRONMENTAL HEALTH SECTION,
APPLICATION FOR REPAIR

DATE 6/29/99NAME F. Kay Denner TELEPHONE NO. 919/499-6139ADDRESS (current) 317 Milled Rd. Buffalo LakePROPERTY OWNER Rita C. & F. Kay DennerSUBDIVISION NAME Buffalo Lake LOT NO. 241STATE ROAD NAME Milled Road. STATE ROAD NO. -LOCATION OF PROPERTY:SIZE OF LOT OR TRACT 80' x 194 x 87 x 228'DIRECTIONS Buffalo Lake - milled Road -
.3 miles on left -

Type of dwelling	<u>Frame</u>	Basement with plumbing	<u>Yes</u>
Number of bedrooms	<u>4</u>	Garage	<u>No</u>
Dishwasher	<u>2</u>	Garbage disposal	<u>No</u>

WATER SUPPLY: PRIVATE WELL COMMUNITY SYSTEM COUNTY X

1) A surveyed and recorded map must be attached to this application along with a site plan showing: 1) Location of dwelling, 2) Location of driveway, 3) Location of any walls and other existing structures. A copy of the deed must also be attached.

2) The outlet end of the tank and distribution box will need to be uncovered and property lines marked. After the tank is uncovered and property lines are marked, you will need to call us at 893-7547 or 893-7548 and let us know that it is ready.

3) The system must be repaired in the set time of violation letter or if there is no violation letter, then it needs to be repaired within 30 days.

This certifies that all of the above information is correct to the best of my knowledge. False information will result in the denial of the permit. The permit is subject to revocation if the site plan, intended use, or ownership change.

Signature of Owner or
Authorized Agent ONLYF. Kay Denner

Address: 317 MALLARD RD.
Buffalo Lake
Zebulon, NC. 27330

Phone: (E) 919/499-6139
(W) 919/274-3003
Ex 1302

Installer of System: UNKNOWN

Septic Tank Pumped: Wayne Shape

Designer of System: DK/now

1. Number of people who live in the house: 4

How many adults: 4 How many children: 0

2. What is your average daily water usage?

3. Do you have a garbage disposal? NO

How often do you use it?

4. When was the septic tank last pumped? 6/5/99

How often do you have it pumped? Avg. monthly (likely)

5. Do you have a dishwashing machine? Yes

How often do you use it? Like 2-3 days

6. Do you have a clothes washing machine? Yes

How often do you use it? 7 loads a week

7. Do you have a water softener or water treatment system? NO

Where does it drain?

8. Do you use an "in the tank" toilet bowl sanitizers? NO

9. Is any family member using a (long term) prescription drug, antibiotics or chemotherapy? NO

What kinds?

What kinds?

11. Are any chemicals (paints, thinners, etc.) disposed down the drain? NO

What kinds?

12. Have any new water using fixtures been added since the system was installed? Yes

What kinds? Dishwasher, Wash machine in Downspout APT.

List plumbing fixtures (like spas, whirlpools) other than sinks, lavatories,

bath/showers and toilets: NONE

13. Do you have an underground lawn-watering system? Yes

14. Has any site work been done to the house since you moved in, such as underground roof gutter drains, basement/foundation drains, landscaping, etc.? No

What kinds? Root gutter drains And Landscaping

15. Are there any underground utilities on your lot?

Check which types:

Power Phone _____ Cable _____ Gas _____ Water


16. Describe what happens when you have a problem with your septic tank system.

Water backs up & collects in the Bath tub
in the basement apt. & the Basement Toilet
does not flush properly

When did you first notice the problem? 3 months ago

Does the problem seem to be linked to a specific event (washing clothes, heavy rains, company coming over, etc.)?


Washing Clothes

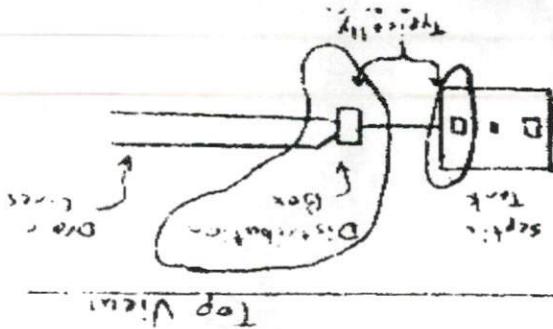

Please call us when the
893-7547

- * Please uncover outlet end
and loose trapdoor cover.

Baffle wall

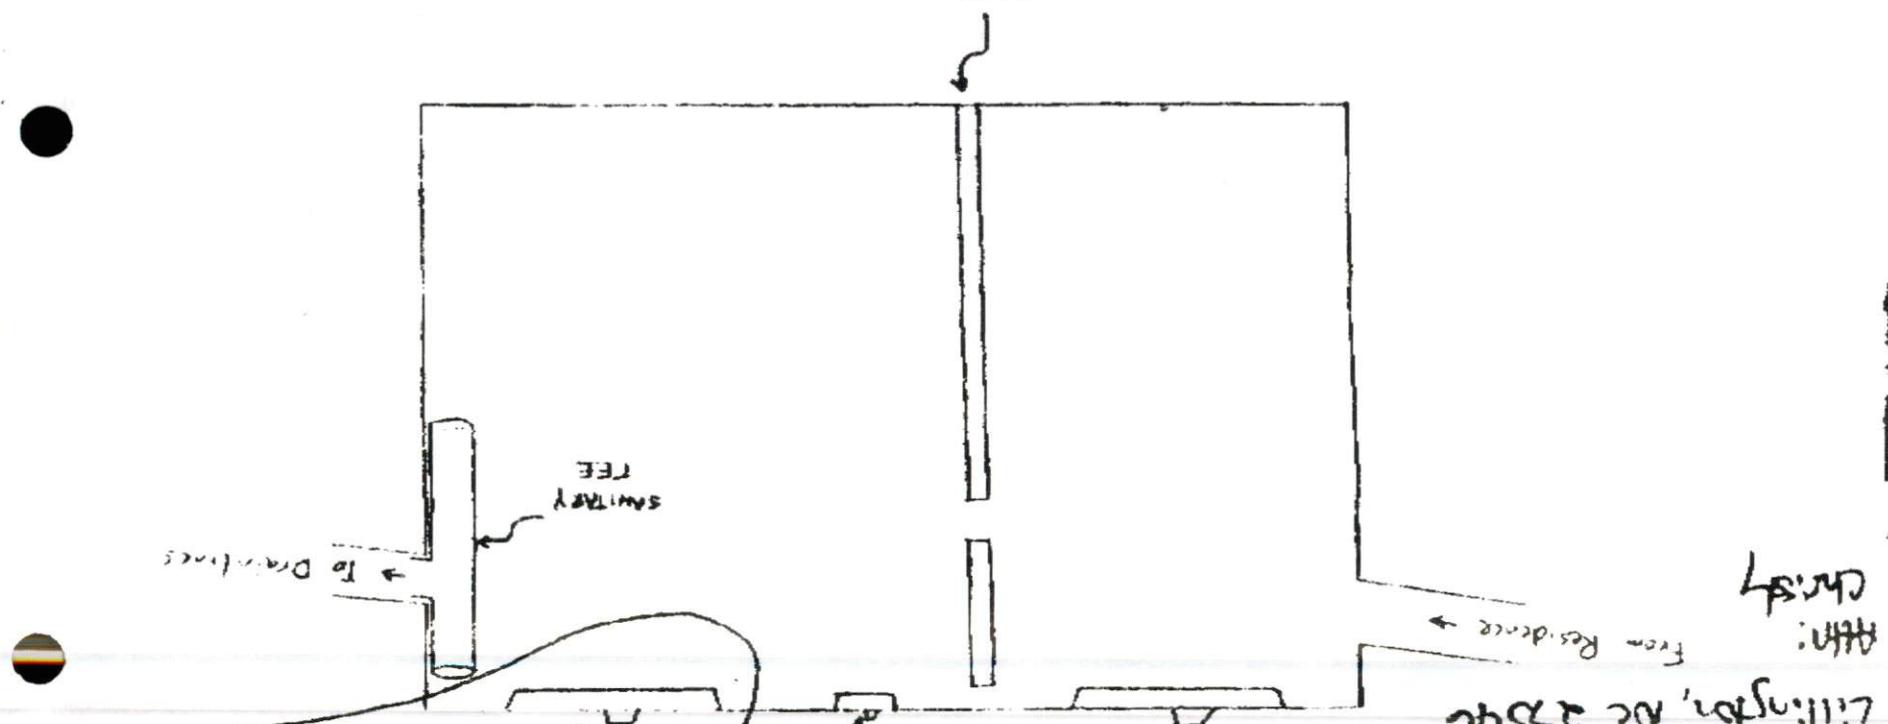

Please call

Hanover County Health Dept.
Environmental Health Section
307 Cornelius Hartnett Blvd.
Lilleyton, NC 27546
Attn: Fire Residencies
Chris

SIDE VIEW

TYPIICAL SEPTIC TANK

1-800-633-4949

WATER

MISCELLANEOUS DEEDS
AND MORTGAGES

597

92

THIS DEED Made this the 14th day of August, A.D. 1973, by

WILLIAM ELBERT COOK and his wife

of RITA JEAN COOK County, and State of North Carolina, part X, of the first part, to

and his wife

of Lee County, and State of North Carolina, part X, of the second part,

WITNESSED, That the TEN AND NO/100 DOLLARS

to him, paid by the said part X of the second part, the receipt of which is hereby acknowledged, has/have been gained and sold and by these presents dees... bargain, sell and convey unto the said part X of the second part and him holds a tract or parcel of land in Barbecue Township, Harnett County, North Carolina, more particularly described as follows:

All of Lot No. 241, as shown on the Map entitled "Map No. 6 Buffalo Lakes, Harnett County N.C.", which map is recorded in Map Book 9, Page 130, Office of the Register of Deeds of Harnett County N.C. and also to which map reference is hereby made for a more particularly and exact description.

TRANSFER RECORDED IN THE
OFFICE OF HARNETT COUNTY
TAX SUPERVISOR

ON 7-17-79

TAX SUPERVISOR

Dr. Thomas C. Allen



5970092

The above land was conveyed to grantee by William Elbert Cook, Esq. Book No. Page.

TO HAVE AND TO HOLD the aforesaid tract or parcel of land and all privileges and appurtenances therewith belonging to the said part X of the second part and her heirs and assigns forever.

And the said part X of the first part do acknowledge that he is/were seized of said premises in fee and has the right to convey the same in fee simple; that the same are free from encumbrances other than aforesaid above; and that he will warrant and defend the said title to the same against the claims of all persons whatsoever.

IN WITNESS WHEREUPF the said part X of the first part had hereto set his hand, and seal, the day and year first above written.

WITNESS:

Yvette S. Jones
224 Spencer Drive
Pt. Walton Beach, Florida 32543

William Elbert Cook (SEAL)

(SEAL)

(SEAL)

(SEAL)

STATE OF NORTH CAROLINA, COUNTY OF CRANE CO. S.A.

I, William Elbert Cook, Notary Public of said County, do hereby certify,

Grantors, personally appeared before me this day and acknowledged the execution of the foregoing instrument conveying the same.

Witness my hand and seal, this the 27 day of August, A.D. 1973.

My commission expires:

Notary Public, State of Florida, No. 11-1974

Notary Public

The foregoing certificate(s) of Jeanne E. Paper

is (are) certified to be correct. This instrument was presented for registration this 17 day of Sept, A.D. 1973, at 8:30 A.M., P.M., and duly recorded in the office of the Register of Deeds of


Harnett County, North Carolina in Book 597, Page 92, A.D. 1973.


This the 17 day of Sept, A.D. 1973,


Dr. Thomas C. Allen

REGISTER OF DEEDS

By ASSISTANT, DEPUTY REGISTER OF DEEDS

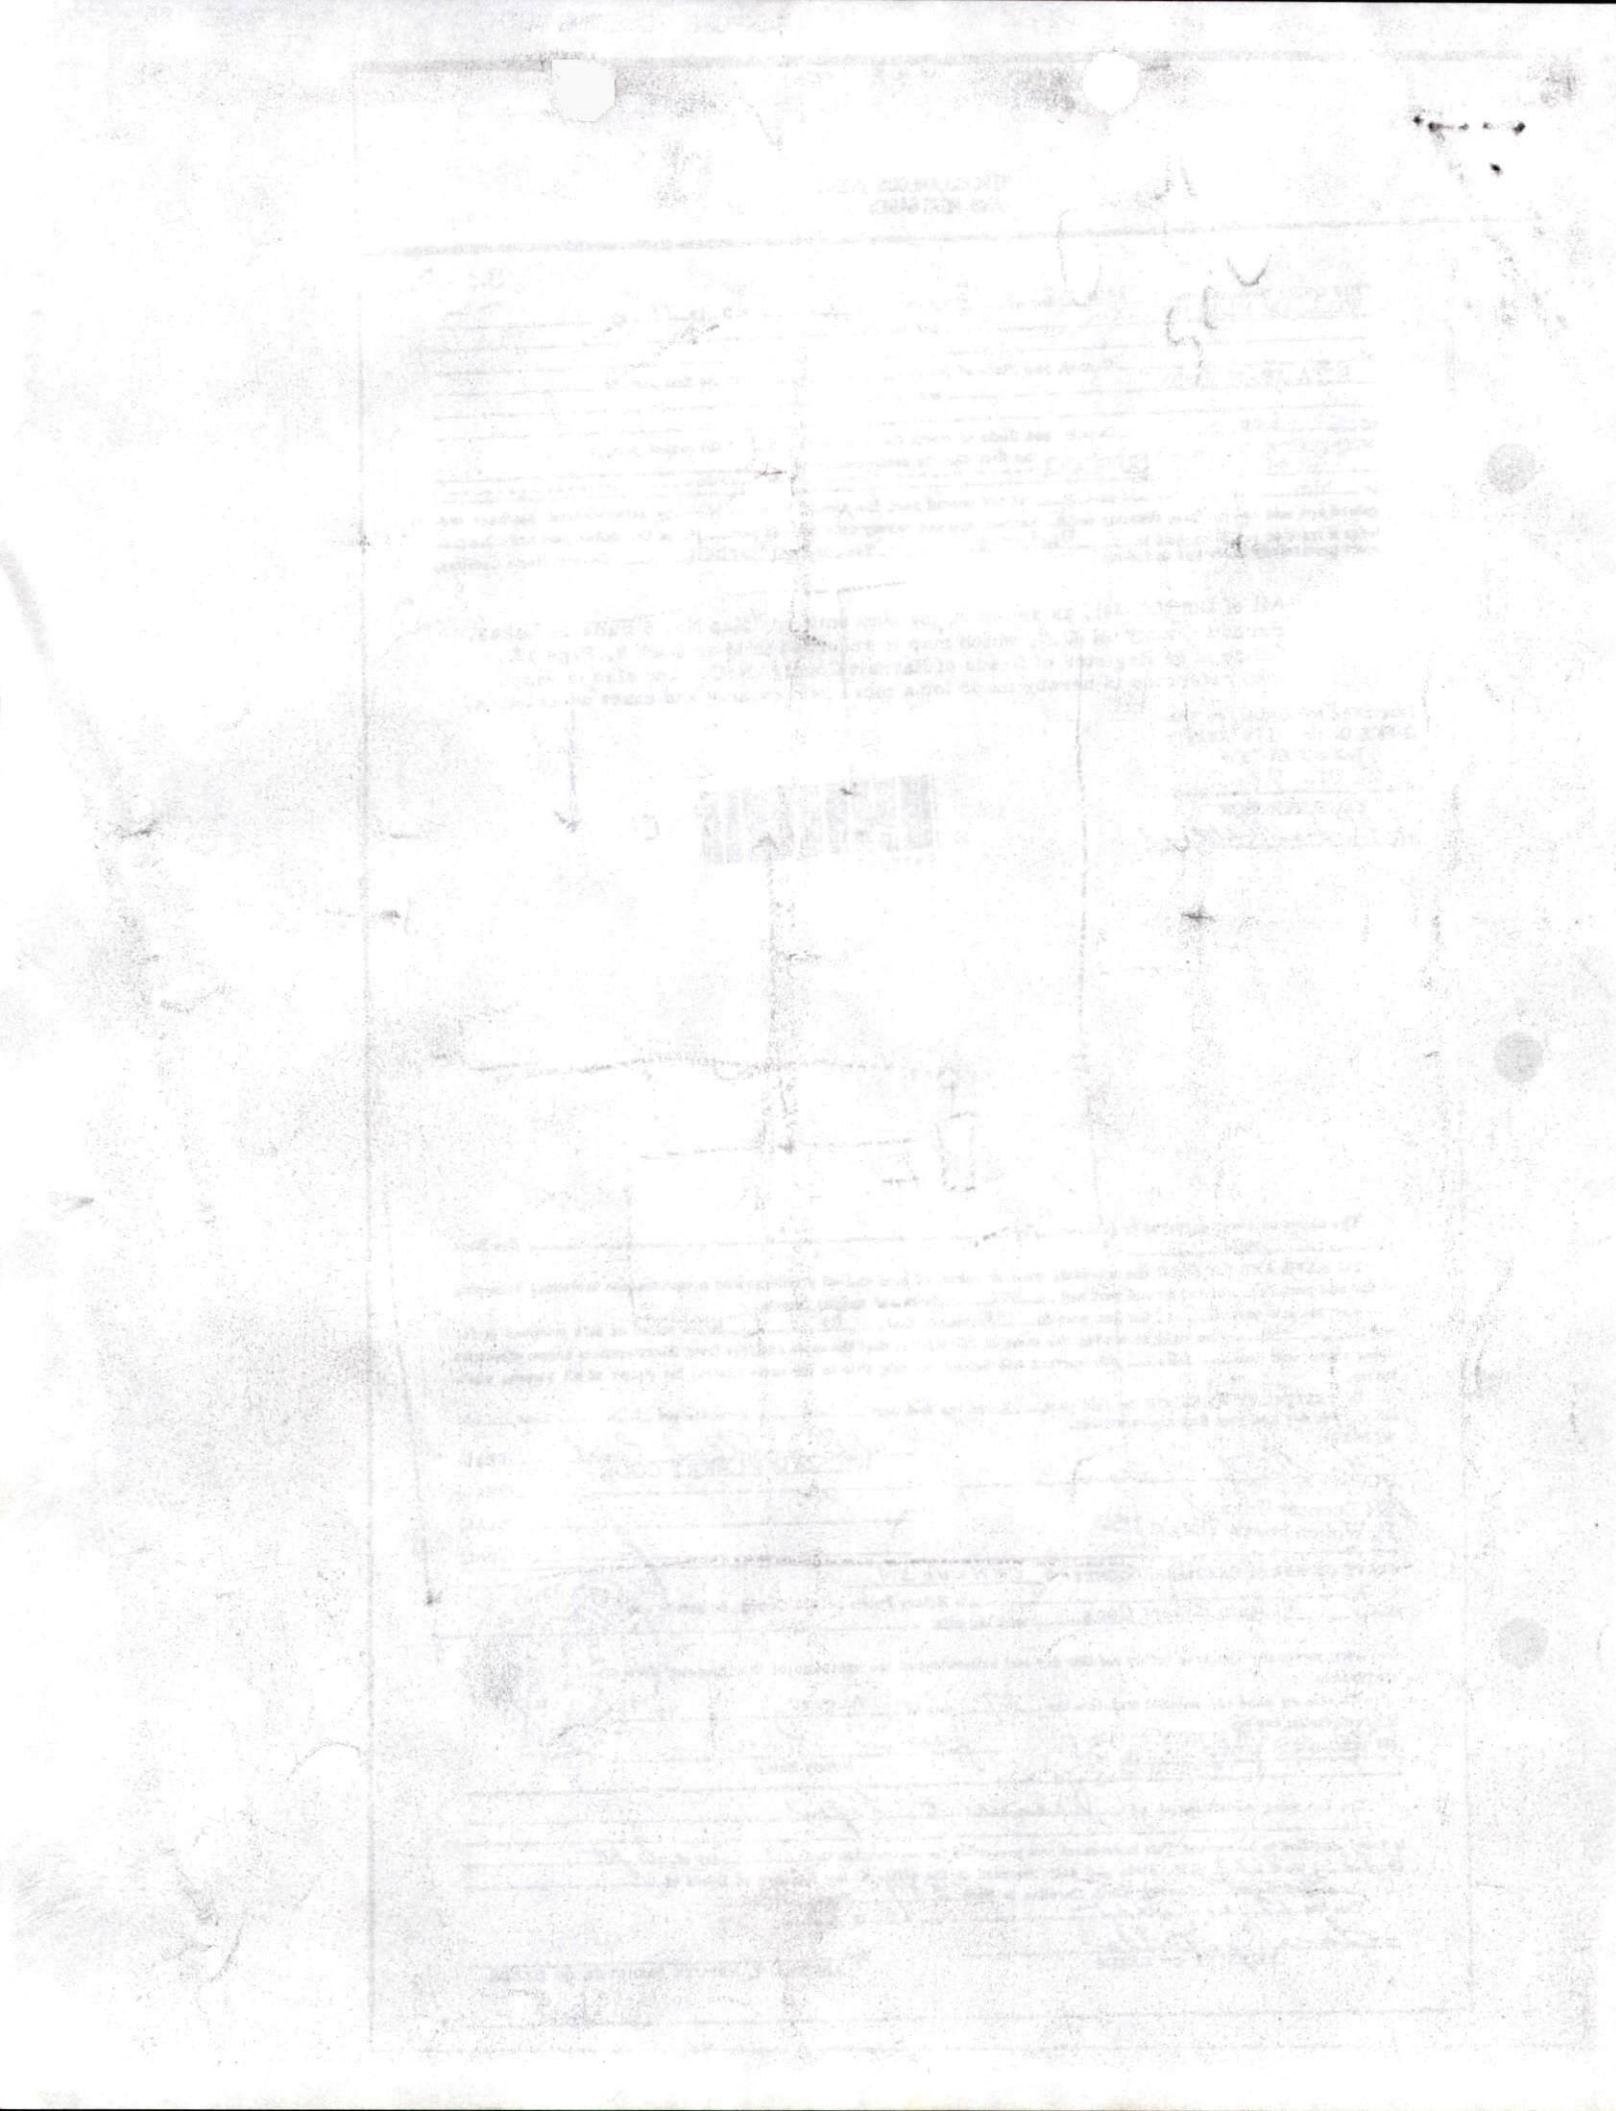

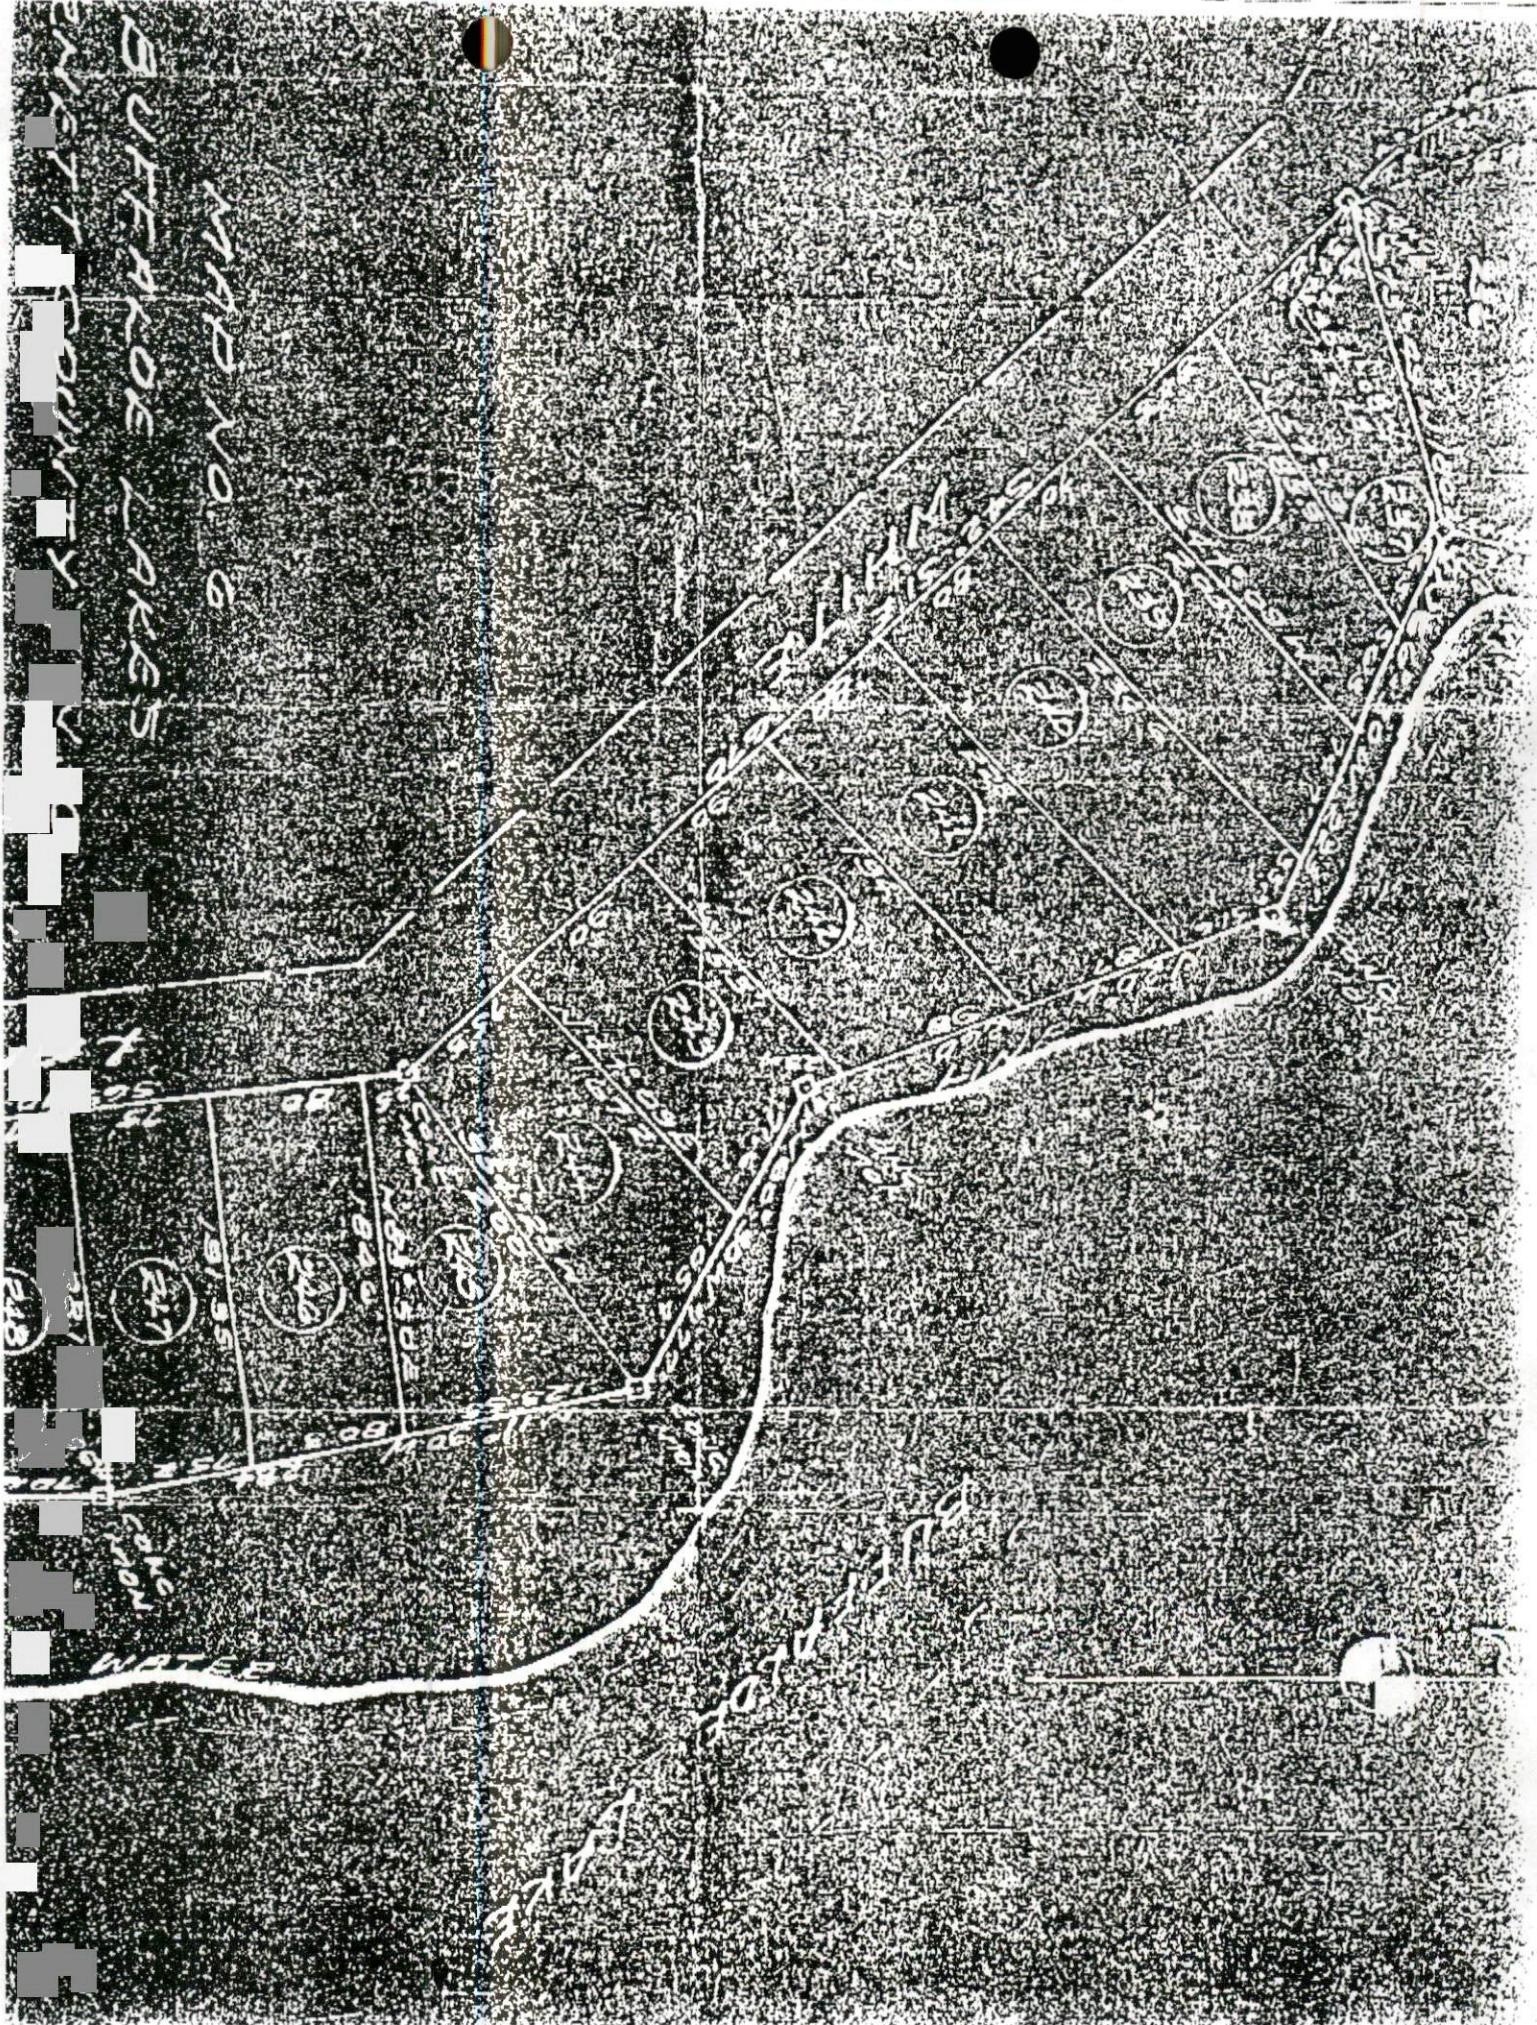

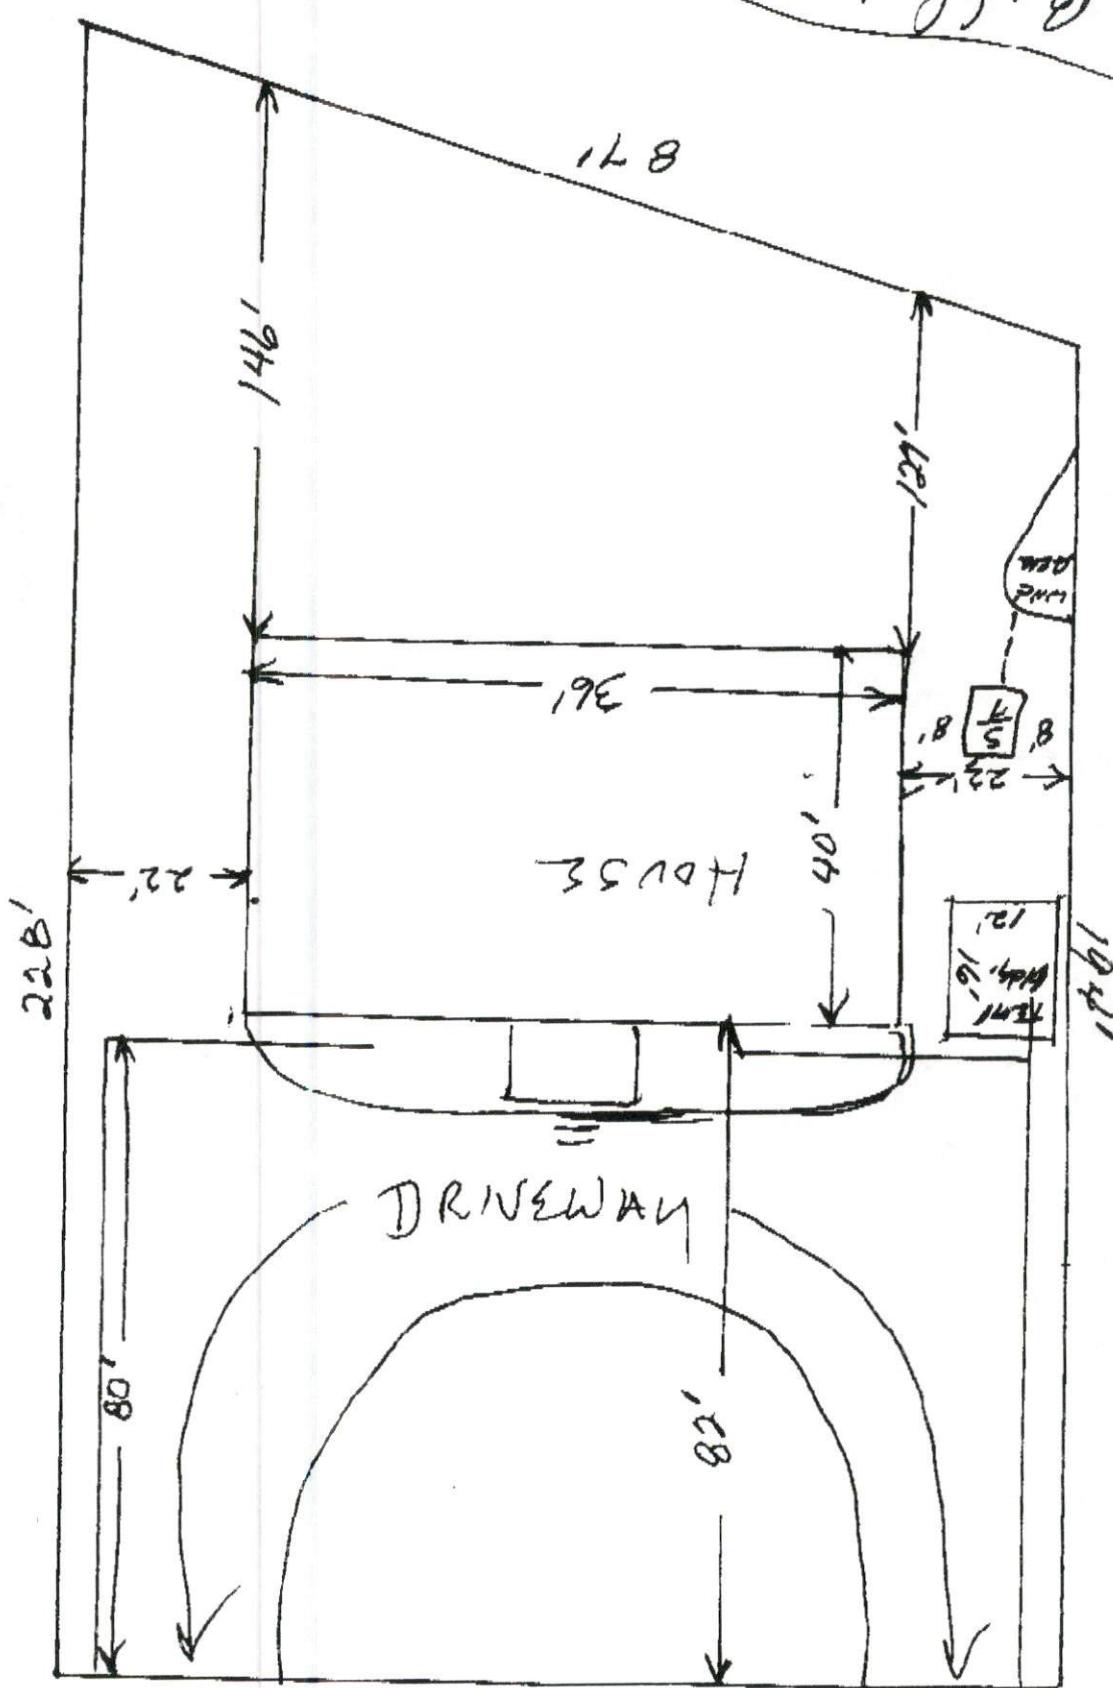


3287 0107 Bluffa 10
LOT # 341
BLK # 107
Sect to Scale



Mark or
Not
Det. for
5' from
PL

Lake

0.54
cuv

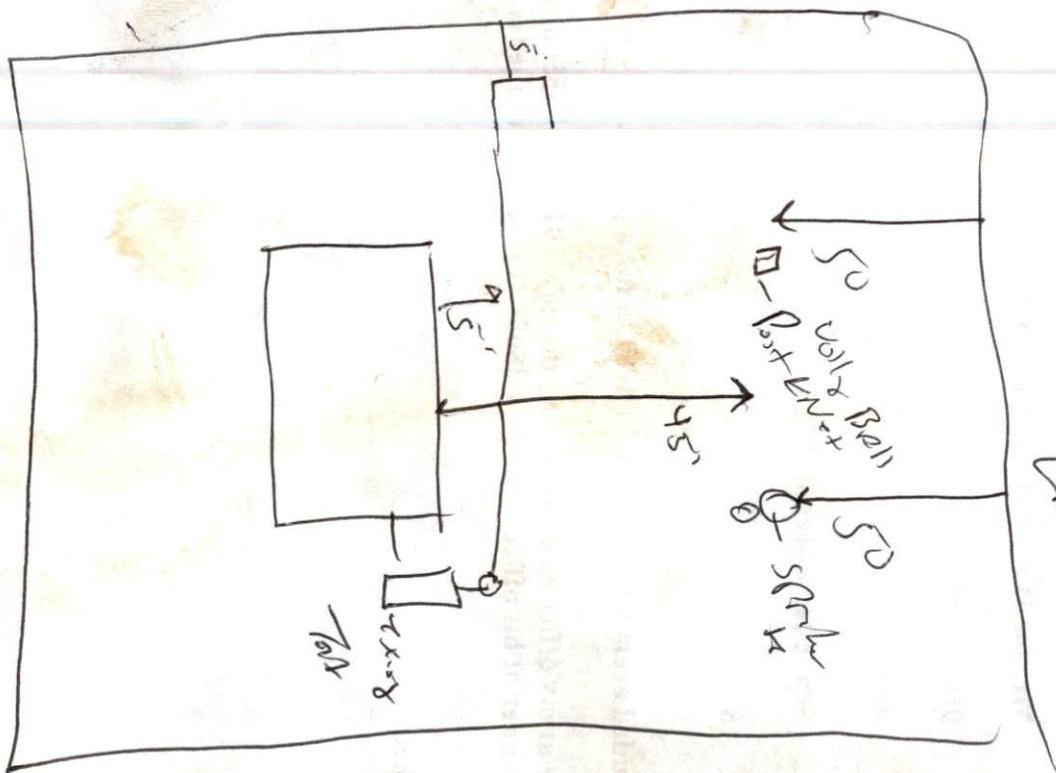

Gen contractor
List

~~1320
1250
1000
400
0~~

~~460
450
320
310
0~~