

Conf. 12-10-93

HARNETT COUNTY HEALTH DEPARTMENT
ENVIRONMENTAL HEALTH SECTION, PO BOX 09, LILINGTON, NC 893-7547
APPLICATION FOR IMPROVEMENT PERMIT

DATE 9/6/93

NAME LENA FIRSOVS TELEPHONE NO. 499-6344

ADDRESS (current) Route #1, Box 546, Broadway, N.C.

PROPERTY OWNER LENA FIRSOVS

SUBDIVISION NAME _____ LOT NO. _____

PROPERTY ADDRESS SAME AS ABOVE (Buie Road) STATE ROAD NO. 1213

DO YOU HAVE A LEGAL DEED TO THIS PROPERTY? YES _____ IF NO _____
PLEASE SHOW A PURCHASE AGREEMENT OR AUTHORIZATION OF AUTHORITY
IF NO EXPLAIN _____

DIRECTIONS Barbecue Church area

Highway 27 - First Road on right after W.
Harnett School. Cross Creek Bridge 1st house on left

SIZE OF LOT OR TRACT 1.01 acres

1. Type of dwelling double wide Basement with plumbing _____
2. Number of Bedrooms 3 Garage _____
3. Dishwasher _____
4. Garbage Disposal _____

WATER SUPPLY - PRIVATE WELL ☒ COMMUNITY SYSTEM ☐ COUNTY ☒
Owner represented Private Well sited during consultative visit 5-2-94

A plot plan must be attached to this application showing: 1) Setting of dwelling, 2) Desired placement of septic tank system and 3) well placement.

Place stakes at the exact location of dwelling and at each corner of lot.

An on site inspection must be made, which consists of a soil evaluation.

A zoning permit must be obtained from the Planning Department before an improvement permit can be issued by this department.


This certifies that all the above information is correct to the best of my knowledge and any false information will result in the denial of permit. Once the permit is issued, the permit is good for a period of 5 years. The permit is subject to revocation if site plans or the intended use change.

Signature of Owner Lena Firsovs
Revised (3-93) or Authorized Agent ONLY.

THE FOREGOING CERTIFICATE
Graham, Notary of
 NOTARY PUBLIC (NOTARIES PUBLIC) IS/ARE CERTIFIED
 TO BE CORRECT. THIS INSTRUMENT WAS PRESENTED FOR
 REGISTRATION AND RECORDED IN THIS OFFICE AT
 BOOK 232 B PAGE 232 B
 THIS 2nd DAY OF December, 1998 AT
11:10 O'CLOCK a M.

Gasper P. Holder
 REGISTER OF DEEDS - ASST. DEPUTY
By: 2nd C. Smith

I, MELVIN A. GRAHAM, CEN
 WAS DRAWN UNDER MY SUPERVISION;
 ACTUAL SURVEY MADE UNDER
 (DEED DESCRIPTION RECORDED IN BOOK 232 B
 PAGE 232 B) THAT BOUNDARIES NOT SURVEYED
 ARE SHOWN AS BROKEN LINES AND DRAWN FROM
 DEEDS AS INDICATED; THAT THE RATIO OF
 PRECISION AS CALCULATED IS 1 : 2500
 THAT THIS PLAT WAS PREPARED IN ACCORDANCE
 WITH G.S. 47-30 AS AMENDED. WITNESS MY
 ORIGINAL SIGNATURE, REGISTRATION NUMBER
 AND SEAL THIS 23 DAY OF SEP
 A.D. 1998 L-3471
Melvin A. Graham
 SURVEYOR REGISTRATION NO. 1-3471
 STATE OF NORTH CAROLINA, COUNTY OF KEE
 I, A NOTARY PUBLIC OF THE COUNTY AND
 STATE AFORESAID, CERTIFY THAT MELVIN A.
 GRAHAM, A REGISTERED LAND SURVEYOR,
 PERSONALLY APPEARED BEFORE ME THIS DAY AND
 ACKNOWLEDGED THE EXECUTION OF THE FORE-
 GOING INSTRUMENT. WITNESS MY HAND AND
 OFFICIAL STAMP OR SEAL, THIS 23
 DAY OF SEP, 1998
Melvin A. Graham MY COMMISSION EXP. 02/03/97
 NOTARY PUBLIC

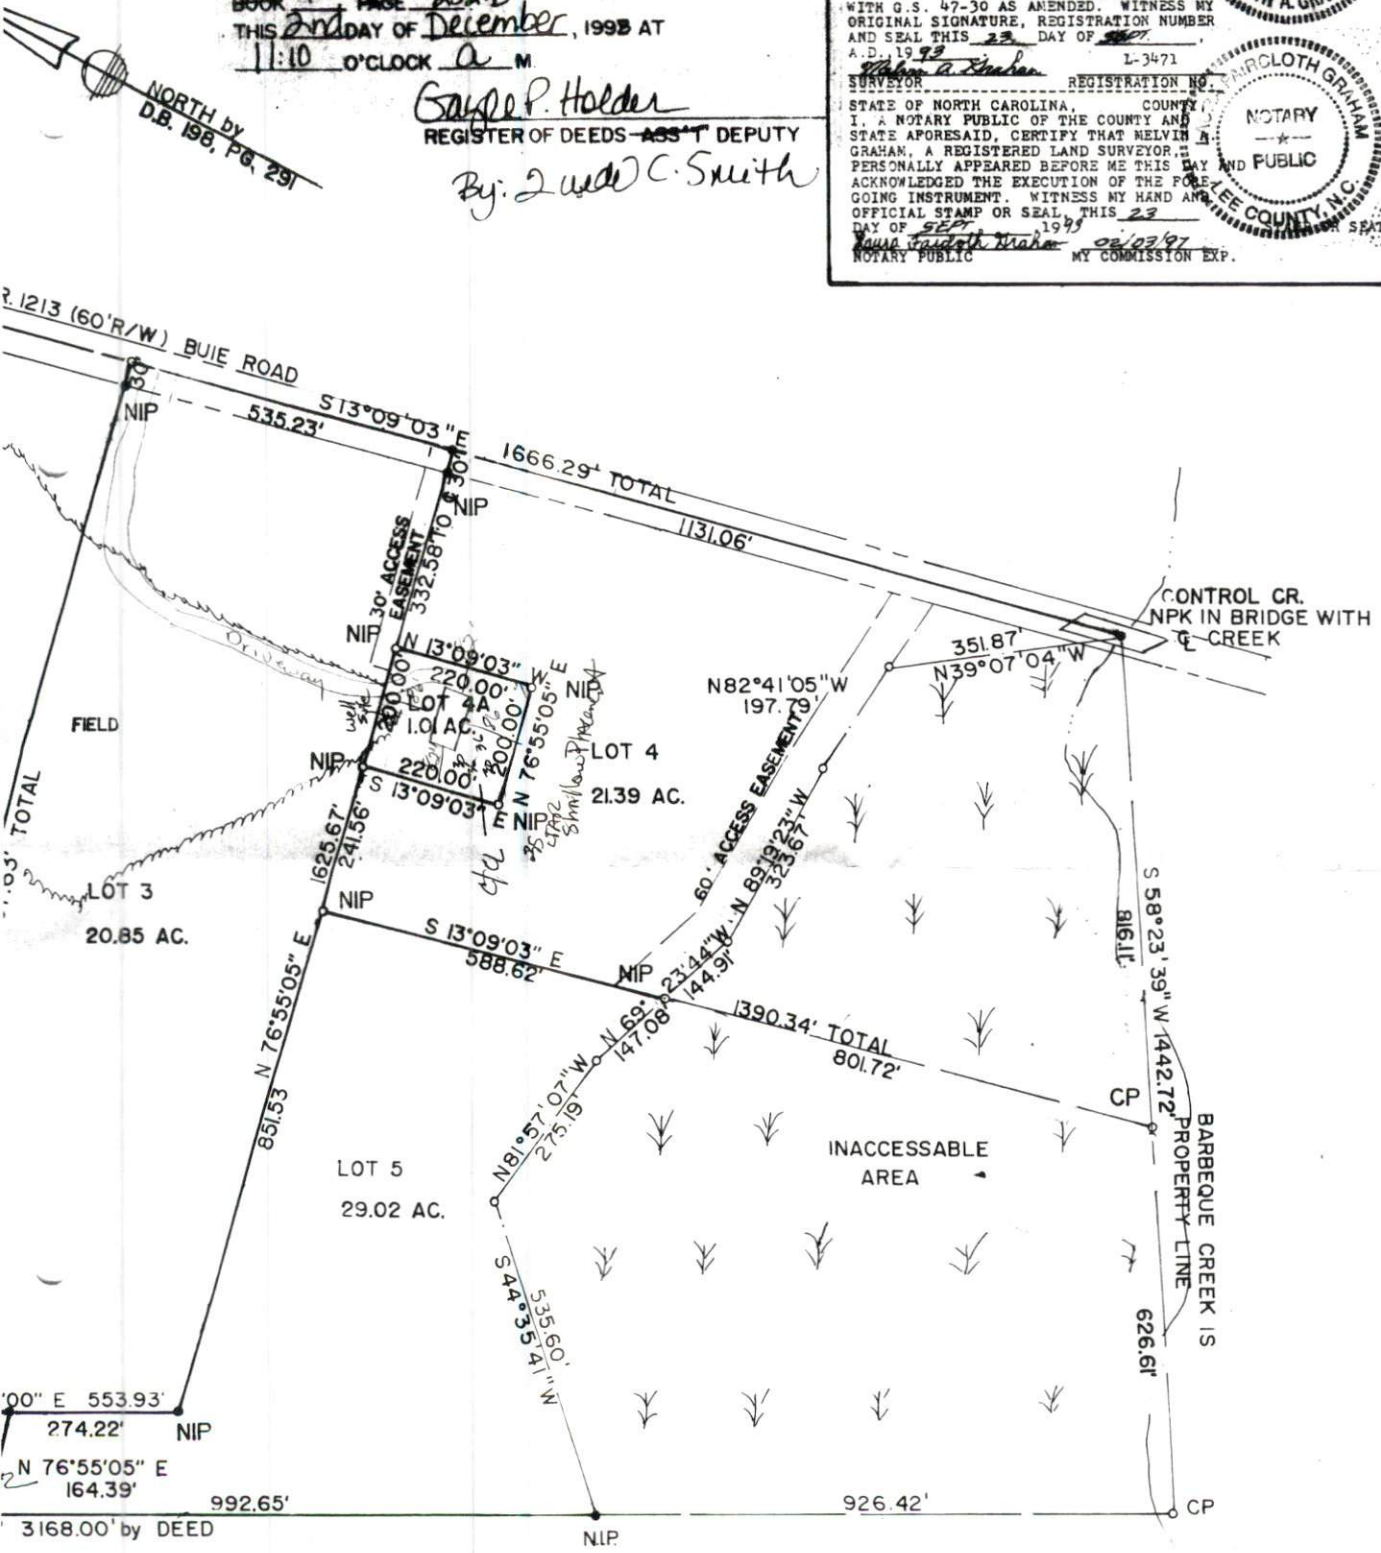

CHALMERS HEIRS
 212/475
 D. HAIR
 COUNTY.
 12/93
 ANNER

TOWNSHIP: BARBEQUE	COUNTY: HARNETT	STATE: N.C.	0' 100' 200' 400' 600'
LEGEND: EIP - EXISTING IRON PIPE NIP - NEW IRON PIPE ERRS-EXISTING RAILROAD SPIKE NRRS-NEW RAILROAD SPIKE PP-POWER POLE CP-CALCULATED POINT LP-LIGHT POLE E-ELECTRICITY		SURVEY FOR CURTIS HAIR ESTATE RT. 1, BROADWAY, N.C.	
		DATE: 09/24/93	SCALE: 1" = 200'
		PROJECT:	