

HARNETT CO. HEALTH DEPARTMENT
ENVIRONMENTAL HEALTH SECTION
307 CORNELIUS HARNETT BLVD. LILLINGTON NC 27546
APPLICATION FOR REPAIR

Work Copy

DATE 1-14-80
NAME Mattie Ruth Jones TELEPHONE 919 639-3506
ADDRESS P.O. Box 84 Angier - NC-27501
PROPERTY OWNER Mattie Ruth Jones
SUBDIVISION NAME _____ LOT NO. _____
STATE ROAD NAME 421 Owens Rd STATE RD. NO. _____
SIZE OF LOT OR TRACT 3-7 ac
DIRECTIONS go to blinking light on 55 going or coming
from Angier or coming from Coats turn left from Coats
go to next road turn right 5 trails on Right
Coming from Angier turn left right first road on Right 5
TYPE OF DWELLING _____ BASEMENT WITH PLUMBING _____
NUMBER OF BEDROOMS _____ GARAGE _____
DISHWASHER _____ GARBAGE DISPOSAL _____
WATER SUPPLY: PRIVATE WELL _____ COMMUNITY SYSTEM _____ COUNTY ✓

INSTRUCTIONS

1. A surveyed and recorded map and deed must be attached to this application along with a site plan showing:
1) Location of dwelling 2) Location of driveway 3) Location of any wells and other existing structures.
2. The outlet end of the tank and distribution box will need to be uncovered and property lines marked. After the tank is uncovered and property lines are marked, you will need to call our office at 893-7547 or 893-7548 and let us know that it is ready.
3. The system must be repaired in the set time of the violation letter or if there is no violation letter, then the tank needs to be repaired within 30 days.

This certifies that all of the above information is correct to the best of my knowledge. False information will result in the denial of the permit. The permit is subject to revocation if the site plan, intended use, or ownership change.

Signature of Owner or
Authorized Agent ONLY

Mattie Ruth Jones

(N)

Installer of System _____

Septic Tank Installer _____

Designer of System _____

1. Number of people who live in the house one

How many adults one How many children _____

2. What is your average daily water usage? _____

3. Do you have a garbage disposal? NO

How often do you use it? _____

4. When was the septic tank last pumped? last summer

How often do you have it pumped? 2nd time since 1986

5. Do you have a dishwashing machine? yes

How often do you use it? _____

6. Do you have a clothes washing machine? ✓

How often do you use it? twice week

7. Do you have a water softener or water treatment system? _____

Where does it drain? _____

8. Do you use an "in the tank" toilet bowl sanitizer? _____

9. Is any family member using a (long term) prescription drug, antibiotics or chemotherapy? NO

What kinds? _____


10. Are any chemicals (paints, thinners, etc.) disposed of down the drain? NO

What kinds? _____


11. Have any new water using fixtures been added since the system was installed? dish washer

What kinds? _____

12. List plumbing fixtures (spas, whirlpools, etc.) other than sinks, lavatories, bath/showers and toilets:
Washer & dryer Dish washer
13. Do you have any underground lawn-watering system? NO
14. Has any site work been done to the house since you moved in, such as underground roof gutter drain, basement/foundation drains, landscaping, etc.? NO
 What kinds? Ten roof
15. Are there any underground utilities on your lot? NO
 Power ✓ Phone Cable Gas ✓ Water ✓
16. Describe what happens when you have a problem with your septic tank system.
A truck got stuck and tore up a leader line
but it is wet in the back yard
its rained a lot.
17. When did you first notice the problem? April it used to be another
trailer was to be on my land on another
tank it was moved ~~into~~ Feb or March
18. Does the problem seem to be linked to a specific event (washing clothes, heavy rains, company coming over, etc?)
heavy rain

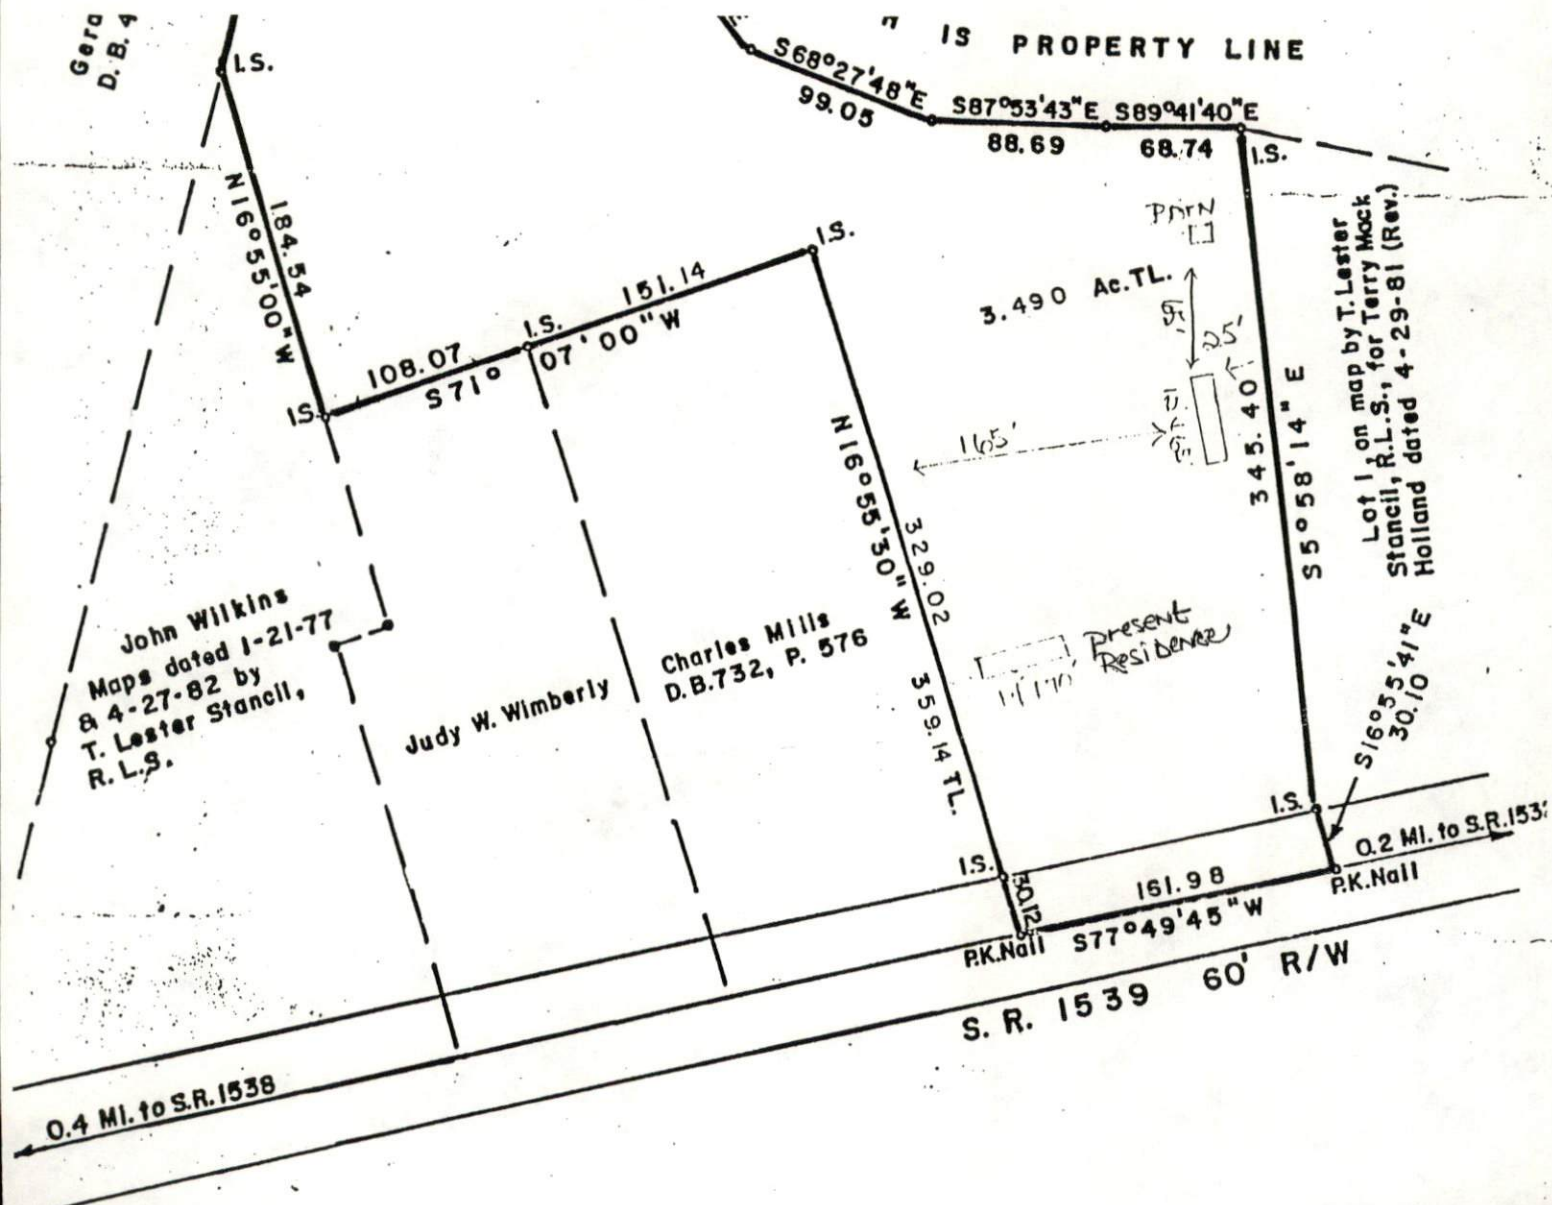

Thomas L. Stancil certify that this
 map was drawn from ~~(actual survey made by me)~~ deed
 description recorded in Book _____, Page _____, Book
 _____, Page _____, (other); that the error of closure as
 indicated by latitudes and departures is 1: _____, that the

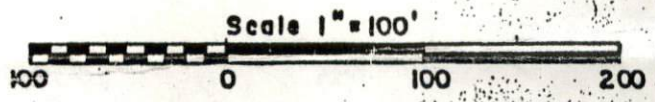

Mapped For
FRED SMITH