

HARNETT COUNTY HEALTH DEPARTMENT

ENVIRONMENTAL HEALTH SECTION

307 W. CORNELIUS HARNETT BLVD.

LILLINGTON, NC 27546

910-893-7547 PHONE

910-893-9371 FAX

Call - dogs to be locked up

Gerald Temple Tank damaged needs replacing

Application for Repair

1965 dwelling

EMAIL ADDRESS: _____

NAME Bonnie H Lewis PHONE NUMBER 919 820 1381

PHYSICAL ADDRESS 402 Gainey Rd - Dunn, 28334 (mail to:)

MAILING ADDRESS (IF DIFFERENT THAN PHYSICAL) Same (I95 Exit 70) 400 Gainey Rd Dunn, NC

IF RENTING, LEASING, ETC., LIST PROPERTY OWNER NAME _____

This is a Rental House (Brotherlaw)

SUBDIVISION NAME LOT #/TRACT # STATE RD/HWY SIZE OF LOT/TRACT

Type of Dwelling: Modular Mobile Home Stick built Other _____

Number of bedrooms 2 Basement

Garage: Yes No Dishwasher: Yes No Garbage Disposal: Yes No

Water Supply: Private Well Community System County

Directions from Lillington to your site: I95 South Exit 70 - come across in front of old Cafe Risque that's Gainey Rd, 1st two brick houses on right - (Red Bains) (Home furthest back)

In order for Environmental Health to help you with your repair, you will need to comply by completing the following:

1. A "surveyed and recorded map" and "deed to your property" must be attached to this application. Please inform us of any wells on the property by showing on your survey map.
2. The outlet end of the tank and the distribution box will need to be uncovered and property lines flagged. After the tank is uncovered, property lines flagged, underground utilities marked, and the orange sign has been placed, you will need to call us at 910-893-7547 to confirm that your site is ready for evaluation.

Your system must be repaired within 30 days of issuance of the Improvement Permit or the time set within receipt of a violation letter. (Whichever is applicable.)

By signing below, I certify that all of the above information is correct to the best of my knowledge. False information will result in the denial of the permit. The permit is subject to revocation if the site plan, intended use, or ownership changes.

Bonnie H Lewis 10-11-13
Signature Date

10/17/13
N

HOMEOWNER INTERVIEW FORM

It is important that you answer the following questions for our inspectors. Please do not leave any blanks if possible, and answer all questions to the best of your ability. Thank You.

Have you received a violation letter for a failing system from our office? YES NO

Also, within the last 5 years have you completed an application for repair for this site? YES NO

Year home was built (or year of septic tank installation) 19

Installer of system _____

Septic Tank Pumper _____

Designer of System septic Tank with Lines

1. Number of people who live in house? 1 # adults — # children 1 # total

2. What is your average estimated daily water usage? _____ gallons/month or day county water. If HCPU please give the name the bill is listed in also use water at the Barn

3. If you have a garbage disposal, how often is it used? daily weekly monthly

4. When was the septic tank last pumped? _____ How often do you have it pumped? never

5. If you have a dishwasher, how often do you use it? daily every other day weekly

6. If you have a washing machine, how often do you use it? daily every other day weekly monthly

7. Do you have a water softener or treatment system? YES NO Where does it drain? _____

8. Do you use an "in tank" toilet bowl sanitizer? YES NO

9. Are you or any member in your household using long term prescription drugs, antibiotics or chemotherapy? YES NO If yes please list _____

10. Do you put household cleaning chemicals down the drain? YES NO If so, what kind?

Soft scrub - maybe comet Bathroom

11. Have you put any chemicals (paints, thinners, etc.) down the drain? YES NO

12. Have you installed any water fixtures since your system has been installed? YES NO If yes, please list any additions including any spas, whirlpool, sinks, lavatories, bath/showers, toilets _____

13. Do you have an underground lawn watering system? YES NO

14. Has any work been done to your structure since the initial move into your home such as, a roof, gutter drains, basement foundation drains, landscaping, etc? If yes, please list gutter on front of house

15. Are there any underground utilities on your lot? Please check all that apply:

Power Phone Cable Gas Water


16. Describe what is happening when you are having problems with your septic system, and when was this first noticed?

No Trouble - TANK BAN OVER

17. Do you notice the problem as being patterned or linked to a specific event (i.e., wash clothes, heavy rains, and household guests?) YES NO If Yes, please list _____

not yet

Deed Reference	
Book	40
"	50
"	35
"	35

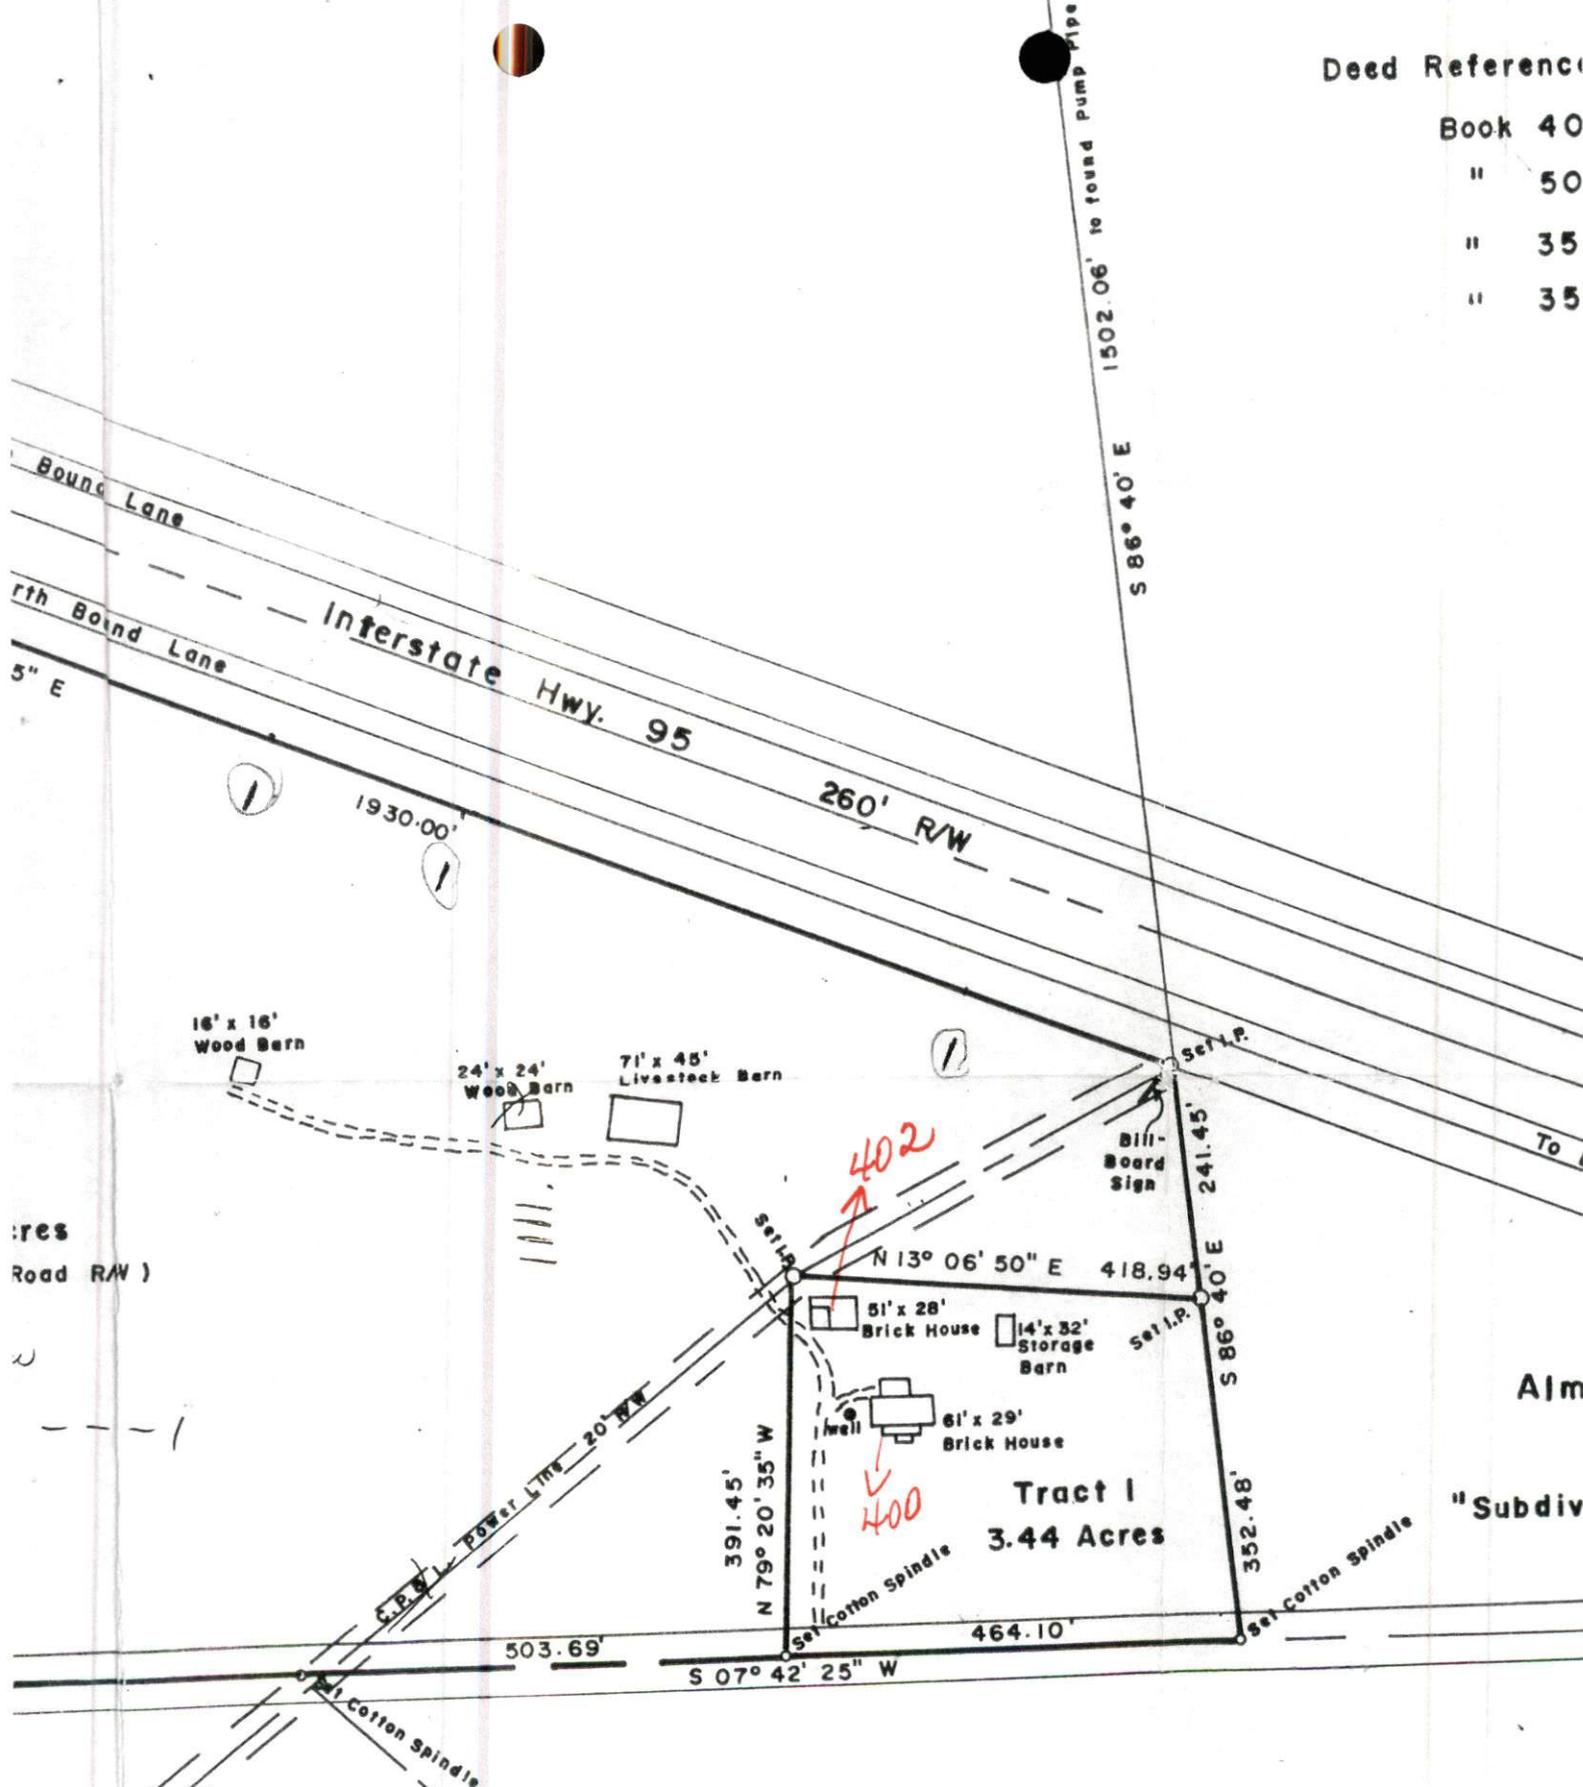

T. H. Johnson, Jr.
 Piedmont Surveying Co.
 Sept., 1972

PROPERTY OF:
KENNETH LE

(1)
 erland Co.