

HARNETT COUNTY HEALTH DEPARTMENT
ENVIRONMENTAL HEALTH SECTION
307 W. CORNELIUS HARNETT BLVD.
LILLINGTON, NC 27546
910-893-7547 PHONE
910-893-9371 FAX

Application for Repair

Please call Joe prior to
visit. He would like an hour
notice so he can
meet on site.

FAX TO

919-782-1612

NAME Joe Stewart EMAIL ADDRESS: _____
PHONE NUMBER 910-897-7465
919 524-5999
PHYSICAL ADDRESS 65 Violet Lane Coats NC 27521
MAILING ADDRESS (IF DIFFERENT THAN PHYSICAL) PO Box 280 Coats NC
IF RENTING, LEASING, ETC., LIST PROPERTY OWNER NAME _____

SUBDIVISION NAME DreamLand LOT #/TRACT # 3 STATE RD/HWY _____ SIZE OF LOT/TRACT _____

Type of Dwelling: ☐ Modular ☐ Mobile Home ☒ Stick built ☐ Other _____

Number of bedrooms 4 ☐ Basement

Garage: Yes ☐ No ☐

Dishwasher: Yes ☒ No ☐

Garbage Disposal: Yes ☒ No ☐

Water Supply: ☒ Private Well

☐ Community System

☐ County

Directions from Lillington to your site: Hwy 27 towards Coats Left on
Bill Avery Rd About 1 1/2 miles Right onto Violet Lane
2nd House on Left

In order for Environmental Health to help you with your repair, you will need to comply by completing the following:

1. A "surveyed and recorded map" and "deed to your property" must be attached to this application. Please inform us of any wells on the property by showing on your survey map.
2. The outlet end of the tank and the distribution box will need to be uncovered and property lines flagged. After the tank is uncovered, property lines flagged, underground utilities marked, and the orange sign has been placed, you will need to call us at 910-893-7547 to confirm that your site is ready for evaluation.

Your system must be repaired within 30 days of issuance of the Improvement Permit or the time set within receipt of a violation letter. (Whichever is applicable.)

By signing below, I certify that all of the above information is correct to the best of my knowledge. False information will result in the denial of the permit. The permit is subject to revocation if the site plan, intended use, or ownership changes.

Joe Stewart
Signature

2-22-2011
Date

2/23/11
N



HOMEOWNER INTERVIEW FORM

It is important that you answer the following questions for our inspectors. Please do not leave any blanks if possible, and answer all questions to the best of your ability. Thank You.

Have you received a violation letter for a failing system from our office? ☐ YES ☒ NO
Also, within the last 5 years have you completed an application for repair for this site? ☐ YES ☒ NO

Year home was built (or year of septic tank installation) 19
Installer of system _____
Septic Tank Pumper _____
Designer of System _____

1. Number of people who live in house? 3 # adults 0 # children 3 # total
2. What is your average estimated daily water usage? 40 gallons/month or day _____ county water. If HCPU please give the name the bill is listed in _____
3. If you have a garbage disposal, how often is it used? ☐ daily ☐ weekly ☐ monthly NO
4. When was the septic tank last pumped? 2010 How often do you have it pumped? 2yr
5. If you have a dishwasher, how often do you use it? ☐ daily ☐ every other day ☒ weekly
6. If you have a washing machine, how often do you use it? ☐ daily ☒ every other day ☐ weekly ☐ monthly
7. Do you have a water softener or treatment system? ☐ YES ☒ NO Where does it drain? _____
8. Do you use an "in tank" toilet bowl sanitizer? ☐ YES ☒ NO
9. Are you or any member in your household using long term prescription drugs, antibiotics or chemotherapy? ☐ YES ☒ NO If yes please list _____
10. Do you put household cleaning chemicals down the drain? ☐ YES ☒ NO If so, what kind? _____
11. Have you put any chemicals (paints, thinners, etc.) down the drain? ☐ YES ☒ NO
12. Have you installed any water fixtures since your system has been installed? ☐ YES ☒ NO If yes, please list any additions including any spas, whirlpool, sinks, lavatories, bath/showers, toilets _____
13. Do you have an underground lawn watering system? ☐ YES ☒ NO
14. Has any work been done to your structure since the initial move into your home such as, a roof, gutter drains, basement foundation drains, landscaping, etc? If yes, please list Gutter on Back
15. Are there any underground utilities on your lot? Please check all that apply:
☒ Power ☒ Phone ☒ Cable ☐ Gas ☒ Water
16. Describe what is happening when you are having problems with your septic system, and when was this first noticed?
D Box overflows some times
17. Do you notice the problem as being patterned or linked to a specific event (i.e., wash clothes, heavy rains, and household guests?) ☐ YES ☐ NO If Yes, please list RAIN

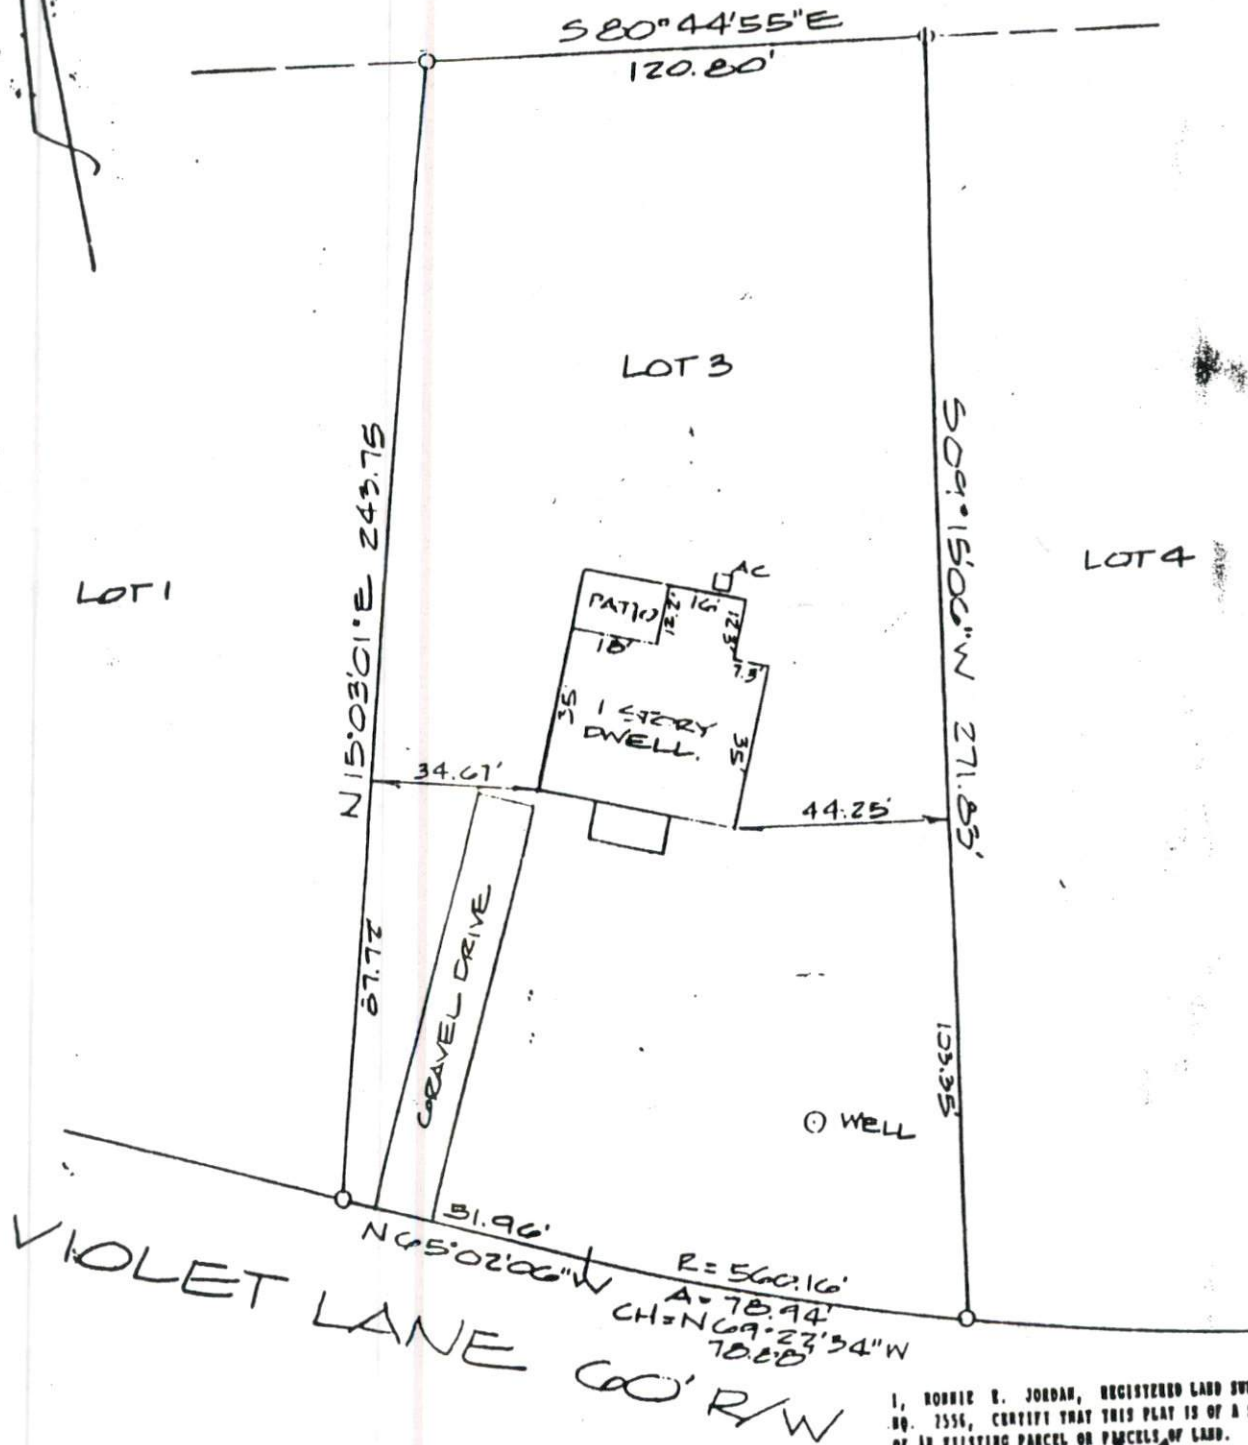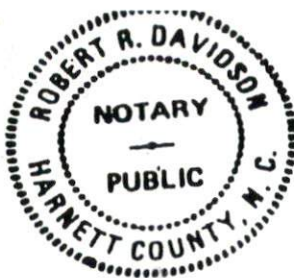

I, RONNIE E. JORDAN, REGISTERED LAND SURVEYOR NO. 2556, CERTIFY THAT THIS PLAT IS OF A SURVEY OF AN EXISTING PARCEL OR PARCELS OF LAND.

Ronnie E. Jordan

PEAMLAND, REVISION OF LOTS 1, 2, 3 & 4

SURVEY FOR
**EDWARD HAPONSKI &
Wife VIOLET HAPONSKI**

CITY OR TWSP. GROVE	COUNTY HARNETT
SCALE 1" = 40'	DATE 12-28-94

I, RONNIE E. JORDAN CERTIFY THAT THIS PLAT WAS DRAWN UNDER MY SUPERVISION FROM AN ACTUAL SURVEY MADE UNDER MY SUPERVISION (AND DESCRIPTION RECORDED IN BOOK 445, PAGE 67L, ETC.) (OTHER); THAT THE BOUNDARIES NOT SURVEYED ARE CLEARLY INDICATED AS BEING FROM INFORMATION FOUND IN BOOK , PAGE ; THAT THE DATE OF PRECISION AS CALCULATED IS 11-1-94; THAT THIS PLAT WAS PREPARED IN ACCORDANCE WITH G. S. 47-30 AS AMENDED, WITHOUT MY COUSIN'S SIGNATURE; REGISTRATION NUMBER AND SEAL THIS 28 DAY OF DEC., A.D., 19 94

Ronnie E. Jordan L-2556
SURVEYOR REGISTRATION NUMBER

B

A

