PHOTOVOLTAIC ROOF MOUNT SYSTEM

22 MODULES-ROOF MOUNTED -{8.690 kW DC, 7.600 kW AC } 3495 RAWLS CHURCH RD, FUQUAY-VARINA, NC 27526

PROJECT DATA

PROJECT ADDRESS

3495 RAWLS CHURCH RD. FUQUAY-VARINA, NC 27526

OWNER:

STEPHEN REGISTER

DESIGNER: ESR

SCOPE(8.690 KW DC ROOF MOUNT SOLAR PV SYSTEM WITH

22 MISSION SOLAR: MSE395SX9R 395W

PV MODULES WITH

22 SOLAREDGE: S440 POWER OPTIMIZERS AND (01 SOLAREDGE: SE76000H-US (240V) INVERTER

AUTHORITIES HAVING JURISDICTION:

BUILDING: HARNETT COUNTY ZONING: HARNETT COUNTY UTILITY: DUKE ENERGY PROGRESS

SHEET INDEX

PV-1 **COVER SHEET** PV-2 SITE PLAN

PV-3 **ROOF PLAN & MODULES**

PV-4 **ELECTRICAL PLAN** PV-5 STRUCTURAL DETAIL PV-6 **ELECTRICAL LINE DIAGRAM**

PV-7 WIRING CALCULATIONS

PV-8 LABFLS

PV-9+ **EQUIPMENT SPECIFICATIONS**

SIGNATURE

GENERAL NOTES

- ALL COMPONENTS ARE UL LISTED AND CEC CERTIFIED, WHERE WARRANTED
- THE SOLAR PV SYSTEM WILL BE INSTALLED IN ACCORDANCE WITH ARTICLE 690 OF THE NEC 2017.
- THE UTILITY INTERCONNECTION APPLICATION MUST BE APPROVED AND PV SYSTEM INSPECTED PRIOR TO PARALLEL OPERATION.
- ALL CONDUCTORS OF A CIRCUIT, INCLUDING THE EGC, MUST BE INSTALLED IN THE SAME RACEWAY, OR CABLE, OR OTHERWISE RUN WITH THE PV ARRAY CIRCUIT CONDUCTORS WHEN THEY LEAVE THE VICINITY OF THE PV ARRAY.
- WHERE METALLIC CONDUIT CONTAINING DC CONDUCTORS IS USED INSIDE THE BUILDING. IT SHALL BE IDENTIFIED AS "CAUTION: SOLAR CIRCUIT" EVERY 10FT.
- HEIGHT OF THE AC DISCONNECT SHALL NOT EXCEED 6'-7" PER NEC CODE 240.24.
- A GROUNDING ELECTRODE SYSTEM IN ACCORDANCE WITH CEC 690.47 AND 250.50 THROUGH 60 AND 250-166 SHALL BE PROVIDED. PER NEC GROUNDING ELECTRODE SYSTEM OF EXISTING BUILDING MAY BE USED AND BONDED TO THE SERVICE ENTRANCE. IF EXISTING SYSTEM IS INACCESSIBLE OR INADEQUATE A SUPPLEMENTAL GROUNDING ELECTRODE WILL BE USED AT THE INVERTER LOCATION CONSISTING OF A UL LISTED 8 FT. GROUND ROD WITH ACORN CLAMP. GROUNDING ELECTRODE CONDUCTORS SHALL BE NO LESS THAN #8 AWG AND NO LARGER THAN #6 AWG COPPER AND BONDED TO THE EXISTING GROUNDING ELECTRODE TO PROVIDE FOR A COMPLETE SYSTEM.
- PHOTOVOLTAIC MODULES ARE TO BE CONSIDERED NON-COMBUSTIBLE
- PHOTOVOLTAIC INSTALLATION WILL NOT OBSTRUCT ANY PLUMBING. MECHANICAL, OR BUILDING ROOF VENTS.
- 10. ALL WIRING MUST BE PROPERLY SUPPORTED BY DEVICES OR MECHANICAL MEANS DESIGNED AND LISTED FOR SUCH USE. WIRING MUST BE PERMANENTLY AND COMPLETELY HELD OFF THE ROOF SURFACE.
- ALL SINAGE TO BE PLACED IN ACCORDANCE WITH THE LOCAL BUILDING CODE. IF EXPOSED TO SUNLIGHT, IT SHALL BE UV RESISTANT, ALL PLAQUES AND SINAGE WILL BE INSTALLED AS REQUIRED BY THE NEC AND AHJ.
- 12. INVERTER(S) USED IN UNGROUNDED SYSTEM SHALL BE UL 1741 LISTED.
- 13. THE INSTALLATION OF EQUIPMENT AND ALL ASSOCIATED WIRING AND INTERCONNECTION SHALL BE PERFORMED ONLY BY QUALIFIED PERSONS [NEC 690.4(C)]
- 14. ALL OUTDOOR EQUIPMENT SHALL BE NEMA 3R RATED (OR BETTER), INCLUDING ALL ROOF MOUNTED TRANSITION BOXES AND
- 15. ALL EQUIPMENT SHALL BE PROPERLY GROUNDED AND BONDED IN ACCORDANCE WITH NEC ARTICLE 250.
- 16. SYSTEM GROUNDING SHALL BE IN ACCORDANCE WITH NEC 690.41.
- 17. PV SYSTEM CIRCUITS INSTALLED ON OR IN BUILDINGS SHALL INCLUDE A RAPID SHUTDOWN FUNCTION IN ACCORDANCE WITH NEC 690.12
- 18. DISCONNECTING MEANS SHALL BE LOCATED IN A VISIBLE, READILY ACCESSIBLE LOCATION WITHIN THE PV SYSTEM EQUIPMENT OR A MAXIMUM OF 10 FEET AWAY FROM THE SYSTEM [NEC 690.13(A)]
- 19. ALL WIRING METHODS SHALL BE IN ACCORDANCE WITH NEC 690.31
- 20. WORK CLEARANCES AROUND ELECTRICAL EQUIPMENT WILL BE MAINTAINED PER NEC 110.26(A)(1), 110.26(A)(2) AND 110.26(A)(3).
- 21. ROOFTOP MOUNTED PHOTOVOLTAIC PANELS AND MODULES SHALL BE TESTED, LISTED & IDENTIFIED IN ACCORDANCE WITH
- 22. ELECTRICAL CONTRACTOR TO PROVIDE CONDUIT EXPANSION JOINTS AND ANCHOR CONDUIT RUNS AS REQUIRED PER NEC.

VICINITY MAP



HOUSE PHOTO



CODE REFERENCES

2018 NORTH CAROLINA BUILDING CODE 2018 NORTH CAROLINA RESIDENTIAL CODE 2018 NORTH CAROLINA FIRE CODE 2017 NATIONAL ELECTRICAL CODE

> THIS PLAN HAS BEEN ELECTRONICALLY SIGNED AND SEALED BY SCOTT WYSSLING, PE USING A DIGITAL SIGNATURE AND DATE, PRINTED COPIES OF THIS DOCUMENT ARE NOT CONSIDERED SIGNED AND SEALED AND THE SIGNATURE MUST BE VERIFIED ON ANY ELECTRONIC COPIES

76 N Meadowbrook Drive Alpine UT 84004



DRAWN BY

EPHEN REGISTER RESIDENCE

TOP TIER SOLAR SOLUTIONS

1530 CENTER PARK DR #2911. CHARLOTTE, NC 28217, UNITED STATES

Wyssling Consulting, PLLC

North Carolina COA # P-2308

Signed 5/09/2023

PROJECT NAME & ADDRESS

3495 RAWLS CHURCH RD, FUQUAY-VARINA, NC 27526

04/26/2023

05/04/2023

DESCRIPTION

INITIAL DESIGN

SEPTIC & DRAIN FIELD ADD

ESR


SHEET NAME

COVER SHEET

SHEET SIZE **ANSI B**

11" X 17"

SHEET NUMBER

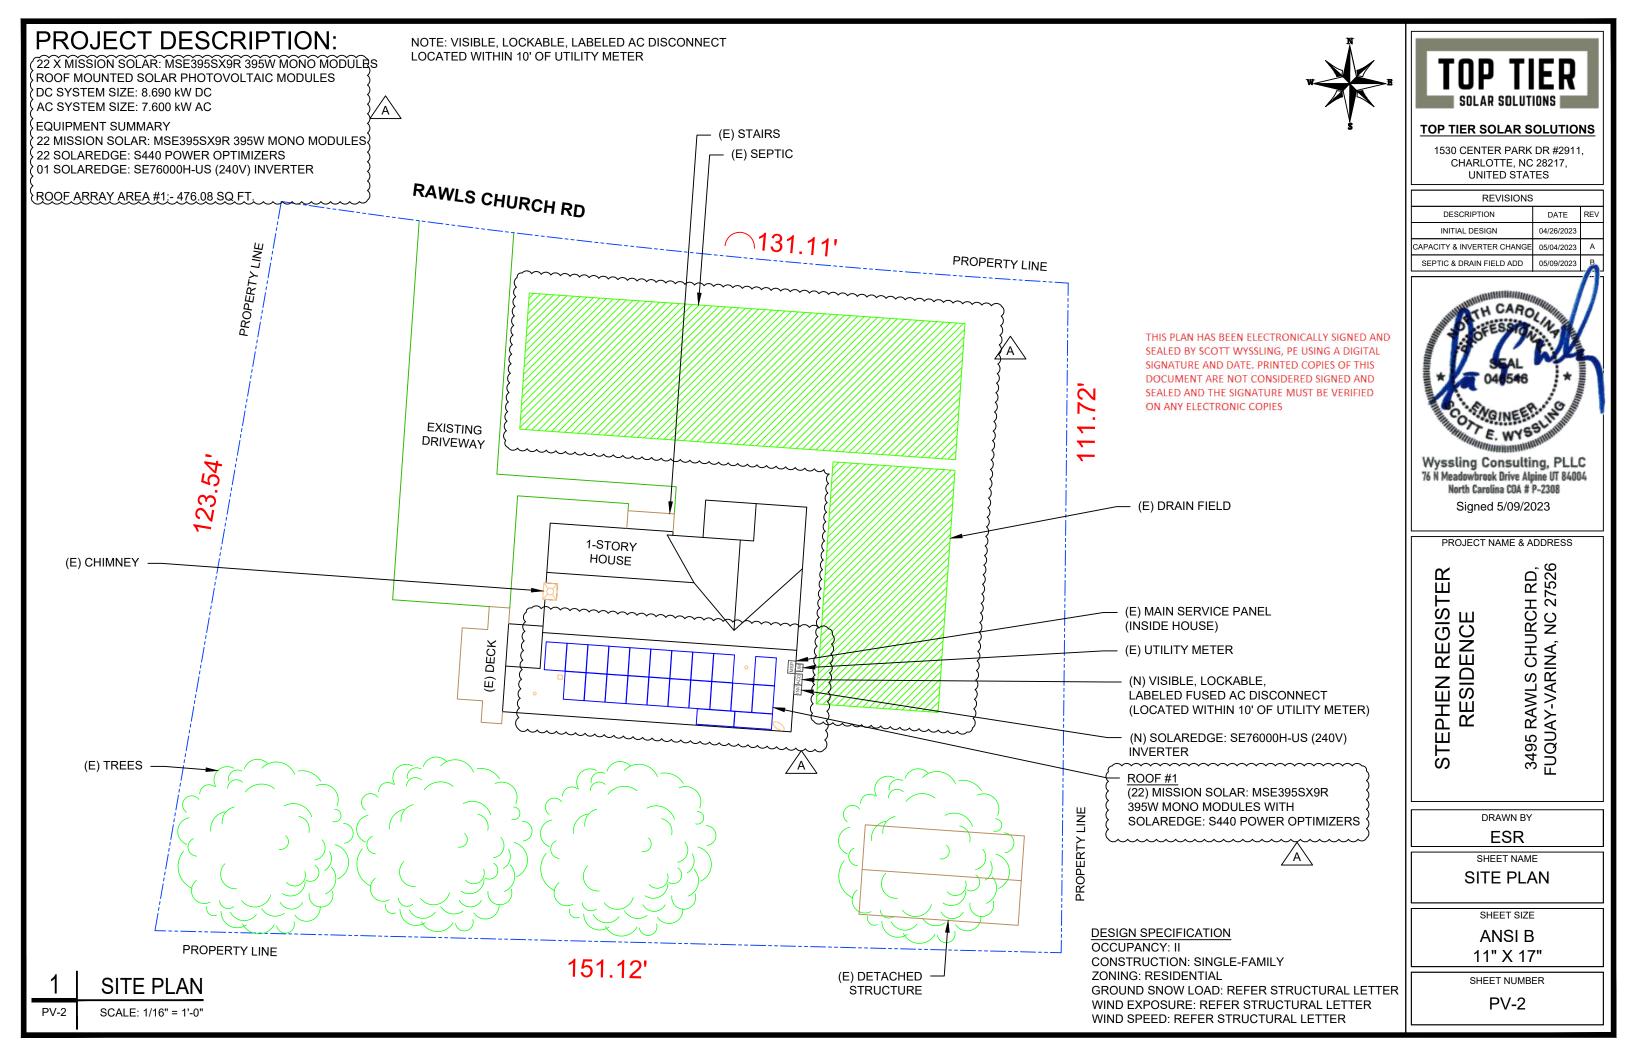

MODULE TYPE, DIMENSIONS & WEIGHT

NUMBER OF MODULES = 22 MODULES MODULE TYPE = MISSION SOLAR: MSE395SX9R 395W MONO MODULES MODULE WEIGHT = 48.5 LBS / 22.0 kg.

MODULE DIMENSIONS = 75.08" x 41.50" = 21.64 SF




ROOF TYPE		01 01	ESCRIPT		SHINGLE						
ROOF LAYER 1 LAYER											
ROOF	# OF MODULES	AZIMUTH	RAFTER SIZE	RAFTER SPACING							
#1	22	42°	184°	2"X6"	16"						

ARRAY AREA & ROOF AREA CALC'S											
TOTAL PV ARRAY AREA (SQ. FT.)	TOTAL ROOF AREA (Sq. Ft.)	ROOF AREA COVERED BY ARRAY (%)									
476.08	1513.21	31									

THIS PLAN HAS BEEN ELECTRONICALLY SIGNED AND SEALED BY SCOTT WYSSLING, PE USING A DIGITAL SIGNATURE AND DATE. PRINTED COPIES OF THIS DOCUMENT ARE NOT CONSIDERED SIGNED AND SEALED AND THE SIGNATURE MUST BE VERIFIED ON ANY ELECTRONIC COPIES

(INSIDE HOUSE)

(22) MISSION SOLAR: MSE395SX9R 395W MONO MODULES WITH

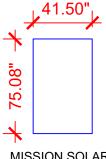

MSE395SX9R 395W MODULES

- AC DISCONNECT

- MAIN SERVICE PANEL

- ROOF ATTACHMENT

- CONDUIT

SHEET NAME **ROOF PLAN &**

 
SHEET SIZE

ANSI B 11" X 17"





- INVERTER INV







SCALE: 1/8" = 1'-0"



AZIM. - 184°

(E) MAIN SERVICE PANEL

ROOF #1

SOLAREDGE: S440 POWER OPTIMIZERS

MISSION SOLAR:

STEPHEN REGISTER RESIDENCE

ESR

DRAWN BY

TOP TIER SOLAR SOLUTIONS 1530 CENTER PARK DR #2911, CHARLOTTE, NC 28217, UNITED STATES

REVISIONS

Wyssling Consulting, PLLC 76 N Meadowbrook Drive Alpine UT 84004 North Carolina COA # P-2308

Signed 5/09/2023

PROJECT NAME & ADDRESS

3495 RAWLS CHURCH RD, FUQUAY-VARINA, NC 27526

04/26/2023

05/04/2023

DESCRIPTION

INITIAL DESIGN

SEPTIC & DRAIN FIELD ADD

MODULES

SHEET NUMBER




DC SYSTEM SIZE: 8.690 kW DC
AC SYSTEM SIZE: 7.600 kW AC
(22) MISSION SOLAR: MSE395SX9R 395W MONO MODULES
WITH (22) SOLAREDGE: S440 POWER OPTIMIZERS
LOCATED UNDER EACH PANEL AND
01 SOLAREDGE: SE76000H-US (240V) INVERTER

STRING LEGENDS

----- STRING #1 ---- STRING #2



RAWLS CHURCH RD

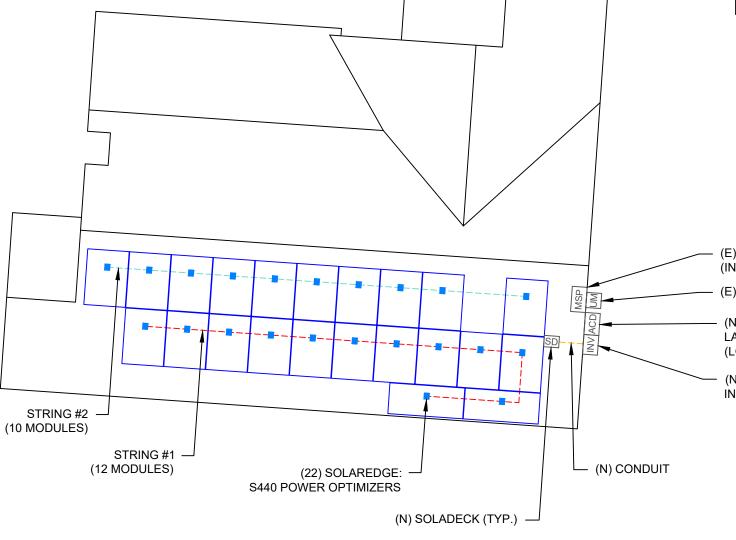

BILL OF MATERIALS EQUIPMENT DESCRIPTION QTY 22 SOLAR PV MODULES: MISSION SOLAR: MSE395SX9R 395W MODULE 22 OPTIMIZERS: SOLAREDGE: S440 POWER OPTIMIZERS INVERTER: SOLAREDGE: SE76000H-US (240V) INVERTER 01 SOLADECKS 3 AC DISCONNECT: FUSED AC DISCONNECT, 60A FUSED, 1 (2) 60A FUSES 240V NEMA 3R, UL LISTED IRONRIDGE XR10 RAIL (RAIL 168" (14 FEET) BLACK) (XR-10-168B) 16 BONDED SPLICE, XR10 (XR10-BOSS-01-M1) 8 52 UNIVERSAL MODULE CLAMP, BLACK (UFO-CL-01-B1) STOPPER SLEEVE, 40MM, BLACK (UFO-STP-40MM-B1) 16 GROUNDING LUG (XR-LUG-03-A1) 4 50 IRONRIDGE FLASHFOOT2 ATTACHMENTS 50 SQUARE-BOLT BONDING HARDWARE (BHW-SQ-02-A1)

(E) MAIN SERVICE PANEL (INSIDE HOUSE)

(E) UTILITY METER

(N) VISIBLE, LOCKABLE, LABELED FUSED AC DISCONNECT (LOCATED WITHIN 10' OF UTILITY METER)

(N) SOLAREDGE: SE76000H-US (240V) INVERTER

LEGEND

SOLADECK

INV - INVERTER

- AC DISCONNECT

- UTILITY METER

- MAIN SERVICE PANEL

- VENT, ATTIC FAN (ROOF OBSTRUCTION)
- ROOF ATTACHMENT

– – - RAFTER

-- - CONDUIT

TOP TIER

TOP TIER SOLAR SOLUTIONS

1530 CENTER PARK DR #2911, CHARLOTTE, NC 28217, UNITED STATES

	REVISIONS		
	DESCRIPTION	DATE	REV
1	INITIAL DESIGN	04/26/2023	
	CAPACITY & INVERTER CHANGE	05/04/2023	Α
	SEPTIC & DRAIN FIELD ADD	05/09/2023	В

PROJECT NAME & ADDRESS

STEPHEN REGISTER RESIDENCE 3495 RAWLS CHURCH RD, FUQUAY-VARINA, NC 27526

DRAWN BY
ESR

SHEET NAME

ELECTRICAL PLAN

SHEET SIZE ANSI B

11" X 17"


SHEET NUMBER


PV-4

1 ELECTRICAL PLAN

PV-4

SCALE: 1/8" = 1'-0"

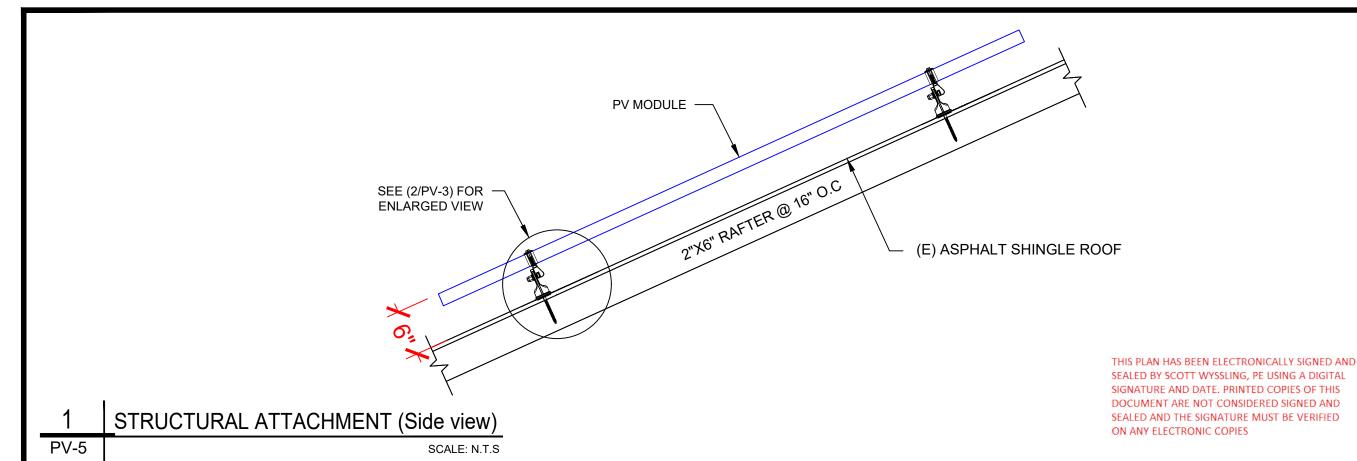

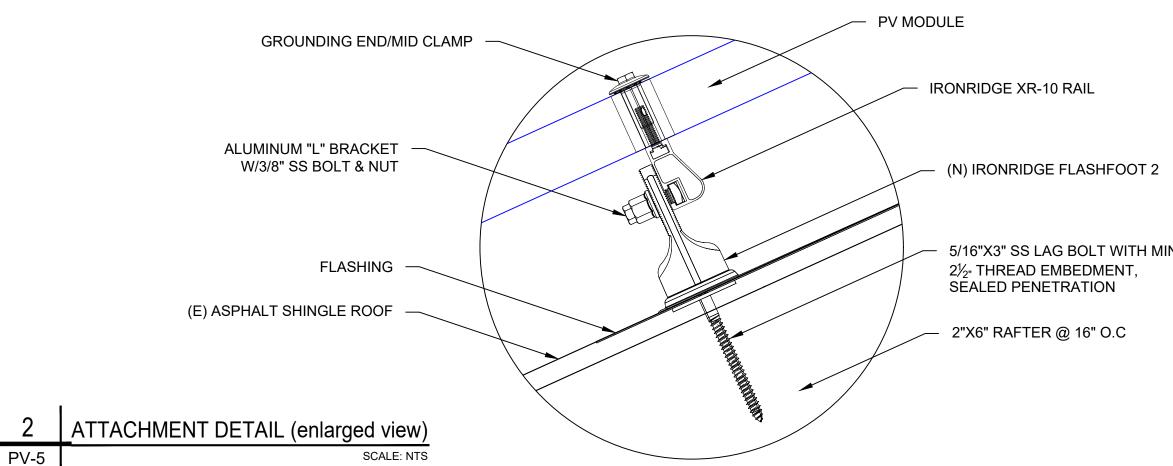




TOP TIER SOLAR SOLUTIONS

1530 CENTER PARK DR #2911, CHARLOTTE, NC 28217, UNITED STATES

REVISIONS		
DESCRIPTION	DATE	REV
INITIAL DESIGN	04/26/2023	
CAPACITY & INVERTER CHANGE	05/04/2023	Α
SEPTIC & DRAIN FIELD ADD	05/09/2023	В

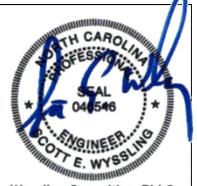

Wyssling Consulting, PLLC 76 N Meadowbrook Drive Alpine UT 84004 North Carolina COA # P-2308

Signed 5/09/2023

PROJECT NAME & ADDRESS

3495 RAWLS CHURCH RD, FUQUAY-VARINA, NC 27526 STEPHEN REGISTER RESIDENCE

> DRAWN BY **ESR**


SHEET NAME


STRUCTURAL DETAIL

SHEET SIZE

ANSI B 11" X 17"

SHEET NUMBER

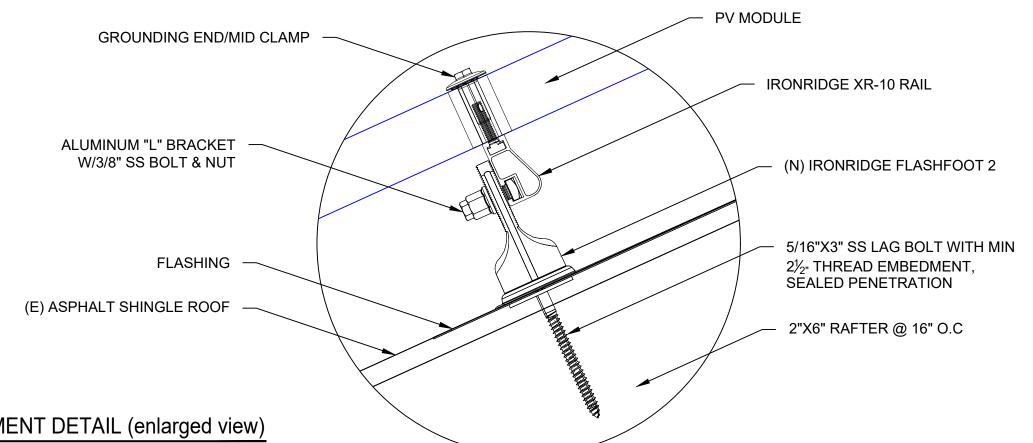

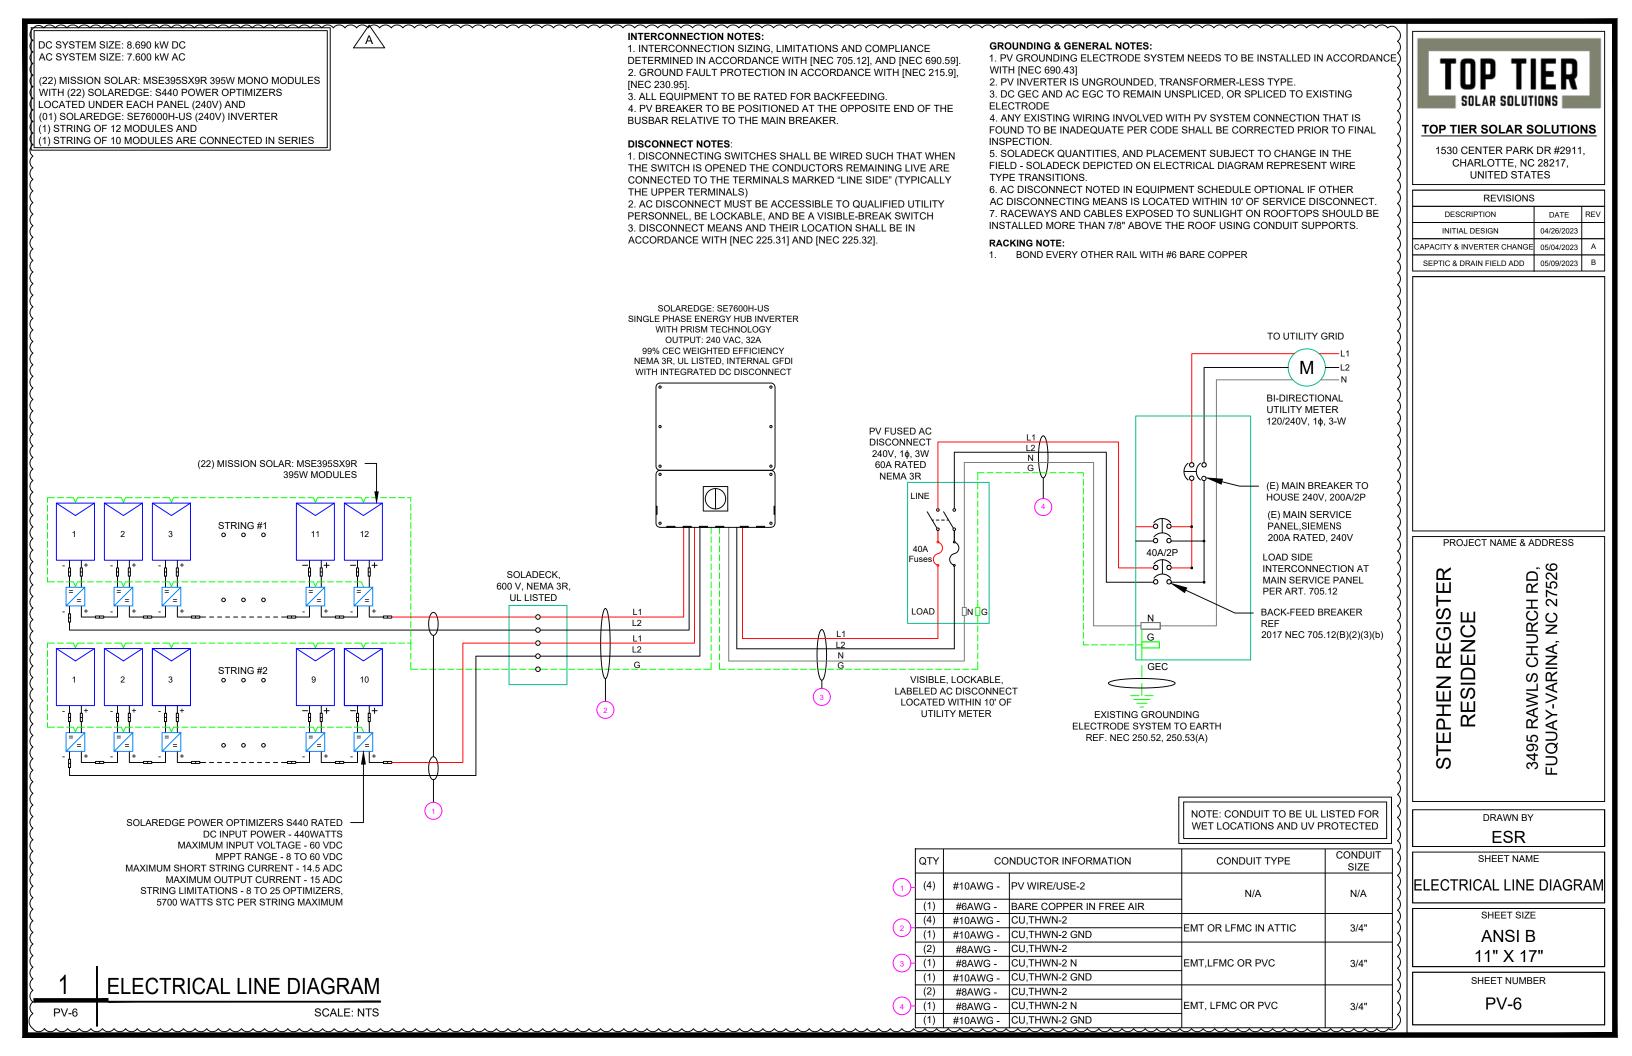

			~~~~~~	~~~~~	~~~~~~~	~~~~			
SOLAR M	ODULE SPECIFICATIONS	]{	INVERTER SPECIFICATIONS						
MANUEACTURER / MODEL #	MISSION SOLAR: MSE395SX9R 395W MODULE	\{   	MANUFACTURER /	MODEL#	SOLAREDGE: SE76000H- INVERTER	-US (240V)			
WANT ACTORER / WOBEL #	INICOION COLAIX. MICESSONSIX 333W MICESE	$\mathbb{R}$	NOMINAL AC POW	ER	7.600 kW				
\ \ \ \ \ \ \ \ \ \ \ \ \ \ \ \ \ \ \	00.001	-18[	NOMINAL OUTPUT	VOLTAGE	240 VAC				
VMP	36.99V	]([	NOMINAL OUTPUT	CURRENT	32A				
IMP	10.68A	16							
VOC	45.18V	٦ [	PERCENT OF	NUMBEI	R OF CURRENT				
ISC	11.24A	1 L	VALUES	CARRYING C	ONDUCTORS IN EMT				
		4 F	.80		4-6				
TEMP. COEFF. VOC	-0.259%/°C	╛╏	.70		7-9				
MODULE DIMENSION	75.08"L x 41.50"W x 1.57"D (In Inch)	1 -	.70		10.20				

.50

CONDUCTOR SIZE

CU #10 AWG

CU #10 AWG

CU #10 AWG

AMPACITY

(A)

35

35

PASS

PASS

38

AMBIENT TEMPERATURE SPEC	<u>S</u>
AMBIENT TEMP (HIGH TEMP 2%)	38°
RECORD LOW TEMPERATURE	-9°
MODULE TEMPERATURE COEFFICIENT OF Voc	-0.259%/°C

	OD TI	<b>EB</b>
	UP 11	EK 🛮
#4 S	SOLAR SOLUTI	

#### TOP TIER SOLAR SOLUTIONS

1530 CENTER PARK DR #2911, CHARLOTTE, NC 28217, UNITED STATES

REVISIONS		
DESCRIPTION	DATE	REV
INITIAL DESIGN	04/26/2023	
CAPACITY & INVERTER CHANGE	05/04/2023	Α
SEPTIC & DRAIN FIELD ADD	05/09/2023	В

А	L	r	E	E	υ	E	к	4	u	А	ц	L	U	L	А	u	Ц	U	Ш	V	5	

10-20

CIRCUIT ORIGIN CIRCUIT ORIGINAL CIRCUIT	s																							Ш
	CIRCUIT ORIGIN		VOLTAGE (V)	AMPS "FLA"	FLA*1.25 (A)		NEUTRAL SIZE	GROUND SIZE		AMPACITY	Account to the second second	The state of the s	CONDUCTORS		FOR AMBIENT TEMPERATURE NEG	FOR CONDUCTORS PER RACEWAY NEC	AMPACITY		LENGTH	RESISTANCE	DROP AT	CONDUIT	1 33.1.23.1.	
AC DISCONNECT POI 240 32 40 40 CU #8 AWG CU #10 AWG CU #8 AWG 50 PASS 38 2 55 0.91 1 50.05 PASS 5 0.778 0.104 3/4" EMT 24.5591	INVERTER 1	AC DISCONNECT	240	32	40	40	CU #8 AWG	CU #10 AWG	CU #8 AWG	50	PASS	38	2	55	0.91	1	50.05	PASS	5	0.778	0.104	3/4" EMT	24.5591	Ш
	AC DISCONNECT	POI	240	32	40	40	CU #8 AWG	CU #10 AWG	CU #8 AWG	50	PASS	38	2	55	0.91	1	50.05	PASS	5	0.778	0.104	3/4" EMT	24.5591	

CUMULATIVE VOLTAGE 0.207

DO	FEEDER CAL	CULATIONS										
AMPACITY CHECK #1	AMBIENT TEMP. (°C)	TOTAL CC CONDUCTO RS IN RACEWAY	90°C AMPACITY (A)	FOR AMBIENT	DERATION FACTOR FOR CONDUCTORS PER RACEWAY NEC 310.15(B)(3)(a)	90°C AMPACITY DERATED (A)	AMPACITY CHECK #2	FEEDER LENGTH (FEET)	CONDUCTOR RESISTANCE (OHM/KFT)	VOLTAGE DROP AT FLA (%)	CONDUIT	CONDUIT FILL (%)
PASS	38	2	40	0.91	1	36.4	PASS	5	1.24	0.049	N/A	#N/A

29.12

PASS

PASS

0.91

String 1 Voltage Drop	0.245
String 2 Voltage Drop	0.245

1.24

0.049

0.196



N/A #N/A

3/4" EMT 19.79362

## PROJECT NAME & ADDRESS

STEPHEN REGISTER
RESIDENCE
3495 RAWLS CHURCH RD,
FUQUAY-VARINA, NC 27526

ESR

SHEET NAME

WIRING CALCULATIONS

SHEET SIZE

ANSI B 11" X 17"

SHEET NUMBER

PV-7

## **ELECTRICAL NOTES**

**CIRCUIT ORIGIN** 

STRING 1

STRING 2

SOLADECK

1. ALL EQUIPMENT TO BE LISTED BY UL OR OTHER NRTL, AND LABELED FOR ITS APPLICATION.

**FULL LOAD** 

AMPS "FLA"

15.00

15.00

FLA*1.25 OCPD

18.75

SIZE (A)

VOLTAGE

(V)

380

DESTINATION

SOLADECK

SOLADECK

INVERTER

- 2. ALL CONDUCTORS SHALL BE COPPER, RATED FOR 600 V AND 90 DEGREE C WET ENVIRONMENT.
- 3. WIRING, CONDUIT, AND RACEWAYS MOUNTED ON ROOFTOPS SHALL BE ROUTED DIRECTLY TO, AND LOCATED AS CLOSE AS POSSIBLE TO THE NEAREST RIDGE, HIP, OR VALLEY.

**GROUND SIZE** 

BARE COPPER #6 AWG

CU #10 AWG

20 BARE COPPER #6 AWG

- 4. WORKING CLEARANCES AROUND ALL NEW AND EXISTING ELECTRICAL EQUIPMENT SHALL COMPLY WITH NEC 110.26.
- 5. DRAWINGS INDICATE THE GENERAL ARRANGEMENT OF SYSTEMS. CONTRACTOR SHALL FURNISH ALL NECESSARY OUTLETS, SUPPORTS, FITTINGS AND ACCESSORIES TO FULFILL APPLICABLE CODES AND STANDARDS.
- 6. WHERE SIZES OF SOLADECK, RACEWAYS, AND CONDUITS ARE NOT SPECIFIED, THE CONTRACTOR SHALL SIZE THEM ACCORDINGLY.
- 7. ALL WIRE TERMINATIONS SHALL BE APPROPRIATELY LABELED AND READILY VISIBLE.
- 8. MODULE GROUNDING CLIPS TO BE INSTALLED BETWEEN MODULE FRAME AND MODULE SUPPORT RAIL, PER THE GROUNDING CLIP MANUFACTURER'S INSTRUCTION.
- 9. MODULE SUPPORT RAIL TO BE BONDED TO CONTINUOUS COPPER G.E.C. VIA WEEB LUG OR ILSCO GBL-4DBT LAY-IN
- 10. TEMPERATURE RATINGS OF ALL CONDUCTORS, TERMINATIONS, BREAKERS, OR OTHER DEVICES ASSOCIATED WITH THE SOLAR PV SYSTEM SHALL BE RATED FOR AT LEAST 75 DEGREE C.

## PHOTOVOLTAIC POWER SOURCE

**EVERY 10' ON CONDUIT & ENCLOSURES** 

LABEL- 1: LABEL LOCATION: EMT/CONDUIT RACEWAY SOLADECK / JUNCTION BOX CODE REF: NEC 690.31 (D)(2)

## **↑** WARNING

## **ELECTRIC SHOCK HAZARD**

TERMINALS ON THE LINE AND LOAD SIDES MAY BE ENERGIZED IN THE OPEN POSITION

LABEL- 2:
LABEL LOCATION:
AC DISCONNECT
INVERTER
MAIN SERVICE PANEL
SUBPANEL
MAIN SERVICE DISCONNECT
CODE REF: NEC 690.13(B)

## **⚠ WARNING**

#### **DUAL POWER SUPPLY**

SOURCE: UTILITY GRID AND PV SOLAR ELECTRIC SYSTEM

LABEL- 3: LABEL LOCATION: MAIN SERVICE PANEL CODE REF: NEC 705.12(C) & NEC 690.59

## SOLAR PV BREAKER:

# BREAKER IS BACKFED DO NOT RELOCATE

LABEL-4:
LABEL LOCATION:
MAIN SERVICE PANEL
CODE REF: NEC 705.12(C) & NEC 690.59




POWER SOURCE OUTPUT CONNECTION. DO NOT RELOCATE THIS OVERCURRENT DEVICE

LABEL- 5:
LABEL LOCATION:
MAIN SERVICE PANEL (ONLY IF SOLAR IS BACK-FED)
SUBPANEL (ONLY IF SOLAR IS BACK-FED)
CODE REF: NEC 705.12(B)(3)(2)

# SOLAR PV SYSTEM EQUIPPED WITH RAPID SHUTDOWN

TURN RAPID SHUTDOWN
SWITCH TO THE
"OFF" POSITION TO
SHUT DOWN PV SYSTEM
AND REDUCE
SHOCK HAZARD
IN THE ARRAY

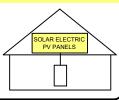

LABEL - 6: <u>LABEL LOCATION:</u> AC DISCONNECT

CODE REF: [NEC 690.56(C)(1)(A)]


# RAPID SHUTDOWN SWITCH FOR SOLAR PV SYSTEM

LABEL-7:
LABEL LOCATION:
AC DISCONNECT
MAIN SERVICE PANEL
CODE REF: NEC 690.56(C)(2)

## DC DISCONNECT

LABEL - 8: LABEL LOCATION: INVERTER CODE REF: NEC 690.13(B)

CODE REF: NEC 690.54

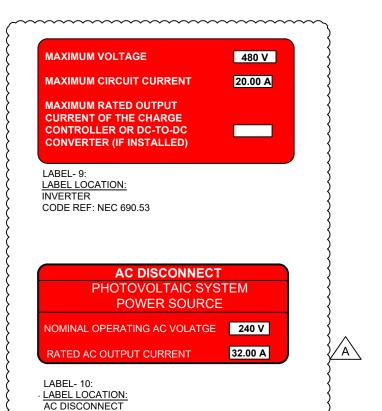



#### TOP TIER SOLAR SOLUTIONS

1530 CENTER PARK DR #2911, CHARLOTTE, NC 28217, UNITED STATES

REVISIONS					
DESCRIPTION	DATE	REV			
INITIAL DESIGN	04/26/2023				
CAPACITY & INVERTER CHANGE	05/04/2023	Α			
SEPTIC & DRAIN FIELD ADD	05/09/2023	В			

#### PROJECT NAME & ADDRESS

STEPHEN REGISTER
RESIDENCE
3495 RAWLS CHURCH RD,
FUQUAY-VARINA, NC 27526

DRAWN BY

SHEET NAME

LABELS

SHEET SIZE

ANSI B 11" X 17"

SHEET NUMBER

MSE PERC 66





Class leading power output



#### FRAME-TO-FRAME WARRANTY

Degradation guaranteed not to exceed 2% in year one and 0.58% annually from years two to 30 with 84.08% capacity guaranteed in year 25. For more information, visit www.missionsolar.com/warranty

#### CERTIFICATIONS







If you have questions or concerns about certification of our products in your area,

# True American Quality True American Brand

Mission Solar Energy is headquartered in San Antonio, Texas where we manufacture our modules. We produce American, high-quality solar modules ensuring the highest-in-class power output and best-in-class reliability. Our product line is tailored for residential, commercial and utility applications. Every Mission Solar Energy solar module is certified and surpasses industry standard regulations, proving excellent performance over the long term.

Demand the best. Demand Mission Solar Energy.



#### Certified Reliability

- . Tested to UL 61730 & IEC Standards
- PID resistant
- · Resistance to salt mist corrosion



#### Advanced Technology

- 9 Bushar
- · Passivated Emitter Rear Contact
- · Ideal for all applications



#### Extreme Weather Resilience

- . Up to 5,400 Pa front load & 3,600 Pa back load
- Tested load to UL 61730
- 40 mm frame

#### **BAA Compliant for Government Projects**

- Buy American Act
- American Recovery & Reinvestment Act






www.missionsolar.com | info@missionsolar.com

Class Leading 390-400W


## MSE PERC 66

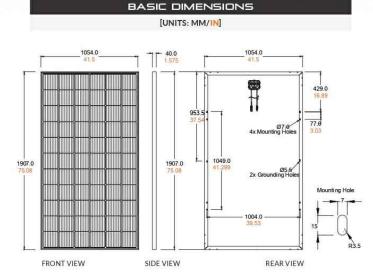

#### CURRENT-VOLTAGE CURVE

#### MSE385SX9R: 385WP, 66 CELL SOLAR MODULE

Current-voltage characteristics with dependence on irradiance and module temperature

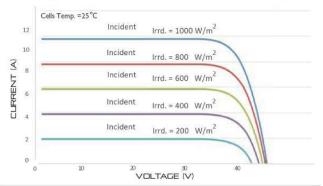

CERTIFICATIONS AND TESTS					
IEC	61215, 61730, 61701				
UL	L 61730				







## Mission Solar Energy

8303 S. New Braunfels Ave., San Antonio, Texas 78235 www.missionsolar.com | info@missionsolar.com

Mission Solar Energy reserves the right to make specification changes without notice. C-SA2-MKTG-0027 REV 4 03/18/2022

43.75°C (±3.7%)

Up to 5,400 Pa front and 3,600 Pa

back load, Tested to UL 61730

PRODUCT TYPE	MSE	XXXXX	9R (xxx = P	max)	
Power Output	P _{max}	$W_p$	390	395	400
Module Efficiency		%	19.4	19.7	19.9
Tolerance		%	0/+3	0/+3	0/+3
Short Circuit Current	Isc	Α	11.19	11.24	11.31
Open Circuit Voltage	Voc	V	45.04	45.18	45.33
Rated Current	Imp	Α	10.63	10.68	10.79
Rated Voltage	Vmp	V	36.68	36.99	37.07
Fuse Rating		Α	20	20	20
System Voltage		V	1,000	1,000	1,000

Temperature Coefficient of Voc		-0.259%/°C
Temperature Coefficient of Isc		0.033%/°C
OPERATINI	CONDIT	10NS
Maximum System Voltage	1,000Vdc	
Operating Temperature Range	-40°F to 185°	F (-40°C to +85°C)
Maximum Series Fuse Rating	20A	
Fire Safety Classification	Type 1*	

TEMPERATURE COEFFICIENTS

Normal Operating Cell Temperature (NOCT)

Front & Back Load

Hail Safety Impact Velocity

Temperature Coefficient of Pmax

*Mission Solar Energy uses quality sourced materials that result in a Type 1 fire rating. Please note, the 'Fire Class' Rating is designated for the fully-installed PV system, which includes, but is not limited to, the module, the type of mounting used, pitch and roof composition.

25mm at 23 m/s

MECHANICAL DATA				
Solar Cells	P-type mono-crystalline silicon			
Cell Orientation	66 cells (6x11)			
Module Dimension	1,907mm x 1,054mm x 40mm			
Weight	48.5 lbs. (22 kg)			
Front Glass	3.2mm tempered, low-iron, anti-reflective			
Frame	40mm Anodized			
Encapsulant	Ethylene vinyl acetate (EVA)			
Junction Box	Protection class IP67 with 3 bypass-diodes			
Cable	1.2m, Wire 4mm2 (12AWG)			
Connector	Staubli PV-KBT4/6II-UR and PV-KST4/6II-UR MC4, Renhe 05-8			

Container Feet	Ship To	Pallet	Panels	390W Bin
53'	Most States	30	780	304.20 kW
Double Stack	CA	26	676	263.64 kW
	PALLE	T [26 PAN	ELS]	
Weight	Height		Width	Length
1,300 lbs. (572 kg)	47.56 in (120.80 cm	1 /1-	46 in 16.84 cm)	77 in (195.58 cm)

www.missionsolar.com | info@missionsolar.com

## **TOP TIER SOLAR SOLUTIONS**

1530 CENTER PARK DR #2911, CHARLOTTE, NC 28217, **UNITED STATES** 

REVISIONS					
DESCRIPTION	DATE	REV			
INITIAL DESIGN	04/26/2023				
CAPACITY & INVERTER CHANGE	05/04/2023	Α			
SEPTIC & DRAIN FIELD ADD	05/09/2023	В			

PROJECT NAME & ADDRESS

3495 RAWLS CHURCH RD, FUQUAY-VARINA, NC 27526 EPHEN REGISTI RESIDENCE ST

> DRAWN BY **ESR**

SHEET NAME **EQUIPMENT SPECIFICATION** 

> SHEET SIZE ANSI B

11" X 17"

SHEET NUMBER

PV-9

C-SA2-MKTG-0027 REV 4 03/18/2022

# **Power Optimizer** For Residential Installations

S440, S500



## **Enabling PV power optimization at the module level**

- Specifically designed to work with SolarEdge residential inverters
- Detects abnormal PV connector behavior, preventing potential safety issues*
- Module-level voltage shutdown for installer and firefighter safety
- Superior efficiency (99.5%)

- / Mitigates all types of module mismatch loss, from manufacturing tolerance to partial shading
- Faster installations with simplified cable management and easy assembly using a single bolt
- Flexible system design for maximum space utilization
- Compatible with bifacial PV modules




## / Power Optimizer For Residential Installations S440, S500

	S440	\$500	UNI	
Rated Input DC Power ⁽¹⁾	440	500	W	
Absolute Maximum Input Voltage (Voc)	60		Vdc	
MPPT Operating Range	8 - 60		Vdc	
Maximum Short Circuit Current (Isc) of Connected PV Module	14.5	15	Adc	
Maximum Efficiency	99.5		%	
Weighted Efficiency	98.6		%	
Overvoltage Category	II			
OUTPUT DURING OPERATION				
Maximum Output Current	15		Adc	
Maximum Output Voltage	60		Vdc	
OUTPUT DURING STANDBY (POWER OPTIMIZER DIS	CONNECTED FROM INVERTER OR I	NVERTER OFF)		
Safety Output Voltage per Power Optimizer	1			
STANDARD COMPLIANCE			-	
EMC	FCC Part 15 Class B, IEC61000-6-2, IEC61000-6-3, CISPR11, EN-55011			
Safety	IEC62109-1 (class II safety), UL1741			
Material	UL94 V-0, UV Resistant			
RoHS	Yes			
Fire Safety	VDE-AR-E 2100-712:2013-05			
INSTALLATION SPECIFICATIONS			·	
Maximum Allowed System Voltage	1000		Vdc	
Dimensions (W x L x H)	129 x 155	x 30	mm	
Weight (including cables)	655 / 1	.5	gr/ll	
Input Connector	MC4 ^g	2)		
Input Wire Length	0.1		m	
Output Connector	MC4			
Output Wire Length	(+) 2.3, (-)	0.10	m	
Operating Temperature Range ⁽³⁾	-40 to +	-85	°C	
Protection Rating	IP68 / NEM	MA6P		
Relative Humidity	0 - 10	0	%	

PV System Design Using Inverter	a SolarEdge	Single Phase HD-Wave	Three Phase	Three Phase for 277/480V Grid	
Minimum String Length (Power Optimizers)	S440, S500	8	16	18	
Maximum String Length (Power O	ptimizers)	25	5	0	
Maximum Nominal Power per Stri	ng ⁽⁴⁾	5700	11250 ⁽⁵⁾	12750 ⁽⁶⁾	W
Parallel Strings of Different Length	s or Orientations		Yes		

(4) If the inverters rated AC power s maximum nominal power per string, then the maximum power per string will be able to reach up to the inverters maximum input DC power Refer to: https://www.solaredge.com/sites/default/files/se-power-optimizer-single-string-design-application-note.pdf
(5) For the 230/400/ grid: it is allowed to install up to 13,500W per string when the maximum power difference between each string is 2,000W
(6) For the 27/4080 grid: it is allowed to install up to 15,000W per string when the maximum power difference between each string is 2,000W
(7) It is not allowed to mix S-series and P-series Power Optimizers in new installations

(3) For ambient temperature above +70°C / +158°F power de-rating is applied. Refer to Power Optimizers Temperature De-Rating Technical Note for more details

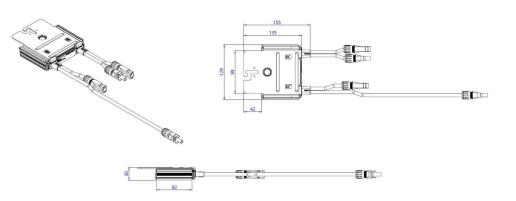

**CE RoHS** 

#### **TOP TIER SOLAR SOLUTIONS**

1530 CENTER PARK DR #2911, CHARLOTTE, NC 28217, **UNITED STATES** 

REVISIONS					
DESCRIPTION	DATE	REV			
INITIAL DESIGN	04/26/2023				
CAPACITY & INVERTER CHANGE	05/04/2023	Α			
SEPTIC & DRAIN FIELD ADD	05/09/2023	В			

PROJECT NAME & ADDRESS

3495 RAWLS CHURCH RD, FUQUAY-VARINA, NC 27526 STEPHEN REGISTER RESIDENCE

> DRAWN BY **ESR**

SHEET NAME **EQUIPMENT SPECIFICATION** 

SHEET SIZE

ANSI B 11" X 17"

SHEET NUMBER

^{*} Functionality subject to inverter model and firmware version



## For North America

SE3000H-US / SE3800H-US / SE6000H-US / SE7600H-US / SE10000H-US / SE11400H-US(1)



# HOME BACKUP

## Optimized battery storage with HD-Wave technology

- Record-breaking 99% weighted efficiency with 200% DC oversizing
- / Small, lightweight, and easy to install
- / Modular design, future ready with optional upgrades to:
- DC-coupled storage for full or partial home backup
- Built-in consumption monitoring
- ✓ Direct connection to the SolarEdge smart EV

- Multi-inverter, scalable storage solution
- / With enhanced battery power up to 10kW
- Integrated arc fault protection and rapid shutdown for NEC 2014, NEC 2017 and NEC 2020, per article 690.11 and 690.12
- Embedded revenue grade production data, ANSI C12.20 Class 0.5





## / Single Phase Energy Hub Inverter with Prism Technology

For North America

SE3000H-US / SE3800H-US / SE6000H-US / SE7600H-US / SE10000H-US / SE11400H-US(1)

	SE3000H-US	SE3800H-US	SE6000H-US	SE7600H-US	SE10000H-US	SE11400H-US	UNIT
OUTPUT - AC ON GRID					•		
Rated AC Power	3000	3800 @ 240V 3300 @ 208V	6000 @ 240V 5000 @ 208V	7600	10000	11400 @ 240V 10000 @ 208V	W
Maximum AC Power Output	3000	3800 @ 240V 3300 @ 208V	6000 @ 240V 5000 @ 208V	7600	10000	11400 @ 240V 10000 @ 208V	W
AC Frequency Range (min - nom - max)			59.3 - 60	- 60.5 ¹²¹			Hz
Maximum Continuous Output Current @ 240V	12.5	16	25	32	42	47.5	Α
Maximum Continuous Output Current @ 208V	÷	16	24	1 1	=	48.5	Α
GFDI Threshold			1				Α
Total Harmonic Distortion (THD)			<	3			%
Power Factor			1, adjustable -	-0.85 to 0.85			
Utility Monitoring, Islanding Protection, Country Configurable Thresholds			Ye	es			
Charge Battery from AC (if allowed)			Υe	es			
Typical Nighttime Power Consumption			<2	5			W
OUTPUT - AC BACKUP(3)	·						
Dated AC Device in Bardon Connection W	3000	3800	6000	7600	10000	10300	w
Rated AC Power in Backup Operation®	3000	7600*	6000	10300*	10000	10300	VV
AC L-L Output Voltage Range in Backup		717	211 -	264			Vac
AC L-N Output Voltage Range in Backup			105 -	132			Vac
AC Frequency Range in Backup (min - nom - max)			55 - 60	O - 65			Hz
Maximum Continuous Output Current in Backup Operation	12.5	16 32*	25	32 43*	42	43	А
GFDI			· 1		1		A
THD			<	5			%
OUTPUT - SMART EV CHARGER AC	I.			-			
Rated AC Power			960	00			W
AC Output Voltage Range			211 -				Vac
On-Grid AC Frequency Range (min - nom - max)			59.3 - 60	H 1047545			Hz
Maximum Continuous Output Current @240V (grid, PV and battery)			41				Aar
INPUT - DC (PV AND BATTERY)				2			,,,,,,
Transformer-less, Ungrounded	Ť		Υe	oc .			
MaxInput Voltage			48	-			Vde
Nom DC Input Voltage			38				Vde
Reverse-Polarity Protection			Υe				V C.
Ground-Fault Isolation Detection			600kΩ Si	***			
INPUT - DC (PV)	1		0001423	erisiuvity			1
		7600		15200			
Maximum DC Power @ 240V	6000	15200*	12000	22800*	22000	22800	W
Maximum DC Power @ 208V	23	6600	10000	-	2	20000	W
Maximum Input Current ⁽⁵⁾ @ 240V	8.5	10.5 20*	16.5	20 31*	27	31	Add
	-	9	13.5		9	27	Add
Maximum Input Current ⁵¹ @ 208V	45						Add
Maximum Input Current [©] @ 208V  Max. Input Short Circuit Current			99 99.2				
Max. Input Short Circuit Current	99			99.2			%
	99		99	99.2		99 @ 240V 98.5 @ 208V	%

#### TOP TIER SOLAR SOLUTIONS

1530 CENTER PARK DR #2911, CHARLOTTE, NC 28217, **UNITED STATES** 

REVISIONS					
DESCRIPTION	DATE	REV			
INITIAL DESIGN	04/26/2023				
CAPACITY & INVERTER CHANGE	05/04/2023	Α			
SEPTIC & DRAIN FIELD ADD	05/09/2023	В			

PROJECT NAME & ADDRESS

EPHEN REGIST RESIDENCE

DRAWN BY **ESR** 

SHEET NAME **EQUIPMENT SPECIFICATION** 

> SHEET SIZE ANSI B

11" X 17"

SHEET NUMBER

**PV-11** 

solaredge.com

⁽i) These specifications apply to inverters with part numbers SExxxxH-USSMxxxxx or SExxxxH-USSNxxxxx and connection unit model number DCD-1PH-US-PxH-F-x (2) For other regional settings please contact SolarEdge support (3) Not designed for standalone applications and requires AC for commissioning. Backup functionality is only supported for 240V grid


⁽⁴⁾ Rated AC power in Backup Operation are valid for installations with multiple inverters. For a single backup inverter operation, rated AC power in Backup is 90% of the value stated (5) A higher current source may be used; the inverter will limit its input current to the values stated

## / Single Phase Energy Hub Inverter with Prism Technology

## For North America

SE3000H-US / SE3800H-US / SE6000H-US / SE7600H-US / SE10000H-US / SE11400H-US(1)

	SE3000H-US	SE3800H-US	SE6000H-US	SE7600H-US	SE10000H-US SE11400H-US	UNIT
INPUT - DC (BATTERY)						
Supported Battery Types		Sol	arEdge Energy Ban	k, LG RESU Prime ⁽⁶⁾		
Number of Batteries per Inverter		Up to 3 Sc	larEdge Energy Bai	nk, up to 2 LG RESU	J Prime	
Continuous Power ⁱⁿ	6000	7600		100	000	W
Peak Power ^m	6000	7600		100	000	W
Max Input Current	16	20		26	6.5	Adc
2-pole Disconnection		l.	Y	es		
SMART ENERGY CAPABILITIES						
Consumption Metering			Built	- iu _{lai}		Ì
Backup & Battery Storage	With Ba	ickup Interface (pur	chased separately)	for service up to 20	00A; Up to 3 inverters	
EV Charging			Direct connection t	o Smart EV charge	r	
ADDITIONAL FEATURES						2.1
Supported Communication Interfaces		RS485, Ethernet	Cellular ⁹⁾ , Wi-Fi (o	ptional),SolarEdge I	Energy Net (optional)	
Revenue Grade Metering, ANSI C12.20			Built	- ju _{lar}		
Integrated AC, DC and Communication Connection Unit			Y	es		
Inverter Commissioning	With the	SetApp mobile app	lication using built-	in Wi-Fi Access Poir	nt for local connection	
DC Voltage Rapid Shutdown (PV and Battery)		Yes, accordin	g to NEC 2014, NEC	2017 and NEC 202	20 690.12	
STANDARD COMPLIANCE						
Safety		UL1741, UL1741 SA	A, UL1741 PCS, UL16	99B, UL1998, UL95	40, CSA 22.2	
Grid Connection Standards			IEEE1547, Rul	e 21, Rule 14H		
Emissions			FCC part	15 class B		
INSTALLATION SPECIFICATIONS	*					**
AC Output and EV AC Output Conduit Size / AWG Range			1" maximum	/ 14-4 AWG		
DC Input (PV and Battery) Conduit Size / AWG Range			1" maximum	/ 14-6 AWG		
	0.44.60		6	17.7 x 14.6 x 6.8 / 450 x 370 x 174		100000000000000000000000000000000000000
Dimensions with Connection Unit (H x W x D)	17.7 x 1	4.6 x 6.8 / 450 x 37	0 x 174	17.7 x 14.6 x 6.8 / 450 x 370 x 174*	17.7 x 14.6 x 6.8 / 450 x 370 x 174	in/m
Weight with Connection Unit		26/11.8		26 / 11.8 41.7/18.9*	41.7 / 18.9	lb/kg
Noise	< 25	< 25 < 50*	< 25		< 50	dBA
Cooling	Natural Convection					
Operating Temperature Range	-40 to +140/-40 to +60 ^{no}				°F/°C	
Protection Rating	NEMA 4					

 



#### **TOP TIER SOLAR SOLUTIONS**

1530 CENTER PARK DR #2911, CHARLOTTE, NC 28217, UNITED STATES

REVISIONS					
DESCRIPTION	DATE	REV			
INITIAL DESIGN	04/26/2023				
CAPACITY & INVERTER CHANGE	05/04/2023	Α			
SEPTIC & DRAIN FIELD ADD	05/09/2023	В			

PROJECT NAME & ADDRESS

STEPHEN REGISTER RESIDENCE

DRAWN BY **ESR** 

SHEET NAME

**EQUIPMENT SPECIFICATION** 

SHEET SIZE

ANSI B 11" X 17"

SHEET NUMBER

⁽a) The part numbers sexword-to-symboox only support the solarizage thereby bank the part numbers sexword-to-symboox only support the solarizage thereby bank the part numbers sexword the inverter rated AC power for on-grid and backup applications

(b) For consumption metering current transformers should be ordered separately. SECT-SPL-225A-T-20 or SEACT0750-400NA-20 units per box. Revenue grade metering is only for production metering

(c) Information concerning the Data Plan's terms & conditions is available in the following link:

https://www.solaredge.com/sites/default/files/se-communication-plan-terms-and-conditions-eng.pdf

(d) Full power up to at least 50°C/122°F; for power de-rating information refer to: https://www.solaredge.com/sites/default/files/se-temperature-derating-note-ha.pdf




## **XR** Rail Family

## Solar Is Not Always Sunny Over their lifetime, solar panels experience countless extreme weather events. Not just the worst storms in years, but the worst storms in 40 years. High winds capable of ripping panels from a roof, and snowfalls weighing

XR Rails are the structural backbone preventing these results. They resist uplift, protect against buckling and safely and efficiently transfer loads into the building structure.

Their superior spanning capability requires fewer roof attachments, reducing the number of roof penetrations and the amount of installation time.

enough to buckle a panel frame.

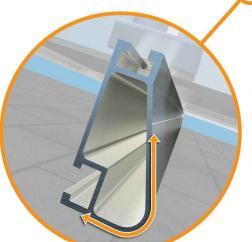

Sloped roofs generate both vertical and lateral forces on mounting rails which can cause them to bend and twist. The curved shape of XR Rails is specially designed to increase strength in both directions while resisting the twisting. This unique feature ensures greater security during extreme weather and a longer system lifetime

## **XR Rail Family**

The XR Rail Family offers the strength of a curved rail in three targeted sizes. Each size supports specific design loads, while minimizing material costs. Depending on your location, there is an XR Rail to match.



XR10 is a sleek, low-profile mounting rail, designed for regions with light or no snow. It achieves 6 foot spans, while emaining light and economical.

- 6' spanning capability
- Moderate load capability
- Clear anodized finish
- Internal splices available



#### XR100

XR100 is the ultimate residential mounting rail. It supports a range of wind and snow conditions, while also maximizing spans up to 8 feet.

- · 8' spanning capability
- · Heavy load capability · Internal splices available
- · Clear & black anodized finish



#### XR1000

XR1000 is a heavyweight among solar mounting rails. It's built to handle extreme climates and spans 12 feet or more for commercial applications.

- 12' spanning capability
- Extreme load capability Clear anodized finish
- · Internal splices available

## **Rail Selection**

Lo	ad		Rail Span				
Snow (PSF)	Wind (MPH)	4'	5' 4"	6'	8'	10'	12'
	100						
None	120						
None	140	XR10		XR100		XR1000	
	160						
	100						
10-20	120						
10-20	140						
	160						
30	100						
30	160						
40	100						
40	160						
50-70	160						
80-90	160						

The following table was prepared in compliance with applicable engineering codes and standards. Values are based on the following criteria: ASCE 7-10, Roof Zone 1, Exposure B, Roof Slope of 7 to 27 degrees and Mean Building Height of 30 ft. Visit IronRidge.com for detailed span tables and certifications.

Lo	ad		Rail Span				
Snow (PSF)	Wind (MPH)	4'	5' 4"	6'	8'	10'	12'
	100						
None	120						
None	140	XR10		XR100		XR1000	
	160						
	100						
10-20	120						
10-20	140						
	160						
30	100						
30	160						
40	100						
40	160						
50-70	160						
80-90	160						



#### **TOP TIER SOLAR SOLUTIONS**

1530 CENTER PARK DR #2911, CHARLOTTE, NC 28217, **UNITED STATES** 

REVISIONS				
DESCRIPTION	DATE	REV		
INITIAL DESIGN	04/26/2023			
CAPACITY & INVERTER CHANGE	05/04/2023	A		
SEPTIC & DRAIN FIELD ADD	05/09/2023	В		

PROJECT NAME & ADDRESS

3495 RAWLS CHURCH RD, FUQUAY-VARINA, NC 27526 EPHEN REGISTER RESIDENCE ST

> DRAWN BY **ESR**

SHEET NAME **EQUIPMENT SPECIFICATION** 


> SHEET SIZE ANSI B

11" X 17"

SHEET NUMBER

PV-13



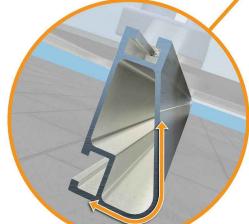







IronRidge offers a range of tilt leg options for flat roof mounting applications



All XR Rails are made of marine-grade aluminum alloy, then protected with an anodized finish. Anodizing prevents surface and structural corrosion, while also providing a more attractive appearance.





## **UFO Family of Components**

## Simplified Grounding for Every Application

The UFO family of components eliminates the need for separate grounding hardware by bonding solar modules directly to IronRidge XR Rails. All system types that feature the UFO family-Flush Mount, Tilt Mount and Ground Mount - are fully listed to the UL 2703 standard.

module and the rail, resulting in many parallel grounding paths throughout the system. This leads to safer and more reliable installations.

**Bonded Splice** 

Each Bonded Splice uses self-drilling screws to form a secure connection. No

bonding strap needed.



**Grounding Lug** 

A single Grounding Lug

connects an entire row

of PV modules to the


grounding conductor.

**Bonded Attachments** 

The bonding bolt attaches

rail. It is installed with the same socket as the rest of the

and bonds the L-foot to the

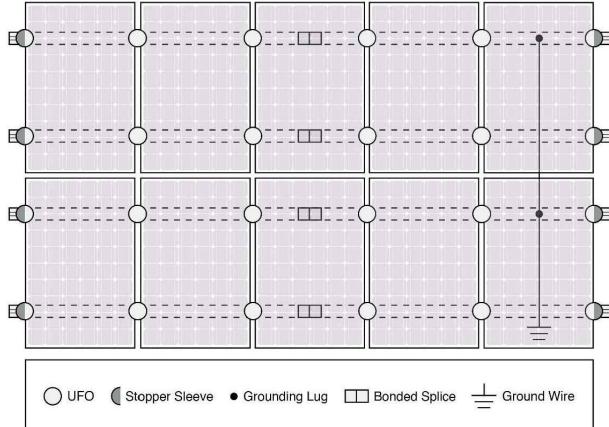

Approved Enphase microinverters can provide equipment grounding of IronRidge systems, eliminating the need for grounding lugs and field installed equipment ground conductors (EGC). A minimum of two microinverters mounted to the same rail and connected to the same Engage cable is required. Refer to installation manuals for additional details.


## **UL Certification**

UL 2703 is the standard for evaluating solar mounting systems. It ensures these devices will maintain strong electrical and mechanical connections over an extended period of time in extreme outdoor environments.

Go to IronRidge.com/UFO

	Cross-System	Compatibility	
Feature	Flush Mount	Tilt Mount	Ground Mount
XR Rails	~	~	XR1000 Only
UFO/Stopper	~	~	~
Bonded Splice	~	~	N/A
Grounding Lugs	1 per Row	1 per Row	1 per Array
Microinverters & Power Optimizers	Darfon - N	0-72, M250-60, M2 11G240, M1G300, G P320, P400, P405	
Fire Rating	Class A	Class A	N/A
Modules		ated with over 400 llation manuals for	

## **System Diagram**

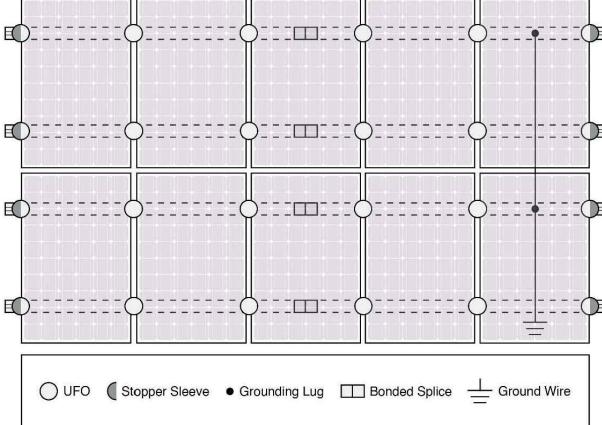

The IronRidge Flush Mount, Tilt Mount, and Ground Mount Systems have been listed to UL 2703 by Intertek Group plc.

## **TOP TIER SOLAR SOLUTIONS**

1530 CENTER PARK DR #2911, CHARLOTTE, NC 28217, **UNITED STATES** 

ш						
l	REVISIONS					
l	DESCRIPTION	DATE	REV			
l	INITIAL DESIGN	04/26/2023				
l	CAPACITY & INVERTER CHANGE	05/04/2023	Α			
١	SEPTIC & DRAIN FIELD ADD	05/09/2023	В			

PROJECT NAME & ADDRESS

3495 RAWLS CHURCH RD, FUQUAY-VARINA, NC 27526 STEPHEN REGISTER RESIDENCE

> DRAWN BY **ESR**

SHEET NAME **EQUIPMENT SPECIFICATION** 

SHEET SIZE

ANSI B 11" X 17"


SHEET NUMBER



## FlashFoot2

## The Strongest Attachment in Solar

IronRidge FlashFoot2 raises the bar in solar roof protection. The unique water seal design is both elevated and encapsulated, delivering redundant layers of protection against water intrusion. In addition, the twist-on Cap perfectly aligns the rail attachment with the lag bolt to maximize mechanical strength.

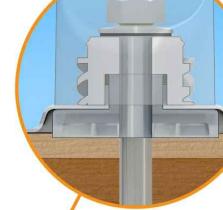

#### Twist-On Cap

Single Socket Size

A custom-design lag bolt allows

you to install FlashFoot2 with


the same 7/16" socket size

used on other Flush Mount System components.

FlashFoot2's unique Cap design encapsulates the lag bolt and locks into place with a simple twist. The Cap helps FlashFoot2 deliver superior structural strength, by aligning the rail and lag bolt in a concentric load path.

#### Three-Tier Water Seal


FlashFoot2's seal architecture utilizes three layers of protection. An elevated platform diverts water away, while a stack of rugged components raises the seal an entire inch. The seal is then fully-encapuslated by the Cap. FlashFoot2 is the first solar attachment to pass the TAS-100 Wind-Driven Rain Test.

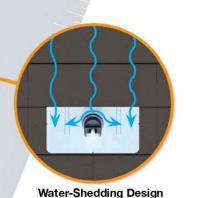

An elevated platform diverts water

away from the water seal

#### Installation Features

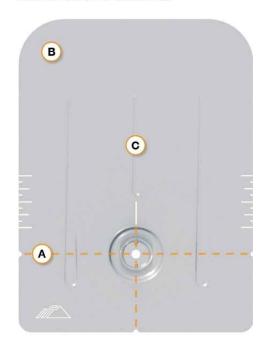

## (A) Alignment Markers

Quickly align the flashing with chalk lines to find pilot holes.

## B Rounded Corners

Makes it easier to handle and insert under the roof shingles.


## C Reinforcement Ribs

Help to stiffen the flashing and prevent any bending or crinkling during installation.

## **Benefits of Concentric Loading**

Traditional solar attachments have a horizontal offset between the rail and lag bolt, which introduces leverage on the lag bolt and decreases uplift capacity.

FlashFoot2 is the only product to align the rail and lag bolt. This concentric loading design results in a stronger attachment for the system.

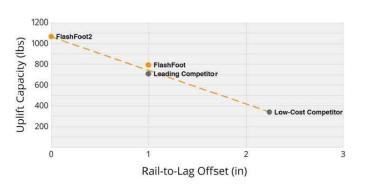

## **Testing & Certification**

#### Structural Certification

Designed and Certified for Compliance with the International Building Code & ASCE/SEI-7.

### **Water Seal Ratings**

Water Sealing Tested to UL 441 Section 27 "Rain Test" and TAS 100-95 "Wind Driven Rain Test" by Intertek. Ratings applicable for composition shingle roofs having slopes between 2:12 and 12:12.

#### UL 2703

Conforms to UL 2703 Mechanical and Bonding Requirements. See Flush Mount Install Manual for full ratings.

2016 IronBidge Inc. All rights reserved. Visit www.ironridge.com.or.call 1-900-227-9523 for more information. Version 1.0



#### TOP TIER SOLAR SOLUTIONS

1530 CENTER PARK DR #2911, CHARLOTTE, NC 28217, UNITED STATES

REVISIONS				
DESCRIPTION	DATE	REV		
INITIAL DESIGN	04/26/2023			
CAPACITY & INVERTER CHANGE	05/04/2023	Α		
SEPTIC & DRAIN FIELD ADD	05/09/2023	В		

PROJECT NAME & ADDRESS

STEPHEN REGISTER RESIDENCE

DRAWN BY

3495 RAWLS CHURCH RD, FUQUAY-VARINA, NC 27526

SHEET NAME
EQUIPMENT
SPECIFICATION

SHEET SIZE ANSI B

11" X 17"

SHEET NUMBER


Cut Sheet

v2.0






## FlashFoot2®

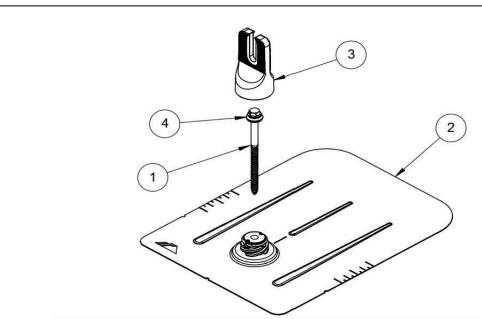


ITEM NO.	DESCRIPTION	Qty in Kit
1	BOLT LAG 5/16 X 4.75"	1
2	ASSY, FLASHING	1
3	ASSY, CAP	1
4	WASHER, EPDM BACKED	1

#### **FLASHFOOT 2**

 
Part Number	Description	
FF2-02-M2	FlashFoot2® (Mill)	
FF2-02-B2	FlashFoot2® (Black)	



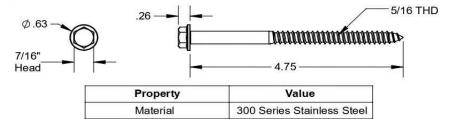

Clear

Finish

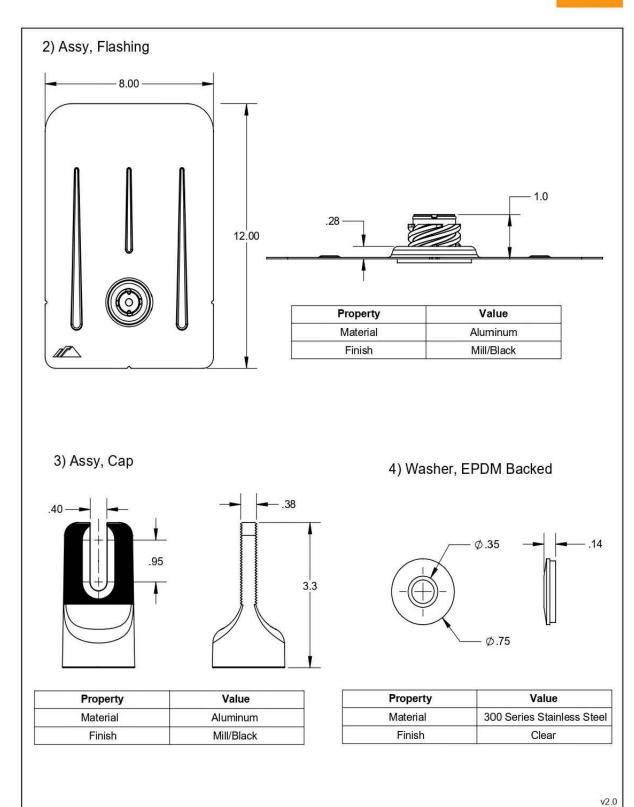



#### **TOP TIER SOLAR SOLUTIONS**

1530 CENTER PARK DR #2911, CHARLOTTE, NC 28217, UNITED STATES

REVISIONS				
DESCRIPTION	DATE	REV		
INITIAL DESIGN	04/26/2023			
CAPACITY & INVERTER CHANGE	05/04/2023	Α		
SEPTIC & DRAIN FIELD ADD	05/09/2023	В		

## PROJECT NAME & ADDRESS

3495 RAWLS CHURCH RD, FUQUAY-VARINA, NC 27526 STEPHEN REGISTER RESIDENCE

> DRAWN BY **ESR**

SHEET NAME **EQUIPMENT SPECIFICATION** 

> SHEET SIZE ANSI B

11" X 17"

SHEET NUMBER



#### **Basic Features**

- Stamped Seamless Construction
- 18 Gauge Galvanized Steel
- Powder Coated Surfaces
- · Flashes into the roof deck
- 3 Roof deck knockouts .5", .75", 1"
- 5 Centering dimples for entry/exit fittings or conduit
- · 2 Position Ground lug installed
- · Mounting Hardware Included



SolaDeck Model SD 0783



 
## SolaDeck UL50 Type 3R Enclosures

Available Models: Model SD 0783 - (3" fixed Din Rail) Model SD 0786 - (6" slotted Din Rail)

#### SolaDeck UL 1741 Combiner/Enclosures

Models SD 0783-41 and SD 0786-41  $\,$  are labeled and ETL listed UL STD 1741 according to the UL STD 1741 for photovoltaic combiner enclosures.

Max Rated - 600VDC, 120AMPS



- 4- Din Rail Mounted Fuse Holders 600VDC 30 AMP
- 1- Power Distribution Block 600VDC 175AMP
- 1- Bus Bar with UL lug

Model SD 0786-41 6" Slotted Din Rail fastened using steel studs

#### **Typical System Configuration

- 4- Din Rail Mounted Fuse Holders 600VDC 30 AMP
- 4- Din Rail Mounted Terminal Blocks Bus Bars with UL lug

**Fuse holders and terminal blocks added in the field must be UL listed or recognized and meet 600 VDC 30 AMP 110C for fuse holders, 600V 50 AMP 90C for rail mounted terminal blocks and 600 V 175 AMP 90C for Power Distribution Blocks. Use Copper Wire Conductors.



Cover is trimmed to allow conduit or fittings, base is center dimpled for fitting locations.



Model SD 0783-41, wired with Din Rail mounted fuse holders, bus bar and power distribution



Model SD 0786-41, wired with Din Rail mounted fuse holders, terminal blocks and bus bars.

RSTC Enterprises, Inc • 2219 Heimstead Road • Eau Cliare, WI 54703 For product information call 1(866) 367-7782



#### **TOP TIER SOLAR SOLUTIONS**

1530 CENTER PARK DR #2911, CHARLOTTE, NC 28217, UNITED STATES

REVISIONS				
DESCRIPTION	DATE	REV		
INITIAL DESIGN	04/26/2023			
CAPACITY & INVERTER CHANGE	05/04/2023	Α		
SEPTIC & DRAIN FIELD ADD	05/09/2023	В		

PROJECT NAME & ADDRESS

STEPHEN REGISTER
RESIDENCE
3495 RAWLS CHURCH RD,
FUQUAY-VARINA, NC 27526

DRAWN BY

ESR

SHEET NAME
EQUIPMENT
SPECIFICATION

SHEET SIZE

ANSI B 11" X 17"

SHEET NUMBER