


# PHOTOVOLTAIC GROUND MOUNTED - 11.060 kW DC, 10.000 kW AC

# 1591 OAKRIDGE DUNCAN RD, FUQUAY-VARINA, NC 27526

PROJECT DATA	GENERAL NOTES	VICI
PROJECT DATA         PROJECT SERVICE         ADDRESS FUQUAY-VARINA, NC 27526         OWNER PATRICIA SCARDINO         DESIGNER FOR STRICT         SCOPE         \$11.060 KW DC GROUND MOUNT         SOLAR PV SYSTEM WITH         28 MISSION SOLAR: MSE395SX9R 395W         PV MODULES WITH         28 SOLAREDGE: S440 POWER OPTIMIZERS AND         OT SOLAREDGE: SE10000H-US (240V/10000W)         INVERTER         AUTHORITIES HAVING JURISDICTION:         BULDING: HARNETT COUNTY         ONING: HARNETT COUNTY         ONING: HARNETT COUNTY         UTILITY: DUKE ENERGY PROGRESS <b>SHEET INDEX</b> PV-1       COVER SHEET         PV-3       GROUND PLAN & MODULES         PV-4       ELECTRICAL PLAN         PV-5       MOUNTING DETAIL-1         PV-5       MOUNTING DETAIL-1         PV-5       MOUNTING DETAIL-1         PV-6       ELECTRICAL LINE DIAGRAM         PV-7       WIRING CALCULATIONS         PV-8       LABELS         PV-9       EQUIPMENT SPECIFICATIONS	<ol> <li>ALL COMPONENTS ARE UL LISTED AND CEC CERTIFIED, WHERE WARRANTED.</li> <li>THE SOLAR PV SYSTEM WILL BE INSTALLED IN ACCORDANCE WITH ARTICLE 690 OF THE NEC 2017.</li> <li>THE UTILITY INTERCONNECTION APPLICATION MUST BE APPROVED AND PV SYSTEM INSPECTED PRIOR TO PARALLEL OPERATION.</li> <li>ALL CONDUCTORS OF A CIRCUIT, INCLUDING THE EGC, MUST BE INSTALLED IN THE SAME RACEWAY, OR CABLE, OR OTHERWISE RUN WITH THE PV ARRAY CIRCUIT CONDUCTORS WHEN THEY LEAVE THE VICINITY OF THE PV ARRAY.</li> <li>WHERE METALLIC CONDUIT CONTAINING DC CONDUCTORS IS USED INSIDE THE BUILDING, IT SHALL BE IDENTIFIED AS "CAUTION: SOLAR CIRCUIT" EVERY 10FT.</li> <li>HEIGHT OF THE AC DISCONNECT SHALL NOT EXCEED 6'-7" PER NEC CODE 240.24.</li> </ol>	VICI VICI VIIIISTOT-Saleri Point Point Project Site PROJECT SITE PROJECT SITE PROJECT SITE CODE F 2018 NORTH CAROLIN 2018 NORTH CAROLIN 2018 NORTH CAROLIN 2017 NATIONAL ELECT

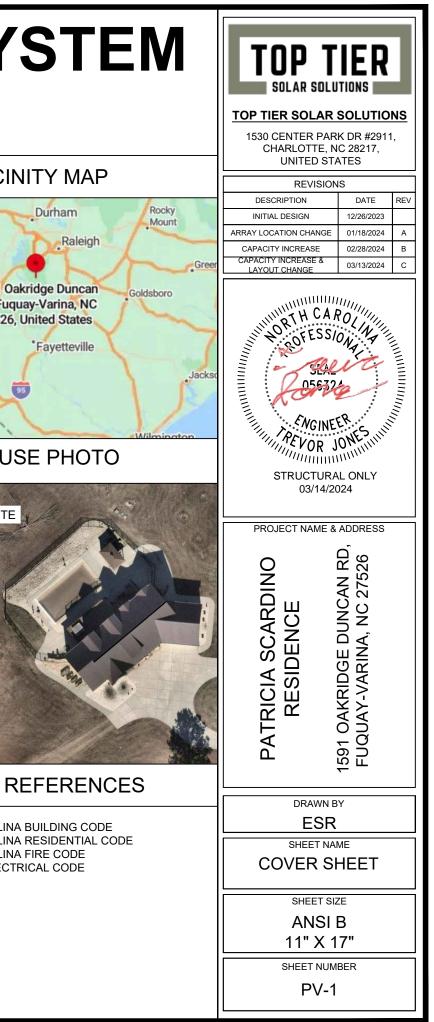

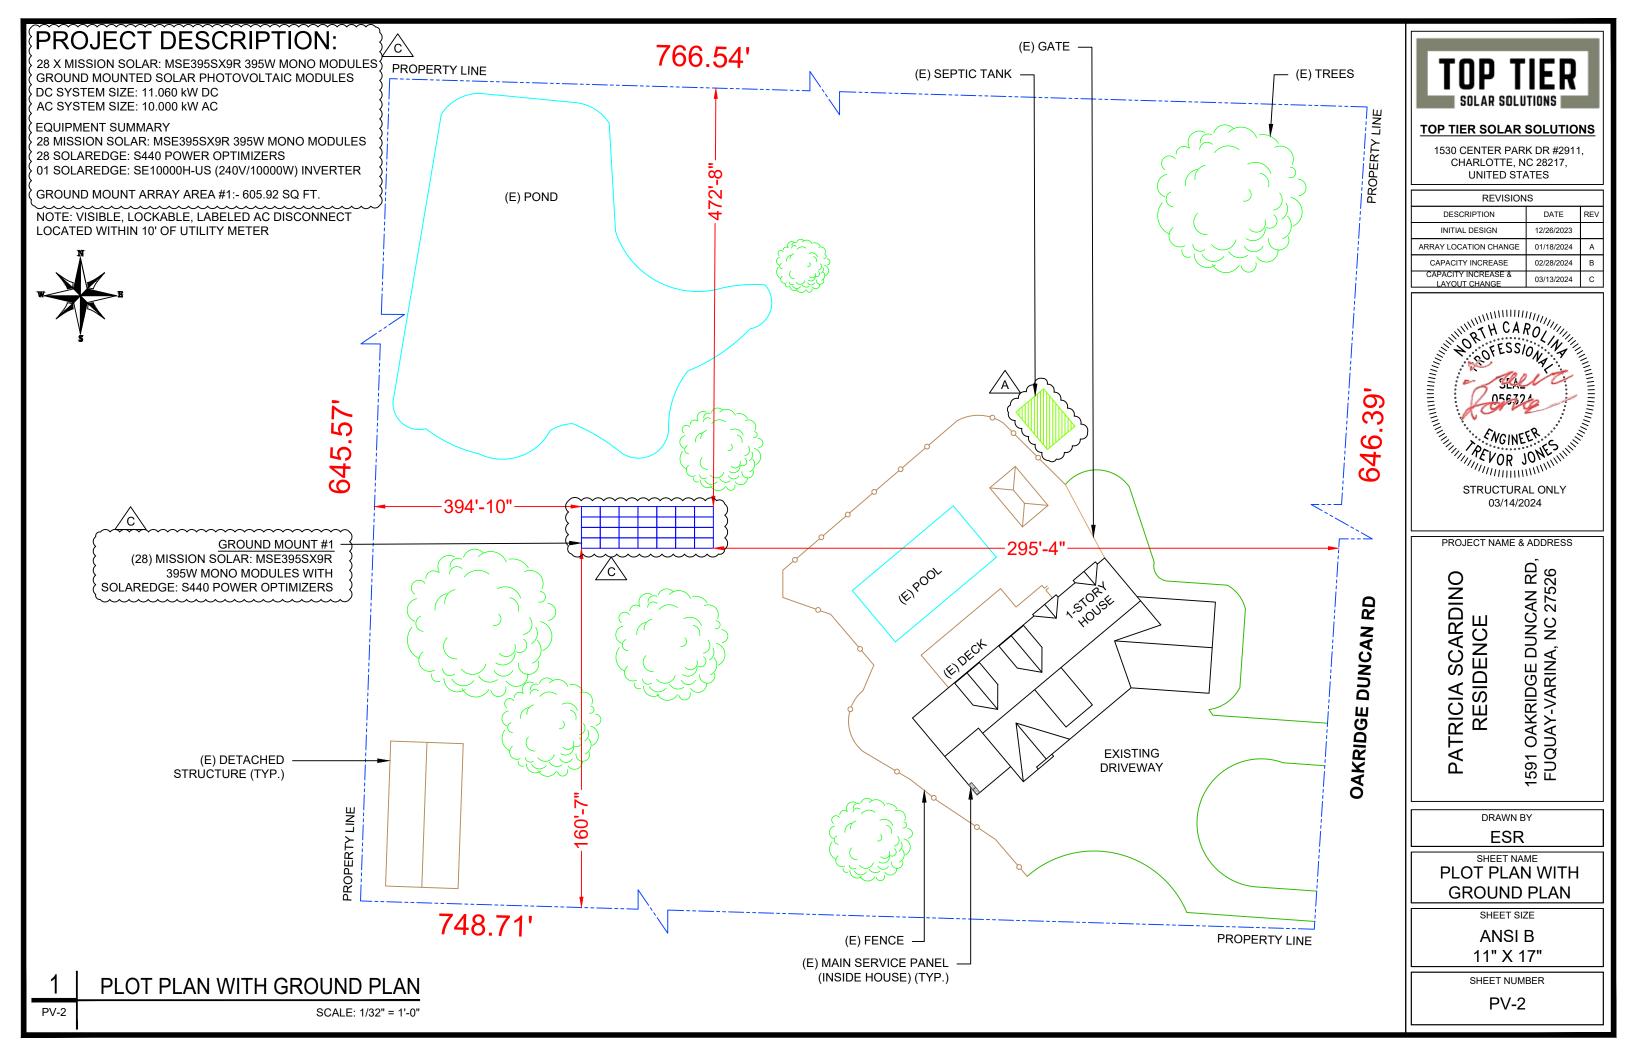

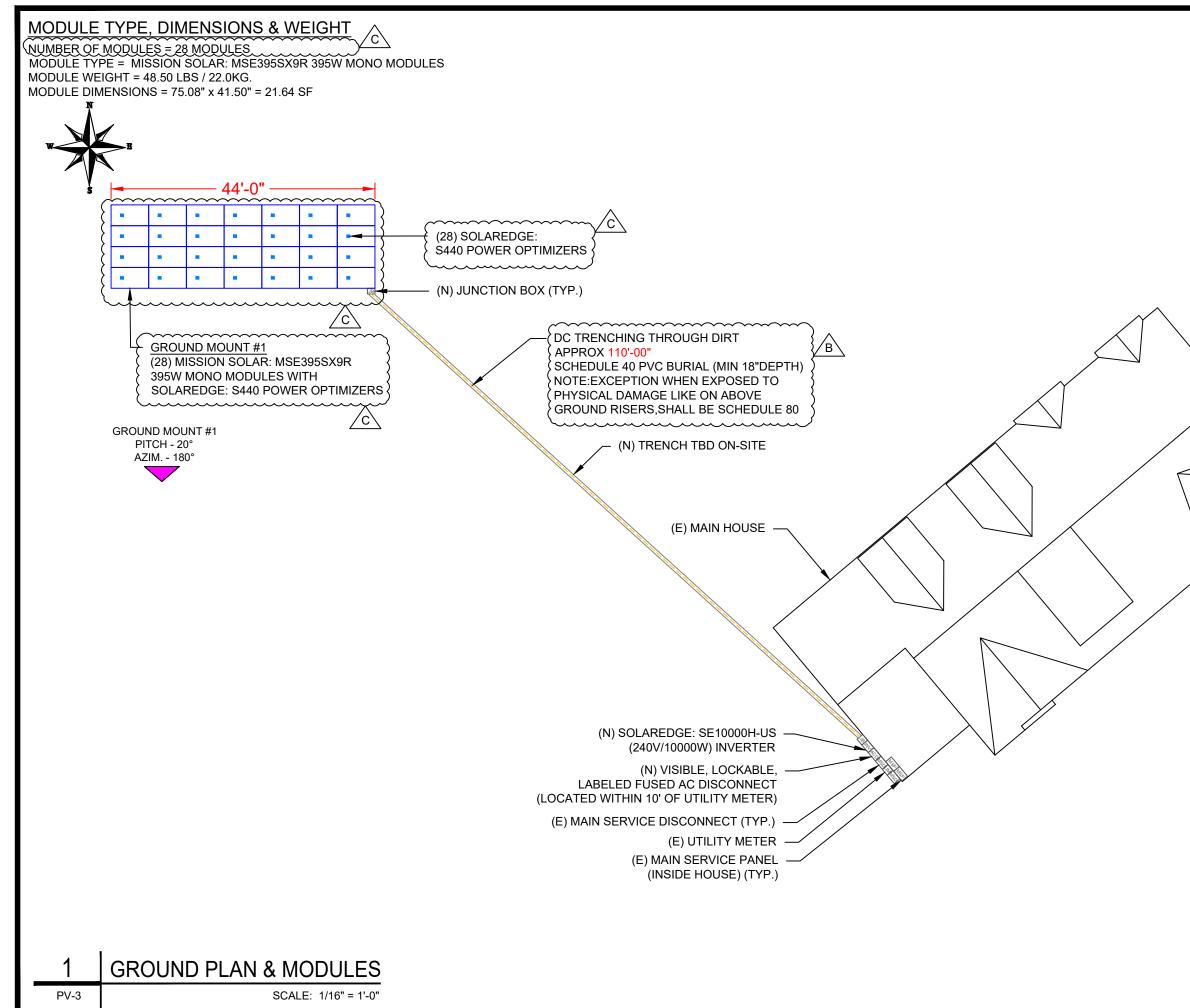

	TOP TIER SOLAR SOLUTIONS           DISTOR SOLUTIONS           TOP TIER SOLAR SOLUTIONS           1530 CENTER PARK DR #2911, CHARLOTTE, NC 28217, UNITED STATES           REVISIONS           DESCRIPTION           DATE           REVISIONS           DESCRIPTION           ARRAY LOCATION CHANGE           01/18/2024           CAPACITY INCREASE           02/28/2024           B           CAPACITY INCREASE & 03/13/2024
	MGINEER SCALAR S
41.50" 41.50" 80.52 MISSION SOLAR: MSE395SX9R 395W MODULES	PATRICIA SCARDINO RESIDENCE 1591 OAKRIDGE DUNCAN RI FUQUAY-VARINA, NC 27526
LEGEND	DRAWN BY ESR
ACD - AC DISCONNECT	SHEET NAME
	GROUND PLAN & MODULES
UM - UTILITY METER	SHEET SIZE
MSP - MAIN SERVICE PANEL	ANSI B
JB - JUNCTION BOX	11" X 17"
CONDUIT	PV-3
-	


STRING LEGENDS

----- STRING #1 STRING #2



Bill of Materials		
Part	Spares	Total Qty
Rails		
XR-1000-204A XR1000, Rail 204" Clear	0	14
Clamps & Grounding		
UFO-CL-01-A1 Universal Module Clamp, Clear	0	70
UFO-STP-40MM-M1 Stopper Sleeve, 40MM, Mill	0	28
XR-LUG-03-A1 Grounding Lug, Low Profile	0	1
Substructure		
70-0300-SGA SGA Top Cap at 3"	0	10
GM-BRC3-01-M1 Ground Mount Bonded Rail Connector - 3"	0	28

QTY 28
28
20
28
01
2
1
-

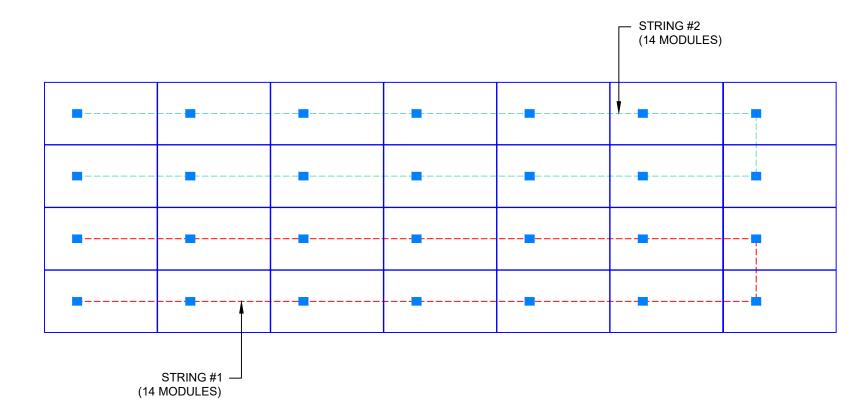





#### TOP TIER SOLAR SOLUTIONS

1530 CENTER PARK DR #2911, CHARLOTTE, NC 28217, UNITED STATES

REVISION	IS	_
DESCRIPTION	DATE	REV
INITIAL DESIGN	12/26/2023	
ARRAY LOCATION CHANGE	01/18/2024	А
CAPACITY INCREASE	02/28/2024	В
CAPACITY INCREASE & LAYOUT CHANGE	03/13/2024	С

 $\triangle$ 

PROJECT NAME & ADDRESS

PATRICIA SCARDINO RESIDENCE

1591 OAKRIDGE DUNCAN RD, FUQUAY-VARINA, NC 27526

DRAWN BY ESR


SHEET NAME


ELECTRICAL PLAN

SHEET SIZE ANSI B

11" X 17"

SHEET NUMBER

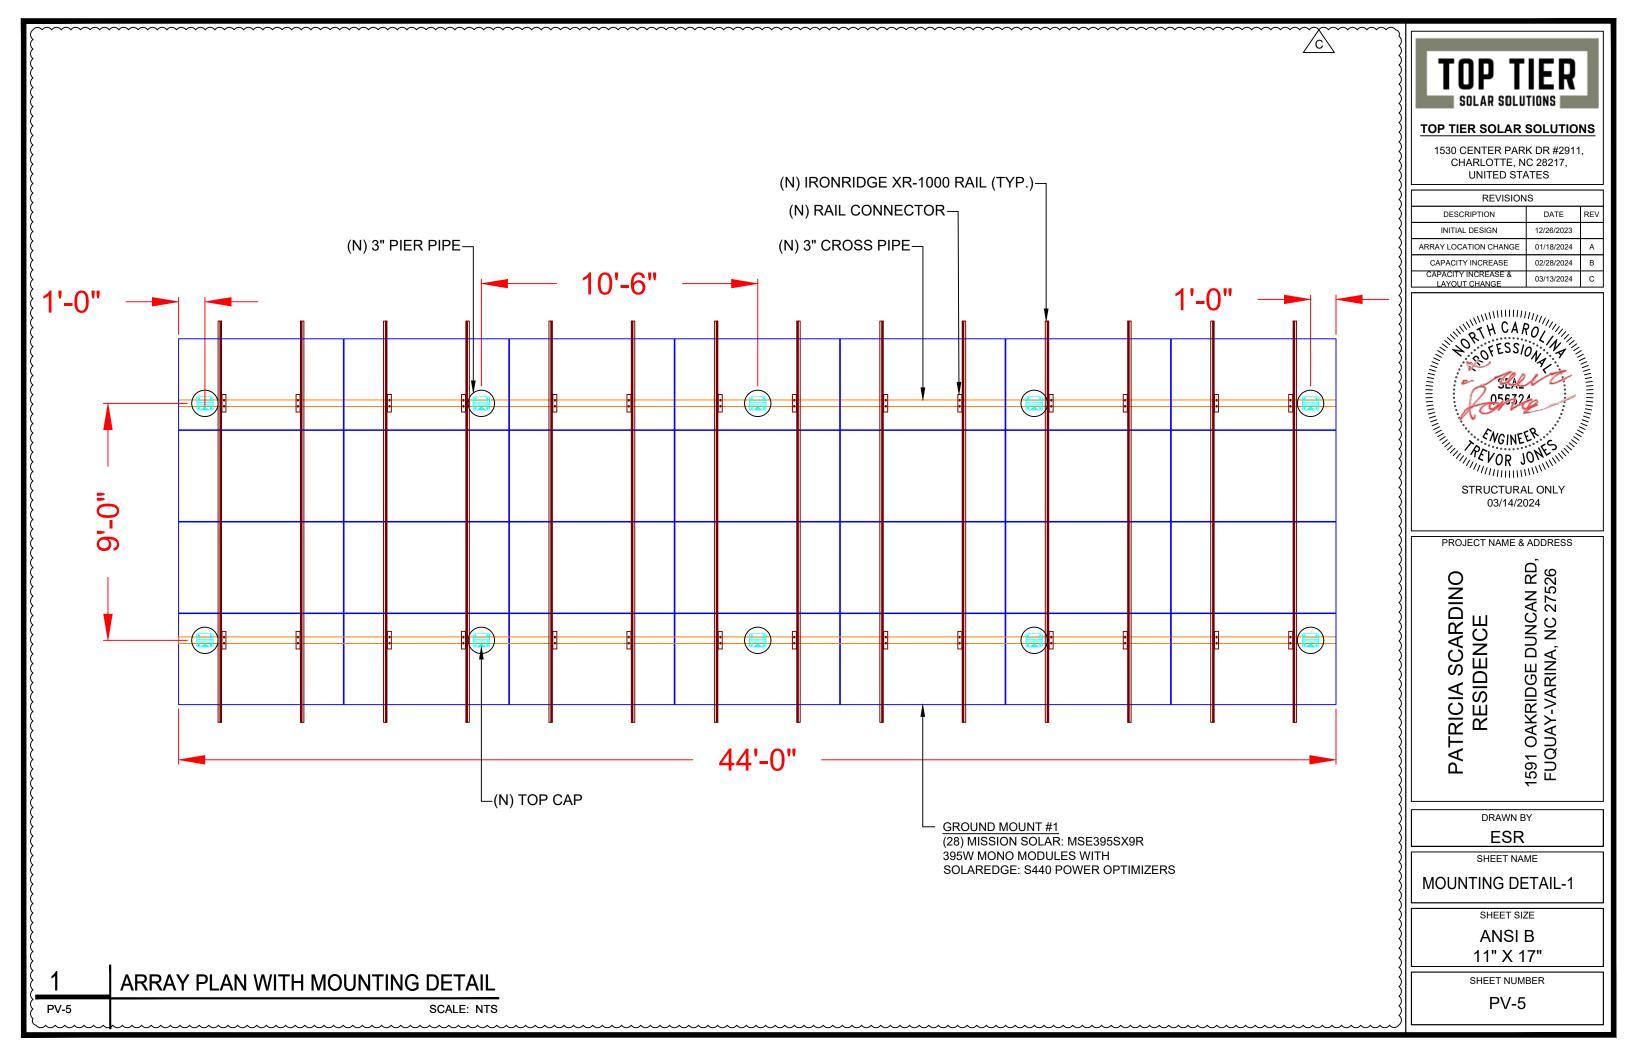


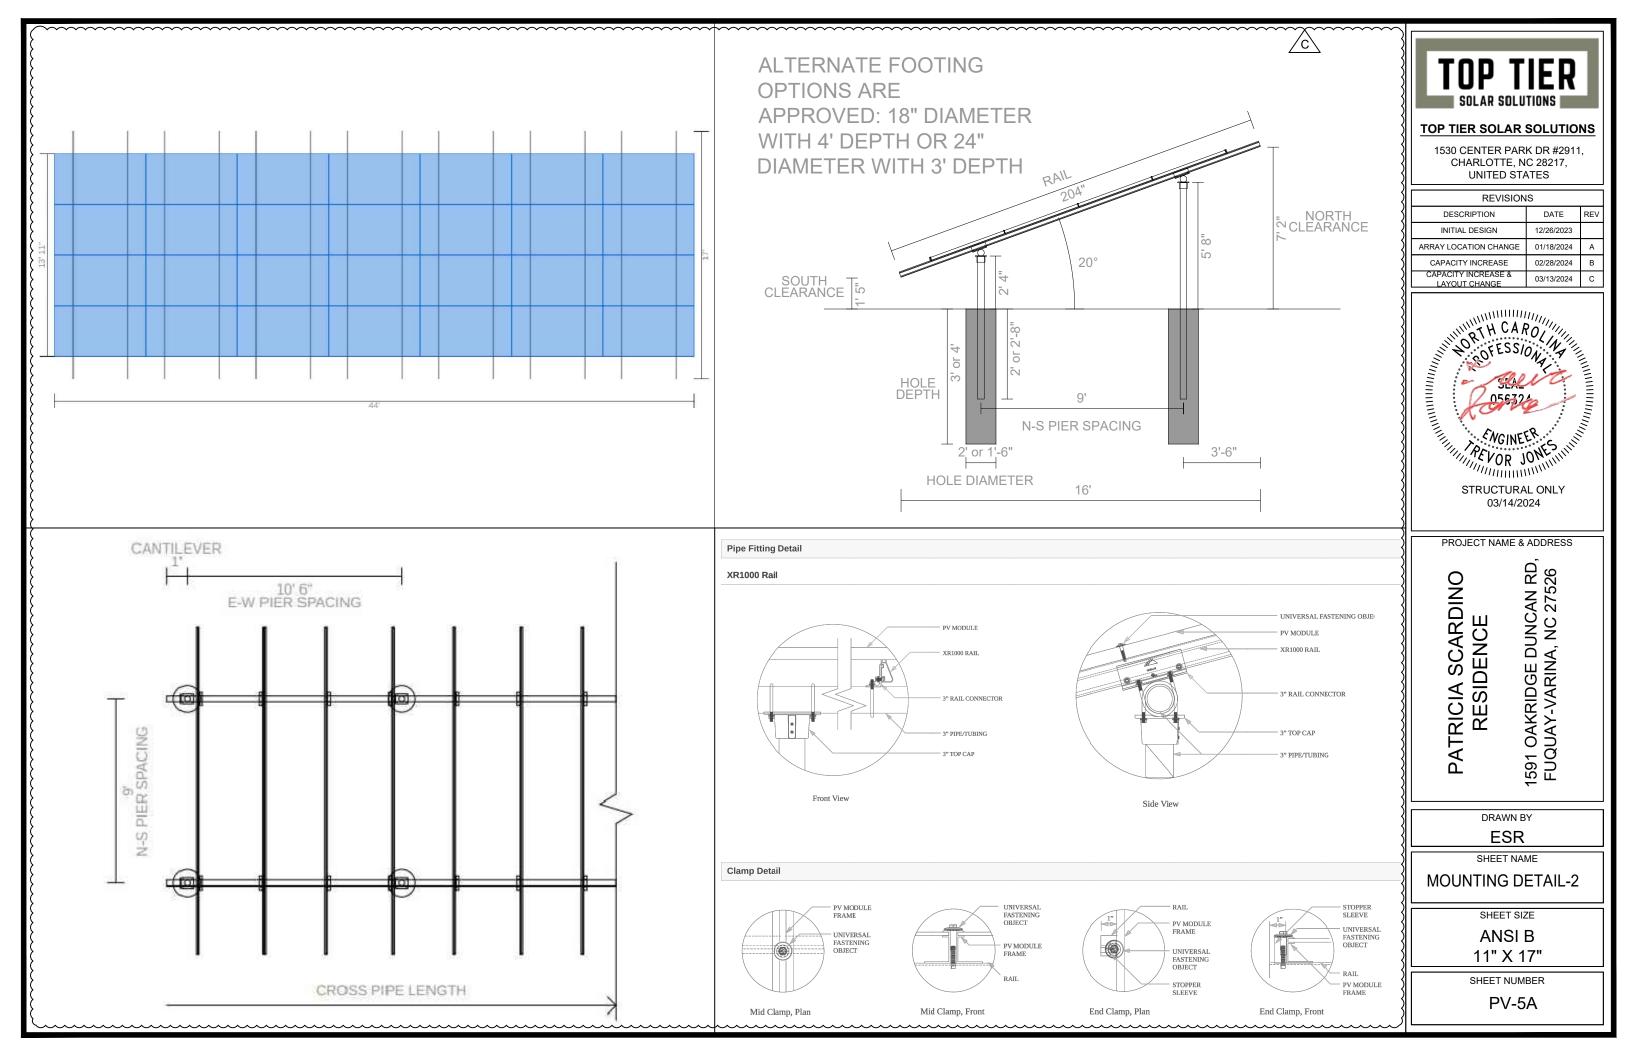

WITH (28) SOLAREDGE: S440 POWER OPTIMIZERS LOCATED UNDER EACH PANEL (240V) AND (01) SOLAREDGE: SE10000H-US (240V/10000W) INVERTER



THE SWITCH IS OPENED THE CONDUCTORS REMAINING LIVE ARE CONNECTED TO THE TERMINALS MARKED "LINE SIDE" (TYPICALLY THE LIPPER TERMINALS)

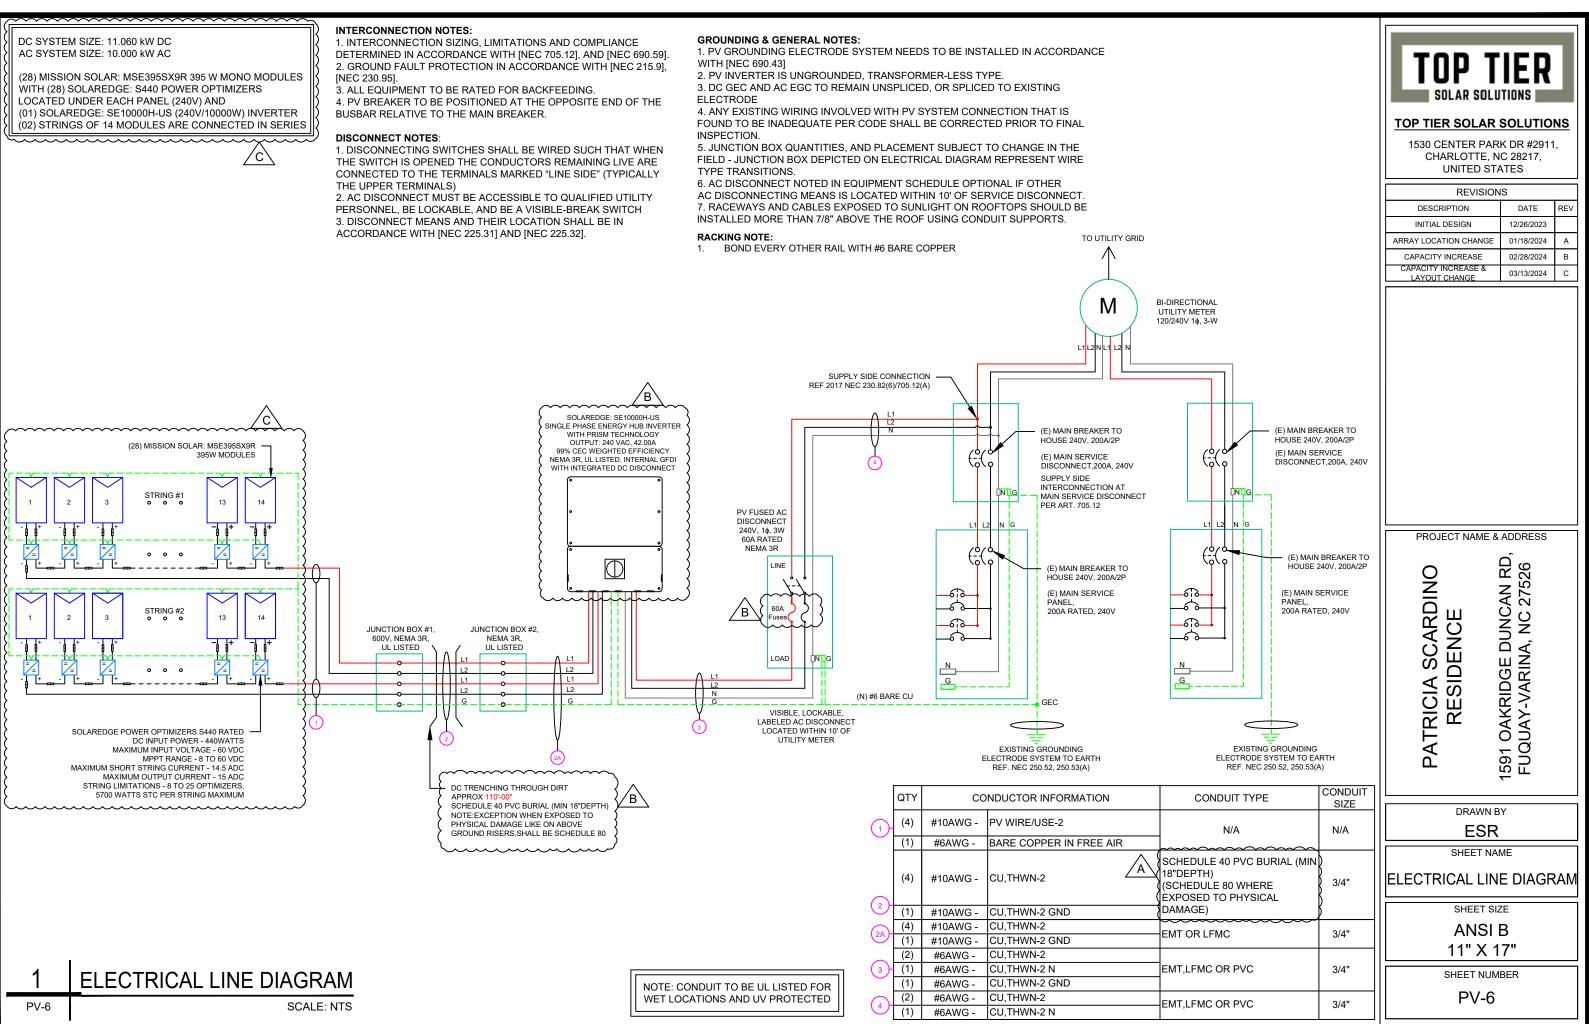


		(	~~~~~~~~~~~~~~~~~~~~~~~~~~~~~~~~~~~~~~~	~~~~~~~~~~~~~~~~~~~~~~~~~~~~~~~~~~~~~~~	~~~~~~~~~~~~~~~~~~~~~~~~~~~~~~~~~~~~~~~	~~~~~~~~~~~~~~~~~~~~~~~~~~~~~~~~~~~~~~~	、 、		
SOLAR N	- {		INVERTER	R SPECIFICATIONS		5	AMBIENT TEMPERATURE SPECS	S	
MANUEACTURER / MODEL #	MISSION SOLAR: MSE395SX9R 395W MODULE		MANUFACTURER /	MODEL #	SOLAREDGE: SE10000H-US (240V/10000W) INVERTER			RECORD LOW TEMP AMBIENT TEMP (HIGH TEMP 2%)	-12° 37°
			NOMINAL AC POW	ER	10.000 kW		5	MODULE TEMPERATURE COEFFICIENT OF Voc	-0.259%/°C
		(	NOMINAL OUTPUT VOLTAGE		240 VAC				
VMP	36.99V	- \	NOMINAL OUTPUT CURRENT		42.00A		{		
IMP	10.68A						)		
VOC	45.18V		PERCENT OF	NUMBE	R OF CURRENT				
ISC	11.24A		VALUES	CARRYING C	ONDUCTORS IN EMT				
TEMP. COEFF. VOC	-0.259%/°C		.80		4-6				
			.70		7-9	1			
MODULE DIMENSION	75.08"L x 41.50"W x 1.57"D (In Inch)		.50		10-20				

<pre>&gt;</pre>									DC	FEEDER CALC	CULATIONS							
	CIRCUIT DESTINATION	VOLTAGE (V)	FULL LOAD AMPS "FLA" (A)	FI A*1.25	OCPD SIZE (A)	GROUND SIZE	CONDUCTOR SIZE	75°C AMPACITY (A)	AMPACITY CHECK #1	AMBIENT TEMP. (°C)	TOTAL CC CONDUCT ORS IN RACEWAY	AMPACITY (A)	FOR AMBIENT	DERATION FACTOR FOR CONDUCTORS PER RACEWAY NEC 310.15(B)(3)(a)	90°C AMPACITY DERATED (A)	AMPACITY CHECK #2	FEEDER LENGTH (FEET)	CON RES (OH
STRING 1	JUNCTION BOX#1	380	15.00	18.75	20	BARE COPPER #6 AWG	CU #10 AWG	35	PASS	37	2	40	0.91	1	36.4	PASS	5	
STRING 2	JUNCTION BOX#1	380	15.00	18.75	20	BARE COPPER #6 AWG	CU #10 AWG	35	PASS	37	2	40	0.91	1	36.4	PASS	5	
JUNCTION BOX#1	JUNCTION BOX#2	380	15.00	18.75	20	CU #10 AWG	CU #10 AWG	35	PASS	37	4	40	0.91	0.8	29.12	PASS	110	
JUNCTION BOX#2	INVERTER	380	15.00	18.75	20	CU #10 AWG	CU #10 AWG	35	PASS	37	4	40	0.91	0.8	29.12	PASS	5	
<pre>}</pre>																	String 1 V	oltag

{										AC FEEDER		INS							
	CIRCUIT DESTINATION	VOLTAGE (V)	FULL LOAD AMPS "FLA" (A)	FLA*1.25 (A)	OCPD SIZE (A)	NEUTRAL SIZE	GROUND SIZE	CONDUCTOR SIZE	75°C AMPACITY (A)	AMPACITY CHECK #1	AMBIENT TEMP. (°C)	TOTAL CC CONDUCTORS IN RACEWAY	90°C AMPACITY (A)	FOR AMBIENT	DERATION FACTOR FOR CONDUCTORS PER RACEWAY NEC 310.15(B)(3)(a)	AMPACITY	AMPACITY CHECK #2	FEEDER LENGTH (FEET)	Γ
INVERTER	AC DISCONNECT	240	42	52.5	60	CU #6 AWG	CU #6 AWG	CU #6 AWG	65	PASS	37	2	75	0.91	1	68.25	PASS	5	
AC DISCONNECT	POI	240	42	52.5	60	CU #6 AWG	N/A	CU #6 AWG	65	PASS	37	2	75	0.91	1	68.25	PASS	5	
{							-											CUMULATIVE	٤V

#### ELECTRICAL NOTES

- 1. ALL EQUIPMENT TO BE LISTED BY UL OR OTHER NRTL, AND LABELED FOR ITS APPLICATION.
- 2. ALL CONDUCTORS SHALL BE COPPER, RATED FOR 600 V AND 90 DEGREE C WET ENVIRONMENT.
- 3. WIRING, CONDUIT, AND RACEWAYS MOUNTED ON GROUNDTOPS SHALL BE ROUTED DIRECTLY TO, AND LOCATED AS CLOSE AS POSSIBLE TO THE NEAREST RIDGE, HIP, OR VALLEY.
- 4. WORKING CLEARANCES AROUND ALL NEW AND EXISTING ELECTRICAL EQUIPMENT SHALL COMPLY WITH NEC 110.26.
- 5. DRAWINGS INDICATE THE GENERAL ARRANGEMENT OF SYSTEMS. CONTRACTOR SHALL FURNISH ALL NECESSARY OUTLETS, SUPPORTS, FITTINGS AND ACCESSORIES TO FULFILL APPLICABLE CODES AND STANDARDS.
- 6. WHERE SIZES OF JUNCTION BOX, RACEWAYS, AND CONDUITS ARE NOT SPECIFIED, THE CONTRACTOR SHALL SIZE THEM ACCORDINGLY.
- 7. ALL WIRE TERMINATIONS SHALL BE APPROPRIATELY LABELED AND READILY VISIBLE.
- 8. MODULE GROUNDING CLIPS TO BE INSTALLED BETWEEN MODULE FRAME AND MODULE SUPPORT RAIL, PER THE GROUNDING CLIP MANUFACTURER'S INSTRUCTION.
- 9. MODULE SUPPORT RAIL TO BE BONDED TO CONTINUOUS COPPER G.E.C. VIA WEEB LUG OR ILSCO GBL-4DBT LAY-IN LUG.
- 10. TEMPERATURE RATINGS OF ALL CONDUCTORS, TERMINATIONS, BREAKERS, OR OTHER DEVICES ASSOCIATED WITH THE SOLAR PV SYSTEM SHALL BE RATED FOR AT LEAST 75 DEGREE C.

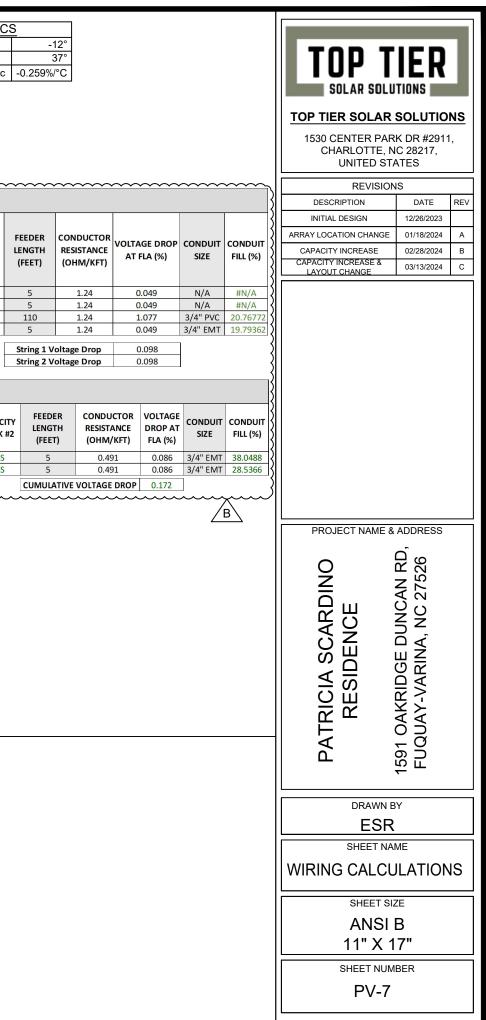

#### PHOTOVOLTAIC POWER SOURCE

#### EVERY 10' ON CONDUIT & ENCLOSURES

LABEL- 1: LABEL LOCATION: EMT/CONDUIT RACEWAY SOLADECK / JUNCTION BOX CODE REF: NEC 690.31 (D)(2)

#### 

#### **ELECTRIC SHOCK HAZARD**

TERMINALS ON THE LINE AND LOAD SIDES MAY BE ENERGIZED IN THE OPEN POSITION

LABEL- 2: LABEL LOCATION: AC DISCONNECT CODE REF: NEC 690.13(B)

#### 

#### **DUAL POWER SUPPLY**

SOURCE: UTILITY GRID AND PV SOLAR ELECTRIC SYSTEM

#### LABEL- 3: LABEL LOCATION: MAIN SERVICE PANEL CODE REF: NEC 705.12(C) & NEC 690.59

#### SOLAR PV BREAKER:


#### BREAKER IS BACKFED DO NOT RELOCATE

LABEL-4: LABEL LOCATION: MAIN SERVICE PANEL CODE REF: NEC 705.12(C) & NEC 690.59



LABEL LOCATION: MAIN SERVICE PANEL (ONLY IF SOLAR IS BACK-FED) SUBPANEL (ONLY IF SOLAR IS BACK-FED) CODE REF: NEC 705.12(B)(3)(2)

#### SOLAR PV SYSTEM EQUIPPED WITH RAPID SHUTDOWN

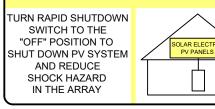

LABEL- 6: LABEL LOCATION: AC DISCONNECT CODE REF: [NEC 690.56(C)(1)(A)]

### **RAPID SHUTDOWN SWITCH** FOR SOLAR PV SYSTEM

LABEL- 7: LABEL LOCATION: AC DISCONNECT MAIN SERVICE PANEL (ONLY IF SOLAR IS BACK-FED) CODE REF: NEC 690.56(C)(2)

#### DC DISCONNECT

LABEL- 8: LABEL LOCATION: INVERTER CODE REF: NEC 690.13(B)

AC DISCONNECT	
PHOTOVOLTAIC SYS POWER SOURCE	TEM
NOMINAL OPERATING AC VOLATGE	240 V
RATED AC OUTPUT CURRENT	42.00 A
LABEL- 9: LABEL LOCATION: AC DISCONNECT CODE REF: NEC 690.54	
MAXIMUM VOLTAGE	480 V
MAXIMUM CIRCUIT CURRENT	30.00 A
MAXIMUM RATED OUTPUT CURRENT OF THE CHARGE CONTROLLER OR DC-TO-DC CONVERTER (IF INSTALLED)	
ABEL- 10: ABEL LOCATION: DN THE RIGHT SIDE OF THE INVERTER CODE REF: NEC 690.53	(PRE-EXISTING ON THE INVERTER)



#### TOP TIER SOLAR SOLUTIONS

1530 CENTER PARK DR #2911, CHARLOTTE, NC 28217, UNITED STATES

REVISION	IS	_
DESCRIPTION	DATE	REV
INITIAL DESIGN	12/26/2023	
ARRAY LOCATION CHANGE	01/18/2024	А
CAPACITY INCREASE	02/28/2024	В
CAPACITY INCREASE & LAYOUT CHANGE	03/13/2024	С

PROJECT NA	ME & ADDRESS
PATRICIA SCARDINO RESIDENCE	1591 OAKRIDGE DUNCAN RD, FUQUAY-VARINA, NC 27526
DRA	WN BY
E	SR
SHEE	T NAME
LAB	ELS
SHEE	ET SIZE
AN	SI B
11"	X 17"
SHEET	NUMBER

#### MSE PERC 66

MISSION SOL





#### FRAME-TO-FRAME WARRANTY

Degradation guaranteed not to exceed 2% in year one and 0.58% annually from years two to 30 with 84.08% capacity guaranteed in year 25. For more information, visit www.missionsolar.com/warranty

#### CERTIFICATIONS



C-SA2-MKTG-0027 REV 4 03/18/2022

If you have questions or concerns about certification of our products in your area, please contact Mission Solar Energy.

# True American Quality True American Brand

Mission Solar Energy is headquartered in San Antonio, Texas where we manufacture our modules. We produce American, high-quality solar modules ensuring the highest-in-class power output and best-in-class reliability. Our product line is tailored for residential, commercial and utility applications. Every Mission Solar Energy solar module is certified and surpasses industry standard regulations, proving excellent performance over the long term.

#### Demand the best. Demand Mission Solar Energy.

#### Certified Reliability

- Tested to UL 61730 & IEC Standards
- PID resistant Resistance to salt mist corrosion

#### Advanced Technology


- 9 Busbar
- Passivated Emitter Rear Contact Ideal for all applications


#### **Extreme Weather Resilience**

- Up to 5,400 Pa front load & 3,600 Pa back load
- Tested load to UL 61730
- 40 mm frame

#### BAA Compliant for Government Projects


- Buy American Act American Recovery & Reinvestment Act

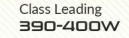

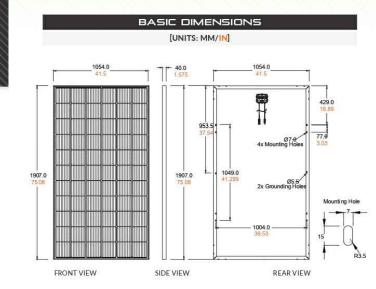


#### CURRENT-VOLTAGE CURVE

MSE3855X9R: 385WP, 66 CELL SOLAR MODULE

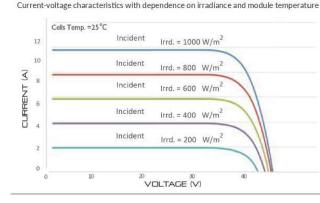

#### CERTIFICATIONS AND TESTS IEC 61215, 61730, 61701

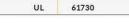



#### Mission Solar Energy 8303 S. New Braunfels Ave., San Antonio, Texas 78235 www.missionsolar.com | info@missionsolar.com

Mission Solar Energy reserves the right to make specification changes without notice. C-SA2-MKTG-0027 REV 4 03/18/2022

#### ELECTRICAL SPECIFICATION PRODUCT TYPE MSEX Power Output Module Efficiency Tolerance Short Circuit Current Open Circuit Voltage Rated Current Rated Voltage Fuse Rating System Voltage

Normal Operating Cell Tempera Temperature Coeffi Temperature Coef Temperature Coe

. 1	
1	Maximum System Voltage
	Operating Temperature Range
	Maximum Series Fuse Rating
	Fire Safety Classification
	Front & Back Load (UL Standard)

Hail Safety Impact Velocity 25mm at 23 m/s

M	
Solar Cells	P-type m
Cell Orientation	66 cells (d
Module Dimension	1,907mm
Weight	48.5 lbs.
Front Glass	3.2mm te
Frame	40mm Ar
Encapsulant	Ethylene
Junction Box	Protectio
Cable	1.2m, Wi
Connector	Staubli PV MC4. Rer

S	HIPPING	INFOR		N
Container Feet	Ship To	Pallet	Panels	390W Bin
53'	Most States	30	780	304.20 kW
Double Stack	CA	26	676	263.64 kW
	PALLE	T [26 PAN	IELS]	
Weight 1,300 lbs. (572 kg)	Height 47.56 in (120.80 cm	) (1	Width 46 in 16.84 cm)	Length 77 in (195.58 cm

www.missionsolar.com | info@missionsolar.com





## MSE PERC 66

××SX	9R ( <mark>×××</mark> = P	max)	
Wp	390	395	400
%	19.4	19.7	19.9
%	0/+3	0/+3	0/+3
А	11.19	11.24	11.31
V	45.04	45.18	45.33
А	10.63	10.68	10.79
V	36.68	36.99	37.07
А	20	20	20
V	1,000	1,000	1,000

#### TEMPERATURE COEFFICIENTS

ature (NOCT)	43.75°C (±3.7%)
cient of Pmax	-0.367%/°C
ficient of Voc	-0.259%/°C
efficient of Isc	0.033%/°C

#### OPERATING CONDITIONS

- 1.000Vdd
- -40°F to 185°F (-40°C to +85°C)
- 20A
- Type 1\*
- Up to 5,400 Pa front and 3,600 Pa back load. Tested to UL 61730
- \*Mission Solar Energy uses quality sourced materials that result in a Type 1 fire rating Please note, the 'Fire Class' Rating is designated for the fully-installed PV system, which includes, but is not limited to, the module, the type of mounting used, pitch and roof composition.

#### 

- nono-crystalline silicon
- (6x11)
- n x 1,054mm x 40mm
- . (22 kg)
- empered, low-iron, anti-reflective
- nodized
- vinyl acetate (EVA)
- on class IP67 with 3 bypass-diodes
- ire 4mm2 (12AWG)
- V-KBT4/6II-UR and PV-KST4/6II-UR, Renhe 05-8

www.missionsolar.com | info@missionsolar.com



#### TOP TIER SOLAR SOLUTIONS

1530 CENTER PARK DR #2911, CHARLOTTE, NC 28217, UNITED STATES

REVISIONS				
DESCRIPTION	DATE	REV		
INITIAL DESIGN	12/26/2023			
ARRAY LOCATION CHANGE	01/18/2024	А		
CAPACITY INCREASE	02/28/2024	В		
CAPACITY INCREASE & LAYOUT CHANGE	03/13/2024	С		

#### **PROJECT NAME & ADDRESS**

SCARDINO PATRICIA SCARE RESIDENCE

591 OAKRIDGE DUNCAN RD FUQUAY-VARINA, NC 27526

DRAWN BY

ESR

SHEET NAME EQUIPMENT SPECIFICATION

SHEET SIZE

ANSI B 11" X 17"

SHEET NUMBER

CERTIFICA	TE OF COMPLIANCE
Certificate Number Report Reference Date	E364743 E364743-20201208 2021-August-04
Issued to:	Mission Solar Energy LLC 8303 S New Braunfels Ave San Antonio TX, 78235 US
This is to certify that representative samples of	PHOTO VOLTAIC MODULES AND PANELS WITH SYSTEM VOLTAGE RATINGS OVER 600 VOLTS See Addendum Page for Product Designation(s).
	Have been investigated by UL in accordance with the Standard(s) indicated on this Certificate.
Standard(s) for Safety:	UL 61730-1, Photovoltaic (PV) Module Safety Qualification - Part 1: Requirements for Construction
	UL 61730-2, Photovoltaic (PV) Module Safety Qualification - Part 2: Requirements for Testing
	CSA C22.2 No. 61730-2:2019, Photovoltaic (PV) Module Safety Qualification - Part 2: Requirements for Testing
Additional Information:	See the UL Online Certifications Directory at

https://ig.ulprospector.com for additional information

This Certificate of Compliance does not provide authorization to apply the UL Mark. Only the UL Follow-Up Services Procedure provides authorization to apply the UL Mark.

Only those products bearing the UL Mark should be considered as being UL Certified and covered under UL's Follow-Up Services.

Look for the UL Certification Mark on the product.

Bamely

ioan Carlitication Program III LIC

Any information and documentation involving UL Mark cervices are provided on behalf of ULLLC (UL) or any authorized licences of UL. For que clons, pleace contro ta local UL Curchemer Bervice Representative at <u>http://www.aum.abou/bul/constoncy</u>

# CERTIFICATE OF COMPLIANCE

Certificate Number **Report Reference** Date

E364743 E364743-20201208 2021-August-04

This is to certify that representative samples of the product as specified on this certificate were tested according to the current UL requirements

Photovoltaic Modules and Panels with System Voltage Ratings Over 600 Volts (QIIA) Models:

Model	Where XXX is wattage
MSEXXXSX6S, may be followed by -IV	where XXX is 405-425
MSEXXXSX6W, may be followed by -IV	where XXX is 405-425
MSEXXXSX6Z, may be followed by -IV	where XXX is 405-425
MSEXXXSX5R, may be followed by -IV	where XXX is 375-390
MSEXXXSX5K, may be followed by -IV	where XXX is 335-355
MSEXXXSX5T, may be followed by-IV	where XXX is 330-350
MSEXXXSX9W, may be followed by -IV	where XXX is 420-440
MSEXXXSX9Z, may be followed by -IV	where XXX is 415-435
MSEXXXSX9R , may be followed by -IV	where XXX is 380-400
MSEXXXSX9K, may be followed by -IV	where XXX is 345-365
MSEXXXSX9T, may be followed by -IV	where XXX is 340-360

-IV indicates Type 4 module

Bamely an Carliloation Program Any information and documentation involving UL Mark cervices are provided on behalf of UL LLC (UL) or any authorized licence of UL. Porque clond, pleace contractal coal UL Curchmer Bervice Representative at <u>http://ul.com/aboutul/location.c/</u>







#### TOP TIER SOLAR SOLUTIONS

1530 CENTER PARK DR #2911, CHARLOTTE, NC 28217, UNITED STATES

REVISIONS				
DESCRIPTION	DATE	REV		
INITIAL DESIGN	12/26/2023			
ARRAY LOCATION CHANGE	01/18/2024	А		
CAPACITY INCREASE	02/28/2024	В		
CAPACITY INCREASE & LAYOUT CHANGE	03/13/2024	С		

#### **PROJECT NAME & ADDRESS**

PATRICIA SCARDINO RESIDENCE

1591 OAKRIDGE DUNCAN RD FUQUAY-VARINA, NC 27526

DRAWN BY

ESR

SHEET NAME EQUIPMENT **SPECIFICATION** 

SHEET SIZE

ANSI B

11" X 17"

SHEET NUMBER

# **Power Optimizer** For Residential Installations

## S440, S500



# POWER $\bigcirc$ PTIMIZ フ

#### Enabling PV power optimization at the module level

- Specifically designed to work with SolarEdge residential inverters
- Detects abnormal PV connector behavior, preventing potential safety issues\*
- / Module-level voltage shutdown for installer and firefighter safety
- Superior efficiency (99.5%)

- / Mitigates all types of module mismatch loss, from manufacturing tolerance to partial shading
- Faster installations with simplified cable management and easy assembly using a single bolt
- / Flexible system design for maximum space utilization
- Compatible with bifacial PV modules


#### **/** Power Optimizer For Residential Installations S440, S500

	S440	S500	UNI
Rated Input DC Power <sup>(1)</sup>	440	500	W
Absolute Maximum Input Voltage (Voc)	60		Vdd
MPPT Operating Range	8 - 60		Vdd
Maximum Short Circuit Current (Isc) of Connected PV Module	14.5	15	Ado
Maximum Efficiency	99.5		%
Weighted Efficiency	98.6		%
Overvoltage Category	Π		
OUTPUT DURING OPERATION			
Maximum Output Current	15		Ade
Maximum Output Voltage	60		
OUTPUT DURING STANDBY (POWER OPTIMIZER DIS	CONNECTED FROM INVERTER OR IN	VERTER OFF)	
Safety Output Voltage per Power Optimizer	1		Vd
STANDARD COMPLIANCE			
EMC	FCC Part 15 Class B, IEC61000-6-2, IEC	61000-6-3, CISPR11, EN-55011	
Safety	IEC62109-1 (class II sa	fety), UL1741	
Material	UL94 V-0, UV R	esistant	
RoHS	Yes		
Fire Safety	VDE-AR-E 2100-712:2013-05		
INSTALLATION SPECIFICATIONS			
Maximum Allowed System Voltage	1000		Vd
Dimensions (W x L x H)	129 x 155 x	30	mn
Weight (including cables)	655 / 1.5		gr /
Input Connector	MC4 <sup>(2)</sup>		
Input Wire Length	0.1		m
Output Connector	MC4		
Output Wire Length	(+) 2.3, (-) 0.10		m
Operating Temperature Range <sup>(3)</sup>	-40 to +8	5	°C
Protection Rating	IP68 / NEMA	16P	
Relative Humidity	0 - 100		%

(3) For ambient temperature above +70°C / +158°F power de-rating is applied. Refer to Power Optimizers Temperature De-Rating Technical Note for more details

PV System Design Using a SolarEdge Inverter		Single Phase HD-Wave	Three Phase	Three Phase for 277/480V Grid	
Minimum String Length (Power Optimizers)	S440, S500	8	16	18	
Maximum String Length (Power	Optimizers)	25	50		
Maximum Nominal Power per S	String <sup>(4)</sup>	5700	11250(5)	12750(6)	W
Parallel Strings of Different Leng	yths or Orientations		Yes		

(4) If the inverters rated AC power ≤ maximum nominal power per string, then the maximum power per string will be able to reach up to the inverters maximum input DC power Refer to: https://www.solaredge.com/sites/default/files/se-power-optimizer-single-string-design-application-note.pdf
 (5) For the 230/400V grid: its allowed to install up to 13,500W per string when the maximum power difference between each string is 2,000W
 (6) For the 277/480V grid: its allowed to install up to 13,500W per string when the maximum power difference between each string is 2,000W
 (7) It is not allowed to mix S-series and P-series Power Optimizers in new installations

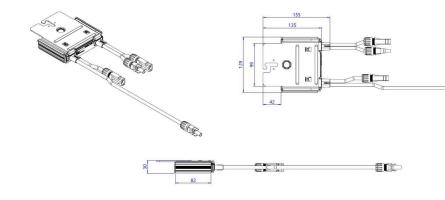

\* Functionality subject to inverter model and firmware version



© SolarEdge Technologies, Inc. All rights reserved. SOLAREDGE, the SolarEdge logo, OPTIMIZED BY SOLAREDGE are trademarks or register All other trademarks mentioned herein are trademarks of their respective owners. Date: 12/2021 DS-000091-1.2-ENG. Subject to change wi

solaredge.com

Epo

CE RoHS



#### TOP TIER SOLAR SOLUTIONS

1530 CENTER PARK DR #2911, CHARLOTTE, NC 28217, UNITED STATES

REVISIONS				
DESCRIPTION	DATE	REV		
INITIAL DESIGN	12/26/2023			
ARRAY LOCATION CHANGE	01/18/2024	А		
CAPACITY INCREASE	02/28/2024	В		
CAPACITY INCREASE & LAYOUT CHANGE	03/13/2024	С		

#### **PROJECT NAME & ADDRESS**

PATRICIA SCARDINO RESIDENCE

1591 OAKRIDGE DUNCAN RD FUQUAY-VARINA, NC 27526

DRAWN BY

ESR

SHEET NAME EQUIPMENT SPECIFICATION

SHEET SIZE

ANSI B 11" X 17"

SHEET NUMBER

# SolarEdge Home Hub Inverter

#### For North America

SE3800H-US / SE5700H-US / SE6000H-US / SE7600H-US / SE10000H-US / SE11400H-US<sup>(1)</sup>



# HOME BACKUF

#### Optimized battery storage with HD-Wave technology

- Record-breaking 99% weighted efficiency with 200% DC oversizing
- Small, lightweight, and easy to install
- Modular design, future ready with optional upgrades to:
- I DC-coupled storage for full or partial home backup
- Built-in consumption monitoring
- Direct connection to the SolarEdge Home EV Charger

- Multi-inverter, scalable storage solution, with 1 enhanced battery power up to 10kW
- Integrated arc fault protection and rapid shutdown for NEC 2014 – 2023, per article 690.11 and 690.12
- I Embedded revenue grade production data, ANSI C12.20 Class 0.5

# **/** SolarEdge Home Hub Inverter For North America

SE3800H-US / SE5700H-US / SE6000H-US / SE7600H-US / SE10000H-US / SE11400H-US<sup>(1)</sup>

SEXXXXH-USMNBBXXX / SEXXXXH-USSNB				
SE3800H-US	SE5700H-US	SE6000H-US	SE7600H-US	
3800 @ 240V 3300 @ 208V	5760 @ 240V 5000 @ 208V	6000 @ 240V 5000 @ 208V	7600	
3800 @ 240V 3300 @ 208V	5760 @ 240V 5000 @ 208V	6000 @ 240V 5000 @ 208V	7600	
			/ 240	
		183 -	- 264	_
		59.3 - 60	0 – 60.5 <sup>(2)</sup>	
16	24	25	32	Γ
16	24	24	-	Γ
			1	
		<	3	_
		1, adjustable	-0.85 to 0.85	
		V	es	
		15		
		<	2.5	
7600	5760	6000	7600 11400*	
		211 -	- 264	
		105 -	- 132	_
		55 - 6	60 - 65	
22	24		32	Г
32	24	25	47.5	ſ
			1	
		<	5	
RGER AC				
		96	500	7
		211 -	- 264	_
				-
		2	40	
		Y	es	
		4	80	
		3	80	
		Y	es	
		600kΩ S	ensitivity	
7600	11520	12000	15200	Γ
6600	10000	10000	L.	r
20	16	16.5	20	
9	13.5	13.5	- 30	+
3	1.5	1000 500		-
		/		
			15 9 2	
			9.2	
	3300 @ 208V 3800 @ 240V 3300 @ 208V 16 16 16 16 16 16 16 16 16 16	3300 @ 208V     5000 @ 208V       3800 @ 240V     5760 @ 240V       3300 @ 208V     5000 @ 208V       16     24       16     24       16     24       16     24       7600     5760       32     24       32     24       32     24       32     24       7600     5760       9     9       9	3300 @ 208V         5000 @ 208V         5000 @ 208V           3800 @ 240V         5760 @ 240V         5000 @ 208V         5000 @ 208V           3300 @ 208V         5000 @ 208V         5000 @ 208V         5000 @ 208V           3300 @ 208V         5000 @ 208V         5000 @ 208V         5000 @ 208V           183	3300 @ 208V         5000 @ 208V         5000 @ 208V         7600           3800 @ 208V         5760 @ 240V         5000 @ 208V         5000 @ 208V         7600           3300 @ 208V         5000 @ 208V         5000 @ 208V         5000 @ 208V         7600           183 - 264         59.3 - 60 - 60.5 <sup>[2]</sup> 183 - 264         -         1           16         24         25         32         1           16         24         24         -         -           16         24         24         -         -           16         24         24         -         -           16         24         24         -         -           -         -         1         -         -           -         -         -0.85 to 0.85         -         -           7600         5760         6000         7600         11400*           11-264         25         32         -         -           7600         5760         6000         211 - 264         -           32         24         25         32         -           32         24         25         32         - <t< td=""></t<>

Supported with PN SExxxxH-USMNxxxxx

These specifications apply to inverters with part numbers SExxxxH-USMNxxxxx or SExxxxH-USSNxxxxx and connection unit model number DCD-1PH-US-PxH-F-x. (2) For other regional settings please contact SolarEdge support.

(3) Not designed for standalone applications and requires AC for commissioning. Backup functionality is only supported for 240V grid.
(4) Rated AC power in Backup Operation is valid for installations with multiple inverters. For a single backup inverter operation, rated AC power in Backup is 90% of the value stated.


(5) A higher current source may be used; the inverter will limit its input current to the values stated



solaredge.com

′B`

xx		
E10000H-US	SE11400H-US	Units
10000	11400 @ 240V 10000 @ 208V	W
10000	11400 @ 240V 10000 @ 208	W
		Vac
		Vac
42	47.5	Hz A
-	47.5	A
	40	A
		%
		W
10000	11400	W
11400*		
		Vac
		Vac Hz
42 47.5	47.5	A
47.5		A
		%
		W
		Vac
		Hz
		Aac
		Vdc
		Vdc
20000	22800	w
-	20000	W
30	30	Adc
=	27	Adc
		%
	99 @ 240V 98.5 @ 208V	%

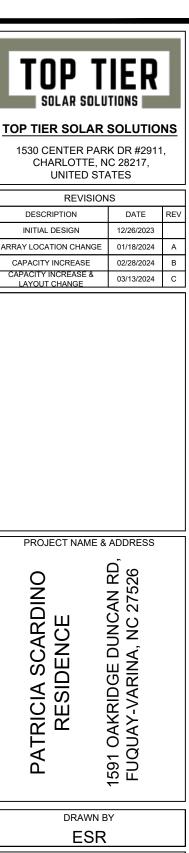

SHEET NAME EQUIPMENT **SPECIFICATION** SHEET SIZE

ANSI B 11" X 17"

SHEET NUMBER

# / SolarEdge Home Hub Inverter For North America

SE3800H-US / SE5700H-US / SE6000H-US / SE7600H-US / SE10000H-US / SE11400H-US<sup>(1)</sup>


Applicable to inverters with part number	SEXXXXH-USMNBBXXX / SEXXXXH-USSNBBXXX						
	SE3800H-US	SE5700H-US	SE6000H-US	SE7600H-US	SE10000H-US	SE11400H-US	Units
OUTPUT – DC (BATTERY)							
Supported Battery Types		SolarEdge Home Battery, LG RESU Prime					
Number of Batteries per Inverter		Up to 3 SolarEdge Home Battery, up to 2 LG RESU Prime					
Continuous Power <sup>(6)</sup>	7600 @ 240V 3800 @ 208V	5760 @ 240V 5000 @ 208V	6000	11400		11400 @ 240V 10000 @ 208V	W
Peak Power <sup>(6)</sup>	7600 @ 240V 3800 @ 208V	5760 @ 240V 5000 @ 208V	6000	11/00		11400 @ 240V 10000 @ 208V	W
Max Input Current	20			26.5			Adc
2-pole Disconnection	Up to inverter rated backup power						
SMART ENERGY CAPABILITIES							
Consumption Metering		Built-in <sup>(7)</sup>					
Backup & Battery Storage	Wit	With Backup Interface (purchased separately) for service up to 200A; up to 3 inverters					
EV Charging	Direct connection to SolarEdge Home EV Charger						
ADDITIONAL FEATURES							
Supported Communication Interfaces		RS485, Ethernet, Cellular <sup>(8, 9)</sup> , Wi-Fi <sup>(9)</sup> , SolarEdge Home Network					
Revenue Grade Metering, ANSI C12.20		Built-in <sup>(7)</sup>					
Integrated AC, DC and Communication Connection Unit		Yes					
Inverter Commissioning	With	With the SetApp mobile application using built-in Wi-Fi Access Point for local connection					
DC Voltage Rapid Shutdown (PV and Battery)		Yes, accordi	ng to NEC 2014 – 2	023 per article 690.	11 and 690.12		
STANDARD COMPLIANCE							
Safety	1	UL1741, UL1741 SA, UL1741 SB, UL1741 PCS, UL1699B, UL1998, UL9540, CSA 22.2					
Grid Connection Standards	IEEE1547-2018, Rule 21, Rule 14H, CSA C22.3 No. 9						
Emissions	FCC part 15 class B						
INSTALLATION SPECIFICATIONS							
AC Output and EV AC Output Conduit Size / AWG Range		1" maximum / 14-4 AWG					
DC Input (PV and Battery) Conduit Size / AWG Range	1" maximum / 14-6 AWG						
Dimensions with Connection Unit (H x W x D)	17.7 x	14.6 x 6.8 / 450 x 37	0 x 174	17.7 x 14.6 x 6.8 / 450 x 370 x 174** 21.06 x 14.6 x 8.2	21.06 x 14.6 x 7.3 / 535 x 370 x 185** / 535 x 370 x 208***	21.06 x 14.6 x 8.2 / 535 x 370 x 208***	in / mm
Weight with Connection Unit			30.8 / 14**	41.7 / 18.9**			
	30.8/14 44.9/20.3*** 44.9/20.3***					lb / kg	
Noise	< 50				dBA		
Cooling	Natural Convection						
Operating Temperature Range	-40 to +140 / -40 to +60 <sup>(10)</sup>			°F/°C			
Protection Rating	NEMA 4X						

\*\* Supported with PN SEXXXXH-USSNBBXX4 or SEXXXXH-USMNBBXX4.

\*\*\* Supported with PN SEXXXXH-USSNBBXX5 or SEXXXXH-USMNBBXX5.

Supported with PN SEXXXH-USSNBBXX5 or SEXXXH-USSNBBXX5.
 Discharge power is limited up to the inverter rated AC power for on-grid and backup applications, as well as up to the installed batteries' rating.
 For consumption metering current transformers should be ordered separately. SECT-SPL-225A-T-20 or SEACT0750-400NA-20 units per box. Revenue grade metering is only for production metering.
 Information concerning the Data Plan's terms & conditions is available in the following link: <u>SolarEdge Communication Plan Terms and Conditions</u>.
 The part number SEXXXH-USXNBBXXX only supports the Wi-Fi communication interface, and the part number SEXXXH-USXNBLXX only supports the cellular communication interface.

(10) Full power up to at least 50°C / 122°F; for power de-rating information refer to the Temperature Derating Technical Note for North America

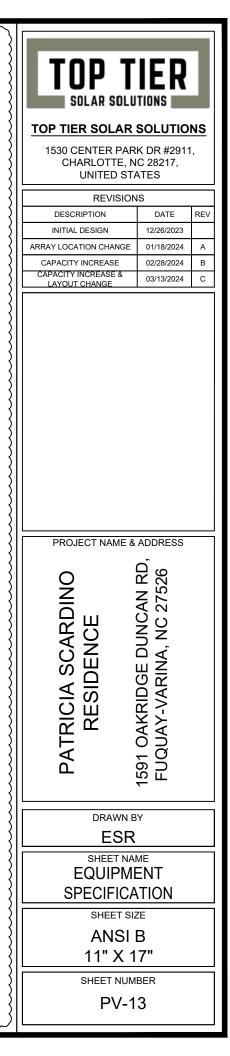

∕в∖



Solar Is Not Always Sunny

enough to buckle a panel frame.

these results. They resist uplift, protect against buckling and safely and efficiently

transfer loads into the building structure.

Their superior spanning capability

requires fewer roof attachments, reducing the number of roof

Over their lifetime, solar panels experience countless extreme weather events. Not just the worst storms in years, but the worst storms in 40 years. High winds capable of ripping panels from a roof, and snowfalls weighing

XR Rails are the structural backbone preventing



#### **XR Rail Family**

#### **XR Rail Family**

The XR Rail Family offers the strength of a curved rail in three targeted sizes. Each size supports specific design loads, while minimizing material costs. Depending on your location, there is an XR Rail to match.





XR100

XR100 is the ultimate residential mounting rail. It supports a range of wind and snow conditions, while also maximizing spans up to 10 feet.

Clear & black anodized finish

Internal splices available

· 10' spanning capability

Heavy load capability

#### XR10 is a sleek, low-profile mounting rail, designed for regions with light or no snow. It achieves spans up to 6 feet, while remaining light and economical.


- 6' spanning capability
- Moderate load capability · Clear & black anodized finish
- Internal splices available

#### **Rail Selection**

The table below was prepared in compliance with applicable engineering codes and standards.\* Values are based on the following criteria: ASCE 7-16, Gable Roof Flush Mount, Roof Zones 1 & 2e, Exposure B, Roof Slope of 8 to 20 degrees and Mean Building Height of 30 ft. Visit IronRidge.com for detailed certification letters.

Lo	ad		Rail Span			
Snow (PSF)	Wind (MPH)	4'	5' 4"	6'	8'	
None	90					
	120					
	140	XR10		XR100		
	160					
	90					Γ
20	120					
	140					
	160					
	90					Γ
30	160					
10	90					Γ
40	160					
80	160					
120	160					

'Table is meant to be a simplified span chart for conveying general rail capabilities. Use approved certification letters for actual design guidance

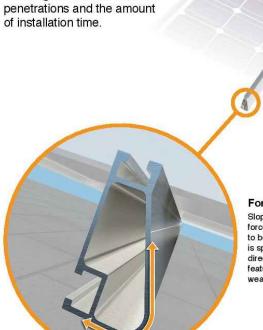

#### Force-Stabilizing Curve

Sloped roofs generate both vertical and lateral forces on mounting rails which can cause them to bend and twist. The curved shape of XR Rails is specially designed to increase strength in both directions while resisting the twisting. This unique feature ensures greater security during extreme weather and a longer system lifetime.

#### **Compatible with Flat & Pitched Roofs**






#### **Corrosion-Resistant Materials**

All XR Rails are made of 6000-series aluminum alloy, then protected with an anodized finish. Anodizing prevents surface and structural corrosion, while also providing a more attractive appearance.





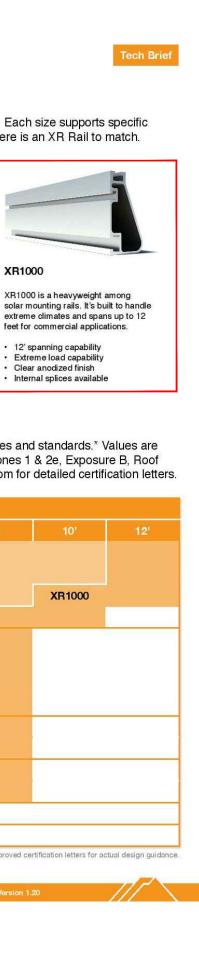

# TOP TIER SOLAR SOLUTION

#### TOP TIER SOLAR SOLUTIONS

1530 CENTER PARK DR #2911, CHARLOTTE, NC 28217, UNITED STATES

REVISIONS				
DESCRIPTION	DATE	REV		
INITIAL DESIGN	12/26/2023			
ARRAY LOCATION CHANGE	01/18/2024	А		
CAPACITY INCREASE	02/28/2024	В		
CAPACITY INCREASE & LAYOUT CHANGE	03/13/2024	С		

#### **PROJECT NAME & ADDRESS**

1591 OAKRIDGE DUNCAN RD FUQUAY-VARINA, NC 27526 PATRICIA SCARE RESIDENCE

SCARDINO

DRAWN BY

ESR

SHEET NAME EQUIPMENT SPECIFICATION

SHEET SIZE

ANSI B 11" X 17"

SHEET NUMBER



### Ground Mount System



#### Mount on all terrains, in no time.

The IronRidge Ground Mount System combines our XR1000 rails with locally-sourced steel pipes, or mechanical tubing, to create a cost-effective structure capable of handling any site or terrain challenge.


Installation is simple with only a few structural components and no drilling, welding, or heavy machinery required. In addition, the system works with a variety of foundation options, including concrete piers and driven piles.



**Rugged Construction** Engineered steel and aluminum components ensure durability.



Simple Assembly

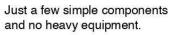



**Flexible Architecture** Multiple foundation and array configuration options.



PE Certified Pre-stamped engineering letters available in most states.









20 Year Warranty Twice the protection offered by competitors.

values and bill of materials.

Online tool generates engineering

