

# PHOTOVOLTAIC GROUND MOUNT SYSTEM

### 40 MODULES-GROUND MOUNTED - 19.200 kW DC, 23.000 kW AC

# 2184 WIRE RD, BUNNLEVEL, NC 28323

PROJECT DATA	GENERAL NOTES	VICI
PROJECT2184 WIRE RD, ADDRESSADDRESSBUNNLEVEL, NC 28323OWNER:TRAVIS BASSDESIGNER:ESRSCOPE: 19.200 KW DC GROUND MOUNT SOLAR PV SYSTEM WITH 40 HANWHA SOLAR: Q CELLS Q.PEAK DUO XL-G10.3/BFG 480W PV MODULES WITH 01 SOL-ARK 15K-LV INVERTER 01 SOL-ARK 8K-P INVERTER	<ol> <li>ALL COMPONENTS ARE UL LISTED AND CEC CERTIFIED, WHERE WARRANTED.</li> <li>THE SOLAR PV SYSTEM WILL BE INSTALLED IN ACCORDANCE WITH ARTICLE 690 OF THE NEC 2017.</li> <li>THE UTILITY INTERCONNECTION APPLICATION MUST BE APPROVED AND PV SYSTEM INSPECTED PRIOR TO PARALLEL OPERATION.</li> <li>ALL CONDUCTORS OF A CIRCUIT, INCLUDING THE EGC, MUST BE INSTALLED IN THE SAME RACEWAY, OR CABLE, OR OTHERWISE RUN WITH THE PV ARRAY CIRCUIT CONDUCTORS WHEN THEY LEAVE THE VICINITY OF THE PV ARRAY.</li> <li>WHERE METALLIC CONDUIT CONTAINING DC CONDUCTORS IS USED INSIDE THE BUILDING, IT SHALL BE IDENTIFIED AS "CAUTION: SOLAR CIRCUIT" EVERY 10FT.</li> <li>HEIGHT OF THE AC DISCONNECT SHALL NOT EXCEED 6'-7" PER NEC CODE 240.24.</li> <li>A GROUNDING ELECTRODE SYSTEM IN ACCORDANCE WITH CEC 690.47 AND 250.50 THROUGH 60 AND 250-166 SHALL BE PROVIDED. PER NEC GROUNDING ELECTRODE SYSTEM OF EXISTING BUILDING MAY BE USED AND BONDED TO THE SERVICE ENTRANCE. IF EXISTING SYSTEM IS INACCESSIBLE OR INADEQUATE A SUPPLEMENTAL GROUNDING ELECTRODE WILL BE USED AT THE INVERTER LOCATION CONSISTING OF A UL LISTED 8 FT. GROUND ROD WITH ACORN CLAMP. GROUNDING ELECTRODE WILL BE USED AT THE INVERTER LOCATION CONSISTING OF A UL LISTED 8 FT. GROUND ROD WITH ACORN CLAMP. GROUNDING ELECTRODE CONDUCTORS WICH HAM AND NO LARGER THAN #6 AWG COPPER AND BONDED TO THE EXISTING</li> </ol>	erson eek 2184 Wire Rd Bunnlevel, NC 28 United States
AUTHORITIES HAVING JURISDICTION: BUILDING: HARNETT COUNTY ZONING: HARNETT COUNTY UTILITY: DUKE ENERGY PROGRESS	<ol> <li>PHOTOVOLTAIC INSTALLATION WILL NOT OBSTRUCT ANY PLUMBING. MECHANICAL, OR BUILDING ROOF VENTS.</li> </ol>	HOU
SHEET INDEX         PV-1       COVER SHEET         PV-2       PLOT PLAN WITH GROUND PLAN         PV-3       GROUND PLAN & MODULES         PV-4       ELECTRICAL PLAN         PV-5       MOUNTING DETAIL-1         PV-6       ELECTRICAL LINE DIAGRAM         PV-7       WIRING CALCULATIONS         PV-8       LABELS         PV-9       PLACARD         PV-10+       EQUIPMENT SPECIFICATIONS	<ol> <li>ALL WIRING MUST BE PROPERLY SUPPORTED BY DEVICES OR MECHANICAL MEANS DESIGNED AND LISTED FOR SUCH USE. WIRING MUST BE PERMANENTLY AND COMPLETELY HELD OFF THE ROOF SURFACE.</li> <li>ALL SINAGE TO BE PLACED IN ACCORDANCE WITH THE LOCAL BUILDING CODE. IF EXPOSED TO SUNLIGHT, IT SHALL BE UV RESISTANT. ALL PLAQUES AND SINAGE WILL BE INSTALLED AS REQUIRED BY THE NEC AND AHJ.</li> <li>INVERTER(S) USED IN UNGROUNDED SYSTEM SHALL BE UL 1741 LISTED.</li> <li>THE INSTALLATION OF EQUIPMENT AND ALL ASSOCIATED WIRING AND INTERCONNECTION SHALL BE PERFORMED ONLY BY QUALIFIED PERSONS [NEC 690.4(C)]</li> <li>ALL OUTDOOR EQUIPMENT SHALL BE NEMA 3R RATED (OR BETTER), INCLUDING ALL ROOF MOUNTED TRANSITION BOXES AND SWITCHES.</li> <li>ALL EQUIPMENT SHALL BE PROPERLY GROUNDED AND BONDED IN ACCORDANCE WITH NEC ARTICLE 250.</li> <li>SYSTEM GROUNDING SHALL BE IN ACCORDANCE WITH NEC 690.41.</li> <li>PV SYSTEM CIRCUITS INSTALLED ON OR IN BUILDINGS SHALL INCLUDE A RAPID SHUTDOWN FUNCTION IN ACCORDANCE WITH NEC 690.12</li> </ol>	
SIGNATURE	<ol> <li>DISCONNECTING MEANS SHALL BE LOCATED IN A VISIBLE, READILY ACCESSIBLE LOCATION WITHIN THE PV SYSTEM EQUIPMENT OR A MAXIMUM OF 10 FEET AWAY FROM THE SYSTEM [NEC 690.13(A)]</li> <li>ALL WIRING METHODS SHALL BE IN ACCORDANCE WITH NEC 690.31</li> <li>WORK CLEARANCES AROUND ELECTRICAL EQUIPMENT WILL BE MAINTAINED PER NEC 110.26(A)(1), 110.26(A)(2) AND 110.26(A)(3).</li> <li>ROOFTOP MOUNTED PHOTOVOLTAIC PANELS AND MODULES SHALL BE TESTED, LISTED &amp; IDENTIFIED IN ACCORDANCE WITH UL1703</li> <li>ELECTRICAL CONTRACTOR TO PROVIDE CONDUIT EXPANSION JOINTS AND ANCHOR CONDUIT RUNS AS REQUIRED PER NEC.</li> </ol>	2018 NORTH CAROLIN 2018 NORTH CAROLIN 2018 NORTH CAROLIN 2017 NATIONAL ELECT

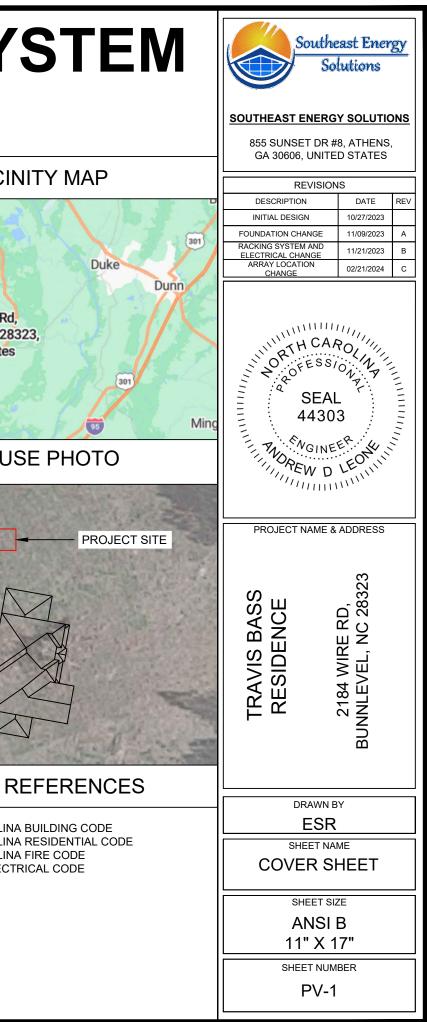

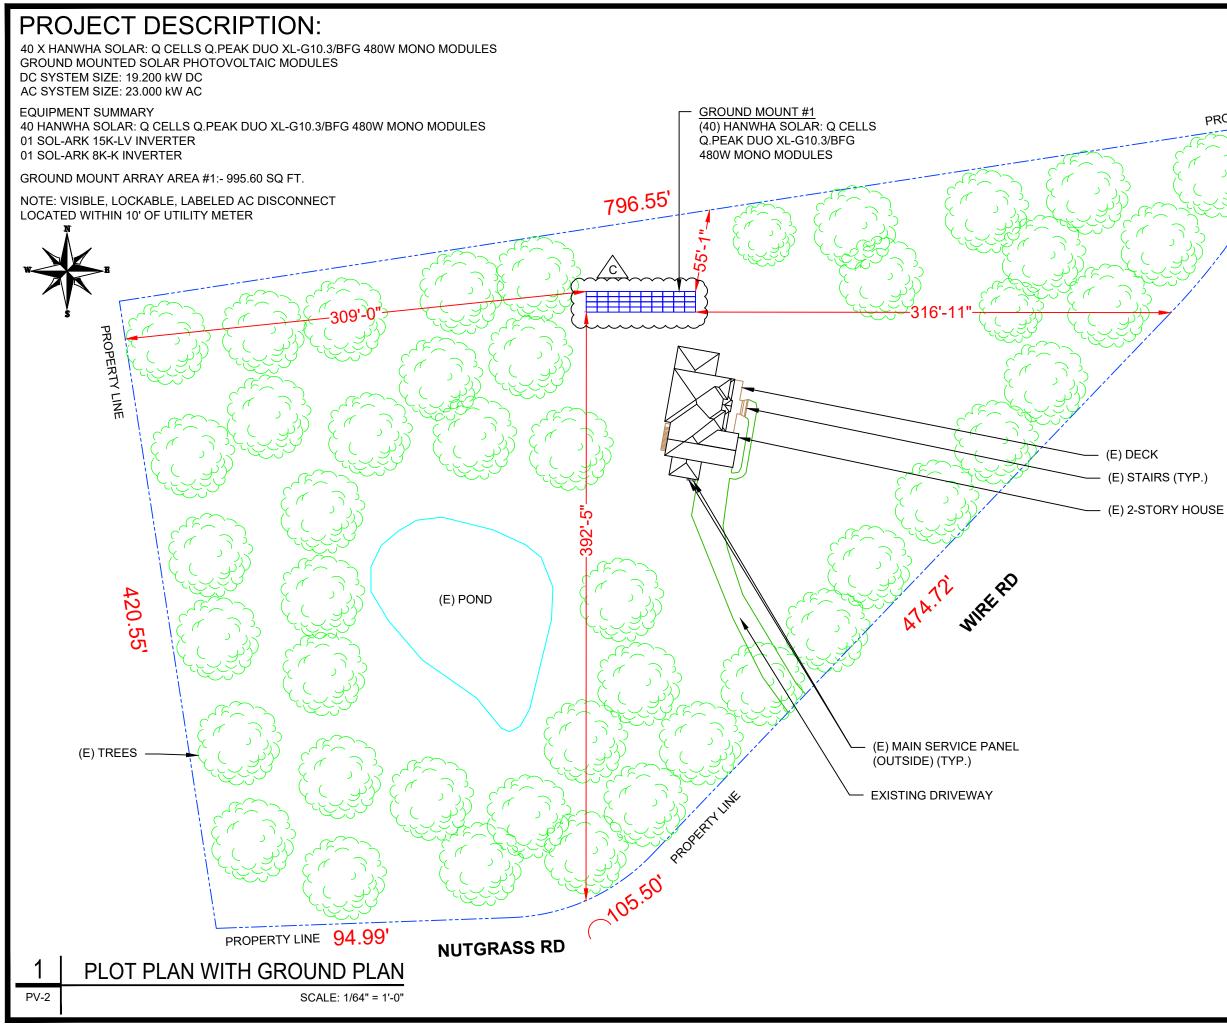



855 SUNSET DR #8, ATHENS, GA 30606, UNITED STATES

REVISION	IS	
DESCRIPTION	DATE	REV
INITIAL DESIGN	10/27/2023	
FOUNDATION CHANGE	11/09/2023	А
RACKING SYSTEM AND ELECTRICAL CHANGE	11/21/2023	В
ARRAY LOCATION CHANGE	02/21/2024	С



**PROJECT NAME & ADDRESS** 

TRAVIS BASS RESIDENCE

2184 WIRE RD, BUNNLEVEL, NC 28323



SHEET NAME PLOT PLAN WITH

**GROUND PLAN** SHEET SIZE ANSI B


11" X 17"

SHEET NUMBER PV-2

DRAWN BY

ESR

PROPERTY LINE .60.092

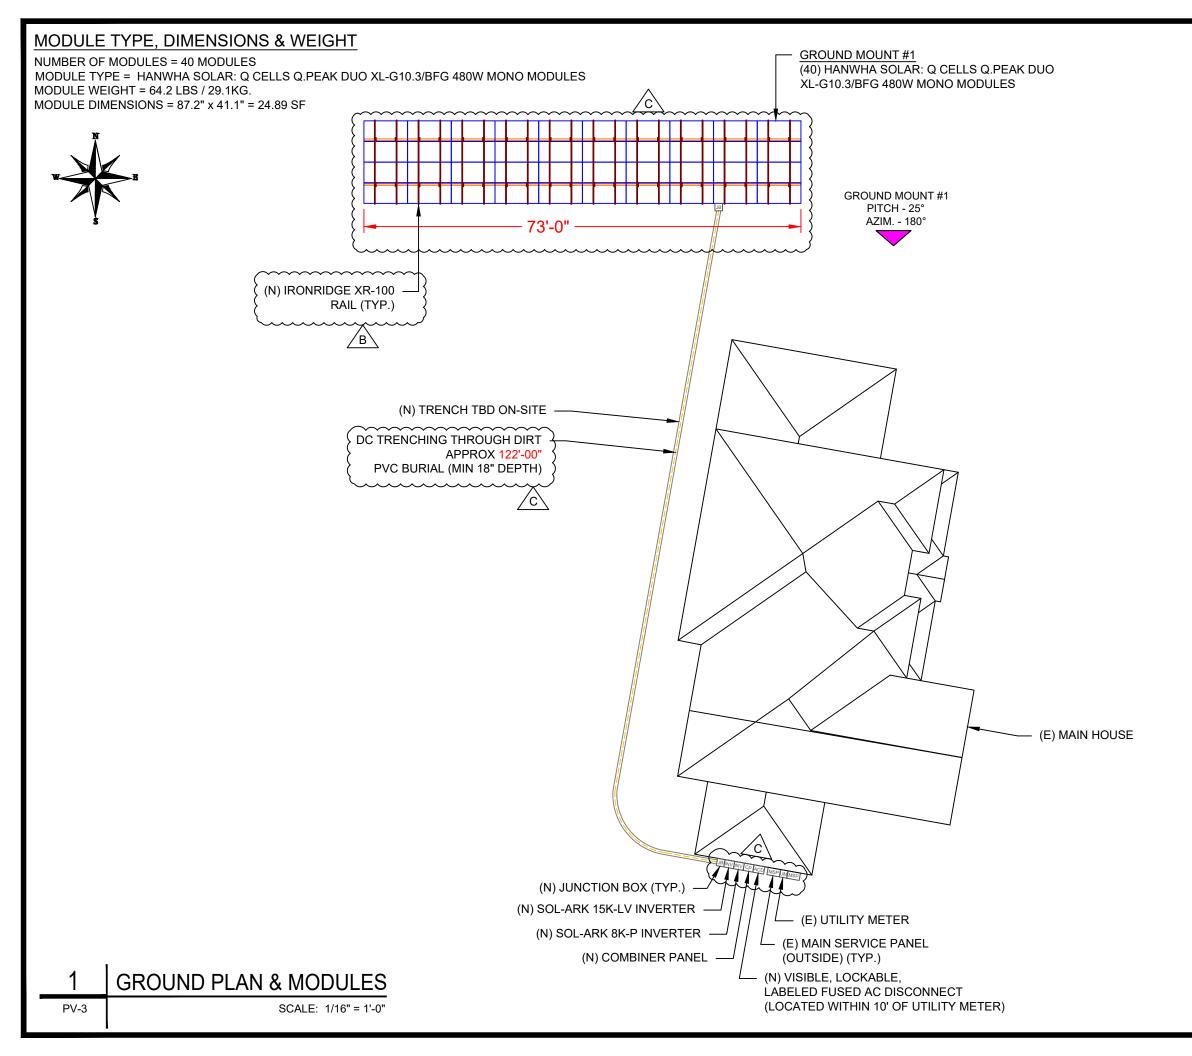



855 SUNSET DR #8, ATHENS, GA 30606, UNITED STATES

REVISION	IS	
DESCRIPTION	DATE	REV
INITIAL DESIGN	10/27/2023	
FOUNDATION CHANGE	11/09/2023	А
RACKING SYSTEM AND ELECTRICAL CHANGE	11/21/2023	В
ARRAY LOCATION CHANGE	02/21/2024	С



PROJECT NAME & ADDRESS

DRAWN BY

ESR

SHEET NAME

MODULES

SHEET SIZE

ANSI B

11" X 17"

SHEET NUMBER

PV-3

**GROUND PLAN &** 

TRAVIS BASS RESIDENCE 2184 WIRE RD, BUNNLEVEL, NC 28323

41.1" 2 87 HANWHA SOLAR: Q CELLS Q.PEAK DUO XL-G10.3/BFG 480W MODULES LEGEND - AC DISCONNECT ACD - INVERTER INV - UTILITY METER UM - SUBPANEL SUB - MAIN SERVICE PANEL MSP

- JUNCTION BOX
- CONDUIT

JB

- TRENCH


{	STRING LEGENDS				BILL OF MAT
Ş	STRING #1/INV#1		~~~~~~~~~~~~~~~~~~~~~~~~~~~~~~~~~~~~~~~	~~~~~~~~~~~~~~~~~~~~~~~~~~~~~~~~~~~~~~~	EQUIPMENT DESCR
ξ	STRING #2/INV#1	Bill of Materials			SOLAR PV MODULES: HANWHA SOLAR: Q
ξ	STRING #3/INV#1	Part	Spares	Total Qty	XL-G10.3/BFG 480W MODULE
ζ	STRING #//INV#2	Rails XR-100-168A			INVERTER: SOL-ARK 15K-LV INVERTER
Ş	STRING #//////#2	XR-100-100A XR100, Rail 168" Clear	0	20	JUNCTION BOXES: 6"X6"X4" UL LISTED, ST
(		Clamps & Grounding			TIGHT NEMA TYPE 3R, UL LISTED
		UFO-CL-01-A1 Universal Module Clamp, Clear	0	100	AC DISCONNECT: FUSED AC DISCONNEC
		UFO-STP-35MM-M1	0	40	(2) 125A FUSES 240V NEMA 3R, UL LISTED
	W	Stopper Sleeve, 35MM, Mill XR-LUG-03-A1			{
	ZK	Grounding Lug, Low Profile	0	1	}
		Substructure			}
	Ś	70-0300-SGA SGA Top Cap at 3"	0	14	}
		GM-BRC3-01-M1 Ground Mount Bonded Rail Connector - 3"	0	40	
		A manual sector			5
			В		
				^	
				μ) B	کے
	<pre>{ STRING #1/INV# { (8 MODULES)</pre>		STRING #3/INV	#1 }	}
		$\sim$			
			i i	L	
	i i		i i	Ĺ	
	i i		i i	Ĺ	
	i i		i i	Ĺ	
	i i		i i		
	i i	STRING #2/INV#1	i i	L	
		STRING #2/INV#1 (8 MODULES)	i i		




ATERIALS	
CRIPTION	QTY
Q CELLS Q.PEAK DUO	40
	01
	01
STEEL WATER	2
ECT, 200A FUSED, ED	1




REVISIONS          DESCRIPTION       DATE       REV         INITIAL DESIGN       10/27/2023       A         FOUNDATION CHANGE       11/09/2023       A         RACKING SYSTEM AND       11/21/2023       B         ARRAY LOCATION       02/21/2024       C         OPOJECT NAME & ADDRESS       B       B         PROJECT NAME & ADDRESS       S       S         SHEET NAME       C       C         DRAWN BY       ESR       S         SHEET NAME       ELECCTRICAL PLAN         SHEET NAME       SHEET SIZE         ANSI B       11" X 17"         SHEET NUMBER       PV-4			
INITIAL DESIGN 10/27/2023 A FOUNDATION CHANGE 11/09/2023 A RACKING SYSTEM AND ELECTRICAL CHANGE 11/12/12023 B ARRAY LOCATION 02/21/2024 C PROJECT NAME & ADDRESS PROJECT NAME & ADDRESS (02/21/2024 C (02/21/2024 C C PROJECT NAME & ADDRESS (02/21/2024 C (02/21/2024 C C (02/21/2024 C (02/21/2024 C (02/21/20)		1	DEV
FOUNDATION CHANGE       11/09/2023       A         RACKING SYSTEM AND       11/21/2023       B         ARRAV LOCATION       02/21/2024       C         CHANGE       02/21/2024       C         PROJECT NAME & ADDRESS <ul> <li>Young</li> <li>Young</li> <li>Young</li> <li>Young</li> <li>Young</li> </ul> PROJECT NAME & ADDRESS <ul> <li>Young</li> </ul> Drawn By <ul> <li>Young</li> </ul> Drawn By <ul> <li>Young</li>             &lt;</ul>			REV
RACKING SYSTEM AND ELECTRICAL CHANGE       11/21/2023       B         ARRAY LOCATION CHANGE       02/21/2024       C         PROJECT NAME       02/21/2024       C         PROJECT NAME & ADDRESS       S       Y         Y       Y       Y         Y </td <td></td> <td></td> <td>Δ</td>			Δ
ELECTRICAL CHANGE       02/21/2024       C         ARRAY LOCATION CHANGE       02/21/2024       C         PROJECT NAME & ADDRESS       S       S         PROJECT NAME & ADDRESS       02/21/2024       C         SHEET NAME       C       SHEET NAME         ELECTRICAL PLAN       SHEET SIZE       ANSI B         SHEET NUMBER       SHEET NUMBER       SHEET NUMBER			
DRAWN BY ESR SHEET NAME ELECTRICAL PLAN SHEET SIZE ANSI B 11" X 17" SHEET NUMBER	ELECTRICAL CHANGE ARRAY LOCATION		
DRAWN BY ESR SHEET NAME ELECTRICAL PLAN SHEET SIZE ANSI B 11" X 17" SHEET NUMBER		02/21/2024	C
SHEET NAME ELECTRICAL PLAN SHEET SIZE ANSI B 11" X 17" SHEET NUMBER	TRAVIS BASS RESIDENCE	2184 WIRE RD, BUNNLEVEL, NC 28323	
ELECTRICAL PLAN SHEET SIZE ANSI B 11" X 17" SHEET NUMBER			
SHEET SIZE ANSI B 11" X 17" SHEET NUMBER			
ANSI B 11" X 17" SHEET NUMBER			
11" X 17" SHEET NUMBER	SHEET S	IZE	
11" X 17" SHEET NUMBER	ANSI	В	
PV-4	SHEET NUM	/BER	

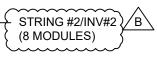


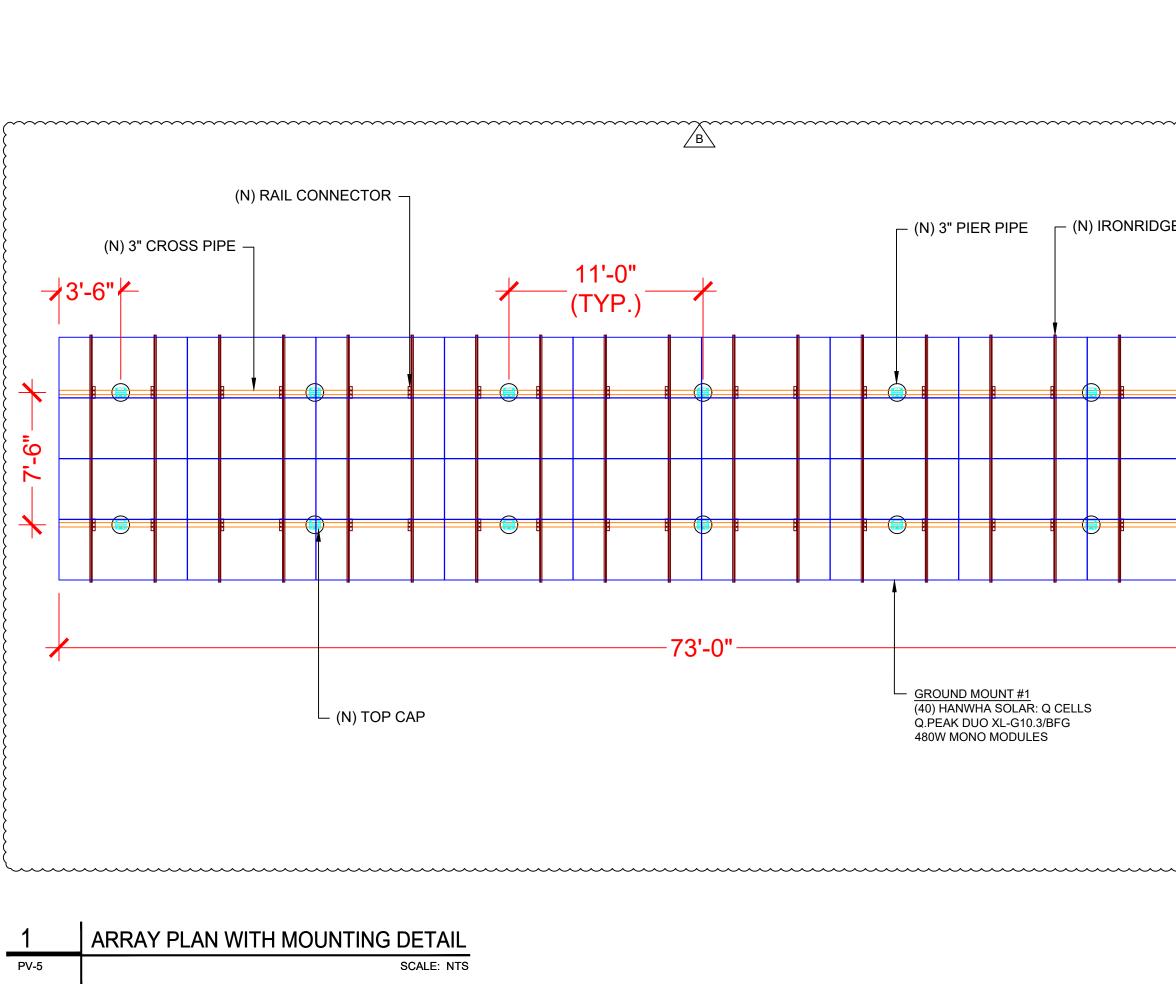



	· · · · · ]	GA 30606, UNITE	DSTATES	
	31	REVISION	٧S	
	<u>}</u>	DESCRIPTION	DATE	REV
	511	INITIAL DESIGN	10/27/2023	
		FOUNDATION CHANGE	11/09/2023	Α
	511	RACKING SYSTEM AND ELECTRICAL CHANGE	11/21/2023	в
SE XR-100 RAIL (TYP.)		ARRAY LOCATION CHANGE	02/21/2024	с
	3	SEAL SEAL 4430 PROJECT NAME 8	201111 01111 3 LEONUL	
		PROJECT NAME 8	ADDRESS	
		TRAVIS BASS RESIDENCE	2184 WIRE RD, BUNNLEVEL, NC 28323	
	3	DRAWN E		
	}			
		SHEET NA		
~~~~~~~~~~~~~~~~~~~~~~~~~~~~~~~~~~~~~~~		sheet si ANSI 11" X 1	В	
	li	SHEET NUM	IBER	
		PV-5	5	

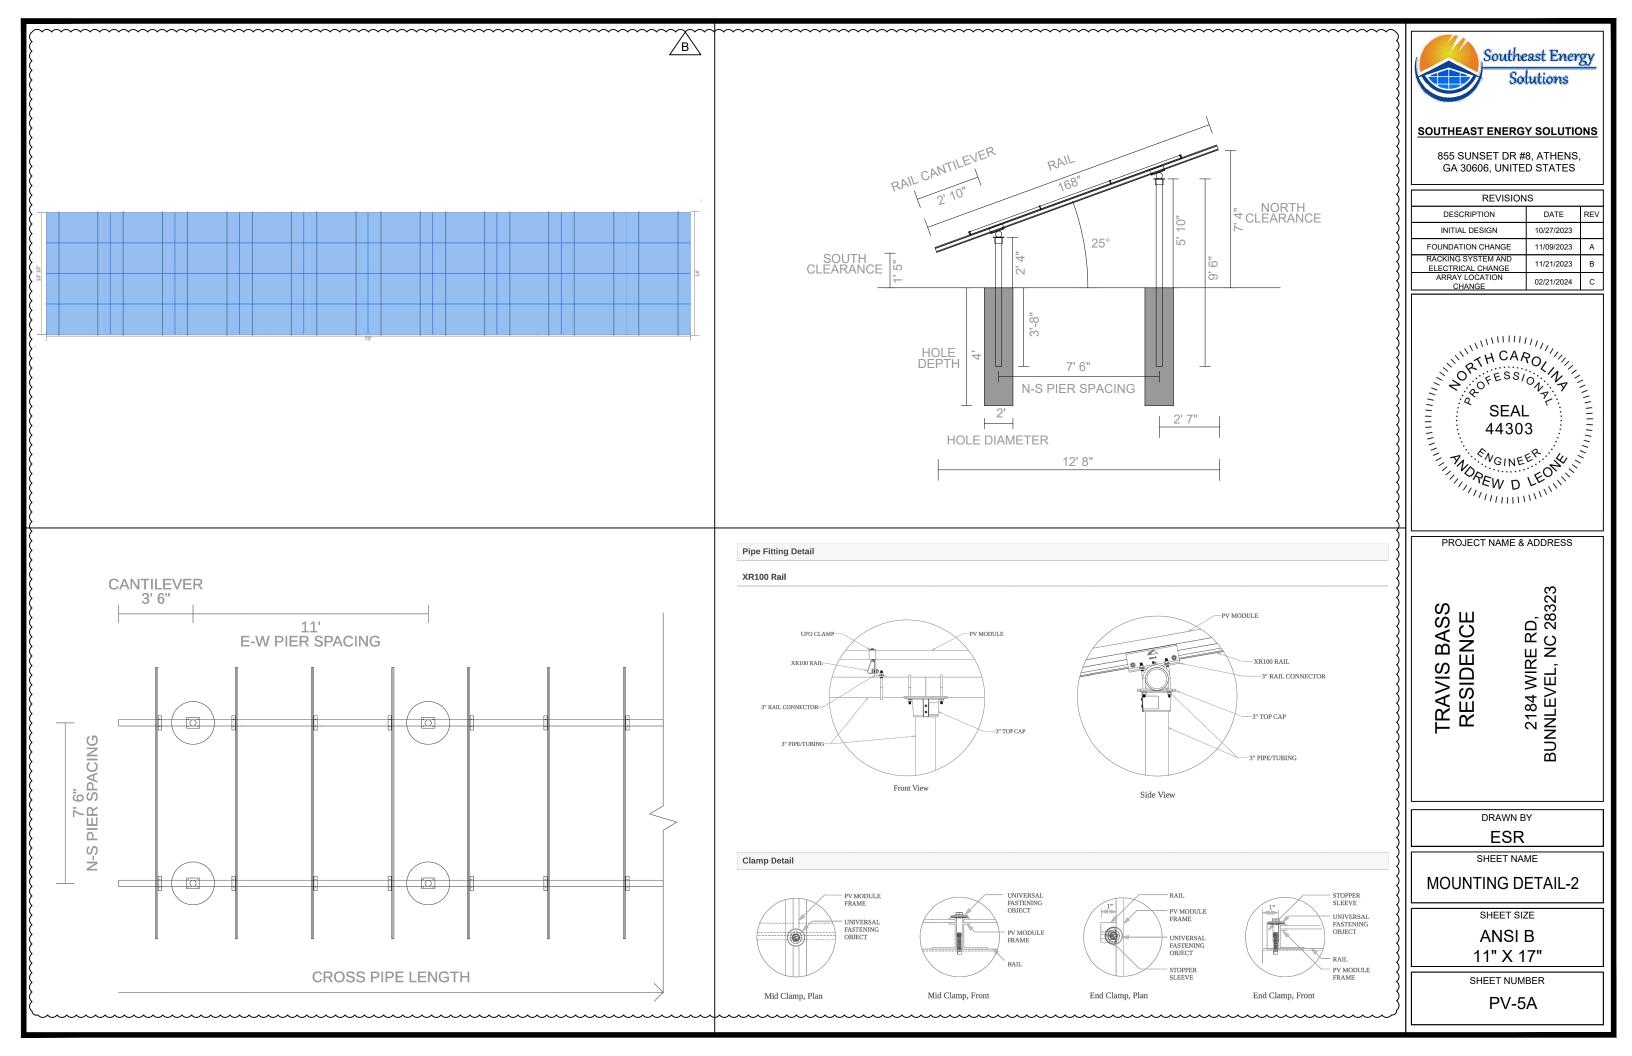

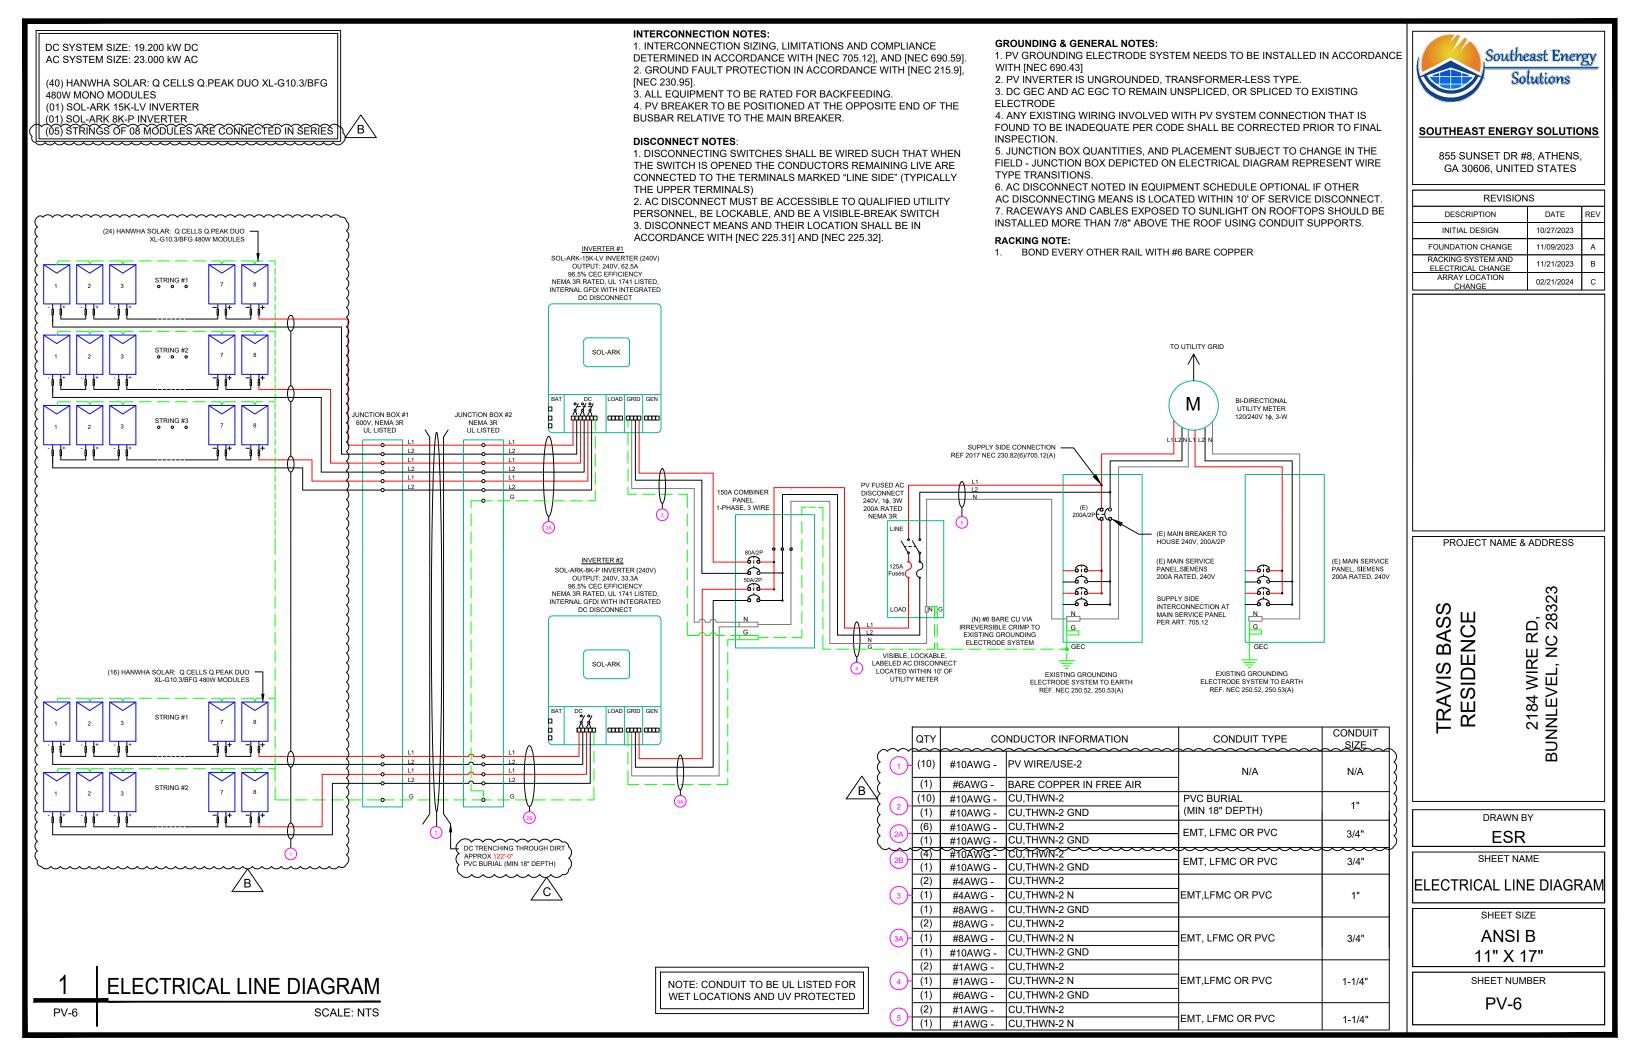

SOLAR M	IODULE SPECIFICATIONS	]	INVERTEF	R #1 SPECIFICATIONS		AMBIENT TEMPERATURE SPECS					
	HANWHA SOLAR: Q CELLS Q.PEAK DUO	MANUFACTURER / MOD	MANUFACTURER / MODEL # SOL-ARK 1			RECORD LOW TEM		-9° 38°			
	XL-G10.3/BFG 480W MODULE	NOMINAL AC POWER		15.000 kW		MODULE TEMPERA	TURE COEFFICIENT OF Voc	-0.27%/°C			
		NOMINAL OUTPUT VOL	TAGE	240 VAC							
VMP	45.33V	NOMINAL OUTPUT CUR	RENT	62.5A		PERCENT OF	NUMBER OF CURRE				
IMP	10.59A					VALUES	CARRYING CONDUCTORS	S IN EMT			
VOC	53.39V		INVERTE	R #2 SPECIFICATIONS		.80	4-6				
ISC	11.12A					.70	7-9				
TEMP. COEFF. VOC	-0.27%/°C	MANUFACTURER / MOD	DEL #	SOL-ARK 8K-P INVERTER		.50	10-20				
MODULE DIMENSION	87.2"L x 41.1"W x 1.38"D (In Inch)	NOMINAL AC POWER		8.000 kW							
		NOMINAL OUTPUT VOL	TAGE	240 VAC							
		NOMINAL OUTPUT CUR	RENT	33.3A							

									DC F	EEDER CALCU	LATIONS										
	CIRCUIT DESTINATION	VOLTAGE (V)	FULL LOAD AMPS "FLA" (A)	FLA*1.56 (A)	OCPD SIZE (A)	GROUND SIZE	CONDUCTOR SIZE	75°C AMPACITY (A)	AMPACITY CHECK #1		TOTAL CC CONDUCTORS IN RACEWAY	90°C AMPACITY (A)	DERATION FACTOR FOR AMBIENT TEMPERATURE NEC 310.15(B)(2)(a)	DERATION FACTOR FOR CONDUCTORS PER RACEWAY NEC 310.15(B)(3)(a)	90°C AMPACITY DERATED (A)	AMPACITY CHECK #2	FEEDER LENGTH (FEET)	CONDUCTOR RESISTANCE (OHM/KFT)	VOLTAGE DROP AT FLA (%)	CONDUIT SIZE	CONDI FILL (9
STRING 1/INV#1	JUNCTION BOX 1	500	11.12	17.35	20	BARE COPPER #6 AWG	CU #10 AWG	35	PASS	38	2	40	0.91	1	36.4	PASS	5	1.24	0.028	N/A	#N/A
STRING 2/INV#1	JUNCTION BOX 1	500	11.12	17.35		BARE COPPER #6 AWG	CU #10 AWG	35	PASS	38	2	40	0.91	1	36.4	PASS	5	1.24	0.028	N/A	#N/A
STRING 3/INV#1	JUNCTION BOX 1	500	11.12	17.35		BARE COPPER #6 AWG	CU #10 AWG	35	PASS	38	2	40	0.91	1	36.4	PASS	5	1.24	0.028	N/A	#N/A
STRING 1/INV#2	JUNCTION BOX 1	500	11.12	17.35		BARE COPPER #6 AWG	CU #10 AWG	35	PASS	38	2	40	0.91	1	36.4	PASS	5	1.24	0.028	N/A	#N/A
STRING 2/INV#2	JUNCTION BOX 1	500	11.12	17.35	20	BARE COPPER #6 AWG	CU #10 AWG	35	PASS	38	2	40	0.91	1	36.4	PASS	5	1.24	0.028	N/A	#N/A
JUNCTION BOX 1	JUNCTION BOX 2	500	11.12	17.35	20	CU #10 AWG	CU #10 AWG	35	PASS	38	10	40	0.91	0.5	18.2	PASS	122	1.24	0.673	1" PVC	27.896
JUNCTION BOX 2	INVERTER 1	500	11.12	17.35	20	CU #10 AWG	CU #10 AWG	35	PASS	38	6	40	0.91	0.8	29.12	PASS	5	1.24	0.028	3/4" EMT	27.711
JUNCTION BOX 2	INVERTER 2	500	11.12	17.35	20	CU #10 AWG	CU #10 AWG	35	PASS	38	4	40	0.91	0.8	29.12	PASS	5	1.24	0.028	3/4" EMT	19.793
																	String	g 1/Inv#1 Volta	ige Drop	0.728	
																	String	g 2/Inv#1 Volta	ige Drop	0.728	
																	String	g 3/Inv#1 Volta	ige Drop	0.728	
																	String	g 1/Inv#2 Volta	ige Drop	0.728	
										/	Â						String	g 2/Inv#2 Volta	ige Drop	0.728	

	AC FEEDER CALCULATIONS																					
	CIRCUIT DESTINATION	VOLTAGE (V)	FULL LOAD AMPS "FLA" (A)	FLA*1.25 (A)	OCPD SIZE (A)	NEUTRAL SIZE	GROUND SIZE	CONDUCTOR SIZE	75°C AMPACITY (A)	AMPACITY CHECK #1	AMBIENT TEMP. (°C)	TOTAL CC CONDUCTORS IN RACEWAY	90°C AMPACITY (A	FOR AMBIENT	DERATION FACTOR FOR CONDUCTORS PER RACEWAY NEC 310.15(B)(3)(a)	AMPACITY		FEEDER LENGTH (FEET)	CONDUCTOR RESISTANCE (OHM/KFT)	DROP AT	CONDUIT SIZE	CONDUIT FILL (%)
INVERTER 1	COMBINER PANEL	240	62.5	78.125	80	CU #4 AWG	CU #8 AWG	CU #4 AWG	85	PASS	38	2	95	0.91	1	86.45	PASS	5	0.308	0.080	1" EMT	32.8472
INVERTER 2	COMBINER PANEL	240	33.3	41.625	50	CU #8 AWG	CU #10 AWG	CU #8 AWG	50	PASS	38	2	55	0.91	1	50.05	PASS	5	0.778	0.108	3/4" EMT	24.5591
COMBINER PANEL	AC DISCONNECT	240	95.8	119.75	125	CU #1 AWG	CU #6 AWG	CU #1 AWG	130	PASS	38	2	145	0.91	1	131.95	PASS	5	0.154	0.061	1 1/4" EMT	T 34.7126
AC DISCONNECT	POI	240	95.8	119.75	125	CU #1 AWG	N/A	CU #1 AWG	130	PASS	38	2	145	0.91	1	131.95	PASS	5	0.154	0.061	1 1/4" EMT	31.3235

#### ELECTRICAL NOTES

- 1. ALL EQUIPMENT TO BE LISTED BY UL OR OTHER NRTL, AND LABELED FOR ITS APPLICATION.
- 2. ALL CONDUCTORS SHALL BE COPPER, RATED FOR 600 V AND 90 DEGREE C WET ENVIRONMENT.
- 3. WIRING, CONDUIT, AND RACEWAYS MOUNTED ON GROUNDTOPS SHALL BE ROUTED DIRECTLY TO, AND LOCATED AS CLOSE AS POSSIBLE TO THE NEAREST RIDGE, HIP, OR VALLEY.
- 4. WORKING CLEARANCES AROUND ALL NEW AND EXISTING ELECTRICAL EQUIPMENT SHALL COMPLY WITH NEC 110.26.
- 5. DRAWINGS INDICATE THE GENERAL ARRANGEMENT OF SYSTEMS. CONTRACTOR SHALL FURNISH ALL NECESSARY OUTLETS, SUPPORTS, FITTINGS AND ACCESSORIES TO FULFILL APPLICABLE CODES AND STANDARDS.
- 6. WHERE SIZES OF JUNCTION BOX, RACEWAYS, AND CONDUITS ARE NOT SPECIFIED, THE CONTRACTOR SHALL SIZE THEM ACCORDINGLY.
- ALL WIRE TERMINATIONS SHALL BE APPROPRIATELY LABELED AND READILY VISIBLE. 7.
- MODULE GROUNDING CLIPS TO BE INSTALLED BETWEEN MODULE FRAME AND MODULE SUPPORT RAIL, PER THE 8. GROUNDING CLIP MANUFACTURER'S INSTRUCTION.
- 9. MODULE SUPPORT RAIL TO BE BONDED TO CONTINUOUS COPPER G.E.C. VIA WEEB LUG OR ILSCO GBL-4DBT LAY-IN LUG.
- 10. TEMPERATURE RATINGS OF ALL CONDUCTORS, TERMINATIONS, BREAKERS, OR OTHER DEVICES ASSOCIATED WITH THE SOLAR PV SYSTEM SHALL BE RATED FOR AT LEAST 75 DEGREE C.

CUMULATIVE VOLTAGE	0.20
DROP INV #1	
CUMULATIVE VOLTAGE	0.23
DROP INV #2	0.25



#### SOUTHEAST ENERGY SOLUTIONS

				REVISION	S			
				DESCRIPTION	DATE	REV		
$\sim$	$\sim$	$\sim\sim\sim$	$\mathbb{Z}$	INITIAL DESIGN	10/27/2023			
			X	FOUNDATION CHANGE	11/09/2023	A		
			₹	RACKING SYSTEM AND	11/21/2023	В		
GE				ELECTRICAL CHANGE ARRAY LOCATION				
T FLA	CONDUIT	CONDUIT	)	CHANGE	02/21/2024	С		
	SIZE	FILL (%)	₹					
			₹					
8	N/A	#N/A	{					
8	N/A	#N/A	5					
8	N/A	#N/A	Ś					
8	N/A	#N/A	)					
8	N/A	#N/A	)					
3	1" PVC	27.89663	₹					
8	3/4" EMT	27.71107	₹					
8	3/4" EMT	19.79362	- {					
	0.728		X					
	0.728	_	Ś					
	0.728	_	Ś					
	0.728	_	}					
	0.728		Ş					
$\sim$	~~~~	~~~~	~	PROJECT NAME &	ADDRESS			
					/ BBRECC			
					S			
				(0)	32			
				TRAVIS BASS RESIDENCE	_ <u>60</u>			
TAGE	CONDUIT	CONDUIT			чО			
OP AT	SIZE	FILL (%)			ЩZ			
A (%)		/			<u>ت</u> کے			
080	1" EMT	32.8472			ŚШ			
108	3/4" EMT	24.5591			4 N			
061	1 1/4" EMT			≫ Ш	ŵЩ			
061	1 1/4" EMT	31.3235			Z Z			
	Т				2184 WIRE RD, INNLEVEL, NC 28323			
0.20					BL			
0.23								
				DRAWN B	Y			
				ESR				
				SHEET NAI				
				WIRING CALCU	LATION	S		
				SHEET SIZ	Έ			
				ANSI				
				11" X 1	1			
				SHEET NUM	BER			
				PV-7				
			- 1	1				

#### PHOTOVOLTAIC POWER SOURCE

#### EVERY 10' ON CONDUIT & ENCLOSURES

LABEL- 1: LABEL LOCATION: EMT/CONDUIT RACEWAY SOLADECK / JUNCTION BOX CODE REF: NEC 690.31 (D)(2)

### 

#### ELECTRIC SHOCK HAZARD

TERMINALS ON THE LINE AND LOAD SIDES MAY BE ENERGIZED IN THE OPEN POSITION

LABEL- 2: LABEL LOCATION: AC DISCONNECT CODE REF: NEC 690.13(B)

### 

#### **DUAL POWER SUPPLY**

SOURCE: UTILITY GRID AND **PV SOLAR ELECTRIC SYSTEM** 

#### LABEL- 3: LABEL LOCATION: MAIN SERVICE PANEL CODE REF: NEC 705.12(C) & NEC 690.59

### SOLAR PV BREAKER:

### **BREAKER IS BACKFED** DO NOT RELOCATE

LABEL-4: LABEL LOCATION: MAIN SERVICE PANEL CODE REF: NEC 705.12(C) & NEC 690.59




LABEL- 5:

LABEL LOCATION: MAIN SERVICE PANEL (ONLY IF SOLAR IS BACK-FED) SUBPANEL (ONLY IF SOLAR IS BACK-FED) CODE REF: NEC 705.12(B)(3)(2)

### SOLAR PV SYSTEM EQUIPPED WITH RAPID SHUTDOWN

TURN RAPID SHUTDOWN SWITCH TO THE "OFF" POSITION TO SHUT DOWN PV SYSTEM AND REDUCE SHOCK HAZARD IN THE ARRAY

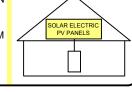

LABEL- 6: LABEL LOCATION: AC DISCONNECT CODE REF: [NEC 690.56(C)(1)(A)]

### **RAPID SHUTDOWN SWITCH** FOR SOLAR PV SYSTEM

LABEL- 7: LABEL LOCATION: AC DISCONNECT MAIN SERVICE PANEL (ONLY IF SOLAR IS BACK-FED) CODE REF: NEC 690.56(C)(2)

### DC DISCONNECT

LABEL- 8: LABEL LOCATION: INVERTER CODE REF: NEC 690.13(B)

AC DISCONNECT	
PHOTOVOLTAIC SYST	EM
POWER SOURCE	
NOMINAL OPERATING AC VOLATGE	240 V
RATED AC OUTPUT CURRENT	95.8 A
ABEL - 9'	

LABEL LOCATION: AC DISCONNECT CODE REF: NEC 690.54

#### FOR INV #1

INVERTER AC DISCONNECT	
NOMINAL OPERATING AC VOLATGE	240 V
RATED AC OUTPUT CURRENT	62.50 A
LABEL- 10: LABEL LOCATION	

INVERTER CODE REF: NEC 690.54

#### FOR INV #2

INVERTER AC DISCONNECT	
NOMINAL OPERATING AC VOLATGE	240 V
RATED AC OUTPUT CURRENT	33.3 A
LABEL-11:	

LABEL LOCATION: INVERTER CODE REF: NEC 690.54

#### FOR INV #1 & #2

MAXIMUN

MAXIMUN

MAXIMUM

CURRENT

CONTROL

VOLTAGE	500
CIRCUIT CURRENT	18
RATED OUTPUT	
OF THE CHARGE	
LER OR DC-TO-DC	

CONVERTER (IF INSTALLED)

LABEL- 12: LABEL LOCATION: INVERTER CODE REF: NEC 690.53



REVISIONS						
DESCRIPTION	DATE	REV				
INITIAL DESIGN	10/27/2023					
FOUNDATION CHANGE	11/09/2023	А				
RACKING SYSTEM AND ELECTRICAL CHANGE	11/21/2023	В				
ARRAY LOCATION CHANGE	02/21/2024	С				


**PROJECT NAME & ADDRESS** 

2184 WIRE RD, BUNNLEVEL, NC 28323 **TRAVIS BASS** RESIDENCE DRAWN BY ESR SHEET NAME LABELS SHEET SIZE ANSI B 11" X 17"

SHEET NUMBER

PV-8



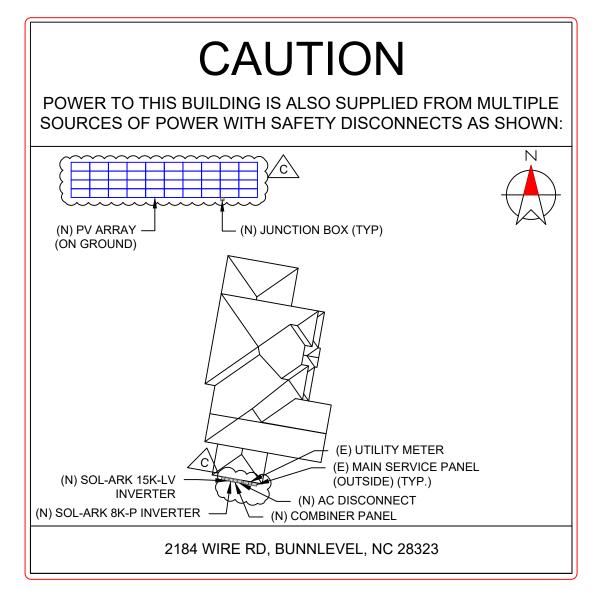

#### DIRECTORY

PERMANENT PLAQUE OR DIRECTORY PROVIDING THE LOCATION OF THE SERVICE DISCONNECTING MEANS AND THE PHOTOVOLTAIC SYSTEM.

(ALL PLAQUES AND SIGNAGE WILL BE INSTALLED AS OUTLINED WITHIN: NEC 690.56(B)&(C), [NEC 705.10]) [NEC 690.56(C)(1)(A)]

LABELING NOTES:

- 1. LABELS CALLED OUT ACCORDING TO ALL COMMON CONFIGURATIONS. ELECTRICIAN TO DETERMINE EXACT REQUIREMENTS IN THE FIELD PER CURRENT NEC AND LOCAL CODES AND MAKE APPROPRIATE ADJUSTMENTS.
- 2. LABELING REQUIREMENTS BASED ON THE 2017 NATIONAL ELECTRIC CODE, OSHA STANDARD 19010.145, ANSI Z535.
- 3. MATERIAL BASED ON THE REQUIREMENTS OF THE AUTHORITY HAVING JURISDICTION.
- 4. LABELS TO BE OF SUFFICIENT DURABILITY TO WITHSTAND THE ENVIRONMENT INVOLVED [NEC 110.21]
- 5. LABELS TO BE A MINIMUM LETTER HEIGHT OF 3/8", WHITE ON RED BACKGROUND; REFLECTIVE, AND PERMANENTLY

AFFIXED [NEC 690.56(C)(1)(A)].



#### SOUTHEAST ENERGY SOLUTIONS

GA 30606, UNITED STATES							
REVISION	IS						
DESCRIPTION	DATE	REV					
INITIAL DESIGN	10/27/2023						
FOUNDATION CHANGE	11/09/2023	А					
RACKING SYSTEM AND ELECTRICAL CHANGE	11/21/2023	в					
ARRAY LOCATION CHANGE	02/21/2024	с					
PROJECT NAME & SERIDENCE RESIDENCE	2184 WIRE RD, BUNNLEVEL, NC 28323						
ESR							
SHEET NA	ME						
PLACAF	RD						
SHEET SIZ	ZE						
ANSI							
11" X 1							
SHEET NUM PV-9	BER						



## Q.PEAK DUO XL-G10.3/BFG 470-485

BIFACIAL DOUBLE GLASS MODULE WITH EXCELLENT RELIABILITY AND ADDITIONAL YIELD



#### THE IDEAL SOLUTION FOR: Ground-mounted solar power plants

**P** 



 $\overline{\bigcirc}$ 

TUT





#### BIFACIAL ENERGY YIELD GAIN OF UP TO 20%

Bifacial Q.ANTUM solar cells with zero gap cell layout make efficient use of light shining on the module rear-side for radically improved LCOE.

EUPD RESEARCH

TOP BRAND PV

MODULES

EUROPE

Q CELLS ield Security

#### LOW ELECTRICITY GENERATION COSTS

Q.ANTUM DUO Z combines cutting edge cell separation and innovative wiring with Q.ANTUM Technology for higher yield per surface area, lower BOS costs, higher power classes, and an efficiency rate of up to 21.2%.

#### INNOVATIVE ALL-WEATHER TECHNOLOGY

Optimal yields, whatever the weather with excellent low-light and temperature behavior.

#### ENDURING HIGH PERFORMANCE

Long-term yield security with Anti LID and Anti PID Technology<sup>1</sup> Hot-Spot Protect and Traceable Quality Tra.Q™.

#### FRAME FOR VERSATILE MOUNTING OPTIONS

High-tech aluminum alloy frame protects from damage, enables use of a wide range of mounting structures and is certified regarding IEC for high snow (5400Pa) and wind loads (2400Pa).


#### A RELIABLE INVESTMENT

Double glass module design enables extended lifetime with 12-year product warranty and improved 30-year performance warranty<sup>2</sup>.

<sup>2</sup> APT test conditions according to IEC /TS 62804-1:2015 method B (-1500 V, 168 h) including post treatment according to IEC 61215-1-1 Ed. 2.0 (CD) See data sheet on rear for further information



Format	87.2 in × 41.1 in × 1.38 in (including frame) (2216 mm × 1045 mm × 35 mm)	
Weight	64.2 lbs (29.1kg)	
Front Cover	0.08 in (2.0 mm) thermally pre-stressed glass with anti-reflection technology	
Back Cover	0.08 in (2.0 mm) semi-tempered glass	
Frame	Anodized aluminum	
Cell	6 × 26 monocrystalline Q.ANTUM solar half cells	
Junction Box	2.09-3.98 in × 1.26-2.36 in × 0.59-0.71 in (53-101 mm × 32-60 mm × 15-18 mm), IP67, with bypass diodes	
Cable	4 mm² Solar cable; (+) ≥27.6 in (700 mm), (-) ≥13.8 in (350 mm)	
Connector	Stäubli MC4-Evo2, Hanwha Q CELLS HQC4, IP68	

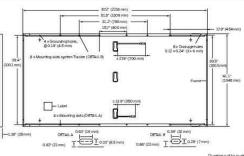


#### **ELECTRICAL CHARACTERISTICS**


PO	VER CLASS			470		475		480		485	
MIN	IMUM PERFORMANCE AT STANDA	RD TEST CONDITIC	NS, STC1	AND BSTC <sup>2</sup> (F	OWER TOL	ERANCE +5	W/-0W)				
					BSTC*		BSTC*		BSTC*		BSTC
	Power at MPP <sup>1</sup>	PMPP	[W]	470	514.1	475	519.6	480	525.0	485	530.9
-	Short Circuit Current <sup>1</sup>	I <sub>sc</sub>	[A]	11.04	12.08	11.08	12.12	11.12	12.17	11.16	12.2
unu	Open Circuit Voltage <sup>1</sup>	Vac	[V]	52.91	53.10	53.15	53.34	53.39	53.58	53.63	53.8
Minii	Current at MPP	1 <sub>NPP</sub>	[A]	10.51	11.50	10.55	11.54	10.59	11.58	10.63	11.6
2	Voltage at MPP	V <sub>MPP</sub>	[V]	44.73	44.72	45.03	45.02	45.33	45.32	45.63	45.6
	Efficiency <sup>1</sup>	η	[%]	≥20.3	≥22.2	≥20.5	≥22.4	≥20.7	≥22.7	≥20.9	≥22.9

lerances P<sub>hiller</sub> ±3%; I<sub>sc</sub>, V<sub>oc</sub> ±5% at STC: 1000W/m²; \*at BSTC: 1000W/m² + φ × 135W/m², φ = 70% ±5%, 25±2°C, AM 1.5 according to IEC 60

Power at MPP	PIMPP	[W]	353.8	357.6	361.4	365.1
Short Circuit Current	Isc	[A]	8.89	8.92	8.96	8.99
Open Circuit Voltage	Voc	[V]	50.04	50.27	50.49	50.72
Current at MPP	I <sub>MPP</sub>	[A]	8.27	8.30	8.34	8.37
Voltage at MPP	V <sub>MPP</sub>	[V]	42.77	43.06	43.35	43.63

#### Q CELLS PERFORMANCE WARRANTY

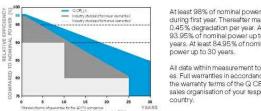

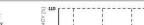



sales organisation of your respective country

Typical module performance under low irradiance conditions in comparison to STC conditions ( $25^{\circ}$ C, 1000W/m<sup>2</sup>)

TEMPERATURE COEFFICIENTS								
Temperature Coefficient of Isc	α	[%/K]	+0.04	Temperature Coefficient of Voc	β	[%/K]	-0.27	
Temperature Coefficient of PMPP	γ	[%/K]	-0.34	Nominal Module Operating Temperature	NMOT	[°F]	108±5.4 (42±3°C)	

#### PROPERTIES FOR SYSTEM DESIGN


Maximum System Voltage V <sub>SYS</sub>	[V]	1500	PV module classification	ClassII	
Maximum Series Fuse Rating	[ADC]	20	Fire Rating based on ANSI / UL 61730	TYPE 294	
Max. Design Load, Push/Pull <sup>3</sup>	[lbs/ft²]	75 (3600Pa)/33 (1600Pa)	Permitted Module Temperature	-40°F up to +185°F	
Max. Test Load, Push / Pull <sup>3</sup>	[lbs/ft <sup>2</sup> ]	113 (5400 Pa) / 50 (2400 Pa)	on Continuous Duty	(-40°C up to +85°C)	
*See Installation Manual			<sup>4</sup> New Type is similar to Type 3 but with metallic frame		



Note: Installation instructions must be followed. See the installation and operating manual or contact our technical service department for further information on approved installation and use of this product.

#### Hanwha Q CELLS America Inc.

400 Spectrum Center Drive, Suite 1400, Irvine, CA 92618, USA | TEL +1 949748 59 96 | EMAIL inquiry@us.q-cells.com | WEB www.q-cells.us

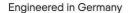


Con the second



#### SOUTHEAST ENERGY SOLUTIONS

855 SUNSET DR #8, ATHENS, GA 30606, UNITED STATES

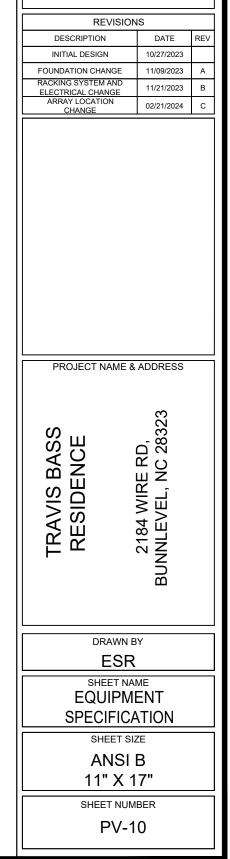

PERFORMANCE AT LOW IRRADIANCE





Solar Input Power 17000W		
Max Allowed PV Power	17000W	
Max PV Power Delivered to Battery & AC Outputs	15000W	
Max DC Voltage (Voc)	500V @ 18A, 450V @ 20A	
MPPT Voltage Range	150-425V	
Starting Voltage	125V	
Number of MPPT	3	
Max Solar Strings Per MPPT	2	
Max DC Current per MPPT (Self Lim- iting)	26A	
Max AC Coupled Input (Micro/String Inverters)	19200W	

AC Output Power 15kW On-Grid & Off-G	irid
--------------------------------------	------

120/240/208V Split Phase
15000W 62.5A-L (240V)
12000W 50A-L (240V)
24,000W L-L (240V)
TBD
Yes - 12 Max
60/50Hz
48000W 200A L-L (240V)
24000W 200A L-N (120V)
96.5% (Peak 97.5%)
90W
Limited to Household/Fully Grid-Tied
Transformerless DC
4ms
+/- 0.9 - 1.0

Battery (optional) Output Power 12000W		
Туре	Lead-Acid or Li-Ion	
Nominal DC Input	48V	
Capacity	50 — 9900Ah	
Voltage Range	43.0 — 63.0V	
Continuous Battery Charging Output	275A	
Charging Curve	3-Stage w/ Equalization	
Grid to Batt Charging Efficiency	96.0%	
External Temperature Sensor	Included	
Current Shunt for Accurate % SOC	Integrated	
External Gen Start Based on Voltage or %SOC	Integrated	
Communication to Lithium Battery	CanBus & RS485	

General	
Dimensions (H x W x D)	31.8" x 18.3" x 10.9"
Weight	101 lbs
Enclosure	IP65 / NEMA 3R
Ambient Temperature	-40~60°C, >45°C Derating
Installation Style	Wall-Mounted
Wi-Fi & LAN Communication	Included
Standard Warranty (verified by HALT Testing)	10 Years

### **Protections & Certifications**

Electronics Certified Safety by SGS Labs to NEC & UL Specs - NEC 690.4B & NEC 705.4/6	Yes
Grid Sell Back — UL1741-2010/2018, IEE- E1547a-2003/2014, FCC 15 Class B, UL1741SA, CA Rule 21, HECO Rule 14H	Yes
PV DC Disconnect Switch — NEC 240.15	Integrated
Ground Fault Detection — NEC 690.5	Integrated
PV Rapid Shutdown Control — NEC 690.12	Integrated
PV Arc Fault Detection — NEC 690.11	Integrated
PV Input Lightning Protection	Integrated
PV String Input Reverse Polarity Protection	Integrated
AC Output Breakers - 63A	Integrated
250A Battery Breaker / Disconnect	Integrated
Surge Protection	DC Type II / AC Type II



#### SOUTHEAST ENERGY SOLUTIONS

GA 30606, UNITE	DSTATES		
REVISION	REVISIONS		
DESCRIPTION	DATE	REV	
INITIAL DESIGN	10/27/2023		
FOUNDATION CHANGE	11/09/2023	А	
RACKING SYSTEM AND ELECTRICAL CHANGE	11/21/2023	В	
ARRAY LOCATION CHANGE	02/21/2024	С	
PROJECT NAME & BASS RESIDENCE	2184 WIRE RD, BUNNLEVEL, NC 28323 ssaude		
DRAWN BY ESR SHEET NAME EQUIPMENT SPECIFICATION SHEET SIZE ANSI B 11" X 17" SHEET NUMBER			
PV-1	1		



Sol-Ark 8K-P Spec Sheet



Solar Input Power 9000W		
Max Allowed PV Power	5500W + 5500W = 11000W	
Max PV Power Delivered to Battery & AC Outputs	8000W	
Max DC Voltage (Voc)	500V @ 18A, 450V @ 20A	
MPPT Voltage Range	150-425V	
Starting Voltage	125V	
Number of MPPT	2	
Max Solar Strings Per MPPT	2	
Max DC Current per MPPT (Self Lim- iting)	20A	
Max AC Coupled Input (Micro/String Inverters)	9600W	

AC Output Power 8kW On-Grid & Off-Grid		
Connections	120/240/208V Split Phase	
Continuous AC Power to Grid (On-Grid)	8000W 33.3A-L (240V)	
Continuous AC Power to Load (Off- Grid)	8000W 33.3A-L (240V)	
Surge AC Power 10sec (Load)	16,000VA L-L (240V)	
Surge AC Power 100ms (Load)	25,000VA L-L(240V)	
Parallel Stacking	No	
Frequency	60/50Hz	
Continuous AC Power with Grid or	15120W 63A L-L (240V)	
Generator (Pass-through Power)	7560W 63A L-N (120V)	
CEC Efficiency	96.5% (Peak 97.5%)	
Idle Consumption Typical—No Load	60W	
Sell Back Power Modes	Limited to Household/Fully Grid-Tied	
Design (DC to AC)	Transformerless DC	
Response Time (Grid-Tied to Off-Grid)	4ms	
Power Factor	+/-0.9-1.0	

Output Power 8000W Battery (optional) Type Nominal DC Input Lead-Acid or Li-Ion 48V Capacity 50 — 9900Ah Voltage Range 43.0 - 63.0V Continuous Battery Charging Output 185A Charging Curve 3-Stage w/ Equalization Grid to Batt Charging Efficiency 96.0% Included External Temperature Sensor Current Shunt for Accurate % SOC Integrated External Gen Start Based on Voltage Integrated or %SOC CanBus & RS485 Communication to Lithium Battery

General	
Dimensions (H x W x D)	30.0" x 18.3" x
Weight	78 lbs
Enclosure	NEMA 3R
Ambient Temperature	-25-55°C, >45°C
Installation Style	Wall-Mounted
Wi-Fi & LAN Communication	Included
Standard Warranty (verified by HALT Testing)	5 Years

Protections & Certifications	
Electronics Certified Safety by SGS Labs to NEC & UL Specs - NEC 690.4B & NEC 705.4/6	Yes
Grid Sell Back — UL1741-2010/2018, IEE- E1547a-2003/2014, FCC 15 Class B, UL1741SA,	Yes
PV DC Disconnect Switch — NEC 240.15	Integrated
Ground Fault Detection — NEC 690.5	Integrated
PV Rapid Shutdown Control — NEC 690.12	Integrated
PV Arc Fault Detection — NEC 690.11	Integrated
PV Input Lightning Protection	Integrated
PV String Input Reverse Polarity Protection	Integrated
AC Output Breakers - 63A	Integrated
250A Battery Breaker / Disconnect	Integrated
Surge Protection	DC Type II / AC Type II



#### SOUTHEAST ENERGY SOLUTIONS

GA 30606, UNITE	DSTATES	
REVISIONS		
DESCRIPTION	DATE	REV
INITIAL DESIGN	10/27/2023	
FOUNDATION CHANGE	11/09/2023	А
RACKING SYSTEM AND	11/21/2023	в
ELECTRICAL CHANGE ARRAY LOCATION	02/21/2024	С
CHANGE		
<u></u>		
PROJECT NAME &	ADDRESS	
	~	
	323	
О Ш	.83	
ll ¥Ω		
II M Z I	шZ	
l s l i	R _	
	≥Ü	
RAVIS BASS RESIDENCE	₩ 2	
ll R R - S	2184 WIRE RD, INLEVEL, NC 28	
TRAVIS BASS RESIDENCE 2184 WIRE RD, NNLEVEL, NC 28323		
	ЗU	
	ш	
DRAWN B	Y	
ESR		
	SHEET NAME	
	EQUIPMENT SPECIFICATION	
	SPECIFICATION SHEET SIZE	
	ANSI B	
11" X 17"		
SHEET NUMBER		
PV-12		
11		



Solar Is Not Always Sunny

enough to buckle a panel frame.

these results. They resist uplift, protect against buckling and safely and efficiently

transfer loads into the building structure.

Their superior spanning capability

requires fewer roof attachments, reducing the number of roof

penetrations and the amount

of installation time.

Over their lifetime, solar panels experience countless extreme weather events. Not just the worst storms in years,

ripping panels from a roof, and snowfalls weighing

XR Rails are the structural backbone preventing

but the worst storms in 40 years. High winds capable of

### **XR Rail Family**

### **XR Rail Family**

/в\

The XR Rail Family offers the strength of a curved rail in three targeted sizes. Each size supports specific design loads, while minimizing material costs. Depending on your location, there is an XR Rail to match.





XR100

XR100 is the ultimate residential mounting rail. It supports a range of wind and snow conditions, while also maximizing spans up to 10 feet.

10' spanning capability

Clear & black anodized finish

Internal splices available

· Heavy load capability

XR10 is a sleek, low-profile mounting rail, designed for regions with light or no snow. It achieves spans up to 6 feet while remaining light and economical.


- 6' spanning capability
- Moderate load capability
  Clear & black anodized finish
- · Internal splices available

#### **Rail Selection**

The table below was prepared in compliance with applicable engineering codes and standards.\* Values are based on the following criteria: ASCE 7-16, Gable Roof Flush Mount, Roof Zones 1 & 2e, Exposure B, Roof Slope of 8 to 20 degrees and Mean Building Height of 30 ft. Visit IronRidge.com for detailed certification letters.

Load		Rail Span				
Snow (PSF)	Wind (MPH)	4'	5' 4"	6'	8'	
None	90					
	120					
	140	XR10		XR100		
	160					
20	90					
	120					
	140					
	160					
30	90					
	160					
40	90					
	160					
80	160					
120	160					

\*Table is meant to be a simplified span chart for conveying general rail capabilities. Use approved certification letters for actual design guidance.

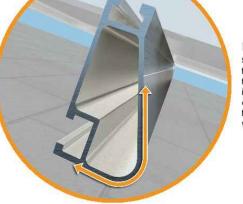

#### Force-Stabilizing Curve

Sloped roofs generate both vertical and lateral forces on mounting rails which can cause them to bend and twist. The curved shape of XR Rails is specially designed to increase strength in both directions while resisting the twisting. This unique feature ensures greater security during extreme weather and a longer system lifetime

#### **Compatible with Flat & Pitched Roofs**

XR Rails are compatible with FlashFoot and other pitched roof attachments




### **Corrosion-Resistant Materials**

All XR Rails are made of 6000-series aluminum alloy, then protected with an anodized finish. Anodizing prevents surface and structural corrosion, while also providing a more attractive appearance.



### IronRidge offers options for flat

#### a range of tilt leg roof mounting applications.

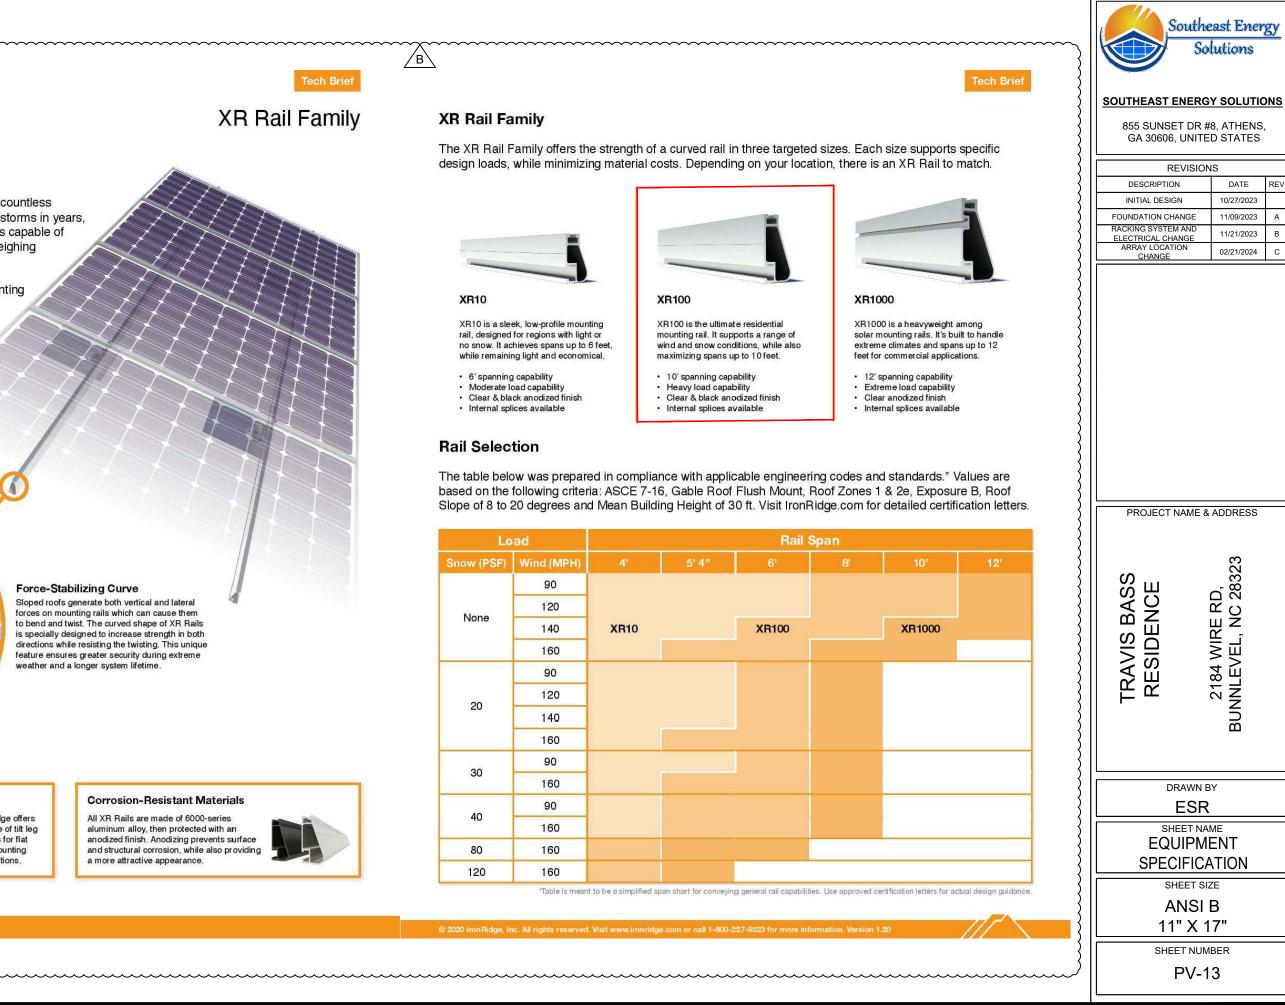

REV



# Ground Mount System

Datasheet



#### **All-Terrain Mounting**

The IronRidge® Ground Mount System combines our XR100® or XR1000® rails with locally-sourced steel pipes or mechanical tubing, to create a cost-effective structure capable of handling any site or terrain challenge.

Installation is simple with only a few structural components and no drilling, welding, or heavy machinery required. In addition, the system works with a variety of foundation options-including concrete piers, ground screws, helical or driven piles, and above-ground ballast blocks.



**Rugged Construction** Engineered steel and aluminum components ensure durability.



UL 2703 Listed System Meets newest effective UL 2703 standard.




**Flexible Architecture** Multiple foundation and array configuration options.



PE Certified Pre-stamped engineering letters available in most states.





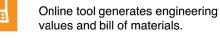



**25-Year Warranty** Products guaranteed to be free of impairing defects.

