


# (E) 24 + (N) 10 MODULES-ROOF MOUNTED - 13.430 kW DC, 11.400 kW AC


#### 18 THUNDER VALLELY CT, LILLINGTON, NC 27546

PROJECT DATA	GENERAL NOTES	VICIN
PROJECT 18 THUNDER VALLELY CT, ADDRESS LILLINGTON, NC 27546 OWNER: ELLIS DAVIS DESIGNER: ESR SCOPE: (N) 3.950 kW DC ROOF MOUNT SOLAR PV SYSTEM WITH (N) 10 JINKO SOLAR: JKM395M-72HBL-V 395W PV MODULES WITH (N) 10 SOLAREDGE: S440 POWER OPTIMIZERS (N) 01 SOLAREDGE: SE11400H-US (240V/11400W) INVERTER 01 10 kWh SOLAREDGE ENERGY BANK EXISTING: (E) 9.480 kW DC ROOF MOUNT	<ol> <li>ALL COMPONENTS ARE UL LISTED AND CEC CERTIFIED, WHERE WARRANTED.</li> <li>THE SOLAR PV SYSTEM WILL BE INSTALLED IN ACCORDANCE WITH ARTICLE 690 OF THE NEC 2017.</li> <li>THE UTILITY INTERCONNECTION APPLICATION MUST BE APPROVED AND PV SYSTEM INSPECTED PRIOR TO PARALLEL OPERATION.</li> <li>ALL CONDUCTORS OF A CIRCUIT, INCLUDING THE EGC, MUST BE INSTALLED IN THE SAME RACEWAY, OR CABLE, OR OTHERWISE RUN WITH THE PV ARRAY CIRCUIT CONDUCTORS WHEN THEY LEAVE THE VICINITY OF THE PV ARRAY.</li> <li>WHERE METALLIC CONDUIT CONTAINING DC CONDUCTORS IS USED INSIDE THE BUILDING, IT SHALL BE IDENTIFIED AS "CAUTION: SOLAR CIRCUIT" EVERY 10FT.</li> <li>HEIGHT OF THE AC DISCONNECT SHALL NOT EXCEED 6'-7" PER NEC CODE 240.24.</li> <li>A GROUNDING ELECTRODE SYSTEM IN ACCORDANCE WITH CEC 690.47 AND 250.50 THROUGH 60 AND 250-166 SHALL BE PROVIDED. PER NEC GROUNDING ELECTRODE SYSTEM OF EXISTING BUILDING MAY BE USED AND BONDED TO THE SERVICE ENTRANCE. IF EXISTING SYSTEM IS INACCESSIBLE OR INADEQUATE A SUPPLEMENTAL GROUNDING ELECTRODE WILL BE USED AT HE INVERTER LOCATION CONSISTING OF A UL LISTED S FT. GROUND ROD WITH ACORN CLAMP. GROUNDING ELECTRODE WILL BE USED ATH BONDED TO THE SERVICE CONDUCTORS SHALL BE NO LESS THAN #8 AWG AND NO LARGER THAN #6 AWG COPPER AND BONDED TO THE EXISTING GROUNDING ELECTRODE FOR A COMPLETE SYSTEM.</li> <li>PHOTOVOLTAIC MODULES ARE TO BE CONSIDERED NON-COMBUSTIBLE.</li> </ol>	VICIN Sanford 18 Thu Ct, Lil 27546, 95 HOUS
SOLAR PV SYSTEM WITH (E) 24 MISSION SOLAR: MSE395SX9R 395W PV MODULES WITH (E) 24 SOLAREDGE: S440 POWER OPTIMIZERS AUTHORITIES HAVING JURISDICTION: BUILDING: HARNETT COUNTY ZONING: HARNETT COUNTY UTILITY: DUKE ENERGY PROGRESS SHEET INDEX PV-1 COVER SHEET PV-2 SITE PLAN PV-3 ROOF PLAN & MODULES PV-4 ELECTRICAL PLAN PV-5 STRUCTURAL DETAIL PV-6 ELECTRICAL LINE DIAGRAM PV-7 WIRING CALCULATIONS PV-8 LABELS PV-9+ EQUIPMENT SPECIFICATIONS SIGNATURE	<ol> <li>PHOTOVOLTAIC INSTALLATION WILL NOT OBSTRUCT ANY PLUMBING. MECHANICAL, OR BUILDING ROOF VENTS.</li> <li>ALL WIRING MUST BE PROPERLY SUPPORTED BY DEVICES OR MECHANICAL MEANS DESIGNED AND LISTED FOR SUCH USE. WIRING MUST BE PROPERLY AND COMPLETELY HELD OFF THE ROOF SURFACE.</li> <li>ALL SINAGE TO BE PLACED IN ACCORDANCE WITH THE LOCAL BUILDING CODE. IF EXPOSED TO SUNLIGHT, IT SHALL BE UV RESISTANT. ALL PLAQUES AND SINAGE WILL BE INSTALLED AS REQUIRED BY THE NEC AND AHJ.</li> <li>INVERTER(S) USED IN UNGROUNDED SYSTEM SHALL BE UL 1741 LISTED.</li> <li>THE INSTALLATION OF EQUIPMENT AND ALL ASSOCIATED WIRING AND INTERCONNECTION SHALL BE PERFORMED ONLY BY QUALIFIED PERSONS [NEC 690.4(C)]</li> <li>ALL OUTDOOR EQUIPMENT SHALL BE NEMA 3R RATED (OR BETTER), INCLUDING ALL ROOF MOUNTED TRANSITION BOXES AND SWITCHES.</li> <li>ALL EQUIPMENT SHALL BE PROPERLY GROUNDED AND BONDED IN ACCORDANCE WITH NEC ARTICLE 250.</li> <li>SYSTEM GROUNDING SHALL BE IN ACCORDANCE WITH NEC 690.41.</li> <li>PV SYSTEM CIRCUITS INSTALLED ON OR IN BUILDINGS SHALL INCLUDE A RAPID SHUTDOWN FUNCTION IN ACCORDANCE WITH NEC 690.12</li> <li>DISCONNECTING MEANS SHALL BE LOCATED IN A VISIBLE, READILY ACCESSIBLE LOCATION WITHIN THE PV SYSTEM EQUIPMENT OR A MAXIMUM OF 10 FEET AWAY FROM THE SYSTEM [NEC 690.13(A)]</li> <li>ALL WIRING METHODS SHALL BE IN ACCORDANCE WITH NEC 690.31</li> <li>WORK CLEARANCES AROUND ELECTRICAL EQUIPMENT WILL BE MAINTAINED PER NEC 110.26(A)(1), 110.26(A)(2) AND 110.26(A)(3).</li> </ol>	CODE RI 2018 NORTH CAROLINA 2018 NORTH CAROLINA 2018 NORTH CAROLINA 2018 NORTH CAROLINA 2018 NORTH CAROLINA 2018 NORTH CAROLINA
	<ol> <li>21. ROOFTOP MOUNTED PHOTOVOLTAIC PANELS AND MODULES SHALL BE TESTED, LISTED &amp; IDENTIFIED IN ACCORDANCE WITH UL1703</li> <li>22. ELECTRICAL CONTRACTOR TO PROVIDE CONDUIT EXPANSION JOINTS AND ANCHOR CONDUIT RUNS AS REQUIRED PER NEC.</li> </ol>	A control on must comply with ourser ND Building Cock. APPROVED Winder Aufgreute Prinfer full compliance with the code 03/08/2024 REV1 Batt/intern

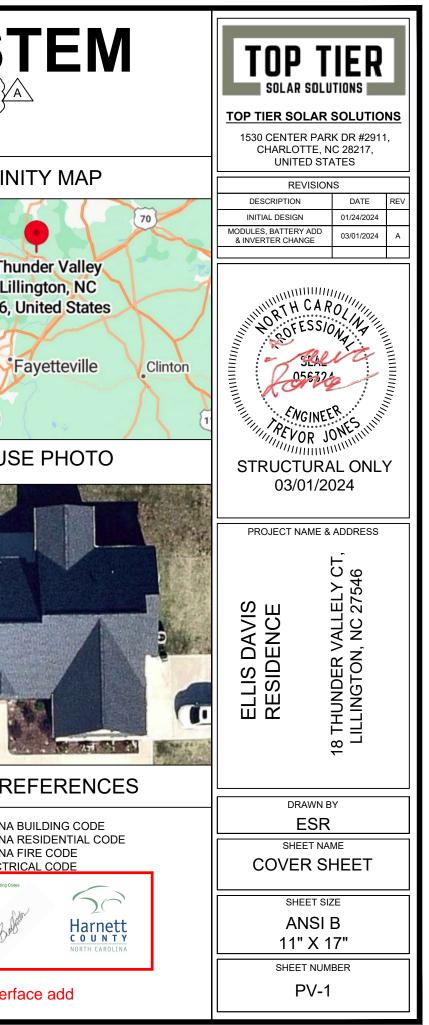

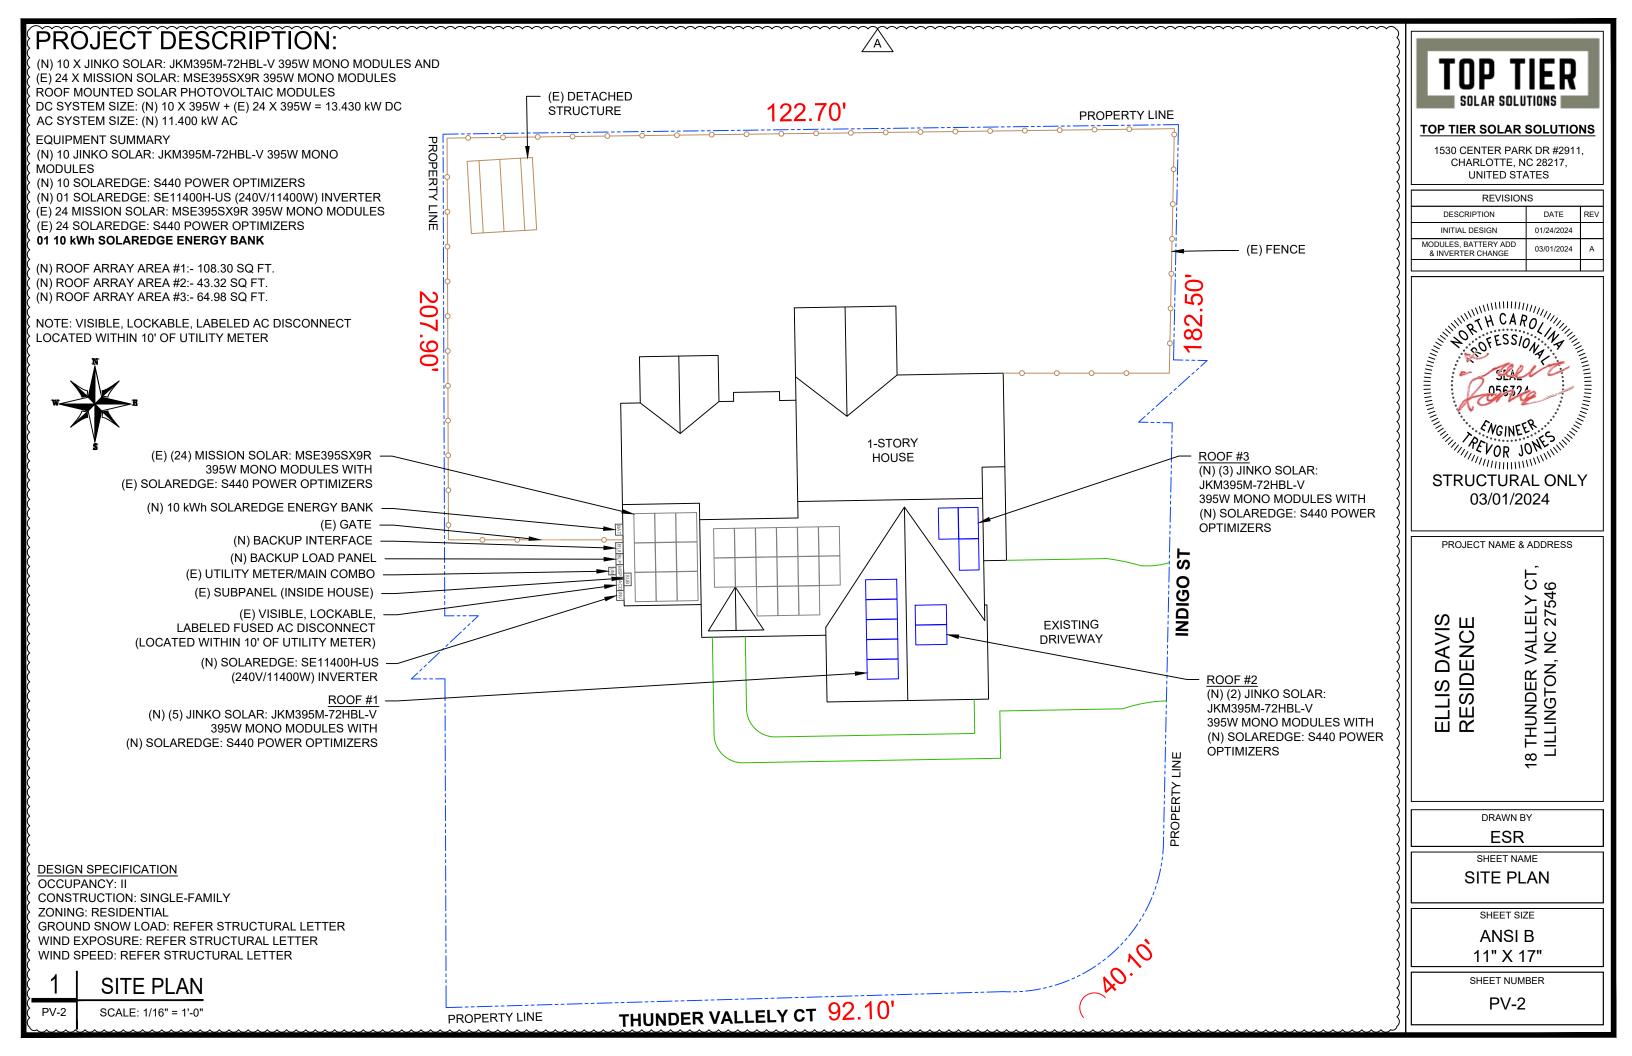

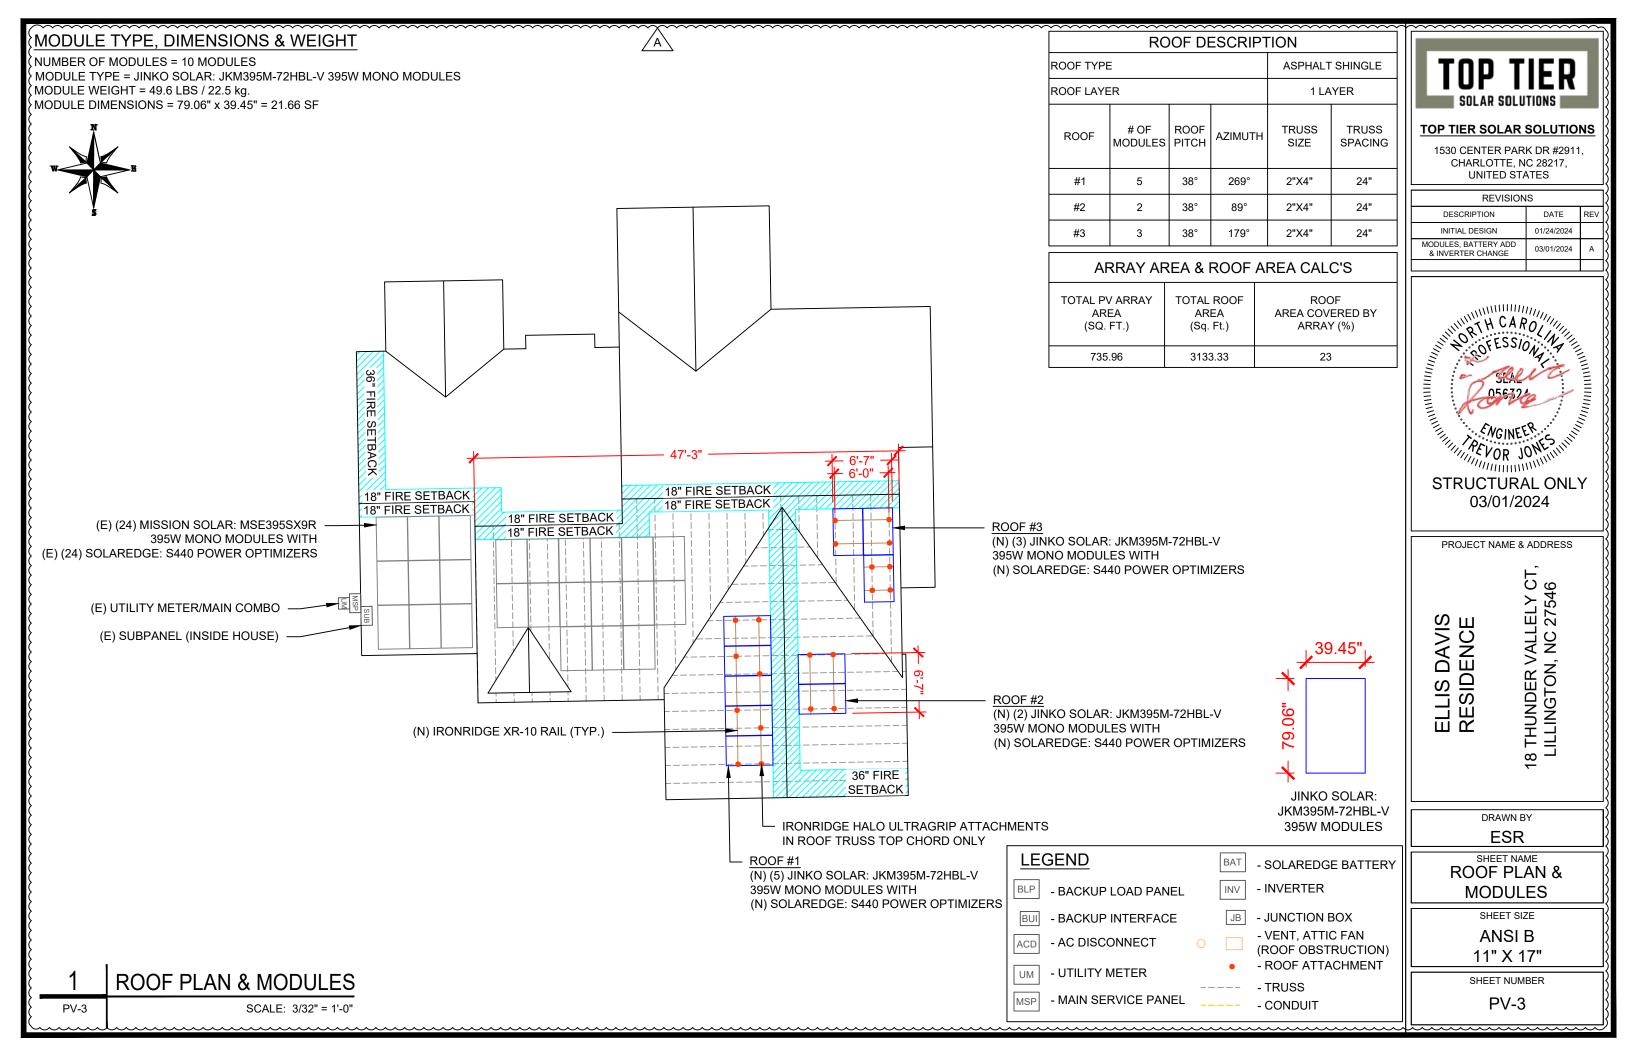

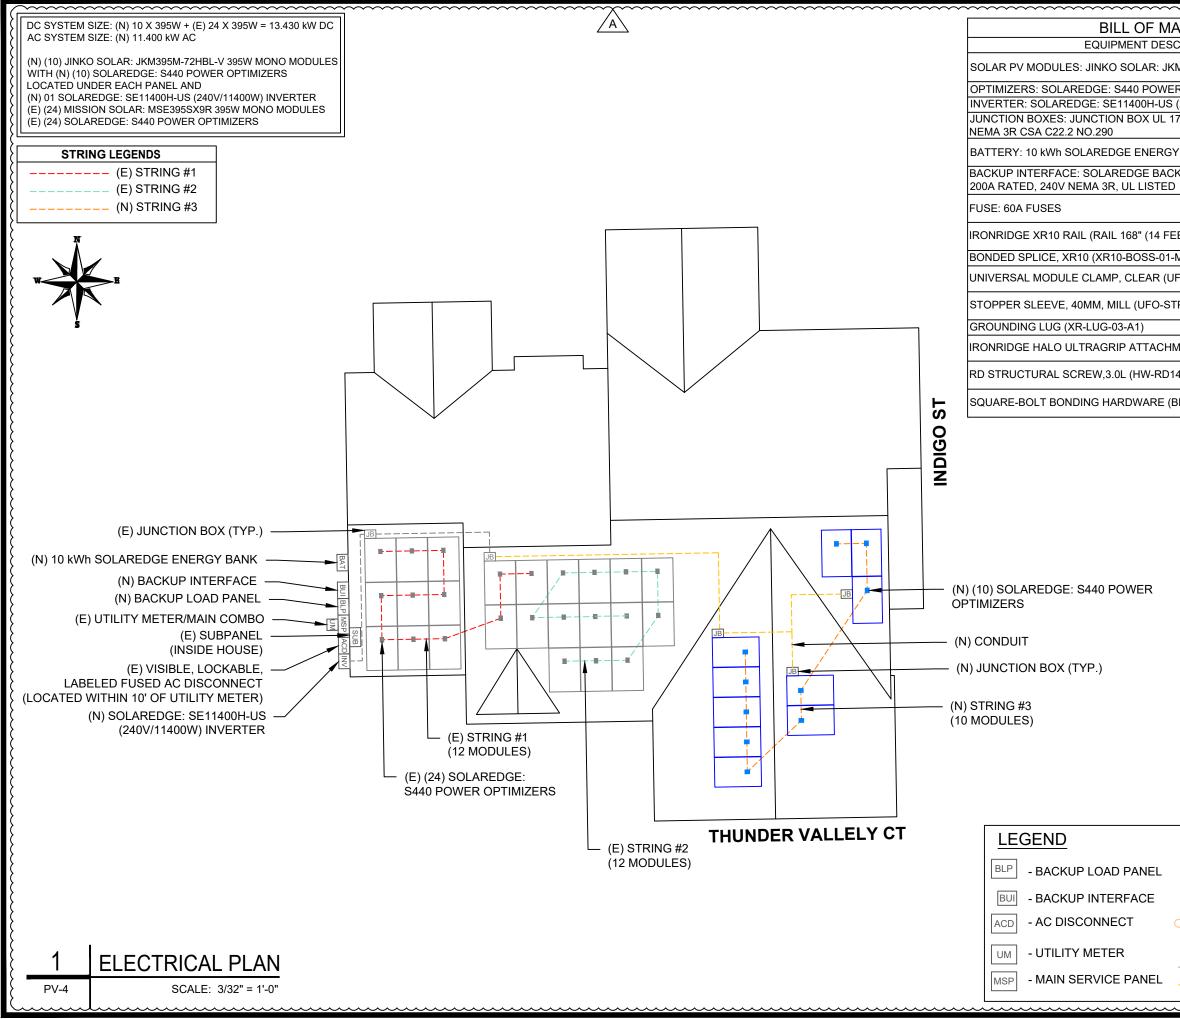

~~~~~~~~~~~~~~~~~~~~~~~~~~~~~~~~~~~~~~~	<u> </u>	7	
ATERIALS		₹	
CRIPTION	QTY	ł	T
M395M-72HBL-V 395W MODULE	10	$\mathbf{x}$	
R OPTIMIZERS	10		
(240V/11400W) INVERTER	01	ł	
1741,	3		<b>TOP TI</b> 1530
Y BANK	1	$\mathbf{i}$	C
CKUP INTERFACE <b>BI-NUSGN-01</b>	1		
	2	***********************************	DES <sup>I</sup> INITIA
EET) CLEAR) (XR-10-168A)	10		MODULES & INVER
-M1)	2		
IFO-CL-01-A1)	28		
TP-40MM-M1)	16	Š	
	4	1	
MENTS (QM-HUG-01-M1)	22	Ś	
1430-01-M1)	44	ł	
BHW-SQ-02-A1)	22	Š	
		~~~~~~~~	
			PRC
		*****	ELLIS DAVIS

BAT

INV

JB

- SOLAREDGE BATTERY

(ROOF OBSTRUCTION)

- ROOF ATTACHMENT

- INVERTER

- TRUSS

- CONDUIT

- JUNCTION BOX - VENT, ATTIC FAN



#### IER SOLAR SOLUTIONS

CENTER PARK DR #2911, CHARLOTTE, NC 28217, UNITED STATES

REVISIONS						
DESCRIPTION	DATE	REV				
INITIAL DESIGN	01/24/2024					
MODULES, BATTERY ADD & INVERTER CHANGE	03/01/2024	А				

OJECT NAME & ADDRESS

RESIDENCE

18 THUNDER VALLELY CT LILLINGTON, NC 27546

DRAWN BY

ESR

SHEET NAME

ANSI B


11" X 17"


SHEET NUMBER

PV-4

ELECTRICAL PLAN

SHEET SIZE

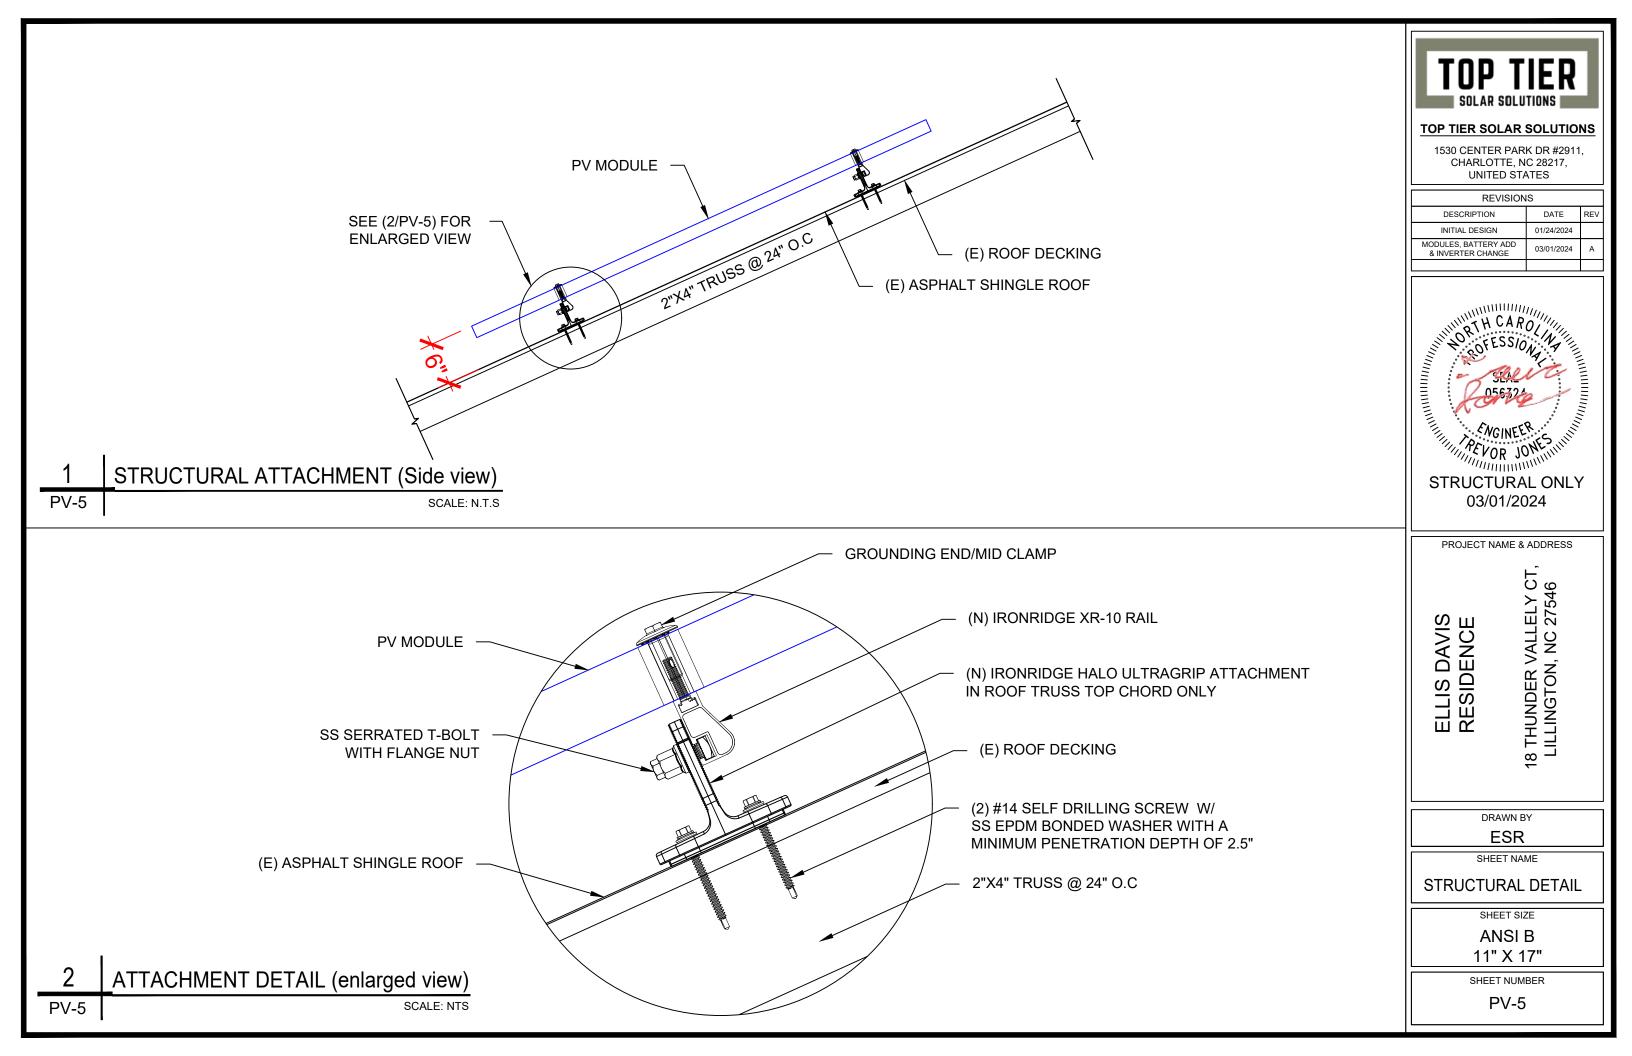


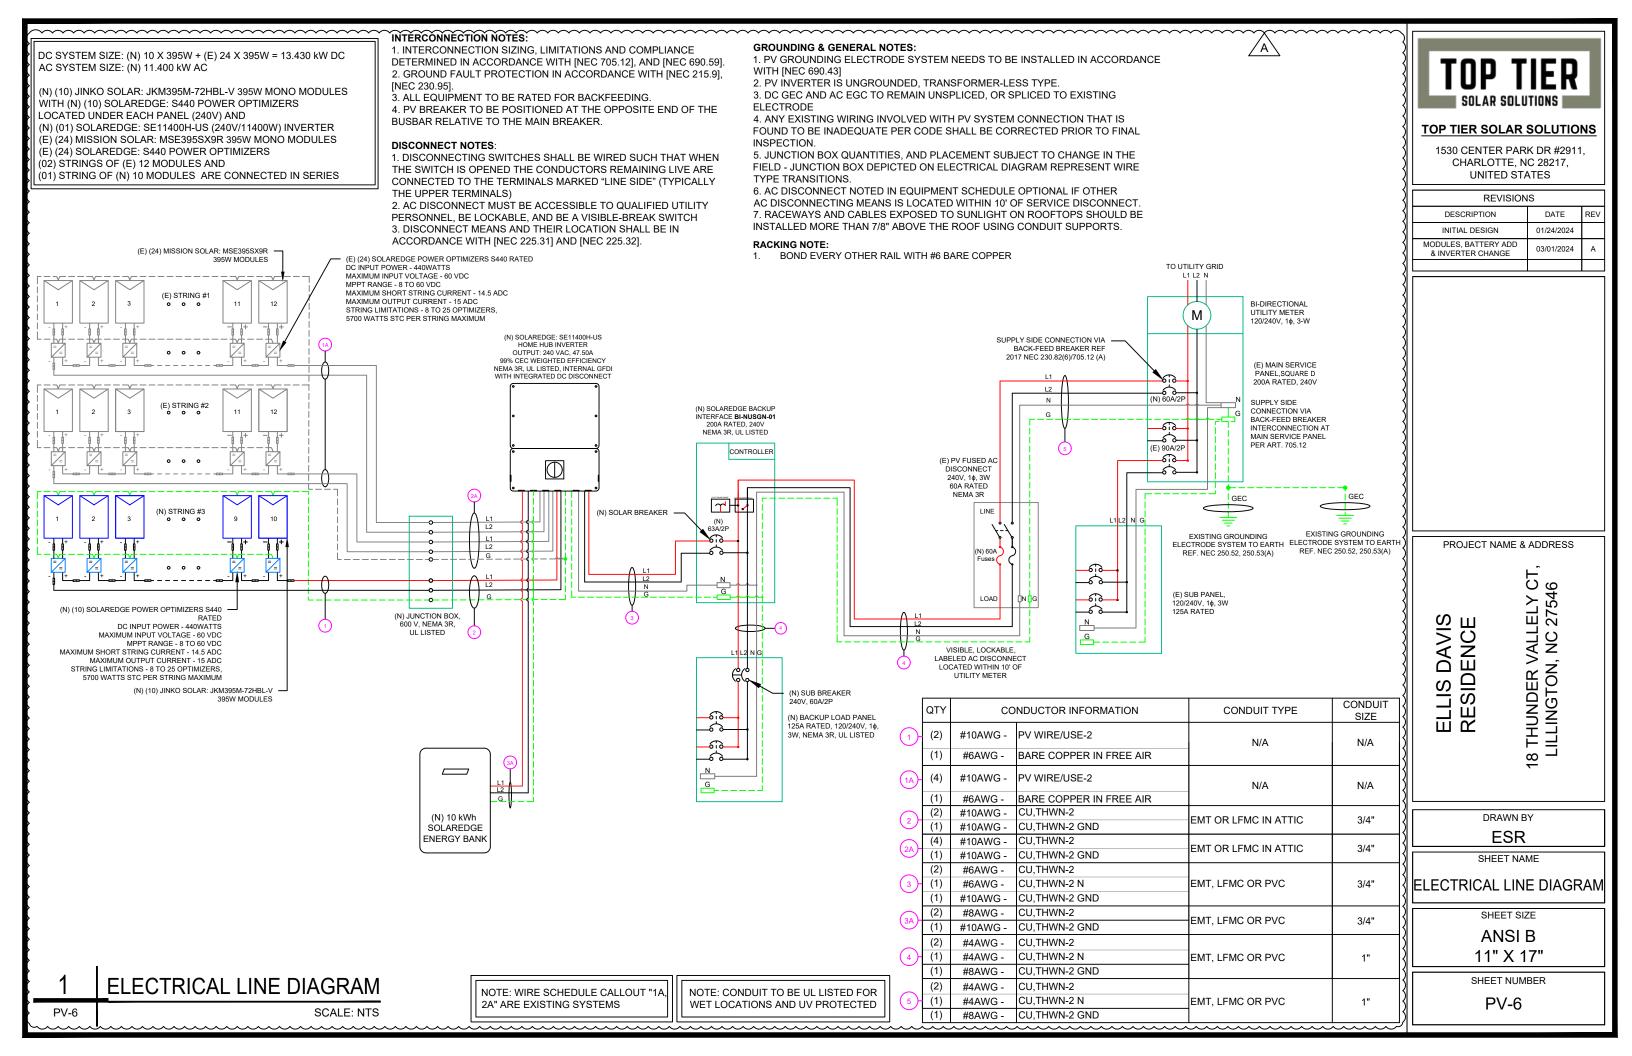

~~~~~~~~~~~~~~~~~~~~~~~~~~~~~~~~~~~~~~~	SOLAR MC					N								1				00000			
	SOLAR MO	DULE SPE	CIFICATIO	<u> </u>		{		INVERI	ER SPECIF						AMBIENT T			SPECS			
					/ 205\//	MANUFA	CTURER / MO	ODEL #			SE11400H	-US (240V/	11400W)		TEMP (HIGH T					18°	
MANUFACTURER / MODEL # JINKO SOLAR: JKM395M-72HBL-V 395W MODULE															$\backslash$						
MODOLL				N	L OUTPUT VO		11.400 k 240 VAC					MODULE T	EMPERATUR	RE COEF	FICIENT (		-0.29%/				
VMP	3	9.90V								5				-					~~~~	$\sim$	
IMP	g	.90A					NOMINAL OUTPUT CURRENT 47.50A			]											
VOC	4	8.80V				PERCE			BER OF CUI												
ISC	1	0.54A						CARRYING	CONDUCT	FORS IN	EMT										
TEMP. COEFF.	VOC -	0.29%/°C							4-6												
MODULE DIMEN	NSION 7	9.06"L x 39	.45"W x 1.57	"D (In Inch	)	.7			7-9												
				in		.5	0		10-20												
					2										/	4					
				~~~~											·····	~~~~	~~~~~	~~~~	~~~~		~~~~
	-					1										FACTOR			T		
			FULL LOAD	FLA *1 25	OCPD			:	75°C	PACITY	AMBIENT	TOTAL CC	90°C	FOR AMBIEN	TOR DERATION		90°C AMP		MPACITY	FEEDER	COND
CIRCUIT ORIGIN	CIRCUIT DESTINAT		AMPS "FLA'	, FLA*1.25 (A)	SIZE (A)	GROUND SIZE	CONDUCTO	R SIZE AM	PACITY		TEMP. (°C)	RS IN	AMPACITY (A				DERATED		HECK #2	LENGTH	RESIS
		(*)	(A)	(4)	SIZE (A)				(A)		1 EIVIP. ( C)	RACEWAY	AMPACIT	NEC 310.15(B)(			DERATED		HECK #2	(FEET)	(онм
STRING 1	JUNCTION BOX	380	15.00	18.75	20	BARE COPPER #6 AWG	G CU #10 A	WG	35 P	PASS	38	2	40	0.91	1		36.4		PASS	5	1.
STRING 2	JUNCTION BOX		15.00	18.75	20	BARE COPPER #6 AWG				PASS	38	2	40	0.91	1		36.4		PASS	5	1.
STRING 3	JUNCTION BOX	380	15.00	18.75	20	BARE COPPER #6 AWG	G CU #10 A	WG	35 P	PASS	38	2	40	0.91	1		36.4		PASS	5	1.
JUNCTION BOX								and the second se			100 A 100 A	-	40	0.01	0.8		29.12				
JOINCHON BOX	INVERTER	380	15.00	18.75	20	CU #10 AWG	CU #10 A	WG	35 P	PASS	38	6	40	0.91	0.8	5	29.12		PASS	20	1.
SOLAREDGE BANK	INVERTER INVERTER	380 380	15.00 11.11	18.75 13.89	20	CU #10 AWG	CU #10 A CU #8 A\			PASS PASS	38 38	6	55	0.91	1		50.05		PASS	5 String 1 V String 2 V	0. oltage oltage
																				5 String 1 V	0.7 oltage l oltage l
										PASS		2								5 String 1 V String 2 V	0. oltage oltage
			11.11						50 P	PASS AC FE	38	2 JLATIONS	55	0.91			50.05	5		5 String 1 V String 2 V String 3 V	0.7 oltage   oltage   oltage
SOLAREDGE BANK	INVERTER	380	FULL LOAD	13.89		CU #10 AWG	CU #8 A\		50 P	AC FE	38 EDER CALCU ACITY AM	2 JLATIONS BIENT TO	55 TAL CC	0.91	DERATION FACTO FOR AMBIENT	R DERATI	50.05 ION FACTOR DNDUCTORS	90°C AMPACITY	PASS	5 String 1 V String 2 V String 3 V	0.1 oltage oltage oltage
SOLAREDGE BANK		380	FULL LOAD AMPS "FLA"	13.89 FLA*1.25	20				50 P TOR 75°C AMPACIT	AC FE	38 EDER CALCU ACITY AM	2 JLATIONS BIENT TO CONI	TAL CC DUCTORS 90°	0.91 C AMPACITY (A)	DERATION FACTOR FOR AMBIENT EMPERATURE NE	R DERATI FOR CO	50.05 ION FACTOR DNDUCTORS ICEWAY NEC	90°C AMPACITY DERATED	PASS	5 String 1 V String 2 V String 3 V	0.1 oltage oltage oltage ER TH
SOLAREDGE BANK		DN VOLTAGE (V)	FULL LOAD AMPS "FLA" (A)	13.89 FLA*1.25 (A)	OCPD SIZE (A)	CU #10 AWG	GROUND SIZE		50 P TOR 75°C AMPACII (A)	AC FE TY AMP	38 EDER CALCU ACITY AM CK #1 TEM	JLATIONS BIENT IP. (°C)	TAL CC DUCTORS ACEWAY	C AMPACITY (A)	PERATION FACTOR FOR AMBIENT EMPERATURE NE 310.15(B)(2)(a)	R DERATI FOR CO	50.05 ION FACTOR DNDUCTORS .CEWAY NEC L5(B)(3)(a)	90°C AMPACITY DERATED (A)	PASS	5 String 1 V String 2 V String 3 V ITY #2 FEED LENG (FEE	0.: oltage oltage oltage ER TH T)
SOLAREDGE BANK CIRCUIT ORIGIN INVERTER	INVERTER CIRCUIT DESTINATIO BACKUP INTERFAC	380 DN VOLTAGE (V) E 240	FULL LOAD           AMPS "FLA"           (A)           47.5	13.89 FLA*1.25 (A) 59.375	0CPD 5IZE (A) 63	CU #10 AWG	GROUND SIZE	• CONDUC SIZE	50 P TOR 75°C AMPACIT (A) VG 65	AC FE TY AMP. CHEC	38 EDER CALCU ACITY AM CK #1 TEM	JLATIONS BIENT IP. (°C) 38	TAL CC DUCTORS ACEWAY 2	0.91	DERATION FACTOR FOR AMBIENT EMPERATURE NE 310.15(B)(2)(a) 0.91	R DERATI FOR CO	50.05 ION FACTOR INDUCTORS ICEWAY NEC L5(B)(3)(a) 1	90°C AMPACITY DERATED (A) 68.25	PASS	5 String 1 V String 2 V String 3 V ITY #2 FEED LENG (FEE	0.7 oltage l oltage l oltage l ER TH TH
SOLAREDGE BANK CIRCUIT ORIGIN INVERTER BACKUP INTERFACE	INVERTER CIRCUIT DESTINATIO BACKUP INTERFAC BACKUP LOAD PAN	380           DN         VOLTAGE (V)           E         240           EL         240	FULL LOAD AMPS "FLA" (A) 47.5 60	13.89 FLA*1.25 (A) 59.375 60	0CPD SIZE (A) 63 60	CU #10 AWG	GROUND SIZE	E CONDUC SIZE CU #6 A CU #4 A	50 P 70R 75°C AMPACIT (A) NG 65 NG 85	AC FE TY AMP. CHEC PA	38 EDER CALCU ACITY AM CK #1 TEM ASS	JLATIONS BIENT IP. (°C) 38 38	TAL CC DUCTORS ACEWAY 2 2	0.91 C AMPACITY (A) 75 95	DERATION FACTOR FOR AMBIENT EMPERATURE NE 310.15(B)(2)(a) 0.91 0.91	R DERATI FOR CO	50.05 ION FACTOR DNDUCTORS ICEWAY NEC L5(B)(3)(a) 1 1	90°C AMPACITY DERATED (A) 68.25 86.45	PASS  AMPACI AMPACK PASS PASS	5 String 1 V String 2 V String 3 V FEED LENG (FEE 5 5 5	0.7 oltage l oltage l oltage l ER TH TH
SOLAREDGE BANK CIRCUIT ORIGIN INVERTER BACKUP INTERFACE BACKUP INTERFACE	INVERTER CIRCUIT DESTINATIO BACKUP INTERFAC BACKUP LOAD PAN AC DISCONNECT	380 DN VOLTAGE (V) E 240	FULL LOAD           AMPS "FLA"           (A)           47.5           60           47.5	13.89           FLA*1.25 (A)           59.375           60           59.375	0CPD SIZE (A) 63 60 60	CU #10 AWG	GROUND SIZE	E CONDUC SIZE CU #6 A CU #4 A CU #4 A	50 P TOR 75°C AMPACIT (A) NG 65 NG 85 NG 85	AC FE TY AMP, CHEC PA PA PA	38 EDER CALCU ACITY AM CK #1 TEM ASS ASS	JLATIONS BIENT IP. (°C) 38 38 38 38	TAL CC DUCTORS ACEWAY 2	0.91 C AMPACITY (A) 75 95 95	DERATION FACTOR FOR AMBIENT EMPERATURE NE 310.15(B)(2)(a) 0.91 0.91 0.91	R DERATI FOR CO	50.05 ION FACTOR INDUCTORS ICEWAY NEC L5(B)(3)(a) 1	90°C AMPACITY DERATED (A) 68.25 86.45 86.45	PASS AMPACI AMPACI CHECK PASS PASS PASS	5 String 1 V String 2 V String 3 V ITY FEED LENG (FEE 5 5 5 5 5	0.7 oltage l oltage l oltage l ER TH TH
SOLAREDGE BANK CIRCUIT ORIGIN INVERTER BACKUP INTERFACE	INVERTER CIRCUIT DESTINATIO BACKUP INTERFAC BACKUP LOAD PAN	380           DN         VOLTAGE (V)           E         240           EL         240	FULL LOAD AMPS "FLA" (A) 47.5 60	13.89 FLA*1.25 (A) 59.375 60	0CPD SIZE (A) 63 60	CU #10 AWG	GROUND SIZE	E CONDUC SIZE CU #6 A CU #4 A	50 P TOR 75°C AMPACIT (A) NG 65 NG 85 NG 85	AC FE TY AMP. CHEC PA	38 EDER CALCU ACITY AM CK #1 TEM ASS ASS	JLATIONS BIENT IP. (°C) 38 38	TAL CC DUCTORS ACEWAY 2 2 2 2	0.91 C AMPACITY (A) 75 95	DERATION FACTOR FOR AMBIENT EMPERATURE NE 310.15(B)(2)(a) 0.91 0.91	R DERATI FOR CO	50.05 ION FACTOR DNDUCTORS ICEWAY NEC I5(B)(3)(a) 1 1 1	90°C AMPACITY DERATED (A) 68.25 86.45	PASS  AMPACI AMPACK PASS PASS	5 String 1 V String 2 V String 3 V ITY FEED LENG (FEE 5 5 5 5 5	0.: oltage oltage oltage ER TH T)
SOLAREDGE BANK CIRCUIT ORIGIN INVERTER BACKUP INTERFACE BACKUP INTERFACE	INVERTER CIRCUIT DESTINATIO BACKUP INTERFAC BACKUP LOAD PAN AC DISCONNECT	380           DN         VOLTAGE (V)           E         240           EL         240	FULL LOAD           AMPS "FLA"           (A)           47.5           60           47.5	13.89           FLA*1.25 (A)           59.375           60           59.375	0CPD SIZE (A) 63 60 60	CU #10 AWG	GROUND SIZE	E CONDUC SIZE CU #6 A CU #4 A CU #4 A	50 P TOR 75°C AMPACIT (A) NG 65 NG 85 NG 85	AC FE TY AMP, CHEC PA PA PA	38 EDER CALCU ACITY AM CK #1 TEM ASS ASS	JLATIONS BIENT IP. (°C) 38 38 38 38	TAL CC DUCTORS ACEWAY 2 2 2 2	0.91 C AMPACITY (A) 75 95 95	DERATION FACTOR FOR AMBIENT EMPERATURE NE 310.15(B)(2)(a) 0.91 0.91 0.91	R DERATI FOR CO	50.05 ION FACTOR DNDUCTORS ICEWAY NEC I5(B)(3)(a) 1 1 1	90°C AMPACITY DERATED (A) 68.25 86.45 86.45	PASS AMPACI AMPACI CHECK PASS PASS PASS	5 String 1 V String 2 V String 3 V ITY FEED LENG (FEE 5 5 5 5 5	0.7 oltage l oltage l oltage l ER TH T)
SOLAREDGE BANK CIRCUIT ORIGIN INVERTER BACKUP INTERFACE BACKUP INTERFACE	INVERTER CIRCUIT DESTINATIO BACKUP INTERFAC BACKUP LOAD PAN AC DISCONNECT	380           DN         VOLTAGE (V)           E         240           EL         240	FULL LOAD           AMPS "FLA"           (A)           47.5           60           47.5	13.89           FLA*1.25 (A)           59.375           60           59.375	0CPD SIZE (A) 63 60 60	CU #10 AWG	GROUND SIZE	E CONDUC SIZE CU #6 A CU #4 A CU #4 A	50 P TOR 75°C AMPACIT (A) NG 65 NG 85 NG 85	AC FE TY AMP, CHEC PA PA PA	38 EDER CALCU ACITY AM CK #1 TEM ASS ASS	JLATIONS BIENT IP. (°C) 38 38 38 38	TAL CC DUCTORS ACEWAY 2 2 2 2	0.91 C AMPACITY (A) 75 95 95	DERATION FACTOR FOR AMBIENT EMPERATURE NE 310.15(B)(2)(a) 0.91 0.91 0.91	R DERATI FOR CO	50.05 ION FACTOR DNDUCTORS ICEWAY NEC I5(B)(3)(a) 1 1 1	90°C AMPACITY DERATED (A) 68.25 86.45 86.45	PASS AMPACI AMPACI CHECK PASS PASS PASS	5 String 1 V String 2 V String 3 V ITY FEED LENG (FEE 5 5 5 5 5 5 5	0. oltage oltage oltage ER TH T)
SOLAREDGE BANK CIRCUIT ORIGIN INVERTER BACKUP INTERFACE BACKUP INTERFACE	INVERTER CIRCUIT DESTINATIO BACKUP INTERFAC BACKUP LOAD PAN AC DISCONNECT	380           DN         VOLTAGE (V)           E         240           EL         240	FULL LOAD           AMPS "FLA"           (A)           47.5           60           47.5	13.89           FLA*1.25 (A)           59.375           60           59.375	0CPD SIZE (A) 63 60 60	CU #10 AWG	GROUND SIZE	E CONDUC SIZE CU #6 A CU #4 A CU #4 A	50 P TOR 75°C AMPACIT (A) VG 65 VG 85 VG 85	AC FE TY AMP, CHEC PA PA PA	38 EDER CALCU ACITY AM CK #1 TEM ASS ASS	JLATIONS BIENT IP. (°C) 38 38 38 38	TAL CC DUCTORS ACEWAY 2 2 2 2	0.91 C AMPACITY (A) 75 95 95	DERATION FACTOR FOR AMBIENT EMPERATURE NE 310.15(B)(2)(a) 0.91 0.91 0.91	R DERATI FOR CO	50.05 ION FACTOR DNDUCTORS ICEWAY NEC I5(B)(3)(a) 1 1 1	90°C AMPACITY DERATED (A) 68.25 86.45 86.45	PASS AMPACI AMPACI CHECK PASS PASS PASS	5 String 1 V String 2 V String 3 V ITY FEED LENG (FEE 5 5 5 5 5 5 5	0. oltage oltage oltage ER TH T)
SOLAREDGE BANK CIRCUIT ORIGIN INVERTER BACKUP INTERFACE BACKUP INTERFACE	INVERTER CIRCUIT DESTINATIO BACKUP INTERFAC BACKUP LOAD PAN AC DISCONNECT	380           DN         VOLTAGE (V)           E         240           EL         240	FULL LOAD           AMPS "FLA"           (A)           47.5           60           47.5	13.89           FLA*1.25 (A)           59.375           60           59.375	0CPD SIZE (A) 63 60 60	CU #10 AWG	GROUND SIZE	E CONDUC SIZE CU #6 A CU #4 A CU #4 A	50 P TOR 75°C AMPACIT (A) VG 65 VG 85 VG 85	AC FE TY AMP, CHEC PA PA PA	38 EDER CALCU ACITY AM CK #1 TEM ASS ASS	JLATIONS BIENT IP. (°C) 38 38 38 38	TAL CC DUCTORS ACEWAY 2 2 2 2	0.91 C AMPACITY (A) 75 95 95	DERATION FACTOR FOR AMBIENT EMPERATURE NE 310.15(B)(2)(a) 0.91 0.91 0.91	R DERATI FOR CO	50.05 ION FACTOR DNDUCTORS ICEWAY NEC I5(B)(3)(a) 1 1 1	90°C AMPACITY DERATED (A) 68.25 86.45 86.45	PASS AMPACI AMPACI CHECK PASS PASS PASS	5 String 1 V String 2 V String 3 V ITY FEED LENG (FEE 5 5 5 5 5 5 5	O. oltage oltage oltage ER TH T)
SOLAREDGE BANK CIRCUIT ORIGIN INVERTER BACKUP INTERFACE BACKUP INTERFACE	INVERTER CIRCUIT DESTINATIO BACKUP INTERFAC BACKUP LOAD PAN AC DISCONNECT	380           DN         VOLTAGE (V)           E         240           EL         240	FULL LOAD           AMPS "FLA"           (A)           47.5           60           47.5	13.89           FLA*1.25 (A)           59.375           60           59.375	0CPD SIZE (A) 63 60 60	CU #10 AWG	GROUND SIZE	E CONDUC SIZE CU #6 A CU #4 A CU #4 A	50 P TOR 75°C AMPACIT (A) VG 65 VG 85 VG 85	AC FE TY AMP, CHEC PA PA PA	38 EDER CALCU ACITY AM CK #1 TEM ASS ASS	JLATIONS BIENT IP. (°C) 38 38 38 38	TAL CC DUCTORS ACEWAY 2 2 2 2	0.91 C AMPACITY (A) 75 95 95	DERATION FACTOR FOR AMBIENT EMPERATURE NE 310.15(B)(2)(a) 0.91 0.91 0.91	R DERATI FOR CO	50.05 ION FACTOR DNDUCTORS ICEWAY NEC I5(B)(3)(a) 1 1 1	90°C AMPACITY DERATED (A) 68.25 86.45 86.45	PASS AMPACI AMPACI CHECK PASS PASS PASS	5 String 1 V String 2 V String 3 V ITY FEED LENG (FEE 5 5 5 5 5 5 5	O.: oltage oltage oltage ER TH T)
SOLAREDGE BANK CIRCUIT ORIGIN INVERTER BACKUP INTERFACE BACKUP INTERFACE	INVERTER CIRCUIT DESTINATIO BACKUP INTERFAC BACKUP LOAD PAN AC DISCONNECT	380           DN         VOLTAGE (V)           E         240           EL         240	FULL LOAD           AMPS "FLA"           (A)           47.5           60           47.5	13.89           FLA*1.25 (A)           59.375           60           59.375	0CPD SIZE (A) 63 60 60	CU #10 AWG	GROUND SIZE	E CONDUC SIZE CU #6 A CU #4 A CU #4 A	50 P TOR 75°C AMPACIT (A) VG 65 VG 85 VG 85	AC FE TY AMP, CHEC PA PA PA	38 EDER CALCU ACITY AM CK #1 TEM ASS ASS	JLATIONS BIENT IP. (°C) 38 38 38 38	TAL CC DUCTORS ACEWAY 2 2 2 2	0.91 C AMPACITY (A) 75 95 95	DERATION FACTOR FOR AMBIENT EMPERATURE NE 310.15(B)(2)(a) 0.91 0.91 0.91	R DERATI FOR CO	50.05 ION FACTOR DNDUCTORS ICEWAY NEC I5(B)(3)(a) 1 1 1	90°C AMPACITY DERATED (A) 68.25 86.45 86.45	PASS AMPACI AMPACI CHECK PASS PASS PASS	5 String 1 V String 2 V String 3 V ITY FEED LENG (FEE 5 5 5 5 5 5 5	O.: oltage oltage oltage ER TH T)
SOLAREDGE BANK CIRCUIT ORIGIN INVERTER BACKUP INTERFACE BACKUP INTERFACE	INVERTER CIRCUIT DESTINATIO BACKUP INTERFAC BACKUP LOAD PAN AC DISCONNECT	380           DN         VOLTAGE (V)           E         240           EL         240	FULL LOAD           AMPS "FLA"           (A)           47.5           60           47.5	13.89           FLA*1.25 (A)           59.375           60           59.375	0CPD SIZE (A) 63 60 60	CU #10 AWG	GROUND SIZE	E CONDUC SIZE CU #6 A CU #4 A CU #4 A	50 P TOR 75°C AMPACIT (A) VG 65 VG 85 VG 85	AC FE TY AMP, CHEC PA PA PA	38 EDER CALCU ACITY AM CK #1 TEM ASS ASS	JLATIONS BIENT IP. (°C) 38 38 38 38	TAL CC DUCTORS ACEWAY 2 2 2 2	0.91 C AMPACITY (A) 75 95 95	DERATION FACTOR FOR AMBIENT EMPERATURE NE 310.15(B)(2)(a) 0.91 0.91 0.91	R DERATI FOR CO	50.05 ION FACTOR DNDUCTORS ICEWAY NEC I5(B)(3)(a) 1 1 1	90°C AMPACITY DERATED (A) 68.25 86.45 86.45	PASS AMPACI AMPACI CHECK PASS PASS PASS	5 String 1 V String 2 V String 3 V ITY FEED LENG (FEE 5 5 5 5 5 5 5	0.7 oltage l oltage l oltage l ER TH T)
#### ELECTRICAL NOTES

- 1. ALL EQUIPMENT TO BE LISTED BY UL OR OTHER NRTL, AND LABELED FOR ITS APPLICATION.
- 2. ALL CONDUCTORS SHALL BE COPPER, RATED FOR 600 V AND 90 DEGREE C WET ENVIRONMENT.
- 3. WIRING, CONDUIT, AND RACEWAYS MOUNTED ON ROOFTOPS SHALL BE ROUTED DIRECTLY TO, AND LOCATED AS CLOSE AS POSSIBLE TO THE NEAREST RIDGE, HIP, OR VALLEY.
- 4. WORKING CLEARANCES AROUND ALL NEW AND EXISTING ELECTRICAL EQUIPMENT SHALL COMPLY WITH NEC 110.26.
- 5. DRAWINGS INDICATE THE GENERAL ARRANGEMENT OF SYSTEMS. CONTRACTOR SHALL FURNISH ALL NECESSARY OUTLETS, SUPPORTS, FITTINGS AND ACCESSORIES TO FULFILL APPLICABLE CODES AND STANDARDS.
- 6. WHERE SIZES OF JUNCTION BOX, RACEWAYS, AND CONDUITS ARE NOT SPECIFIED, THE CONTRACTOR SHALL SIZE THEM ACCORDINGLY.
- 7. ALL WIRE TERMINATIONS SHALL BE APPROPRIATELY LABELED AND READILY VISIBLE.
- 8. MODULE GROUNDING CLIPS TO BE INSTALLED BETWEEN MODULE FRAME AND MODULE SUPPORT RAIL, PER THE GROUNDING CLIP MANUFACTURER'S INSTRUCTION.
- 9. MODULE SUPPORT RAIL TO BE BONDED TO CONTINUOUS COPPER G.E.C. VIA WEEB LUG OR ILSCO GBL-4DBT LAY-IN LUG.
- 10. TEMPERATURE RATINGS OF ALL CONDUCTORS, TERMINATIONS, BREAKERS, OR OTHER DEVICES ASSOCIATED WITH THE SOLAR PV SYSTEM SHALL BE RATED FOR AT LEAST 75 DEGREE C.

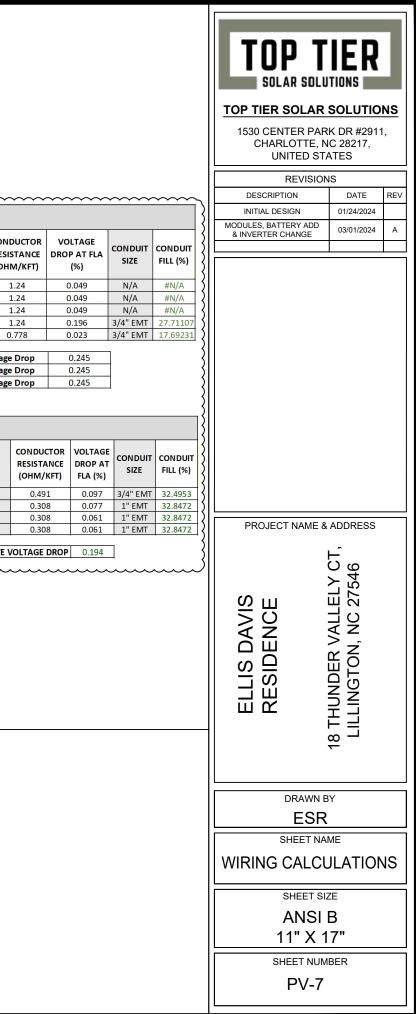

#### PHOTOVOLTAIC POWER SOURCE

#### EVERY 10' ON CONDUIT & ENCLOSURES

LABEL- 1: <u>LABEL LOCATION:</u> EMT/CONDUIT RACEWAY SOLADECK / JUNCTION BOX CODE REF: NEC 690.31 (D)(2)

#### 

#### ELECTRIC SHOCK HAZARD

TERMINALS ON THE LINE AND LOAD SIDES MAY BE ENERGIZED IN THE OPEN POSITION

LABEL- 2: <u>LABEL LOCATION:</u> AC DISCONNECT CODE REF: NEC 690.13(B)

WARNING TRI POWER SOURCE SECOND SOURCE IS PHOTOVOLTAIC SYSTEM THIRD SOURCE IS BATTERY SYSTEM

/ A /

LABEL- 3: LABEL LOCATION: UTILITY METER MAIN SERVICE PANEL SUBPANEL

CODE REF: NEC 705.12(C) & NEC 690.59

#### SOLAR PV BREAKER:

#### BREAKER IS BACKFED DO NOT RELOCATE


LABEL-4: <u>LABEL LOCATION:</u> MAIN SERVICE PANEL CODE REF: NEC 705.12(C) & NEC 690.59



LABEL- 5:

LABEL LOCATION: MAIN SERVICE PANEL (ONLY IF SOLAR IS BACK-FED) SUBPANEL (ONLY IF SOLAR IS BACK-FED) CODE REF: NEC 705.12(B)(3)(2)

#### SOLAR PV SYSTEM EQUIPPED WITH RAPID SHUTDOWN

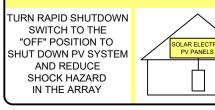

LABEL- 6: <u>LABEL LOCATION:</u> AC DISCONNECT CODE REF: [NEC 690.56(C)(1)(A)]

#### RAPID SHUTDOWN SWITCH FOR SOLAR PV SYSTEM

LABEL- 7: <u>LABEL LOCATION:</u> AC DISCONNECT MAIN SERVICE PANEL (ONLY IF SOLAR IS BACK-FED) CODE REF: NEC 690.56(C)(2)

#### DC DISCONNECT

LABEL- 8: LABEL LOCATION: INVERTER CODE REF: NEC 690.13(B)

AC DISCONNECT	
PHOTOVOLTAIC SYS	TEM
POWER SOURCE	
NOMINAL OPERATING AC VOLATGE	240 V
RATED AC OUTPUT CURRENT	47.50 A
LABEL- 9: L <u>ABEL LOCATION:</u> AC DISCONNECT CODE REF: NEC 690.54	
MAXIMUM VOLTAGE	480 V
MAXIMUM CIRCUIT CURRENT	30.00 A
MAXIMUM RATED OUTPUT CURRENT OF THE CHARGE CONTROLLER OR DC-TO-DC CONVERTER (IF INSTALLED)	
LABEL- 10: LABEL LOCATION <u>:</u> ON THE RIGHT SIDE OF THE INVERTER CODE REF: NEC 690.53	R (PRE-EXISTING ON THE INVERTER)

DECENSIONS         SOLAR SOLUTIONS         SOLAR SOLUTIONS         DEPTIER SOLAR SOLUTIONS         REVISIONS         DESCRIPTION         DATE REV         NODUCES, BATTERY ADD         SOLAT ENANCE & ADDRESS         OPOJECT NAME & ADDRESS         SOLAR SOLUTION NOTSON NOTSON NOTSON         OPOJECT NAME & ADDRESS         SOLAR SOLUTION NOTSON NOTSON         DISTORY NOTSON NOTSON NOTSON         OPOJECT NAME & ADDRESS         DISTORY NOTSON NOTSON NOTSON         DISTORY NOTSON NOTSON NOTSON         DISTORY NOTSON NOTSON NOTSON NOTSON NOTSON			
SOLAR SOLUTIONS			
SOLAR SOLUTIONS	TODT		
SOLAR SOLUTIONS		ᆘᆔ	
TOP TIER SOLAR SOLUTIONS 1530 CENTER PARK DR #2911, CHARLOTTE, NC 28217, UNITED STATES REVISIONS DESCRIPTION DATE REV INITIAL DESIGN 01/24/2024 MODULES, BATTERY ADD 03/01/2024 A INVERTER CHANGE 03/01/2024 A INVERTER CHANGE 03/01/2024 A SINCET NAME & ADDRESS INVERTER CHANGE 103/01/2024 A INVERTER CHANGE 03/01/2024 A INVERT			
1530 CENTER PARK DR #2911, CHARLOTTE, NC 28217, UNITED STATES         REVISIONS         DESCRIPTION         DATE         NUTED STATES         DESCRIPTION         DATE         NUTED SIGN         MODULES, BATTERY ADD         NUVERTER CHANGE         MODULES, BATTERY ADD         NUVERTER CHANGE         DATE         PROJECT NAME & ADDRESS         ON 'NO 501/2024         ON 'NO 501/	SOLAR SOLU	TIONS	
1530 CENTER PARK DR #2911, CHARLOTTE, NC 28217, UNITED STATES         REVISIONS         DESCRIPTION         DATE         NUTED STATES         DESCRIPTION         DATE         NUTED SIGN         MODULES, BATTERY ADD         NUVERTER CHANGE         MODULES, BATTERY ADD         NUVERTER CHANGE         DATE         PROJECT NAME & ADDRESS         ON 'NO 501/2024         ON 'NO 501/			
CHARLOTTE, NC 28217, UNITED STATES REVISIONS DESCRIPTION DATE REV INITIAL DESIGN 01/24/2024 A MODULES, BATTERY ADD 03/01/2024 A INVERTER CHANGE 03/01/2024 A INVERTER CHANGE 03/01/2024 A SINVERTER CHANGE 03/01/2024 A INVERTER CHANGE 03/01/2024 A SINUERTER CHANGE 03/01/2024 A INVERTER CHANGE 03/01	TOP TIER SOLAR	SOLUTIO	NS
CHARLOTTE, NC 28217, UNITED STATES REVISIONS DESCRIPTION DATE REV INITIAL DESIGN 01/24/2024 A MODULES, BATTERY ADD 03/01/2024 A INVERTER CHANGE 03/01/2024 A INVERTER CHANGE 03/01/2024 A SINVERTER CHANGE 03/01/2024 A INVERTER CHANGE 03/01/2024 A SINUERTER CHANGE 03/01/2024 A INVERTER CHANGE 03/01	1530 CENTER PAR	K DR #2911	
UNITED STATES			,
DESCRIPTION DATE REV INITIAL DESIGN 01/24/2024 A MODULES, BATTERY ADD & INVERTER CHANGE 03/01/2024 A INVERTER CHANGE 03/01/2024 A INVERTER CHANGE ADDRESS INVERTER CHANGE ADDR			
DESCRIPTION DATE REV INITIAL DESIGN 01/24/2024 A MODULES, BATTERY ADD & INVERTER CHANGE 03/01/2024 A INVERTER CHANGE 03/01/2024 A INVERTER CHANGE ADDRESS INVERTER CHANGE ADDR			
INITIAL DESIGN 01/24/2024 A MODULES, BATTERY ADD & INVERTER CHANGE 03/01/2024 A INVERTER CHANGE 03/01/2024 A INVERTER CHANGE ADDRESS INTER CHANGE & ADDRESS INTE	REVISION	IS	
MODULES, BATTERY ADD & INVERTER CHANGE 03/01/2024 A A A A A A A A A A A A A	DESCRIPTION	DATE	REV
A INVERTER CHANGE 03/01/2024 A USU 01/2024 A	INITIAL DESIGN	01/24/2024	
DRAWN BY ESR SHEET NAME LABELS SHEET NAME LABELS SHEET SIZE ANSI B 11" X 17" SHEET NUMBER		03/01/2024	А
LABELS SHEET NAME LABELS SHEET SIZE ANSI B 11" X 17" SHEET NUMBER	& INVERTER CHANGE	00/0 //2021	
LABELS SHEET NAME LABELS SHEET SIZE ANSI B 11" X 17" SHEET NUMBER			
LABELS SHEET NAME LABELS SHEET SIZE ANSI B 11" X 17" SHEET NUMBER			
DRAWN BY ESR BHEET NAME LABELS SHEET SIZE ANSI B 11" X 17" SHEET NUMBER	PROJECT NAME &	ADDRESS	
DRAWN BY ESR BHEET NAME LABELS SHEET SIZE ANSI B 11" X 17" SHEET NUMBER			
DRAWN BY ESR BHEET NAME LABELS SHEET SIZE ANSI B 11" X 17" SHEET NUMBER		É.	
DRAWN BY ESR BHEET NAME LABELS SHEET SIZE ANSI B 11" X 17" SHEET NUMBER		ပဖ	
DRAWN BY ESR BHEET NAME LABELS SHEET SIZE ANSI B 11" X 17" SHEET NUMBER		≻ ¼	
DRAWN BY ESR SHEET NAME LABELS SHEET SIZE ANSI B 11" X 17" SHEET NUMBER		1 K	
DRAWN BY ESR SHEET NAME LABELS SHEET SIZE ANSI B 11" X 17" SHEET NUMBER	ОШ	Щζ	
DRAWN BY ESR SHEET NAME LABELS SHEET SIZE ANSI B 11" X 17" SHEET NUMBER		-l 0	
DRAWN BY ESR SHEET NAME LABELS SHEET SIZE ANSI B 11" X 17" SHEET NUMBER		₹ž	
DRAWN BY ESR SHEET NAME LABELS SHEET SIZE ANSI B 11" X 17" SHEET NUMBER		>	
DRAWN BY ESR SHEET NAME LABELS SHEET SIZE ANSI B 11" X 17" SHEET NUMBER		r Z	
DRAWN BY ESR SHEET NAME LABELS SHEET SIZE ANSI B 11" X 17" SHEET NUMBER	v ∐	ШO	
DRAWN BY ESR SHEET NAME LABELS SHEET SIZE ANSI B 11" X 17" SHEET NUMBER		o 72	
DRAWN BY ESR SHEET NAME LABELS SHEET SIZE ANSI B 11" X 17" SHEET NUMBER	I I III	zÿ	
DRAWN BY ESR SHEET NAME LABELS SHEET SIZE ANSI B 11" X 17" SHEET NUMBER	「ヨマ	⊇≦	
DRAWN BY ESR SHEET NAME LABELS SHEET SIZE ANSI B 11" X 17" SHEET NUMBER		픈 글	
11" X 17" SHEET NUMBER		B	
SHEET NUMBER			
	<u>11" X 1</u>	<u> </u>	
		BER	
PV-8			
	1		
1	P\/_8		

# **EAGLE CONTINENTAL**

#### 380-400 WATT • MONO PERC HALF-CELL MODULE

Positive power tolerance of 0~+3%

G

- NYSE-listed since 2010, Bloomberg Tier 1 manufacturer
- Top performance in the strictest 3rd party labs
- Automated manufacturing utilizing artificial intelligence
- · Vertically integrated, tight controls on quality
- Premium solar module factory in Jacksonville, Florida



TOUGH

BACKSHEET

#### **KEY FEATURES**

ASSEMBLED IN THE

USA



#### Superior Aesthetics

Black backsheet and black frame create ideal look for residential applications.



TOUGH

#### Diamond Half-Cell Technology

World-record breaking efficient mono PERC half-cells deliver high power in a small footprint.

#### Thick and Tough

Fire Type 1 rated module engineered with a thick frame, 3.2mm front side glass, and thick backsheet for added durability.

• ISO9001:2008 Quality Standards

IEC61215. IEC61730 certified

IS014001:2004 Environmental Standards

#### Shade Tolerant

Twin array design allows continued performance even with shading by trees or debris.





8

Certified to withstand humidity, heat, rain, marine environments, wind, hailstorms, and packed snow.




25-year product and 25-year linear power warranty.


- ISO 45001 2018 Occupational
- Health & Safety Standards
- UL1703/61730 certified

#### BUILDING YOUR TRUST IN SOLAR, WWW, JINKOSOLAR, US



#### ENGINEERING DRAWINGS

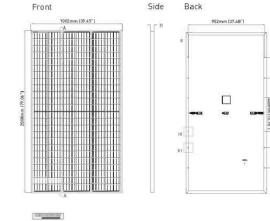

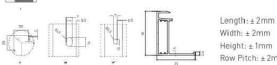

#### Width: ± 2mm Height: ± 1mm Row Pitch: ± 2mm

#### MAXIMUM RATINGS

Operating Temperature (°C) Maximum System Voltage Maximum Series Fuse Rating

#### PACKAGING CONFIGURATION

(Two pallets = One stack)

#### WARRANTY

#### ELECTRICAL CHARACTERISTICS

Voltage (V)

Current-Voltage & Power-Voltage

Curves (400W)

JU14120014	I-72HBL-V	JKM385M	I-72HBL-V	JKM390M	-72HBL-V
STC	NOCT	STC	NOCT	SCT	NOCT
380Wp	280Wp	385Wp	283Wp	390Wp	287Wp
39.10V	36.5V	39.37V	36.8V	39.64V	37.0V
9.72A	7.67A	9.78A	7.71A	9.84A	7.75A
48.2V	45.4V	48.4V	45.6V	48.6V	45.8V
10.3 0A	8.32A	10.38A	8.38A	10.46A	8.45A
18.8	39%	19.	13%	19.3	18%
			erc 2	) AM = 1.5 ) AM = 1.5	- 20
	STC 380Wp 39.10V 9.72A 48.2V 10.30A 18.8	STC         NOCT           380Wp         280Wp           39.10V         36.5V           9.72A         7.67A           48.2V         45.4V           10.30A         8.32A           18.89%	STC         NOCT         STC           380Wp         280Wp         385Wp           39.10V         36.5V         39.37V           9.72A         7.67A         9.78A           48.2V         45.4V         48.4V           10.30A         8.32A         10.38A           18.89%         19.*	STC         NOCT         STC         NOCT           380Wp         280Wp         385Wp         283Wp           39.10V         36.5V         39.37V         36.8V           9.72A         7.67A         9.78A         7.71A           48.2V         45.4V         48.4V         45.6V           10.30A         8.32A         10.38A         8.38A           18.89%         19.13%         19.13%	STC         NOCT         STC         NOCT         SCT           380Wp         280Wp         385Wp         283Wp         390Wp           39.10V         36.5V         39.37V         36.8V         39.64V           9.72A         7.67A         9.78A         7.71A         9.84A           48.2V         45.4V         48.4V         45.6V         48.6V           10.30A         8.32A         10.38A         8.38A         10.46A           18.89%         19.13%         19.3

The company reserves the final right for explanation on any of the information presented hereby, JKM380-400M-72HBL-V-F1-US

BUILDING YOUR TRUST IN SOLAR. WWW.JINKOSOLAR.US

#### MECHANICAL CHARACTERISTICS

Cells	Mono P
No. of Half Cells	144 (6 x
Dimensions	2008 x 1
Weight	22.5kg
Front Glass	3.2mm, High Tr
Frame	Anodize
Junction Box	IP68 Ra
Output Cables	12 AWG
Connector	Staubli
Fire Type	Type 1
Pressure Rating	5400Pa
Hailstone Test	50 mm l


#### TEMPERATURE CHARACTERISTICS

Temperature Coefficients of Pmax Temperature Coefficients of Voc Temperature Coefficients of Isc Nominal Operating Cell Temperature (NOCT)

#### **ELECTRICAL PERFORMANCE & TEMPERATURE DEPENDENCE** Temperature Dependence

of Isc. Voc. Pmax

# Cell Temperature (°C)

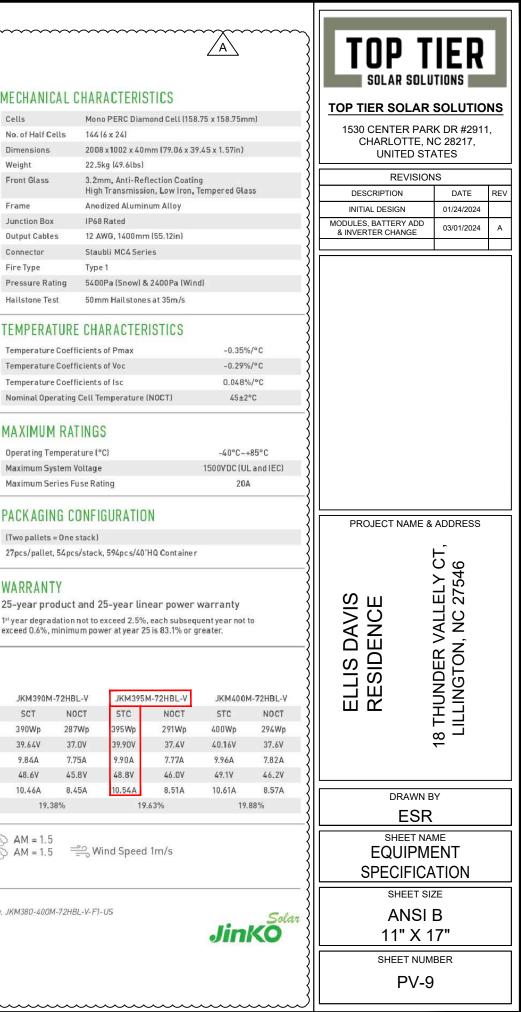

#### CERTIFICATE OF COMPLIANCE

Certificate Number Report Reference Date

E362479 E362479-20200410 2023-July-16

Issued to: JINKO SOLAR CO LTD No.1, Yingbin Road, Economic Development Zone Shangrao Jiangxi Sheng 334100 CN

This is to certify that representative samples of PHOTOVOLTAIC MODULES AND PANELS WITH SYSTEM VOLTAGE RATINGS OVER 600 VOLTS See Addendum Page for Product Designation(s).

Have been evaluated by UL in accordance with the Standard(s) indicated on this Certificate.

Standard(s) for Safety: UL 61730-1 - Standard for Photovoltaic (PV) Module Safety Qualification - Part 1: Requirements for Construction, Edition 2, Issue Date 10/28/2022 and UL 61730-2, Photovoltaic (PV) Module Safety Qualification - Part 2: Requirements for Testing, Edition 2, Revision Date 04/25/2023 and CSA C22.2 No. 61730-1:19 December 2019, Photovoltaic (PV) module safety qualification — Part 1: Requirements for construction and CSA C22.2 No. 61730-2:19 December 2019, Photovoltaic (PV) module safety qualification — Part 2: Requirements for testing.

Additional Information:

See the UL Online Certifications Directory at https://ig.ulprospector.com for additional information

This Certificate of Compliance indicates that representative samples of the product described in the certification report have met the requirements for UL certification. It does not provide authorization to apply the UL Mark. Only the Authorization Page that references the Follow-Up Services Procedure for ongoing surveillance provides authorization to apply the UL Mark.

Only those products bearing the UL Mark should be considered as being UL Certified and covered under UL's Follow-Up Services.

Look for the UL Certification Mark on the product.

enning lane nings-Conner, VP Regulatory Service

UL LLC

y information and documentation involving UL Mark services are provided on behalf of UL LLC (UL) or any authorized licensee of UL. For questions, plea ntact a local UL Customer Service Representative at http://ul.com/aboutul/locations/

#### CERTIFICATE OF COMPLIANCE

Certificate Number Report Reference Date E362479 E362479-20200410 2023-July-16

JKM525N-72HL4-V, JKM530N-72HL4-V, JKM535N-72HL4-V, JKM540N-72HL4-V, JKM545N-72HL4-V, JKM550N-72HL4-V, JKM550N-72HL4-V, JKM560N-72HL4-V, JKM565N-72HL4-V, JKM570N-72HL4-V, JKM575N-72HL4-V.

JKM480N-66HL4-V, JKM485N-66HL4-V, JKM490N-66HL4-V, JKM495N-66HL4-V, JKM500N-66HL4-V, JKM505N-66HL4-V, JKM510N-66HL4-V, JKM515N-66HL4-V, JKM520N-66HL4-V, JKM525N-66HL4-V

JKM435N-60HL4-V, JKM440N-60HL4-V, JKM445N-60HL4-V, JKM450N-60HL4-V, JKM455N-60HL4-V, JKM460N-60HL4-V, JKM465N-60HL4-V, JKM470N-60HL4-V, JKM475N-60HL4-V, JKM480N-60HL4-V.

JKM395N-54HL4-V, JKM400N-54HL4-V, JKM405N-54HL4-V, JKM410N-54HL4-V, JKM415N-54HL4-V, JKM420N-54HL4-V, JKM425N-54HL4-V, JKM430N-54HL4-V.

JKM565M-78HL4-V, JKM570M-78HL4-V, JKM575M-78HL4-V, JKM580M-78HL4-V, JKM585M-78HL4-V, JKM590M-78HL4-V, JKM595M-78HL4-V, JKM600M-78HL4-V, JKM605M-78HL4-V

JKM385N-54HL4-B-V, JKM390N-54HL4-B-V, JKM395N-54HL4-B-V, JKM400N-54HL4-B-V, JKM405N-54HL4-B-V, JKM410N-54HL4-B-V, JKM415N-54HL4-B-V, JKM420N-54HL4-B-V, JKM425N-54HL4-B-V, JKM430N-54HL4-B-V. JKM435N-54HL4-B-V, JKM440N-54HL4-B-V.

JKM585N-78HL4R-V, JKM590N-78HL4R-V, JKM595N-78HL4R-V, JKM600N-78HL4R-V, JKM605N-78HL4R-V, JKM610N-78HL4R-V, JKM615N-78HL4R-V, JKM620N-78HL4R-V, JKM625N-78HL4R-V, JKM630N-78HL4R-V, JKM635N-78HL4R-V, JKM640N-78HL4R-V, JKM645N-78HL4R-V, JKM650N-78HL4R-V

Ultrah Jewanp Conve-Deborah Jennings-Conner, VP Regulatory Service

Any information and documentation involving UL Mark services are provided on behalf of UL LLC (UL) or any authorized licensee of UL. For questions, | contact a local UL Customer Service Representative at <a href="http://ul.com/aboutul/locations/">http://ul.com/aboutul/locations/</a>

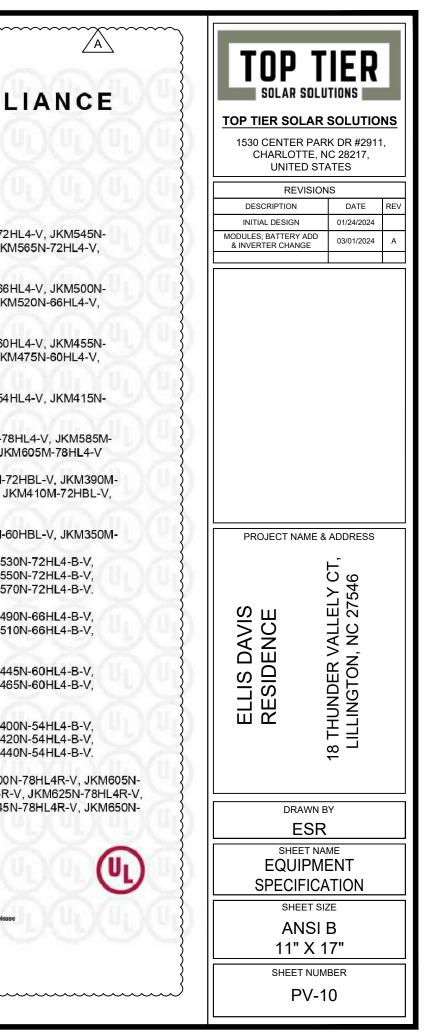

# **Power Optimizer**

#### **For Residential Installations**

#### S440 / S500 / S500B / S650B



# POWER OPTIMIZER

#### Enabling PV power optimization at the module level

- I Specifically designed to work with SolarEdge residential inverters
- I Detects abnormal PV connector behavior, preventing potential safety issues\*
- Module-level voltage shutdown for installer and firefighter safety
- Superior efficiency (99.5%)

\* Functionality subject to inverter model and firmware version

- Mitigates all types of module mismatch loss, from manufacturing tolerance to partial shading
- Faster installations with simplified cable management and easy assembly using a single bolt
- Flexible system design for maximum space utilization
- Compatible with bifacial PV modules

#### **/** Power Optimizer For Residential Installations S440 / S500 / S500B / S650B

	S440	S500	S500B	S650B	UNI
INPUT					
Rated Input DC Power <sup>(1)</sup>	440	5	00	650	W
Absolute Maximum Input Voltage (Voc)	60		125	85	Vdc
MPPT Operating Range	8-1	50	12.5 - 105	12.5 - 85	Vdc
Maximum Short Circuit Current (Isc) of Connected PV Module	14.5		15		Ado
Maximum Efficiency		99	9.5		%
Weighted Efficiency		98	3.6		%
Overvoltage Category			1		
OUTPUT DURING OPERTION					
Maximum Output Current		1	5		Add
Maximum Output Voltage	60		8	30	Vdd
OUTPUT DURING STANDBY (POWER OPTIMIZER	DISCONNECTED I	FROM INVERTER	OR INVERTER OF	F)	
Safety Output Voltage per Power Optimizer		1±	0.1		Vdd
STANDARD COMPLIANCE <sup>(2)</sup>					
EMC	FCC Part 1	5 Class B, IEC61000-6-2	, IEC61000-6-3, CISPR11, I	EN-55011	
Safety		IEC62109-1 (class	II safety), UL1741		
Material		UL94 V-0, U	JV Resistant		
RoHS		Ye	es		
Fire Safety		VDE-AR-E 210	0-712:2018-12		
INSTALLATION SPECIFICATIONS					
Maximum Allowed System Voltage		10	00		Vdd
Dimensions (W x L x H)	129 x 15	5 x 30	129 x 1	65 x 45	mm
Weight	720	)	7	90	gr
Input Connector		MC	4(3)		
Input Wire Length		0	.1		m
Output Connector		M	C4		
Output Wire Length		(+) 2.3,	(-) 0.10		m
Operating Temperature Range <sup>(4)</sup>		-40 to	o +85		°C
Protection Rating		IP	68		
Relative Humidity		0 -	100		%

(2) For details about CE compliance, see Declaration of Conformity - CE


(3) For other connector types please contact SolarEdge.

(4) Power	de-rating is applied for ambient te	mperatures above +85°C for	5440 and 5500,	and for ambient temperatures a	bove +75°C for S500B. Refer to the
Power	Optimizers Temperature De-Rating	<u>I Technical Note</u> for details.			

PV System Design Usi	ng a SolarEdge Inverter <sup>(5)</sup>	SolarEdge Home Wave Inverter Single Phase	SolarEdge Home Short String Inverter Three Phase	Three Phase for 230/400V Grid	Three Phase for 277/480V Grid	
Minimum String Length	S440, S 500	8	9	16	18	
(Power Optimizers)	S500B, S650B	6	8	1	4	
Maximum String Length (Po	ower Optimizers)	25	20	5	0	
Maximum Continuous Powe	er per String	5700	5625	11250	12750	W
	ted Power per String naximum is permitted only when the petween strings is 2,000W or less)	See <sup>i®</sup>	See <sup>isi</sup>	13500	15000	W
Parallel Strings of Different	Lengths or Orientations		Yes		1	

(5) It is not allowed to mix S-series and P-series Power Optimizers in new installations in the same string.

(6) If the inverter's rated AC power < maximum nominal power per string, then the maximum power per string will be able to reach up to the inverters maximum input DC power Refer to Application Note: Single String Design Guidelines

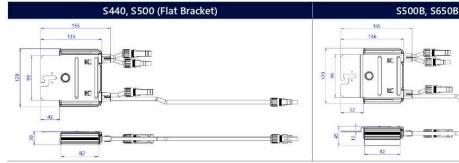

solaredge.com



© SolarEdge Technologies, Ltd. All rights reserved. SOLAREDGE, the SolarEdge logo, OPTIMIZED BY SOLAREDGE are trademarks or registered trademarks of SolarEdge Technologies, Inc. All other trademarks mentioned herein are trademarks of their respective owners. Date: June 20, 2023 DS-000091-ENG. Subject to change without notice.

_	OP	_		
	SOLAR	SOLUI	rions	

#### TOP TIER SOLAR SOLUTIONS

1530 CENTER PARK DR #2911, CHARLOTTE, NC 28217, UNITED STATES

REVISIONS				
DESCRIPTION	DATE	REV		
INITIAL DESIGN	01/24/2024			
MODULES, BATTERY ADD & INVERTER CHANGE	03/01/2024	А		

P	ROJECT NAM	/IE & ADDRESS

18 THUNDER VALLELY CT, LILLINGTON, NC 27546

ELLIS DAVIS RESIDENCE

DRAWN BY

ESR

SHEET NAME EQUIPMENT

**SPECIFICATION** 

SHEET SIZE

ANSI B 11" X 17"

SHEET NUMBER

PV-11

#### S500B, S650B (Bent Bracket)

	(E RoHS
31	E CE
ä	

## SolarEdge Home Hub Inverter

#### For North America

SE3800H-US / SE5700H-US / SE6000H-US / SE7600H-US / SE10000H-US / SE11400H-US<sup>(1)</sup>



# HOME BACKUF

#### Optimized battery storage with HD-Wave technology

- Record-breaking 99% weighted efficiency with 200% DC oversizing
- Small, lightweight, and easy to install
- Modular design, future ready with optional upgrades to:
- / DC-coupled storage for full or partial home backup
- Built-in consumption monitoring
- Direct connection to the SolarEdge Home EV Charger

- Multi-inverter, scalable storage solution, with enhanced battery power up to 10kW
- Integrated arc fault protection and rapid shutdown for NEC 2014 – 2023, per article 690.11 and 690.12
- Embedded revenue grade production data, 1 ANSI C12.20 Class 0.5

#### **/** SolarEdge Home Hub Inverter For North America

SE3800H-US / SE5700H-US / SE6000H-US / SE7600H-US / SE10000H-US / SE11400H-US<sup>(1)</sup>


Applicable to inverters with part number		SEXX	XH-USMNBBXXX	/ SEXXXXH-USSN	BBXXX		
	SE3800H-US	SE5700H-US	SE6000H-US	SE7600H-US	SE10000H-US	SE11400H-US	Unit
OUTPUT – AC ON GRID							
Rated AC Power	3800 @ 240V 3300 @ 208V	5760 @ 240V 5000 @ 208V	6000 @ 240V 5000 @ 208V	7600	10000	11400 @ 240V 10000 @ 208V	W
Maximum AC Power Output	3800 @ 240V 3300 @ 208V	5760 @ 240V 5000 @ 208V	6000 @ 240V 5000 @ 208V	7600	10000	11400 @ 240V 10000 @ 208	W
AC Output Voltage (Nominal)			208	/ 240			Vac
AC Output Voltage (Range)			183 -	- 264			Vac
AC Frequency Range (min - nom - max)			59.3 - 60	0 – 60.5 <sup>(2)</sup>			Hz
Maximum Continuous Output Current @ 240V	16	24	25	32	42	47.5	A
Maximum Continuous Output Current @ 208V	16	24	24	-	-	48	A
GFDI Threshold				1			A
Total Harmonic Distortion (THD)			6	3			%
Power Factor				-0.85 to 0.85			70
Utility Monitoring, Islanding Protection, Country Configurable Thresholds				es			
Charge Battery from AC (if allowed)			V	es			
Typical Nighttime Power Consumption				2.5			W
				2.J			
OUTPUT – AC BACKUP <sup>(3)</sup>	1	1	1			1	T
Rated AC Power in Backup Operation <sup>(4)</sup>	7600	5760	6000	7600 11400*	10000 11400*	11400	W
AC L-L Output Voltage Range in Backup			211 -	- 264			Va
AC L-N Output Voltage Range in Backup	105 – 132				Vac		
AC Frequency Range in Backup (min - nom - max)			55 – 6	60 - 65			Hz
Maximum Continuous Output Current in Backup Operation	32	24	25	32 47.5	42 47.5	47.5	A
GFDI				1		1	A
THD			<	5			%
OUTPUT - SOLAREDGE HOME EV CHA	RGFR AC						
Rated AC Power			96	500			W
AC Output Voltage Range				- 264			Vac
On-Grid AC Frequency Range (min - nom - max)				50 - 60.5			Hz
Maximum Continuous Output Current @240V			55.5 - 0	0-00.5			112
(grid, PV and battery)			2	10			Aad
INPUT – DC (PV AND BATTERY)	1						-
Transformer-less, Ungrounded			Y	es			
Max Input Voltage				80			Vdd
Nom DC Input Voltage				80			Vdd
Reverse-Polarity Protection	-			es			
Ground-Fault Isolation Detection				ensitivity			
INPUT – DC (PV)	-		0001111	ansarray			
Maximum DC Power @ 240V	7600	11520	12000	15200	20000	22800	W
Maximum DC Power @ 208V	6600	10000	10000	-		20000	W
Maximum Input Current <sup>(5)</sup> @ 240V	20	16	16.5	20 30	- 30	30	Ade
Maximum Input Current <sup>(5)</sup> @ 208V	9	13.5	13.5	-	-	27	Ado
Max. Input Short Circuit Current				15			1.01
Maximum Inverter Efficiency				9.2			%
	99 @ 240V						
CEC Weighted Efficiency			99			98.5 @ 208V	%

\* Supported with PN SExxxxH-USMNxxxx

(1) These specifications apply to inverters with part numbers SExxxxH-USMNxxxxx or SExxxxH-USSNxxxxx and connection unit model number DCD-1PH-US-PxH-F-x. (2) For other regional settings please contact SolarEdge support.

(3) Not designed for standalone applications and requires AC for commissioning. Backup functionality is only supported for 240V grid.
(4) Rated AC power in Backup Operation is valid for installations with multiple inverters. For a single backup inverter operation, rated AC power in Backup is 90% of the value stated (5) A higher current source may be used; the inverter will limit its input current to the values stated



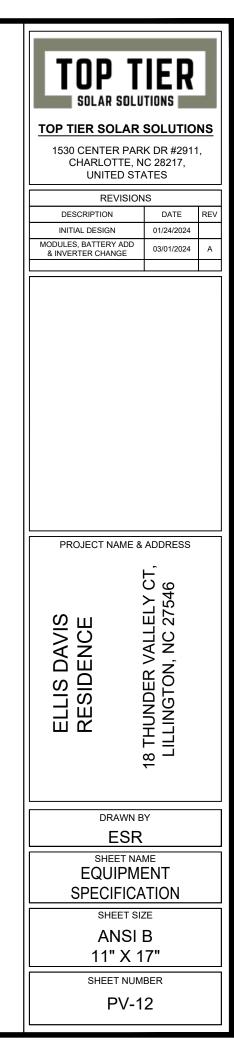

/A`

#### / SolarEdge Home Hub Inverter

#### For North America

#### <u>SE3800H-US / S</u>E5700H-US / SE6000H-US / SE7600H-US / SE10000H-US / SE11400H-US<sup>(1)</sup>

/ A \

Applicable to inverters with part number		SEXXX	XH-USMNBBXXX	/ SEXXXXH-USSN	BBXXX		
	SE3800H-US	SE5700H-US	SE6000H-US	SE7600H-US	SE10000H-US	SE11400H-US	Unit
OUTPUT – DC (BATTERY)							
Supported Battery Types		<u></u>	SolarEdge Home Ba	ttery, LG RESU Prim	e		
Number of Batteries per Inverter				ittery, up to 2 LG RE			
Continuous Power <sup>(6)</sup>	7600 @ 240V 3800 @ 208V	5760 @ 240V 5000 @ 208V	6000	114	400	11400 @ 240V 10000 @ 208V	W
Peak Power <sup>(6)</sup>	7600 @ 240V 3800 @ 208V	5760 @ 240V 5000 @ 208V	6000	112	400	11400 @ 240V 10000 @ 208V	Ŵ
Max Input Current	20			26.5			Adc
2-pole Disconnection			Up to inverter rat	ted backup power			
SMART ENERGY CAPABILITIES							
Consumption Metering			Built	t-in <sup>(7)</sup>			
Backup & Battery Storage	Wit	h Backup Interface (	purchased separate	ely) for service up to	200A; up to 3 inve	rters	
EV Charging		Direc	t connection to Sola	arEdge Home EV Cł	harger		
ADDITIONAL FEATURES							
Supported Communication Interfaces		RS485, Ethernet, Cellular <sup>(8, 9)</sup> , Wi-Fi <sup>(9)</sup> , SolarEdge Home Network					
Revenue Grade Metering, ANSI C12.20		Built-in <sup>(7)</sup>					
Integrated AC, DC and Communication Connection Unit		Yes					
Inverter Commissioning	With	With the SetApp mobile application using built-in Wi-Fi Access Point for local connection					
DC Voltage Rapid Shutdown (PV and Battery)		Yes, accordi	ng to NEC 2014 – 2	023 per article 690.	11 and 690.12		
STANDARD COMPLIANCE							
Safety	1	UL1741, UL1741 SA, UL1741 SB, UL1741 PCS, UL1699B, UL1998, UL9540, CSA 22.2					
Grid Connection Standards		IEEE1547-2018, Rule 21, Rule 14H, CSA C22.3 No. 9					
Emissions			FCC part	15 class B			
INSTALLATION SPECIFICATIONS							
AC Output and EV AC Output Conduit Size / AWG Range			1" maximum	n / 14-4 AWG			
DC Input (PV and Battery) Conduit Size / AWG Range			1" maximum	n / 14-6 AWG			
Dimensions with Connection Unit (H x W x D)	17.7 x	14.6 x 6.8 / 450 x 37	0 x 174	17.7 x 14.6 x 6.8 / 450 x 370 x 174**	21.06 x 14.6 x 7.3 / 535 x 370 x 185** 535 x 370 x 208***	21.06 x 14.6 x 8.2 / 535 x 370 x 208***	in / mm
Weight with Connection Unit		30.8 / 14		30.8 / 14**	41.7 / 18.9**	44.9 / 20.3***	lb/k
Noise			<	50	20.3		dBA
			Niati1C	onvection			
Cooling Operating Temperature Range			A Provide A Rep 100	-40 to +60 <sup>(10)</sup>			°F / °0
Protection Rating				1A 4X			

\*\* Supported with PN SEXXXXH-USSNBBXX4 or SEXXXXH-USMNBBXX4.

\*\*\* Supported with PN SEXXXXH-USSNBBXX5 or SEXXXXH-USMNBBXX5.

(6) Discharge power is limited up to the inverter rated AC power for on-grid and backup applications, as well as up to the installed batteries' rating.
 (7) For consumption metering current transformers should be ordered separately: SECT-SPL-22SA-T-20 or SEACT0750-400NA-20 units per box. Revenue grade metering is only for production metering.
 (8) Information concerning the Data Plan's terms & conditions is available in the following link: <u>SolarEdge Communication Plan Terms and Conditions</u>.
 (9) The part number SEXXXXH-USXNBBXXX only supports the Wi-Fi communication interface, and the part number SEXXXXH-USXNBBLXX only supports the cellular communication interface.
 (10) Full power up to at least 50°C / 122°F; for power de-rating information refer to the <u>Temperature Derating Technical Note for North America</u>.

.....

TOP T SOLAR SOLU			
TOP TIER SOLAR	SOLUTIO	NS	
1530 CENTER PAR	K DR #2911	,	
CHARLOTTE, N UNITED STA			
REVISION	S		
DESCRIPTION	DATE	REV	
INITIAL DESIGN	01/24/2024		
MODULES, BATTERY ADD & INVERTER CHANGE	03/01/2024	А	
PROJECT NAME & ADDRESS			
	18 THUNDER VALLELY CT, LILLINGTON, NC 27546		
DRAWN B	DRAWN BY ESR		
SHEET NAME EQUIPMENT SPECIFICATION			
SHEET SIZ			
ANSI I 11" X 1			
SHEET NUM	BER		
PV-1	3		

# Backup Interface

#### IOI NOI UI AMERICA

BI-EUSGN-01 / BI-NUSGN-01



#### Backup Interface for Flexible Backup

- Automatically provides backup power to home loads in the event of grid interruption
- Full flexibility in which loads to backup the entire home or selected loads
- Scalable solution to support higher power & higher capacity<sup>(\*)</sup>

(\*) Requires supporting inverter firmware

Built-in Auto Transformer and Energy Meter for easier and faster installation

- Seamless integration with the Energy Hub Inverter with Prism Technology to manage and monitor both PV generation and energy storage
- Generator connection support<sup>(\*)</sup>

#### **/** Backup Interface for North America

BI-EUSGN-01 / BI-NUSGN-01

	BI-EUSGN-01	
INPUT FROM GRID		
AC Current Input	200	
AC Output Voltage (Nominal)	240	
AC Output Voltage Range	211 - 264	
AC Frequency (Nominal)	60	
AC Frequency Range	59.3 - 60.5	
Microgrid Interconnection Device Rated Current	200	
Service Side AC Main Circuit Breaker Rated Current	200	
Service Side AC Main Circuit Breaker Interrupt Current	10k	
Grid Disconnection Switchover Time	<100	
OUTPUT TO MAIN DISTRIBUTION PANEL		
Maximum AC Current Output	200	
AC L-L Output Voltage (Nominal)	240	
AC L-L Output Voltage Range	211 - 264	
AC Frequency (Nominal)	60	
AC Frequency Range	59.3 - 60.5	
Maximum Inverters AC Current Output in Backup Operation	78	
Imbalance Compensation in Backup Operation	5000	
AC L-N Output Voltage in Backup (Nominal)	120	
AC L-N Output Voltage Range in Backup	105 - 132	
AC Frequency Range in Backup	55 - 65	
INPUT FROM INVERTER		
Number of Inverter Inputs	3	
Rated AC Power	7,600	
Maximum Continuous Input Current @ 240V	32	
Rated AC Power in Continuous Backup Operation	6,100	
Maximum Continuous Input Current in Backup Operation	26	
Peak AC Power (<10 sec) in Backup Operation	7,000	
Peak AC Current (<10 sec) in Backup Operation	30	
Inverter Input AC Circuit Breaker	40	
Upgradability	Up to 3 X 63A 0	
GENERATOR <sup>(2)</sup>		
Maximum Rated AC Power	15,000	
Maximum Continuous Input Current	63	
Dry Contact Switch Voltage Rating	250/30	
Dry Contact Switch Current Rating	5	
2-wire Start Switch	Yes	
ADDITIONAL FEATURES		
Installation Type	Suitable for use as service equipment	
Number of Communication Inputs	2	
Communication	R\$485	
Energy Meter (for Import/Export)	1% accuracy	
Manual Control Over Microgrid Interconnection Device	Yes	

(1) Each 40A CB supports up to one 7.6kW inverter, with each 63A CB supporting one 10kW and one 11.4kW inverter. The CB upgrade kit is available to the following part numbers: for 40A CB, CB-UPG-40-01; for 63A, CB CB-UPG-63-01 (2) Requires supporting inverter firmware



STOREDG

8

solaredge.com


~~~~~~~~~~~~~~~~~~~~~~~~~~~~~~~~~~~~~~~	~~~~~~			
/	A	TOD T		
<u> </u>	}	TOP T	IER 🔳	
	<pre>{</pre>	SOLAR SOLU		
	<pre>{</pre>			
	{	TOP TIER SOLAR	SOLUTIONS	
	}	1530 CENTER PAR CHARLOTTE, N		
	<pre>}</pre>	UNITED ST		
BI-NUSGN-01	l l l l l l l l l l l l l l l l l l l	REVISION	IS	
	{	DESCRIPTION	DATE REV	
	{ }	INITIAL DESIGN	01/24/2024	
	Vac S	MODULES, BATTERY ADD & INVERTER CHANGE	03/01/2024 A	
	Hz			
	Hz			
	A }			
N/A				
N/A	A			
	}			
	A			
	Vac			
	Vac 🖌			
	Hz }			
	A \$			
	w {			
	v }			
	{			
	Hz			
	}			
	}	PROJECT NAME &	ADDRESS	
	A		Ļ I	
	<u> </u>		5 0 1 0	
	}		12 <sup>2</sup>	
	X	ШυΩщ	л Л	
	A	≥♀		
CB(I)	}	ELLIS DAVIS RESIDENCE	18 THUNDER VALLEL LILLINGTON, NC 27	
	{		жó	
	Adc	N 1		
	Vac/Vdc		Υğ	
	A }	ШЩ	<u> </u>	
	{		LII 8	
For main lug only	{		~	
	{			
ý	{	DRAWN E		
with	<b>}</b>	ESR		
with	}	SHEET NA		
	Ş	EQUIPMENT		
	Ş			
	}	SHEET SI	ZE	
	}	ANSI	ΒΙ	
	Ş	11" X 1		
	\$			
	}	SHEET NUM		
	· · · · · · · · · · · · · · · · · · ·	PV-1	4	

## **/** Backup Interface for North America

BI-EUSGN-01 / BI-NUSGN-01

	BI-EUSGN-01	BI-NUSGN-01	
STANDARD COMPLIANCE			
eur à l	UL1741, CSA	22.2 NO. 107	
Safety	UL869A	N/A	
Emissions	FCC part	15 class B	
INSTALLATION SPECIFICATIONS			
Supported Inverters		e phase inverter, verter with Prism technology	
AC From Grid Conduit Size / AWG Range	2" conduits / #0 - 4/0 AWG		
AC Inverter Conduit Size / AWG Range	1" conduit / 14 - 4 AWG		
AC Generator Input Conduit Size / AWG Range	1" conduit / 8 - 3 AWG		
Communication Conduit Size / AWG Range	3/4'' / 24 - 10 AWG		
Weight	73 / 33		lb / Kg
Cooling	Fan (user replaceable)		
Noise	< 50		dBA
Operating Temeprature Range	-40 to +122 / -40 to +50		°F / °C
Protection Rating	NEMA	3R, IP44	
Dimensions (HxWxD)	20.59 x 13.88 x 8.62	/ 523.5 x 352.5 x 219	in / mn

⁄A\

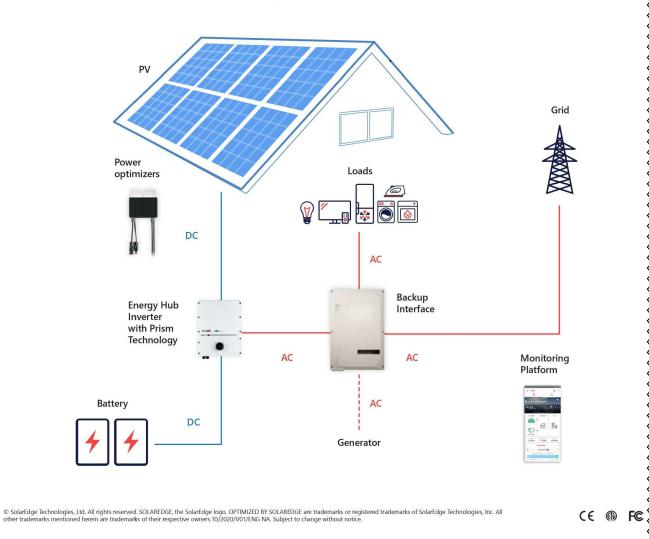

DECENSIONS         SOLAR SOLUTIONS         SOLAR SOLUTIONS         DEPTIER SOLAR SOLUTIONS         SIGNAR SOLUTIONS         SIGNAR SOLUTIONS         SIGNAR SOLUTIONS         SIGNAR SOLUTIONS         SIGNAR SOLUTIONS         SIGNAR SOLUTIONS         ISSO CENTER PARK DR #2911, CHARLOTTE, NC 28217, UNITED STATES         REVISIONS         DESCRIPTION DATE REV         DESCRIPTION DATE REV         INTEL CENTION         DESCRIPTION DATE & ADDRESS         INTEL SIZE         SHEET NAME         SUPEOIFICATION         SHEET NUMBER         DRAWN BY         ESR         SHEET NAME         EQUIPMENT         SHEET NUME         ANSI B         SHEET NUMBER         PV-15				
IS30 CENTER PARK DR #2911, CHARLOTTE, NC 28217, UNITED STATES REVISIONS DESCRIPTION DATE REV INITIAL DESIGN 01/24/2024 MODULES, BATTERY ADD 03/01/2024 A INVERTER CHANGE 03/01/2024 A INVERTER 03/01/2024 A INV				
CHARLOTTE, NC 28217, UNITED STATES	TOP TIER SOLAR	SOLUTIO	NS	
UNITED STATES	1530 CENTER PAR	K DR #2911	,	
REVISIONS DESCRIPTION DATE REV INITIAL DESIGN 01/24/2024 MODULES, BATTERY ADD 03/01/2024 A INVERTER CHANGE 03/01/2024 A INVERTER CHA	-			
DESCRIPTION DATE REV INITIAL DESIGN 01/24/2024 MODULES, BATTERY ADD & INVERTER CHANGE 03/01/2024 A DROJECT NAME & ADDRESS I SHEET NAME & ADDRESS I SHEET NAME & ADDRESS I SHEET NAME EQUIPMENT SPECIFICATION SHEET SIZE ANSI B 11" X 17" SHEET NUMBER	REVISION	S		
MODULES, BATTERY ADD & INVERTER CHANGE       03/01/2024       A         Image: Stress of the st			REV	
& INVERTER CHANGE       03/01/2024       A         Image: A state of the	INITIAL DESIGN	01/24/2024		
LITINGTON, NC 27546 LILINGTON, NC 27546 LILINGTON, NC 27546 SHEET SIZE ANSI B 11, X 12, SHEET NIMBER		03/01/2024	А	
LITINGTON, NC 27546 LILINGTON, NC 27546 LILINGTON, NC 27546 SHEET SIZE ANSI B 11, X 12, SHEET NIMBER				
SHEET NUMBER SHEET NUMBER SHEET NAME EQUIPMENT SPECIFICATION SHEET SIZE ANSI B 11" X 17"				
SHEET NUMBER SHEET NUMBER SHEET NAME EQUIPMENT SPECIFICATION SHEET SIZE ANSI B 11" X 17"	_			
ESR SHEET NAME EQUIPMENT SPECIFICATION SHEET SIZE ANSI B 11" X 17" SHEET NUMBER				
SHEET NAME EQUIPMENT SPECIFICATION SHEET SIZE ANSI B 11" X 17" SHEET NUMBER				
EQUIPMENT SPECIFICATION SHEET SIZE ANSI B 11" X 17" SHEET NUMBER				
ANSI B 11" X 17" SHEET NUMBER	EQUIPMENT			
11" X 17" SHEET NUMBER	SHEET SIZ	ZE		
SHEET NUMBER				

# SolarEdge Energy Bank **10kWh Battery**

#### For North America



HOME BACKU

#### Optimized for SolarEdge Energy Hub Inverters<sup>(1)</sup>

- / Maximized system performance, gaining more energy to store and use for on-grid and backup power applications
- Integrates with the complete SolarEdge residential offering, providing a single point of contact for warranty, support, training, and simplified logistics & operations
- I DC coupled battery featuring superior overall system efficiency, from PV to battery to grid
- I Scalable solution for increased power and capacity with multiple SolarEdge inverters and batteries

\* Backup application are subject to local regulation and may require

additional components and firmware upgrade

- / Solar, storage, EV charging, and smart devices all monitored and managed by a single app to optimize solar production, consumption and backup\* power
- / Wireless communication to the inverter, reducing wiring, labor and installation faults
- I Simple plug and play installation, with automatic SetApp-based configuration
- Includes multiple safety features for battery protection

#### / SolarEdge Energy Bank **10kWh Battery** For North America

	BAT-10K1P <sup>(2)</sup>
BATTERY SPECIFICATION	
Usable Energy (100% depth of discharge)	9700
Continuous Output Power	5000
Peak Output Power (for 10 seconds)	7500
Peak Roundtrip Efficiency	>94.5
Warranty <sup>a</sup>	10
Voltage Range	350-450
Communication Interfaces	Wireless*
Batteries per Inverter	Up to 3 <sup>(4)</sup>
STANDARD COMPLIANCE	
Safety	UL1642, UL1973, UL9540, UN38.3
Emissions	FCC Part 15 Class B
MECHANICAL SPECIFICATIONS	
Dimensions (W x H x D)	31.1 x 46.4 x 9.84 / 790 x 1179 x 250
Weight	267 / 121
Mounting <sup>(5)</sup>	Floor or wall mount®
Operating Temperature <sup>(7)</sup>	+14 to +122 / -10 to +50
Storage Temperature (more than 3 months)	+14 to +86 / -10 to +30
Storage Temperature (less than 3 months)	-22 to + 140 / -30 to +60
Altitude	6562 / 2000
Enclosure Protection	IP55 / NEMA 3R - indoor and outdoor (water and dus
Cooling	Natural convection
Noise (at 1m distance)	<25

Using RS485 could reduce the usable energy to 9500/h. (1) Please refer to the SolarEdge Energy Bank battery connections and configuration application note for compatible inverters.

(2) These specifications apply to part number BAT-10K1PS0B-01.

(a) To constrain the solution of the solution of

(6) The floor stand is purchased separately. One floor stand is required per SolarEdge Energy Bank battery. Please refer to the Accessories' PN table below.

(7) Please note that operating the SolarEdge Energy Bank at extreme temperatures for extended durations of time may void the Energy Bank's warranty covera Please see the Energy Bank Limited Product Warranty for additional details.

SolarEdge Energy Bank Battery – Accessories (purchased separately)				
Accessory				
Floor stand	IAC-RB			
Branch connectors set (includes a pair of DC + and DC - connectors) Required for installations with multiple SolarEdge Energy Bank batteries with a single inverter	IAC-RB			
Handles	IAC-RB/			
SolarEdge Energy Net Plug-in	ENE			
Battery inverter extension cable 2m long (MC4 to terminal block)	IAC-RB/			



© SolarEdge Technologies Ltd. All rights reserved. SOLAREDGE, the SolarEdge logo, OPTIMIZED BY SOLAREDGE are trademarks or registered trademarks of SolarEdge T All other trademarks mentioned herein are trademarks of their respective owners. Date: 11/2021 DS-000026-3.6-NA Subject to change without notice.

solaredge.com

	Wh
	W
	W
	%
	Years
	Vdc
	in / mm
	lb / kg
	°F/°C
	°F/°C
	°F/°C
	ft/m
otection)	
	dBA
uding the	
cluding the	
cluding the	
luding the	
PN	
PN T-FLRSTD-01	
PN xT-FLRSTD-01 xT-USYCBL-01	
<b>PN</b> T-FLRSTD-01 T-USYCBL-01 T-HANDLE-01	
PN T-FLRSTD-01 T-USYCBL-01 T-HANDLE-01 -HBNP-01	
PN T-FLRSTD-01 T-USYCBL-01 T-HANDLE-01 HBNP-01	
PN T-FLRSTD-01 T-USYCBL-01 T-HANDLE-01 -HBNP-01	
PN T-FLRSTD-01 T-USYCBL-01 T-HANDLE-01 HBNP-01	
PN T-FLRSTD-01 T-USYCBL-01 -HANDLE-01 HBNP-01	
-FLRSTD-01 USYCBL-01 -HANDLE-01 HBNP-01	
PN -FLRSTD-01 USYCBL-01 -HANDLE-01 HBNP-01	
PN T-FLRSTD-01 T-USYCBL-01 -HANDLE-01 HBNP-01	
PN T-FLRSTD-01 T-USYCBL-01 -HANDLE-01 HBNP-01	
PN T-FLRSTD-01 T-USYCBL-01 T-HANDLE-01 -HBNP-01	
PN T-FLRSTD-01 T-USYCBL-01 T-HANDLE-01 -HBNP-01	
PN T-FLRSTD-01	
PN T-FLRSTD-01 T-USYCBL-01 T-HANDLE-01 -HBNP-01	
PN T-FLRSTD-01 T-USYCBL-01 T-HANDLE-01 -HBNP-01	
PN T-FLRSTD-01 T-USYCBL-01 T-HANDLE-01 HBNP-01	
PN -FLRSTD-01 -USYCBL-01 HANDLE-01 -IBNP-01 -10M420-01	RoHS





Solar Is Not Always Sunny

enough to buckle a panel frame.

these results. They resist uplift, protect against buckling and safely and efficiently

transfer loads into the building structure.

Their superior spanning capability

requires fewer roof attachments, reducing the number of roof

penetrations and the amount

of installation time.

Over their lifetime, solar panels experience countless extreme weather events. Not just the worst storms in years, but the worst storms in 40 years. High winds capable of ripping panels from a roof, and snowfalls weighing

XR Rails are the structural backbone preventing



#### **XR** Rail Family

#### **XR Rail Family**

The XR Rail Family offers the strength of a curved rail in three targeted sizes. Each size supports specific design loads, while minimizing material costs. Depending on your location, there is an XR Rail to match.



#### **Rail Selection**

The following table was prepared in compliance with applicable engineering codes and standards. Values are based on the following criteria: ASCE 7-10, Roof Zone 1, Exposure B, Roof Slope of 7 to 27 degrees and Mean Building Height of 30 ft. Visit IronRidge.com for detailed span tables and certifications.

Lo	ad	Rail Span		Span	
Snow (PSF)	Wind (MPH)	4'	5' 4"	6'	8'
	100				
None	120				
None	140	XR10		XR100	
	160				
	100				
10-20	120				
10-20	140				
	160				
30	100				
30	160				
40	100				
40	160				
50-70	160				
80-90	160				

# **Force-Stabilizing Curve** Sloped roofs generate both vertical and lateral

forces on mounting rails which can cause them to bend and twist. The curved shape of XR Rails is specially designed to increase strength in both directions while resisting the twisting. This unique feature ensures greater security during extreme weather and a longer system lifetime.

#### **Compatible with Flat & Pitched Roofs**





#### **Corrosion-Resistant Materials**

All XR Rails are made of marine-grade aluminum alloy, then protected with an anodized finish. Anodizing prevents surface and structural corrosion, while also providing a more attractive appearance.



Tec	- 1	100	< 1
160		16	

10'	12'
XR1000	
1.11	

TOP TIER SOLAR SOLUTIONS

#### TOP TIER SOLAR SOLUTIONS

1530 CENTER PARK DR #2911, CHARLOTTE, NC 28217, UNITED STATES

REVISIONS				
DESCRIPTION	DATE	REV		
INITIAL DESIGN	01/24/2024			
MODULES, BATTERY ADD & INVERTER CHANGE	03/01/2024	А		

PROJECT NAME & ADDRESS

ELLIS DAVIS RESIDENCE

3 THUNDER VALLELY CT LILLINGTON, NC 27546 30

DRAWN BY

ESR

SHEET NAME EQUIPMENT SPECIFICATION

SHEET SIZE

ANSI B 11" X 17"

SHEET NUMBER

PV-17





#### UFO Family of Components

#### **Simplified Grounding for Every Application**

The UFO family of components eliminates the need for separate grounding hardware by bonding solar modules directly to IronRidge XR Rails. All system types that feature the UFO family—Flush Mount, Tilt Mount and Ground Mount—are fully listed to the UL 2703 standard.

UFO hardware forms secure electrical bonds with both the module and the rail, resulting in many parallel grounding paths throughout the system. This leads to safer and more reliable installations.



Stopper Sleeve The Stopper Sleeve snaps onto the UFO, converting it into a bonded end clamp. Universal Fastening Object (UFO) The UFO securely bonds solar modules to XR Rails. It comes assembled and lubricated, and can fit a wide range of module heights.

**Bonded Attachments** 

The bonding bolt attaches

and bonds the L-foot to the

same socket as the rest of the


rail. It is installed with the

system

Bonded Splice Each Bonded Splice uses self-drilling screws to form a secure connection. No bonding strap needed.



Grounding Lug A single Grounding Lug connects an entire row of PV modules to the grounding conductor. System Diagram

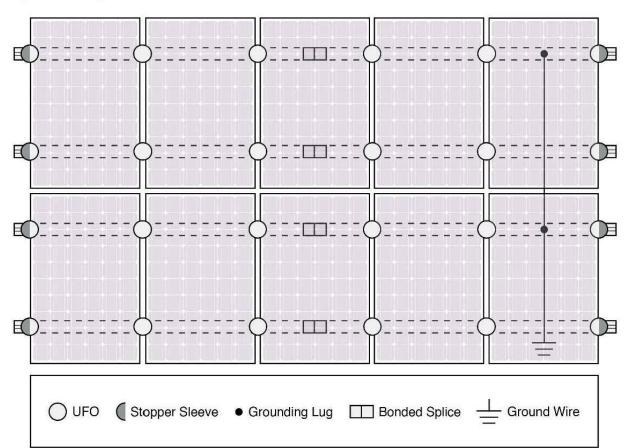

Q Approved Enphase microinverters can provide equipment grounding of IronRidge systems, eliminating the need for grounding lugs and field installed equipment ground conductors (EGC). A minimum of two microinverters mounted to the same rail and connected to the same Engage cable is required. Refer to installation manuals for additional details.

#### **UL** Certification


The IronRidge Flush Mount, Tilt Mount, and Ground Mount Systems have been listed to UL 2703 by Intertek Group plc.

UL 2703 is the standard for evaluating solar mounting systems. It ensures these devices will maintain strong electrical and mechanical connections over an extended period of time in extreme outdoor environments.

Go to IronRidge.com/UFO

Cross-System Compa		
Feature	Flush Mount	Tilt N
XR Rails	*	
UFO/Stopper	~	,
Bonded Splice	~	
Grounding Lugs	1 per Row	1 pei
Microinverters & Power Optimizers	Enphase - M250-72, M2 Darfon - MIG240, N SolarEdge - P300, P320, P4	
Fire Rating	Class A	Cla
Modules	Tested or Evaluated with Refer to installation ma	



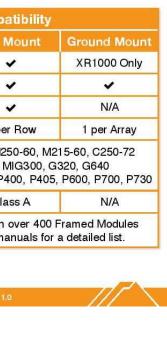

SOLAR SOLUTIONS

#### TOP TIER SOLAR SOLUTIONS

1530 CENTER PARK DR #2911, CHARLOTTE, NC 28217, UNITED STATES

REVISIONS				
DESCRIPTION	DATE	REV		
INITIAL DESIGN	01/24/2024			
MODULES, BATTERY ADD & INVERTER CHANGE	03/01/2024	А		

PROJECT NAME & ADDRESS

ELLIS DAVIS RESIDENCE 18 THUNDER VALLELY CT LILLINGTON, NC 27546

DRAWN BY

ESR


SHEET NAME EQUIPMENT SPECIFICATION

SHEET SIZE

11" X 17"


SHEET NUMBER

PV-18

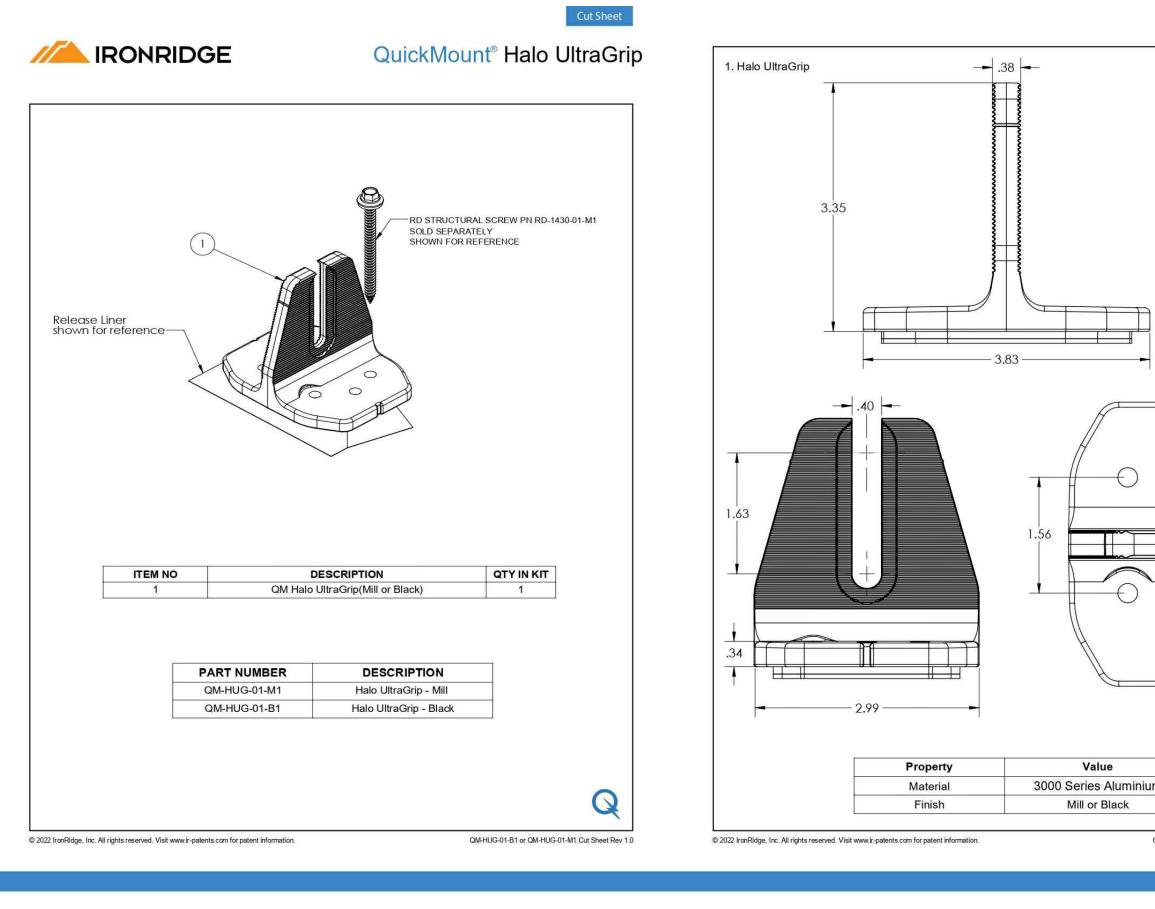

Cut Sheet	TOP TIER	
	TOP TIER SOLAR SOLUTIONS 1530 CENTER PARK DR #2911, CHARLOTTE, NC 28217,	
	UNITED STATES REVISIONS	
	DESCRIPTION DATE REV	
	INITIAL DESIGN 01/24/2024	
	MODULES, BATTERY ADD & INVERTER CHANGE 03/01/2024 A	
	PRAWN BY BEAUS BELLIS DAVIS ELLIS DAVIS BELLS DAVIS BELLIS DAVIS BELLS DAVIS BELLIS DAVIS BELLIS DAVIS BELLS DAVIS BELLIS DAVIS BELLS DAVIS BELLIS DAVIS BELLS DAVIS BELLIS DA	
	ESR	
m 🕥	SHEET NAME	
	EQUIPMENT	
QM-HUG-01-B1 or QM-HUG-01-M1 Cut Sheet Rev 1.0	SPECIFICATION	
	SHEET SIZE ANSI B	
	ANSI B 11" X 17"	
	SHEET NUMBER	
	PV-19	

#### IRONRIDGE QuickMount® RD Structural Screw

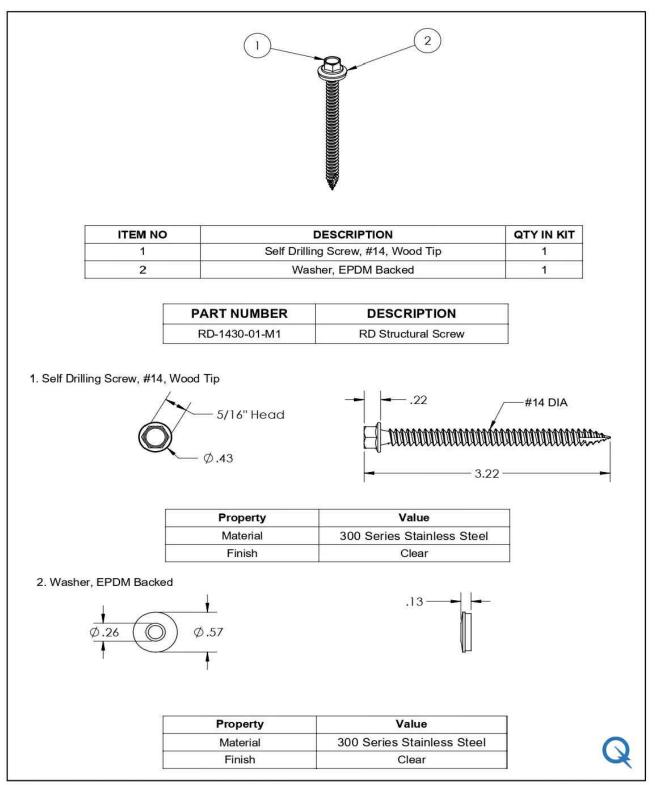

© 2022 IronRidge, Inc. All rights reserved. Visit www.ir-patents.com for patent information.

QM-RD-1430-01-M1 Cut Sheet Rev 1.0

TOP TIER				
TOP TIER SOLAR	SOLUTIO	NS		
1530 CENTER PAR	K DR #2911	,		
CHARLOTTE, N UNITED ST				
-				
DESCRIPTION		REV		
INITIAL DESIGN	01/24/2024			
MODULES, BATTERY ADD & INVERTER CHANGE	03/01/2024	А		
	18 THUNDER VALLELY CT, P LILLINGTON, NC 27546 ssaudd ssaudd			
ELL	18 THUN LILLING			
DRAWN BY ESR				
SHEET NAME				
EQUIPMENT SPECIFICATION				
SPECIFICATION SHEET SIZE				
ANSI B				
11" X 17"				
SHEET NUM	BER			
PV-2	20			
L				





#### PHONE: 385-202-4150 WWW.EZSOLARPRODUCTS.COM




ITEM NO.	PART NUMBER	DESCRIPTION	QTY
1	JB-1.2 BODY	POLYCARBONATE WITH UV INHIBITORS	1
2	JB-1.2 LID	POLYCARBONATE WITH UV INHIBITORS	1
3	#10 X 1-1/4" PHILLIPS PAN HEAD SCREW		6
4	#8 X 3/4" PHILLIPS PAN HEAD SCREW		6

size <b>B</b>	DWG. NO. JB-1.2			REV
SCALE: 1:2	<u>, , , , , , , , , , , , , , , , , , , </u>			T 1 OF 3
TORQUE SPEC	CIFICATION:	ION: 15-20 L		.BS
CERTIFIC	ation:	UL 1741, NEMA 3 CSA C22.2 NO. 29		
WEIG	HT:	1.45 LBS		S

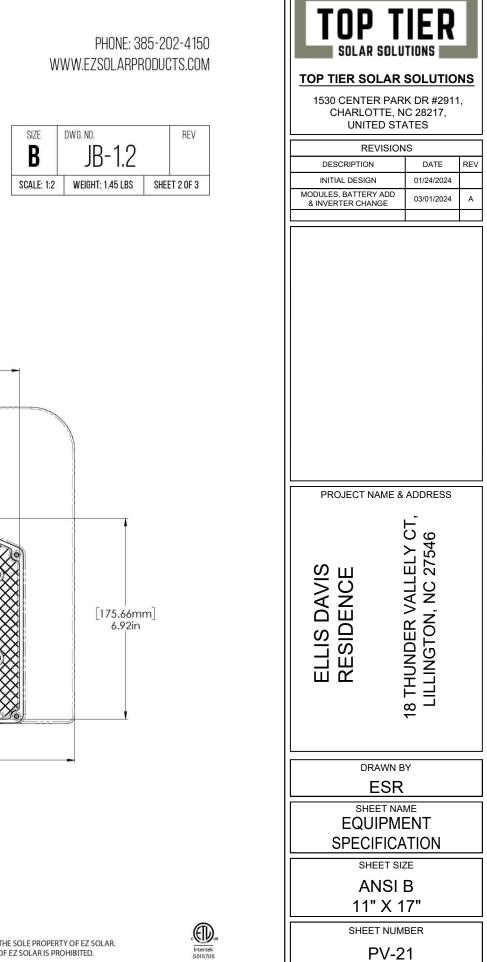

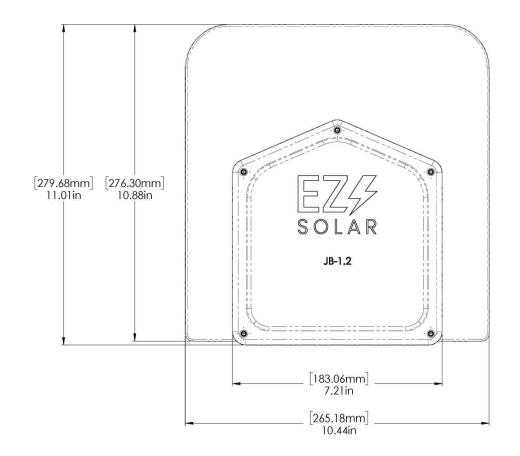

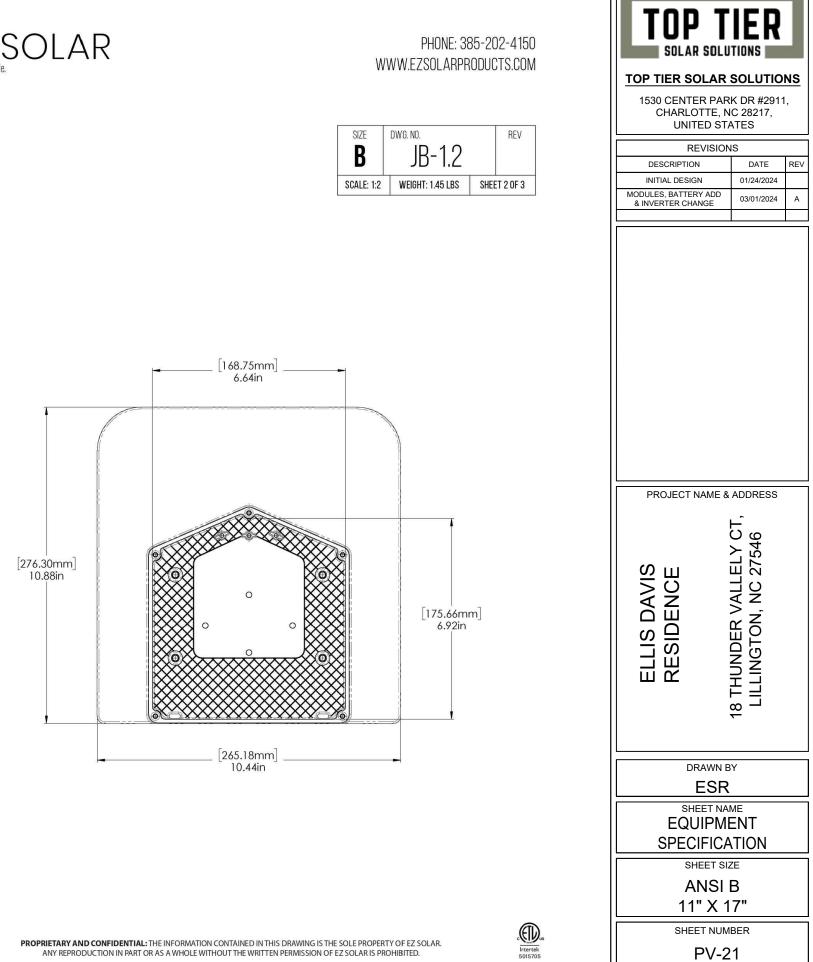

PROPRIETARY AND CONFIDENTIAL: THE INFORMATION CONTAINED IN THIS DRAWING IS THE SOLE PROPERTY OF EZ SOLAR. ANY REPRODUCTION IN PART OR AS A WHOLE WITHOUT THE WRITTEN PERMISSION OF EZ SOLAR IS PROHIBITED.



\_ [72.53mm] \_ 2.86in