



Scott E. Wyssling, PE
Coleman D. Larsen, SE, PE
Gregory T. Elvestad, PE

76 North Meadowbrook Drive
Alpine, UT 84004
office (201) 874-3483
swyssling@wysslingconsulting.com

July 01, 2024
Revised August 05, 2024

BYLD Better
1213 W Moorehead Street Suite 500
Charlotte, NC 28208

Re: Engineering Services
Daley Residence
40 Adrian Street, Holly Springs, NC
16.400 kW System

To Whom It May Concern:

We have received information regarding solar panel installation on the roof of the above referenced structure. Our evaluation of the structure is to verify the existing capacity of the roof system and its ability to support the additional loads imposed by the proposed solar system.

A. Site Assessment Information

1. Site visit documentation identifying attic information including size and spacing of framing for the existing roof structure.
2. Design drawings of the proposed system including a site plan, roof plan and connection details for the solar panels. This information will be utilized for approval and construction of the proposed system.

B. Description of Structure:

Roof Framing: 2x8 dimensional lumber at 24" on center with a knee wall support.
Roof Material: Composite Asphalt Shingles
Roof Slope: 35 degrees
Attic Access: Accessible
Foundation: Permanent

C. Loading Criteria Used

- **Dead Load**
 - Existing Roofing and framing = 7 psf
 - New Solar Panels and Racking = 3 psf
 - TOTAL = 10 PSF
- **Live Load** = 20 psf (reducible) – 0 psf at locations of solar panels
- **Ground Snow Load** = 15 psf
- **Wind Load** based on ASCE 7-10
 - Ultimate Wind Speed = 120 mph (based on Risk Category II)
 - Exposure Category C

Analysis performed of the existing roof structure utilizing the above loading criteria is in accordance with the 2018 North Carolina Residential Code, including provisions allowing existing structures to not require strengthening if the new loads do not exceed existing design loads by 105% for gravity elements and 110% for seismic elements. This analysis indicates that the existing framing will support the additional panel loading without damage, if installed correctly.


D. Solar Panel Anchorage

1. The solar panels shall be mounted in accordance with the most recent Pegasus installation manual. If during solar panel installation, the roof framing members appear unstable or deflect non-uniformly, our office should be notified before proceeding with the installation.
2. The system utilizes the Pegasus SkipRail racking system. Please reference the stamped plan set for rail and mounting locations.
3. The maximum allowable withdrawal force for a 5/16" lag screw is 229 lbs per inch of penetration as identified in the National Design Standards (NDS) of timber construction specifications. Based on a minimum penetration depth of 2½", the allowable capacity per connection is greater than the design withdrawal force (demand). Considering the variable factors for the existing roof framing and installation tolerances, the connection using one 5/16" diameter lag screws with a minimum of 2½" embedment will be adequate and will include a sufficient factor of safety.
4. Considering the wind speed, roof slopes, size and spacing of framing members, and condition of the roof, the panel supports shall be placed no greater than 48" on center.

Based on the above evaluation, this office certifies that with the racking and mounting specified, the existing roof system will adequately support the additional loading imposed by the solar system. This evaluation is in conformance with the 2018 North Carolina Residential Code, current industry standards, and is based on information supplied to us at the time of this report.

Should you have any questions regarding the above or if you require further information do not hesitate to contact me.

Very truly yours,

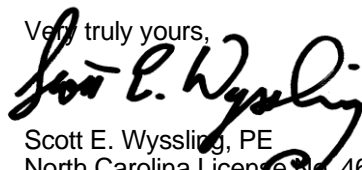

Scott E. Wyssling, PE
North Carolina License No. 46546
North Carolina COA P-2308



Signed 8/05/2024



THIS PLAN HAS BEEN ELECTRONICALLY SIGNED AND SEALED BY SCOTT WYSSLING, PE USING A DIGITAL SIGNATURE AND DATE. PRINTED COPIES OF THIS DOCUMENT ARE NOT CONSIDERED SIGNED AND SEALED AND THE SIGNATURE MUST BE VERIFIED ON ANY ELECTRONIC COPIES

Project information

Installer	-	Project Name	Timothy Daley
		Project Number	-
Project Address	40 Adrian Street, Holly Springs, NC 27540 USA	AHJ/ASCE	Harnett County / 7-10
		Wind / Exp. Cat. / Snow	120.0mph / C / 15 psf

Equipment Type
Summary

Module	URE Co. FBM400MFG-BB	Total modules	41
Inverter	-	Total watts	16400 W
Battery	--	Total Attachments	62

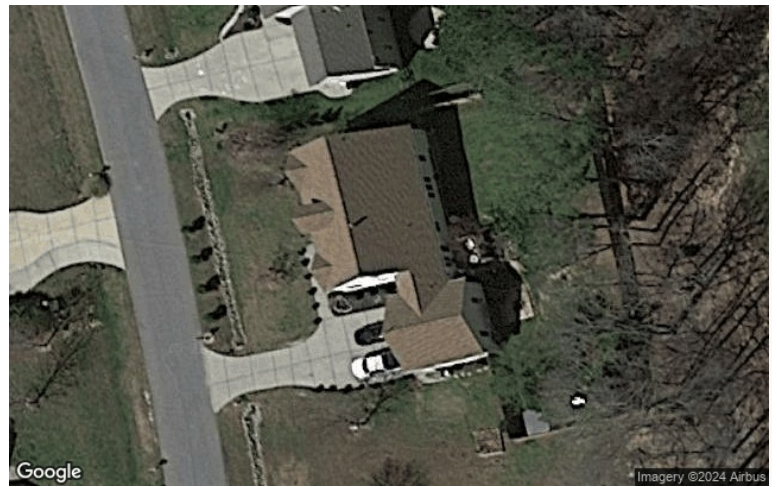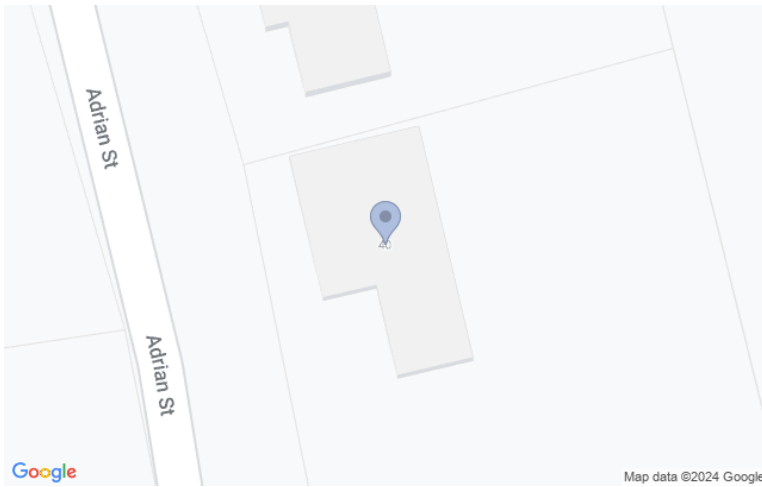
Location preview

Arrays
Array 1

 Roof Type: **Gable**
 Roof Material: **Comp**

 SkipRail: **Yes**
 Roof Slope: **35°**
Array 2

 Roof Type: **Gable**
 Roof Material: **Comp**

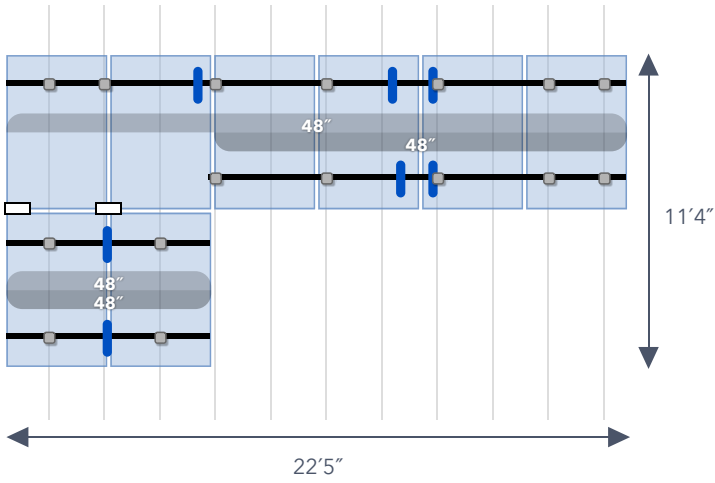 SkipRail: **Yes**
 Roof Slope: **35°**

Array 1 SkipRail


Zones:

- 1
- 2
- 3

Details

Roof Type: **35° Comp Gable**
 Rafter Spacing: **24.0"**
 SkipRail: **Yes**
 Use Scrap Rail: **Yes**

Hidden End Clamp: **Yes**
 Attachment Type: **Instaflash**
 Rail: **8 x 7ft**

Layout

 Panels: **8**

 Panel Size: **67.83" x 44.61" x 35mm**
Design Notes

System Weight: **430.7 lbs**
 Attachments: **16**

System Weight/Attachment: **26.9 lbs**
 Total Area: **862 sqft**

Engineering


Max span values for SkipRail system are displayed on the diagram

Legend

- | | |
|-----------------|-------------------------------|
| Rail Splice | Module with Rails |
| Roof Attachment | SkipRail Clamp |
| Thermal Break | SkipRail Clamp with Kickstand |

Maximum Rail Cantilever

Attachment Span	Max Rail Cantilever
72"	28"
64"	25"
48"	19"
32"	12"
24"	9"
Other	40% of attachment span

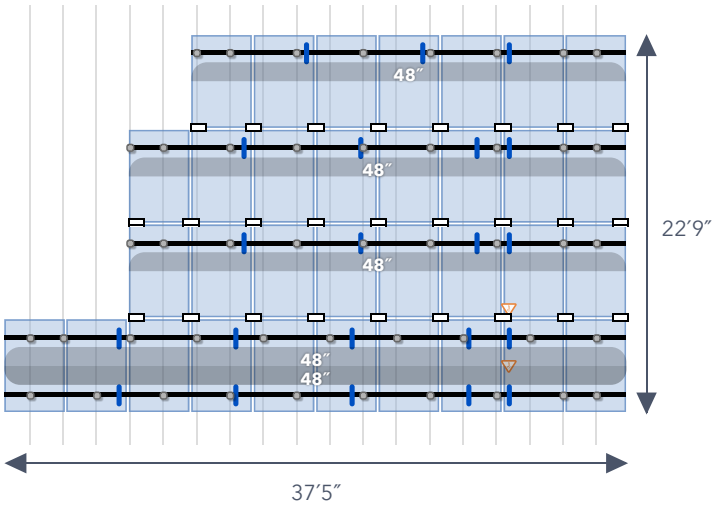Array 2 SkipRail

Zones:

- 1
- 2
- 3

Details

Roof Type: **35° Comp Gable**
 Rafter Spacing: **24.0"**
 SkipRail: **Yes**
 Use Scrap Rail: **Yes**

Hidden End Clamp: **Yes**
 Attachment Type: **Instaflash**
 Rail: **23 x 7ft**

Layout

Panels: **33**

Panel Size: **67.83" x 44.61" x 35mm**

Design Notes

System Weight: **1730.5 lbs**
 Attachments: **46**

System Weight/Attachment: **37.6 lbs**
 Total Area: **862 sqft**

Engineering

Max span values for SkipRail system are displayed on the diagram

Maximum Rail Cantilever

Attachment Span	Max Rail Cantilever
72"	28"
64"	25"
48"	19"
32"	12"
24"	9"
Other	40% of attachment span



Leave a 1" thermal break every 36ft of continuous Rails sections (marked as ▽ on the array miniature). Thermal break must be offset 1" or more from attachment.

Bill of Materials

Part Info	Array 1	Array 2	Spares	Total QTY
PSR-B84 Pegasus Rail - Black 84"	8	23	-	31
PSR-SPLS Pegasus - Bonded Structural Splice	7	21	-	28
PSR-MCB Pegasus - Multi-Clamp - Mid/End 30-40mm - Full Black	11	38	-	49
PSR-HEC Pegasus - Hidden End Clamp	7	10	-	17
PSR-SRC Pegasus - SkipRail Clamp	2	26	-	28
PSR-MLP Pegasus - MLPE Mount	8	33	-	41
PSR-LUG Pegasus - Ground Lug	1	1	-	2
PSR-WMC Pegasus - Wire Management Clip	12	50	-	62
PSR-CBG Pegasus - Cable Grip	2	6	-	8
PSR-CAP Pegasus - End Cap	7	10	-	17
PIF-RBDT Pegasus InstaFlash - Black - Dovetail T-bolt	16	46	-	62

NEW PV SYSTEM DESIGN

41 MODULES - 16.400 kW DC, 12.180 kW AC SYSTEM SIZE

DALEY RESIDENCE - 40 ADRIAN STREET, HOLLY SPRINGS, NC 27540

DESIGN ENGINEER



76 N. MEADOWBROOK DRIVE
ALPINE UT 84004
swysling@wysslingconsulting.com
(201) 874-3483
COA NO. P-2308

SOLAR COMPANY/CLIENT



BYLD BETTER
1213 W MOOREHEAD STREET SUITE 500
CHARLOTTE, NC

DALEY
RESIDENCE
40 ADRIAN STREET
HOLLY SPRINGS, NC 27540

COVER PAGE

THIS PLAN HAS BEEN ELECTRONICALLY SIGNED AND SEALED BY SCOTT WYSSLING, PE USING A DIGITAL SIGNATURE AND DATE. PRINTED COPIES OF THIS DOCUMENT ARE NOT CONSIDERED SIGNED AND SEALED AND THE SIGNATURE MUST BE VERIFIED ON ANY ELECTRONIC COPIES.



Signed 8/05/2024
SCOTT E WYSSLING, PE
NC LICENSE NO 46546

DC SYSTEM SIZE: 16.400kW
AC SYSTEM SIZE: 12.180kW

PV-1


AHJ: HARNETT COUNTY
UTILITY: DEP

DRAWN BY: RRT
DATE: 8/5/2024

AERIAL MAP NTS



VICINITY MAP NTS

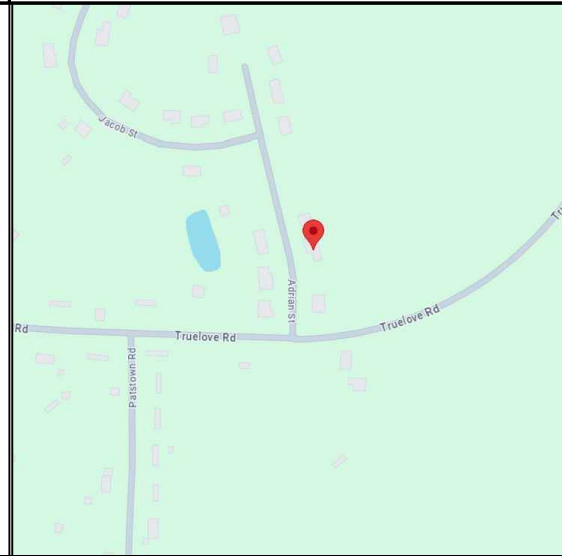

SHEET INDEX

PV-1	COVER PAGE
PV-2	SITE PLAN
PV-3	MOUNTING DETAILS
PV-4	THREE LINE DIAGRAM
PV-5	ELECTRICAL NOTES
PV-6	LABELS
PV-6.1	PLACARD
PV-7	SITE PHOTOS
SPEC	MANUFACTURER SPECIFICATION SHEETS

SCOPE OF WORK

SYSTEM SIZE: 16.400kW DC / 12.180kW AC SYSTEM SIZE
PV MODULE: (41) URECO FBM400MFG-BB
INVERTER: (21) NEP BDM-600X [240V]
COMBINER: (1) 125A LOAD CENTER

ROOF STORIES: 1
ROOF TYPE(S): COMP SHINGLE
MOUNTING(S) & RACKING(S): PEGASUS INSTAFLASH WITH SKIPRAIL WITH PEGASUS RAIL

INTERCONNECTION: LOAD BREAKER
MAIN SERVICE PANEL RATING: (E) 200A
MAIN BREAKER RATING: (D) 175A

GOVERNING CODES

2017 NATIONAL ELECTRIC CODE
2018 NORTH CAROLINA BUILDING CODE
2018 NORTH CAROLINA RESIDENTIAL CODE
2018 NORTH CAROLINA FIRE PREVENTION CODE
2018 NORTH CAROLINA FUEL GAS CODE
2018 NORTH CAROLINA EXISTING BUILDING CODE
2018 NORTH CAROLINA ENERGY CONSERVATION CODE
2018 NORTH CAROLINA MECHANICAL CODE
2018 NORTH CAROLINA PLUMBING CODE

AS ADOPTED BY HARNETT COUNTY INCLUDING ANY AMENDMENTS OR ADDITIONAL LISTED REQUIREMENTS. DESIGNED IN ACCORDANCE WITH THE REQUIREMENTS OF DUKE ENERGY PROGRESS UTILITY.

DESIGN CRITERIA

WIND SPEED: 120 MPH
GROUND SNOW LOAD: 15 PSF
ASCE: 7-10
EXPOSURE CATEGORY: C
BUILDING OCCUPANCY: R-2
CONSTRUCTION TYPE: TYPE I-B
SPRINKLERS: NO

DATE	REVISION
8/5/2024	AS-BUILT

GENERAL NOTES

- CONTRACTOR SHALL FIELD VERIFY ALL DIMENSIONS AND REVIEW ALL MANUFACTURER INSTALLATION DOCUMENTS PRIOR TO INITIATING CONSTRUCTION.
- ALL COMPONENTS SHALL BE NEW AND LISTED BY A RECOGNIZED ELECTRICAL TESTING LABORATORY AND LISTED FOR THEIR SPECIFIC APPLICATION.
- OUTDOOR EQUIPMENT SHALL BE NEMA 3R RATED OR BETTER.
- ACCESS TO ELECTRICAL COMPONENTS OVER 150 VOLTS TO GROUND SHALL BE RESTRICTED TO QUALIFIED PERSONNEL.
- CONTRACTOR SHALL OBTAIN ELECTRICAL PERMITS PRIOR TO INSTALLATION AND SHALL COORDINATE ALL INSPECTIONS, TESTING COMMISSIONING, AND ACCEPTANCE WITH THE HOMEOWNER, UTILITY CO. AND CITY INSPECTORS AS NEEDED.
- EACH MODULE TO BE GROUNDED USING THE SUPPLIED CONNECTION POINT PER THE MANUFACTURER'S REQUIREMENTS. ALL PV MODULES, EQUIPMENT, AND METALLIC COMPONENTS ARE TO BE BONDED. IF THE EXISTING GROUNDING ELECTRODE SYSTEM CANNOT BE VERIFIED OR IS ONLY METALLIC WATER PIPING, IT IS THE CONTRACTOR'S RESPONSIBILITY TO INSTALL A SUPPLEMENTAL GROUNDING ELECTRODE.
- DC CONDUCTORS SHALL BE RUN IN EMT AND/OR MC (METAL CLAD CABLE) AND SHALL BE LABELED. ALL DC CONDUCTORS RUN INSIDE OF THE STRUCTURE SHALL BE INSTALLED A MINIMUM OF 18" BELOW THE ROOF DECK.
- EXPOSED NON-CURRENT CARRYING METAL PARTS OF ELECTRICAL EQUIPMENT SHALL BE GROUNDED IN ACCORDANCE WITH APPLICABLE NEC.
- CONFIRM LINE SIDE VOLTAGE AT THE ELECTRIC UTILITY SERVICE PRIOR TO CONNECTING INVERTER. VERIFY SERVICE VOLTAGE IS WITHIN INVERTER VOLTAGE OPERATIONAL RANGE.
- ELECTRICAL CONTRACTOR TO PROVIDE CONDUIT EXPANSION JOINTS AND ANCHOR CONDUIT RUNS AS REQUIRED PER CODE.
- ALL WIRING MUST BE PROPERLY SUPPORTED BY DEVICES OR MECHANICAL MEANS DESIGNED AND LISTED FOR SUCH USE, AND FOR ROOF-MOUNTED SYSTEMS, WIRING MUST BE PERMANENTLY AND COMPLETELY HELD OFF OF THE ROOF SURFACE.
- ALL ROOF PENETRATIONS MUST BE SEALED OR FLASHED.
- EQUIPMENT MAY BE SUBSTITUTED FOR SIMILAR EQUIPMENT BASED ON AVAILABILITY, SUBSTITUTED EQUIPMENT SHALL COMPLY WITH DESIGN CRITERIA.
- REMOVAL OF AN INTERACTIVE INVERTER OR OTHER EQUIPMENT SHALL NOT DISCONNECT THE BONDING CONNECTION BETWEEN THE GROUNDING ELECTRODE CONDUCTOR AND THE PHOTOVOLTAIC SOURCE AND/OR OUTPUT CIRCUIT GROUNDED CONDUCTORS.
- WHENEVER A DISCREPANCY IN THE QUALITY OF EQUIPMENT ARISES ON THE DRAWING OR SPECIFICATIONS, THE CONTRACTOR SHALL BE RESPONSIBLE FOR PROVIDING AND INSTALLING ALL MATERIAL AND SERVICES REQUIRED BY THE STRICTEST CONDITIONS NOTED ON THE DRAWINGS OR IN THE SPECIFICATIONS TO ENSURE COMPLETE COMPLIANCE AND LONGEVITY OF THE OPERABLE SYSTEM REQUIRED BY THE ENGINEERS.



SYSTEM INFORMATION

MODULE TYPE	URECO FBM400MFG-BB
MODULE WEIGHT	47.84 LBS
MODULE DIMENSIONS	67.83" x 44.61"
UNIT WEIGHT OF ARRAY	2.28 PSF



LEGEND

ROOF VENT (TYP.)	
PLUMBING VENT (TYP.)	
A/C UNIT	
SATELLITE DISH	
ELECTRICAL MAST	
CHIMNEY	
FIRECODE PATHWAY	

40 ADRIAN STREET

ROOF DESCRIPTION								
ROOF #	ROOF TYPE	TILT	AZIMUTH	ROOF FRAMING	MODULE COUNT	ARRAY SQ. FT.	ATTACHMENT	MIN EMBEDMENT
1	COMP SHINGLE	35°	76°	2X8@24" O.C. RAFTERS W/ KNEE WALL SUPPORT	33	693	(1) 5/16" X 4" LAG SCREW	2.5"
2	COMP SHINGLE	35°	255°	2X8@24" O.C. RAFTERS W/ KNEE WALL SUPPORT	8	168	(1) 5/16" X 4" LAG SCREW	2.5"
TOTAL ROOF AREA SQ. FT.		2586		TOTAL ARRAY SQ. FT.		861	ROOF COVER %	33.31

(N) PV MODULE EQUIPPED W/ (1) MICRO INVERTER PER 2 MODULE
 MAIN SERVICE PANEL
 DUKE ENERGY PROGRESS METER
 (N) VISIBLE LOCKABLE LABELED AC DISCONNECT
 (N) AC COMBINER
 (N) NEP MONITORING

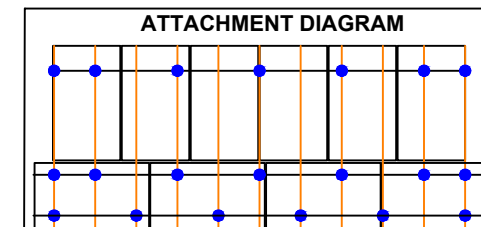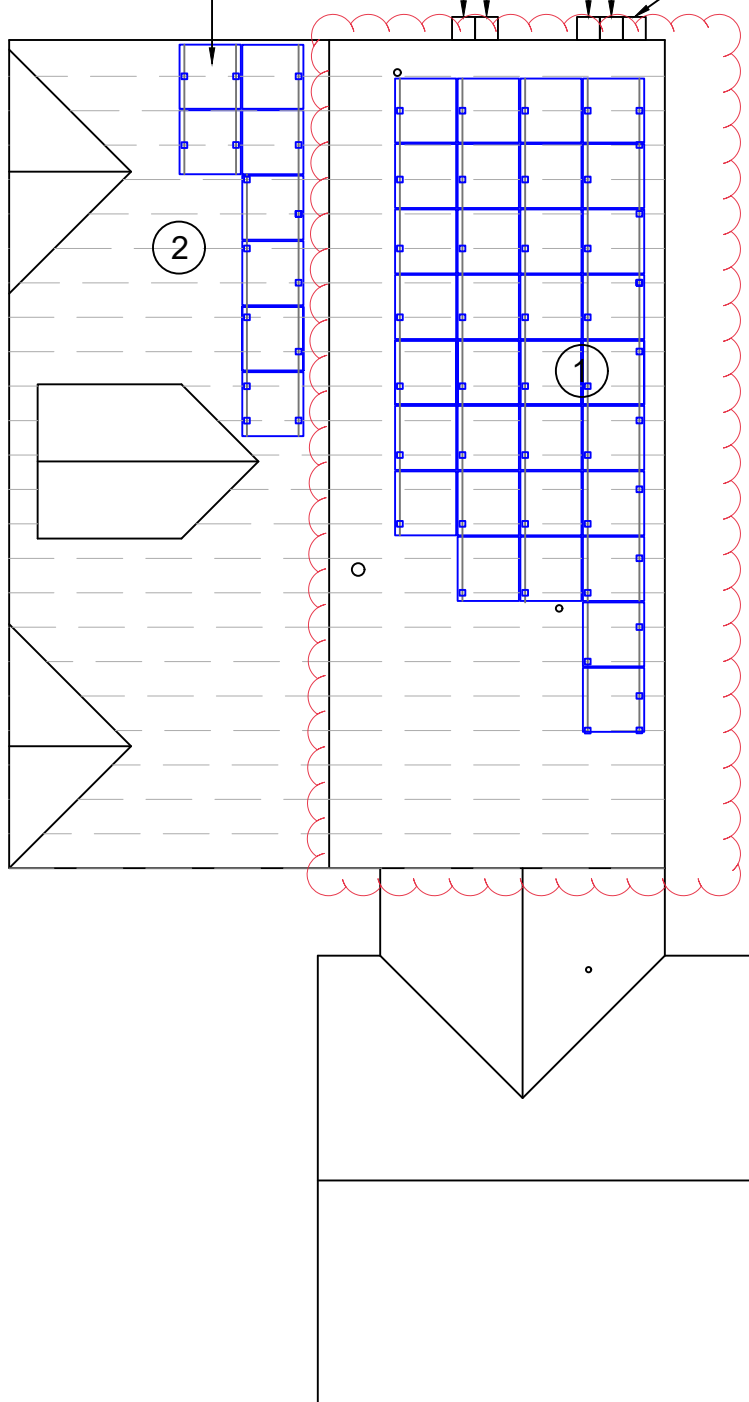

1. MAX ATTACHMENT SPACING SHALL NOT EXCEED 48" O.C
2. ATTACHMENTS SHALL BE STAGGERED
3. ROOF SPACING: 24" O.C.
4. MAX CANTILEVERS < 16"

SCALE: 3/32" = 1'-0"

SITE PLAN NOTES

1. ALL OBSTRUCTIONS MUST BE VERIFIED BEFORE WORK COMMENCES
2. CONDUIT TO BE RUN IN ATTIC IF POSSIBLE
3. VISIBLE LOCKABLE LABELED AC DISCONNECT WILL BE INSTALLED WITHIN 10' OF DUKE ENERGY PROGRESS METER
4. SMOKE/CARBON MONOXIDE DETECTORS REQUIRED ON SITE

DESIGN ENGINEER



**76 N. MEADOWBROOK DRIVE
ALPINE UT 84004**

swyssling@wysslingconsulting.com
(201) 874-3483
COA NO. P-2308

SOLAR COMPANY/CLIENT



BYLD BETTER
1213 W MOOREHEAD STREET SUITE 500
CHARLOTTE, NC

**DALEY
RESIDENCE**

40 ADRIAN STREET
HOLLY SPRINGS, NC 27540

SITE PLAN

THIS PLAN HAS BEEN ELECTRONICALLY SIGNED AND SEALED BY SCOTT WYSSLING, PE USING A DIGITAL SIGNATURE AND DATE. PRINTED COPIES OF THIS DOCUMENT ARE NOT CONSIDERED SIGNED AND SEALED AND THE SIGNATURE MUST BE VERIFIED ON ANY ELECTRONIC COPIES.



Signed 8/05/2024

SCOTT E WYSSLING, PE
NC LICENSE NO 46546

DC SYSTEM SIZE: 16.400kW
AC SYSTEM SIZE: 12.180kW

PV-2

AHJ: HARNETT COUNTY
UTILITY: DEP

DRAWN BY: RRT
DATE: 8/5/2024

DESIGN ENGINEER



76 N. MEADOWBROOK DRIVE
ALPINE UT 84004
swyssling@wysslingconsulting.com
(201) 874-3483
COA NO. P-2308

SOLAR COMPANY/CLIENT



BYLD BETTER
1213 W MOOREHEAD STREET SUITE 500
CHARLOTTE, NC

DALEY
RESIDENCE
40 ADRIAN STREET
HOLLY SPRINGS, NC 27540

MOUNTING DETAILS

THIS PLAN HAS BEEN ELECTRONICALLY SIGNED AND SEALED BY SCOTT WYSSLING, PE USING A DIGITAL SIGNATURE AND DATE. PRINTED COPIES OF THIS DOCUMENT ARE NOT CONSIDERED SIGNED AND SEALED AND THE SIGNATURE MUST BE VERIFIED ON ANY ELECTRONIC COPIES.



Signed 8/05/2024
SCOTT E WYSSLING, PE
NC LICENSE NO 46546

DC SYSTEM SIZE: 16.400kW
AC SYSTEM SIZE: 12.180kW

PV-3

AHJ: HARNETT COUNTY
UTILITY: DEP


DRAWN BY: RRT
DATE: 8/5/2024

MOUNTING INFORMATION

ROOF SECTIONS R1, R2


GENERAL ROOF MOUNT DETAIL

NTS

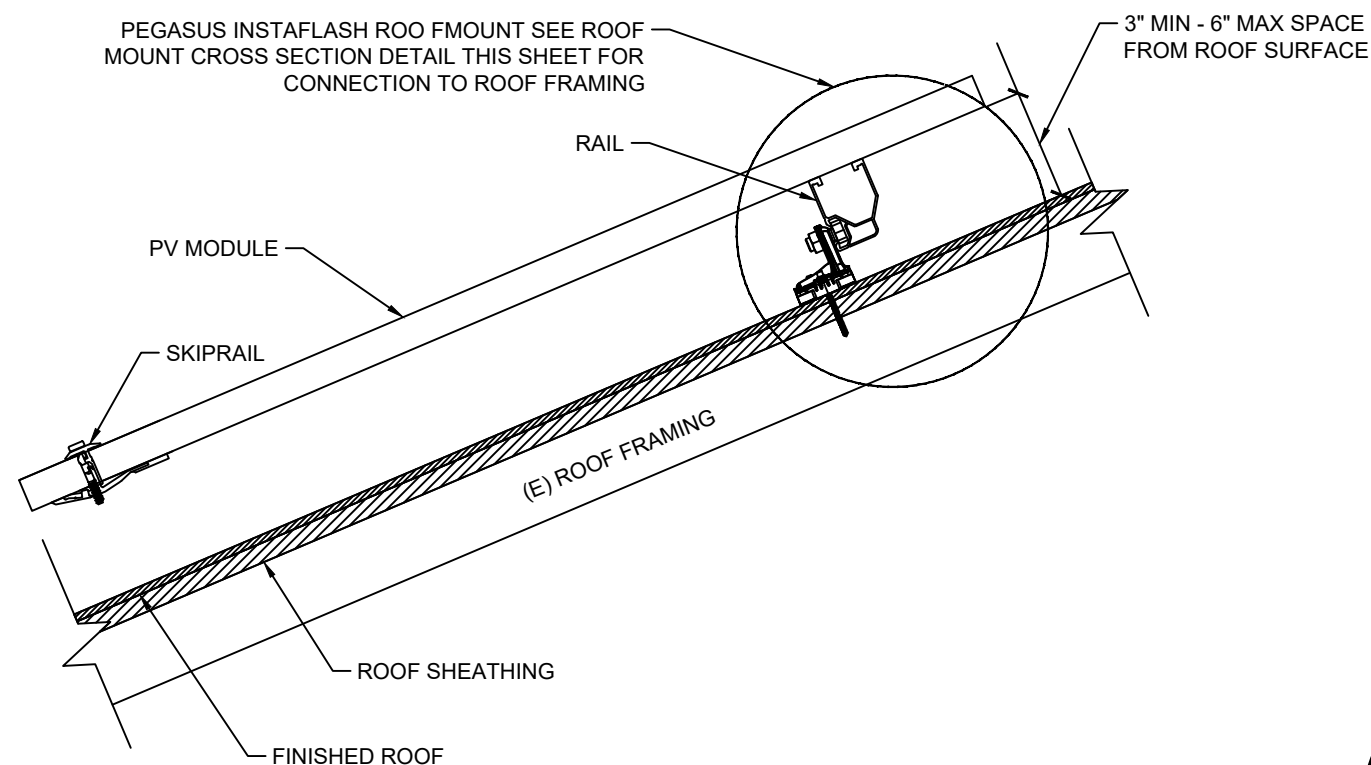


ROOF MOUNT PLAN VIEW DETAIL

NTS

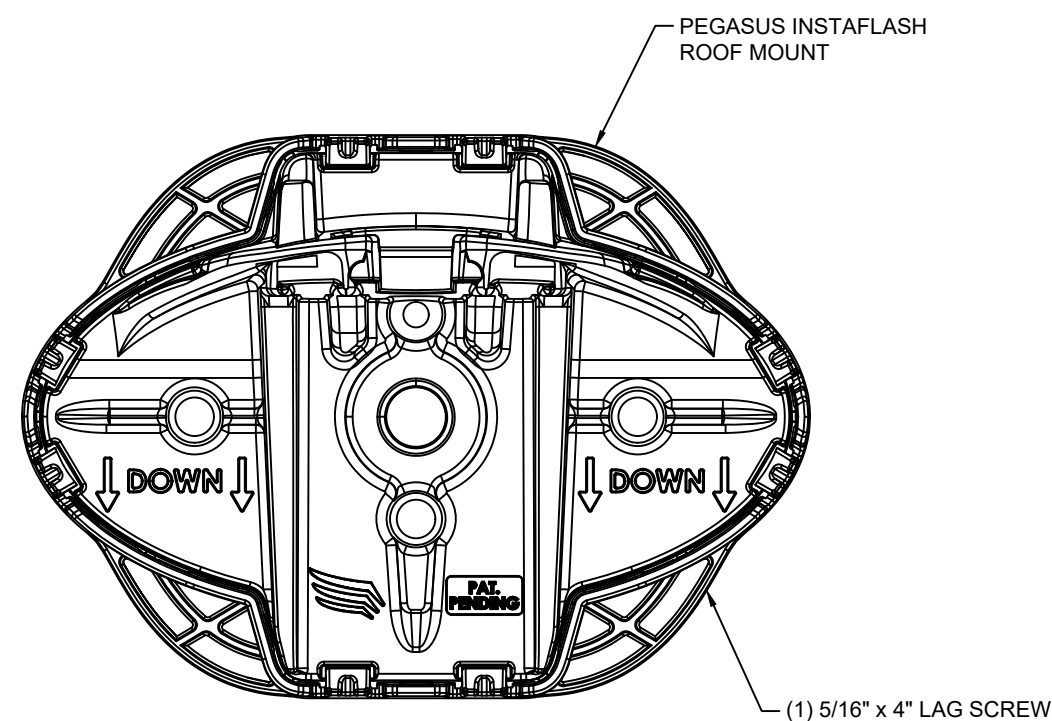

PEGASUS INSTAFLASH ROOF MOUNT WITH (1) LAG BOLT CONNECTED TO ROOF FRAMING

(1) 5/16" x 4" LAG SCREW, SS

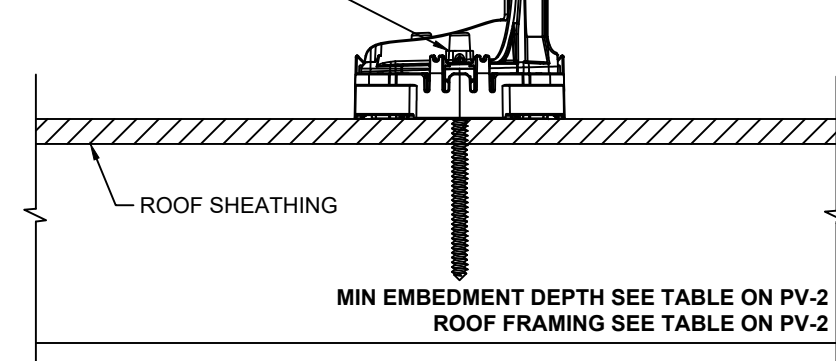

ROOF MOUNT CROSS SECTION DETAIL

NTS

MODULE WATTAGE: 400W
 DC SYSTEM SIZE: 16.400kW
 AC SYSTEM SIZE: 12.180kW

CONDUCTOR SCHEDULE										
TAG	# WIRES IN CONDUIT	MINIMUM WIRE SIZE	TYPE, MATERIAL	MINIMUM GROUND WIRE SIZE	GROUND TYPE, MATERIAL	CONDUIT	AMPS (BEFORE 125% SAFETY FACTOR)	TOTAL AMPS	WIRE AMPERAGE RATING TABLE 310.15(B)(16)	MINIMUM OCPD
A	3	#10 AWG	THWN-2, CU	#6 AWG	BARE CU	3/4 EMT	14.52	18.15	30	20
B	3	#10 AWG	THWN-2, CU	#12 AWG	THWN-2, CU	3/4 EMT	14.52	18.15	30	20
C	4	#6 AWG	THWN-2, CU	#8 AWG	THWN-2, CU	3/4 EMT	50.82	63.53	65	70

DESIGN ENGINEER



76 N. MEADOWBROOK DRIVE
 ALPINE UT 84004
 swyssling@wysslingconsulting.com
 (201) 874-3483
 COA NO. P-2308


SOLAR COMPANY/CLIENT



BYLD BETTER
 1213 W MOOREHEAD STREET SUITE 500
 CHARLOTTE, NC

DALEY RESIDENCE
 40 ADRIAN STREET
 HOLLY SPRINGS, NC 27540

THREE LINE DIAGRAM

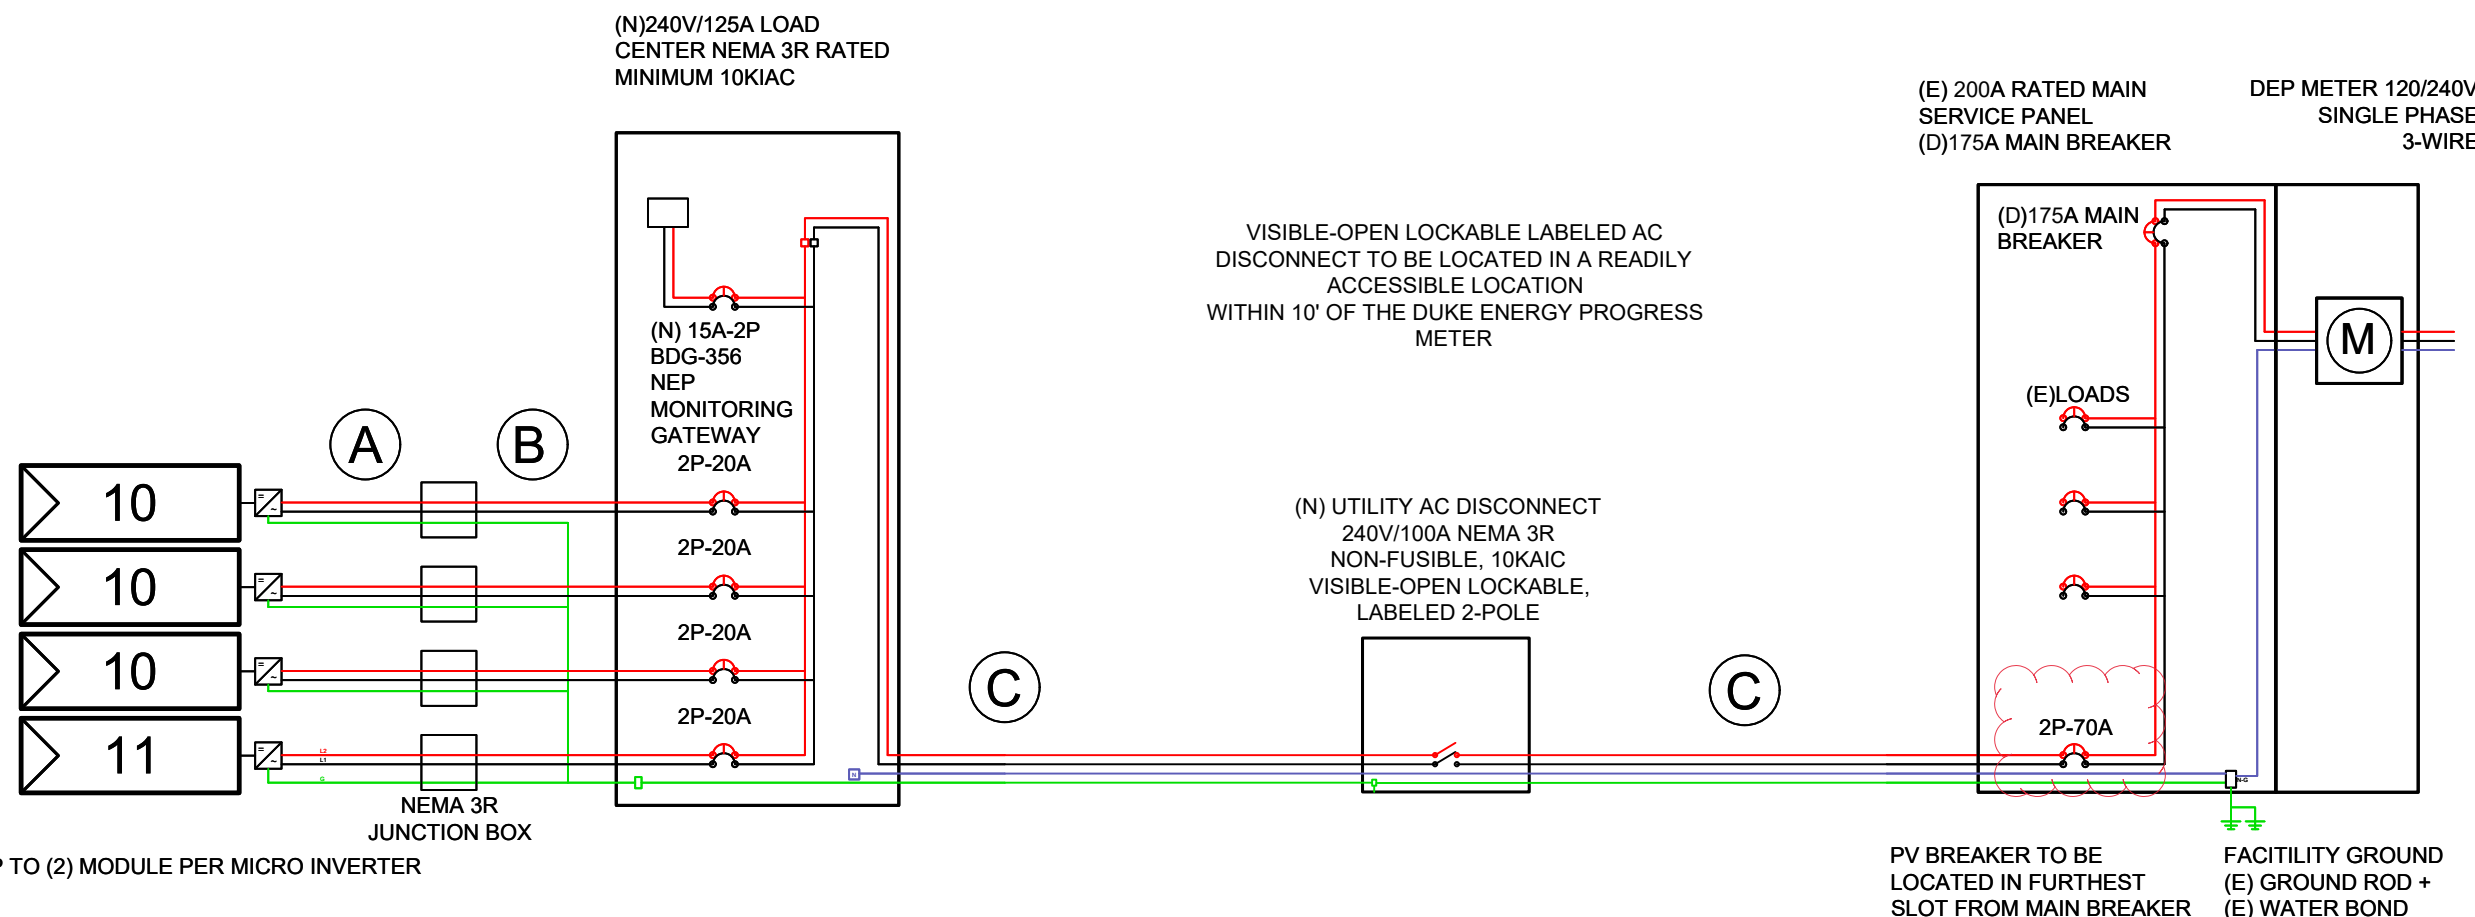

DC SYSTEM SIZE: 16.400kW
 AC SYSTEM SIZE: 12.180kW

PV-4

AHJ: HARNETT COUNTY
 UTILITY: DEP
 DRAWN BY: RRT
 DATE: 8/5/2024

PV MODULE		INVERTER	
MODEL	URECO FBM400MFG-BB	MODEL	NEP BDM-600X [240V]
P _{MAX}	400W	MAX INPUT DC VOLTAGE	60V
V _{OC}	37.2V	MAX DC CURRENT	28A
V _{M_P}	31.17V	MAX OUTPUT POWER	580W
I _{M_P}	12.84A	MAXIMUM CONT. OUTPUT CURRENT	2.42A
I _{SC}	13.68A	CEC EFFICIENCY	0.955

INTERCONNECTION PER NEC 705.12 (B)(3)(3)	
MSP RATING	200A
MAIN DISCONNECT RATING	175A
TOTAL BACK FEED REQUIRED	63.53A
OCPD RATING	70A
(MSP RATING * 1.2)- SUB DISCONNECT	(200A * 1.2)-175 >=70A, GOOD

DESIGN ENGINEER



**76 N. MEADOWBROOK DRIVE
ALPINE UT 84004**

swysling@wysslingconsulting.com
(201) 874-3483
COA NO. P-2308

SOLAR COMPANY/CLIENT



BYLD BETTER
1213 W MOOREHEAD STREET SUITE 500
CHARLOTTE, NC

**DALEY
RESIDENCE**
40 ADRIAN STREET
HOLLY SPRINGS, NC 27540

ELECTRICAL NOTES

DC SYSTEM SIZE: 16.400kW
AC SYSTEM SIZE: 12.180kW

PV-5

AHJ: HARNETT COUNTY
UTILITY: DEP

DRAWN BY: RRT
DATE: 8/5/2024

GENERAL ELECTRICAL NOTES

- CONDUIT A AND B AMPS EQUAL TO LARGEST STRING ON TAG.
- CONDUIT A SHALL BE RUN THROUGH ATTIC IF POSSIBLE.
- EQUIPMENT MAY BE SUBSTITUTED FOR SIMILAR EQUIPMENT BASED ON AVAILABILITY, SUBSTITUTED EQUIPMENT SHALL COMPLY WITH DESIGN CRITERIA. WIRE SIZES ARE BASED ON MINIMUMS AND ARE NOT MEANT TO LIMIT UPSIZING AS REQUIRED BY FIELD CONDITIONS/AVAILABILITY.
- WIRING SHALL COMPLY WITH MAXIMUM CONTINUOUS CURRENT OUTPUT AT 25°C AND MAXIMUM VOLTAGE AT 600V; WIRE SHALL BE WET RATED AT 90°C.
- EXPOSED PHOTOVOLTAIC SYSTEM CONDUCTORS ON THE ROOF WILL BE TYPE 2 OR PV-TYPE WIRE.
- PHOTOVOLTAIC SYSTEM CONDUCTORS SHALL BE IDENTIFIED AND GROUPED. THE MEANS OF IDENTIFICATION SHALL BE PERMITTED BY SEPERATE COLOR-CODING, MARKING TAPE, TAGGING OR OTHER APPROVED MEANS.
- ALL CONDUCTORS AND TERMINATIONS SHALL BE RATED FOR INSTALL LOCATION
- ALL EXTERIOR CONDUIT, FITTINGS, AND BOXES SHALL BE RAIN-TIGHT AND APPROVED FOR USE IN WET LOCATIONS.
- ALL METALLIC RACEWAYS AND EQUIPMENT SHALL BE BONDED AND ELECTRICALLY CONTINUOUS.
- WHERE SIZES OF JUNCTION BOXES, RACEWAYS, AND CONDUITS ARE NOT SPECIFIED, CONTRACTOR SHALL SIZE THEM ACCORDING TO APPLICABLE CODES.
- REMOVAL OF A UTILITY-INTERACTIVE INVERTER OR OTHER EQUIPMENT SHALL NOT DISCONNECT THE BUILDING CONNECTION BETWEEN THE GROUNDING ELECTRODE CONDUCTOR AND THE PV SOURCE AND/OR OUTPUT CIRCUIT GROUNDED CONDUCTOR.
- FOR GROUNDED SYSTEMS, THE PHOTOVOLTAIC SOURCE AND OUTPUT CIRCUITS SHALL BE PROVIDED WITH A GROUND-FAULT PROTECTION DEVICE OR SYSTEM THAT DETECTS A GROUND FAULT, INDICATES THAT FAULT HAS OCCURRED, AND AUTOMATICALLY DISCONNECTS ALL CONDUCTORS OR CAUSES THE INVERTER TO AUTOMATICALLY CEASE SUPPLYING POWER TO OUTPUT CIRCUITS.
- FOR UNGROUNDED SYSTEMS, THE INVERTER IS EQUIPPED WITH GROUND FAULT PROTECTION AND A GFI FUSE PORT FOR GROUND FAULT INDICATION.
- PV MODULE FRAMES SHALL BE BONDED TO RACKING RAIL OR BARE COPPER GEC/GEC PER THE MODULE MANUFACTURER'S LISTED INSTRUCTION SHEET.
- PV MODULE RACKING RAIL SHALL BE BONDED TO BARE COPPER GEC VIA WEEB LUG, IL SCO GBL-4DBT LAY IN LUG, OR EQUIVALENT LISTED LUG.
- THE PHOTOVOLTAIC INVERTER WILL BE LISTED AS AUL 1741 COMPLIANT.
- RACKING AND BONDING SYSTEM TO BE UL2703 RATED.
- ANY REQUIRED GROUNDING ELECTRODE CONDUCTOR WILL BE CONTINUOUS, EXCEPT FOR SPLICES OR JOINTS AS BUSBARS WITHIN LISTED EQUIPMENT
- WHEN BACKFEED BREAKER IS THE METHOD OF UTILITY INTERCONNECTION, THE BREAKERS SHALL NOT READ "LINE AND LOAD."
- WHEN APPLYING THE 120% RULE, THE SOLAR BREAKER TO BE POSITIONED AT THE OPPOSITE END OF THE BUSBAR FROM THE MAIN BREAKER.
- THE WORKING CLEARANCE AROUND THE EXISTING ELECTRICAL EQUIPMENT AS WELL AS THE NEW ELECTRICAL EQUIPMENT WILL BE MAINTAINED.
- LISTED CONDUIT AND CONDUCTOR SIZES ARE BASED ON MINIMUM CODE REQUIREMENTS AND ARE NOT MEANT TO LIMIT UPSIZING AS REQUIRED BY FIELD CONDITIONS/AVAILABILITY.
- NEP BDM-600X [240V] INVERTERS HAVE INTEGRATED GROUND AND DOUBLE INSULATION. NO GEG OR EGC IS REQUIRED. THE DC CIRCUIT IS ISOLATED AND INSULATED FROM GROUND AND MEETS THE REQUIREMENTS OF 2017 NEC.
- CALCULATIONS ARE BASED ON A) ASHRAE 2# AVERAGE HIGH = 32°C B)NEC TABLE 310.15(B)2(a) 75° DERATE FACTOR = .96 C) NEC TABLE NEC 310.15(B)(16) 75°C.
- SUPPLEMENTAL GROUNDING ELECTRODE TO BE INSTALLED NO CLOSER THAN 6' FROM EXISTING WHEN REQUIRED. NEC 250.53(A)(2) DOES NOT REQUIRE IT IF CONTRACTOR CAN PROVE THAT A SINGLE ROD HAS A RESISTANCE TO EARTH OF 25 OHMS OR LESS.

PHOTOVOLTAIC AC DISCONNECT
 MAXIMUM AC OPERATING CURRENT: 50.82
 NOMINAL OPERATING AC VOLTAGE: 240

AT POINT OF INTERCONNECTION, MARKED AT DISCONNECTING MEANS [NEC 690.54]

WARNING DUAL POWER SOURCE
 SECOND SOURCE IS PHOTOVOLTAIC SYSTEM

AT POINT OF INTERCONNECTION [NEC 705.12(C), 690.59]

MAIN PHOTOVOLTAIC SYSTEM DISCONNECT

EACH PV SYSTEM DISCONNECTING MEANS SHALL PLAINLY INDICATE WHETHER IN THE OPEN (OFF) OR CLOSED (ON) POSITION AND BE PERMANENTLY MARKED [NEC 690.13(B)]

PHOTOVOLTAIC DC DISCONNECT

AT EACH DC DISCONNECTING MEANS [NEC 690.13(B)]

PHOTOVOLTAIC AC DISCONNECT

AT EACH AC DISCONNECTING MEANS [NEC 690.13(B)]

WARNING: PHOTOVOLTAIC POWER SOURCE

AT EXPOSED RACEWAYS, CABLE TRAYS, AND OTHER WIRING METHODS; SPACED AT MAXIMUM 10 FT SECTION OR WHERE SEPERATED BY ENCLOSURES, WALLS, PARTITIONS, CEILINGS, OR FLOORS [NEC 690.31(D)(2)]

WARNING
ELECTRICAL SHOCK HAZARD
DO NOT TOUCH TERMINALS
 TERMINALS ON BOTH LINE AND LOAD SIDES
 MAY BE ENERGIZED IN THE OPEN POSITION

AT BUILDING OR STRUCTURE MAIN DISCONNECTING MEANS [NEC 690.12(E), NEC 690.13(B)]

WARNING
 PHOTOVOLTAIC SYSTEM COMBINER PANEL
 DO NOT ADD LOADS

AT AC COMBINER PANEL [NEC 690.13(B)]


WARNING
 THE EQUIPMENT FED BY MULTIPLE SOURCES. TOTAL RATING OF ALL OVERCURRENT DEVICES, EXCLUDING MAIN SUPPLY OVERCURRENT DEVICE, SHALL NOT EXCEED AMPACITY OF BUSBAR

PERMANENT WARNING LABELS SHALL BE APPLIED TO DISTRIBUTION EQUIPMENT

WARNING
 INVERTER OUTPUT CONNECTION. DO NOT RELOCATE THIS OVERCURRENT DEVICE

A PERMANENT WARNING LABEL SHALL BE APPLIED TO THE DISTRIBUTION EQUIPMENT ADJACENT TO THE BACK-FED BREAKER FROM THE INVERTER [NEC 705.12(B)(3)(2)]

SOLAR PV SYSTEM EQUIPPED WITH RAPID SHUTDOWN

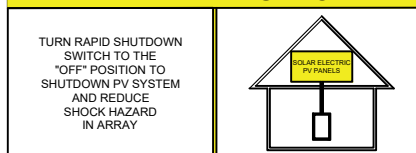

FOR PV SYSTEMS THAT SHUT DOWN THE ARRAY AND CONDUCTORS LEAVING THE ARRAY: THE TITLE "SOLAR PV SYSTEM IS EQUIPPED WITH RAPID SHUTDOWN" SHALL UTILIZED CAPITALIZED CHARACTERS WITH A MINIMUM HEIGHT OF 3/8 IN. IN BLACK ON YELLOW BACKGROUND, AND THE REMAINING CHARACTERS SHALL BE CAPITALIZED WITH A MINIMUM HEIGHT OF 3/16 IN. IN BLACK ON WHITE BACKGROUND [NEC 690.56(C)(1)(A)]

RAPID SHUTDOWN SWITCH FOR SOLAR PV

A RAPID SHUTDOWN SWITCH SHALL HAVE A LABELED LOCATED ON OR NO MORE THAN 8 FT FROM THE SWITCH THAT INCLUDES THIS WORDING. THE LABEL SHALL BE REFLECTIVE, WITH ALL LETTERS CAPITALIZED AND HAVING A MINIMUM HEIGHT OF 3/8 IN., IN WHITE ON RED BACKGROUND [NEC 690.58(C)(2)]

CAUTION: DO NOT INSTALL ADDITIONAL LOADS IN THIS PANEL

PLACE LABEL AT MAIN SERVICE PANEL

WARNING
 THIS EQUIPMENT FED BY MULTIPLE SOURCES. TOTAL RATING OF ALL OVERCURRENT DEVICES, EXCLUDING MAIN SUPPLY OVERCURRENT DEVICE, SHALL NOT EXCEED AMPACITY OF BUSBAR.

PLACE LABEL AT MAIN SERVICE PANEL

LABELING NOTES:

1. LABELS CALLED OUT ACCORDING TO ALL COMMON CONFIGURATIONS. ELECTRICIAN TO DETERMINE EXACT REQUIREMENTS IN THE FIELD PER CURRENT NEC AND LOCAL CODES AND MAKE APPROPRIATE ADJUSTMENTS.
2. LABELING REQUIREMENTS BASED ON THE NATIONAL ELECTRIC CODE, OSHA STANDARD 19010.145, ANSI Z535.
3. MATERIAL BASED ON THE REQUIREMENTS OF THE AUTHORITY HAVING JURISDICTION.
4. LABELS TO BE OF SUFFICIENT DURABILITY TO WITHSTAND THE ENVIRONMENT INVOLVED [NEC 110.21] THEY SHALL BE PERMANENTLY ATTACHED, WEATHER/SUNLIGHT RESISTANT, AND SHALL NOT BE HAND WRITTEN PER NEC 110.21(B)
5. APPLICABLE LABELS TO BE A MINIMUM LETTER HEIGHT OF 3/8", WHITE ON RED BACKGROUND; REFLECTIVE, AND PERMANENTLY AFFIXED [IFC 605.11.1.1]

DESIGN ENGINEER



**76 N. MEADOWBROOK DRIVE
 ALPINE UT 84004**
 swysslings@wysslingconsulting.com
 (201) 874-3483
 COA NO. P-2308

SOLAR COMPANY/CLIENT



BYLD BETTER
 1213 W MOOREHEAD STREET SUITE 500
 CHARLOTTE, NC

DALEY RESIDENCE
 40 ADRIAN STREET
 HOLLY SPRINGS, NC 27540

LABELS

DC SYSTEM SIZE: 16.400kW
 AC SYSTEM SIZE: 12.180kW

PV-6

AHJ: HARNETT COUNTY
 UTILITY: DEP

DRAWN BY: RRT
 DATE: 8/5/2024

CAUTION

POWER TO THIS BUILDING IS ALSO SUPPLIED FROM THE FOLLOWING SOURCES WITH DISCONNECTS AS SHOWN

Labels in diagram:
 MAIN SERVICE PANEL
 METER
 AC DISCONNECT
 AC COMBINER
 NEP MONITORING
 PV MODULE

40 ADRIAN STREET HOLLY SPRINGS, NC 27540

LOCATION: MSP
 NEC 705.10

DESIGN ENGINEER



**76 N. MEADOWBROOK DRIVE
 ALPINE UT 84004**
 swysling@wysslingconsulting.com
 (201) 874-3483
 COA NO. P-2308

SOLAR COMPANY/CLIENT



BYLD BETTER
 1213 W MOOREHEAD STREET SUITE 500
 CHARLOTTE, NC

**DALEY
 RESIDENCE**
 40 ADRIAN STREET
 HOLLY SPRINGS, NC 27540

PLACARD

DC SYSTEM SIZE: 16.400kW
 AC SYSTEM SIZE: 12.180kW

PV-6.1

AHJ: HARNETT COUNTY
 UTILITY: DEP

DRAWN BY: RRT
 DATE: 8/5/2024

DESIGN ENGINEER



76 N. MEADOWBROOK DRIVE
ALPINE UT 84004
swyssling@wysslingconsulting.com
(201) 874-3483
COA NO. P-2308



SOLAR COMPANY/CLIENT



BYLD BETTER
1213 W MOOREHEAD STREET SUITE 500
CHARLOTTE, NC

DALEY
RESIDENCE
40 ADRIAN STREET
HOLLY SPRINGS, NC 27540

SITE PHOTOS

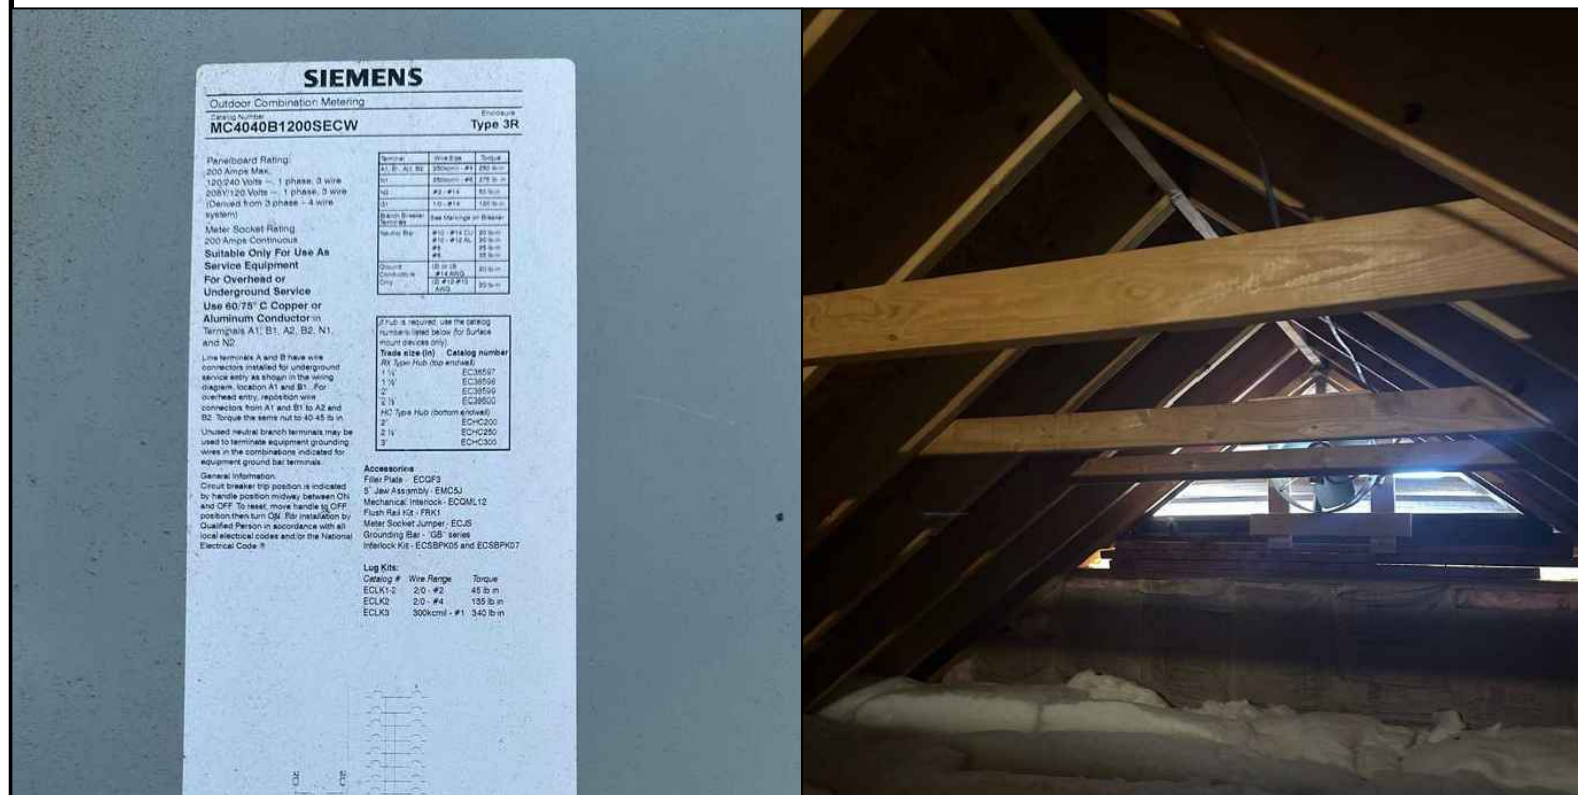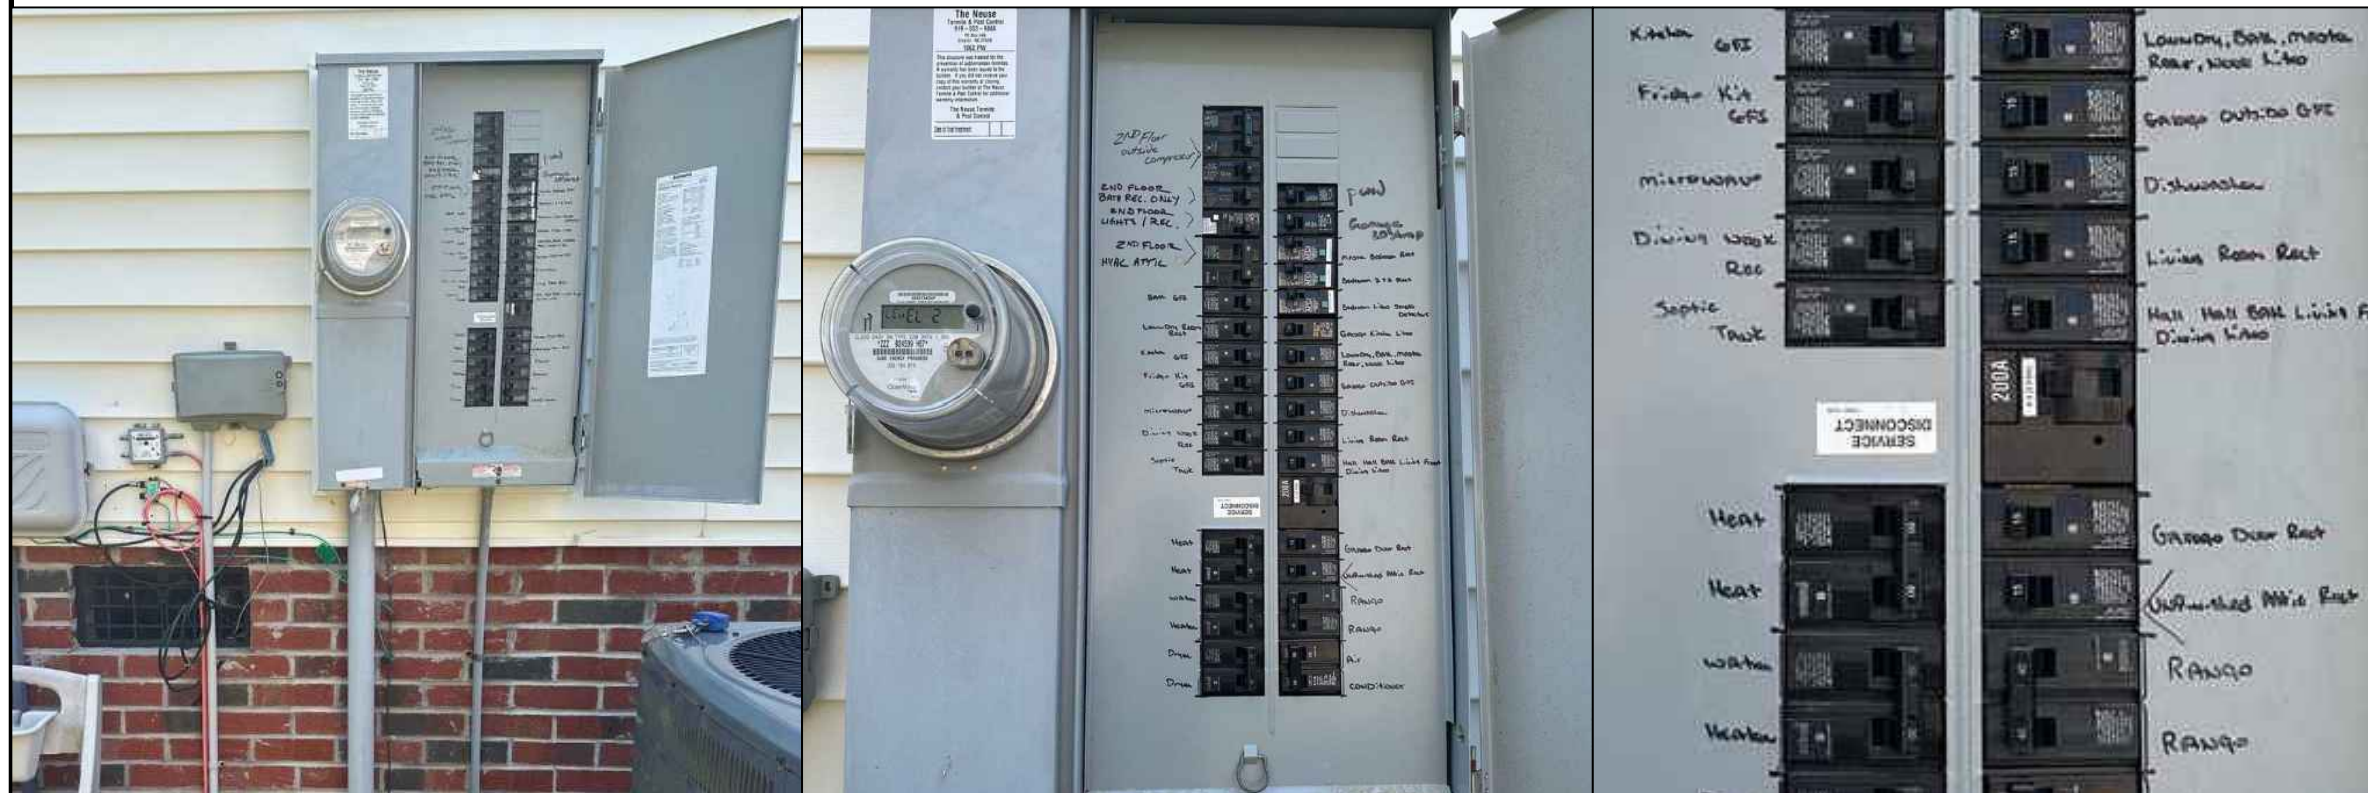

DC SYSTEM SIZE: 16.400kW
AC SYSTEM SIZE: 12.180kW

PV-7

AHJ: HARNETT COUNTY
UTILITY: DEP

DRAWN BY: RRT
DATE: 8/5/2024




FBM400MFG-BB / 108 cells 400 Watt Mono-Crystalline PV Module

URE modules use state-of-the-art cell cutting technology, and advanced module manufacturing experience to provide leading power density and long term reliability.



UL 61730, CE-compliant
Quality Controlled PV-TÜV
SUD IEC 61215:2016,
IEC 61730:2016
Type 1/Class C Fire Rating

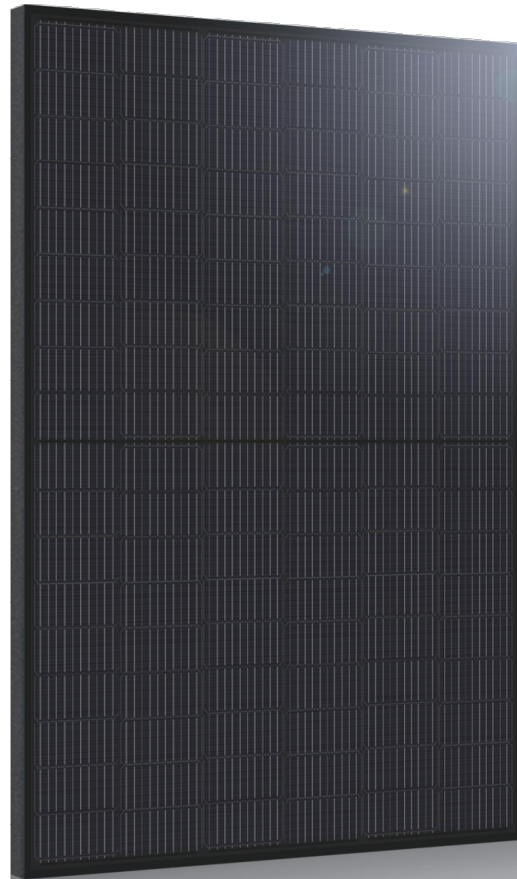

Key Features

- At 400 Watts and 20.49% Efficiency URE Solar Panels are Industry Leaders in Output and Efficiency
- 25 Year Output Warranty and 25 Year Product Guarantee
- Super All Black Design with more Uniform Appearance for High Profile Residential Installations
- High Quality Solar Cell Technology allows URE to be a major international exporter to Solar Module manufacturers in the United States and Europe
- Excellent Performance in Low Light and Poor Weather Conditions to Maximize Energy Harvest
- Winner of Taiwan Excellence Award 7 Consecutive Years for Highest Efficiency Module

THE IDEAL SOLUTION FOR:

- Rooftop arrays on residential buildings
- Residential ground mount arrays



For more information, please visit us at www.ureusa.com
Copyright © 2022 URE Corp. All rights reserved



Electrical Data

Model - STC		FBM390MFG-BB	FBM395MFG-BB	FBM400MFG-BB	FBM405MFG-BB
Maximum Rating Power (Pmax)	[W]	390	395	400	405
Module Efficiency	[%]	19.98	20.23	20.49	20.75
Open Circuit Voltage (Voc)	[V]	36.84	37.03	37.20	37.36
Maximum Power Voltage	[V]	30.82	31.00	31.17	31.36
Short Circuit Current (Isc)	[A]	13.50	13.59	13.68	13.78
Maximum Power Current	[A]	12.66	12.75	12.84	12.92

*Standard Test Conditions (STC): Cell Temperature 25 °C, Irradiance 1000 W/m², AM 1.5
*Values without tolerance are typical numbers. Measurement tolerance: ± 3%

Mechanical Data

Item	Specification
Dimensions	1723 mm (L) ¹ x 1133 mm (W) ¹ x 35 mm (D) ² / 67.83" (L) ¹ x 44.61" (W) ¹ x 1.38" (D) ²
Weight	21.7 kg / 47.84 lbs
Solar Cell	12x9 pieces monocrystalline solar cells series strings
Front Glass	White toughened safety glass, 3.2mm thickness
Cell Encapsulation	EVA (Ethylene-Vinyl-Acetate)
Frame	Black anodized aluminum profile
Junction Box	IP≥ 68, 3 diodes
Cable & Connector	Portrait : 1200 mm (cable length can be customized), 1 x 4 mm ² compatible with MC4
Package Configuration	31 pcs Per Pallet, 806 pcs per 40' HQ container

¹ : With assembly tolerance of ± 2 mm [± 0.08"]
² : With assembly tolerance of ± 0.8 mm [± 0.03"]

Operating Conditions


Item	Specification
Mechanical Load	5400 Pa
Maximum System Voltage	1000V
Series Fuse Ratings	30 A
Operating Temperature	-40 to 85 °C

Temperature Characteristics


Item	Specification
Nominal Module Operating Temperature	45°C ± 2°C
Temperature Coefficient of Isc	0.048 % / °C
Temperature Coefficient of Voc	-0.27 % / °C
Temperature Coefficient of Pmax	-0.32 % / °C

*Nominal module operating temperature (NMOT): Air mass AM 1.5, irradiance 800W/m², temperature 20°C, wind speed 1 m/s.
*Reduction in efficiency from 1000W/m² to 200W/m² at 25°C: 3.5 ± 2%.


Engineering Drawing (mm)

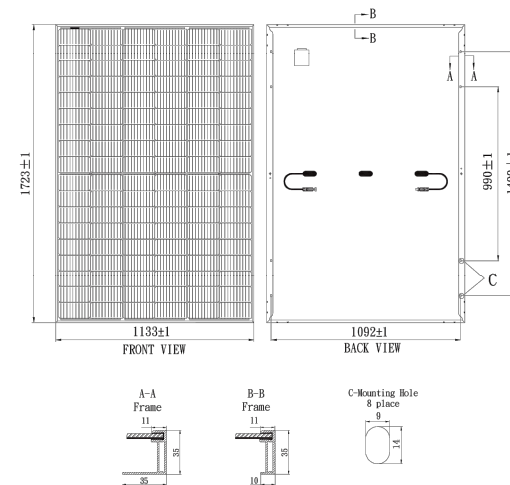

Dependence on Irradiance

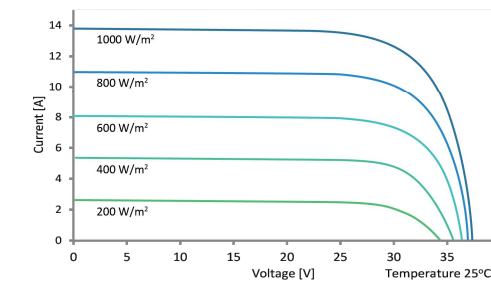

Reliability with Warranty

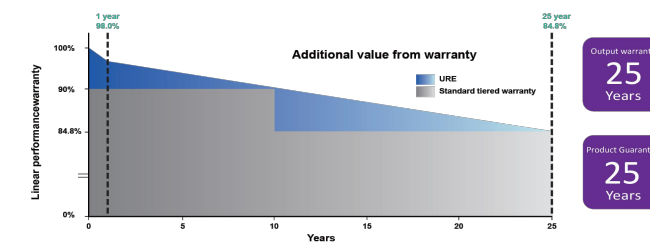

For more information, please visit us at www.ureusa.com
Copyright © 2022 URE Corp. All rights reserved



DESIGN ENGINEER



76 N. MEADOWBROOK DRIVE
ALPINE UT 84004
swyssling@wysslingconsulting.com
(201) 874-3483

MODULE



**76 N. MEADOWBROOK DRIVE
ALPINE UT 84004**
swyssling@wysslingconsulting.com
(201) 874-3483

PRODUCT DATASHEET



BDM-600X MICROINVERTER


BDM-300X2 CEC Listing as Utility Interactive Inverter

(NC0142-US-BQ-A, NC0142-L-US-BQ-A)



STANDARD DIMENSIONS


Inches

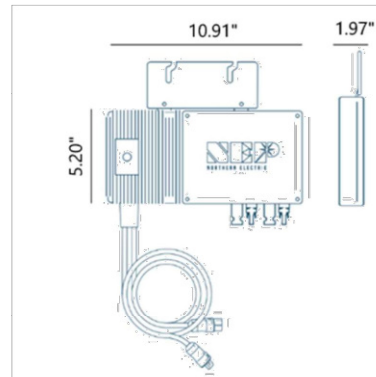

Weight: 6.4 lbs. (2.9 kg)

Certifications

UL 1741, CSA C22.2, NO. 107.1, IEC/EN 62109-1, IEC/EN 62109-2, IEEE 1547, VDE-AR-N 4105*, VDE V 0126-1-1/A1, G83/2, CEI 21, AS 4777.2, AS 4777.3, EN50438, ABNT NBR 16149/16150

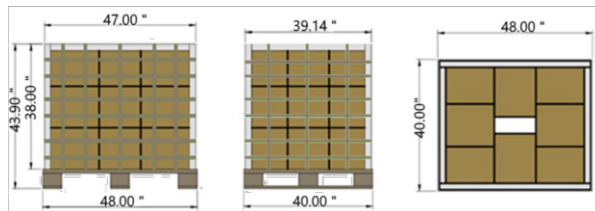

Per box: 6 pcs
Boxes per layer: 9
Layers: 3

Pallet Qty: 162 pcs
Pallet weight: 1072 lbs.

SPECIFICATIONS

Input (DC)	
Recommended Max PV Power:	450 W x 2
Max DC Open Circuit Voltage:	60 Vdc
Max DC Input Current:	14 A x 2
MPPT Tracking Accuracy:	> 99.5%
MPPT Tracking Range:	22 – 55 Vdc
ISC PV (Absolute Maximum):	18 A x 2
Maximum Backfeed Current to Array:	0 A

Output (AC)	
Peak AC Output Power:	600 W
Max Continuous Output Power:	580 W
Nominal Power Grid Voltage:	240 Vac 3φ: 208 Vac
Allowable Power Grid Voltage:	211-264 Vac 3φ: 183-228 Vac
Rated Output Current:	2.42 A 3φ: 2.79 A
Maximum Units Per Branch (20A):	6 units 3φ: 5 units
<i>(All NEC adjustment factors considered)</i>	
Allowable Power Grid Frequency:	59.3 - 60.5 Hz
THD:	< 3% (at rated power)
Power Factor (cos phi, fixed):	-0.99 > 0.9 (adjustable)
Current (inrush) (Peak and Duration):	24 A, 15 US
Nominal Frequency:	60 Hz
Max Output Fault Current:	2.4 Arms for 3 cycles
Max Output Overcurrent Protection:	10 A

System Efficiency	
Weighted Average Efficiency (CEC):	95.5%
Nighttime Tare Loss:	0.11 W

Protection Function	
Over/Under Voltage Protection:	Yes
Over/Under Frequency Protection:	Yes
Anti-Islanding Protection:	Yes
Over Current Protection:	Yes
Reverse DC Polarity Protection:	Yes
Overload Protection:	Yes
Protection Degree:	NEMA-6 / IP-66 / IP-67
Ambient Temperature:	-40°F to +149°F (-40°C to +65°C)
Operating Temperature:	-40°F to +185°F (-40°C to +85°C)
Display:	LED Light
Communications:	Powerline Communications
Environment Category:	Indoor and outdoor
Wet Location:	Suitable
Pollution Degree:	PD 3
Over Voltage Category:	III(PV), III (AC MAINS)

All NEC required adjustment factors have been considered for AC outputs. AC current outputs will not exceed stated values for Rated output AC Current.

COMPLIANCE

- NEC 2020 Section 690.11 DC Arc-Fault Circuit Protection
- NEC 2020 Section 690.12 Rapid Shutdown of PV Systems on Buildings
- NEC 2020 Section 705.12 Point of Connection (AC Arc-Fault Protection)



**76 N. MEADOWBROOK DRIVE
ALPINE UT 84004**
swyssling@wysslingconsulting.com
(201) 874-3483



BDG-256

Monitoring Gateway



Features

Convenient

- WiFi, Ethernet, or Cell
- Easy to configure web portal
- Touch screen for easy Configuration and Troubleshooting
- Supports dual voltage (100/240) and dual frequency (50/60 Hz)

Safe and reliable

- Supports local monitoring without internet

Globally Certified


- UL 60950-1 2nd edition, CSA C22.2 2nd edition, FCC Part 15 Class B AS/NZS 60950.1:2011 Inc A1, AS/NZS CISPR 22: 2009+A1:2010
- EN 60950-1:2006+A11:2009+A1:2010
- Revenue Grade Production Monitoring ANSI C12.20 +/- 0.5%



More efficiency | Maximum 3.5W

Certification global | UL 60950-1 2nd edition
CSA C22.2 2nd edition
FCC Part 15 Class B

More reliability | IP30

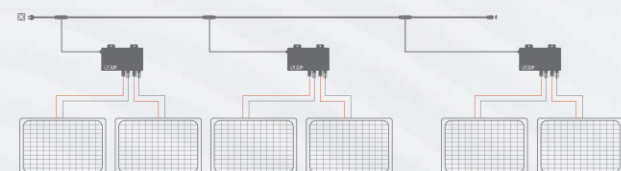

northernep.com

Ver No.: BDG-256-05232024

Model

BDG-256

Communications interface	BDM-256
Communication with Microinverter	PLC
Ethernet	10/100 auto-sensing, auto-negotiation
USB	USB 2.0 interface, auto-sensing, auto-negotiation
Wi-Fi	Support
Monitoring Capability	255 devices (depending on power grid interference)
Human interface	
Display	LCD touch screen
Power requirements	
AC input	100-240 Vac, 50/60Hz, 60mA
Power Consumption	3.5 Watts maximum
Revenue Grade Production Monitoring	
Accessory required	ANSI C12.20 +/-0.5% accuracy
Mechanical data	
Dimensions	6.69" x 4.33" x 1.46" (170mm x 110 mm x 37 mm)
Weight	5.29 oz (150g)
Ambient temperature range	40°C to +55°C (-40°F to 131°F) -40°C to +49°C (-40°F to 120°F) if installed in an enclosure
Cooling	Natural convection - no fans
Environmental Rating	IP30. For installation indoors or in an NRTL-certified NEMA type 3R enclosure
Characteristics	
Standard warranty term	5 year
Compliance	UL 60950-1 2nd Edition Rev Dec 19, 2011 CSA C22.2 2nd Edition Rev Dec 19, 2011 FCC Part 15 Class B AS/NZS 60950.1:2011 Inc A1 AS/NZS CISPR 22: 2009+A1:2010 EN 60950-1:2006+A11:2009+A1:2010 +A12:2011 EN 55022:201 EN 61000-3-2:2006+A1:2009+A2:2009 EN 61000-3-3:2008 EN 55024:2010 EMC Directive 2004/108/EC

northernep.com

**MONITORING
GATEWAY**



INSTAFLASH™

Never Deal With Caulking Again!

Factory-installed, non-hardening sealant



Before InstaFlash Installed: Sealant is contained above roof surface by a protective cage.

After InstaFlash Installed: Sealant is compressed to fill all holes and voids.

Protective Cage
Prevents sealant from getting on hands or roof. Collapses upon lag installation.

Effortless Lifetime Roof Protection

The non-hardening sealant completely fills any missed pilot holes, shingle rips, voids, or other potential water ingress points under the entire footprint of the 4.6" wide base.



25-Year Warranty

Manufactured with advanced materials and coatings to outlast the roof itself




Code Compliant

Fully IBC/CBC Code Compliant Exceeds ASCE 7-16 Standards FL Cert of Approval FL41396 UL2703 Certified



Self-Healing

The proprietary non-hardening sealant will flex and reseal over years of thermal expansion and contraction

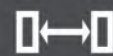

Larger Spans

The extra-large L-foot and proprietary lag screw result in larger spans between mounts

Pegasus Solar Inc | 506 West Ohio Avenue, Richmond, CA 94804 | www.pegasussolar.com



INSTAFLASH™

1
Drill pilot hole in the center of the rafter using a 7/32" bit.




2
Place the InstaFlash over the pilot hole. **Note:** the direction of the InstaFlash Down arrows should point down the roof.



3
Insert the lag screw through the center hole into the pilot hole.



4
Drive the lag until the InstaFlash is fully seated to the roof.

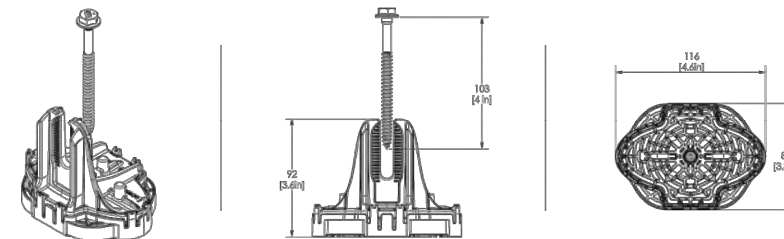

SPECIFICATIONS	INSTAFLASH KITS				
	PIF-RB0	PIF-RBDT	PIF-RBSH	PIF-RM0	PIF-RMDT
Finish	Black			Mill	
Kit Contents	Black InstaFlash, 5/16" x 4.0" SS Lag	Black InstaFlash, 5/16" x 4.0" SS Lag, Dovetail T-bolt w/ Nut	Black InstaFlash, 5/16" x 4.0" SS Lag, M10 Hex Bolt w/ Nut	Mill Insta-Flash, 5/16" x 4.0" SS Lag	Mill InstaFlash, 5/16" x 4.0" SS Lag, Dovetail T-bolt w/ Nut
Attachment Type	Rafter Attached				
Roof Type	Sloped Roof: Composition Shingle, Rolled Asphalt Flat roof: Modified Bitumen Roof, Built-Up Roof				
Sealant Application	Factory Installed				
Installation Temperature	0°F to 170° F				
Cure Time	Instantly Waterproof; Non-hardening				
Service Temperature	-40°F to 195° F				
Certifications	IBC, ASCE/SEI 7-16, FL Cert of Approval FL41396, TAS 100(A), UL2703				
Install Application	Most Railed Systems, Pegasus Tilt Leg Kit				
Kit Quantity	24				
Boxes per Pallet	36				

US Patents Pending. All rights reserved. ©2023 Pegasus Solar Inc.



SCAN FOR INSTALLATION VIDEO



SCAN FOR FREE TRIAL

Pegasus Solar Inc | 506 West Ohio Avenue, Richmond, CA 94804 | www.pegasussolar.com

DESIGN ENGINEER



76 N. MEADOWBROOK DRIVE
ALPINE UT 84004
swyssling@wysslingconsulting.com
(201) 874-3483


ATTACHMENT



SK·PRAIL

Skip Rows!

Eliminate entire rows of mounts, rails and clamps by adding just one SKU!

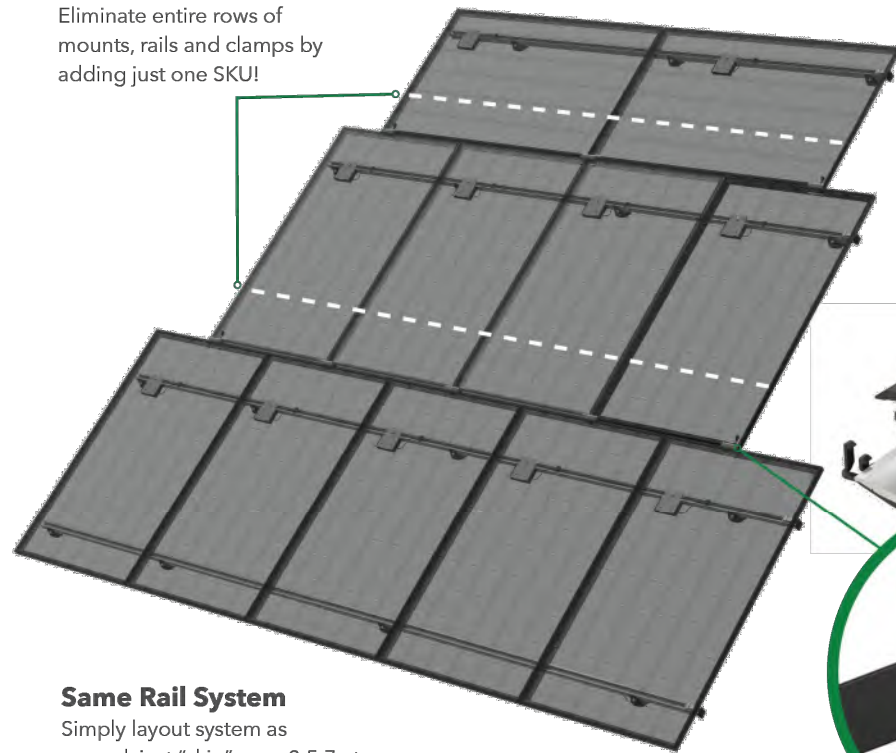

SkipRail Clamp

Structurally connects and bonds modules row-to-row
Eliminate leveling rails: aligns module rows to be in-plane



Same Rail System

Simply layout system as normal, just "skip" rows 3,5,7,etc. of attachments, rails, and clamps

A Revolution in Solar Installations

Lower your costs and provide your crews a faster system by eliminating entire rows of mounts, rails and clamps with just one SKU.



Dramatically Lower Costs

25% fewer rails and clamps
15% fewer roof penetrations
3500 lbs less per MW to ship, warehouse, pack, and load



Recruit the Best Crews

Less work = happier crews
300 lbs less per week to haul
Faster install
Auto-levels modules



Easy to Implement

Minimal to no training
Same layout as standard rail
Same open-channel wire management



Universal to Any Roof

Comp, Tile, Metal, other.
Low slope, steep slopes
Easily work around roof obstructions
Mixed portrait / landscape

Pegasus Solar Inc | 506 West Ohio Avenue, Richmond, CA 94804 | www.pegasussolar.com




SK·PRAIL

SkipRail SAVINGS

18% fewer attachments • 32% fewer feet of rails
22% fewer pounds to ship & warehouse

SkipRail SAVINGS

21% fewer attachments • 30% fewer feet of rails
21% fewer pounds to ship & warehouse

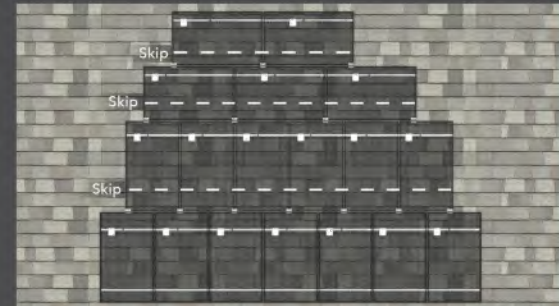


Example of Comp Roof Array




Example of Tile Roof Array

Free Design Tool:

pegasussolar.com/portal

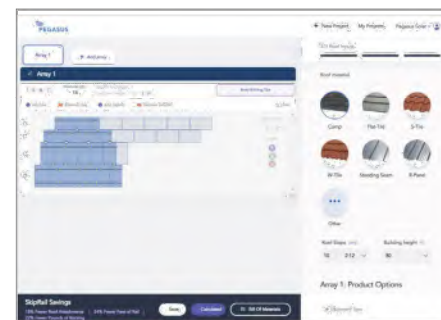

Where SkipRail Works

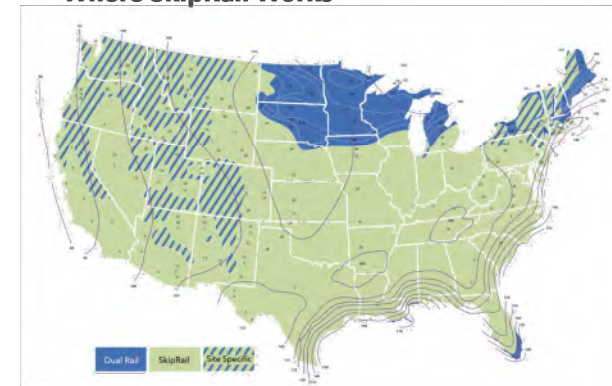

Specifications

	SkipRail Kits	
	PSR-SRC	PSR-SRCK
SKU	PSR-SRC	PSR-SRCK
Type	Floating Clamp	Extra support with Kickstand
Finish	Black	
PV module frames	30, 32, 35, 40mm	
Certifications	ASCE 7-16, IBC, CBC, UL2703	
Applicable Roof Types	Any	
Compatible Rail Systems	Pegasus Rail System	
Kit Contents	Pegasus SkipRail Clamp	Pegasus SkipRail Clamp with Kickstand
Kit Quantity	20	30



SCAN FOR VIDEO



SCAN FOR FREE TRIAL

Patents pending. All rights reserved. ©2023 Pegasus Solar Inc.

Pegasus Solar Inc | 506 West Ohio Avenue, Richmond, CA 94804 | www.pegasussolar.com

DESIGN ENGINEER



76 N. MEADOWBROOK DRIVE
ALPINE UT 84004

swyssl@wysslingconsulting.com
(201) 874-3483

ATTACHMENT




RAIL SYSTEM

One Clamp Anywhere

The Multi-Clamp works as mid- or end-clamp, and fits standard 30-40mm frames.


Instant Bonding

The N-S Bonding Jumper bonds row to row with no tools.

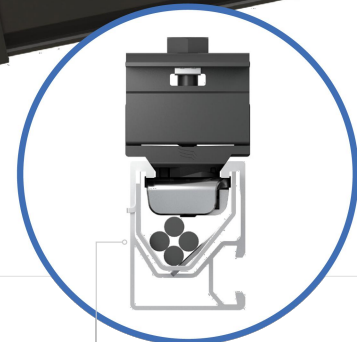

Lifetime Wire Management

Open rail channel holds and protects wires. Clamps won't pinch wires after tightening.

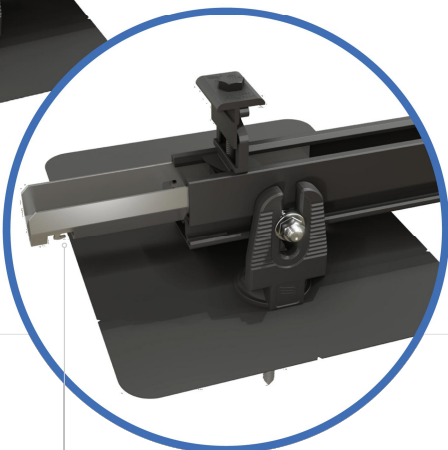

Bonding Structural Splice

Connect rails instantly, without tools, interference or limitations.

Next-Level Solar Mounting

A complete system for hassle-free rooftop installation, from watertight mounts to lifetime wire management.



Simplicity

1/2" socket for everything. One clamp for mid or end. No tool splicing and bonding. Easy wire management.



Code Compliant

UL 2703 listed LTR-AE-001-2012 listed Class A fire rating for any slope ASCE 7-16 PE Certified



Premium Aesthetics

The narrowest panel gap available. Optional Hidden End Clamps and End Caps provide a flush look on the edge of the array.



Watertight for Life

Secured on industry-leading Pegasus Mounts, for composite shingle and tile roofs. Backed by a 25-year warranty.

Pegasus Solar Inc | 506 West Ohio Avenue, Richmond, CA 94804 | T: 510.210.3797 | www.pegassolar.com



RAIL SYSTEM




Pegasus Rail

Available in 14' and 7' lengths for easy layout and shipping. Open-channel design holds MC4 connectors, PV wire and trunk cables. Black and Mill finish.



Pegasus Max Rail

Maximum-strength design. Meets specifications for high snow-load and hurricane zones. Black and Mill finish.

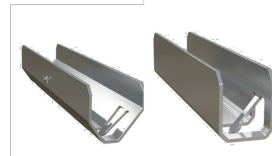

Splice and Max Splice

Installs by hand. Works over mounts. Structurally connects and bonds rails automatically; UL2703 listed as reusable.



Dovetail T-bolt

Dovetail shape for extra strength. Uses 1/2" socket.



Multi-Clamp

Fits 30-40mm PV frames, as mid- or end-clamp. Twist-locks into position; doesn't pinch wires in rail. Bonds modules to rail; UL2703 listed as reusable.



Hidden End Clamp

Offers premium edge appearance. Preinstalled pull-tab grips rail edge, allowing easy, one-hand installation. Tucks away for reuse.



Ground Lug

Holds 6 or 8 AWG wire. Mounts on top or side of rail. Assembled on MLPE Mount. UL2703 listed as reusable.




N-S Bonding Jumper

Installs by hand, eliminates row-to-row copper wire. UL2703 listed as reusable only with Pegasus Rail.



MLPE Mount

Secures and bonds most micro-inverters and optimizers to rail. Connectors and wires easily route underneath after installation. UL2703 listed as reusable.

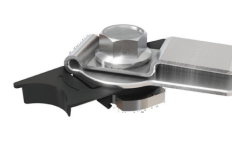

Cable Grip

Secures four PV wires or two trunk cables. Stainless-steel backing provides durable grip. Eliminates sagging wires.



Wire Clip

Hand operable. Holds wires in channel. Won't slip.



End Cap and Max End Cap

Fits flush to PV module and hides raw or angled cuts. Hidden drain quickly clears water from rail.

- Certifications:**
- UL 2703, Edition 1
 - LTR-AE-001-2012
 - ASCE 7-16 PE certified
 - Class A fire rating for any slope roof



Quickly calculate the most efficient layout, spans and materials needed to suit your job. Visit the Pegasus Customer Portal. pegassolar.com/portal

Patents pending. All rights reserved. ©2021 Pegasus Solar Inc.

LOAD	WIND (MPH)	SPAN			
		32"	4'	6'	8'
0	120	[Pegasus Rail]	[Pegasus Rail]	[Pegasus Rail]	[Pegasus Max Rail]
	160				
15	140	[Pegasus Rail]	[Pegasus Rail]	[Pegasus Rail]	[Pegasus Max Rail]
	160				
30	160	[Pegasus Rail]	[Pegasus Rail]	[Pegasus Rail]	[Pegasus Max Rail]
	190				
45	190	[Pegasus Rail]	[Pegasus Rail]	[Pegasus Rail]	[Pegasus Max Rail]
	190				
70	190	[Pegasus Rail]	[Pegasus Rail]	[Pegasus Rail]	[Pegasus Max Rail]
	190				
110	190	[Pegasus Rail]	[Pegasus Rail]	[Pegasus Rail]	[Pegasus Max Rail]
	190				

For reference only. Spans above are calculated using ASCE 7-16 for a Gable Roof, Exposure Category B, 7-20deg roof angle, 30ft mean roof height with non-exposed modules. For PE certified span tables, visit www.pegassolar.com/spans.

Pegasus Solar Inc | 506 West Ohio Avenue, Richmond, CA 94804 | T: 510.210.3797 | www.pegassolar.com

DESIGN ENGINEER



76 N. MEADOWBROOK DRIVE
ALPINE UT 84004

swyssling@wysslingconsulting.com
(201) 874-3483

RAIL