



Structural Letter of Approval

July 31, 2024
Beam Solar Co
1231 Shields Road Ste. 5
Kernersville, NC 27284

Michael Doesken Residence: 810 Buchanan Rd, Lillington, NC 27546

Dear Sir/ Madam,

Terra Engineering Consulting (TEC) has performed a structural evaluation for the roof of the structure referenced above based on its existing and proposed load conditions. The attached calculations are based on the assumption that the existing structural components are in good condition and that they meet industry standards. The existing structure information is assumed based on the site visit documentation provided by the client (Beam Solar Co). The design information and assumptions that the calculations are based on are located in the attached References page. The design of the solar panel's mounting hardware and electrical engineering are provided by others.

Design Method

This engineering analysis was performed in accordance with ASCE 7-10 and 2018 North Carolina Residential Code (NCRC) design methods. In general, this design method is a comparison of the roof loads before and after the solar panel installation. The snow load in the area of the panels will be reduced due to the roof pitch and the solar panel's slippery surface, as justified in Section 7.4 in ASCE 7-10. Due to the reduction in snow load, the total roof loads and the stresses of the structural elements decrease after the solar panels are installed.

Results

The total additional roof load of the solar panels system is 3 psf, and the typical 20 psf live load will not be present in the area of the panels, as defined per R324.4.1 in 2018 NCRC. The slippery surface snow load reduction allowed in Section 7.4 in ASCE 7-10 reduces the roof snow load in the area of the solar panels. The total combined vertical loads are reduced when considering the worst-case load combination (ASD). Regarding lateral wind loads, the solar panel structure is considered to be partially enclosed due to the low profile of the panels (3 to 6 inches) and airflow restrictions below the panels caused by the pv frame, wiring, conduit, and frame brackets. Because the system is considered to be 'partially enclosed' additional wind pressure on the structure is considered negligible. The addition of total PV system weight results in an increase of under 10% of the total roof weight, and meets the seismic requirements in Section 403.4 of 2018 NCEBC. See the attached calculations for further details.


Conclusions

TEC concludes that the installation of solar panels on existing roof will not affect the structure and allows it to remain unaltered under the applicable design standards. The calculations performed to support these conclusions are attached to this letter.

General Instructions

1. The contractor shall comply with all Federal, State, County, City, local and OSHA mandated regulations and requirements. The most stringent shall govern.
2. Contractor shall keep an accurate set of As-Built plans.
3. The solar panel's racking system and mounting hardware shall be mounted in accordance with the manufacturer's most recent installation manual.
4. Connection: Sunmodo Nanomount Deck Mount (or equivalent deck mount) - (4) #14 x 1-1/2" Self drilling fasteners. Maximum anchor spacing of 48" (must embed fully into wood deck). Maximum overhang: 12".
5. Panel support connections shall be staggered to distribute load to adjacent trusses.
6. If during solar panel installation, the roof framing members appear unstable or deflect non-uniformly, our office should be notified before proceeding with the installation.
7. Structural observation or construction inspections will not be performed by TEC, Engineer-of-Record (EOR) nor their representatives.
8. TEC Solar assumes no responsibility for improper installation of the solar panels.

Best Regards,
TEC Solar, PLLC

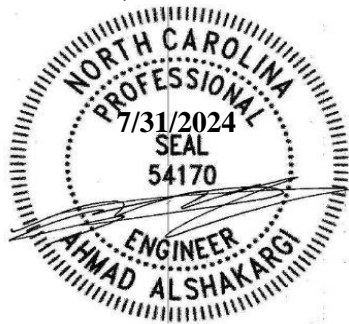

Ahmad Alshakargi, PE
Civil (Structural) Engineer
Firm License P-3037

References

Design Parameter

Code: 2018 North Carolina Residential Code, ASCE 7-10

Risk Category: II

Ground Snow load: 15 psf

Roof Snow load: 10.4 psf

Design Wind Speed: 120 mph (3 sec gust) per ASCE 7-10

Existing roof dead load: 9.6 psf

Live Load: 20 psf (reducible where panels are located per R324.4.1 in 2018 NCRC).

Seismic Design Category: D

Wind Exposure Category: C

Existing Roof Structure

Roof framing: 2x2 Pre-fab Trusses at 24" O.C.

Roof material: Composite shingles

Roof slope: 30°

Solar Panels

Weight: 3 psf



Date: 7/31/2024
 Client: Michael Doesken
 Subject: Gravity load

Gravity load calculations

<u>Snow load (S)</u>	Existing	w/ solar panels	
Roof slope (°):	30	30	
Ground snow load, pg (psf):	15	15	ASCE 7-10, Section 7.2
Terrain category:	C	C	ASCE 7-10, table 7-2
Exposure of roof:	Fully exposed	Fully exposed	ASCE 7-10, table 7-2
Exposure factor, Ce:	0.9	0.9	ASCE 7-10, table 7-2
Thermal factor, Ct:	1.1	1.1	ASCE 7-10, table 7-3
Risk Category:	II	II	ASCE 7-10, table 1.5-1

Where p_g is 20 lb/ft² (0.96 kN/m²) or less:

$$p_m = I_s p_g \quad (\text{Importance Factor times } p_g)$$

Where p_g exceeds 20 lb/ft² (0.96 kN/m²):

$$p_f = 0.7 C_e C_t I_s p_g \quad (7.3-1)$$

$$p_m = 20 (I_s) \quad (20 \text{ lb/ft}^2 \text{ times Importance Factor})$$

Importance Factor, Is:	1	1	ASCE 7-10, table 1.5-2
Flat roof snow load, pf (psf):	10.4	10.4	ASCE 7-10, equation 7.3-1
Minimum roof snow load, pm (psf):	0	0	ASCE 7-10, equation 7.3-4

Roof Surface type:	Other	Unobstructed slippery surface	ASCE 7-10, Section 7.4
Roof slope factor, Cs:	1	0.67	ASCE 7-10, figure 7-2b

$$p_s = C_s p_f \quad (7.4-1)$$

Sloped roof snow load, ps [psf]:	10.4	7.0	ASCE 7-10, equation 7.4-1 Design Snow Load (S)
----------------------------------	------	-----	--

Roof dead load (D)

Roof pitch/12	6.9		
Composite shingles	2 psf	1/2" Gypsum clg.	0 psf
1/2" plywood	1.5 psf	insulation	0.8 psf
Framing	3 psf	M, E & Misc	1 psf

Roof DL without PV arrays	9.6 psf
PV Array DL	3 psf

<u>Roof live load (Lr)</u>	Existing	w/ solar panels	
Roof Live Load	20	0	R324.4.1 in 2018 NCRC

ASD Load combination:

	Existing	With PV array	
D [psf]	9.6	12.6	ASCE 7-10, Section 2.4.1
D+L [psf]	9.6	12.6	ASCE 7-10, Section 2.4.1
D+[Lr or S or R] [psf]	29.6	19.6	ASCE 7-10, Section 2.4.1
D+0.75L+0.75[Lr or S or R] [psf]	24.6	17.8	ASCE 7-10, Section 2.4.1
<u>Maximum gravity load [psf]:</u>	29.6	19.6	
Ratio proposed load to existing load:		66.10%	

The stresses due to gravity load in the area of the solar panels is reduced, allowing the structure to remain unaltered.



Date: 7/31/2024
 Client: Michael Doesken
 Subject: Wind load and Connection

Wind Pressure Calculations

$$p = q_p((GC_p) - (GC_{pi})) \quad (30.9-1)$$


Basic wind speed (mph)	120			
Risk category	II			
Exposure category	C			
Roof type	Gable			
Figure for GCp values	ASCE 7-16 Figure 30.3-2A-I			
	Zone 1	Zone 2	Zone 3	
GCp (neg)	-1	-1.2		-1.2
GCp (pos)	0.9	0.9		0.9
zg (ft)	900 (ASCE 7-16 Table 26.11-1)			
α	9.5 (ASCE 7-16 Table 26.11-1)			
Kzt	1 (ASCE 7-16 Equation 26.8-1)			(only changes if structure located on a hill or ridge)
Kh	0.94 (ASCE 7-6 Table 26.10-1)			
Kd	0.85 (ASCE 7-16 Table 26.6-1)			
Velocity Pressure, qh (psf)	28.48 (ASCE 7-16 Equation 26.10-1)			
Gcpi	0 (ASCE 7-16 Table 26.13-1)			(0 for enclosed buildings)

	Zone 1	Zone 2	Zone 3
W Pressure, (neg) [psf]	-28.48	-34.18	-34.18
W Pressure, (pos) [psf]	25.63	25.63	25.63
W Pressure, (Abs. max) [psf]	28.48	34.18	34.18

Connection calculations (Self-drilling screws - for direct to deck mount)

Capacity

Screw description:	5/16 "x 1 1/12" structural wood screw	
Deck sheathing thickness:	5/32"	(Assumed for worse case calculations - installer to verify roof material compatibility with mounting hardware)
Number of fasteners:	4	
Ultimate pullout load: [lbs]	850	
Factor of safety:	2.5	
Total allowable capacity [lbs]:	340.00	

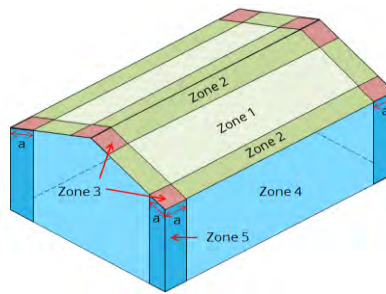

Demand

Anchor spacing: 48 in
 Anchor spacing in roof corners: 32 in

	(0.6 W			
	Pressure, Max.			
	psf), see tributary			
Zone	Note 1	area (ft^2)	Max Uplift force (lbs)	
	1	17.1	11	188.0
	2	20.5	11	225.6
	3	20.5	7.3333333	150.4

Connection Meets Demand

Note: these calculations are based on generic assumption of the deck material and thickness, using the most common fastener used by manufacturers. Conditions may vary per site and mounting hardware, and may require reduction in attachment spacing. Installer shall verify with manufacturer before installation.

HOUSE PHOTO



VICINITY MAP



SHEET INDEX

PV-100.00	TITLE SHEET
PV-200.00	SITE PLAN
PV-300.00	GENERAL NOTES
PV-400.00	ROOF PLAN
PV-500.00	ELEVATIONS
PV-600.00	DETAIL DRAWINGS
PV-700.00	SINGLE LINE DIAGRAM
PV-800.00	SPECS AND CALCS
PV-900.00	WARNING LABELS
MSD	DATA SHEETS
BOM	BILL OF MATERIALS



BEAM SOLAR CO.
1231 SHIELDS ROAD
STE. 5
KERNERSVILLE, NC 27284

SCOPE OF WORK:

TO INSTALL OF A 52 MODULE ROOF MOUNTED SOLAR PHOTOVOLTAIC SYSTEM AT THE OWNER RESIDENCE LOCATED AT 810 BUCHANAN RD THE POWER GENERATED BY THE PV SYSTEM WILL BE INTERCONNECTED WITH THE UTILITY GRID THROUGH THE EXISTING ELECTRICAL SERVICE EQUIPMENT. THE PV SYSTEM DOES NOT INCLUDE STORAGE BATTERIES.

MICHAEL DOESKEN
RESIDENCE
810 BUCHANAN RD
LILLINGTON, NC 27546
(1919)721-8311

MICHAEL.DOESKEN@GMAIL.COM
TMK: #

DRAWN BY: CHARLENE A.

DATE: 2024-09-18

REVISION:

NO.	DESCRIPTION	DATE

TITLE SHEET

PV-100.00


GENERAL PROJECT INFO:


UTILITY COMPANY	SOUTH RIVER ELECTRIC
CITY	LILLINGTON
AHJ	COUNTY OF HARNETT
DC SYSTEM	20,800 KWDC
AC SYSTEM	15,080 KWAC
MODULE	Q.PEAK DUO BLK ML-G10+ 400W MODULES
INVERTER	ENPHASE IQ8PLUS-72-2-US (240V)
MICROINVERTER	

GOVERNING CODES:

2018 NORTH CAROLINA BUILDING CODE
2018 NORTH CAROLINA RESIDENTIAL CODE
2018 NORTH CAROLINA EXISTING BUILDING CODE
2015 INTERNATIONAL FIRE CODE
2020 NATIONAL ELECTRIC CODE

TEC Solar, PLLC
8470 W Magna Main St Unit 311, Magna, UT 84044
North Carolina Firm License P-3037
The mounting hardware is provided by manufacturer and is out of scope of this review. Structural observation or construction inspection will not be performed by TEC, Engineer-of-Record (EOR) nor their representatives.

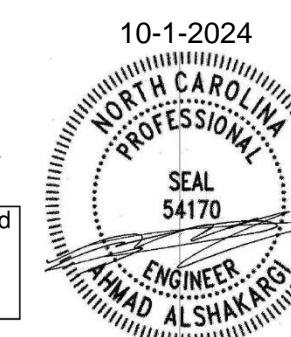

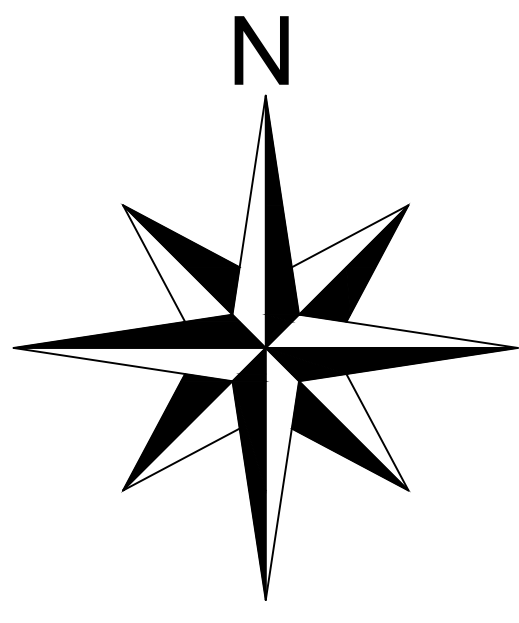

(N) VISIBLE LOCKABLE
LABELED AC DISCONNECT

(N) ENPHASE IQ COMBINER 5/5C
(X-AM1-IQ-240-5/5C)

(E) MAIN SERVICE PANEL

(E) UTILITY METER

313'-6"

79'-9"

98'-1"

110'-2"

371'-2"

322'-4"

210'-5"

278'-5"



(52) Q.PEAK DUO BLK ML-G10+ 400W
MODULES
(52) ENPHASE IQ8PLUS-72-2-US
(240V) MICROINVERTERS



BEAM SOLAR CO.
1231 SHIELDS ROAD
STE. 5
KERNERSVILLE, NC 27284

SCOPE OF WORK:

TO INSTALL OF A 52 MODULE ROOF MOUNTED
SOLAR PHOTOVOLTAIC SYSTEM AT THE OWNER
RESIDENCE LOCATED AT 810 BUCHANAN RD
THE POWER GENERATED BY THE PV SYSTEM
WILL BE INTERCONNECTED WITH THE UTILITY
GRID THROUGH THE EXISTING ELECTRICAL
SERVICE EQUIPMENT. THE PV SYSTEM DOES
NOT INCLUDE STORAGE BATTERIES.

MICHAEL DOESKEN
RESIDENCE
810 BUCHANAN RD
LILLINGTON, NC 27546
(1919)721-8311
MICHAEL.DOESKEN@GMAIL.COM
TMK: #

DRAWN BY: CHARLENE A.

DATE: 2024-09-18

REVISION:

NO.	DESCRIPTION	DATE

LEGEND



SITE NOTES

- UM** UTILITY METER
- MSP** MAIN SERVICE PANEL
- PM** PRODUCTION METER
- AC** AC DISCONNECT
- CB** COMBINER PANEL

- A LADDER SHALL BE IN PLACE FOR INSPECTION IN COMPLIANCE WITH OSHA REGULATIONS.
- THE PV MODULES ARE CONSIDERED NON-COMBUSTIBLE AND THIS SYSTEM IS AN UTILITY INTERACTIVE SYSTEM WITH NO STORAGE BATTERIES.
- THE SOLAR PV INSTALLATION SHALL NOT OBSTRUCT ANY PLUMBING, MECHANICAL, OR BUILDING ROOF VENTS.
- PROPER ACCESS AND WORKING CLEARANCE AROUND EXISTING AND PROPOSED ELECTRICAL EQUIPMENT WILL BE PROVIDED AS PER SECTION [NEC 110.26]

TEC Solar, PLLC
8470 W Magna Main St Unit 311, Magna, UT 84044
North Carolina Firm License P-3037

The mounting hardware is provided by manufacturer and is out of scope of this review. Structural observation or construction inspection will not be performed by TEC, Engineer-of-Record (EOR) nor their representatives.

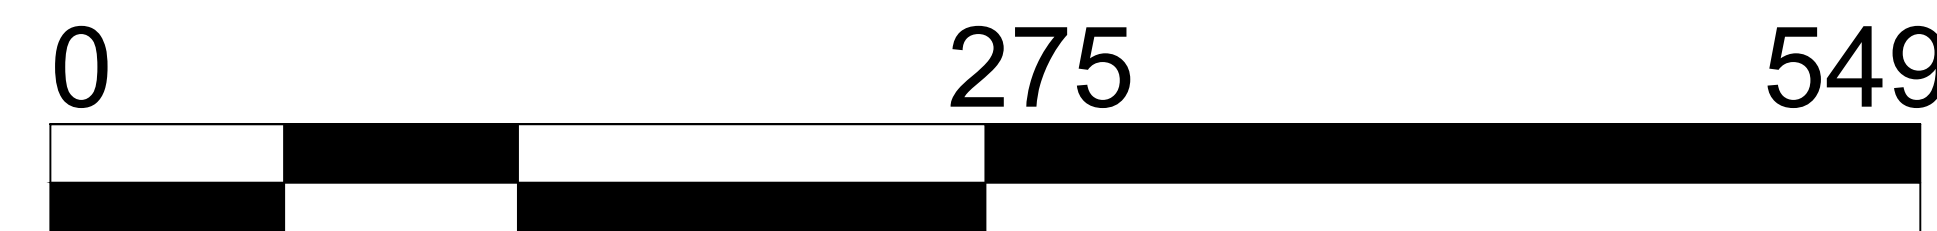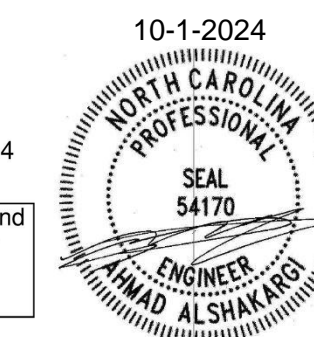


SCALE: 1" = 23'

SITE PLAN

PV-200.00

TEC Solar, PLLC
 8470 W Magna Main St Unit 311, Magna, UT 84044
 North Carolina Firm License P-3037

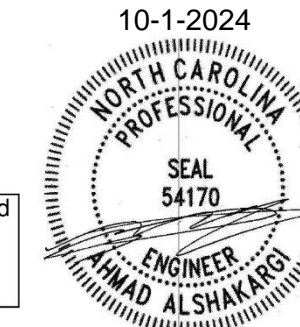

The mounting hardware is provided by manufacturer and is out of scope of this review. Structural observation or construction inspection will not be performed by TEC, Engineer-of-Record (EOR) nor their representatives.

GENERAL NOTES:

- THESE CONSTRUCTION DOCUMENTS HAVE BEEN BASED ON FIELD INSPECTIONS AND OTHER INFORMATION AVAILABLE AT THE TIME. ACTUAL FIELD CONDITIONS MAY REQUIRE MODIFICATIONS IN CONSTRUCTION DETAILS.
- ARCHITECT HAS NOT BEEN RETAINED TO SUPERVISE ANY CONSTRUCTION OR INSTALLATION OF ANY EQUIPMENT AT SITE.
- CONTRACTOR SHALL FURNISH ALL LABOR, MATERIAL, EQUIPMENT, TOOLS, OBTAINS ALL PERMITS, LICENSES AND PAY ALL REQUIRED FEES AND COMPLETE INSTALLATION.
- CONTRACTOR HAS THE FULL RESPONSIBILITY TO CHECK AND VERIFY ALL DIMENSIONS AND EXISTING CONDITIONS. ANY DISCREPANCIES SHALL BE REPORTED TO THE ENGINEER BEFORE PROCEEDING WITH THE WORK. ANY WORK STARTED BEFORE CONSULTATION AND ACCEPTANCE BY THE ENGINEER SHALL BE THE SOLE RESPONSIBILITY OF THE CONTRACTOR AND SHALL BE SUBJECT TO CORRECTION BY THEM WITHOUT ADDITIONAL COMPENSATION.
- DAMAGE CAUSED TO THE EXISTING STRUCTURE, PIPES, DUCTS, WINDOWS, WALL, FLOORS, ETC. SHALL BE REPAIRED TO THE ORIGINAL CONDITION OR REPLACED BY THE CONTRACTOR AT NO ADDITIONAL COST.
- THE CONTRACTOR SHALL BE HELD RESPONSIBLE FOR THE PROPER INSTALLATION AND COMPLETION OF THE WORK WITH APPROVED MATERIALS. NO CHANGES ARE TO BE MADE WITHOUT THE CONSULTATION AND APPROVAL OF THE ARCHITECT. CONTRACTOR SHALL OBTAIN BUILDING PERMIT. NO WORK TO START UNLESS BUILDING PERMIT IS PROPERLY DISPLAYED.
- ALL WORKMANSHIP AND MATERIALS SHALL BE OF FIRST QUALITY AND IN COMPLIANCE WITH THE REQUIREMENTS OF THE TX BUILDING CODE, THE DEPARTMENT OF ENVIRONMENTAL PROTECTION AND ALL PERTINENT AGENCIES.
- IT IS ESSENTIAL THAT ALL WORK PROCEED WITH THE MAXIMUM COOPERATION OF ALL PARTIES AND WITH MINIMUM INTERFERENCE TO THE OCCUPANTS WITHIN THE BUILDING. THE OWNER'S DIRECTIONS IN THIS REGARD SHALL BE FULLY COMPLIED WITH.
- ALL EXPOSED PLUMBING, HVAC, ELECTRICAL DUCTWORK, PIPING AND CONDUITS ARE TO BE PAINTED BY GENERAL CONTRACTOR. THE CONTRACTOR SHALL PERFORM THE WORK IN STRICT CONFORMANCE WITH THE LOCAL LAWS, REGULATIONS AND THE NATIONAL ELECTRIC CODE.
- THE CONTRACTOR SHALL OBTAIN ALL PERMITS, APPROVALS, AFFIDAVITS, CERTIFICATIONS, ETC. AND PAY ALL FEES AS REQUIRED BY THE LOCAL AUTHORITIES. CONTRACTORS SHALL OBTAIN FIRE CERTIF. UPON COMPLETION OF WORK.

ELECTRICAL NOTES:

- THE EQUIPMENT AND ALL ASSOCIATED WIRING AND INTERCONNECTION SHALL BE INSTALLED ONLY BY QUALIFIED PEOPLE. A QUALIFIED PERSON IS ONE WHO HAS SKILLS AND KNOWLEDGE RELATED TO THE CONSTRUCTION AND OPERATION OF THE ELECTRICAL EQUIPMENT AND INSTALLATIONS AND HAS RECEIVED SAFETY TRAINING TO RECOGNIZE AND AVOID THE HAZARDS INVOLVED. (NEC 690.4(E) AND 705.6)
- LOCAL UTILITY PROVIDER SHALL BE NOTIFIED PRIOR TO USE AND ACTIVATION OF ANY SOLAR PHOTOVOLTAIC INSTALLATION. FOR A LINE SIDE TAP CONNECTION, UTILITY NEEDS TO BE NOTIFIED WELL IN ADVANCE TO COORDINATE BUILDING ELECTRICAL SHUT OFF.
- NEW CONDUIT ROUTING SHOWN IS ESSENTIALLY SCHEMATIC. SUBCONTRACTOR SHALL LAY OUT RUNS TO SUIT FIELD CONDITIONS AND THE COORDINATION REQUIREMENTS OF OTHER TRADES.
- ARRAY WIRING SHOULD NOT BE READILY ACCESSIBLE EXCEPT TO QUALIFIED PERSONNEL.
- ALL EXTERIOR CONDUIT, FITTINGS, AND BOXES SHALL BE WATERTIGHT AND APPROVED FOR USE IN WET LOCATIONS. (NEC 314.15A).
- WIRING METHODS FOR PV SYSTEM CONDUCTORS AREN'T PERMITTED WITHIN 10 IN. OF THE ROOF DECKING OR SHEATHING EXCEPT WHERE LOCATED DIRECTLY BELOW THE ROOF SURFACE THAT'S COVERED BY PV MODULES AND ASSOCIATED EQUIPMENT WIRING
- BACK-FED BREAKER MUST BE AT THE OPPOSITE END OF BUS BAR FROM THE MAIN BREAKER OR MAIN LUG SUPPLYING CURRENT FROM THE UTILITIES.
- ALL CONDUCTORS AND WIRE TIES EXPOSED TO SUNLIGHT ARE LISTED AS UV RESISTANT.
- CONTRACTOR SHALL FOLLOW ALL ELECTRICAL EQUIPMENT LABELING REQUIREMENTS IN NEC 690 AND IFC 2021 PV SOURCE, OUTPUT AND INVERTER CIRCUITS SHALL BE IDENTIFIED AT ALL POINTS OF TERMINATION, CONNECTION, AND SPLICES. THE MEANS OF ID CAN BE SEPARATE COLOR CODING, MARKING TAPE, TAGGING ETC. (NEC 690.4).
- MEASURE THE LINE-TO-LINE AND LINE-TO-NEUTRAL VOLTAGE OF ALL SERVICE ENTRANCE CONDUCTORS PRIOR TO INSTALLING ANY SOLAR EQUIPMENT. THE VOLTAGES FOR THE 240VAC RATED.

WIRING AND CONDUIT NOTES:

- ALL CONDUIT SIZES AND TYPES, SHALL BE LISTED FOR ITS PURPOSE AND APPROVED FOR THE SITE APPLICATIONS
- ALL PV CABLES AND HOMERUN WIRES BE #10AWG *USE-2, PV WIRE, OR PROPRIETARY SOLAR CABLING SPECIFIED BY MFR, OR EQUIVALENT; ROUTED TO SOURCE CIRCUIT COMBINER BOXES AS REQUIRED
- ALL CONDUCTORS AND OCPD SIZES AND TYPES SPECIFIED ACCORDING TO [NEC 690.8 (A)(1) & (B)(1)], [NEC 240] [NEC 690.7] FOR MULTIPLE CONDUCTORS
- ALL PV DC CONDUCTORS IN CONDUIT EXPOSED TO SUNLIGHT SHALL BE DERATED ACCORDING TO [NEC TABLE 310.15 (B)(2)(C)] BLACK ONLY**
- EXPOSED ROOF PV DC CONDUCTORS SHALL BE USE-2, 90°C RATED, WET AND UV RESISTANT, AND UL LISTED RATED FOR 600V, UV RATED SPIRAL WRAP SHALL BE USED TO PROTECT WIRE FROM SHARP EDGES
- PHASE AND NEUTRAL CONDUCTORS SHALL BE DUAL RATED THHN/THWN-2 INSULATED, 90°C RATED, WET AND UV RESISTANT, RATED FOR 600V PER NEC 2008 OR 1000V PER NEC 2011
- 4-WIRE DELTA CONNECTED SYSTEMS HAVE THE PHASE WITH THE HIGHER VOLTAGE TO GROUND MARKED ORANGE OR IDENTIFIED BY OTHER EFFECTIVE MEANS
- ALL SOURCE CIRCUITS SHALL HAVE INDIVIDUAL SOURCE CIRCUIT PROTECTION VOLTAGE DROP LIMITED TO 2%
- AC CONDUCTORS >4AWG COLOR CODED OR MARKED: PHASE A OR L1- BLACK, PHASE B OR L2- RED, PHASE C OR L3- BLUE, NEUTRAL- WHITE/GRAY



BEAM SOLAR CO.
 1231 SHIELDS ROAD
 STE. 5
 KERNERSVILLE, NC 27284

SCOPE OF WORK:

TO INSTALL OF A 52 MODULE ROOF MOUNTED SOLAR PHOTOVOLTAIC SYSTEM AT THE OWNER RESIDENCE LOCATED AT 810 BUCHANAN RD THE POWER GENERATED BY THE PV SYSTEM WILL BE INTERCONNECTED WITH THE UTILITY GRID THROUGH THE EXISTING ELECTRICAL SERVICE EQUIPMENT. THE PV SYSTEM DOES NOT INCLUDE STORAGE BATTERIES.

MICHAEL DOESKEN
 RESIDENCE
 810 BUCHANAN RD
 LILLINGTON, NC 27546
 (1919)721-8311
 MICHAEL.DOESKEN@GMAIL.COM
 TMK: #

DRAWN BY: CHARLENE A.


DATE: 2024-09-18

REVISION:

NO.	DESCRIPTION	DATE

GENERAL NOTES

PV-300.00

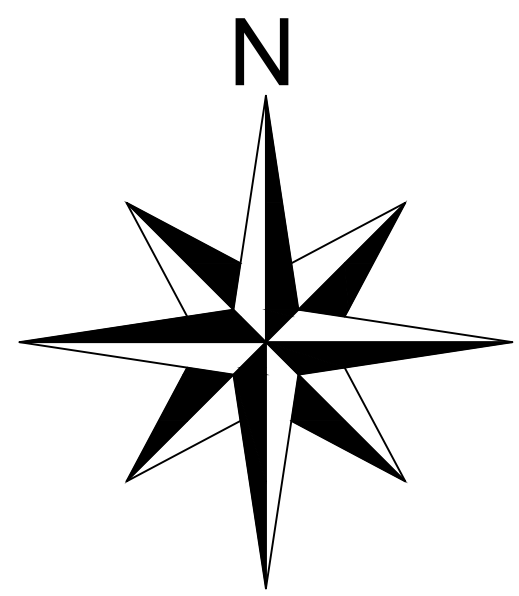


(E) MAIN SERVICE PANEL
(E) UTILITY METER

(N) VISIBLE LOCKABLE
LABELED AC DISCONNECT
(N) ENPHASE IQ COMBINER 5/5C
(X-AM1-IQ-240-5/5C)

ROOF SECTION 3
COUNT 26
TILT 30
AZIMUTH 348

MSP
UMACCB

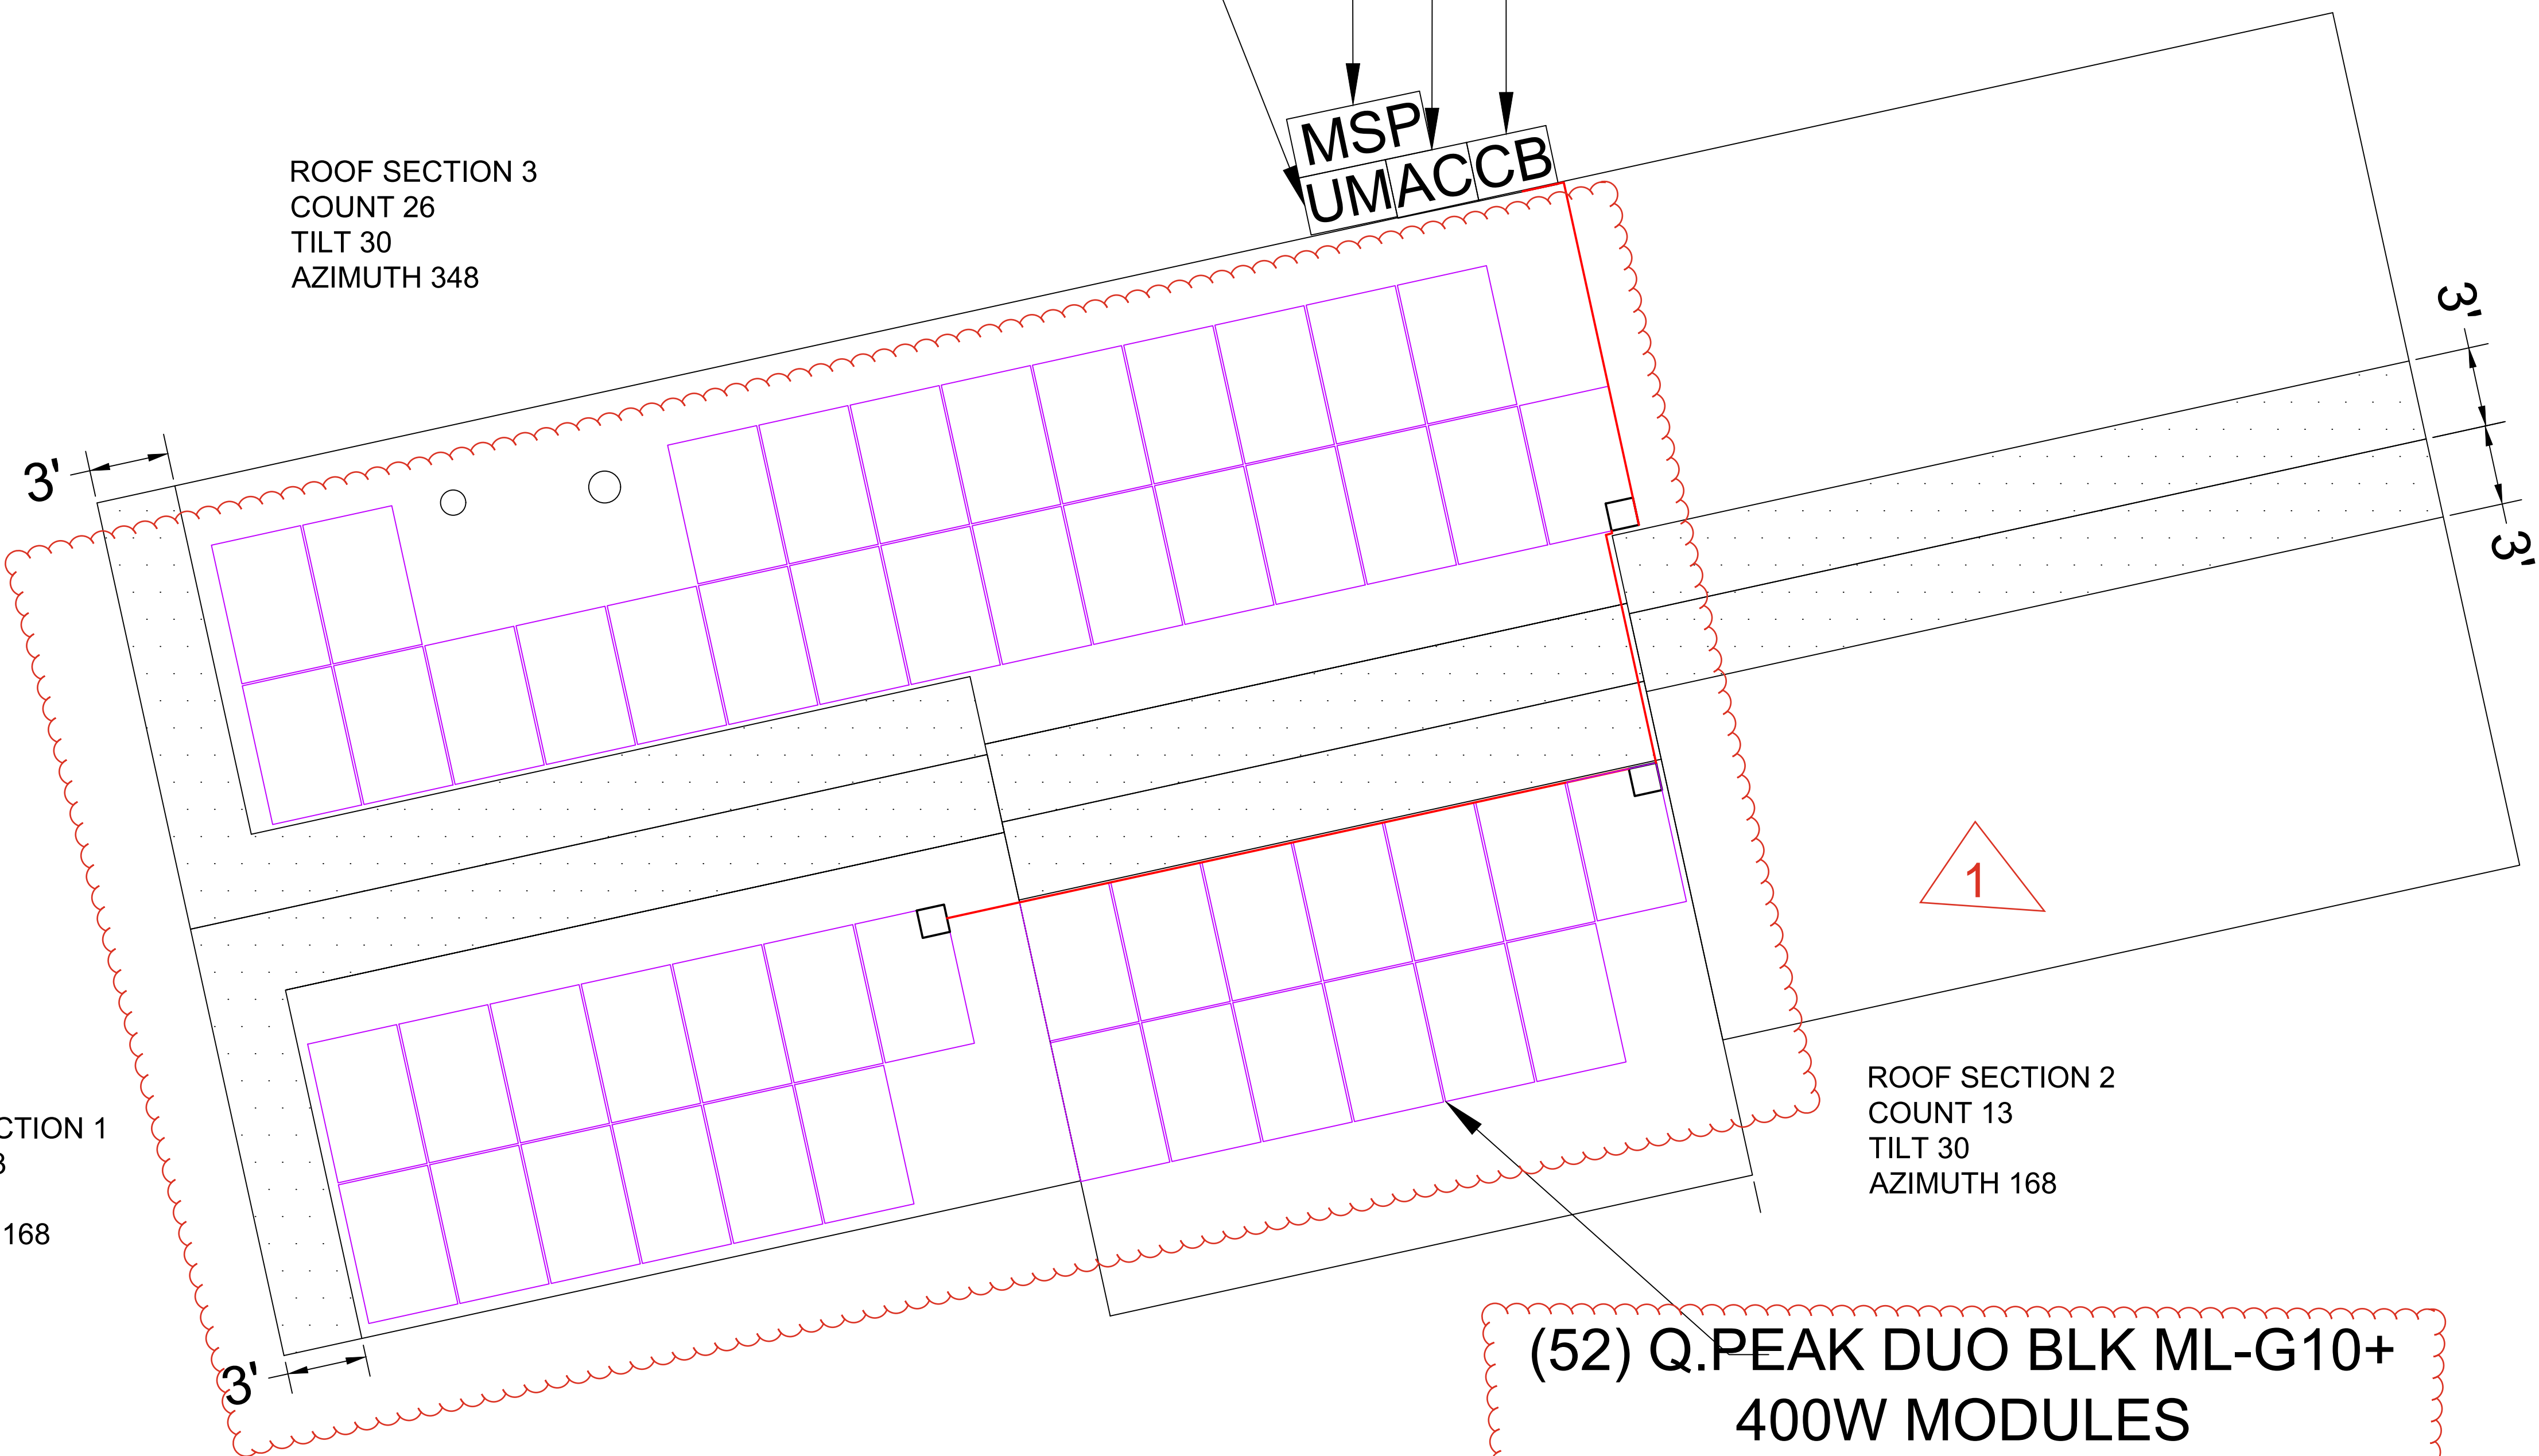




ROOF SECTION 1
COUNT 13
TILT 30
AZIMUTH 168

ROOF SECTION 2
COUNT 13
TILT 30
AZIMUTH 168

(52) Q.PEAK DUO BLK ML-G10+
400W MODULES
(52) ENPHASE IQ8PLUS-72-2-US
(240V) MICROINVERTERS

DESIGN SPECIFICATION		MODULE TYPE, DIMENSIONS, & WEIGHT	
RISK CATEGORY:	II	NUMBER OF MODULES:	52 MODULES
CONSTRUCTION:	SFD	MODULE TYPE:	Q.PEAK DUO BLK ML-G10+ 400W MODULES
ZONING:	RES	MODULE WEIGHT:	48.5 LBS
SNOW LOAD (ASCE 7-16):	10 PSF	MODULE DIMENSIONS:	73.98" (L) x 41.14" (W) = 21.14 SF
EXPOSURE CATEGORY:	B	UNIT WEIGHT OF AREA:	2.29 PSF
WIND SPEED (ASCE 7-16):	118 MPH		

TEC Solar, PLLC
8470 W Magna Main St Unit 311, Magna, UT 84044
North Carolina Firm License P-3037
The mounting hardware is provided by manufacturer and is out of scope of this review. Structural observation or construction inspection will not be performed by TEC, Engineer-of-Record (EOR) nor their representatives.

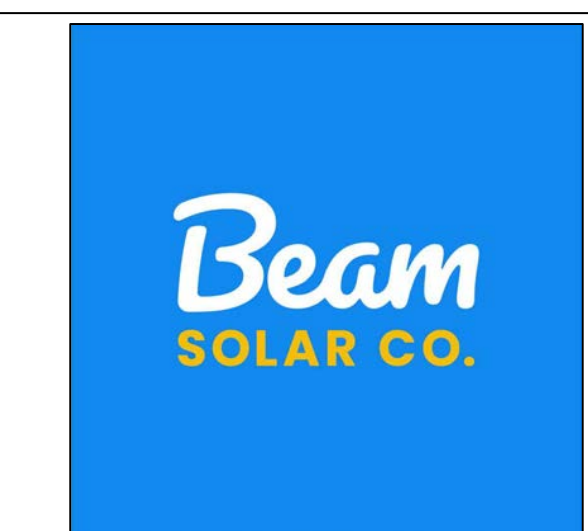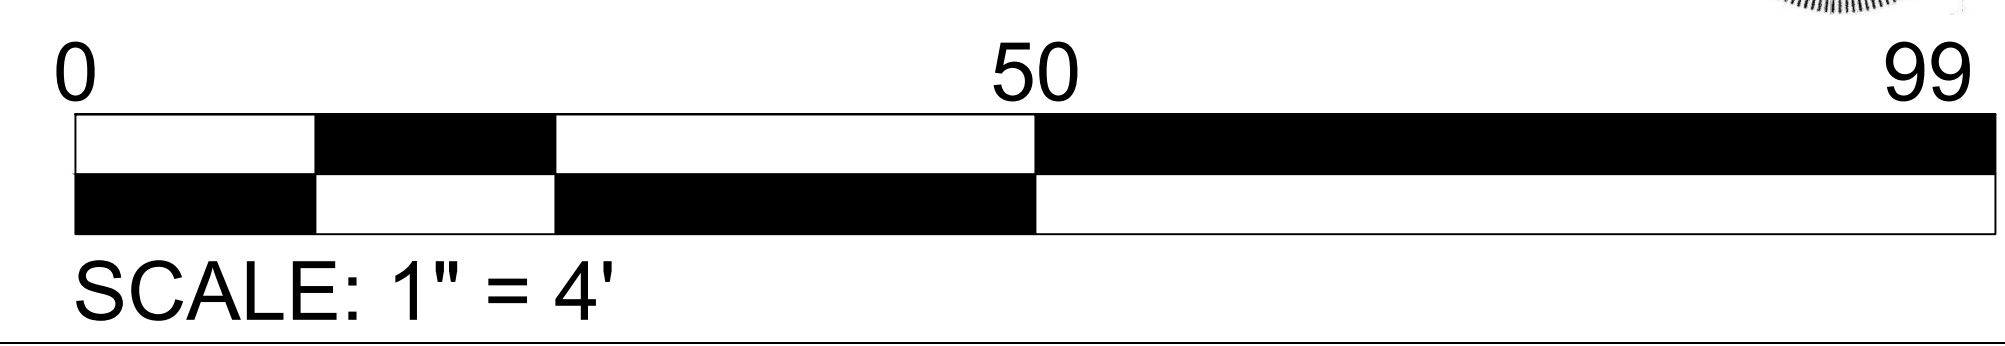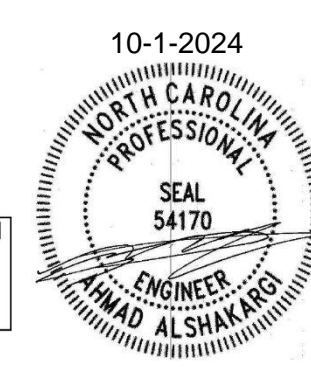

BEAM SOLAR CO.
1231 SHIELDS ROAD
STE. 5
KERNERSVILLE, NC 27284

SCOPE OF WORK:

TO INSTALL OF A 52 MODULE ROOF MOUNTED SOLAR PHOTOVOLTAIC SYSTEM AT THE OWNER RESIDENCE LOCATED AT 810 BUCHANAN RD THE POWER GENERATED BY THE PV SYSTEM WILL BE INTERCONNECTED WITH THE UTILITY GRID THROUGH THE EXISTING ELECTRICAL SERVICE EQUIPMENT. THE PV SYSTEM DOES NOT INCLUDE STORAGE BATTERIES.

MICHAEL DOESKEN
RESIDENCE
810 BUCHANAN RD
LILLINGTON, NC 27546
(1919)721-8311
MICHAEL.DOESKEN@GMAIL.COM
TMK: #

DRAWN BY: CHARLENE A.

DATE: 2024-09-18


REVISION:

NO.	DESCRIPTION	DATE

FLOOR
PLAN

PV-400.00

TEC Solar, PLLC
 8470 W Magna Main St Unit 311, Magna, UT 84044
 North Carolina Firm License P-3037
 The mounting hardware is provided by manufacturer and is out of scope of this review. Structural observation or construction inspection will not be performed by TEC, Engineer-of-Record (EOR) nor their representatives.

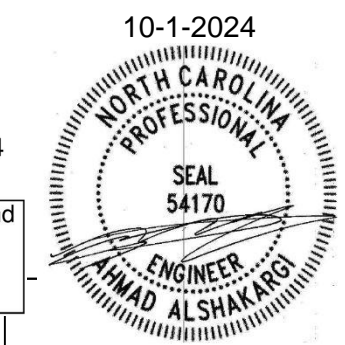

BEAM SOLAR CO.
 1231 SHIELDS ROAD
 STE. 5
 KERNERSVILLE, NC 27284

SCOPE OF WORK:
 TO INSTALL OF A 52 MODULE ROOF MOUNTED SOLAR PHOTOVOLTAIC SYSTEM AT THE OWNER RESIDENCE LOCATED AT 810 BUCHANAN RD THE POWER GENERATED BY THE PV SYSTEM WILL BE INTERCONNECTED WITH THE UTILITY GRID THROUGH THE EXISTING ELECTRICAL SERVICE EQUIPMENT. THE PV SYSTEM DOES NOT INCLUDE STORAGE BATTERIES.


MICHAEL DOESKEN
 RESIDENCE
 810 BUCHANAN RD
 LILLINGTON, NC 27546
 (1919)721-8311
 MICHAEL.DOESKEN@GMAIL.COM
 TMK: #

DRAWN BY: CHARLENE A.
 DATE: 2024-09-18


NO.	DESCRIPTION	DATE

DETAIL DRAWINGS


PV-600.00

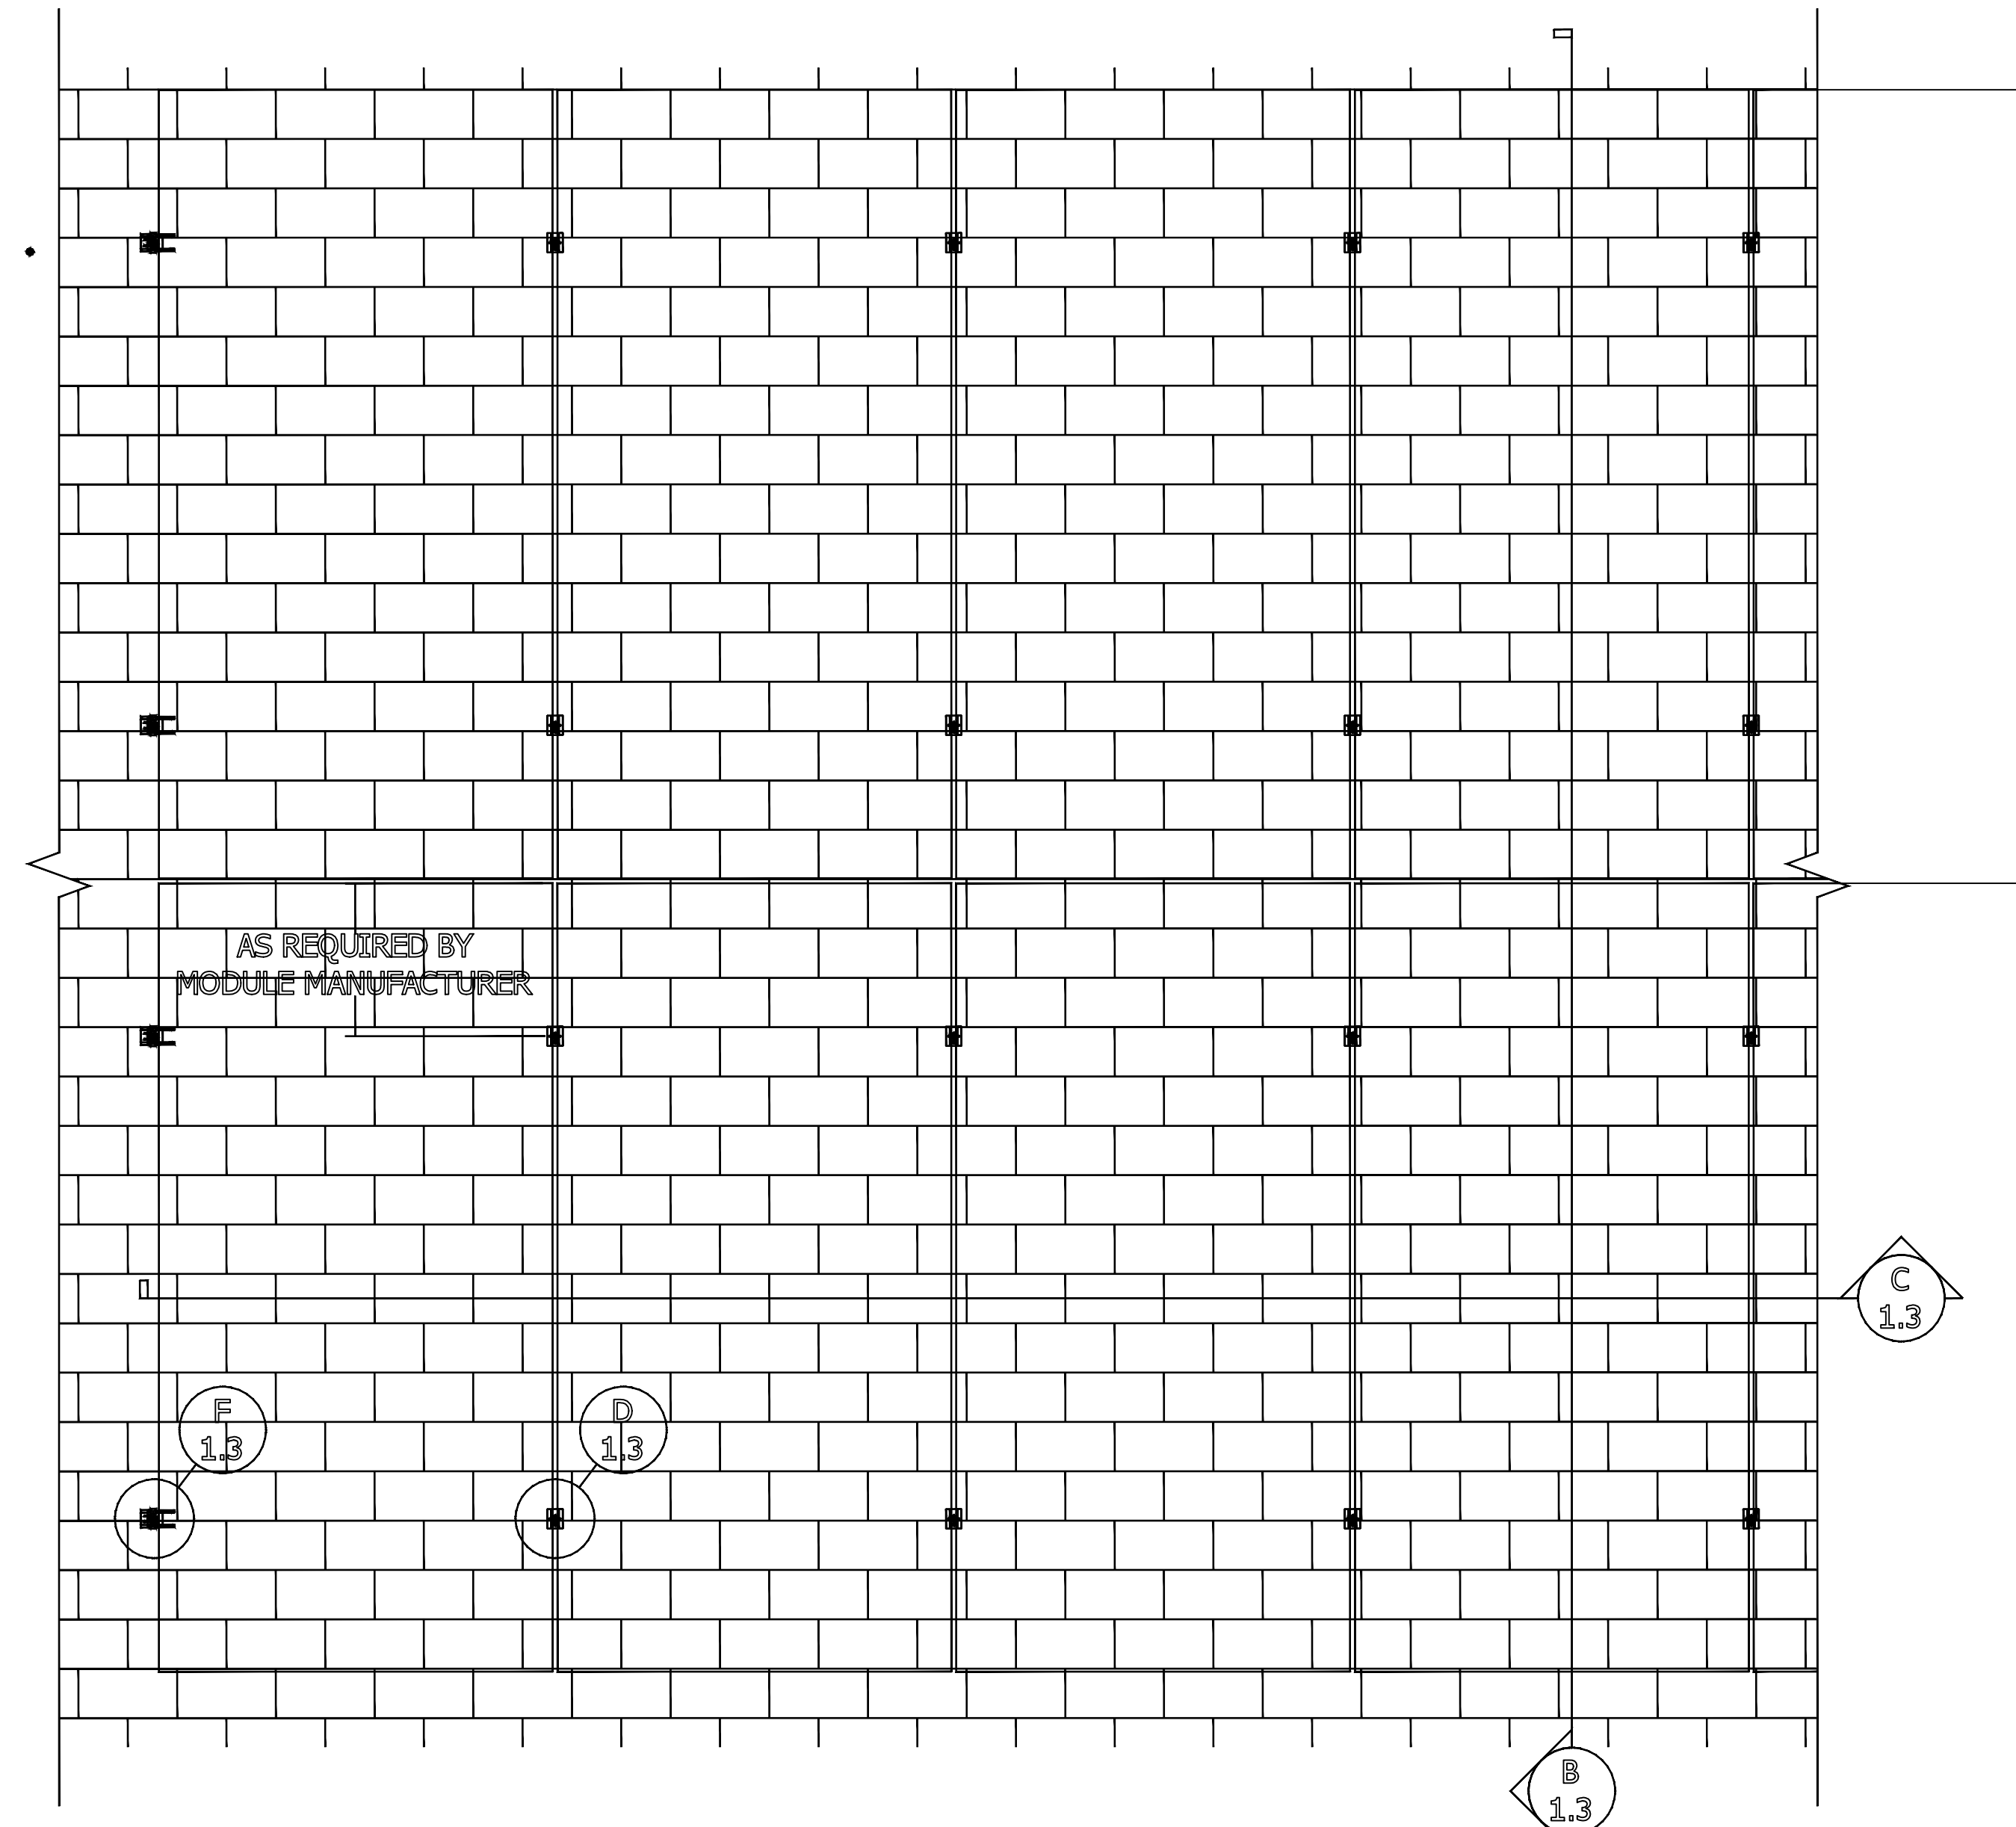


A PLAN VIEW, COMP ASSEMBLY, PORTRAIT MODULE
 Scale: 1"=1'-0"

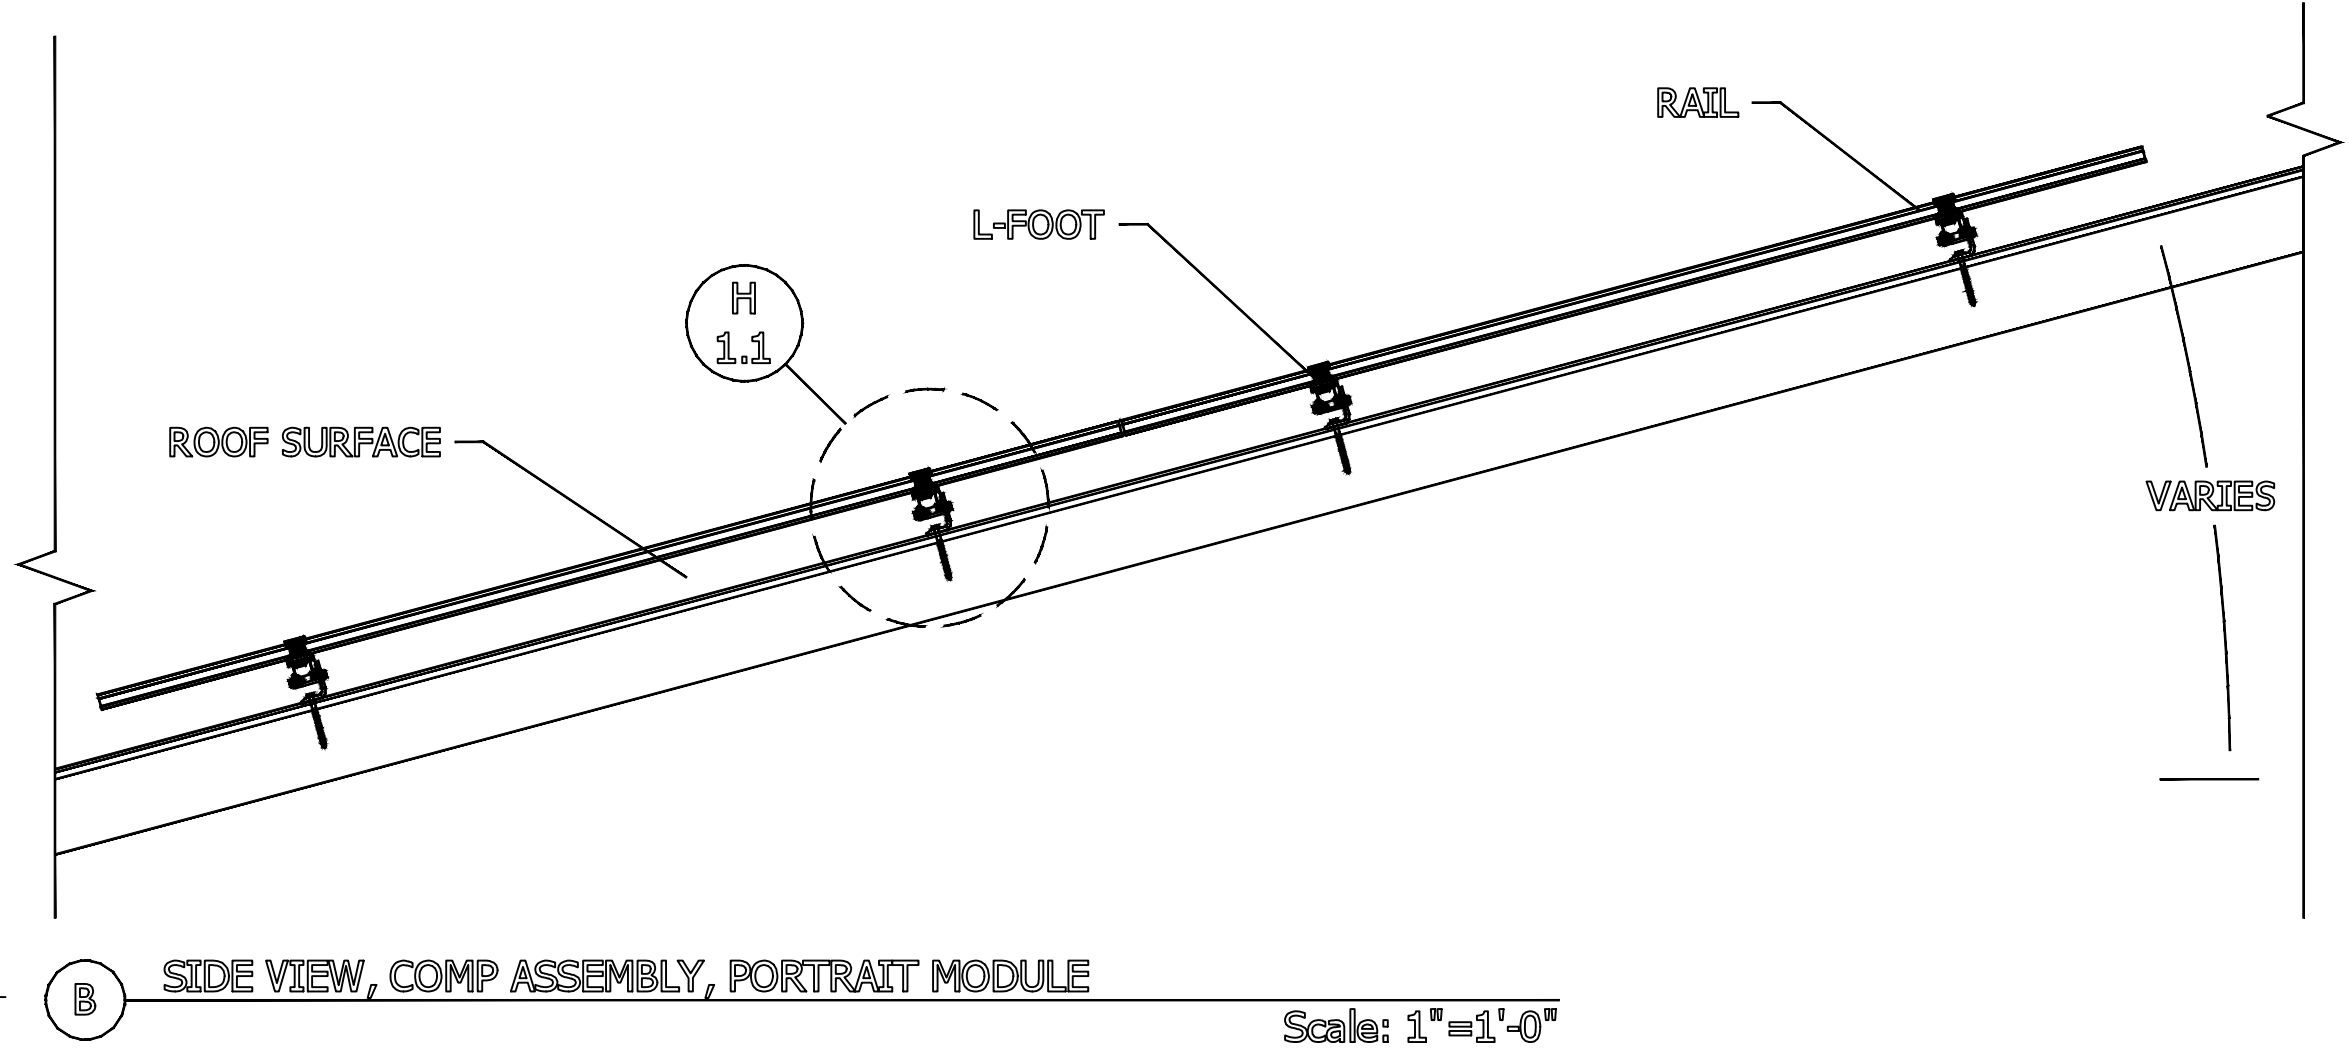


B SIDE VIEW, COMP ASSEMBLY, PORTRAIT MODULE
 Scale: 1"=1'-0"

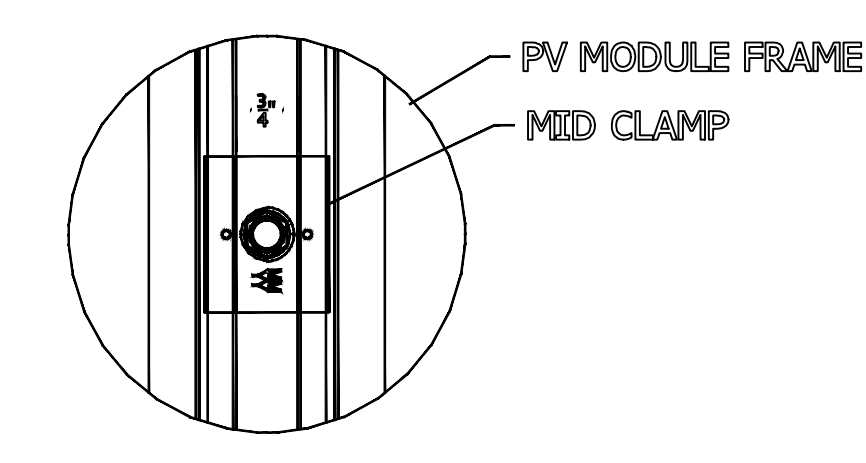


D DETAIL, MID CLAMP PLAN
 Scale: 6"=1'-0"

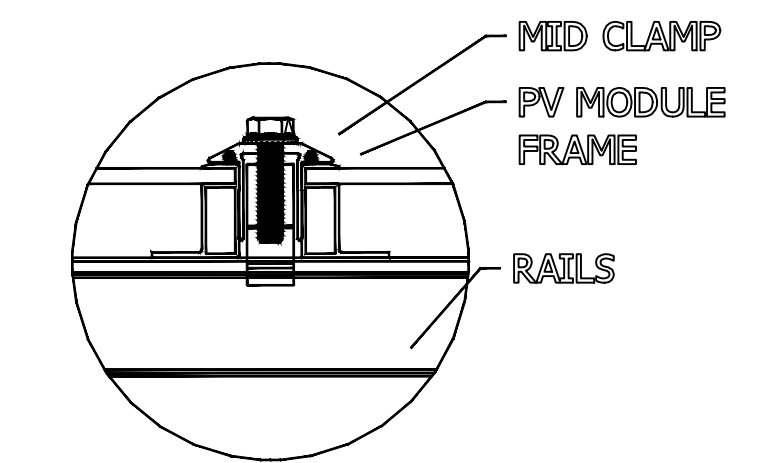


E DETAIL, MID CLAMP FRONT
 Scale: 6"=1'-0"

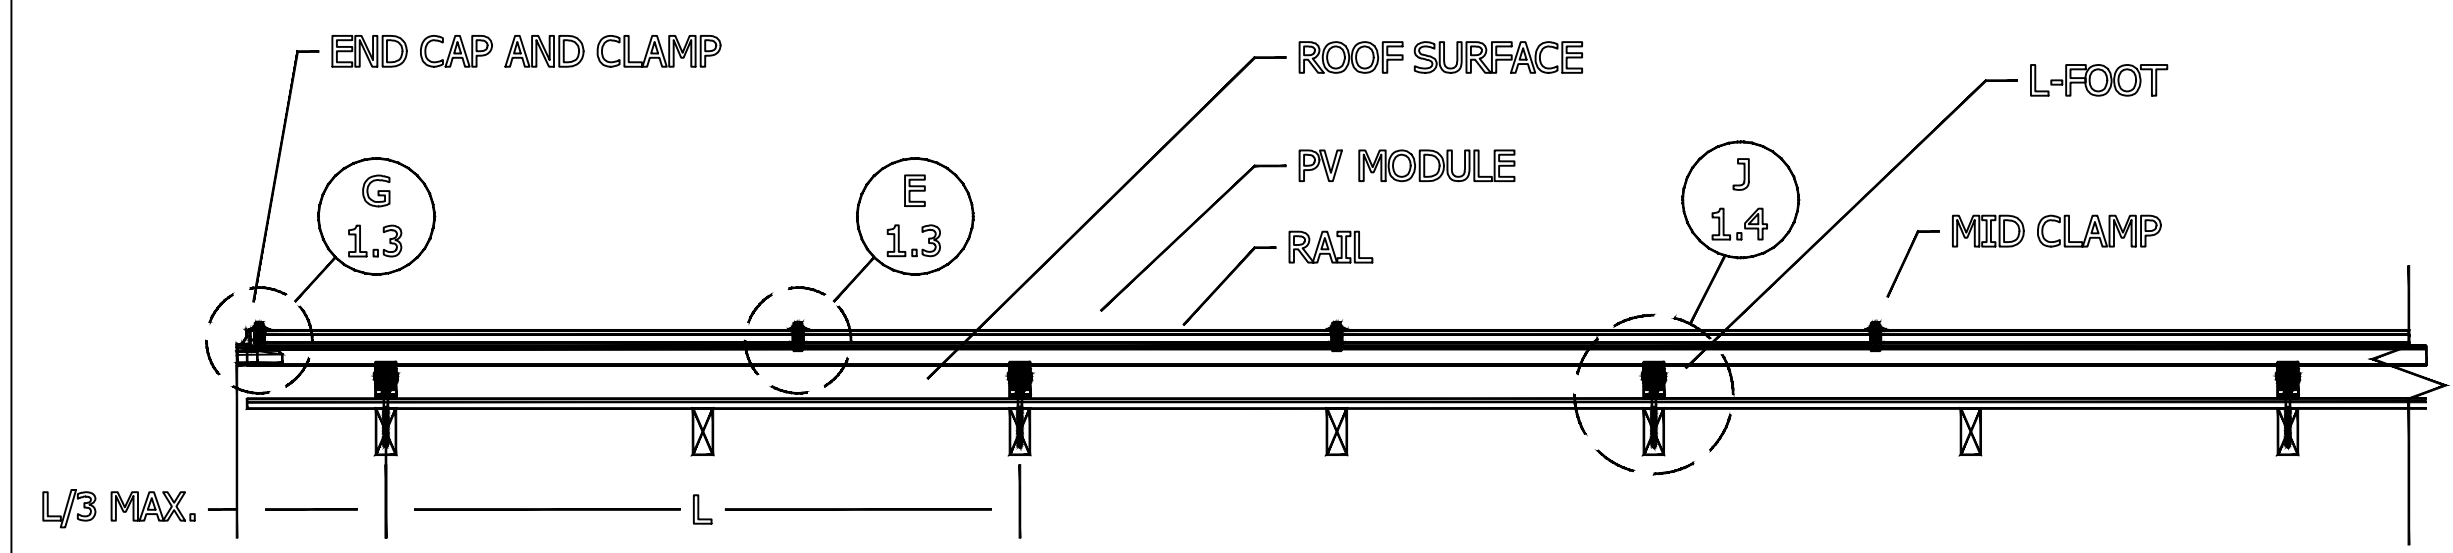

C FRONT VIEW, COMP ASSEMBLY, PORTRAIT MODULE
 Scale: 1"=1'-0"

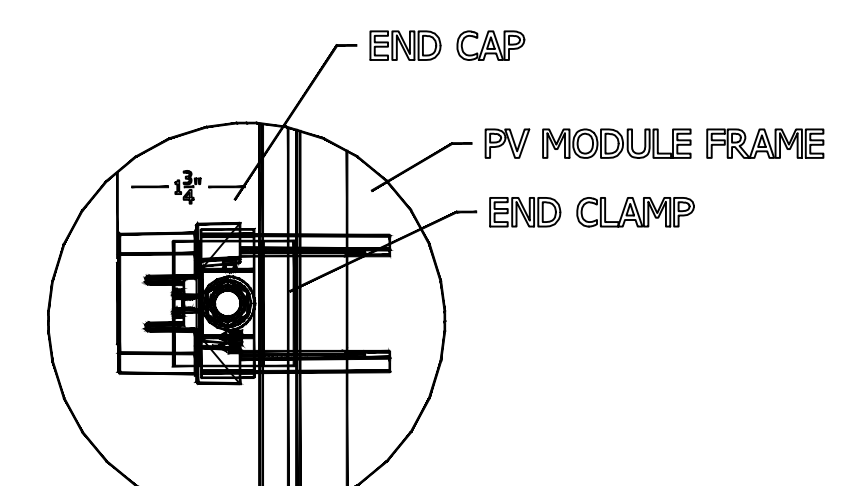

F DETAIL, END CAP AND CLAMP PLAN
 Scale: 6"=1'-0"

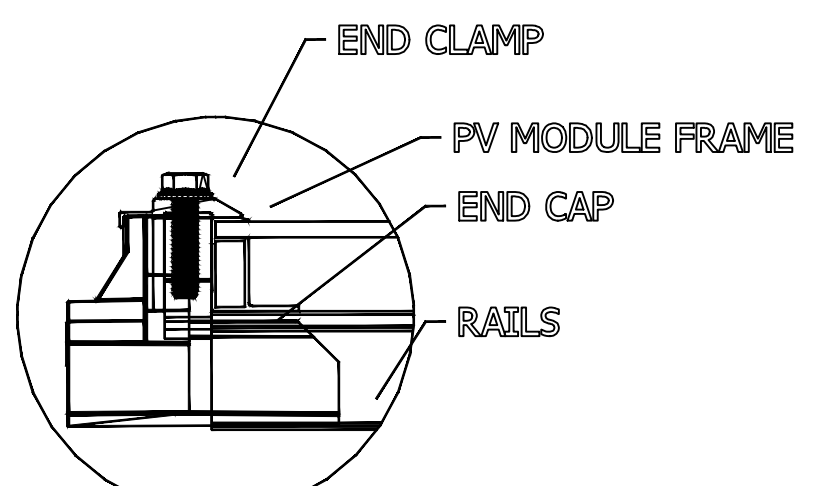

G DETAIL, END CAP AND CLAMP FRONT
 Scale: 6"=1'-0"

ECOFASTEN		
CLIENT NAME	ECOFASTEN	
PROJECT NAME	SLOPED ROOF MOUNT SYSTEM	
PROJECT ADDRESS	4141 WYVAN BUREN ST., SUITE 2, PHOENIX, AZ 85009	
SYSTEM KW/DC		
WIND SPEED, MPH		
SNOW LOAD, PSF		
EXPOSURE CAT		
RISK CAT		
MODULE TYPE		
MODULE W/DC		
MODULE QTY		
APPROVAL STATUS		
REVISION HISTORY		
REV	DESCRIPTION	DATE
SHEET NAME		
SLOPED ROOF PV SYSTEM DETAILS: L-FOOT COMP ASSEMBLY - PORTRAIT		
JOB NO.	1.1 SR	
ISSUE DATE	SEP 2021	
SHEET NO.	ECO 1.3	
SHEET SIZE	24X36	


CONDUCTOR SHCHEDULE

ID	TYPICAL	INITIAL CONDUCTOR LOCATION	FINAL CONDUCTOR LOCATION	CONDUCTOR			CONDUIT	# OF PARALLEL CIRCUITS	CURRENT CARRYING CONDUCTORS IN CONDUIT	CONDUIT FILL PERCENT	OCPD	EGC		TEMP. CORR. FACTOR		CONDUIT FILL FACTOR	CONT. CURRENT	MAX CURRENT	BASE AMP.	DERATED AMP.	TERM. TEMP. RATING	LENGTH IN FEET	VOLTAGE DROP
1	1	STRING	JUNCTION BOX	12 AWG	PV WIRE	COPPER	BARE	4	8	N/A	N/A	6 AWG	BARE COPPER	0,71	(58 °C)	N/A	15.73 A	19.66 A	N/A	N/A	90 °C		0,77%
2	1	JUNCTION BOX	IQ COMBINER BOX	10 AWG	THWN-2	COPPER	EMT	4	8		20A	8 AWG	THWN-2, COPPER	0,91	(36 °C)	0,7	15.73 A	19.66 A	40 A	25,48 A	90 °C		0,00%
3	1	IQ COMBINER BOX	FUSED AC DISCONNECT	8 AWG	THWN-2	COPPER	EMT	1	3		80A	8 AWG	THWN-2, COPPER	0,91	(36 °C)	1	62,92 A	78,65 A	55 A	50.05 A	90 °C		0,00%
4	1	FUSED AC DISCONNECT	MSP	6 AWG	THWN-2	COPPER	EMT	1	3		N/A	8 AWG	THWN-2, COPPER	0,91	(36 °C)	1	62,92 A	78,65 A	75 A	68.25 A	90 °C		0,00%




BEAM SOLAR CO.
1231 SHIELDS ROAD
STE. 5
KERNERSVILLE, NC 27284


ELECTRICAL ONLY
The scope of professional engineer review is exclusive for electrical impact on the existing electrical system by solar panel installation and new wall mounted electrical equipment. Installer must coordinate metering with electric utility and all electrical installation requirements with local AHJ. Mounting hardware is provided by manufacturer and is not in scope of this review. Structural engineering is out of scope of this review.

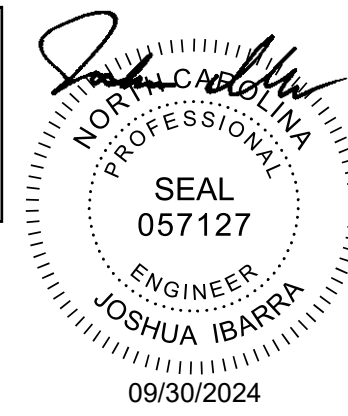


(13) Q.PEAK DUO BLK ML-G10+ 400W MODULES AND (13) ENPHASE IQ8PLUS-72-2-US (240V) MICROINVERTERS IN BRANCH CIRCUIT #4

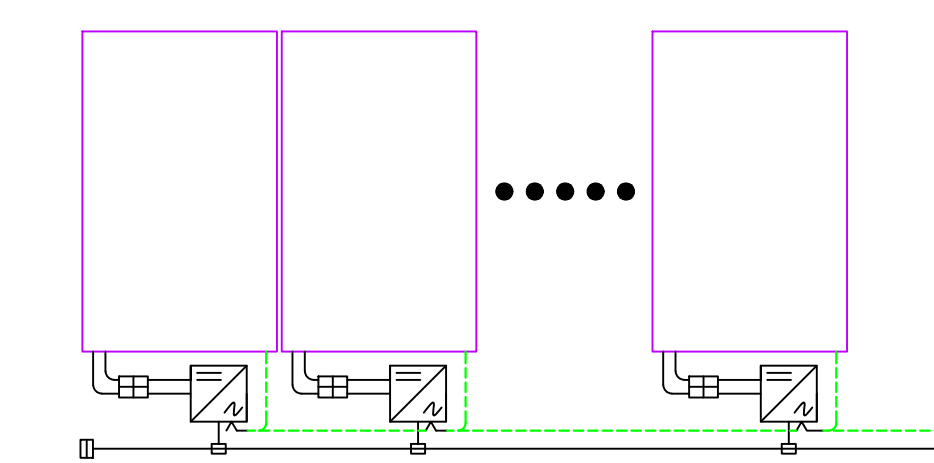


(13) Q.PEAK DUO BLK ML-G10+ 400W MODULES AND (13) ENPHASE IQ8PLUS-72-2-US (240V) MICROINVERTERS IN BRANCH CIRCUIT #3

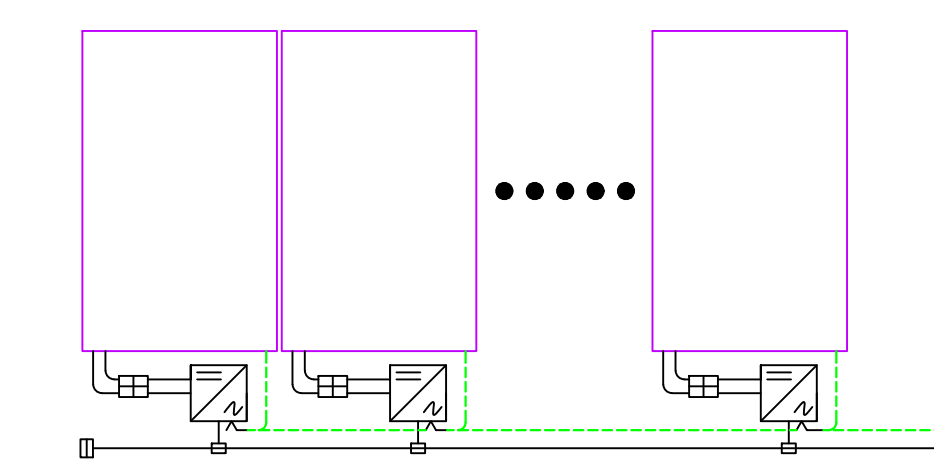


(13) Q.PEAK DUO BLK ML-G10+ 400W MODULES AND (13) ENPHASE IQ8PLUS-72-2-US (240V) MICROINVERTERS IN BRANCH CIRCUIT #2

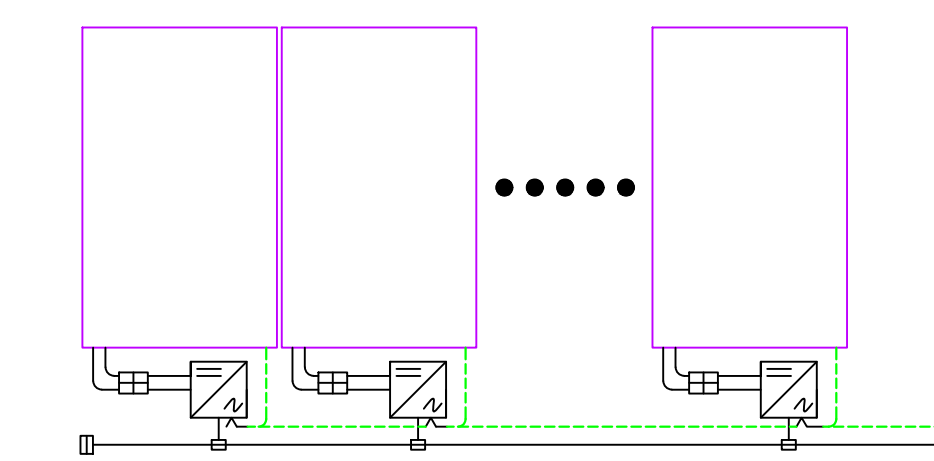

(13) Q.PEAK DUO BLK ML-G10+ 400W MODULES AND (13) ENPHASE IQ8PLUS-72-2-US (240V) MICROINVERTERS IN BRANCH CIRCUIT #1

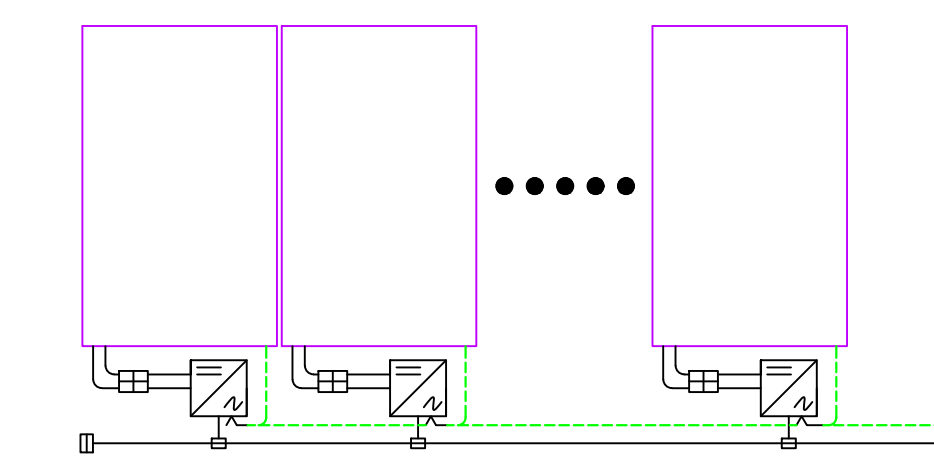


ENPASE IQ COMBINER 5/5C, X-IQ-AM1-240-5/5C 64A/240V CONTINUOUS, PROTECTION MAX 80A BREAKER ON SOLAR OUTPUT; WITH 10 KAIC CIRCUIT BREAKERS

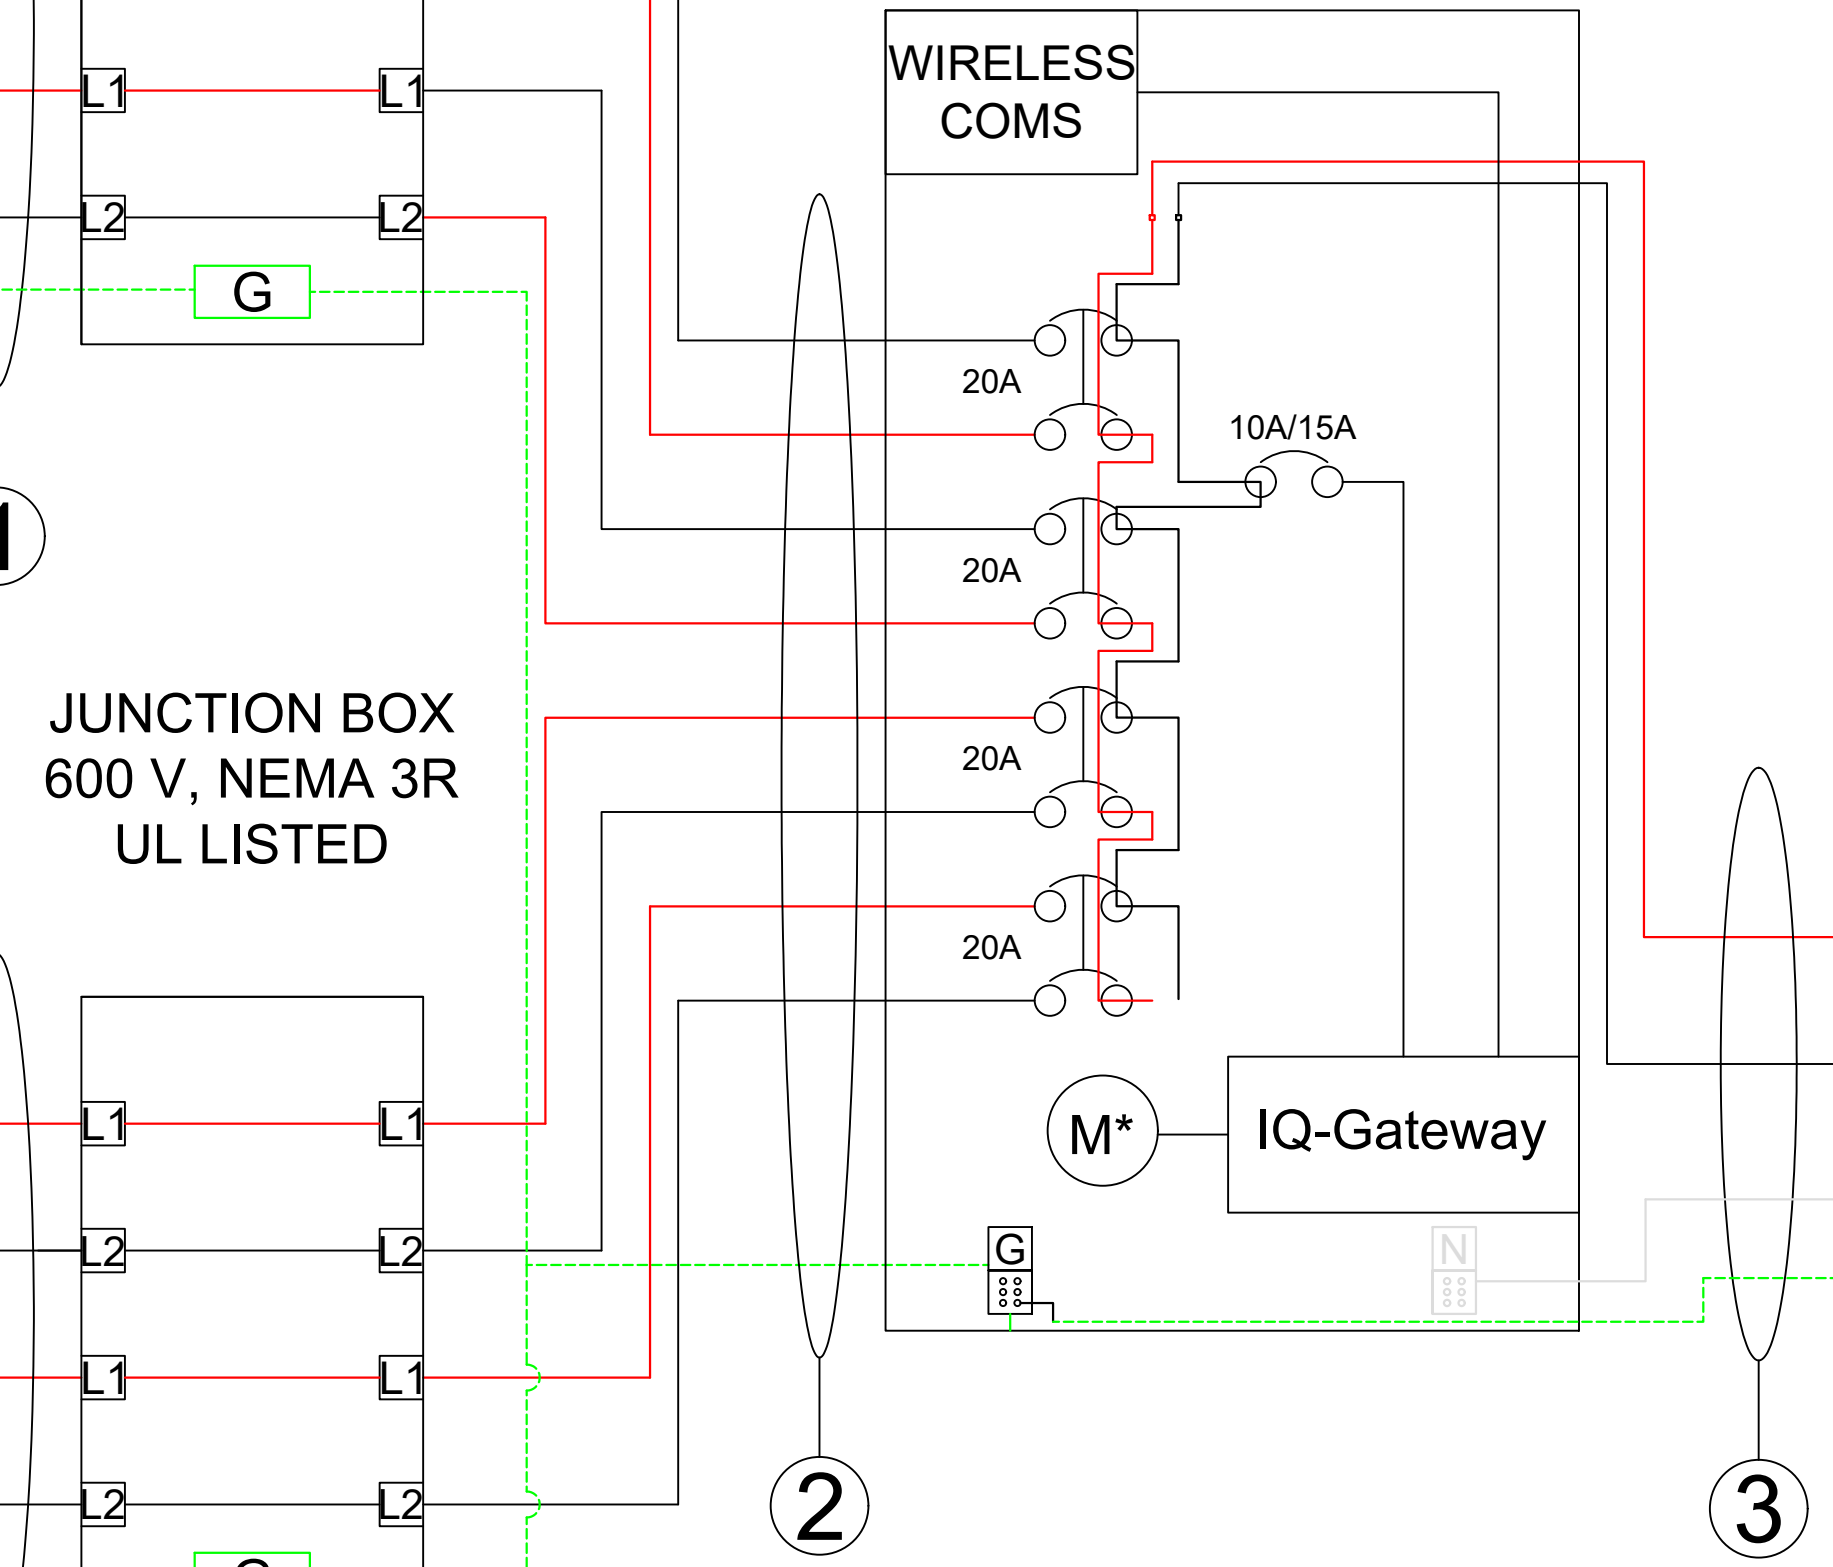

1

BI-DIRECTIONAL UTILITY METER #144 575 24
1-PH, 3-W, 120V/240V TO UTILITY METER
UTILITY COMPANY - SOUTH RIVER ELECTRIC

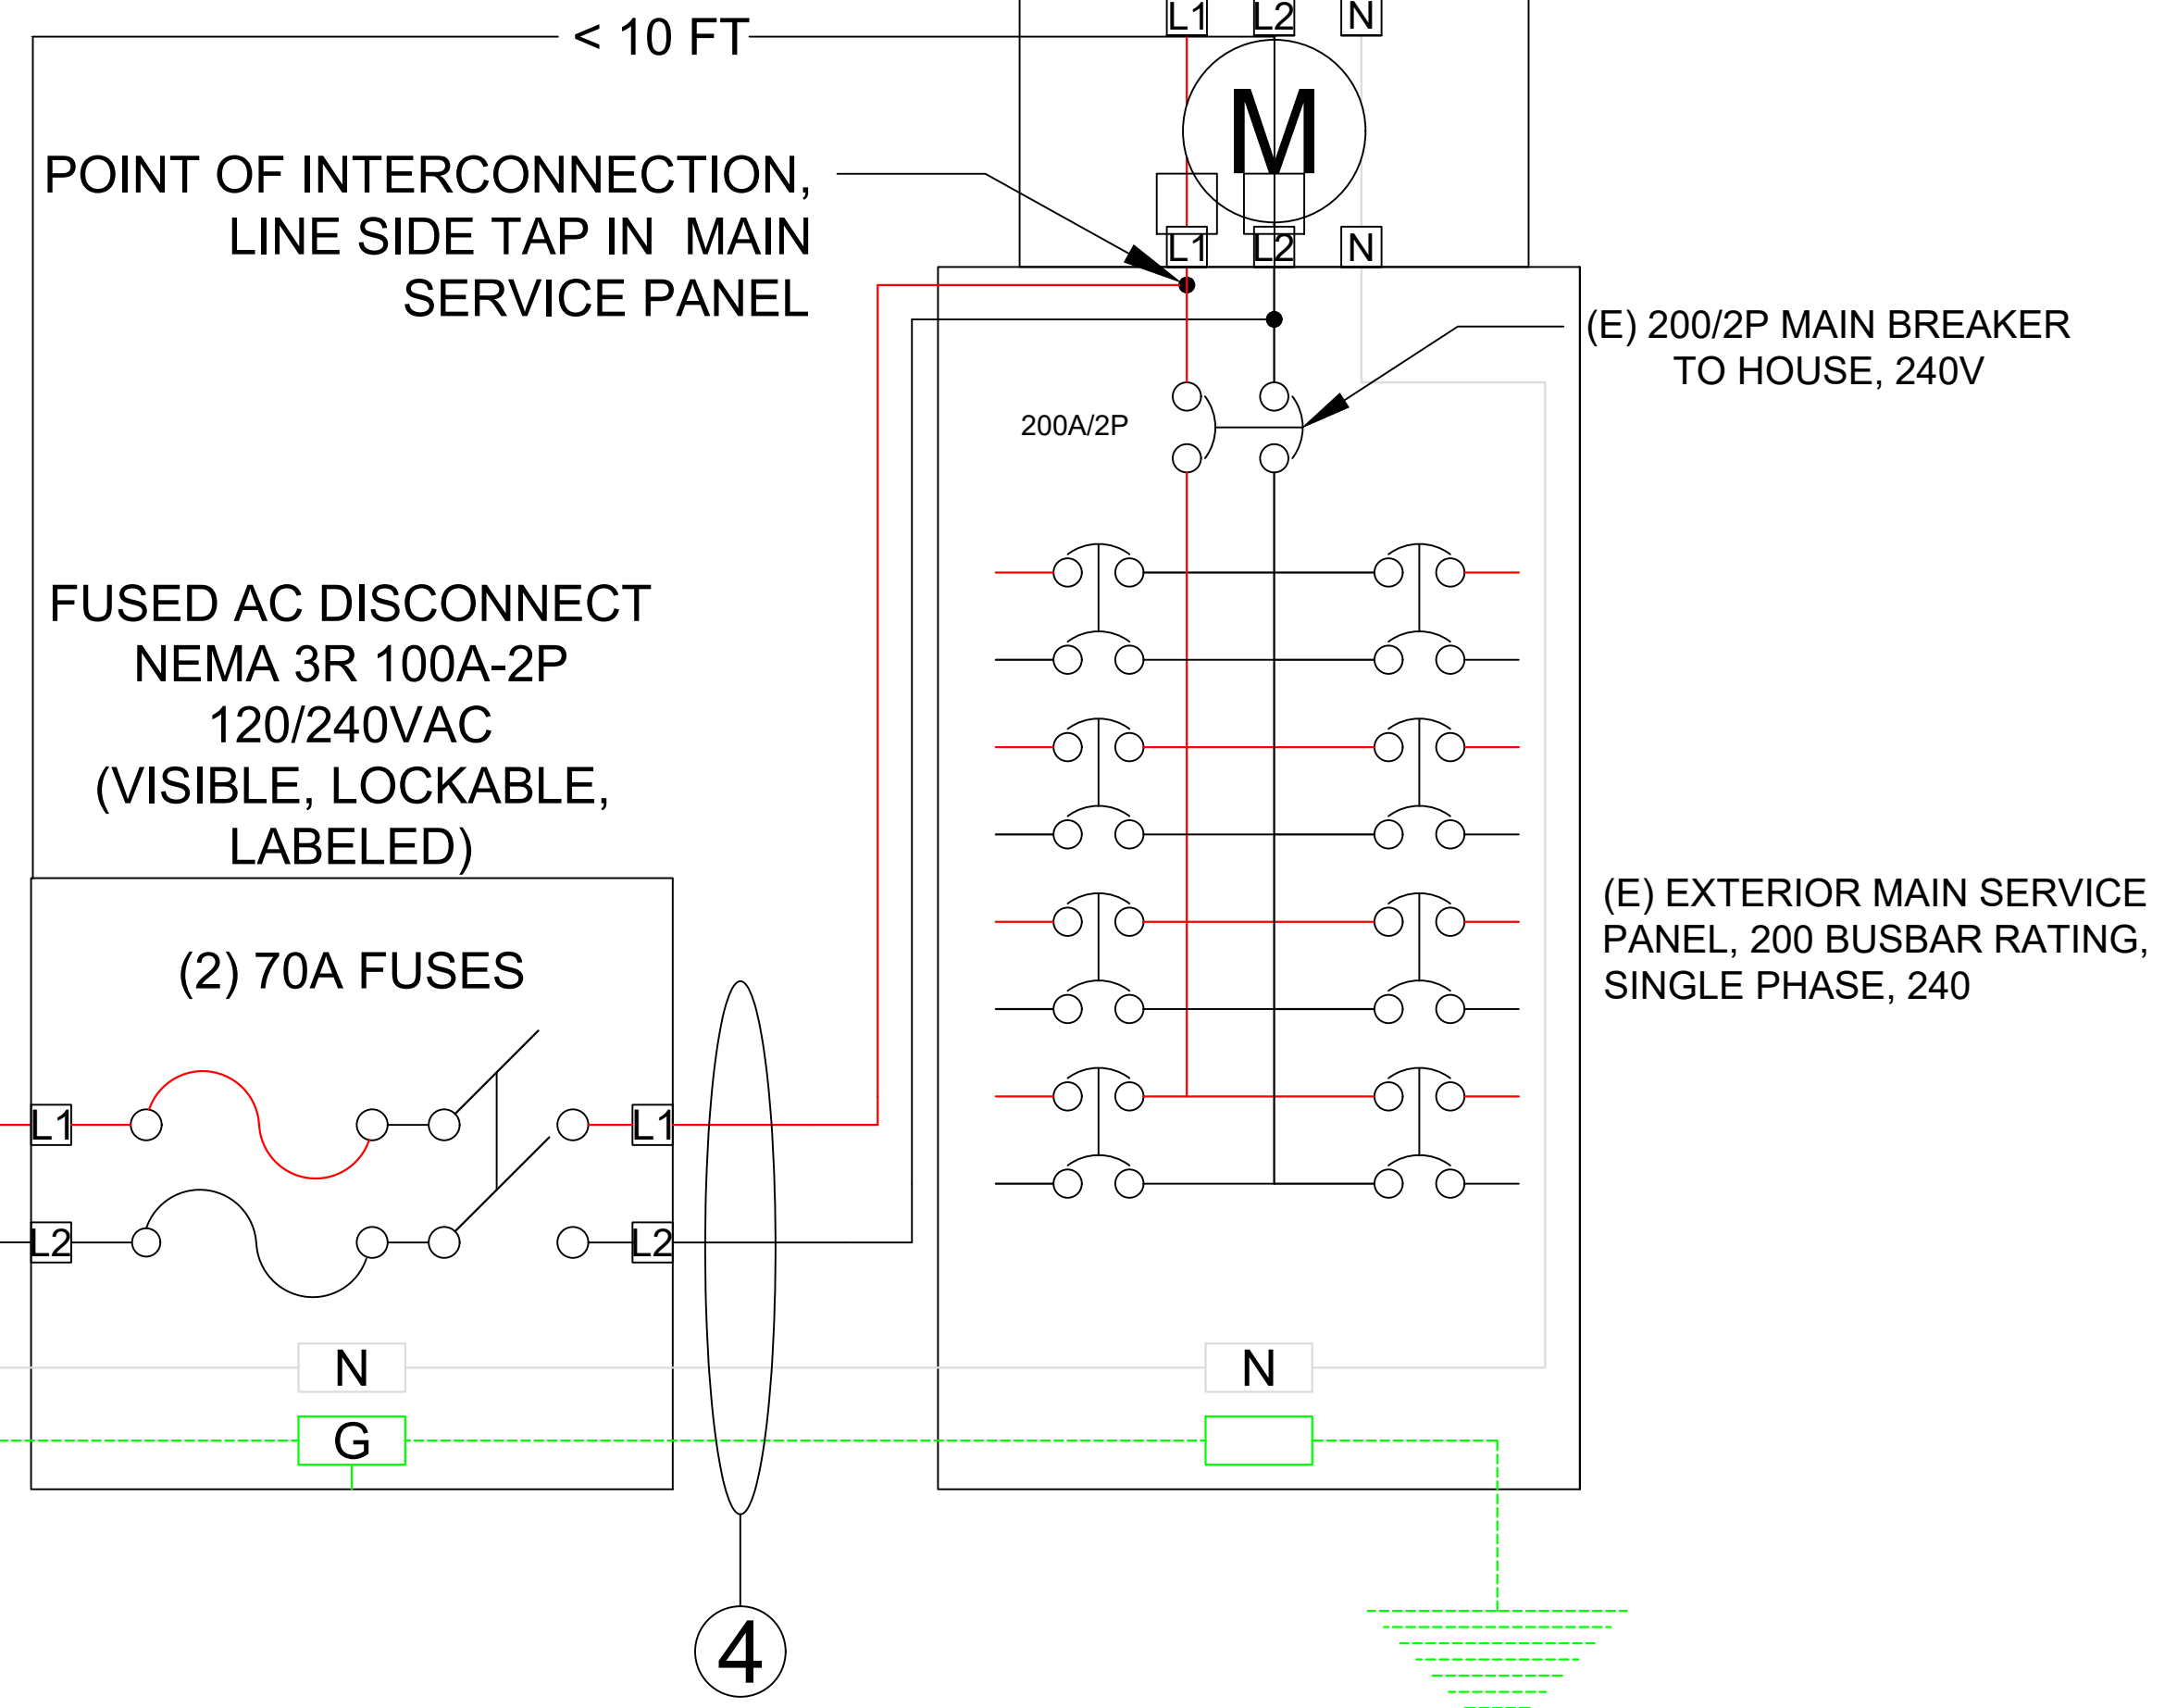

EXISTING GROUNDING ELECTRODE CONDUCTOR

SCOPE OF WORK:
TO INSTALL OF A 52 MODULE ROOF MOUNTED SOLAR PHOTOVOLTAIC SYSTEM AT THE OWNER RESIDENCE LOCATED AT 810 BUCHANAN RD THE POWER GENERATED BY THE PV SYSTEM WILL BE INTERCONNECTED WITH THE UTILITY GRID THROUGH THE EXISTING ELECTRICAL SERVICE EQUIPMENT. THE PV SYSTEM DOES NOT INCLUDE STORAGE BATTERIES.

MICHAEL DOESKEN RESIDENCE
810 BUCHANAN RD
LILLINGTON, NC 27546
(1919)721-8311
MICHAEL.DOESKEN@GMAIL.COM
TMK: #


DRAWN BY: CHARLENE A.
DATE: 2024-09-18

NO.	DESCRIPTION	DATE

ELECTRIC 3LD

PV-700.00

SERVICE INFO.	
UTILITY PROVIDER:	SOUTH RIVER ELECTRIC
AHJ:	HARNETT COUNTY
MAIN SERVICE VOLTAGE:	240
MAIN BUSBAR:	200
MAIN BREAKER RATING:	200
MAIN SERVICE LOCATION:	NORTH EAST
SERVICE FEED SOURCE:	UNDERGROUND

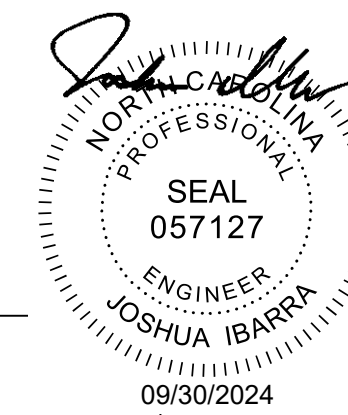

SOLAR MODULE SPECIFICATIONS

MANUFACTURER/ MODEL	Q.PEAK DUO BLK ML-G10+ 400W MODULES
VMP	37.95 V
IMP	10.54 A
VOC	45.24 V
ISC	11.05 A
TEMP. COEFF. VOC	-0.27 %/C°
MODULE DIMENSION	73.98" (L) x 41.14" (W)
PANEL WATTAGE	400 W

INVERTER SPECIFICATIONS

MANUFACTURER/ MODEL	ENPHASE IQ8PLUS-72-2-US (240V) MICROINVERTER
MAX DC SHORT CIRCUIT CURRENT	20 A
CONTINUOUS OUTPUT CURRENT	1.21 A (240 VAC)

AMBIENT TEMPERATURE SPECS

RECORD LOW TEMP	-10 °C
AMBIENT TEMP (HIGH TEMP 2%)	36 °C
CONDUIT HEIGHT	7/8"
ROOF TOP TEMP	58 °C
CONDUCTOR TEMPERATURE RATE	90 °C
MODULE TEMPERATURE COEFFICIENT OF VOC	-0.27 %/C°

ARRAY WEIGHT (DEAD LOAD CALCS)

NUMBER OF MODULES	52
MODULE WEIGHT	48.5 LBS
TOTAL MODULE (ARRAY) WEIGHT	2522 LBS
NUMBER OF ATTACHMENT POINTS	175
MOUNTING SYSTEM WEIGHT (PER MODULE)	0 LBS
MOUNTING SYSTEM WEIGHT	0 LBS
WEIGHT AT EACH ATTACHMENT POINT (ARRAY WEIGHT / NUMBER OF ATTACHMENT POINT)	15,76 LBS
MODULE AREA (73.98" x 41.14")	21.14 SF
TOTAL ARRAY AREA	1099,28 SF
DISTRIBUTED LOAD (TOTAL SYSTEM WEIGHT / TOTAL ARRAY AREA)	2.29 PSF
TOTAL ROOF AREA	3410.35 SF
TOTAL PERCENTAGE OF ROOF COVERED ((TOTAL ARRAY AREA / TOTAL ROOF AREA)*100)	32,23%



BEAM SOLAR CO.
1231 SHIELDS ROAD
STE. 5
KERNERSVILLE, NC 27284

SCOPE OF WORK:

TO INSTALL OF A 52 MODULE ROOF MOUNTED SOLAR PHOTOVOLTAIC SYSTEM AT THE OWNER RESIDENCE LOCATED AT 810 BUCHANAN RD THE POWER GENERATED BY THE PV SYSTEM WILL BE INTERCONNECTED WITH THE UTILITY GRID THROUGH THE EXISTING ELECTRICAL SERVICE EQUIPMENT. THE PV SYSTEM DOES NOT INCLUDE STORAGE BATTERIES.

MICHAEL DOESKEN
RESIDENCE
810 BUCHANAN RD
LILLINGTON, NC 27546
(1919)721-8311
MICHAEL.DOESKEN@GMAIL.COM
TMK: #


DRAWN BY: CHARLENE A.

DATE: 2024-09-18

REVISION:		
NO.	DESCRIPTION	DATE

SPECS AND CALCS

PV-800.00

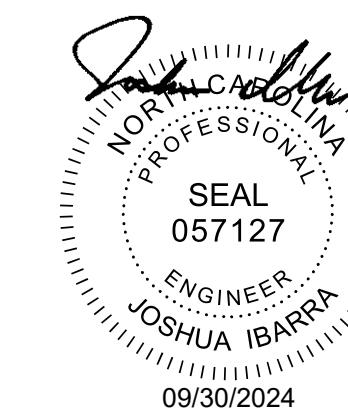

1 **WARNING**

ELECTRIC SHOCK HAZARD
DO NOT TOUCH TERMINALS
TERMINALS ON BOTH LINE AND
LOAD SIDES MAY BE ENERGIZED IN
THE OPEN POSITION

LABEL LOCATION:
POINT OF INTERCONNECTION,
(PER CODE: NEC 690.16(B))

2 **WARNING - Electric Shock Hazard**
No user serviceable parts inside
Contact authorized service provider for assistance

LABEL LOCATION:
INVERTER, JUNCTION BOXES (ROOF),
(PER CODE: NEC 690.13.G.3 & NEC
690.13.G.4)

3 **WARNING: DUAL POWER SOURCE**
DUAL POWER SOURCE

LABEL LOCATION:
POINT OF INTERCONNECTION
(PER CODE: NEC 705.15(C) & NEC 690.59)

4 **WARNING: PHOTOVOLTAIC
POWER SOURCE**

LABEL LOCATION:
CONDUIT, COMBINER BOX
(PER CODE: NEC 690.31(2))

ADHESIVE FASTENED SIGNS:

- THE LABEL SHALL BE SUITABLE FOR THE ENVIRONMENT WHERE IT IS INSTALLED
- WHERE REQUIRED ELSEWHERE IN THIS CODE, ALL FIELD APPLIED LABELS, WARNINGS, AND MARKINGS SHOULD COMPLY WITH ANSI Z535.4 [NEC 110.21(B) FIELD MARKING].
- ADHESIVE FASTENED SIGNS MAY BE ACCEPTABLE IF PROPERLY ADHERED. VINYL SIGNS SHALL BE WEATHER RESISTANT [IFC 605.11.1.3]

5 **PHOTOVOLTAIC SYSTEM AC DISCONNECT**
RATED AC OUTPUT CURRENT 62.92 AMP
NOMINAL OPERATING AC VOLTAGE 240 VOLTS

LABEL LOCATION:
POINT OF INTERCONNECTION,
(PER CODE: NEC 690.54)

10 **CAUTION**
POWER TO THIS SERVICE IS
ALSO SUPPLIED FROM
ON-SITE SOLAR/ WIND
GENERATION

AC SYSTEM DISCONNECT

6 **WARNING**
INVERTER OUTPUT CONNECTION DO NOT
RELOCATE THIS OVERCURRENT DEVICE

LABEL LOCATION:
POINT OF INTERCONNECTION,
(PER CODE: NEC 705.12(B)(3)(2))
[Not required if panelboard is rated not less than sum of ampere ratings
of all overcurrent devices supplying it]

11 **CAUTION**
ALTERNATE POWER SUPPLY
AC SYSTEM DISCONNECT

7 **CAUTION: SOLAR ELECTRIC
SYSTEM CONNECTED**

LABEL LOCATION:
POINT OF INTERCONNECTION,
(PER CODE: NEC 690.15, 690.13(B))
INVERTER



8 **SOLAR PV SYSTEM EQUIPED
WITH RAPID SHUTDOWN**

TURN RAPID SHUTDOWN
SWITCH TO THE "OFF"
POSITION TO SHUT DOWN
PV SYSTEM AND REDUCE
SHOCK HAZARD IN THE
ARRAY

LABEL LOCATION:
LABEL PER NEC 690.56(C)- PROVIDE
AT AC DISCONNECT FOR RAPID
SHUTDOWN COMPLIANT SYSTEM

9 **CAUTION: SOLAR CIRCUIT**

LABEL LOCATION:
MARKINGS PLACED ON ALL INTERIOR AND EXTERIOR DC
CONDUIT, RACEWAYS, ENCLOSURES, AND CABLE ASSEMBLIES AT
LEAST EVERY 10 FT, AT TURNS AND ABOVE/BELOW
PENETRATIONS AND ALL COMBINER/JUNCTION BOXES. (PER CODE:
IFC 605.11.1.4)

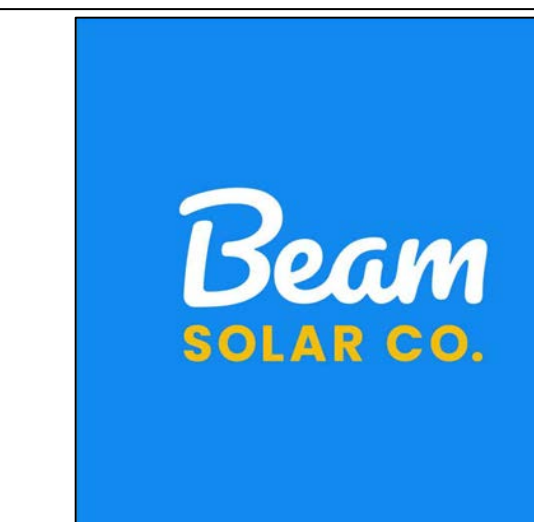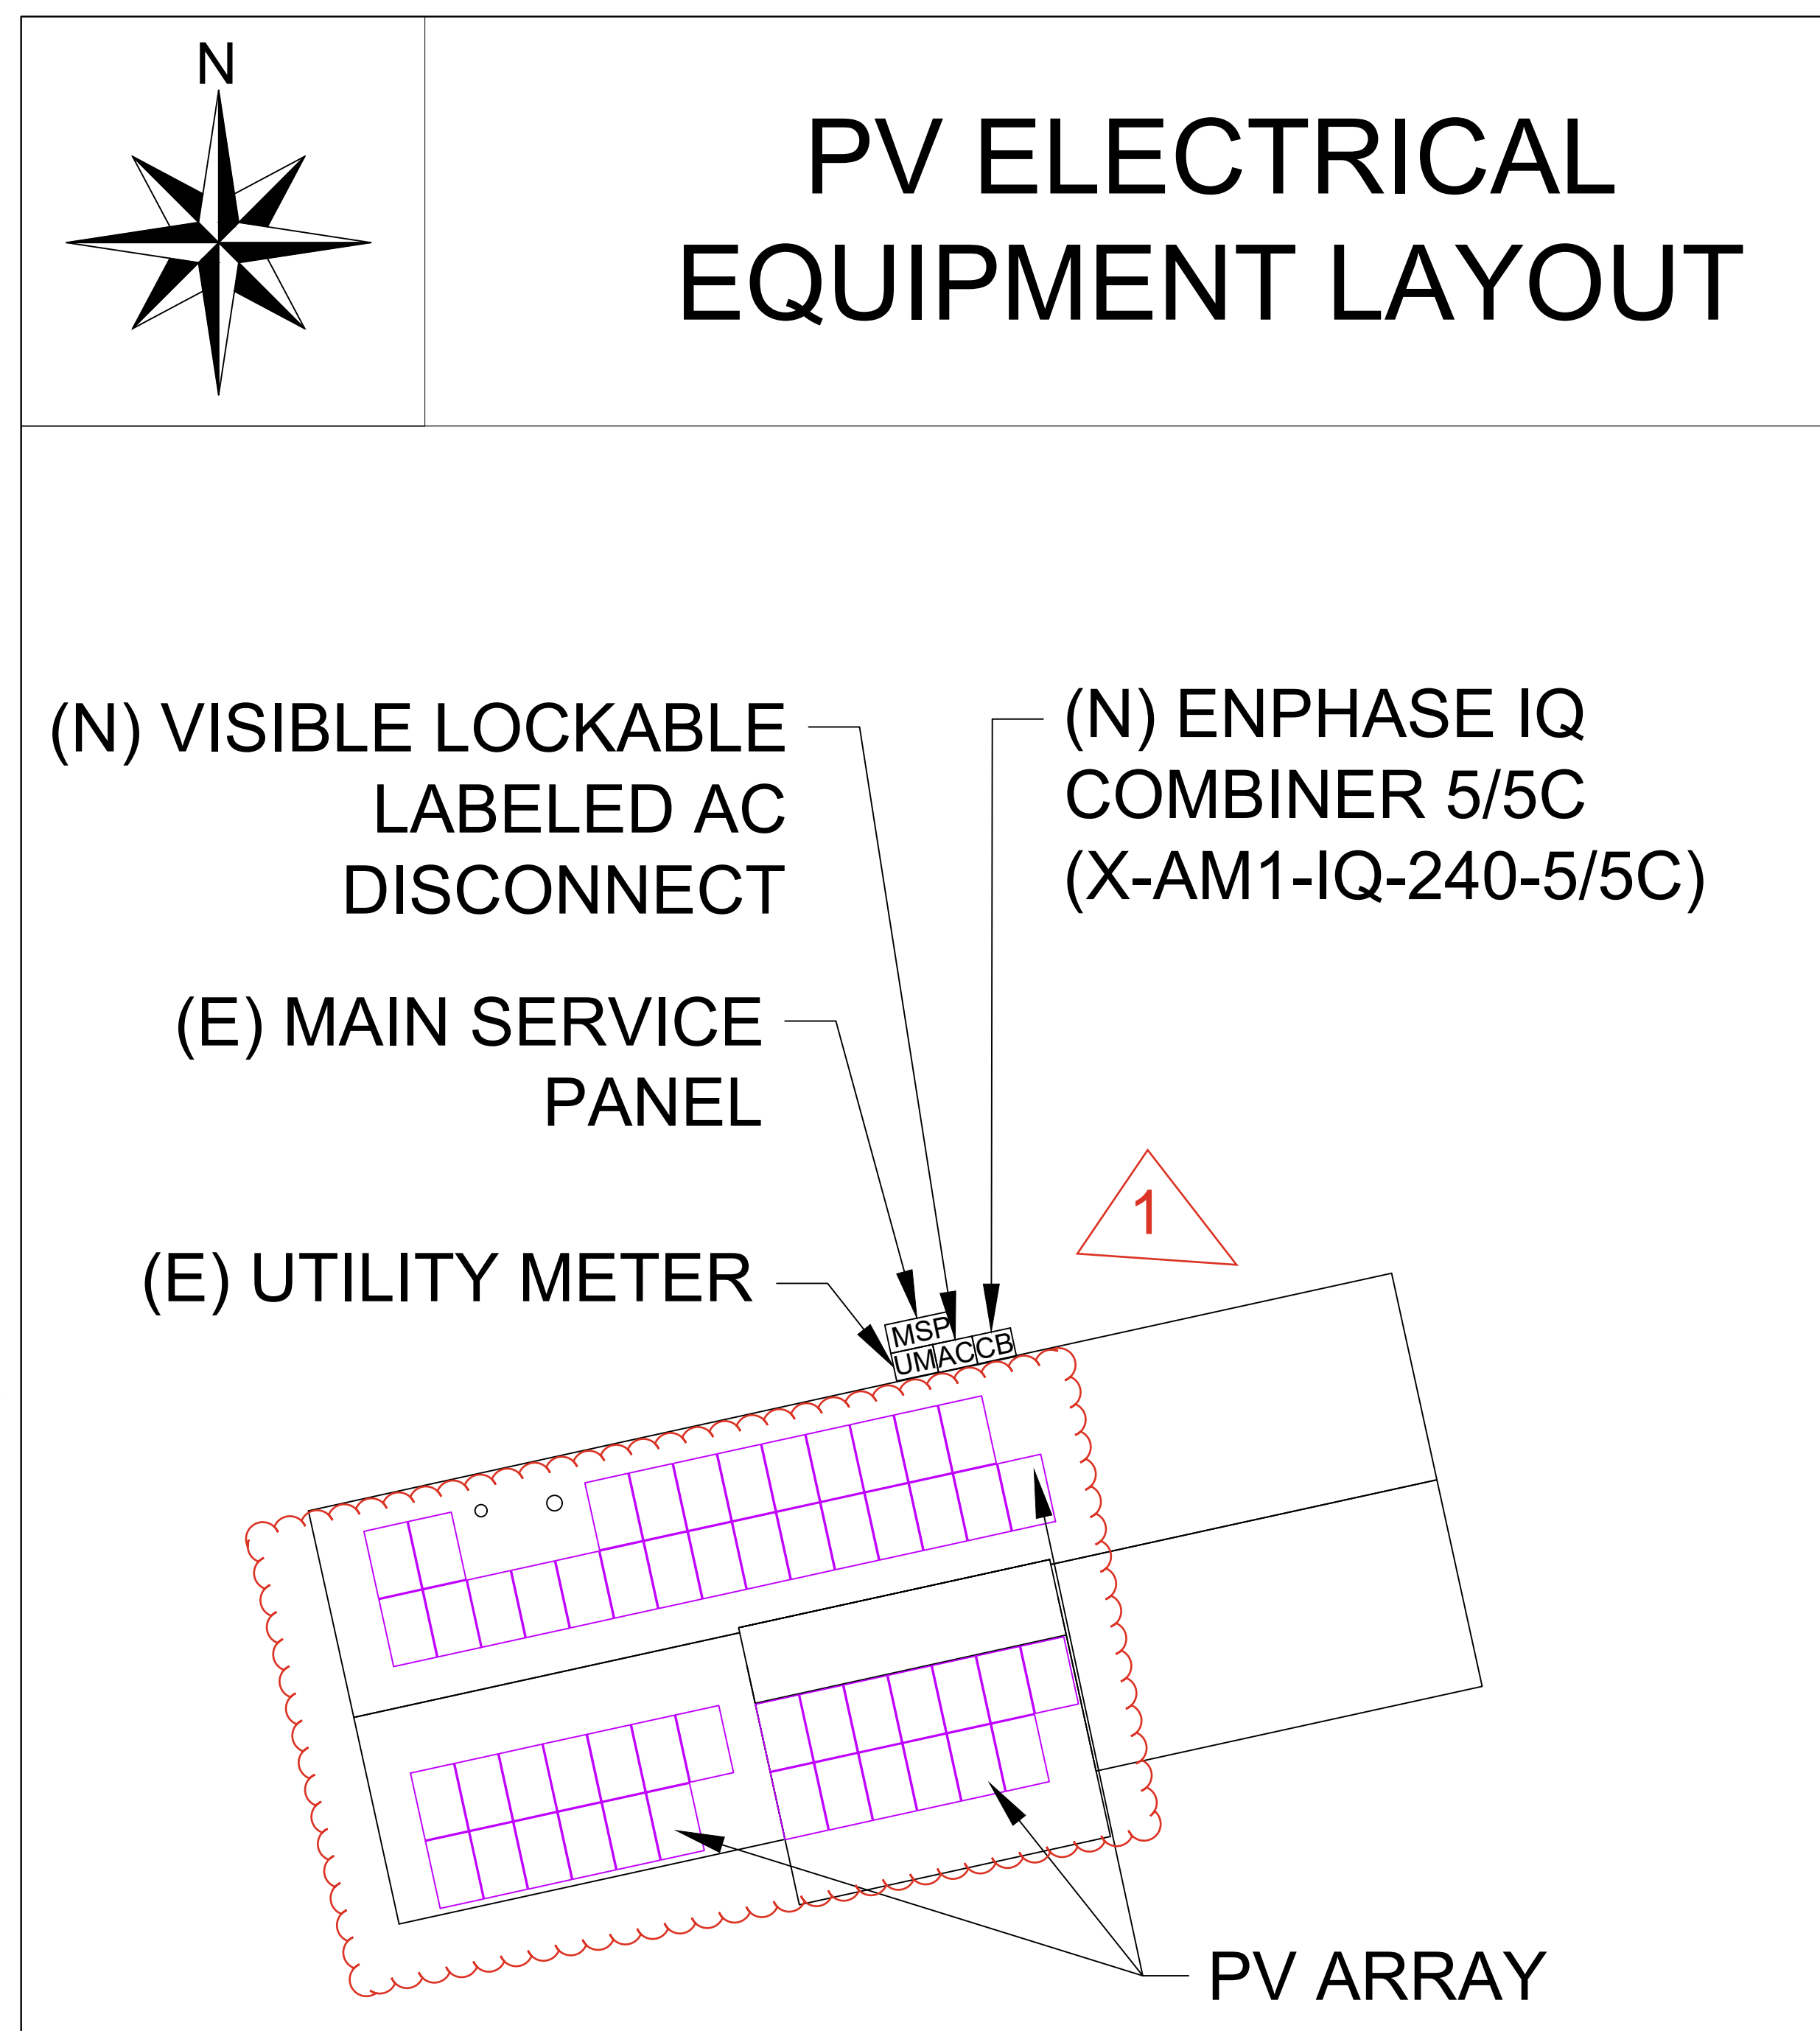

BEAM SOLAR CO.
1231 SHIELDS ROAD
STE. 5
KERNERSVILLE, NC 27284

SCOPE OF WORK:

TO INSTALL OF A 52 MODULE ROOF MOUNTED
SOLAR PHOTOVOLTAIC SYSTEM AT THE OWNER
RESIDENCE LOCATED AT 810 BUCHANAN RD
THE POWER GENERATED BY THE PV SYSTEM
WILL BE INTERCONNECTED WITH THE UTILITY
GRID THROUGH THE EXISTING ELECTRICAL
SERVICE EQUIPMENT. THE PV SYSTEM DOES
NOT INCLUDE STORAGE BATTERIES.

MICHAEL DOESKEN
RESIDENCE
810 BUCHANAN RD
LILLINGTON, NC 27546
(1919)721-8311
MICHAEL.DOESKEN@GMAIL.COM
TMK: #

DRAWN BY: CHARLENE A.

DATE: 2024-09-18

REVISION:

NO.	DESCRIPTION	DATE

LABELS


PV-900.00

Q.PEAK DUO BLK ML-G10+ SERIES



395-415 Wp | 132 Cells
21.1% Maximum Module Efficiency

MODEL Q.PEAK DUO BLK ML-G10.a+
Q.PEAK DUO BLK ML-G10+

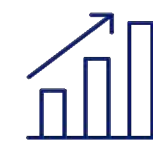

Breaking the 21% efficiency barrier

Q.ANTUM DUO Z Technology with zero gap cell layout boosts module efficiency up to 21.1%.



A reliable investment

Inclusive 25-year product warranty and 25-year linear performance warranty¹.



Enduring high performance

Long-term yield security with Anti LeTID Technology, Anti PID Technology² and Hot-Spot Protect.



Extreme weather rating

High-tech aluminium alloy frame, certified for high snow (5400 Pa) and wind loads (4000 Pa).



Innovative all-weather technology

Optimal yields, whatever the weather with excellent low-light and temperature behaviour.



The most thorough testing programme in the industry

Qcells is the first solar module manufacturer to pass the most comprehensive quality programme in the industry. The new "Quality Controlled PV" of the independent certification institute TÜV Rheinland.

¹ See data sheet on rear for further information.
² APT test conditions according to IEC/TS 62804-1:2015, method A (-1500V, 96h)


The ideal solution for:
Rooftop arrays on residential buildings



Q.PEAK DUO BLK ML-G10+ SERIES

Mechanical Specification

Format	74.0 in × 41.1 in × 1.26 in (including frame) (1879 mm × 1045 mm × 32 mm)
Weight	48.5 lbs (22.0 kg)
Front Cover	0.13 in (3.2 mm) thermally pre-stressed glass with anti-reflection technology
Back Cover	Composite film
Frame	Black anodised aluminium
Cell	6 × 22 monocrystalline Q.ANTUM solar half cells
Junction box	2.09-3.98 in × 1.26-2.36 in × 0.59-0.71 in (53-101 mm × 32-60 mm × 15-18 mm), IP67, with bypass diodes
Cable	4 mm ² Solar cable; (+) ≥ 72.04 in (1830 mm), (-) ≥ 72.04 in (1830 mm)
Connector	Stäubli MC4; IP68

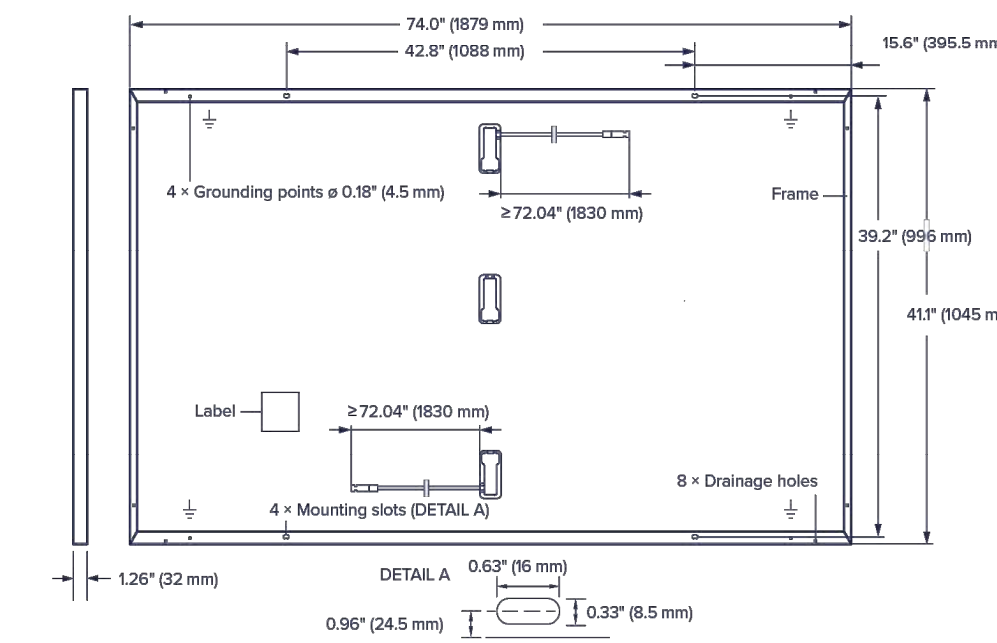

Electrical Characteristics


POWER CLASS	395	400	405	410	415	
MINIMUM PERFORMANCE AT STANDARD TEST CONDITIONS, STC ¹ (POWER TOLERANCE +5W/-0W)						
Power at MPP ¹	P _{MPP} [W]	395	400	405	410	415
Short Circuit Current ¹	I _{SC} [A]	11.02	11.05	11.08	11.11	11.14
Open Circuit Voltage ¹	V _{OC} [V]	45.20	45.24	45.27	45.31	45.34
Current at MPP	I _{MPP} [A]	10.48	10.54	10.60	10.65	10.71
Voltage at MPP	V _{MPP} [V]	37.68	37.95	38.22	38.48	38.74
Efficiency ¹	η [%]	≥ 20.1	≥ 20.4	≥ 20.6	≥ 20.9	≥ 21.1

MINIMUM PERFORMANCE AT NORMAL OPERATING CONDITIONS, NMOT²

Power at MPP	P _{MPP} [W]	296.4	300.1	303.9	307.6	311.4
Short Circuit Current	I _{SC} [A]	8.88	8.91	8.93	8.95	8.98
Open Circuit Voltage	V _{OC} [V]	42.63	42.66	42.69	42.73	42.76
Current at MPP	I _{MPP} [A]	8.25	8.30	8.35	8.40	8.45
Voltage at MPP	V _{MPP} [V]	35.93	36.16	36.39	36.61	36.84

¹ Measurement tolerances P_{MPP} ± 3%; I_{SC}; V_{OC} ± 5% at STC; 1000 W/m²; 25 ± 2 °C, AM 1.5 according to IEC 60904-3 • 800 W/m²; NMOT, spectrum AM 1.5

Qcells PERFORMANCE WARRANTY

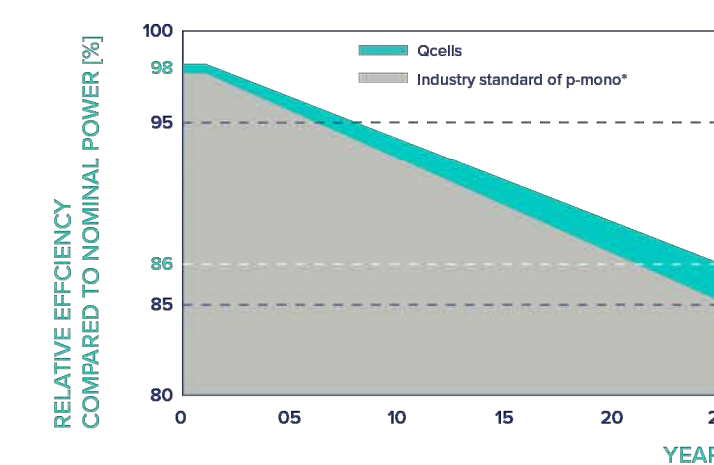


At least 98% of nominal power during first year. Thereafter max. 0.5% degradation per year. At least 93.5% of nominal power up to 10 years. At least 86% of nominal power up to 25 years.

All data within measurement tolerances. Full warranties in accordance with the warranty terms of the Qcells sales organisation of your respective country.

^{*} Standard terms of guarantee for the 5 PV companies with the highest production capacity in 2021 (February 2021)

PERFORMANCE AT LOW IRRADIANCE

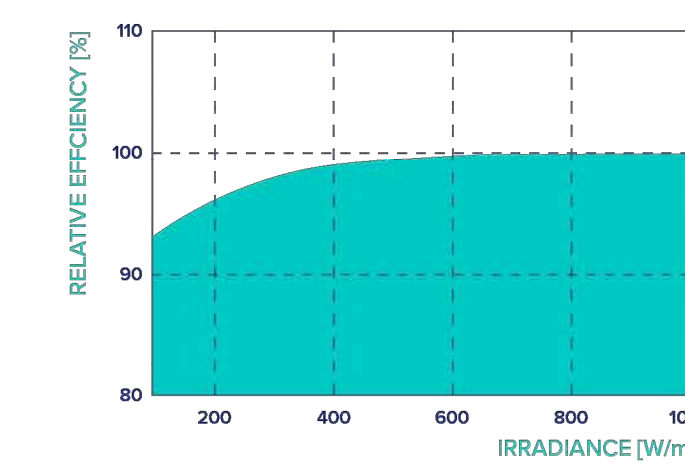

Typical module performance under low irradiance conditions in comparison to STC conditions (25 °C, 1000 W/m²).

TEMPERATURE COEFFICIENTS

Temperature Coefficient of I _{SC}	α [%/K]	+0.04	Temperature Coefficient of V _{OC}	β [%/K]	-0.27
Temperature Coefficient of P _{MPP}	γ [%/K]	-0.34	Nominal Module Operating Temperature	NMOT [°F]	109 ± 5.4 (43 ± 3 °C)

Properties for System Design

Maximum System Voltage	V _{sys} [V]	1000 (IEC)/1000 (UL)	PV module classification	Class II
Maximum Series Fuse Rating	[A DC]	20	Fire Rating based on ANSI/UL 61730	TYPE 2
Max. Design Load, Push/Pull ³	[lbs / ft ²]	75 (3600 Pa) / 55 (2660 Pa)	Permitted Module Temperature on Continuous Duty	-40 °F up to +185 °F (-40 °C up to +85 °C)
Max. Test Load, Push/Pull ³	[lbs / ft ²]	113 (5400 Pa) / 84 (4000 Pa)		

³ See Installation Manual

Qualifications and Certificates

UL61730-1 & UL61730-2, CE-compliant, Quality Controlled PV - TÜV Rheinland, IEC 61215:2016, IEC 61730:2016, U.S. Patent No. 9,893,215 (solar cells),



^{*} Contact your Qcells Sales Representative for details regarding the module's eligibility to be Buy American Act (BAA) compliant.

Qcells pursues minimizing paper output in consideration of the global environment.

Note: Installation instructions must be followed. Contact our technical service for further information on approved installation of this product. Hanwha Q CELLS America Inc. 400 Spectrum Center Drive, Suite 1400, Irvine, CA 92618, USA | TEL +1 949 748 59 96 | EMAIL hqc-inquiry@qcells.com | WEB www.qcells.com



Specifications subject to technical changes © Qcells Q.PEAK DUO BLK ML-G10+ series_395-415_DA_2023-12_Rev.06_MA



BEAM SOLAR CO.
1231 SHIELDS ROAD
STE. 5
KERNERSVILLE, NC 27284

SCOPE OF WORK:

TO INSTALL OF A 52 MODULE ROOF MOUNTED SOLAR PHOTOVOLTAIC SYSTEM AT THE OWNER RESIDENCE LOCATED AT 810 BUCHANAN RD THE POWER GENERATED BY THE PV SYSTEM WILL BE INTERCONNECTED WITH THE UTILITY GRID THROUGH THE EXISTING ELECTRICAL SERVICE EQUIPMENT. THE PV SYSTEM DOES NOT INCLUDE STORAGE BATTERIES.

MICHAEL DOESKEN
RESIDENCE
810 BUCHANAN RD
LILLINGTON, NC 27546
(1919)721-8311
MICHAEL.DOESKEN@GMAIL.COM
TMK: #

DRAWN BY: CHARLENE A.

DATE: 2024-09-18

REVISION:

NO.	DESCRIPTION	DATE

DATA SHEETS

MSD



DATA SHEET



IQ8 and IQ8+ Microinverters

Our newest IQ8 Microinverters are the industry's first microgrid-forming, software defined microinverters with split-phase power conversion capability to convert DC power to AC power efficiently. The brain of the semiconductor-based microinverter is our proprietary application specific integrated circuit (ASIC) which enables the microinverter to operate in grid-tied or off-grid modes. This chip is built in advanced 55nm technology with high speed digital logic and has superfast response times to changing loads and grid events, alleviating constraints on battery sizing for home energy systems.



Part of the Enphase Energy System, IQ8 Series Microinverters integrate with the IQ Battery, IQ Gateway, and the Enphase App monitoring and analysis software.



IQ8 Series Microinverters redefine reliability standards with more than one million cumulative hours of power-on testing, enabling an industry-leading limited warranty of up to 25 years.



Connect PV modules quickly and easily to IQ8 Series Microinverters using the included Q-DCC-2 adapter cable with plug-n-play MC4 connectors.



IQ8 Series Microinverters are UL listed as PV Rapid Shutdown Equipment and conform with various regulations, when installed according to manufacturer's instructions.

*Only when installed with IQ System Controller 2, meets UL 1741.
**IQ8 and IQ8Plus support split-phase, 240V installations only.

Easy to install

- Lightweight and compact with plug-n-play connectors
- Power Line Communication (PLC) between components
- Faster installation with simple two-wire cabling

High productivity and reliability

- Produce power even when the grid is down*
- More than one million cumulative hours of testing
- Class II double-insulated enclosure
- Optimized for the latest high-powered PV modules

Microgrid-forming

- Complies with the latest advanced grid support**
- Remote automatic updates for the latest grid requirements
- Configurable to support a wide range of grid profiles
- Meets CA Rule 21 (UL 1741-SA) and IEEE 1547:2018 (UL 1741-SB)

Note:

IQ8 Microinverters cannot be mixed together with previous generations of Enphase microinverters (IQ7 Series, IQ6 Series, etc) in the same system.

IQ8 and IQ8+ Microinverters

INPUT DATA (DC)		108-60-2-US	108PLUS-72-2-US
Commonly used module pairings ¹	W	235 – 350	235 – 440
Module compatibility		60-cell / 120 half-cell	54-cell / 108 half-cell, 60-cell / 120 half-cell, 66-cell / 132 half-cell and 72-cell / 144 half-cell
MPPT voltage range	V	27 – 37	27 – 45
Operating range	V	16 – 48	16 – 58
Min. / Max. start voltage	V	22 / 48	22 / 58
Max. input DC voltage	V	50	60
Max. continuous input DC current	A	10	12
Max. input DC short-circuit current	A		25
Max. module I _{sc}	A		20
Overvoltage class DC port			II
DC port backfeed current	mA		0
PV array configuration		1 x 1 Ungrounded array; No additional DC side protection required; AC side protection requires max 20A per branch circuit	
OUTPUT DATA (AC)		108-60-2-US	108PLUS-72-2-US
Peak output power	VA	245	300
Max. continuous output power	VA	240	290
Nominal (L-L) voltage / range ²	V	240 / 211 – 264	
Max. continuous output current	A	1.0	1.21
Nominal frequency	Hz	60	
Extended frequency range	Hz	47 – 68	
AC short circuit fault current over 3 cycles	Arms	2	
Max. units per 20 A (L-L) branch circuit ³		16	13
Total harmonic distortion		<5%	
Overvoltage class AC port		III	
AC port backfeed current	mA	30	
Power factor setting		1.0	
Grid-tied power factor (adjustable)		0.85 leading – 0.85 lagging	
Peak efficiency	%	97.7	
CEC weighted efficiency	%	97	
Night-time power consumption	mW	60	
MECHANICAL DATA			
Ambient temperature range		-40°C to +60°C (-40°F to +140°F)	
Relative humidity range		4% to 100% (condensing)	
DC Connector type		MC4	
Dimensions (H x W x D)		212 mm (8.3") x 175 mm (6.9") x 30.2 mm (1.2")	
Weight		1.08 kg (2.38 lbs)	
Cooling		Natural convection – no fans	
Approved for wet locations		Yes	
Pollution degree		PD3	
Enclosure		Class II double-insulated, corrosion resistant polymeric enclosure	
Environ. category / UV exposure rating		NEMA Type 6 / outdoor	
COMPLIANCE			
Certifications		CA Rule 21 (UL 1741-SA), UL 62109-1, IEEE 1547:2018 (UL 1741-SB), FCC Part 15 Class B, ICES-0003 Class B, CAN / CSA-C22.2 NO.107.1-01 This product is UL Listed as PV Rapid Shutdown Equipment and conforms with NEC 2014, NEC 2017, and NEC 2020 section 690.12 and C22.1-2018 Rule 64-218 Rapid Shutdown of PV Systems, for AC and DC conductors, when installed according to manufacturer's instructions.	

(1) Pairing PV modules with wattage above the limit may result in additional clipping losses. See the compatibility calculator at <https://link.enphase.com/module-compatibility>. (2) Nominal voltage range can be extended beyond nominal if required by the utility. (3) Limits may vary. Refer to local requirements to define the number of microinverters per branch in your area.



BEAM SOLAR CO.
1231 SHIELDS ROAD
STE. 5
KERNERSVILLE, NC 27284

SCOPE OF WORK:

TO INSTALL OF A 52 MODULE ROOF MOUNTED SOLAR PHOTOVOLTAIC SYSTEM AT THE OWNER RESIDENCE LOCATED AT 810 BUCHANAN RD THE POWER GENERATED BY THE PV SYSTEM WILL BE INTERCONNECTED WITH THE UTILITY GRID THROUGH THE EXISTING ELECTRICAL SERVICE EQUIPMENT. THE PV SYSTEM DOES NOT INCLUDE STORAGE BATTERIES.

MICHAEL DOESKEN
RESIDENCE
810 BUCHANAN RD
LILLINGTON, NC 27546
(1919)721-8311
MICHAEL.DOESKEN@GMAIL.COM
TMK: #

DRAWN BY: CHARLENE A.

DATE: 2024-09-18

REVISION:

NO.	DESCRIPTION	DATE

DATA SHEETS

MSD



DATASHEET



X-IQ-AMI-240-5
X-IQ-AMI-240-5C

IQ Combiner 5/5C

The IQ Combiner 5/5C consolidates interconnection equipment into a single enclosure and streamlines IQ Series Microinverters and IQ Gateway installation by providing a consistent, pre-wired solution for residential applications. IQ Combiner 5/5C uses wired control communication and is compatible with IQ System Controller 3/3G and IQ Battery 5P.

The IQ Combiner 5/5C, along with IQ Series Microinverters, IQ System Controller 3/3G, and IQ Battery 5P provides you with a complete grid-agnostic Enphase Energy System.



IQ Series Microinverters
The high-powered smart grid-ready IQ Series Microinverters (IQ6, IQ7, and IQ8 Series) dramatically simplify the installation process.



IQ System Controller 3/3G
Provides microgrid interconnection device (MGID) functionality by automatically detecting grid failures and seamlessly transitioning the home energy system from grid power to backup power.



IQ Battery 5P
Fully integrated AC battery system. Includes six field-replaceable IQBD-BAT Microinverters.



IQ Load Controller
Helps prioritize essential appliances during a grid outage to optimize energy consumption and prolong battery life.



© 2023 Enphase Energy. All rights reserved. Enphase, the e and CC logos, IQ, and certain other marks listed at <https://enphase.com/trademark-usage-guidelines> are trademarks of Enphase Energy, Inc. in the US and other countries. Data subject to change.

IQO-5-5C-DSH-00007-2.0-EN-US-2023-09-27

MECHANICAL DATA	
Dimensions (WxHxD)	37.0 cm x 49.0 cm x 16.8 cm (14.7" x 19.3" x 6.6") Height is 21.0" (53.5 cm) with mounting brackets
Weight	7.5 kg (16.5 lb)
Ambient temperature range	-40°C to 46°C (-40°F to 115°F)
Cooling	Natural convection, plus heat shield
Enclosure environmental rating	Outdoor, NRTL-certified, NEMA type 3R, polycarbonate construction
Wire sizes	<ul style="list-style-type: none"> 20 A to 50 A breaker inputs: 14 to 4 AWG copper conductors 60 A breaker branch input: 4 to 1/2 AWG copper conductors Main lug combined output: 10 to 2 1/2 AWG copper conductors Neutral and ground: 14 to 1/2 copper conductors Always follow local code requirements for conductor sizing
Communication (in-premise connectivity)	Built-in CTRL board for wired communication with IQ Battery 5P and IQ System Controller 3/3G. Integrated Power Line Communication for IQ Series Microinverters
Altitude	Up to 2,600 meters (8,530 feet)
COMMUNICATION INTERFACES	
Integrated Wi-Fi	802.11b/g/n (dual band 2.4 GHz/5 GHz), for connecting the Enphase cloud via the internet
Wi-Fi range (recommended)	10 m
Bluetooth	BLE4.2, 10 m range to configure Wi-Fi SSID
Ethernet	Optional, 802.3, Cat5E (or Cat 6) UTP Ethernet cable (not included), for connecting to the Enphase Cloud via the internet
Mobile Connect	CELLMODEM-MI-06-SP-05 or CELLMODEM-MI-06-AT-05 (included with IQ Combiner 5C)
Digital I/O	Digital input/output for grid operator control
USB 2.0	For Mobile Connect
Access point (API) mode	For connection between the IQ Gateway and a mobile device running the Enphase Installer App
Metering ports	Up to two Consumption CTs, one IQ Battery CT, and one Production CT
Power line communication	90-110 kHz
Web API	Refer to https://developer.v4.enphase.com
Local API	Refer to guide for local API
COMPLIANCE	
IQ Combiner	UL 1741, CAN/CSA C22.2 No. 1071, Title 47 CFR, Part 15, Class B, ICES 003
IQ Gateway	UL 60961-1/CAN/CSA 22.2 No. 61010-1, IEEE 1547:2018 (UL 1741-SB, 3 rd Ed.) IEEE 2030.5/CSIP Compliant Production metering: ANSI C12.20 accuracy class 0.5 (PV production)
COMPATIBILITY	
IQ System Controller 3/3G	SC2000RMC340US0L, SC2000RMC340US0R
IQ Battery 5P	IQBATTERY-5P-IP-NA
Microinverter	IQ6, IQ7, and IQ8 Series Microinverters

IQO-5-5C-DSH-00007-2.0-EN-US-2023-09-27

IQ Combiner 5/5C

MODEL NUMBER	DESCRIPTION
IQ Combiner 5 (X-IQ-AMI-240-5)	IQ Combiner 5 with IQ Gateway printed circuit board for integrated revenue grade PV production metering (ANSI C12.20 ±0.5%), consumption monitoring (± 2.5%) and IQ Battery monitoring (±2.5%). Includes a silver solar shield to deflect heat.
IQ Combiner 5C (X-IQ-AMI-240-5C)	IQ Combiner 5C with IQ Gateway printed circuit board for integrated revenue grade PV production metering (ANSI C12.20 ±0.5%), consumption monitoring (±2.5%) and IQ Battery monitoring (±2.5%). Includes Enphase Mobile Connect cellular modem (CELLMODEM-MI-06-SP-05). Includes a silver solar shield to deflect heat.
WHAT'S IN THE BOX	
IQ Gateway printed circuit board	IQ Gateway is the platform for total energy management for comprehensive, remote maintenance and management of the Enphase IQ System.
Busbar	120A busbar with support for 1x IQ Gateway breaker and 4 x 20A breaker for installing IQ Series Microinverters and IQ Battery 5P.
IQ Gateway breaker	Circuit breaker, 2-pole, 10 A/15 A
Production CT	Pre-wired revenue-grade solid core CT, accurate up to 0.5%
Consumption CT	Two consumption metering clamp CTs, shipped with the box, accurate up to 2.5%
IQ Battery CT	One battery metering clamp CT, shipped with the box, accurate up to 2.5%
CTRL board	Control board for wired communication with IQ System Controller 3/3G and the IQ Battery 5P
Enphase Mobile Connect (only with IQ Combiner 5C)	4G-based LTE-M cellular modem (CELLMODEM-MI-06-SP-05) with a 5-year T-Mobile data plan
Accessories kit	Spare control headers for CTRL board
ACCESSORIES AND REPLACEMENT PARTS (NOT INCLUDED, ORDER SEPARATELY)	
CELLMODEM-MI-06-SP-05	4G-based LTE-M cellular modem with a 5-year T-Mobile data plan
CELLMODEM-MI-06-AT-05	4G-based LTE-M cellular modem with a 5-year AT&T data plan
Circuit breakers (off-the-shelf)	Supports Eaton BR210, BR215, BR220, BR230, BR240, BR250, and BR260 circuit breakers Supports Eaton BR220B, BR230B, and BR240B circuit breakers compatible with hold-down kit
Circuit breakers (provided by Enphase)	BRK-10A-2-240V, BRK-15A-2-240V, BRK-20A-2P-240V, BRK-15A-2P-240V-S, and BRK-20A-2P-240V-S (More details in "Accessories" section)
XA-SOLARSHIELD-ES	Replacement solar shield for IQ Combiner 5/5C
XA-ENV2-PCBA-5	IQ Gateway replacement printed circuit board (PCB) for Combiner 5/5C
X-IQ-NA-HD-125A	Hold-down kit compatible with Eaton BR-B series circuit breakers (with screws)
ELECTRICAL SPECIFICATIONS	
Rating	80 A
System voltage	120/240 VAC, 60 Hz
Busbar rating	125 A
Fault current rating	10 kAIC
Maximum continuous current rating (input from PV/storage)	64 A
Branch circuits (solar and/or storage)	Up to four 2-pole Eaton BR series distributed generation (DG) breakers only (not included)
Maximum total branch circuit breaker rating (input)	80 A of distributed generation/95 A with IQ Gateway breaker included
IQ Gateway breaker	10 A or 15 A rating GE/Siemens/Eaton included
Production metering CT	200 A solid core pre-installed and wired to IQ Gateway
Consumption monitoring CT (CT-200-CLAMP)	A pair of 200 A clamp-style current transformers is included with the box
IQ Battery metering CT	200 A, clamp-style current transformer for IQ Battery metering, included with the box

* A plug-and-play industrial-grade cell modem for systems up to 60 microinverters. (Available in the US, Canada, Mexico, Puerto Rico, and the US Virgin Islands, where there is adequate cellular service in the installation area.)

IQO-5-5C-DSH-00007-2.0-EN-US-2023-09-27

Revision history

REVISION	DATE	DESCRIPTION
DSH-00007-2.0	September 2023	Included Bluetooth specifications
DSH-00007-1.0	May 2023	Initial release



BEAM SOLAR CO.
1231 SHIELDS ROAD
STE. 5
KERNERSVILLE, NC 27284

SCOPE OF WORK:

TO INSTALL OF A 52 MODULE ROOF MOUNTED SOLAR PHOTOVOLTAIC SYSTEM AT THE OWNER RESIDENCE LOCATED AT 810 BUCHANAN RD THE POWER GENERATED BY THE PV SYSTEM WILL BE INTERCONNECTED WITH THE UTILITY GRID THROUGH THE EXISTING ELECTRICAL SERVICE EQUIPMENT. THE PV SYSTEM DOES NOT INCLUDE STORAGE BATTERIES.

MICHAEL DOESKEN
RESIDENCE
810 BUCHANAN RD
LILLINGTON, NC 27546
(1919)721-8311
MICHAEL.DOESKEN@GMAIL.COM
TMK: #

DRAWN BY: CHARLENE A.

DATE: 2024-09-18

REVISION:

NO.	DESCRIPTION	DATE

DATA SHEETS

MSD

© 2023 Enphase Energy. All rights reserved. Enphase, the e and CC logos, IQ, and certain other marks listed at <https://enphase.com/trademark-usage-guidelines> are trademarks of Enphase Energy, Inc. in the US and other countries. Data subject to change.

IQO-5-5C-DSH-00007-2.0-EN-US-2023-09-27




GF-1

COMPLETE MOUNT & FLASHING ASSEMBLY

GF-1 is our most versatile solution for composition shingle roofs. The flashing installs with a single fastener for a quick and easy installation. When the GF-1 Flashing with Grommet is paired with EcoFasten compression bracket, a watertight seal is created, maintaining the integrity of the roof.

FEATURES & BENEFITS

- Patented watertight technology
- Installs without removing shingles
- One lag bolt for a single-penetration attachment point
- Compatible with a variety of EcoFasten compression brackets
- Florida Product Approved for any combination of 8"x12" GF-1 flashing with the ClickFit L-foot & Lag Screw

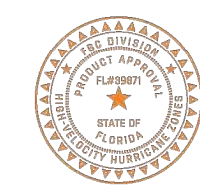

VERSATILE WATERTIGHT MOUNT THAT INSTALLS IN SECONDS

ECOFASTENSOLAR.COM

PRODUCT CUT SHEET



CF UNIV L-FOOT MLL 3"

PART NUMBER	DESCRIPTION
2012022	CF UNIV L-FOOT MLL 3"

ITEM NO.	DESCRIPTION
1	CLICKFIT L FOOT ASSEMBLY

1) CLICKFIT L FOOT ASSEMBLY

Material	Finish
Aluminum/Stainless Steel	Mill

REV.- CS1



GF-1

COMPLETE MOUNT & FLASHING ASSEMBLY

CONFIGURATION OPTIONS

1. CHOOSE YOUR FLASHING:



GF-1 Flashing, 8"x10", 8"x12", Black Finish

2. CHOOSE YOUR BRACKET:



ClickFit Universal L-Foot 3", Mill Finish



Open Slot L-Foot 3", Black Anodized



Conduit Bracket Comp



RockIt Smart Slide 4", Anodized Block

VIEW THE COMPLETE PARTS LIST

LEARN HOW TO USE OUR PRODUCTS
CLICK HERE: [ELEVATELEARNING.COM](https://www.elevatelearning.com)

4141 W. VAN BUREN ST, SUITE 2, PHOENIX AZ 85009
1-877-859-3947 | [INFO@ECOFASTENSOLAR.COM](mailto:info@ecofastensolar.com)

VERSION 2.1

PRODUCT CUT SHEET



LAG SCREW SS .313X4" W/BW (50)

PART NUMBER	DESCRIPTION
3016017	LAG SCREW SS .313X4" W/BW (50)

ITEM NO.	DESCRIPTION
1	LAG SCREW, 5/16-4", THREAD 3", EPDM BACKED WASHER

1) LAG SCREW, 5/16-4", THREAD 3", EPDM BACKED WASHER

Material	Finish
Stainless Steel/EPDM	Mill

REV.- CS1



BEAM SOLAR CO.
1231 SHIELDS ROAD
STE. 5
KERNERSVILLE, NC 27284

SCOPE OF WORK:

TO INSTALL OF A 52 MODULE ROOF MOUNTED SOLAR PHOTOVOLTAIC SYSTEM AT THE OWNER RESIDENCE LOCATED AT 810 BUCHANAN RD THE POWER GENERATED BY THE PV SYSTEM WILL BE INTERCONNECTED WITH THE UTILITY GRID THROUGH THE EXISTING ELECTRICAL SERVICE EQUIPMENT. THE PV SYSTEM DOES NOT INCLUDE STORAGE BATTERIES.

MICHAEL DOESKEN
RESIDENCE
810 BUCHANAN RD
LILLINGTON, NC 27546
(1919)721-8311
MICHAEL.DOESKEN@GMAIL.COM
TMK: #

DRAWN BY: CHARLENE A.


DATE: 2024-09-18

REVISION:

NO.	DESCRIPTION	DATE

DATA SHEETS

MSD

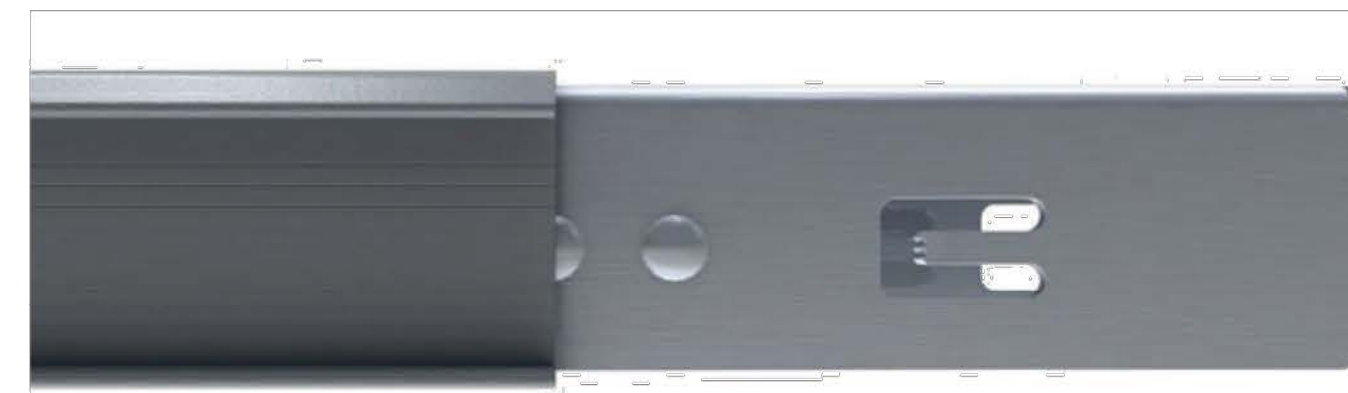

INTERNAL SPLICE
Tool-free bonded Internal Splice installs in seconds.

EBOS ACCESSORIES

Secure Module Level Power Electronics to the top of the rail using the ClickFit MLPE Mount. PV wires can be managed using the ClickFit Wire Clip and the ClickFit Wire Management Clamp.

Additional eBoS accessories are available.




MID CLAMP

Click-on Mid Clamp features integrated bonding pins and fits module frames from 30-50 mm-in-height.



END CLAMP

One Click-on End Clamp fits modules from 30-40mm in height.

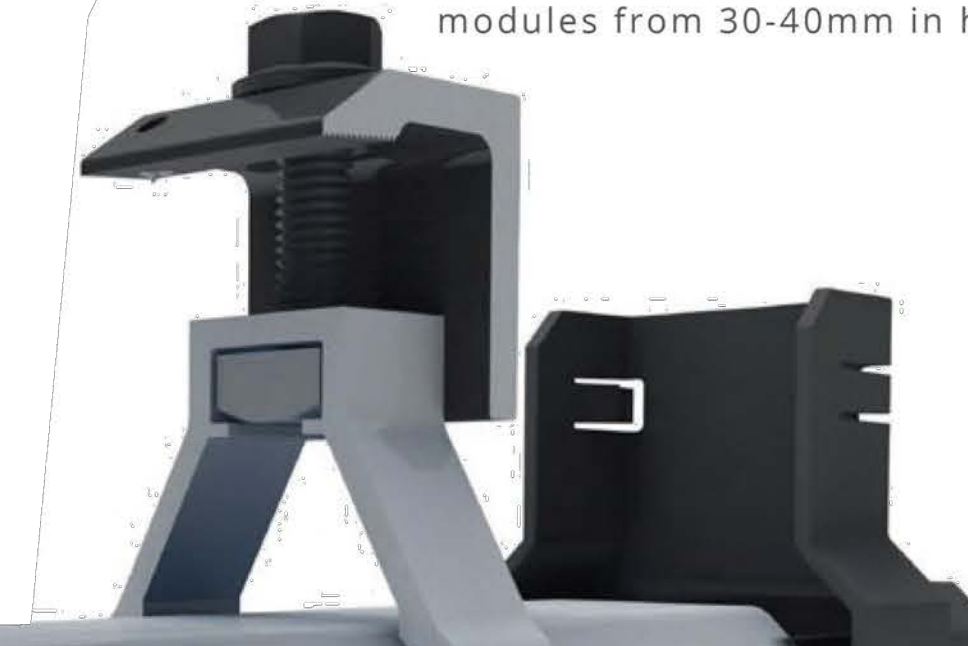

END CAP

Slide-on End Cap provide an aesthetic finish and allow for End Clamps to be accurately positioned on the rail in seconds.



RAIL

The ClickFit rail clicks into our proprietary composition shingle & tile L-foot and is tightened in place with a pre-installed bolt.




COMPLETE RAIL-BASED RACKING SYSTEM

ClickFit is one of the fastest installing rail-based systems in the industry. Thanks to its Click-In rail assembly, the rails can be connected to any of EcoFasten's composition shingle, tile, and standing seam metal roof mounts in seconds without the need for fasteners or tools. The ClickFit system is made of robust materials and coated steel, to ensure corrosion-resistance and longevity. ClickFit conforms to UL 2703 and has been tested in extreme weather conditions including wind, fire, and snow.

FEATURES & BENEFITS

- Pre-installed rail fastening bolt
- Fully integrated bonding
- Click-On Mid & End Clamps
- Compatible with a variety of EcoFasten roof attachments
- Florida Product Approved for composition shingle roofs

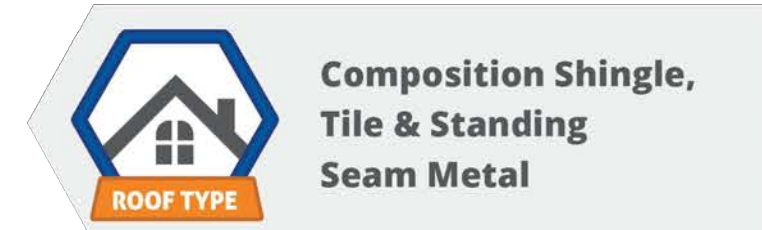

FAST INSTALLING SYSTEM FEATURING CLICK-IN RAIL ASSEMBLY

ECOFASTENSOLAR.COM



BEAM SOLAR CO.
1231 SHIELDS ROAD
STE. 5
KERNERSVILLE, NC 27284

SCOPE OF WORK:

TO INSTALL OF A 52 MODULE ROOF MOUNTED SOLAR PHOTOVOLTAIC SYSTEM AT THE OWNER RESIDENCE LOCATED AT 810 BUCHANAN RD THE POWER GENERATED BY THE PV SYSTEM WILL BE INTERCONNECTED WITH THE UTILITY GRID THROUGH THE EXISTING ELECTRICAL SERVICE EQUIPMENT. THE PV SYSTEM DOES NOT INCLUDE STORAGE BATTERIES.

MICHAEL DOESKEN
RESIDENCE
810 BUCHANAN RD
LILLINGTON, NC 27546
(1919)721-8311
MICHAEL.DOESKEN@GMAIL.COM
TMK: #

DRAWN BY: CHARLENE A.

DATE: 2024-09-18

REVISION:

NO.	DESCRIPTION	DATE

DATA SHEETS

MSD

MICHAEL DOESKEN'S SUNCO BILL OF MATERIALS

ELECTRICAL

ITEM	MANUFACTURER MODEL NO.	QTY
MODULE	Q.PEAK DUO BLK ML-G10+ 400W MODULES	52
INVERTER	ENPHASE IQ8PLUS-72-2-US (240V) MICROINVERTER	52
JUNCTION BOX	600VDC NEMA 3R UL LISTED JUNCTION BOX	3
COMBINER	ENPHASE COMBINER X-IQ-AM1-240-5C	1
COMBINER BREAKER	20A	4
BATTERY	N/A	N/A
CONTROLLER	N/A	N/A
SMART SWITCH	N/A	N/A
AC DISCONNECT	EATON DG223NRB FUSED DISCONNECT	2
AC DISCONNECT FUSES	80A	2
TAP CONNECTORS	POLARIS ITC-3/0	3
Q-CABLE	ENPHASE CABLE Q-12-20-200	68
SEALING CAP	ENPHASE Q-SEAL-10	13
TERM CAPS	ENPHASE Q-TERM-10	4



BEAM SOLAR CO.
1231 SHIELDS ROAD
STE. 5
KERNERSVILLE, NC 27284

SCOPE OF WORK:

TO INSTALL OF A 52 MODULE ROOF MOUNTED SOLAR PHOTOVOLTAIC SYSTEM AT THE OWNER RESIDENCE LOCATED AT 810 BUCHANAN RD THE POWER GENERATED BY THE PV SYSTEM WILL BE INTERCONNECTED WITH THE UTILITY GRID THROUGH THE EXISTING ELECTRICAL SERVICE EQUIPMENT. THE PV SYSTEM DOES NOT INCLUDE STORAGE BATTERIES.

RACKING

ITEM	MANUFACTURER MODEL NO.	QTY
FLASHING	ECOFASTEN CF SMART MNT W/ CLKR AL MLL (RAFTER) 2012028	123
RAILING	ECOFASTEN CLICKFIT STD RAIL 2012025	32
RAIL SPLICE	ECOFASTEN CF RAIL SPLICE 2012013	24
T BOLT	N/A	N/A
ENDS	ECOFASTEN CF END CLAMP 30-40MM BLK 2099022	28
MIDS	ECOFASTEN CF MID CLAMP SHORT BLK 2099039	90
MICROINVERTER BOLT	ECOFASTEN CF MLPE MOUNT 2012019	52
DECK SCREWS	N/A	N/A
GROUND LUGS	ECOFASTEN MODULE JUMPER 4011011 / GROUND LUG (NON ECOFASTEN)	18

MICHAEL DOESKEN
RESIDENCE
810 BUCHANAN RD
LILLINGTON, NC 27546
(1919)721-8311
MICHAEL.DOESKEN@GMAIL.COM
TMK: #

DRAWN BY: CHARLENE A.

DATE: 2024-09-18

REVISION:

NO.	DESCRIPTION	DATE

BILL OF MATERIALS

BOM

MISC

ITEM	MANUFACTURER MODEL NO.	QTY
OTHER	N/A	N/A
MISC	N/A	N/A