PHOTOVOLTAIC ROOF MOUNT SYSTEM

24 MODULES-ROOF MOUNTED - 9.720 kW DC, 7.600 kW AC

48 BETTY ANN ST, DUNN, NC 28334

PROJECT DATA	GENERAL NOTES	VICIN
PROJECT DATA PROJECT 48 BETTY ANN ST, ADDRESS: DUNN, NC 28334 OWNER: MICHELLE STATON DESIGNER: ESR SCOPE: 9.720 kW DC ROOF MOUNT SOLAR PV SYSTEM WITH 24 JA SOLAR: JAM54S31-405/MR 405W PV MODULES WITH 24 SOLAREDGE: S440 POWER OPTIMIZERS AND 01 SOLAREDGE: SE7600H-US (240V/7600W) INVERTER 01 10 kWh SOLAREDGE ENERGY BANK AUTHORITIES HAVING JURISDICTION: BUILDING: HARNETT COUNTY UTILITY: DUKE ENERGY PROGRESS SHEET INDEX PV-1 PV-1 COVER SHEET PV-2 PV-3 PV-4 ELECTRICAL LINE DIAGRAM PV-3 PV-4 ELECTRICAL LINE DIAGRAM PV-7 PV-8 LABELS PV-9 PV-9 PV-10+ EQUIPMENT SPECIFICATIONS	 ALL COMPONENTS ARE UL LISTED AND CEC CERTIFIED, WHERE WARRANTED. THE SOLAR PV SYSTEM WILL BE INSTALLED IN ACCORDANCE WITH ARTICLE 690 OF THE NEC 2017. THE UTILITY INTERCONNECTION APPLICATION MUST BE APPROVED AND PV SYSTEM INSPECTED PRIOR TO PARALLEL OPERATION. ALL CONDUCTORS OF A CIRCUIT, INCLUDING THE EGC, MUST BE INSTALLED IN THE SAME RACEWAY, OR CABLE, OR OTHERWISE RUN WITH THE PV ARRAY CIRCUIT CONDUCTORS WHEN THEY LEAVE THE VICINITY OF THE PV ARRAY. WHERE METALLIC CONDUIT CONTAINING DC CONDUCTORS IS USED INSIDE THE BUILDING, IT SHALL BE IDENTIFIED AS "CAUTION: SOLAR CIRCUIT" EVERY 10FT. HEIGHT OF THE AC DISCONNECT SHALL NOT EXCEED 6'-7" PER NEC CODE 240.24. 	VICIN Unite 48 Bet Dunn, 1 Unite Unite Unite CODE RI 2018 NORTH CAROLINA 2018 NORTH CAROLINA 2018 NORTH CAROLINA 2017 NATIONAL ELECTR



PROJECT DESCRIPTION:

24 X JA SOLAR: JAM54S31-405/MR 405W MONO MODULES ROOF MOUNTED SOLAR PHOTOVOLTAIC MODULES DC SYSTEM SIZE: 9.720 kW DC AC SYSTEM SIZE: 7.600 kW AC

EQUIPMENT SUMMARY

24 JA SOLAR: JAM54S31-405/MR 405W MONO MODULES 24 SOLAREDGE: S440 POWER OPTIMIZERS 01 SOLAREDGE: SE7600H-US (240V/7600W) INVERTER 01 10 kWh SOLAREDGE ENERGY BANK

ROOF ARRAY AREA #1:- 231.11 SQ FT. ROOF ARRAY AREA #2:- 273.13 SQ FT. NOTE: VISIBLE, LOCKABLE, LABELED AC DISCONNECT LOCATED WITHIN 10' OF UTILITY METER

BETTY ANN ST 100.60 PROPERTY LINE PROPERTY LINE EXISTING DRIVEWAY 202.30' 201.30' (E) UTILITY METER/MAIN COMBO (N) VISIBLE, LOCKABLE, 2-STORY HOUSE LABELED FUSED AC DISCONNECT (E) SUBPANEL Ϋ́Α` (LOCATED WITHIN 10' OF UTILITY METER) (INSIDE GARAGE) (N) BACKUP LOAD PANEL ROOF #1 (N) BACKUP INTERFACE (11) JA SOLAR: JAM54S31-405/MR 405W MONO MODULES WITH (N) SOLAREDGE: SE7600H-US SOLAREDGE: S440 POWER OPTIMIZERS (240V/7600W) INVERTER (N) 10 kWh SOLAREDGE ENERGY BANK

PROPERTY LINE

SOLAREDGE: S440 POWER OPTIMIZERS

(13) JA SOLAR: JAM54S31-405/MR

405W MONO MODULES WITH


101.60'

ROOF #2

PROPERTY LINE

DESIGN SPECIFICATION OCCUPANCY: II CONSTRUCTION: SINGLE-FAMILY **ZONING: RESIDENTIAL**




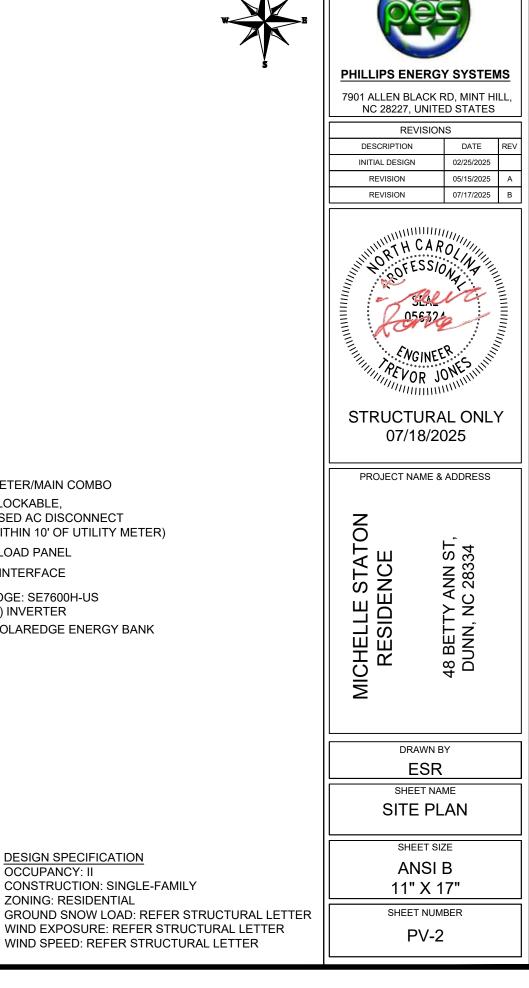

MODULE TYPE, DIMENSIONS & WEIGHT

NUMBER OF MODULES = 24 MODULES MODULE TYPE = JA SOLAR: JAM54S31-405/MR 405W MONO MODULES MODULE WEIGHT = 47.39 LBS / 21.5 kg. MODULE DIMENSIONS = 67.79" x 44.64" = 21.01 SF



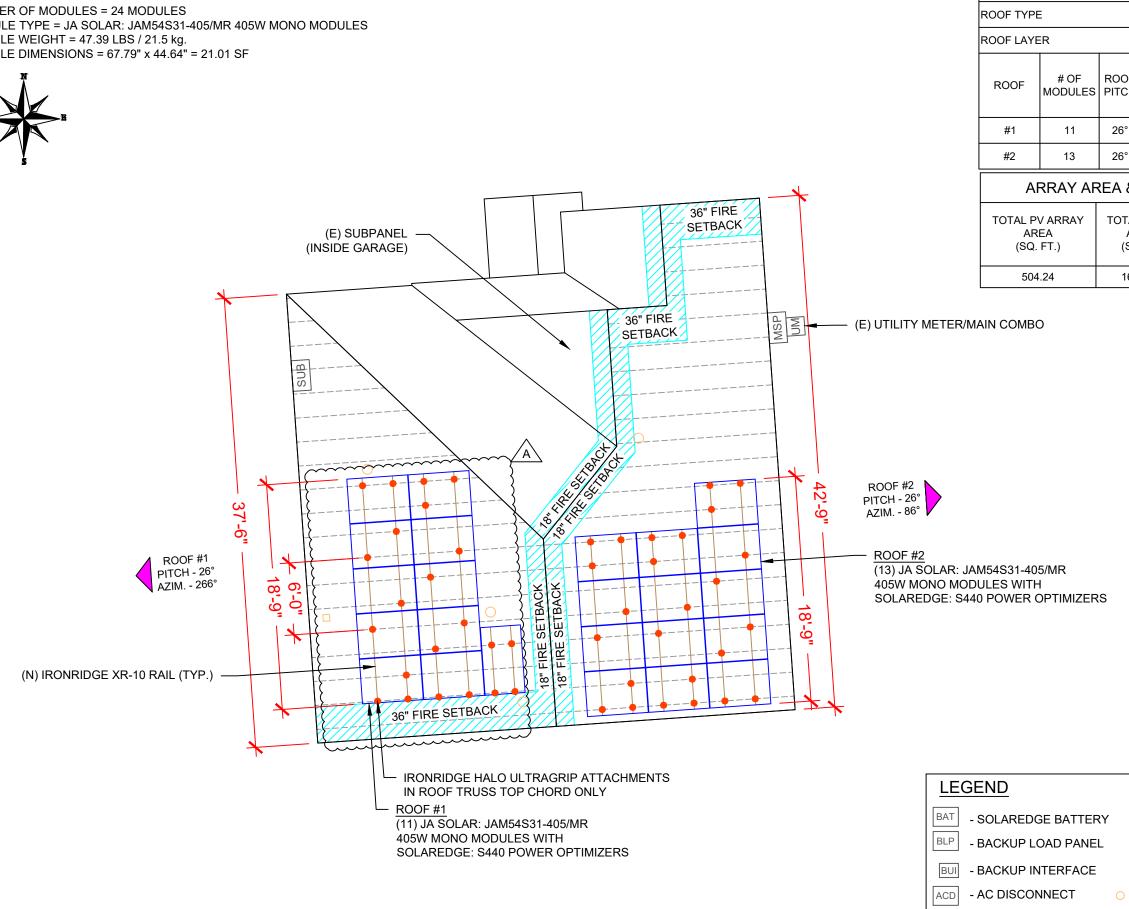

ROOF PLAN & MODULES SCALE: 1/8" = 1'-0"

1

F DESCRIP				Comments of the local division of the local
	ASPHALT	SHINGLE		
	1 LA	YER		
	TRUSS SIZE	TRUSS SPACING	PHILLIPS E	NERGY SYSTEMS
26° 266°	2"X4"	24"		BLACK RD, MINT HILL, , UNITED STATES
26° 86°	2"X4"	24"	R DESCRIPTIO	EVISIONS N DATE REV
A & ROOF A		C'S	INITIAL DESIG	
TOTAL ROOF AREA (Sq. Ft.)	ROO AREA COV ARRA	ERED BY	REVISION	07/17/2025 B
1628.49	3,	1	STRUCT	CAROLINE ESSIONA SEASONA VGINEER OR JONES TURAL ONLY 18/2025
			PROJECT	NAME & ADDRESS
	44. 62.29 JA SO JAM54S31 405W MC	LAR: -405/MR	MICHELLE STATON RESIDENCE	48 BETTY ANN ST, DUNN, NC 28334
				RAWN BY ESR
	UB PANEL		ROO	ESK EET NAME F PLAN & DULES
○ □ - V (R0	JNCTION BC ENT, ATTIC DOF OBSTRI	FAN UCTION)	А	ieet size NSI B " X 17"
T	OOF ATTAC RUSS ONDUIT	HMENI		et number PV-3


ROOF

- UTILITY METER

- MAIN SERVICE PANEL

им 🛛

MSP

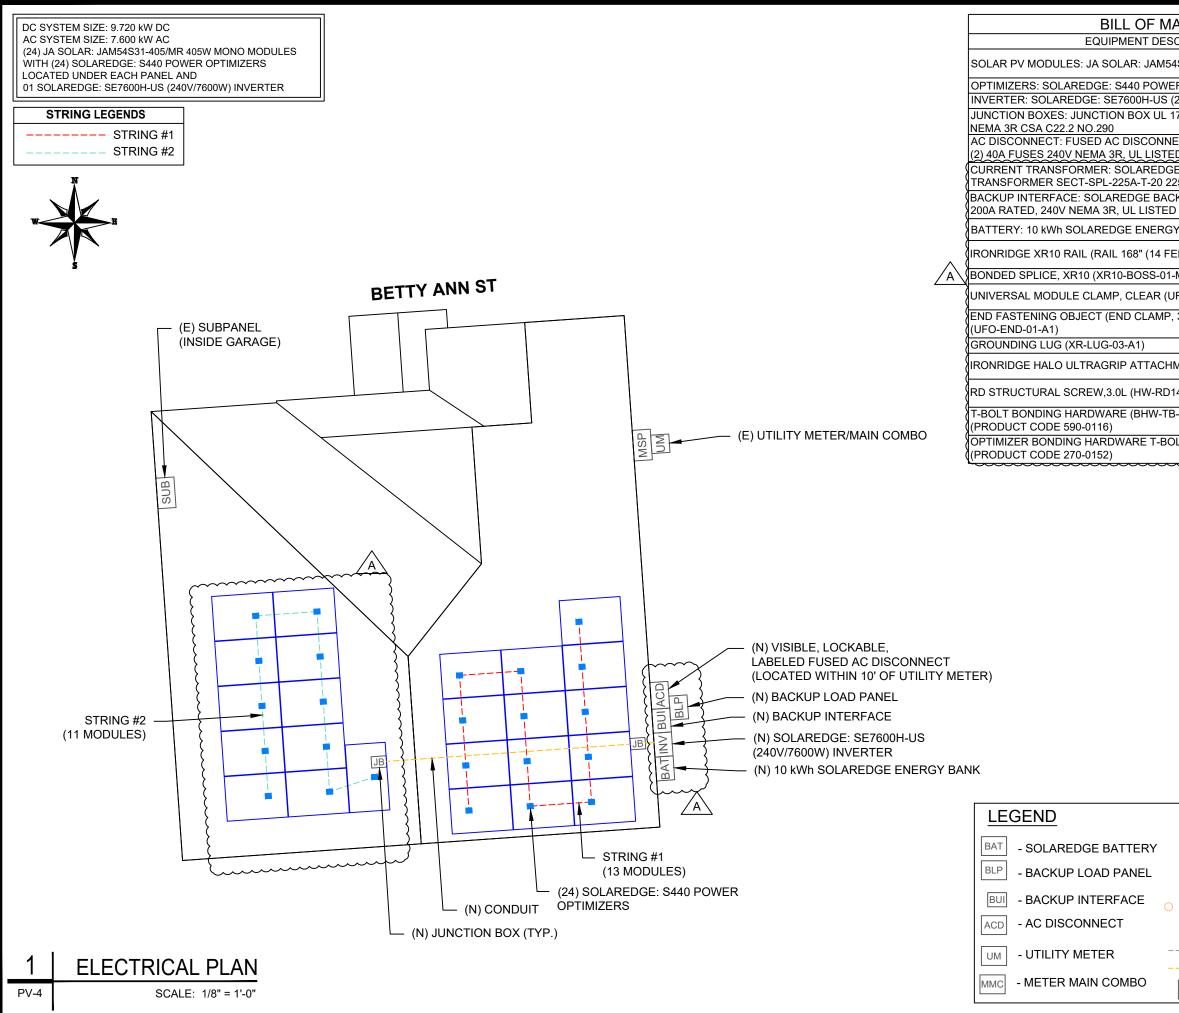

ATERIALS	
CRIPTION	QTY
4S31-405/MR 405W MODULE	24
ROPTIMIZERS	24
240V/7600W) INVERTER	01
741,	2
ECT, 60A FUSED, D	1
E SLIM CURRENT 25A RATED, 240V	1
KUP INTERFACE BI-NUSGN-01	1
Y BANK	1
EET) CLEAR) (XR-10-168A)	22
M1)	10
FO-CL-01-A1)	36
30-40MM), MILL	24
	6
MENTS (QM-HUG-01-M1)	46
430-01-M1)	92
B-02-A1)	46
LT (BHW-MI-01-A1)	24



PHILLIPS ENERGY SYSTEMS

7901 ALLEN BLACK RD, MINT HILL NC 28227, UNITED STATES

REVISIONS							
DESCRIPTION	DATE	REV					
INITIAL DESIGN	02/25/2025						
REVISION	05/15/2025	А					
REVISION	07/17/2025	В					

PROJECT NAME & ADDRESS

MICHELLE - INVERTER INV ELECTRICAL PLAN - JUNCTION BOX - VENT, ATTIC FAN (ROOF OBSTRUCTION) - ROOF ATTACHMENT - TRUSS - CONDUIT SUB - SUB PANEL



DRAWN BY

ESR

SHEET SIZE


ANSI B

11" X 17"

SHEET NUMBER

PV-4

SHEET NAME

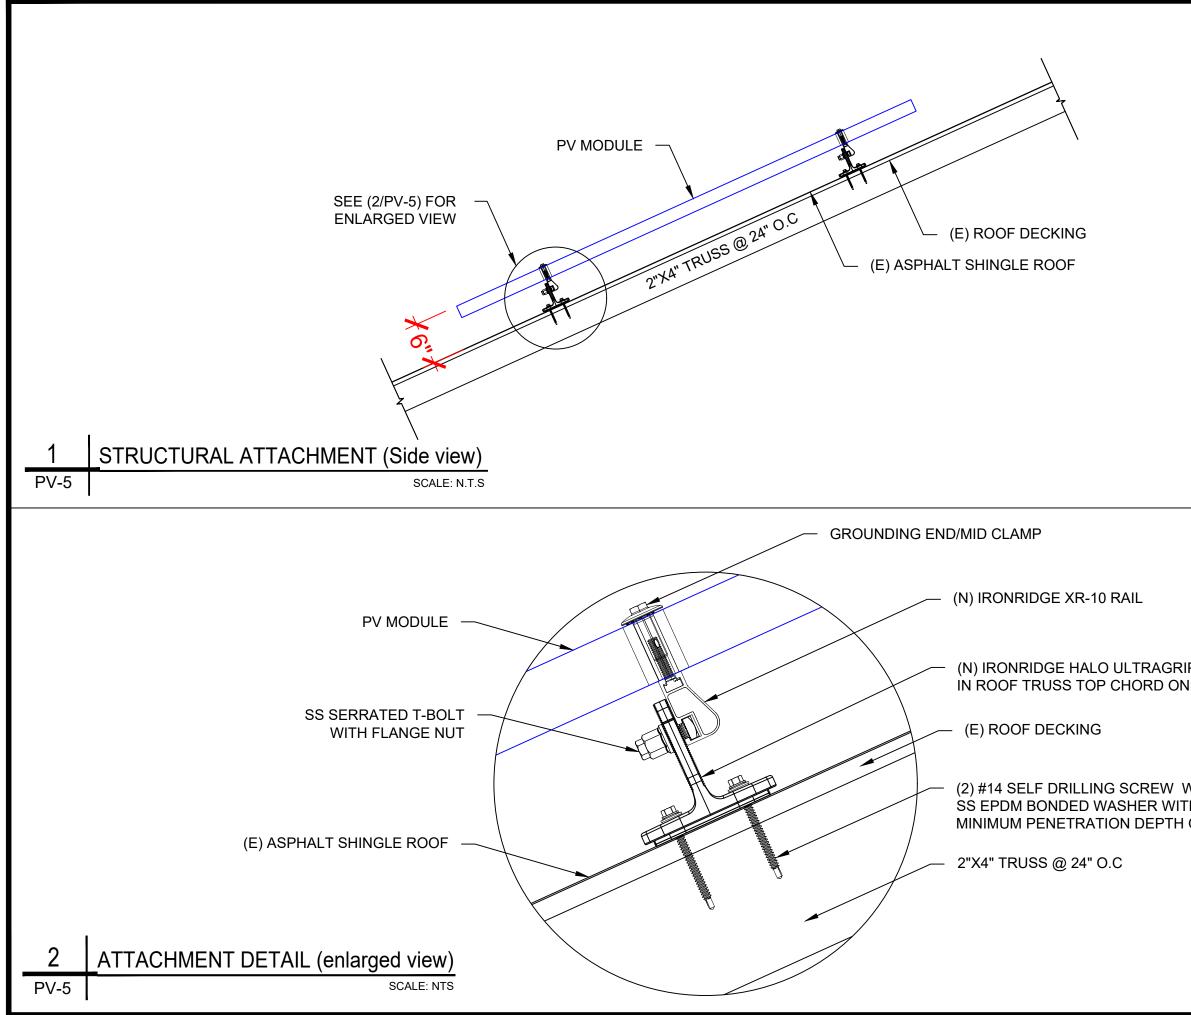

	PHILLIPS ENER 7901 ALLEN BLACK NC 28227, UNIT	RD, MINT HILL,
	DESCRIPTION	DNS DATE REV
	INITIAL DESIGN	02/25/2025
	REVISION	05/15/2025 A
	REVISION	07/17/2025 B
	STRUCTUR 07/18/2	ROLINI
	07/18/2	2025
	PROJECT NAME	& ADDRESS
IP ATTACHMENT NLY	MICHELLE STATON RESIDENCE	48 BETTY ANN ST, DUNN, NC 28334
W/ TH A		
OF 1.75"	ESI	
	STRUCTURA	
	SHEET	SIZE
	ANS 11" X	
	SHEET NU	MBER
	PV-	5

DC SYSTEM SIZE: 9.720 kW DC AC SYSTEM SIZE: 7.600 kW AC

(24) JA SOLAR: JAM54S31-405/MR 405W MONO MODULES WITH (24) SOLAREDGE: S440 POWER OPTIMIZERS LOCATED UNDER EACH PANEL (240V) AND (01) SOLAREDGE: SE7600H-US (240V/7600W) INVERTER (01) STRING OF 13 MODULES AND (01) STRING OF 11 MODULES ARE CONNECTED IN SERIES

BACKFEED BREAKER CALCULATION (120% RULE): (MAIN BUS X 1.2 - MAIN BREAKER) >= (PV BREAKER) (200A X 1.2 - 200A) >= (40A) (40A) >= (40A) HENCE OK

INTERCONNECTION NOTES:

1. INTERCONNECTION SIZING, LIMITATIONS AND COMPLIANCE DETERMINED IN ACCORDANCE WITH [NEC 705.12], AND [NEC 690.59]. 2. GROUND FAULT PROTECTION IN ACCORDANCE WITH [NEC 215.9], [NEC 230.95].

 ALL EQUIPMENT TO BE RATED FOR BACKFEEDING.
 PV BREAKER TO BE POSITIONED AT THE OPPOSITE END OF THE BUSBAR RELATIVE TO THE MAIN BREAKER.

DISCONNECT NOTES:

1. DISCONNECTING SWITCHES SHALL BE WIRED SUCH THAT WHEN THE SWITCH IS OPENED THE CONDUCTORS REMAINING LIVE ARE CONNECTED TO THE TERMINALS MARKED "LINE SIDE" (TYPICALLY THE UPPER TERMINALS)

2. AC DISCONNECT MUST BE ACCESSIBLE TO QUALIFIED UTILITY PERSONNEL, BE LOCKABLE, AND BE A VISIBLE-BREAK SWITCH 3. DISCONNECT MEANS AND THEIR LOCATION SHALL BE IN ACCORDANCE WITH [NEC 225.31] AND [NEC 225.32].

GROUNDING & GENERAL NOTES:

1. PV GROUNDING ELECTRODE SYSTEM NEEDS TO BE INSTALLED IN ACCORDANCE WITH [NEC 690.43]

2. PV INVERTER IS UNGROUNDED, TRANSFORMER-LESS TYPE.

3. DC GEC AND AC EGC TO REMAIN UNSPLICED, OR SPLICED TO EXISTING ELECTRODE


4. ANY EXISTING WIRING INVOLVED WITH PV SYSTEM CONNECTION THAT IS FOUND TO BE INADEQUATE PER CODE SHALL BE CORRECTED PRIOR TO FINAL INSPECTION.

5. JUNCTION BOX QUANTITIES, AND PLACEMENT SUBJECT TO CHANGE IN THE FIELD - JUNCTION BOX DEPICTED ON ELECTRICAL DIAGRAM REPRESENT WIRE TYPE TRANSITIONS.

6. AC DISCONNECT NOTED IN EQUIPMENT SCHEDULE OPTIONAL IF OTHER AC DISCONNECTING MEANS IS LOCATED WITHIN 10' OF SERVICE DISCONNECT. 7. RACEWAYS AND CABLES EXPOSED TO SUNLIGHT ON ROOFTOPS SHOULD BE INSTALLED MORE THAN 7/8" ABOVE THE ROOF USING CONDUIT SUPPORTS.

RACKING NOTE:

1. BOND EVERY OTHER RAIL WITH #6 BARE COPPER

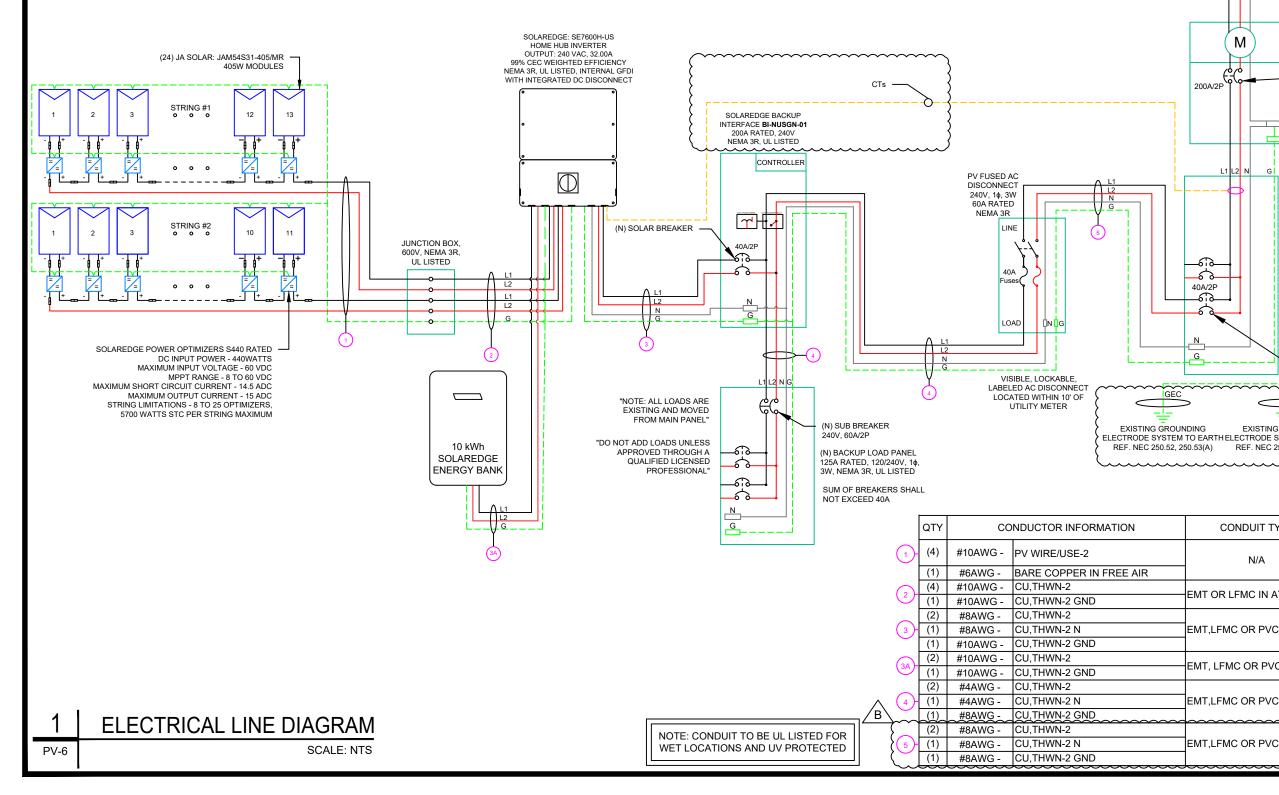



PHILLIPS ENERGY SYSTEMS

7901 ALLEN BLACK RD, MINT HILL NC 28227, UNITED STATES

				, -		
			F	REVISION	S	
			DESCRIPTI		DATE	REV
			INITIAL DES	IGN	02/25/2025	
TO UTILITY GRID			REVISION	N	05/15/2025	А
L1 L2 N			REVISION		07/17/2025	В
M UTILIT 120/240 (E) MA HOUSI N (E) MA HOUSI	ECTIONAL Y METER OV 1¢, 3-W IN BREAKER TO E 240 V,200A/2P AIN SERVICE IL, RATED, 240V					
BACK-FI INTERCI SUB PAI PER AR BACK-FE REF	D-QO TED, 240V EED ONNECTION AT NEL T. 705.12 EED BREAKER C 705.12(B)(2)(3)(b))	MICHELLE STATON RESIDENCE		48 BETTY ANN ST, DUNN, NC 28334	
CONDUIT TYPE	CONDUIT SIZE					
N/A	N/A]	DRAWN B	Y	
IT OR LFMC IN ATTIC	3/4"			HEET NAM	ИF	
IT,LFMC OR PVC	3/4"		ELECTRIC			AM
IT, LFMC OR PVC	3/4"			SHEET SIZ		
IT,LFMC OR PVC	1"		1	1" X 1	7"	
IT,LFMC OR PVC	3/4"	$\left\{ \right\}$		EET NUME PV-6	DEK	

																	T TEL 10					
	SOLAR MC	DULE SF	PECIFICAT	IONS			INVERTER SPECIFICATIONS					AMBIENT TEMPERATURE SPECS										
							MANUFACTURER / MODEL # SOLAREDGE: SE7600H-US (240V/7600W)					AMBIENT TEMP (HIGH TEMP 2%)					38°					
MANUFACTURER / MODEL # JA SOLAR: JAM54S31-405/MR 405W MODULE				INVERTER RE				RECOR	D LOW TEMF	PERATUR	RE			-8°								
							-	NAL AC POWE		7.600						E TEMPERA	TURE CO	EFFICIEN	IT OF Voc	-0.275	%/°C	
VMP		.21V				L	NOMIN	VAL OUTPUT \	/OLTAGE	240 V	-											
	-					L	NOMIN	NAL OUTPUT (CURRENT	32.00	A											
IMP		2.98A				ī	DED	CENT OF	NUIN	MBER OF C		г	7									
VOC	-	7.23V						ALUES		IG CONDU												
ISC		8.87A				[-	• • • • • • • • • • • • • • • • • • • •	.80	0/ 11 (111)	4-6	010101		-									
TEMP. COEFF.		.275%/°C						.70		7-9			-									
MODULE DIME	ENSION 67	7.79"L x 44	.64"W x 1.1	18"D (In In	ich)			.50		10-20)		-1									
						L		.50		10-20)		_									
											DC FE	EDER CALCU	JLATIONS									
	CIRCUIT DESTINATIO	DN VOLTAG (V)	E FULL LOAD AMPS "FLA (A)	EI A *1 2	5 OCPD SIZE (A)	GROUND	SIZE	CONDUCTOR S	IZE AMPAC (A)			BIENT COI IP. (°C)		90°C PACITY (A)	DERATION FACT FOR AMBIEN TEMPERATURE 310.15(B)(2)(a	T FOR COND	UCTORS VAY NEC	90°C AMPA DERATED (ENGTH RES	NDUC SISTA HM/K
STRING 1	JUNCTION BOX	380	15.00	18.75	20	BARE COPPER	#6 AWG	CU #10 AW0	G 35	PAS	SS	38	2	40	0.91	1		36.4	P	PASS	5	1.24
STRING 2	JUNCTION BOX	380	15.00	18.75	20	BARE COPPER	#6 AWG	CU #10 AWG	6 35	PAS	SS	38	2	40	0.91	1		36.4	P	PASS	5	1.24
JUNCTION BOX	INVERTER	380	15.00	18.75	20	CU #10 A	WG	CU #10 AWG	a 35	PAS	SS	38	4	40	0.91	0.8	3	29.12	P	PASS	30	1.24
SOLAREDGE BANK	INVERTER	380	13.16	16.45	20	CU #10 A	WG	CU #10 AWG	G 35	PAS	SS	38	2	40	0.91	1		36.4	P	PASS	5	1.24
																					String 1 Voltag	ge Dr
																					String 2 Voltag	ge Dr
	~~~~~~~~~~~~~~~~~~~~~~~~~~~~~~~~~~~~~~~														В							
	*****	****		****	· • • • •	*****	****	*****	*****	*****		EDER CALCU		****	******	*****		*****	****		*****	**
<u>۲</u>															D	RATION FACTOR			90°C			
	CIRCUIT DESTINATION	VOLTAGE (V)	FULL LOAD AMPS "FLA" (A)	FLA*1.25 (A)	OCPD SIZE (A)	NEUTRAL SIZE	:	GROUND SIZE	CONDUCTOR SIZE	75°C AMPACITY (A)		Y AMBIEN L TEMP. (°	CONDUCT	DRS 90°C		FOR AMBIENT MPERATURE NEC 310.15(B)(2)(a)	FOR CON	DUCTORS A	MPACITY	AMPACITY CHECK #2	FEEDER LENGTH (FEET)	A
	BACKUP INTERFACE	240	32	40	40	CU #8 AWG		CU #10 AWG	CU #8 AWG	50	PASS	38	2		55	0.91	1		50.05	PASS	5	
	BREACH INTERNACE	- 10	52	.0		00 10 1000		00 H10 HW0	CO NO ANO	50		50	-			0.51		-	55.55	17.00	5	

85

85

50

CU #4 AWG

CU #4 AWG

CU #8 AWG

PASS

PASS

PASS

38

38

38

95

95

0.91

0.91

0.91

CUMULATIVE V

PASS

PASS

PASS

86.45

50.05

86.45

#### ELECTRICAL NOTES

BACKUP INTERFACE BACKUP LOAD PANEL 240

AC DISCONNECT

BACKUP INTERFACE AC DISCONNECT 240 32

POI

1. ALL EQUIPMENT TO BE LISTED BY UL OR OTHER NRTL, AND LABELED FOR ITS APPLICATION.

60

40

40

60

40

40

CU #4 AWG

CU #4 AWG

CU #8 AWG

CU #8 AWG

CU #8 AWG

CU #8 AWG

60

32

240

- 2. ALL CONDUCTORS SHALL BE RATED UPTO 600V FOR RESIDENTIAL AND 1000V FOR COMMERCIAL AND 90 DEGREE C WET ENVIRONMENT.
- 3. WIRING, CONDUIT, AND RACEWAYS MOUNTED ON ROOFTOPS SHALL BE ROUTED DIRECTLY TO, AND LOCATED AS CLOSE AS POSSIBLE TO THE NEAREST RIDGE, HIP, OR VALLEY.
- 4. WORKING CLEARANCES AROUND ALL NEW AND EXISTING ELECTRICAL EQUIPMENT SHALL COMPLY WITH NEC 110.26.
- 5. DRAWINGS INDICATE THE GENERAL ARRANGEMENT OF SYSTEMS. CONTRACTOR SHALL FURNISH ALL NECESSARY OUTLETS, SUPPORTS, FITTINGS AND ACCESSORIES TO FULFILL APPLICABLE CODES AND STANDARDS.
- 6. WHERE SIZES OF JUNCTION BOX, RACEWAYS, AND CONDUITS ARE NOT SPECIFIED, THE CONTRACTOR SHALL SIZE THEM ACCORDINGLY.
- 7. ALL WIRE TERMINATIONS SHALL BE APPROPRIATELY LABELED AND READILY VISIBLE.
- 8. MODULE GROUNDING CLIPS TO BE INSTALLED BETWEEN MODULE FRAME AND MODULE SUPPORT RAIL, PER THE GROUNDING CLIP MANUFACTURER'S INSTRUCTION.
- 9. MODULE SUPPORT RAIL TO BE BONDED TO CONTINUOUS COPPER G.E.C. VIA WEEB LUG OR ILSCO GBL-4DBT LAY-IN LUG.
- 10. TEMPERATURE RATINGS OF ALL CONDUCTORS, TERMINATIONS, BREAKERS, OR OTHER DEVICES ASSOCIATED WITH THE SOLAR PV SYSTEM SHALL BE RATED FOR AT LEAST 75 DEGREE C.



#### PHILLIPS ENERGY SYSTEMS

7901 ALLEN BLACK RD, MINT HILL, NC 28227, UNITED STATES

						_ I		110 20	<i>5221</i> , 01111	DUIAILO	
						1			REVISION	١S	
							F	DESCR		DATE	REV
ים	JCTOR						-				
	ANCE		GE DROP	CONDUIT	CONDUIT			INITIAL [		02/25/2025	<u> </u>
	/KFT)	ATI	FLA (%)	SIZE	FILL (%)			REVIS	SION	05/15/2025	A
	24	-	0.049	N/A	#NI/A			REVIS	SION	07/17/2025	В
_	24 24		).049 ).049	N/A N/A	#N/A #N/A						
-	24		).294	3/4" EMT	19.79362						
_	24		0.043	3/4" EMT	11.87617						
	Drop		0.343			•					
_	Drop Drop		0.343								
				I							
~	~~~~	~~~~	~~~~	~~~~~	~~~~						
			I			}					
	CONDU RESIST <i>A</i> (OHM/	ANCE	VOLTAGE DROP AT FLA (%)	CONDUIT SIZE	CONDUIT FILL (%)						
	0.77	8	0.104	3/4" EMT	24.5591	긹					
	0.30		0.077	1" EMT	32.8472	λ					
	0.30		0.041	1" EMT	32.8472	김					
	0.77	8	0.104	3/4" EMT	27.4672	۶I					
v	OLTAGE DE	ROP	0.104	]		3					
	·····	~~~	~~~~		~~~~						
							Γ	PROJE	ECT NAME &	ADDRESS	
								MICHELLE STATON RESIDENCE			
								0			
									I I	2 2 2	
								_ ₹ ^µ	5	48 BETTY ANN ST DUNN, NC 28334	
								F 5	•	≤ ∞	
								() <u>Z</u>	7		
								ш	L	いい	
									נ	í Z	
									)	Ŀź	
								Шй	j	ШZ	
								T R		≝ ⊇	
								U -	-	4 D	
								Ĭ		-	
								2			
							Γ		DRAWN E	3Y	
							L		ESR		
									SHEET NA	ME	
							\	WIRING	G CALCI	JLATION	1S
							Γ		SHEET SI		
									ANSI	_	
									11" X 1	7"	
							Γ	:	SHEET NUM	IBER	
									PV-7		
							1				

# PHOTOVOLTAIC POWER SOURCE

#### EVERY 10' ON CONDUIT & ENCLOSURES

LABEL- 1: <u>LABEL LOCATION:</u> DC/EMT CONDUIT RACEWAY SOLADECK / JUNCTION BOX CODE REF: NEC 690.31 (D)(2)

# 

# ELECTRIC SHOCK HAZARD

TERMINALS ON THE LINE AND LOAD SIDES MAY BE ENERGIZED IN THE OPEN POSITION

LABEL- 2: <u>LABEL LOCATION:</u> AC DISCONNECT CODE REF: NEC 690.13(B)

# 

DUAL POWER SUPPLY

SOURCE: UTILITY GRID AND PV SOLAR ELECTRIC SYSTEM

#### LABEL- 3: <u>LABEL LOCATION:</u> MAIN SERVICE PANEL CODE REF: NEC 705.12(C) & NEC 690.59

# SOLAR PV BREAKER:

# BREAKER IS BACKFED DO NOT RELOCATE


LABEL-4: <u>LABEL LOCATION:</u> MAIN SERVICE PANEL CODE REF: NEC 705.12(C) & NEC 690.59



LABEL- 5:

LABEL LOCATION: MAIN SERVICE PANEL (ONLY IF SOLAR IS BACK-FED) SUBPANEL (ONLY IF SOLAR IS BACK-FED) CODE REF: NEC 705.12(B)(3)(2)

# SOLAR PV SYSTEM EQUIPPED WITH RAPID SHUTDOWN

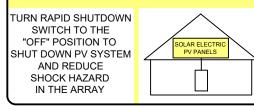


LABEL- 6: <u>LABEL LOCATION:</u> AC DISCONNECT CODE REF: [NEC 690.56(C)(1)(A)]

# RAPID SHUTDOWN SWITCH FOR SOLAR PV SYSTEM

LABEL- 7: <u>LABEL LOCATION:</u> INVERTER CODE REF: NEC 690.56(C)(2)

# DC DISCONNECT

LABEL- 8: LABEL LOCATION: INVERTER CODE REF: NEC 690.13(B)

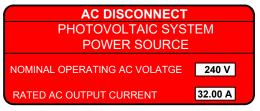

LABEL- 9: <u>LABEL LOCATION:</u> AC DISCONNECT CODE REF: NEC 690.54

MAXIMUM VOLTAGE	480 V
MAXIMUM CIRCUIT CURRENT	40.00 A
MAXIMUM RATED OUTPUT CURRENT OF THE CHARGE CONTROLLER OR DC-TO-DC CONVERTER (IF INSTALLED)	


LABEL- 10: <u>LABEL LOCATION:</u> ON THE RIGHT SIDE OF THE INVERTER (PRE-EXISTING ON THE INVERTER) CODE REF: NEC 690.53




## PHILLIPS ENERGY SYSTEMS

7901 ALLEN BLACK RD, MINT HILL NC 28227, UNITED STATES

REVISIONS							
DESCRIPTION	DATE	REV					
INITIAL DESIGN	02/25/2025						
REVISION	05/15/2025	А					
REVISION	07/17/2025	В					

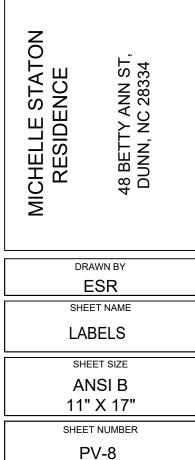

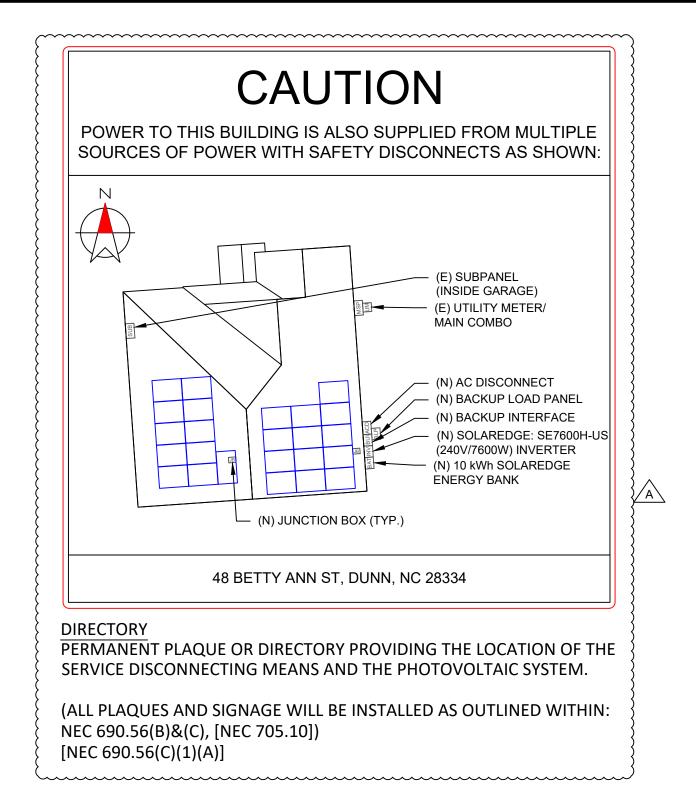

LABELING NOTES:

- 1. LABELS CALLED OUT ACCORDING TO ALL COMMON CONFIGURATIONS. ELECTRICIAN TO DETERMINE EXACT REQUIREMENTS IN THE FIELD PER CURRENT NEC AND LOCAL CODES AND MAKE APPROPRIATE ADJUSTMENTS.
- LABELING REQUIREMENTS BASED ON THE 2017 NATIONAL ELECTRIC CODE, OSHA STANDARD 19010.145, ANSI Z535. 2.
- MATERIAL BASED ON THE REQUIREMENTS OF THE AUTHORITY HAVING JURISDICTION. 3.
- LABELS TO BE OF SUFFICIENT DURABILITY TO WITHSTAND THE ENVIRONMENT INVOLVED [NEC 110.21] 4.
- 5. LABELS TO BE A MINIMUM LETTER HEIGHT OF 3/8", WHITE ON RED BACKGROUND; REFLECTIVE, AND PERMANENTLY

AFFIXED [NEC 690.56(C)(1)(A)].



# PHILLIPS ENERGY SYSTEMS

7901 ALLEN BLACK RD, MINT HILL NC 28227, UNITED STATES

REVISIONS							
DESCRIPTION	DATE	REV					
INITIAL DESIGN	02/25/2025						
REVISION	05/15/2025	А					
REVISION	07/17/2025	В					

PROJECT NAME & ADDRESS

DRAWN BY ESR SHEET NAME PLACARD

SHEET SIZE

ANSI B

11" X 17"

SHEET NUMBER

PV-9

48 BETTY ANN ST DUNN, NC 28334

CHELLE STATON RESIDENCE

MICHELLE





Cable Cross Section Size

SPECIFICATIONS

Cell

Units, mn

Weight

Dimensions

JAM54S31 380-405/MR Series

Mono

21.5kg±3%

1722±2mm×1134±2mm×30±1mm

4mm² (IEC) , 12 AWG(UL) 108(6x18)

IP68, 3 diodes

MC4-EVO2(1500V)

AM54S3

-405/MR 405

37.23

31.21

13 87

12.98

20.7

1000V/1500V DC -40°C ~+85°C

25A

**45±2**°C

Class II

Portrait: 300mm(+)/400mm(-);

JAM54S31

-400/MR

400

37.07

31.01

13.79

12.90

20.5

Landscape: 1200mm(+)/1200mm(-

No. of cells Junction Box Connector Cable Length


(Including Connector) Packaging Configuration 36pcs/Pallet, 864pcs/40ft Container

JAM54S31 JAM54S31 JAM54S31 -385/MR -390/MR -395/MR 385 390 395 36.71 36.85 36.98 30.46 30.64 30.84 13 52 13 61 13 70 12.64 12.73 12.81 20.0 19.7 20.2 ±2% +0.045%°C -0.275%/°C -0.350%/°C Irradiance 1000W/m², cell temperature 25°C, AM1.5G

Remark: Electrical data in this catalog do not refer to a single module and they are not part of the offer. They only serve for comparison among different module types.

ELECTRICAL PARA	ECTRICAL PARAMETERS AT NOCT								
ТҮРЕ	JAM54S31 -380/MR	JAM54S31 -385/MR	JAM54S31 -390/MR	JAM54S31 -395/MR	JAM54S31 -400/MR	JAM54S31 -405/MR	Maximum System Voltage	1000V/150	
Rated Max Power(Pmax) [W]	286	290	294	298	302	306	Operating Temperature	-40°C~+	
Open Circuit Voltage(Voc) [V]	34.36	34.49	34.62	34.75	34.88	35.12	Maximum Series Fuse Rating	254	
Max Power Voltage(Vmp) [V]	28.51	28.68	28.87	29.08	29.26	29.47	Maximum Static Load,Front* Maximum Static Load,Back*	5400Pa(11 2400Pa(50	
Short Circuit Current(Isc) [A]	10.75	10.82	10.89	10.96	11.03	11.10	NOCT	45±2	
Max Power Current(Imp) [A]	10.03	10.11	10.18	10.25	10.32	10.38	Safety Class	Class	
NOCT	Irradian	ce 800W/m².	ambient tem	perature 20°	C.wind speed	1m/s. AM1.5G	Fire Performance	UL Tvr	

Power-Voltage Curve JAM54S31-405/MR

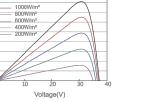

hnical changes and tes



## PHILLIPS ENERGY SYSTEMS

7901 ALLEN BLACK RD, MINT HILL NC 28227, UNITED STATES

REVISIONS			
DESCRIPTION	DATE	REV	
INITIAL DESIGN	02/25/2025		
REVISION	05/15/2025	А	
REVISION	07/17/2025	В	

# **PROJECT NAME & ADDRESS**

MICHELLE STATON RESIDENCE

48 BETTY ANN ST DUNN, NC 28334

DRAWN BY


ESR SHEET NAME

EQUIPMENT **SPECIFICATION** SHEET SIZE

5400Pa(112lb/ft²) 2400Pa(50lb/ft²)

UL Type 1

Current-Voltage Curve JAM54S31-405/MR

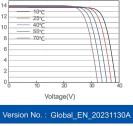

11" X 17" SHEET NUMBER PV-10

ANSI B

# **Residential Power Optimizer**

# For North America

S440 / S500B / S650B



# POWER OPTIMIZER

# PV power optimization at the module level

- I Specifically designed to work with SolarEdge residential inverters
- J Detects abnormal PV connector behavior, preventing potential safety issues
- Module-level voltage shutdown for installer and firefighter safety
- Superior efficiency (99.5%)
- / Mitigates all types of module mismatch loss, from manufacturing tolerance to partial shading

- Faster installations with simplified wire management and easy assembly using a single bolt
- Flexible system design for maximum space utilization
- Compatible with bifacial PV modules
- Meets NEC requirements for arc fault protection (AFCI) and Photovoltaic Rapid Shutdown System (PVRSS)

# **/** Residential Power Optimizer For North America

S440 / S500B / S650B

	S440	S500B
INPUT		
Rated Input DC Power ¹¹	440(2)	500(3)
Absolute Maximum Input Voltage (Voc)	60	125
MPPT Operating Range	8-60	12.5 - 105
Maximum Input Current (Maximum Isc of Connected PV Module) ⁽²⁾	14.5	
Maximum Input Short Circuit Current ⁽⁴⁾		18.75
Maximum Efficiency		99.5
Weighted Efficiency		98.6
Overvoltage Category		11
OUTPUT DURING OPERATION (POWER OPTIMIZER CO	NNECTED TO OPERATI	NG SOLAREDGE IN
Maximum Output Current		15
Maximum Output Voltage	60	
OUTPUT DURING STANDBY (POWER OPTIMIZER DISC	ONNECTED FROM SOLA	REDGE INVERTER
Safety Output Voltage per Power Optimizer		1 ± 0.1
STANDARD COMPLIANCE		
Photovoltaic Rapid Shutdown System	CS	A C22.2#330, NEC 2014 -
EMC	FCC Part 1	5 Class B; IEC 61000-6-2; I
Safety	CSA C22.2#	107.1; IEC 62109-1 (Class II
Material		UL 94 V-0, UV Resistan
RoHS		Yes
Fire Safety		VDE-AR-E 2100-712:2013-
INSTALLATION SPECIFICATIONS	1	
Maximum Allowed System Voltage		1000
Dimensions (W x L x H)	129 x 155 x 30 / 5.07 x 6.10 x 1.18	129 x 165 x 45
Weight	720 / 1.6	7
Input Connector		MC4
Input Wire Length	0.1 / 0.32	
Output Connector		MC4
Output Wire Length	(+	) 2.3, (-) 0.10 / (+) 7.54, (-
Operating Temperature Range ⁽⁵⁾		-40 to +85
Protection Rating		IP68 / NEMA6P
Relative Humidity		0 - 100

Rated power of the module at STC will not exceed the power optimizer Rated input DC Power. Modules with up to +5% power tolerance are allowed.
 For S440 with part number S440-7GM4MRMP, the Rated Input DC Power is 650W, and the Maximum Input Current is 15A.

(3) For installations after Aug 1st, 2024, the Rated Input DC Power for S500B is 650W.

(4) The Maximum Input Short Circuit Current is adjusted for worst case conditions of ambient temperature, irradiance, bifadal gain, and so on, in accordance with NEC and CSA. (5) Power derating is applied for ambient temperatures above +85 °C / +185 °F for S440, and for ambient temperatures above +75 °C / 167 °F for S500B and S650B. Refer to the Power Optimizers Temperature. Derating technical note for more details.

PV System Design Using a SolarEdge Inverter ⁽⁶⁾		SolarEdge Home Wave/Hub Single Phase	Three Phase for 208V Grid	Three Phase for 277/480V Grid	
Minimum String Length (Power	S440	8	10	18	
Optimizers)	S500B, S650B	6	8	14	
Maximum String Length (Power Optimizers)		25		50 ⁽⁷⁾	
Maximum Usable Power Delivered per String		5700	6000	12,750	W
	Inverters with Rated AC Power ≤ 5700W	Per the inverter's maximum input DC power ⁽⁸⁾			
Maximum Allowed Connected Power per String ⁽⁹⁾⁰⁰	Inverters with Rated AC Power of 6000W	5700	One string: 7200 15,000 Two strings or more: 7800	15.000	W
	Inverters with Rated AC Power ≥ 7600W	6800, only when connected to at least two strings			
Parallel Strings of Different Lengths or Orientations			Yes		

(6) It is not allowed to mix S-series and P-series Power Optimizers in new installations in the same string

(7) A string with more than 30 optimizers does not meet NEC rapid shutdown requirements; safety voltage will be above the 30V requirement

Refer to the <u>Single String Design Guidelines</u> application note for details.
 For the 208V grid, the maximum is permitted only when the difference in connected power between strings is 1,000W or less.

(10) For the 240V or 277/480V grids, the maximum is permitted only when the difference in connected power between strings 2,000W or less.



SolarEdgeTechnologies, Ltd. All rights reserved. SOLAREDGE, the SolarEdge logo, OPTIMIZED BY SOLAREDGE are trademarks or registered trademarks of SolarEdge Techn
All other, trademarks mentioned herein are trademarks of their respective owners. Date: September 17, 2024 DS-000018-NA. Subject to change without notice.



#### PHILLIPS ENERGY SYSTEMS

7901 ALLEN BLACK RD, MINT HILL NC 28227, UNITED STATES

REVISIONS			
DESCRIPTION	DATE	REV	
INITIAL DESIGN	02/25/2025		
REVISION	05/15/2025	А	
REVISION	07/17/2025	В	

PROJECT NAME & ADDRESS	3

DRAWN BY

ESR SHEET NAME EQUIPMENT

SPECIFICATION

SHEET SIZE

ANSI B 11" X 17"

SHEET NUMBER PV-11

48 BETTY ANN ST DUNN, NC 28334

MICHELLE STATON RESIDENCE

	S650B	
	650	W
	85	Vdc
	12.5 - 85	Vdc
15		Adc
		Adc
		%
		%
VERTE	R)	
		Adc
80		Vdc
OR IN	/ERTER OFF)	
		Vdc
2023		
EC 61000	-6-3	
Safety); U	L 1741	
05		
		Vdc
/ 5.07 x	6.49 x 1.77	mm / in
90 / 1.74		gr / lb
		m/ft
0.32		m/ft
		°C
		%



# SolarEdge Home Hub Inverter

Single Phase, for North America For Inverters Assembled in the USA

SE3800H-US / SE5700H-US / SE7600H-US / SE10000H-US / SE11400H-US



# Single phase inverter for storage and backup applications

- *I* The ultimate home energy manager in charge of PV production, battery storage, backup operation during a power outage*, EV Charging, and smart energy devices
- Record-breaking 99% weighted efficiency with 1 up to 300% DC oversizing
- Supports LRA can provide the required energy for HVAC systems starting during backup operation
- Integrates seamlessly with the complete 1 SolarEdge Home Smart Energy Ecosystem, through SolarEdge Home Network
- Module-level monitoring and visibility of 1 battery status, PV production, and selfconsumption data

*Requires additional hardware and firmware version upgrade

Fast and easy installation – small and lightweight, with reduced commissioning time

HOME BACKUP

- I A scalable solution that supports future homeowner needs through easy connection to a growing ecosystem of products
- Advanced safety features with integrated arc fault protection and rapid shutdown for 690.11 and 690.12
- Advanced reliability with automotive-grade 1 components
- Embedded revenue grade production data, 1 ANSI C12.20 Class 0.5
- IP65-rated, for indoor and outdoor installations



# **/** SolarEdge Home Hub Inverter Single Phase, for North America

SE3800H-US / SE5700H-US / SE7600H-US / SE10000H-US / SE11400H-US

Model Number ⁽¹⁾⁽²⁾	SE3800H-US	SE5700H-US	SE7600H-US	SE10000H-US	SE11400H-US	Uni
OUTPUT – AC ON GRID						
Rated AC Power	3800 @ 240V 3300 @ 208V	5760 @ 240V 5000 @ 208V	7600	10000	11,400 @ 240V 10,000 @ 208V	W
Maximum AC Power Output	3800 @ 240V 3300 @ 208V	5760 @ 240V 5000 @ 208V	7600	10000	11,400 @ 240V 10,000 @ 208V	W
AC Output Voltage (Nominal)			208 / 240			Vad
AC Output Voltage (Range)			183 – 264			Va
AC Frequency Range (min - nom - max)		5	9.3 – 60 – 60.5 ⁽³⁾			Hz
Maximum Continuous Output Current	16	24	32	42	48	A
GFDI Threshold			1			A
Total Harmonic Distortion (THD)			< 3			%
Power Factor		1, adji	ustable -0.85 to 0.85			
Utility Monitoring, Islanding Protection, Country Configurable Thresholds			Yes			
Charge Battery from AC (if allowed)			Yes			
Typical Nighttime Power Consumption			< 2.5			W
OUTPUT – AC STAND-ALONE (BACKUP) ⁽⁴⁾⁽⁵⁾						
Rated AC Power in Stand-alone Operation			11,400 ⁽⁶⁾			W
Maximum Stand-alone Capacity			11,400			W
AC L-L Output Voltage Range in Stand-alone Operation			211 – 264			Vá
AC L-N Output Voltage Range in Stand-alone Operation			105 - 132			Vá
AC Frequency Range in Stand-alone (min - nom - max)			55 - 60 - 65			Н
Maximum Continuous Output Current in Stand-alone Operation			48			A
GFDI			1			A
THD			< 5			%
OUTPUT – SOLAREDGE HOME EV CHARGER AC						
Rated AC Power			9600			W
AC Output Voltage Range			211 – 264			Va
On-Grid AC Frequency Range (min - nom - max)			59.3 - 60 - 60.5			H:
Maximum Continuous Output Current @240V (grid, PV and battery)			40			Aa
INPUT – DC (PV AND BATTERY)						
Transformer-less, Ungrounded			Yes			
Max Input Voltage			480			Vc
Nom DC Input Voltage			380			Vo
Reverse-Polarity Protection			Yes			
Ground-Fault Isolation Detection		6	i00kΩ Sensitivity			
INPUT – DC (PV)						
Maximum DC Power @ 240V	11,400	11,520	15,200	20,000	22,800	V
Maximum DC Power @ 208V	6600	10,000	-	-	20,000	W
Maximum Input Current ⁽⁷⁾ @ 240V	20	30.5	40	53	60	Ac
Maximum Input Current ⁽⁷⁾ @ 208V	17.5	27	-	-	53	Ac
Maximum Input Short Circuit Current			45	1	1	Ad
Maximum Inverter Efficiency			99.2			9
CEC Weighted Efficiency	98	.5	9	99	99 @ 240V 98.5 @ 208V	%
2-pole Disconnection	Yes			+		

(1) These specifications apply to inverters with part numbers SExxxxH-USMNUxxx5 and SExxxxH-USMNExxx5 and connection unit model number DCD-1PH-US-PxH-F-x. 2) Inverters with part number SExxxxH-USMNFxxx5 are intended for upgrade installations only, as part of the "Re-Energize" program. Use on non-upgrade installations will revoke the product warranty. (3) For other regional settings please refer to the <u>SolarEdge Inverters, Power Control Options Application Note</u>.
 (4) Not designed for non-grid connected applications and requires AC for commissioning. Stand-alone (backup) functionality is only supported for the 240V grid.

(5) For LRA (Locked Rotor Amperage) values please refer to the LRA for NAM Application Note.

(6) For models SE7600H-US and below, the rated AC stand-alone power is configurable between 7600W or 11,400W from CPU version 4.20.xx.

(7) A higher current source may be used. The inverter will limit its input current to the values stated.

solaredge.com



#### PHILLIPS ENERGY SYSTEMS

7901 ALLEN BLACK RD, MINT HILL NC 28227, UNITED STATES

REVISIONS				
DESCRIPTION	DATE	REV		
INITIAL DESIGN	02/25/2025			
REVISION	05/15/2025	А		
REVISION	07/17/2025	В		

# **PROJECT NAME & ADDRESS**

MICHELLE STATON RESIDENCE

48 BETTY ANN ST DUNN, NC 28334

DRAWN BY

ESR SHEET NAME

EQUIPMENT **SPECIFICATION** 

SHEET SIZE ANSI B

11" X 17"

SHEET NUMBER



# / SolarEdge Home Hub Inverter

SE3800H-US / SE5700H-US / SE7600H-US / SE10000H-US / SE11400H-US

Model Number ⁽¹⁾⁽²⁾	SE3800H-US	SE5700H-US	SE7600H-US	SE10000H-US	SE11400H-US	Units
OUTPUT – DC (BATTERY)						
Supported Battery Types		SolarEdge Ho	ome Battery, LG RESI	J Prime		
Number of Batteries per Inverter		Up to 3 SolarEdge Ho				
Continuous Power ⁽⁸⁾	11,400 @ 240V 3800 @ 208V	11,400 @ 240V 5000 @ 208V	11400	@240V	11,400 @ 240V 10,000 @ 208V	W
Peak Power ⁽⁸⁾	11,400 @ 240V 3800 @ 208V	11,400 @ 240V 5000 @ 208V	11400	@240V	11,400 @ 240V 10,000 @ 208V	W
Maximum Input Current		30				
2-pole Disconnection		Up to the inver	ter's rated stand-alo	ne power		
SMART ENERGY CAPABILITIES						
Consumption Metering			Built-in ⁽⁹⁾			
Stand-alone & Battery Storage	With Backup Ir	nterface (purchased s	eparately) for service	e up to 200A; up to	3 inverters	
EV Charging		Direct connection to	the SolarEdge Hon	ne EV Charger		
ADDITIONAL FEATURES						
Supported Communication Interfaces	RS485, Ethe	rnet, Cellular ⁽¹⁰⁾ , Wi-Fi	(optional), SolarEdg	e Home Network (c	optional)	
Revenue Grade Metering, ANSI C12.20		Built-in ⁽⁹⁾				
Integrated AC, DC and Communication Connection Unit		Yes				
Inverter Commissioning	With the SetApp	ο mobile application ι	ising built-in Wi-Fi A	ccess Point for local	l connection	
DC Voltage Rapid Shutdown (PV and Battery)		١	'es, NEC 690.12			
STANDARD COMPLIANCE						
Safety	UL 1741, UL 1741SA, U	JL 1741SB, UL 1699B, C	SA 22.2#107.1, C22,	2#330, C22.3#9, AN	NSI/CAN/UL 9540	
Grid Connection Standards		IEEE1547 and I	EEE-1547.1, Rule 21,	Rule 14H		
Emissions		FC	C Part 15 Class B			
INSTALLATION SPECIFICATIONS						
AC Terminals		.1, L2, N terminal bloc L2 terminal blocks, PE				
DC Terminals	4 x termir	nal block pairs for PV	input; 1 x terminal bl	lock pair for battery	input	
AC Output and EV AC Output Conduit Size / AWG Range		1'' ma	aximum / 14-4 AWG			
DC Input (PV and Battery) Conduit Size / AWG Range		1" ma	aximum / 14-6 AWG			
Dimensions with Connection Unit (H x W x D)		21.06 x 14.	6 x 8.2 / 535 x 370 x	208		in / mr
Weight with Connection Unit			44.9 / 20.3			lb / kg
Noise			< 50			dBA
Cooling		N	atural Convection			
Operating Temperature Range		-40 tc	+140 / -40 to +60 ⁽¹¹⁾			°F/°C
Protection Rating			NEMA 4X			

(8) Discharge power is limited up to the inverter's rated AC power for on-grid and stand-alone applications, as well as up to the installed batteries' rating.
 (9) For consumption metering current transformers should be ordered separately: SECT-SPL-225A-T-20 or SEACT1250-400NA-20. Revenue grade metering is only for production metering.
 (10) Information concerning the data plan terms & conditions is available in <u>SolarEdge Communication Plan Terms and Conditions</u>.

(11) Full power up to at least 50°C / 122°F; for power derating information refer to the Temperature Derating Technical Note for North America.





# PHILLIPS ENERGY SYSTEMS

7901 ALLEN BLACK RD, MINT HILL NC 28227, UNITED STATES

REVISIONS			
DESCRIPTION	DATE	REV	
INITIAL DESIGN	02/25/2025		
REVISION	05/15/2025	А	
REVISION	07/17/2025	В	



# SolarEdge Slim Current Transformer

SECT-SPL-225A-T-20

Α`



ACCESSORIES

# Easily fits into home Main Service Panels, for simpler, faster installations


- / Works seamlessly with SolarEdge consumption meters (external or built-in to the Energy Hub inverter)
- Boosts customer satisfaction by enabling real-time energy insight for greater electricity savings
- Increases installer revenue by creating more opportunities to expand system size or add smart capabilities like batteries, EV charging and smart energy devices
- High system accuracy (with SolarEdge meters) of ±1.25%


- Clamp and split-core design, with single-handed installation
- Supports CT paralleling, enabling measurements of more load conductors
- Includes 17ft twisted pair cable, eliminating need for extension cable and additional labor when installing inverters with built-in consumption meter
- Simplified support and logistics with a single vendor

# / SolarEdge Slim Current Transformer SECT-SPL-225A-T-20 Model number: SECT-S1

		SECT-SPL-225A-T-20	UNITS
ELECTRICAL SPECI	FICATION		
Accuracy (1% - 100% of rate	ed current)	±1	%
CT Phase Angle (10% - 100	% of rated current)	< ±2.0	Degrees
Nominal Line Frequency		60 / 50	Hz
Current Rating		225 (@ 600 Vac)	A
Output Voltage		0 - 333	mVac
Overvoltage Category		CAT III 600V	Vac
Maximum Primary Conduct	or Gauge	300	kcmil
Maximum Continuous Amp	DS S	300	A
MECHANICAL			
Туре		Split core, clamp design	
Dimentions: Overall (H x W x L)		1.85 x 0.49 x 4.05 / 47 x 12.5 x 99	Inch / mm
Average Window Diameter		0.885 / 22.6	Inch / mm
	Туре	Twisted pair	MTW, UL 101
Lead Wire	Length	17 / 5.2	ft/m
	Gauge	18 / 20(1)	AWG
Material		Polycarbonate	
Weight		7.5 / 213	Oz / g
ENVIRONMENTAL			
Operating Temperature Ra	nge	-40 to 140 / -40 to 60	°F / °C
Operating Humidity	-	5% to 90% relative humidity	
IP Rating		30 (NEMA 1)	
STANDARDS			
Safety for US/CAN		UL 2808 (XOBA) listed, meets 2017 NEC code requirements for field installation	
RoHS		Compliant	

(1) 18 AWG or 20 AWG can be used interchangeably

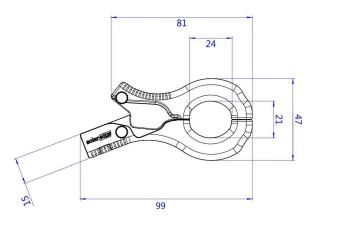

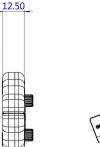

* All dimensions are in millimeters

CE RoHS



SolarEdge Technologies Ltd. All rights reserved. SOLAREDGE, the SolarEdge logo, OPTIMIZED BY SOLAREDGE are trademarks or registered trademarks of SolarEdge Technologies, In All other trademarks mentioned herein are trademarks of their respective owners. Date: 07/2021 DS-000033-1.3-NA. Subject to change without notice.

solaredge.com




## PHILLIPS ENERGY SYSTEMS

7901 ALLEN BLACK RD, MINT HILL NC 28227, UNITED STATES

REVISIONS				
DATE	REV			
02/25/2025				
05/15/2025	А			
07/17/2025	В			
	DATE 02/25/2025 05/15/2025			

}	
Ş	
}	P
}	
5	
)	7

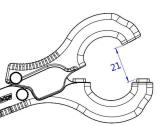

solaredge



# **Backup Interface**

# for North America

BI-EUSGN-01 / BI-NUSGN-01



# Backup Interface for Flexible Backup

- Automatically provides backup power to home loads in the event of grid interruption
- Full flexibility in which loads to backup the entire home or selected loads
- Scalable solution to support higher power & higher capacity^(*)

(*) Requires supporting inverter firmware

- Built-in Auto Transformer and Energy Meter for easier and faster installation
- Seamless integration with the Energy Hub Inverter with Prism Technology to manage and monitor both PV generation and energy storage
- Generator connection support^(*)

# **/** Backup Interface for North America

# BI-EUSGN-01 / BI-NUSGN-01

	BI-EUSGN-01	B
INPUT FROM GRID		
AC Current Input	200	
AC Output Voltage (Nominal)	240	
AC Output Voltage Range	211 - 264	:
AC Frequency (Nominal)	60	
AC Frequency Range	59.3 - 60.1	5
Microgrid Interconnection Device Rated Current	200	
Service Side AC Main Circuit Breaker Rated Current	200	
Service Side AC Main Circuit Breaker Interrupt Current	10k	
Grid Disconnection Switchover Time	<100	
OUTPUT TO MAIN DISTRIBUTION PANEL		
Maximum AC Current Output	200	
AC L-L Output Voltage (Nominal)	240	
AC L-L Output Voltage Range	211 - 264	
AC Frequency (Nominal)	60	
AC Frequency Range	59.3 - 60.	5
Maximum Inverters AC Current Output in Backup Operation	78	
Imbalance Compensation in Backup Operation	5000	
AC L-N Output Voltage in Backup (Nominal)	120	
AC L-N Output Voltage Range in Backup	105 - 132	
AC Frequency Range in Backup	55 - 65	
INPUT FROM INVERTER		
Number of Inverter Inputs	3	
Rated AC Power	7,600	
Maximum Continuous Input Current @ 240V	32	
Rated AC Power in Continuous Backup Operation	6,100	
Maximum Continuous Input Current in Backup Operation	26	
Peak AC Power (<10 sec) in Backup Operation	7,000	
Peak AC Current (<10 sec) in Backup Operation	30	
Inverter Input AC Circuit Breaker	40	
Upgradability	Up to 3 X 63A	CB ⁽¹⁾
GENERATOR ⁽²⁾		
Maximum Rated AC Power	15,000	
Maximum Continuous Input Current	63	
Dry Contact Switch Voltage Rating	250/30	
Dry Contact Switch Current Rating	5	
2-wire Start Switch	Yes	
ADDITIONAL FEATURES		
Installation Type	Suitable for use as service equipment	F
Number of Communication Inputs	2	
Communication	RS485	
Energy Meter (for Import/Export)	1% accurac	y

 Each 40A CB supports up to one 7.6kW inverter, with each 63A CB supporting one 10kW and one 11.4kW inverter. The CB upgrade kit is available with the following part numbers: for 40A CB, CB-UPG-40-01; for 63A, CB CB-UPG-63-01
 Requires supporting inverter firmware

solaredge.com



S

TOREDG



# PHILLIPS ENERGY SYSTEMS

7901 ALLEN BLACK RD, MINT HILL, NC 28227, UNITED STATES

NC 28227, UNITE	DSTATES	
REVISION	S	
DESCRIPTION	DATE	REV
INITIAL DESIGN	02/25/2025	
REVISION	05/15/2025	А
REVISION	07/17/2025	В
MICHELLE STATON RESIDENCE	48 BETTY ANN ST, DUNN, NC 28334	

DRAWN BY

ESR SHEET NAME

EQUIPMENT SPECIFICATION

SHEET SIZE


ANSI B 11" X 17" SHEET NUMBER PV-15

	A
	Vac
	Vac
	Hz
	Hz
	A
I/A	A
/A	A
	ms
	A
	Vac
	Vac
	Hz
	Hz
	A
	W
	V
	V
	Hz
	#
	W
	A
	W
	A
	W
	A
	A
	W
	Adc
	Vac/Vdc
	Vac/Vdc
	A
n lug only	

# **/** Backup Interface for North America

BI-EUSGN-01 / BI-NUSGN-01

	BI-EUSGN-01	BI-NUSGN-01	
STANDARD COMPLIANCE			
C-6+.	UL1741, CSA	22.2 NO. 107	
Safety	UL869A	N/A	
Emissions	FCC part 15 class B		
INSTALLATION SPECIFICATIONS			
Supported Inverters		e phase inverter, Iverter with Prism technology	
AC From Grid Conduit Size / AWG Range	2" conduits /	#0 - 4/0 AWG	
AC Inverter Conduit Size / AWG Range	1" conduit / 14 - 4 AWG		
AC Generator Input Conduit Size / AWG Range	1" conduit / 8 - 3 AWG		
Communication Conduit Size / AWG Range	3/4'' / 24 - 10 AWG		
Weight	73 / 33		lb / Kg
Cooling	Fan (user replaceable)		-
Noise	< 50		dBA
Operating Temeprature Range	-40 to +122 / -40 to +50		°F/°C
Protection Rating	NEMA	3R, IP44	
Dimensions (HxWxD)	20.59 x 13.88 x 8.62	/ 523.5 x 352.5 x 219 ii	n / mm

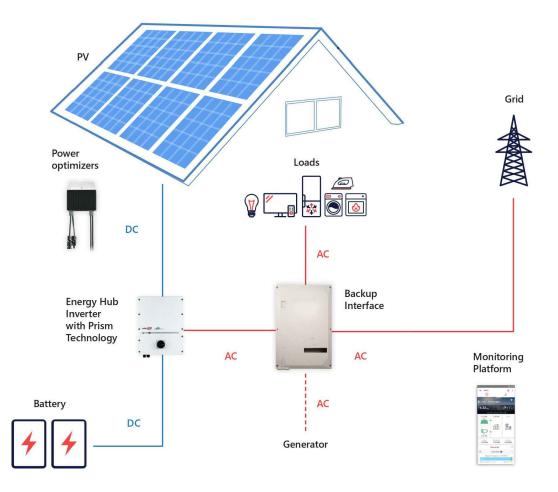


© SolarEdge Technologies, Ltd. All rights reserved. SOLAREDGE, the SolarEdge logo, OPTIMIZED BY SOLAREDGE are trademarks or registered trademarks of SolarEdge Technologies, Inc. All other trademarks mentioned herein are trademarks of their respective owners.10/2020/V01/ENG NA. Subject to change without notice.



# PHILLIPS ENERGY SYSTEMS

7901 ALLEN BLACK RD, MINT HILL, NC 28227, UNITED STATES

REVISIONS				
DESCRIPTION DATE R				
INITIAL DESIGN	02/25/2025			
REVISION	05/15/2025	А		
REVISION 07/17/2025 B				

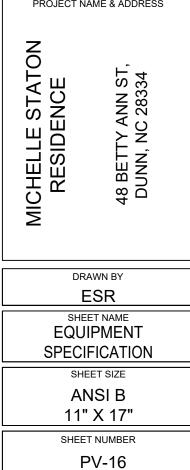

# SolarEdge Energy Bank **10kWh Battery**

# For North America



# HO ME BACKUP

# **Optimized for SolarEdge Energy Hub Inverters**⁽¹⁾

- Maximized system performance, gaining more energy to store and use for on-grid and backup power applications
- Integrates with the complete SolarEdge residential offering, providing a single point of contact for warranty, support, training, and simplified logistics & operations
- / DC coupled battery featuring superior overall system efficiency, from PV to battery to grid
- I Scalable solution for increased power and capacity with multiple SolarEdge inverters and batteries

* Backup application are subject to local regulation and may require additional components and firmware upgrade

- I Solar, storage, EV charging, and smart devices all monitored and managed by a single app to optimize solar production, consumption and backup* power
- // Wireless communication to the inverter, reducing wiring, labor and installation faults
- / Simple plug and play installation, with automatic SetApp-based configuration
- / Includes multiple safety features for battery protection

# / SolarEdge Energy Bank **10kWh Battery** For North America

	BAT-10K1P ⁽²⁾
BATTERY SPECIFICATION	
Usable Energy (100% depth of discharge)	9700
Continuous Output Power	5000
Peak Output Power (for 10 seconds)	7500
Peak Roundtrip Efficiency	>94.5
Warranty ^m	10
Voltage Range	350-450
Communication Interfaces	Wireless*
Batteries per Inverter	Up to 3 ⁽⁴⁾
STANDARD COMPLIANCE	
Safety	UL1642, UL1973, UL9540, UN38.3
Emissions	FCC Part 15 Class B
MECHANICAL SPECIFICATIONS	
Dimensions (W x H x D)	31.1 x 46.4 x 9.84 / 790 x 1179 x 250
Weight	267 / 121
Mounting ⁽⁵⁾	Floor or wall mount®
Operating Temperature ⁽⁷⁾	+14 to +122 / -10 to +50
Storage Temperature (more than 3 months)	+14 to +86 / -10 to +30
Storage Temperature (less than 3 months)	-22 to + 140 / -30 to +60
Altitude	6562 / 2000
Enclosure Protection	IP55 / NEMA 3R - indoor and outdoor (water and du
Cooling	Natural convection
Noise (at 1m distance)	<25

might require a matching SolarEdge Energy Net Plug-in (more details below). Using RS485 could reduce the usable energy to 9500Wh. (1) Please refer to the SolarEdge Energy Bank battery connections and configuration application note for compatible inverters

(2) These specifications apply to part number BAT-10KIPS0B-01.
 (3) For warranty details please refer to the SolarEdge Energy Bank battery Limited Warranty.

(4) Installations with multiple SolarEdge Energy Bank batteries connected to a single inverter require a pair of branch connectors (DC + and DC -) per battery excluding the last battery. Support for 3 batteries is pending supporting inverter firmware. The branch connectors should be purchased separately.

(5) Installation and mounting requires handles that should be purchased separately. Please refer to the Accessories' PN table below. (6) The floor stand is purchased separately. One floor stand is required per SolarEdge Energy Bank battery. Please refer to the Accessories' PN table below.

(7) Please note that operating the SolarEdge Energy Bank at extreme temperatures for extended durations of time may void the Energy Bank's warranty coverage. Please see the Energy Bank Limited Product Warranty for additional details.

#### SolarEdge Energy Bank Battery – Accessories (purchased separately)

Accessory	PN
Floor stand	IAC-RBAT-FLRSTD-01
Branch connectors set (includes a pair of DC + and DC - connectors) Required for installations with multiple SolarEdge Energy Bank batteries with a single inverter	IAC-RBAT-USYCBL-01
Handles	IAC-RBAT-HANDLE-01
SolarEdge Energy Net Plug-in	ENET-HBNP-01
Battery inverter extension cable 2m long (MC4 to terminal block)	IAC-RBAT-10M420-01



# solaredge.com



#### PHILLIPS ENERGY SYSTEMS

7901 ALLEN BLACK RD, MINT HILL NC 28227, UNITED STATES

REVISIONS				
DESCRIPTION	DATE	REV		
INITIAL DESIGN	02/25/2025			
REVISION	05/15/2025	А		
REVISION	07/17/2025	В		

**PROJECT NAME & ADDRESS** 

	14/6
	Wh
	W
	W
	%
	Years
	Vdc
	1
	in / mr
	ín / mr lb / kg
	lb / kg
	lb / kg °F/ °C
	lb/kg °F/°C °F/°C
	الb / kg ۴F/°C ۴F/°C ۴F/°C
protection)	lb / kg
protection)	الb / kg ۴F/°C ۴F/°C ۴F/°C

MICHELLE STATON RESIDENCE	48 BETTY ANN ST, DUNN, NC 28334
	WN BY
	SR
	. <b>5</b> K
	PMENT
SPECIF	FICATION

SHEET NUMBER

SHEET SIZE

ANSI B

11" X 17"




**Tech Brief** 

# XR Rail[®] Family

# Solar Is Not Always Sunny

Over their lifetime, solar panels experience countless extreme weather events. Not just the worst storms in years, but the worst storms in 40 years. High winds capable of ripping panels from a roof, and snowfalls weighing enough to buckle a panel frame.

XR Rails[®] are the structural backbone preventing these results. They resist uplift, protect against buckling and safely and efficiently transfer loads into the building structure. Their superior spanning capability requires fewer roof attachments, reducing the number of roof penetrations and the amount of installation time.

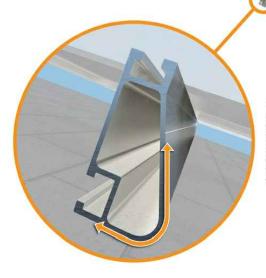

# Force-Stabilizing Curve

Sloped roofs generate both vertical and lateral forces on mounting rails which can cause them to bend and twist. The curved shape of XR Rails® is specially designed to increase strength in both directions while resisting the twisting. This unique feature ensures greater security during extreme weather and a longer system lifetime.

# **Compatible with Flat & Pitched Roofs**



#### IronRidge® offers a range of tilt leg options for flat roof mounting applications.

#### **Corrosion-Resistant Materials**

All XR Rails® are made of 6000-series aluminum alloy, then protected with an anodized finish. Anodizing prevents surface and structural corrosion, while also providing a more attractive appearance.



# XR Rail[®] Family

The XR Rail[®] Family offers the strength of a curved rail in three targeted sizes. Each size supports specific design loads, while minimizing material costs. Depending on your location, there is an XR Rail[®] to match.



- · Clear & black anodized finish
- Internal splices available

# **Rail Selection**

· Internal splices available

The table below was prepared in compliance with applicable engineering codes and standards.* Values are based on the following criteria: ASCE 7-16, Gable Roof Flush Mount, Roof Zones 1 & 2e, Exposure B, Roof Slope of 8 to 20 degrees and Mean Building Height of 30 ft. Visit IronRidge.com for detailed certification letters.

Load		Rail Span		Span	
Snow (PSF)	Wind (MPH)	4'	5' 4"	6'	8'
	90				
	120				
None	140	XR10	XR10	XR100	
	160				
	90				
20	120				
20	140				
	160				
30	90				
30	160				
40	90				
40	160				
80	160				
120	160				






#### XR1000

XR1000 is a heavyweight among solar mounting rails. It's built to handle extreme climates and spans up to 12 feet for commercial applications.

• 12' spanning capability · Extreme load capability · Clear anodized finish Internal splices available

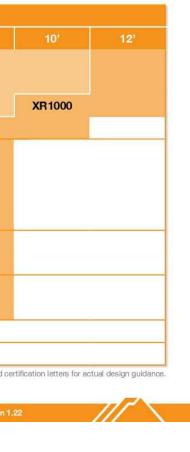



#### PHILLIPS ENERGY SYSTEMS

7901 ALLEN BLACK RD, MINT HILL, NC 28227, UNITED STATES

REVISIONS			
DESCRIPTION	DESCRIPTION DATE		
INITIAL DESIGN	02/25/2025		
REVISION	05/15/2025	А	
REVISION	07/17/2025	В	

#### **PROJECT NAME & ADDRESS**

MICHELLE STATON RESIDENCE

48 BETTY ANN ST DUNN, NC 28334

DRAWN BY

ESR

SHEET NAME EQUIPMENT SPECIFICATION

SHEET SIZE

ANSI B 11" X 17"

SHEET NUMBER






# UFO[®] Family of Components

# Simplified Grounding for Every Application

The UFO® family of components eliminates the need for separate grounding hardware by bonding solar modules directly to IronRidge® XR Rails®. All system types that feature the UFO® family-Flush Mount®, Tilt Mount® and Ground Mount®-are fully listed to the UL 2703 standard.


UFO® hardware forms secure electrical bonds with both the module and the rail, resulting in many parallel grounding paths throughout the system. This leads to safer and more reliable installations.

Only for installation and use with IronRidge products in accord with written instructions. See IronRidge.com/UFO

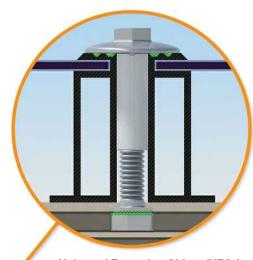

system.

Universal Fastening Object (UFO®) **Stopper Sleeve** The UFO® securely bonds solar modules to XR Rails[®]. It comes assembled and lubricated, and The Stopper Sleeve snaps can fit a wide range of module heights. onto the UFO®, converting it into a bonded end clamp. BOSS[®] Splice Bonded Structural Splice connects rails with built-in bonding teeth. No tools or hardware needed Grounding Lug **Bonded Attachments** A single Grounding Lug connects an entire row The bonding bolt attaches of PV modules to the and bonds the L-foot® to the grounding conductor. rail. It is installed with the same socket as the rest of the System Diagram

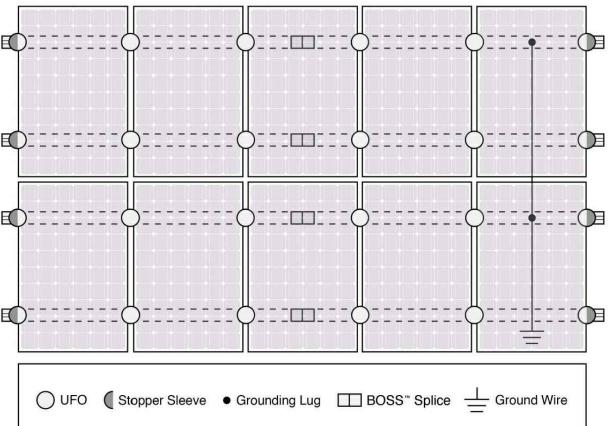

S Approved Enphase microinverters can provide equipment grounding of IronRidge systems, eliminating the need for grounding lugs and field installed equipment ground conductors (EGC). A minimum of two microinverters mounted to the same rail and connected to the same Engage cable is required. Refer to installation manuals for additional details.

# **UL** Certification


The IronRidge® Flush Mount®, Tilt Mount®, and Ground Mount Systems have been listed to UL 2703 by Intertek Group plc.

UL 2703 is the standard for evaluating solar mounting systems. It ensures these devices will maintain strong electrical and mechanical connections over an extended period of time in extreme outdoor environments.

(=) Go to IronRidge.com/UFO

Cross-System Comp		
Feature	Flush Mount	Tilt N
XR Rails [®]	~	
UFO [®] /Stopper	~	•
BOSS [®] Splice	~	
Grounding Lugs	1 per Row	1 per
Microinverters & Power Optimizers	Compatible v Refer to	with most system ir
Fire Rating	Class A	Cla
Modules	Tested or Evalua Refer to insta	



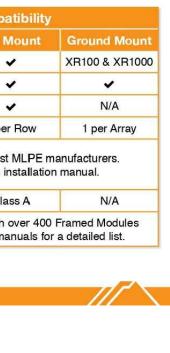



## PHILLIPS ENERGY SYSTEMS

7901 ALLEN BLACK RD, MINT HILL, NC 28227, UNITED STATES

REVISIONS			
DESCRIPTION	DATE R		
INITIAL DESIGN	02/25/2025		
REVISION	05/15/2025	А	
REVISION	07/17/2025	В	

**PROJECT NAME & ADDRESS** 

MICHELLE STATON RESIDENCE

48 BETTY ANN ST DUNN, NC 28334

DRAWN BY


ESR

SHEET NAME EQUIPMENT **SPECIFICATION** 


SHEET SIZE

ANSI B 11" X 17"

SHEET NUMBER

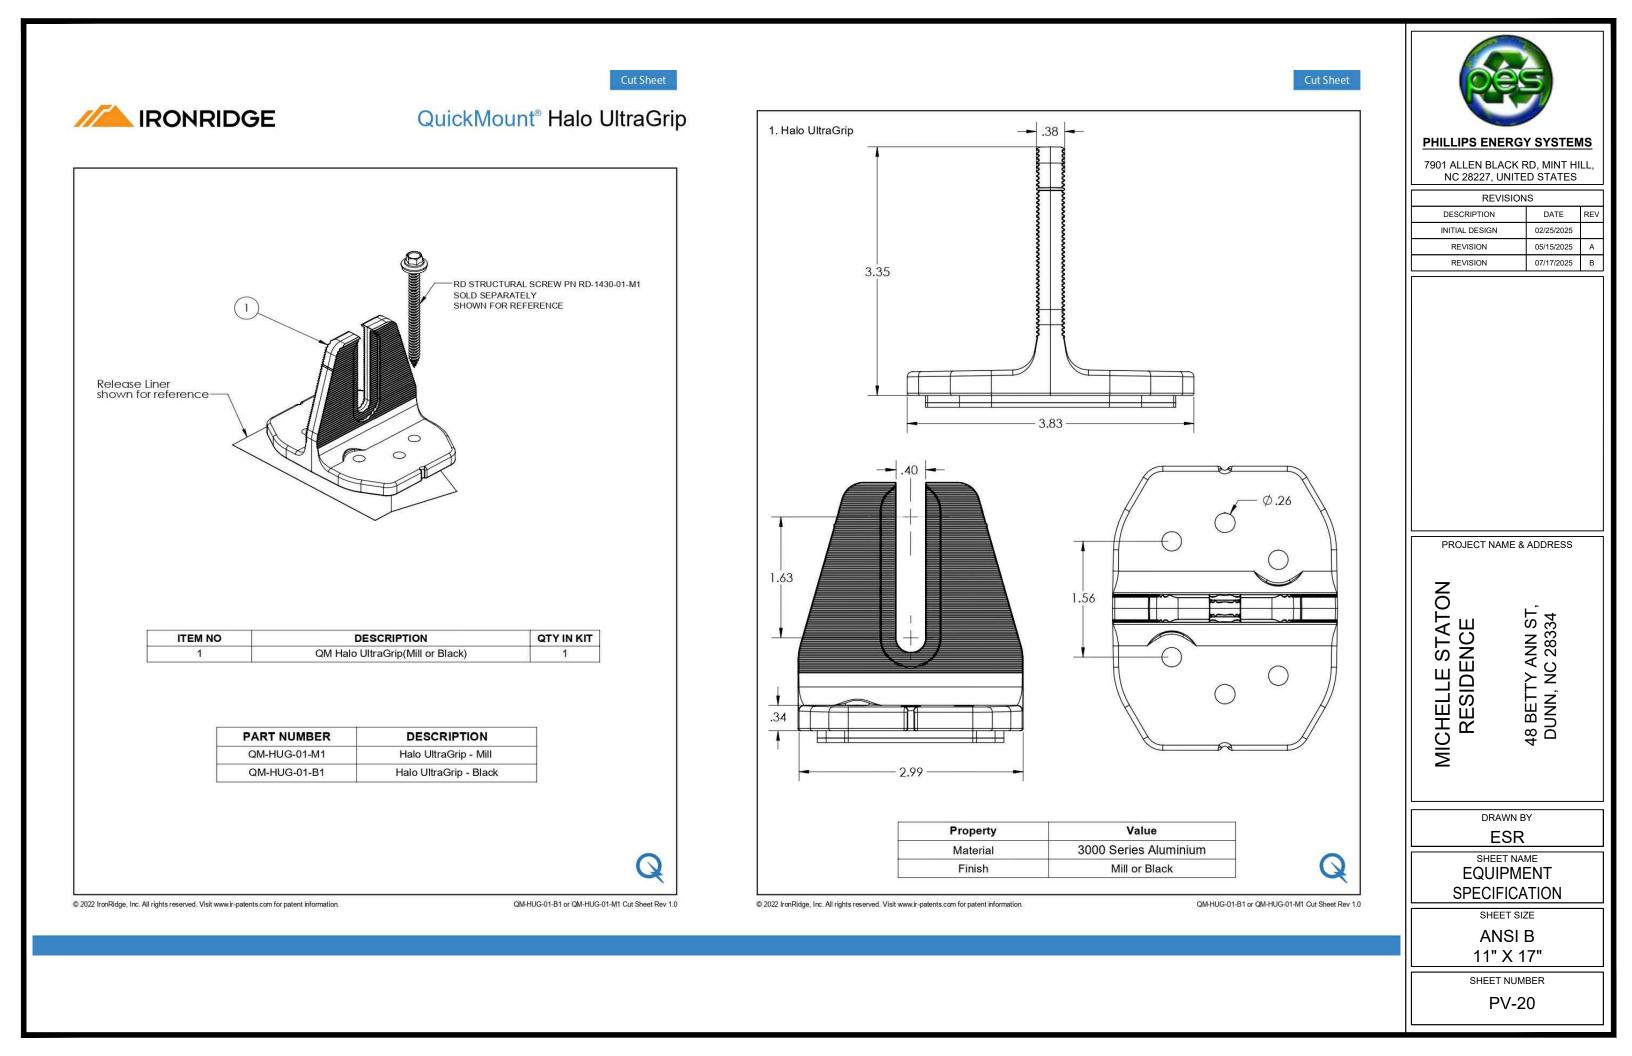

# IRONRIDGE QuickMount® RD Structural Screw

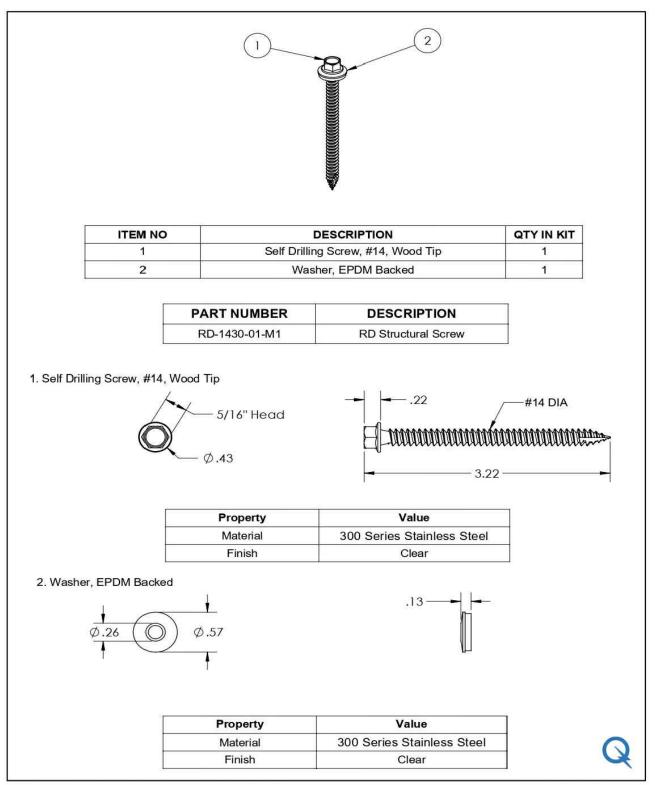

© 2022 IronRidge, Inc. All rights reserved. Visit www.ir-patents.com for patent information.


QM-RD-1430-01-M1 Cut Sheet Rev 1.0



#### PHILLIPS ENERGY SYSTEMS

7901 ALLEN BLACK RD, MINT HILL NC 28227, UNITED STATES

REVISIONS			
DESCRIPTION	DESCRIPTION DATE		
INITIAL DESIGN	02/25/2025		
REVISION	05/15/2025	А	
REVISION	07/17/2025	В	

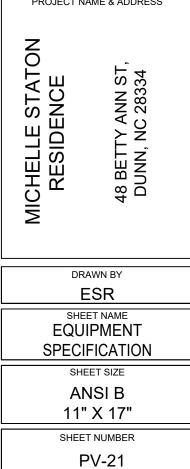




# PHONE: 385-202-4150 WWW.EZSOLARPRODUCTS.COM




ITEM NO.	PART NUMBER	DESCRIPTION	QTY
1	JB-1.2 BODY	POLYCARBONATE WITH UV INHIBITORS	1
2	JB-1.2 LID	POLYCARBONATE WITH UV INHIBITORS	1
3	#10 X 1-1/4" PHILLIPS PAN HEAD SCREW		6
4	#8 X 3/4" PHILLIPS PAN HEAD SCREW		6

size <b>B</b>	dwg. no.	8-1.2		REV
SCALE: 1:2			T 1 OF 3	
TORQUE SPEC	CIFICATION:	15	5-20 L	.BS
CERTIFIC	ation:	UL 1741, NEMA 3 CSA C22.2 NO. 29		
WEIGHT:		1.45 LBS		S



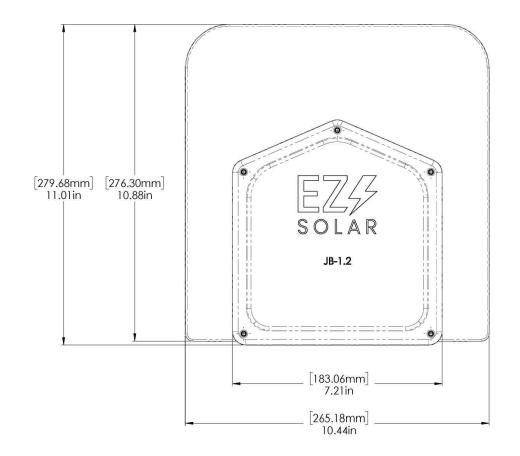

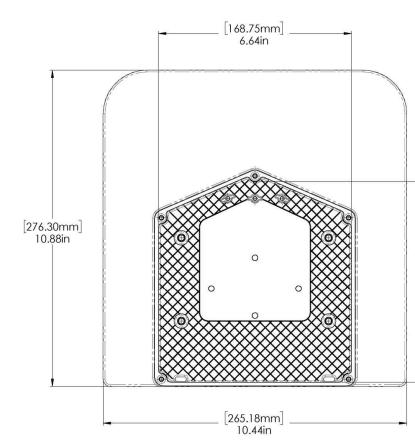

PROPRIETARY AND CONFIDENTIAL: THE INFORMATION CONTAINED IN THIS DRAWING IS THE SOLE PROPERTY OF EZ SOLAR. ANY REPRODUCTION IN PART OR AS A WHOLE WITHOUT THE WRITTEN PERMISSION OF EZ SOLAR IS PROHIBITED.



_ [72.53mm] _ 2.86in

# PHONE: 385-202-4150 WWW.EZSOLARPRODUCTS.COM

^{G. NO.} JB-1.2	REV
VEIGHT: 1.45 LBS	SHEET 2 OF 3



# PHILLIPS ENERGY SYSTEMS

7901 ALLEN BLACK RD, MINT HILL, NC 28227, UNITED STATES

REVISIONS				
DESCRIPTION	DESCRIPTION DATE			
INITIAL DESIGN	02/25/2025			
REVISION	05/15/2025	А		
REVISION	07/17/2025	В		



