


Google Maps 101 S Main St

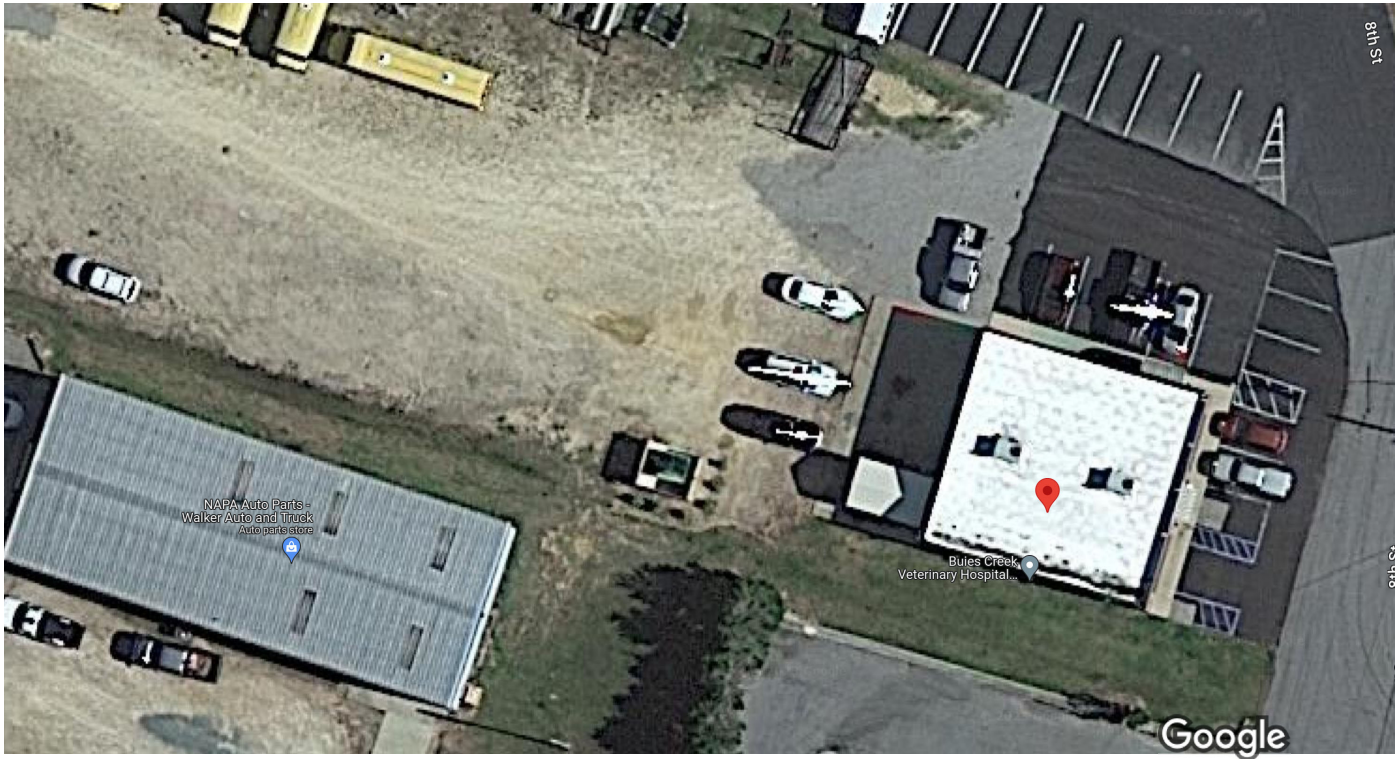

Map data ©2023, Map data ©2023 20 ft



101 S Main St
Building



Directions



Save



Nearby



Send to
phone




Share



101 S Main St, Lillington, NC 27546

Photos

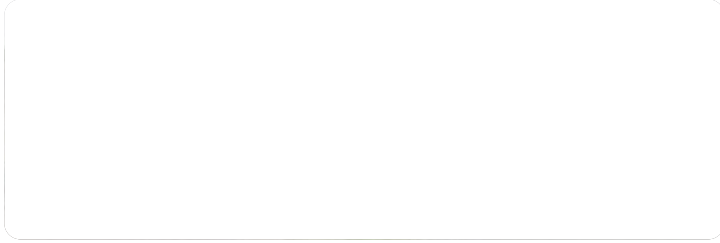

At this place


Buies Creek Veterinary Hospital and Dental Clinic

4.9 (314)


Veterinarian · Floor 1

[Open](#) · Closes 5 PM



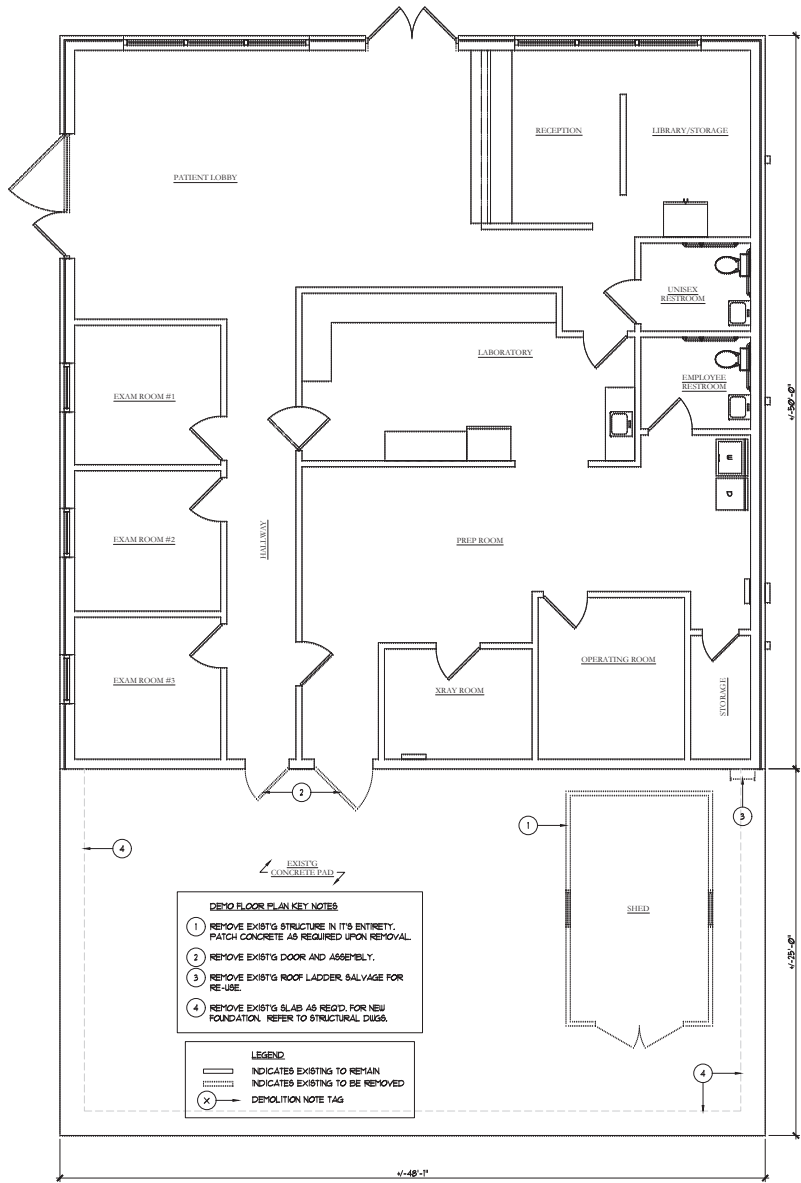

1 EXISTING AND DEMO PLAN
1/4" = 1'-0"

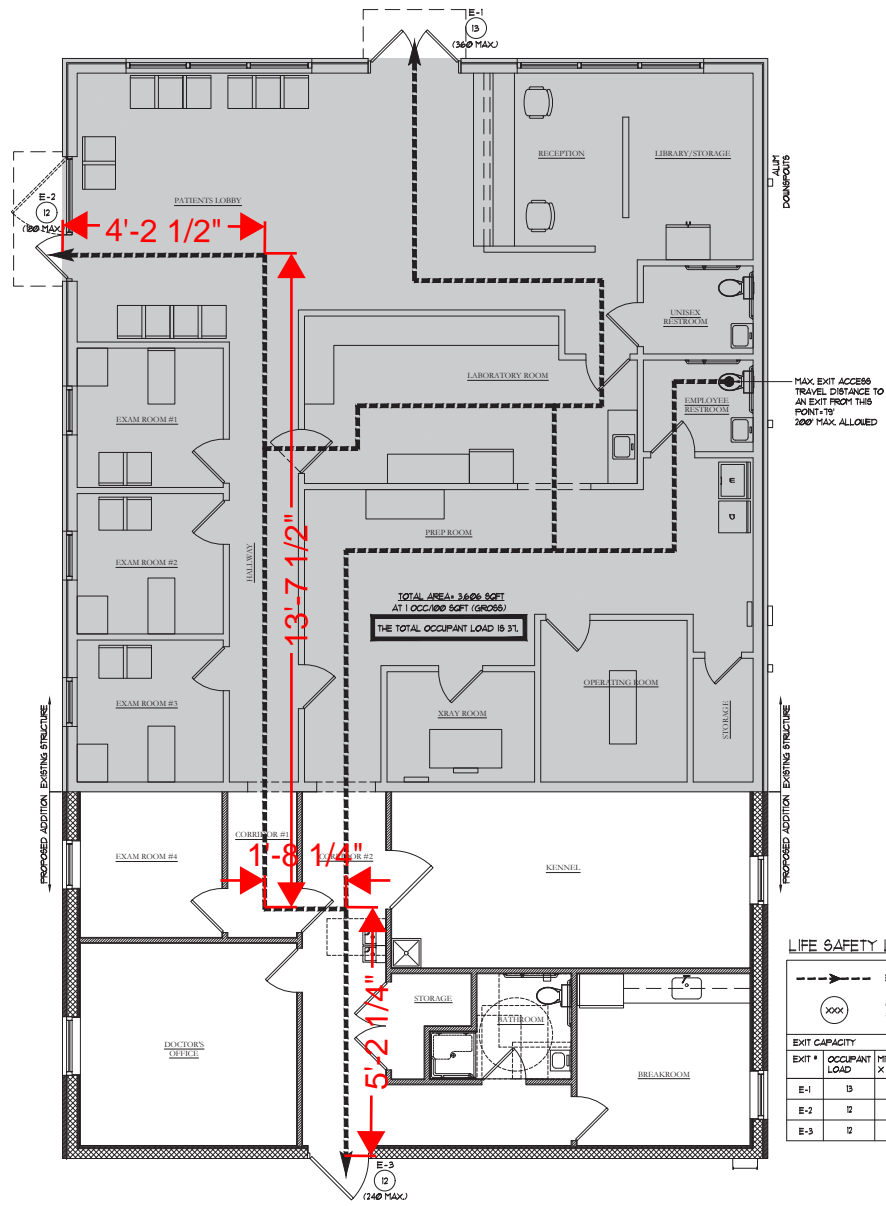

2 LIFE SAFETY PLAN
1/4" = 1'-0"



This plan is the property of Frank Gallucci, R.A. Architect. No part of this drawing may be reproduced or forwarded in any form, by any electronic or mechanical means, without the written consent of Frank Gallucci, R.A.

FGA ASSOCIATES, PLLC
FRANK GALLUCCI, ARCHITECT
11 S. MAIN ST.
WENDELL, N.C. 27591
Frank@FrankGAarchitect.com
919-819-4635



BUTES CREEK VETERINARY HOSPITAL ADDITION
101 S. MAIN ST.
LILLINGTON, N.C. 27546

REVISION/ISSUE:
12-12-2022_PERMIT SET

DATE: 12-12-2022
DRAWN BY: LM
JOB NUMBER: 22-111

DEMOLITION AND LIFE SAFETY PLANS

DATE:

A-1



Application for Plan Review

Application # _____ - _____

Date Received: _____ Received By: _____

Name of Project: Buies Creek Veterinary Clinic Addition

Physical Address of Project: 101 S Main Street

Lillington, NC 27546

Plans Submitted By: Vuncannon & Sons Builders, Inc.

Project Phone: (919)-255 - 8537

Contact Person/Address: Zachary W. Cabe

112 Strickland Lane

Lillington, NC 27546

Contact Email: zwc@vuncannonandsonbuildersinc.com

Contact Phone: (919)-255 - 8537 ()- -

Contractor's Name/Info: Vuncannon & Sons Builders, Inc.

112 Strickland Lane

Lillington, NC 27546

Contractor's Phone: (919)-255 - 8537

- Plans that are submitted will be reviewed as quickly as possible with an average time of review between 7-10 working days.
- Status checks may be conducted on plan reviews by visiting the website <http://hteweb.harnett.org/Click2GovBP/Index.jsp> or by calling the Harnett County Central Permitting Office (910-893-7525, Option #2), or the Harnett County Fire Marshal's Office (910-893-7580).
- Approved plans must be picked up from the Central Permitting Office and all fees paid before any required inspections can be conducted.