

Emergency Services Department

www.harnett.org

Fire Marshal Division


P.O. Box 370 Lillington, NC 27546 910-893-7580

Reviewed for Fire Code Compliance Harnett Leslie Jackson 07/26/2024 9:14:41 AM

Application for Plan Review

Permit Type:
Date Received: Received By:
Name of Project:
Physical Address of Project:
Plans Submitted By:
Project Phone: ()
Contact Person/Address:
Contact Phone: () ()
Contractor's Name/Info:
Contractor's Phone: ()
Contact Email:

- Plans that are submitted will be reviewed as quickly as possible with an average time of review between 7-10 working days.
- Status checks may be conducted on plan reviews by visiting the website http://hteweb.harnett.org/Click2GovBP/Index.jsp or by calling the Harnett County Central Permitting Office (910-893-7525: Opt. 2), or the Harnett County Fire Marshal's Office (910-893-7580).
- Approved plans must be picked up from the Central Permitting Office and all fees paid before any required inspections can be conducted.

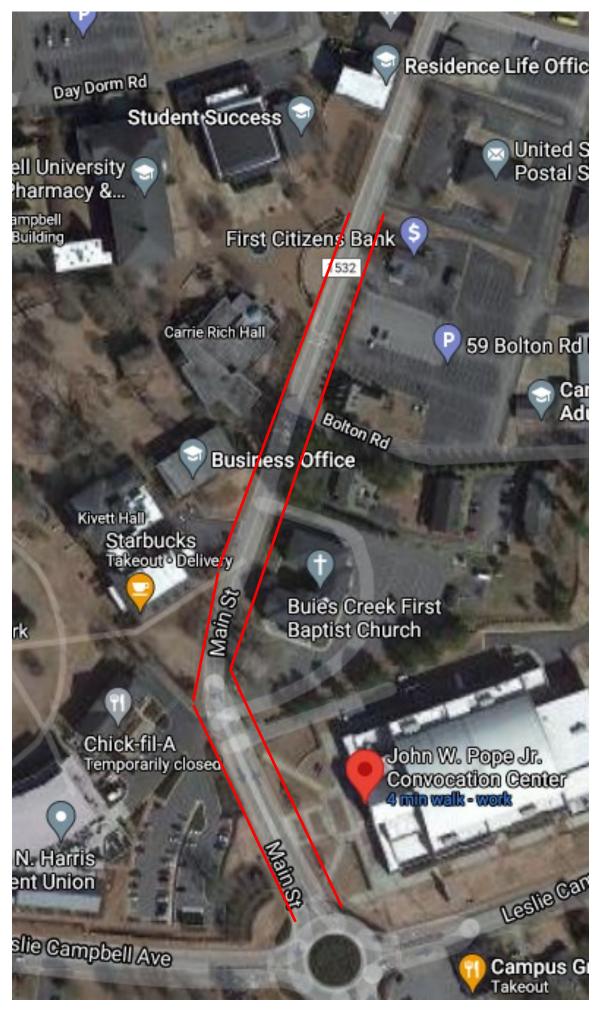

Red lines are
where the tables
will be lined up
on the street
with approx. 5-6
feet between
each table