

WELL CONSTRUCTION RECORD

North Carolina Department of Environment and Natural Resources - Division of Water Quality

WELL CONTRACTOR (INDIVIDUAL) NAME (print) Jerry W. Hamilton CERTIFICATION # 3403
 WELL CONTRACTOR COMPANY NAME Graham & Currie PHONE # (910) 673-2921
 STATE WELL CONSTRUCTION PERMIT# _____ ASSOCIATED WQ PERMIT# _____
 (if applicable) (if applicable)

1. WELL USE (Check Applicable Box): Residential Municipal/Public Industrial Agricultural
 Monitoring Recovery Heat Pump Water Injection Other If Other, List Use _____

2. WELL LOCATION: Cameron
 Nearest Town: Johnsville County Harnett
NC 24/2c 87 8th W. Wilson Rd
 (Street Name, Numbers, Community, Subdivision, Lot No., Zip Code)

Topographic/Land setting
 Ridge Slope Valley Flat
 (check appropriate box)
 Latitude/longitude of well location _____

3. OWNER: Charles White
 Address 874 Wilson Drive
 (Street or Route No.)
Cameron NC
 City or Town State Zip Code
(919) 698-0673
 Area code- Phone number

(degrees/minutes/seconds)
 Latitude/longitude source: GPS Topographic map
 (check box)

4. DATE DRILLED 8-4-08
 5. TOTAL DEPTH: 305
 6. DOES WELL REPLACE EXISTING WELL? YES NO


DEPTH		DRILLING LOG
From	To	Formation Description
0 - 4'		sand/topsoil
5 - 44'		clay
45 - 91'		gravel
92 - 151'		clay
152 - 305'		slate (weathered) granite

7. STATIC WATER LEVEL Below Top of Casing: 25 FT.
 (Use "+" if Above Top of Casing)
 8. TOP OF CASING IS 11 1/2 FT. Above Land Surface*
 *Top of casing terminated at/or below land surface requires a variance in accordance with 15A NCAC 2C .0118.

9. YIELD (gpm): 75 METHOD OF TEST air
 10. WATER ZONES (depth): 160 - 3 gen 176 - 6
~~283 - 66~~

LOCATION SKETCH

Show direction and distance in miles from at least two State Roads or County Roads. Include the road numbers and common road names 894

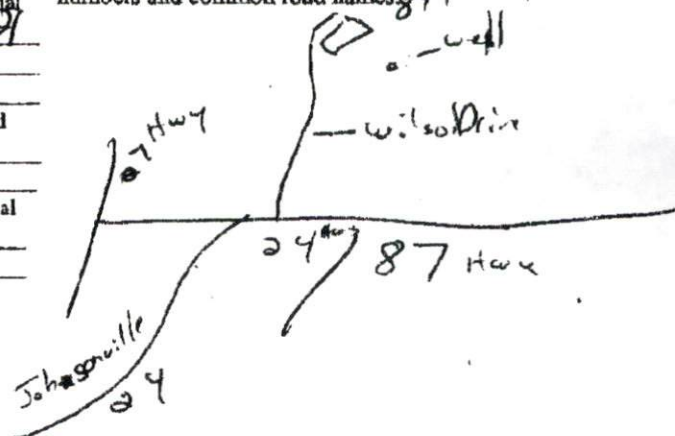

11. DISINFECTION: Type _____ Amount _____
 12. CASING:

From	To	Depth	Diameter	Wall Thickness	Material
		Ft.		or Weight/Ft.	
0	112		6 1/8	.188	SDS
From	To	Ft.			
From	To	Ft.			

13. GROUT: Depth _____ Material _____ Method _____
 From _____ To _____ Ft. _____
 From _____ To _____ Ft. _____

14. SCREEN: Depth _____ Diameter _____ Slot Size _____ Material _____
 From _____ To _____ Ft. _____ in. _____ in. _____
 From _____ To _____ Ft. _____ in. _____ in. _____

15. SAND/GRAVEL PACK:
 Depth _____ Size _____ Material _____
 From _____ To _____ Ft. _____
 From _____ To _____ Ft. _____

16. REMARKS: _____

I DO HEREBY CERTIFY THAT THIS WELL WAS CONSTRUCTED IN ACCORDANCE WITH 15A NCAC 2C, WELL CONSTRUCTION STANDARDS, AND THAT A COPY OF THIS RECORD HAS BEEN PROVIDED TO THE WELL OWNER

Jerry W. Hamilton SIGNATURE OF PERSON CONSTRUCTING THE WELL
8.6.08 DATE

Submit the original to the Division of Water Quality, Attn: Information Management, 1617 Mail Service Center - Raleigh, NC 27699-1617, Phone No. (919) 733-7015, within 30 days.