

Initial Application Date: 9-28-07

Application # 0750018564

COUNTY OF HARNETT LAND USE APPLICATION

Central Permitting 108 E. Front Street, Lillington, NC 27546 Phone: (910) 893-7525 Fax: (910) 893-2793 www.harnett.org

LANDOWNER: Lely m CASTELLANOS ALVARADO Mailing Address: 481 MCDUFFIE Rd
City: CAMERON State: N-C Zip: 28326 Home #: 919-499-2399 Contact #: 910-987-7047

APPLICANT: Lely m CASTELLANOS ALVARADO Mailing Address: 481 MCDUFFIE Rd
City: CAMERON State: N-C Zip: 28326 Home #: 919-499-2399 Contact #: 910-987-7047

*Please fill out applicant information if different than landowner

PROPERTY LOCATION: Subdivision: NA HIVE Lot #: 30 Lot Size: .86

Parcel: 099563 0065 PIN: 9563-89-4736.000

Zoning: RA20R Flood Plain: X Panel: 9562 Watershed: 111 Deed Book&Page: 2086/258 Map Book&Page: 61S

SPECIFIC DIRECTIONS TO THE PROPERTY FROM LILLINGTON: TAKE Hwy 27 TO 24 going TO CAMERON
MAKE LEFT ON 24 go 3 1/2 miles TO MARKS ROAD MAKE A RIGHT ON
MARKS ROAD go 4 miles TO MCDUFFIE ROAD MAKE A RIGHT ON MCDUFFIE
go TO SCOOTER LANE LAST ROAD ON LEFT LOT IS THE LAST LOT ON RIGHT

PROPOSED USE:

- Circle:
- D (Size x) # Bedrooms # Baths Basement (w/wo bath) Garage Deck Crawl Space / Slab
 - Modular On frame Off frame (Size) # Bedrooms # Baths Garage (site built NA) Deck NA (site built?)
 - Multi-Family Dwelling No. Units No. Bedrooms/Unit
 - Manufactured Home: SW DW TW (Size 24 x 60) # Bedrooms 3 Garage (site built?) Deck NA (site built? NA)
 - Business Sq. Ft. Retail Space Type # Employees: Hours of Operation:
 - Industry Sq. Ft. Type # Employees: Hours of Operation:
 - Church Seating Capacity # Bathrooms Kitchen
 - Home Occupation (Size x) # Rooms Use Hours of Operation:
 - Accessory/Other (Size x) Use
 - Addition to Existing Building (Size x) Use Closets in addition () yes () no

Water Supply: (County) (Well (No. dwellings)) **MUST** have operable water before final

Sewage Supply: (New Septic Tank (Complete **New Tank Checklist**)) (Existing Septic Tank) (County Sewer) (Other)

Property owner of this tract of land own land that contains a manufactured home within five hundred feet (500') of tract listed above? (YES) (NO)

Structures on this tract of land: Single family dwellings Manufactured Homes 2 prop Other (specify)

Required Residential Property Line Setbacks:

Front	Minimum	35	Actual	35'
Rear		25		450'
Side		10		30'
Sidestreet/corner lot		20		50'
Nearest Building on same lot		6		

Comments: see 18563 for New tank
DWMH in front existing tank
SWMH in rear new tank

If permits are granted I agree to conform to all ordinances and the laws of the State of North Carolina regulating such work and the specifications of plans submitted. I hereby state that the foregoing statements are accurate and correct to the best of my knowledge. This permit is subject to revocation if false information is provided on this form.

Lely m Castellanos
Signature of Owner or Owner's Agent

9-17-07
Date


This application expires 6 months from the initial date if no permits have been issued

A RECORDED SURVEY MAP, RECORDED DEED (OR OFFER TO PURCHASE) AND PLAT ARE REQUIRED WHEN APPLYING FOR LAND USE APPLICATION

Please use Blue or Black Ink ONLY

10/15 S 3/07


Scooter LN RD

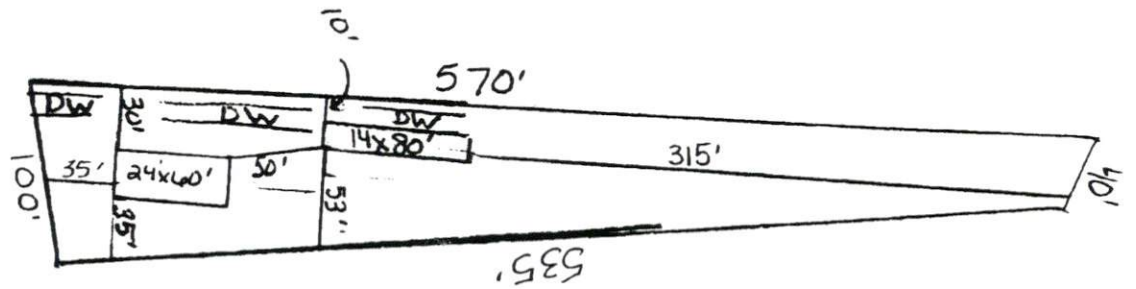

SITE PLAN APPROVAL
DISTRICT RAZOR USE DWMH
#BEDROOMS 3
JNO 9/28/07
ZONING ADMINISTRATOR

X Ilyu. Castellanos.

1"=100'

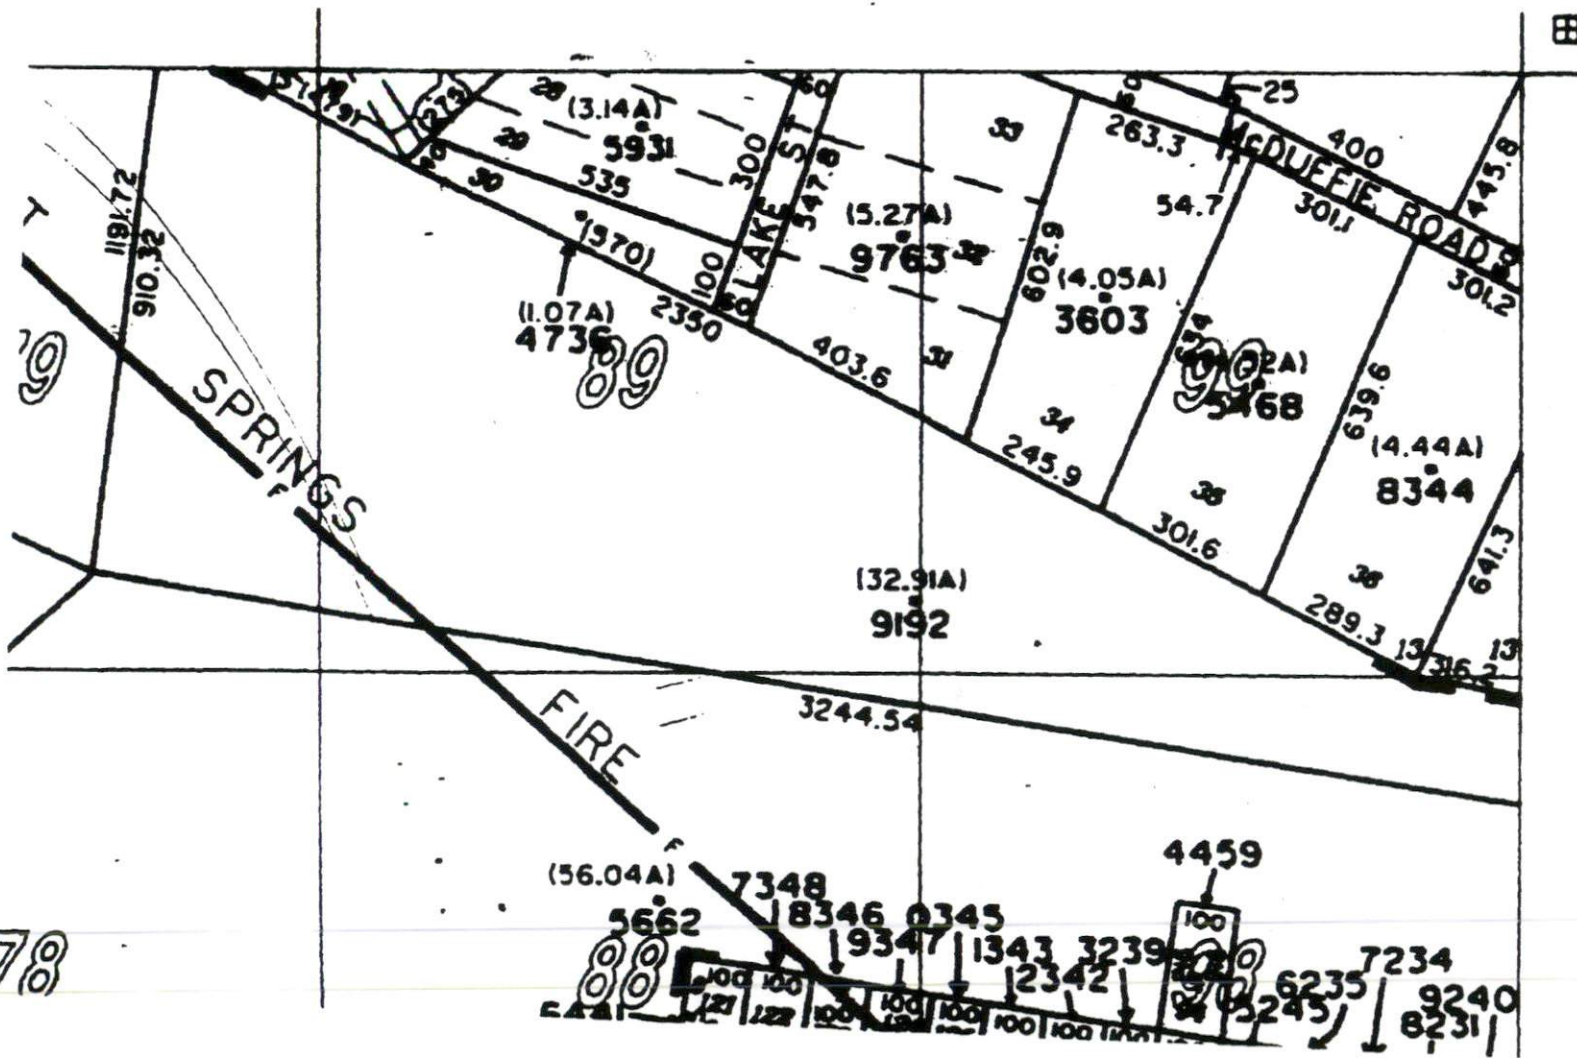

N 540,000

78

9

8

2048

ALL IRONS

Appears

that line from

existing tank runs

under PP MK site (cannot build or place here
on top of drain lines)

In order to tell how down

pipe all come out of tank

2 "D" Box if one is then can

Determine by probe which way

lines run. After that

we can figure ~~where to~~ if it possible

To add ^{and} ~~was~~

~~could go~~ & if it's ~~septic system~~ & ~~repair~~