

Initial Application Date: 2-27-03 Application # 03-50006580

Revised By B
Y OF HARNETT LAND USE APPLICATION 3/19/03

Central Permitting 102 E. Front Street, Lillington, NC 27546 Phone: (910) 893-4759 Fax: (910) 893-2793

LANDOWNER: Tom Herbert Mailing Address: 1794 Old Stage Rd
City: Edwin State: NC Zip: 28339 Phone #: 910 658 3128

APPLICANT: ~~Edna Matthews~~ Mailing Address: 413 E Jackson Blvd
City: ~~Edna NC~~ State: NC Zip: 28339 Phone #: 919 630 0408

PROPERTY LOCATION: SR #: 1769 SR Name: Old Stage
Parcel: 07-0588-0093-18 PIN: 0588-38-9725

Zoning: RA30 Subdivision: _____ Lot #: 2 Lot Size: 2.01Ac
Flood Plain: X Panel: 111 Watershed: D Deed Book/Page: 1360-764 Plat Book/Page: 2002-1221

If located with a Watershed indicate the % of Impervious Surface: _____
DIRECTIONS TO THE PROPERTY FROM LILLINGTON: 421 S (R) Old Stage Rd
Lot on Right 1 1/10 mile

PROPOSED USE:

- Sg. Family Dwelling (Size _____ x _____) # of Bedrooms _____ # Baths _____ Basement (w/wo bath) _____ Garage _____ Deck _____
- Multi-Family Dwelling No. Units _____ No. Bedrooms/Unit _____
- Manufactured Home (Size 28x64) # of Bedrooms 54 Garage _____ Deck _____ 3 Baths

- Comments: _____
- Number of persons per household _____
 - Business Sq. Ft. Retail Space _____ Type Nothing on site plan
 - Industry Sq. Ft. _____ Type 13 Changing! (Gross)
 - Home Occupation (Size _____ x _____) # Rooms _____ Use Just the number of bedrooms is changing.
 - Accessory Building (Size _____ x _____) Use _____
 - Addition to Existing Building (Size _____ x _____) Use _____
 - Other per cum. size of home is

Water Supply: County Well (No. dwellings _____) Other staying the same

Sewage Supply: New Septic Tank Existing Septic Tank County Sewer Other X Debra J Cardone

Erosion & Sedimentation Control Plan Required? YES NO

Structures on this tract of land: Single family dwellings _____ Manufactured homes _____ Other (specify) Proposed

Property owner of this tract of land own land that contains a manufactured home w/in five hundred feet (500') of tract listed above? YES NO


Required Property Line Setbacks:	Minimum	Actual	Minimum	Actual
Front	<u>35</u>	<u>85</u>	Rear	<u>25</u> <u>50</u>
Side	<u>10</u>	<u>50</u>	Corner	<u>20</u> <u>/</u>
Nearest Building	<u>10</u>	<u>/</u>		

If permits are granted I agree to conform to all ordinances and the laws of the State of North Carolina regulating such work and the specifications or plans submitted. I hereby swear that the foregoing statements are accurate and correct to the best of my knowledge.

[Signature]
Signature of Owner or Owner's Agent
X Debra J Cardone

27 Feb 03 3/19 3/20
Date 195+197 N

This application expires 6 months from the date issued if no permits have been issued

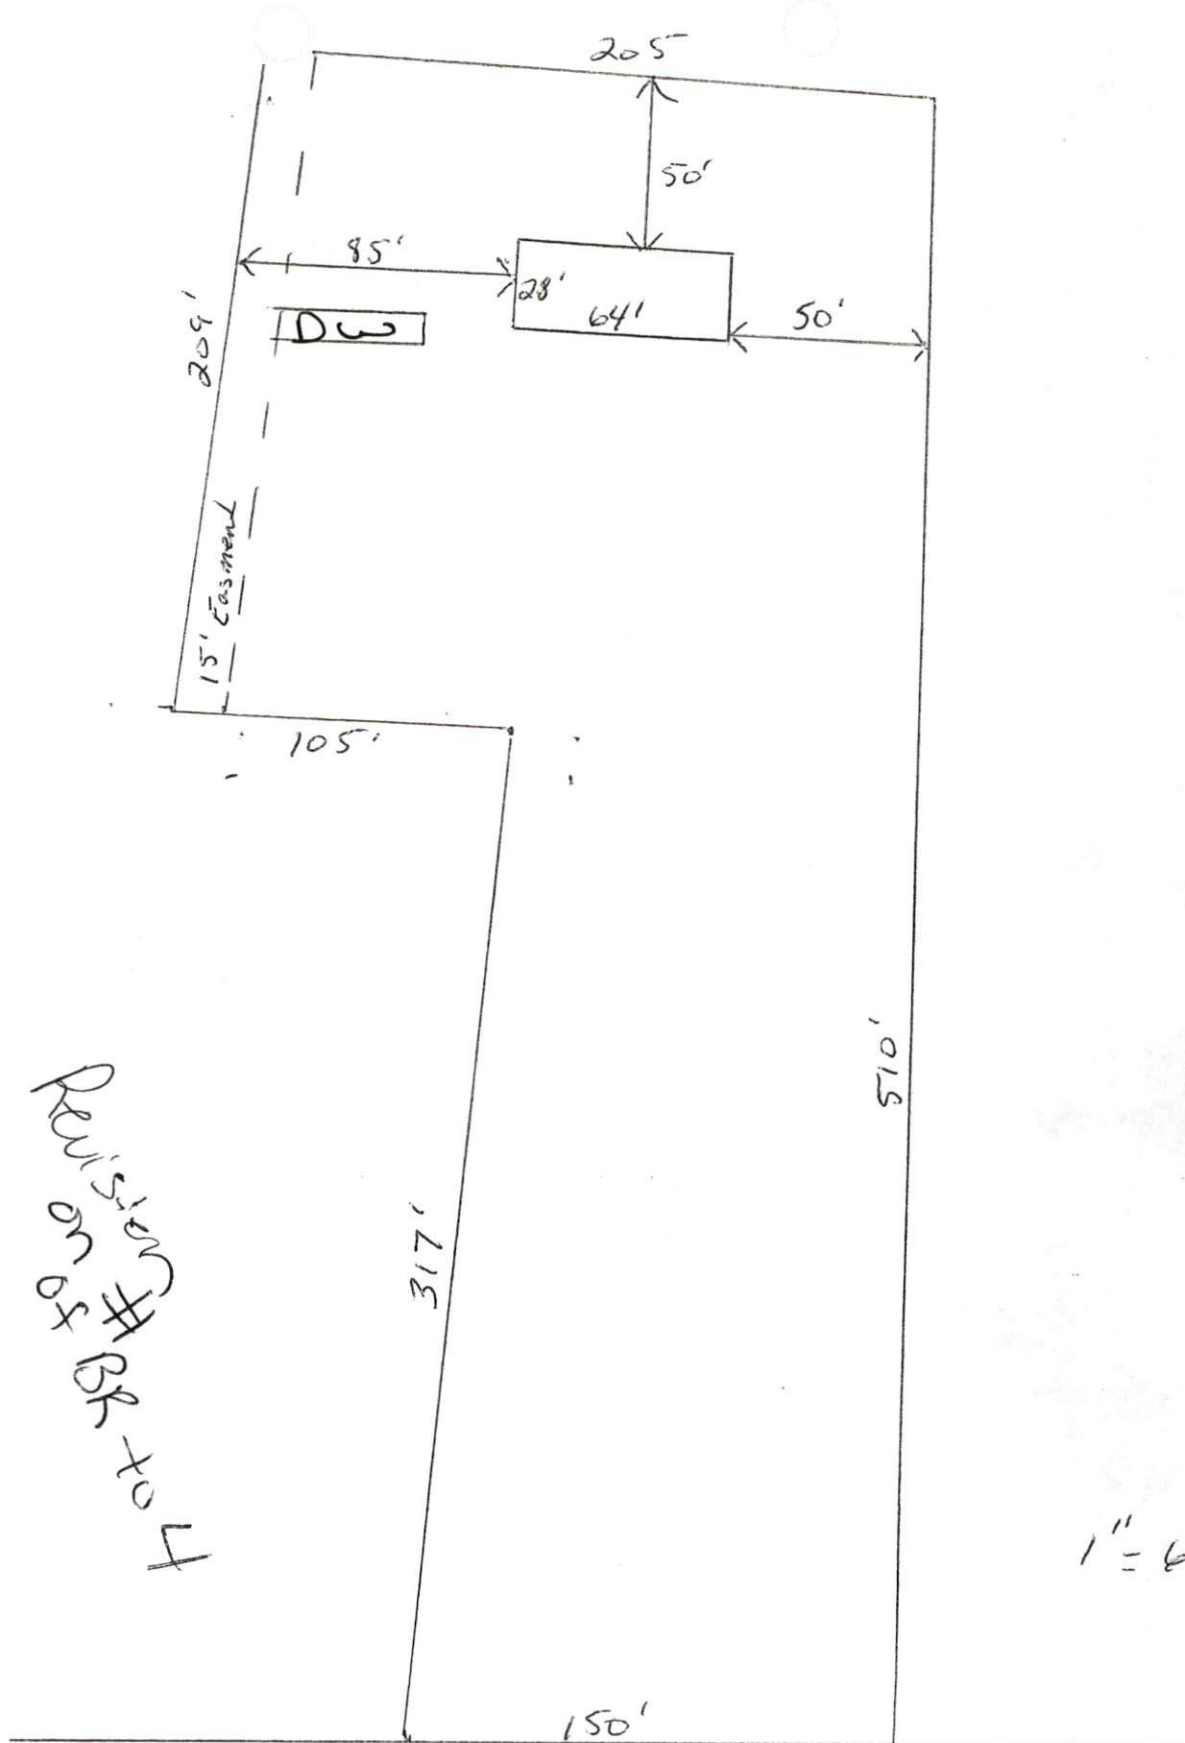

Revision # BR-104
 on 05


SITE PLAN APPROVAL

DISTRICT RA30 USE DwM H

#BEDROOMS 5 4

Date 2-27-03
 Zoning Administrator [Signature]

Old Stage Rd. SR 1769

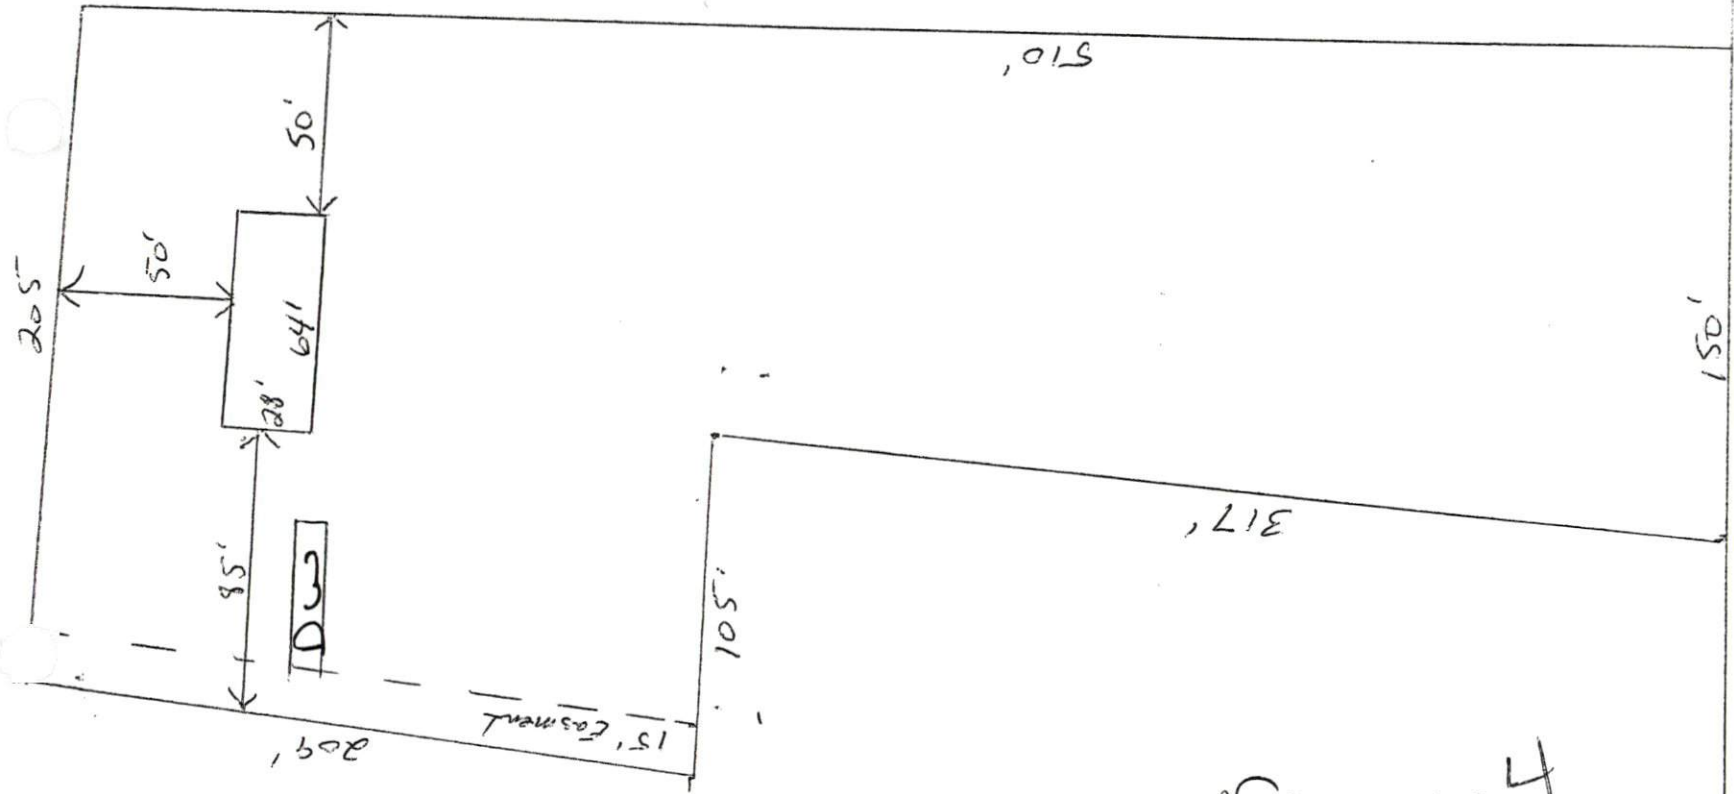

1" = 60'

Old Stage Rd. SR 1769

Revision on # of BR to 4

SITE PLAN APPROVAL

DISTRICT RA30 USE Dw m H

#BEDROOMS 4

2-27-03

[Signature]
Zoning Administrator