
HARNETT DEPARTMENT OF PUBLIC HEALTH PERMIT TO CONSTRUCT A DRINKING WATER SUPPLY WELL			
PIN #: Parcel #: Application #: 2) منابع المحالي محالي			
Applicant Name: MARILYN MAtthems Address: <u>431</u> Nerghbors RA DUNN N.C. 28334			
Type of Facility Served by Well: SFD			
Sewage System:			
Permit Conditions:			
<ul> <li>General Permit Conditions:</li> <li>Drinking water supply well construction must meet 15A NCAC 02C.100 rules</li> <li>The permitted drinking water supply well shall be located in accordance with the SITE PLAN</li> <li>ANY ALTERATION of the site of the site (including location of structures and appurtenance) or modification in use of the well, may subject this Permit to revocation</li> </ul>			
Authorized State Agent Jan & Manhand Eron Date 1-9-13			
Grouting Inspection Witnessed     Date       Grouting self-certified by driller     GW-1 provided?     Yes     No			
See attachment for construction sketch			
WELL CERTIFICATE OF COMPLETION 12-5 Date: 1-9-7 3 Application #: The 34 it Well Contractor: With Contrac			
Use of Well:        Date Drilled:        Total Depth:        Replacement Well?       Yes       No         Static Water Level:        Top of Casing is      in. above surface.       Yield:      gpm at      ft.         Disinfection:       Type        Amount			
Water Zone (depth)       Casing       Grout         From To       From To       From To         From To       Diameter: Material: Thickness:       Material: Method:         From To       To       From To       From To         From To       To       Material: Thickness:       Material: Method:         From To       To       Thickness:       Material: Method:         Diameter: Material: Thickness:       Material: Method:       From To         Diameter: Material: Thickness:       Material: Method:       Method:			
Inspector: On Hold Date: Release Date:			
Remarks:			
Well Head Information         Casing Height:      (above finished grade)       Access Port:      Vent Stack:         Well ID Tag:      Sampling Tap:      Backflow Preventer:          Sample Taken?       Yes       No       Well Head properly sealed:			
Remarks:			
Authorized State Agent and Mark for Date 1-10-13			


See Attachment for completion sketch

125-Application #: Moyic Applicant Name: Mathe Subdivision: \_\_\_\_ Lot #: \_\_\_\_

## Well Construction Sketch

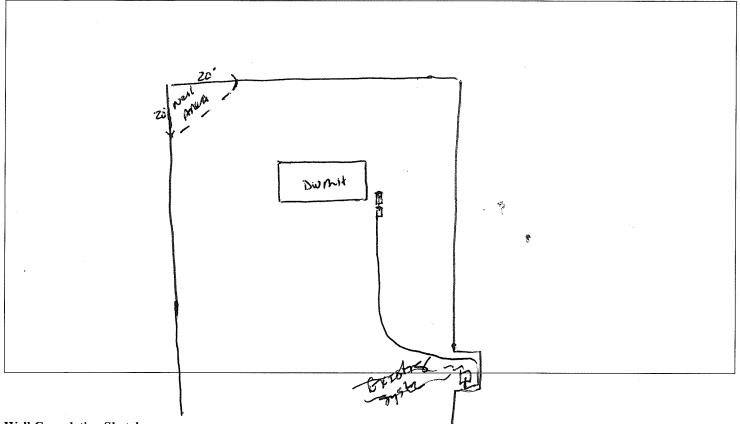

## Well Completion Sketch

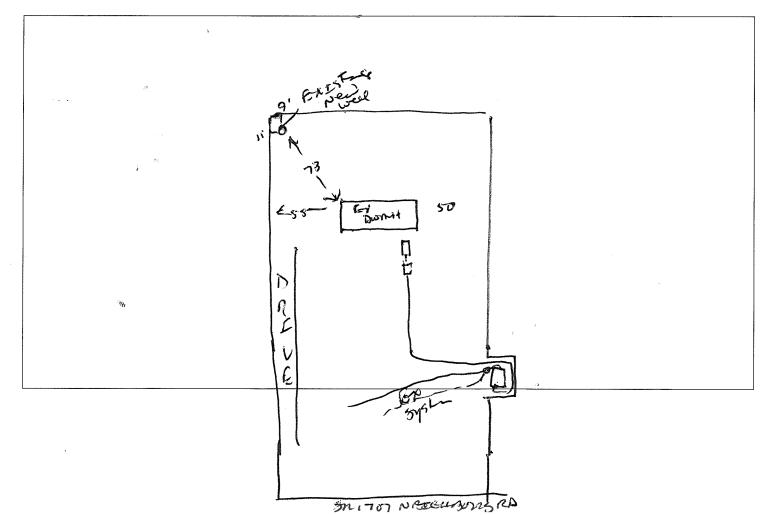

WELL CONSTRUCTION RECORD

i.

North Carolina - Department of Environment and Natural Resources -	- Division of Water Quality - Groundwater Section	
WELL CONTRACTOR (INDIVIDUAL) NAME (print)_ Larry Williford	CERTIFICATION # 2863	
WELL CONTRACTOR COMPANY NAME Larry Williford's Well Drillin	PHONE # (910) 567-2579	
	SOCIATED WO PERMITS	
(if applicable)	(if spplicable)	
1. WELL USE (Check Applicable Box): Residential A Municipal/ Monitoring C Recovery C Heat Pump Water Injection C O	Public D Industrial D Agricultural D other D If Other, List Use	
2. WELL LOCATION: Nearest Town: DUNN County Harnett OFSIde 431 Neighbors RA (Street Name, Number, Community, Subdivision, Lot No., Zip Code)	Topographic/Land setting DRidge DSlope DValley WFlat (check appropriate box) Lastude/longitude of well location	
3. OWNER: <u>Marilyn S Matthews</u> Address <u>13 Nreighbors 24</u> (Struct or Route No.) 28334 <u>Dunn NC</u> 28334 <u>City or Town</u> States Zip Code	(degrees/minutes/seconds)       Latitude/longitude source: []GPS[]Topographic map (check box)       DEPTH     DRILLING LOG       From     To       Formation     Pop Squit	
Ares code Phone number 4. DATE DRILLED <u>11-29-17</u> 5. TOTAL DEPTH: <u>35 F+</u> 6. DOES WELL REPLACE EXISTING WELL? YES □ NO S 7. STATIC WATER LEVEL Below Top of Casing: <u>11</u> FT.	2+9 9-26 7-26 Fan-White Clay 26-55 tan sund	
(Use "4" if Above Top of Casing) 8. TOP OF CASING IS FT. Above Land Surface" "Top of casing terminated at/or below land surface requires a variance in accordance with 15A NCAC 2C .0118. 9. YIELD (gpm): METHOD OF TEST <u>DUMPING</u> 10 WATER ZONES (depth): 26-35		
11. DISINFECTION: Type HTH Amount 14 (ALP 12. CASING: Wall Thickness From 1 To 26 Ft 2 SCH40 PVC	LOCATION SKETCH Show direction and distance in miles from at least two State Reads or County Roads. Include the road numbers and common road names.	
From     To     Ft       From     To     Ft       13. GROUT:     Depth     Material       From     O     To       Pt     Coment     PUUY	Kweil -	
From 26 To 35 Ft 2 in. 018 in. 9VC From To Ft. in. in	neighbors	
From 20 To 35 Ft #2 Sandpuck From To Ft Duit	301 AU	Bensen
I DO HEREBY CERTIFY THAT THIS WELL WAS CONSTRUCTED IN AC CONSTRUCTION STANDARDS, AND THAT A COPY OF THIS RECORD Lawy Willfold Y SIGNATURE OF PERSON CONSTRUCTION	1 HAS BEEN PROVIDED TO THE WELL OWNER	
Signatukeøp person gunstrugta		

Submit the original to the Division of Water Quality, Groundwater Section, 1636 Mail Service Center - Raleigh, NC 27699-1636 Phone No. (919) 733-3221, within 30 days. GW-1 REV. 07/2001