

WILLIAM A. PERSON, P.E.
CONSULTING ENGINEER

774A E F COTTRELL RD.
LOUISBURG, NC 27549

(919) 496-5228
(FAX)(919) 496-3213
1-800-545-3496

October 10, 2017

Paradise Homes
8087 NC 222 West
Kenly, N.C. 27542


Re: Elevated Modular Home Inspection
60 Crystal Brook Dr.
Angier, N.C.


Dear Sirs:

An inspection has been performed on the anchoring system of the manufactured home described above. More than one-fourth of the main I beam support piers exceed 36" in height. The Stabilizing system has been designed for the height of the home and the wind, live, and dead loads specified by the State of North Carolina Regulations for Manufactured Homes.


The stabilizing system is structurally adequate as installed for the specified loads and site conditions. The location and type of each tie down is shown on the attached sheet 2 of 2.

Sincerely,

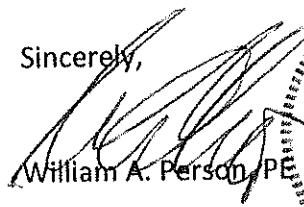

William A. Person, P.E.

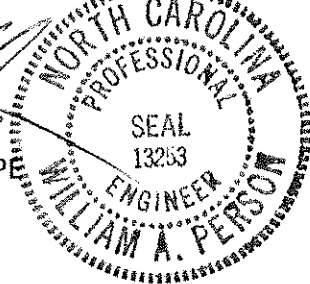

The seal is circular with a double-line border. The outer ring contains the text "NORTH CAROLINA" at the top and "WILLIAM A. PERSON" at the bottom. The inner ring contains "PROFESSIONAL" at the top and "ENGINEER" at the bottom. In the center, it says "SEAL" and "13253".

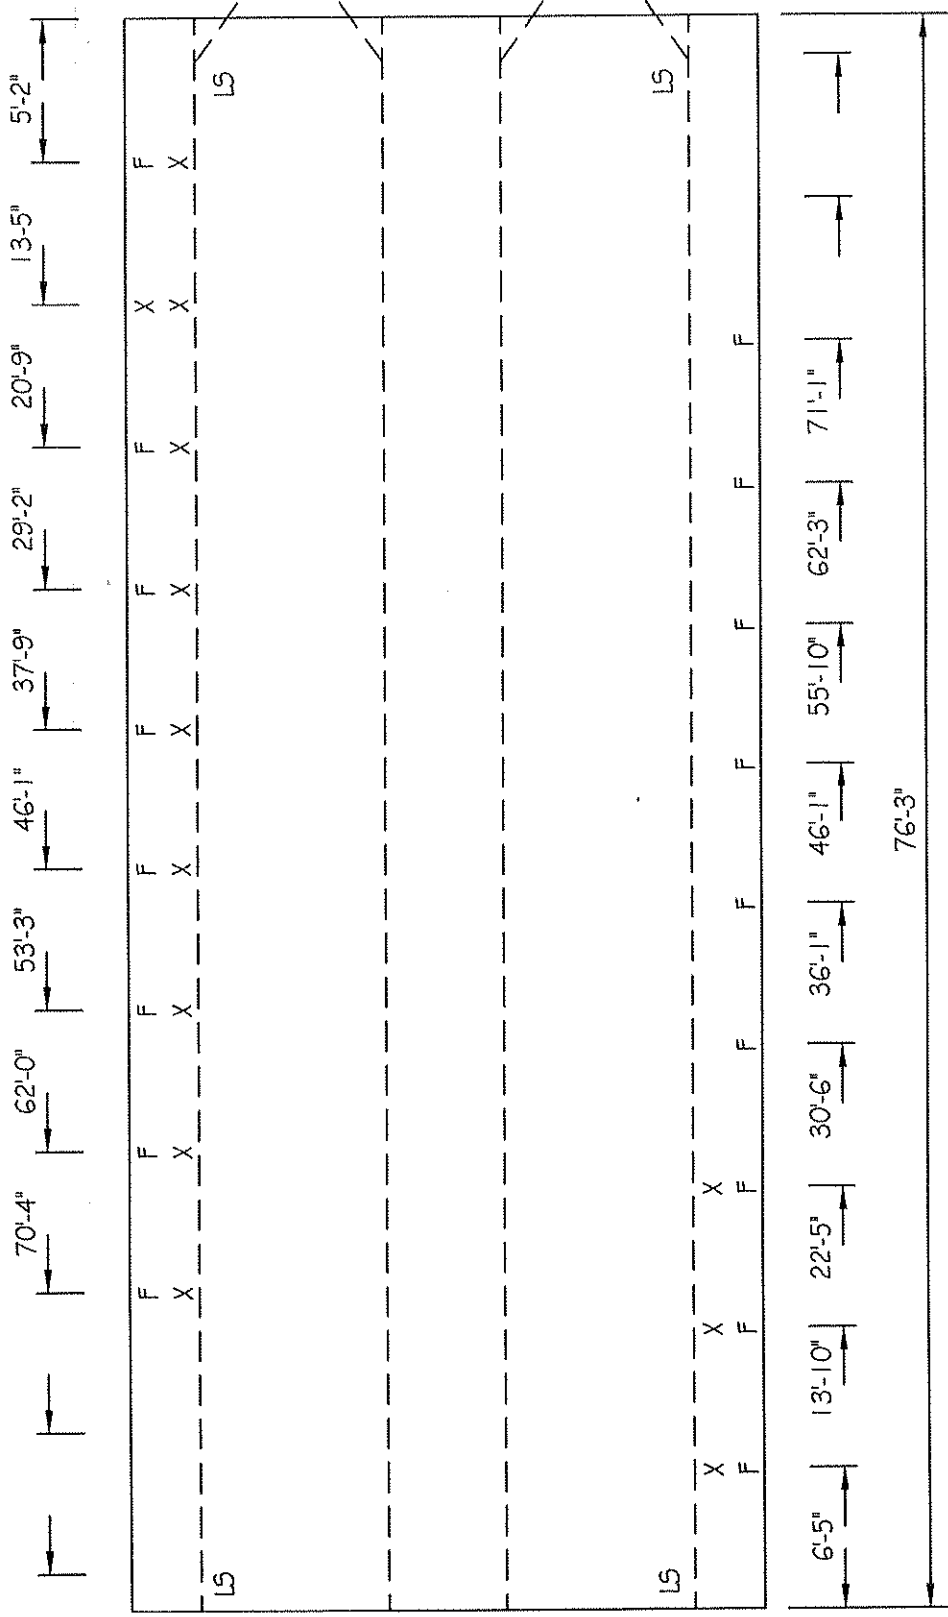

NOTES:
 F = FRAME TIE
 X = CROSS TIE
 LS = LONGITUDINAL STRAP

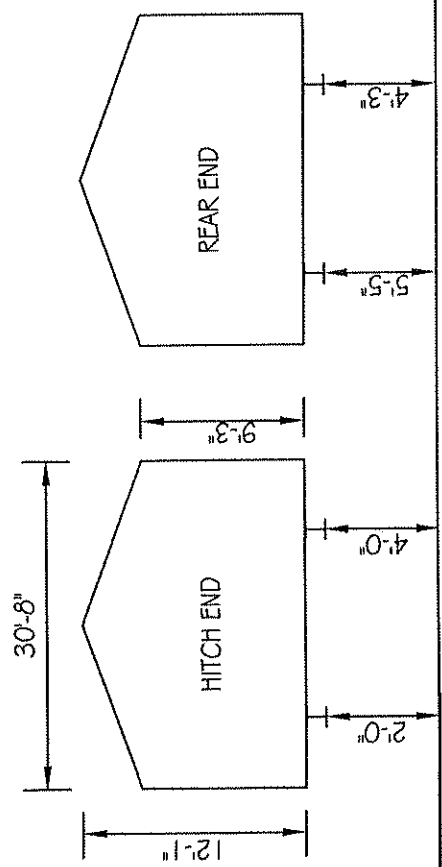

FIELD INSPECTION REPORT	
PARADISE HOMES	
60 CRYSTAL BROOK DR., ANGLIER, NC	
DATE	DWG. NO.
10/5/17	
SHEET NO. 2 OF 3	